



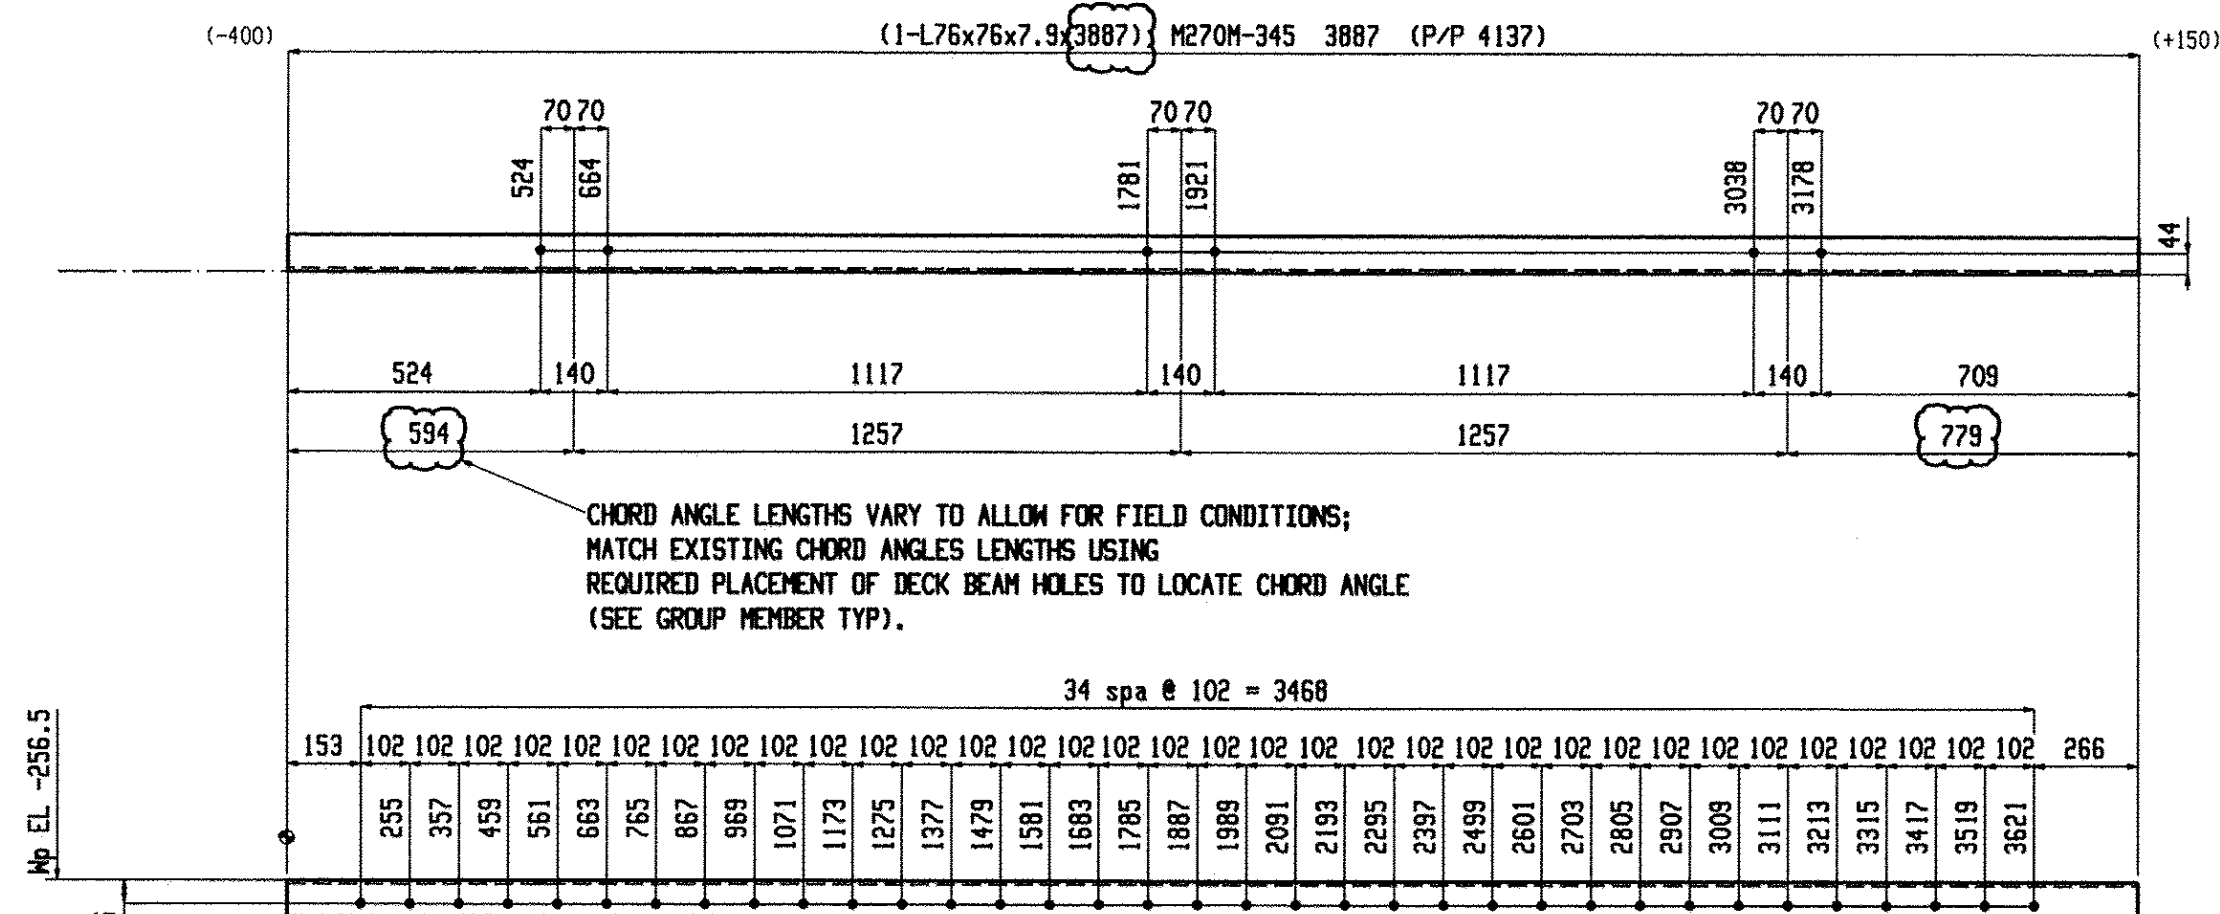


2 ANGLES A22

SHOP NOTE:
TOE DIRECTION FAR SIDE

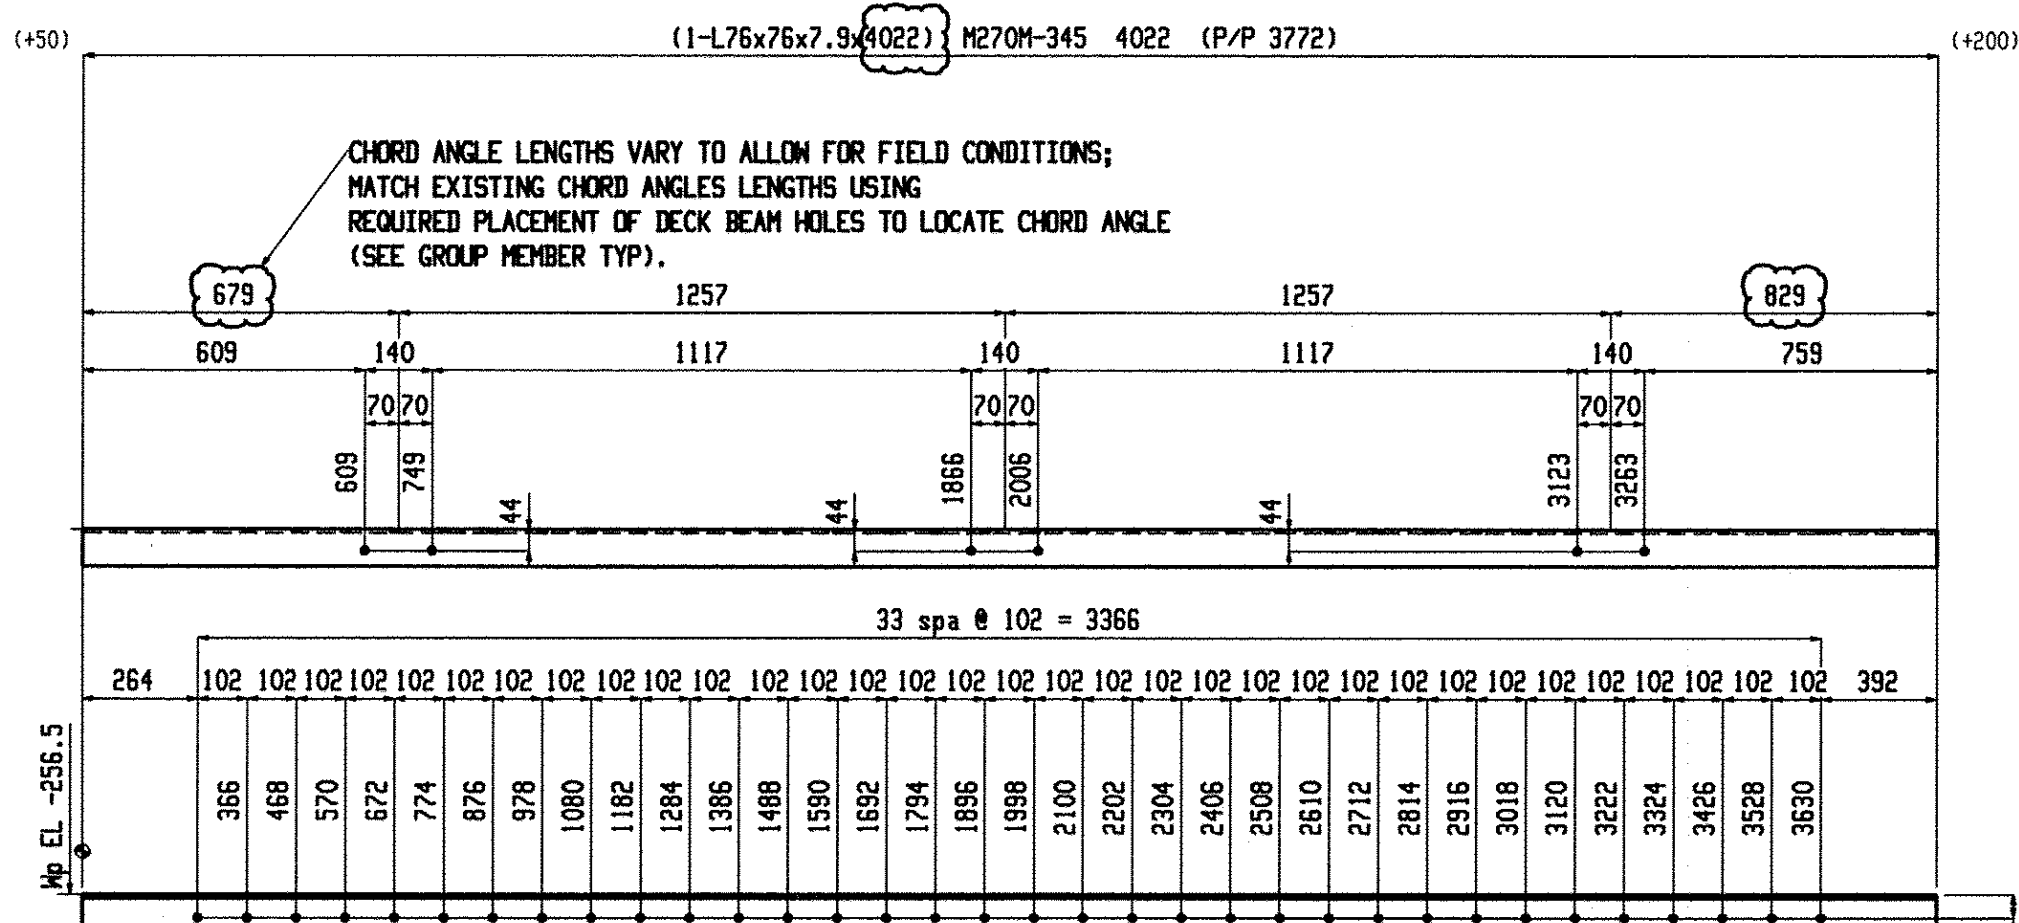


2 ANGLES A24

SHOP NOTE:
TOE DIRECTION NEAR SIDE

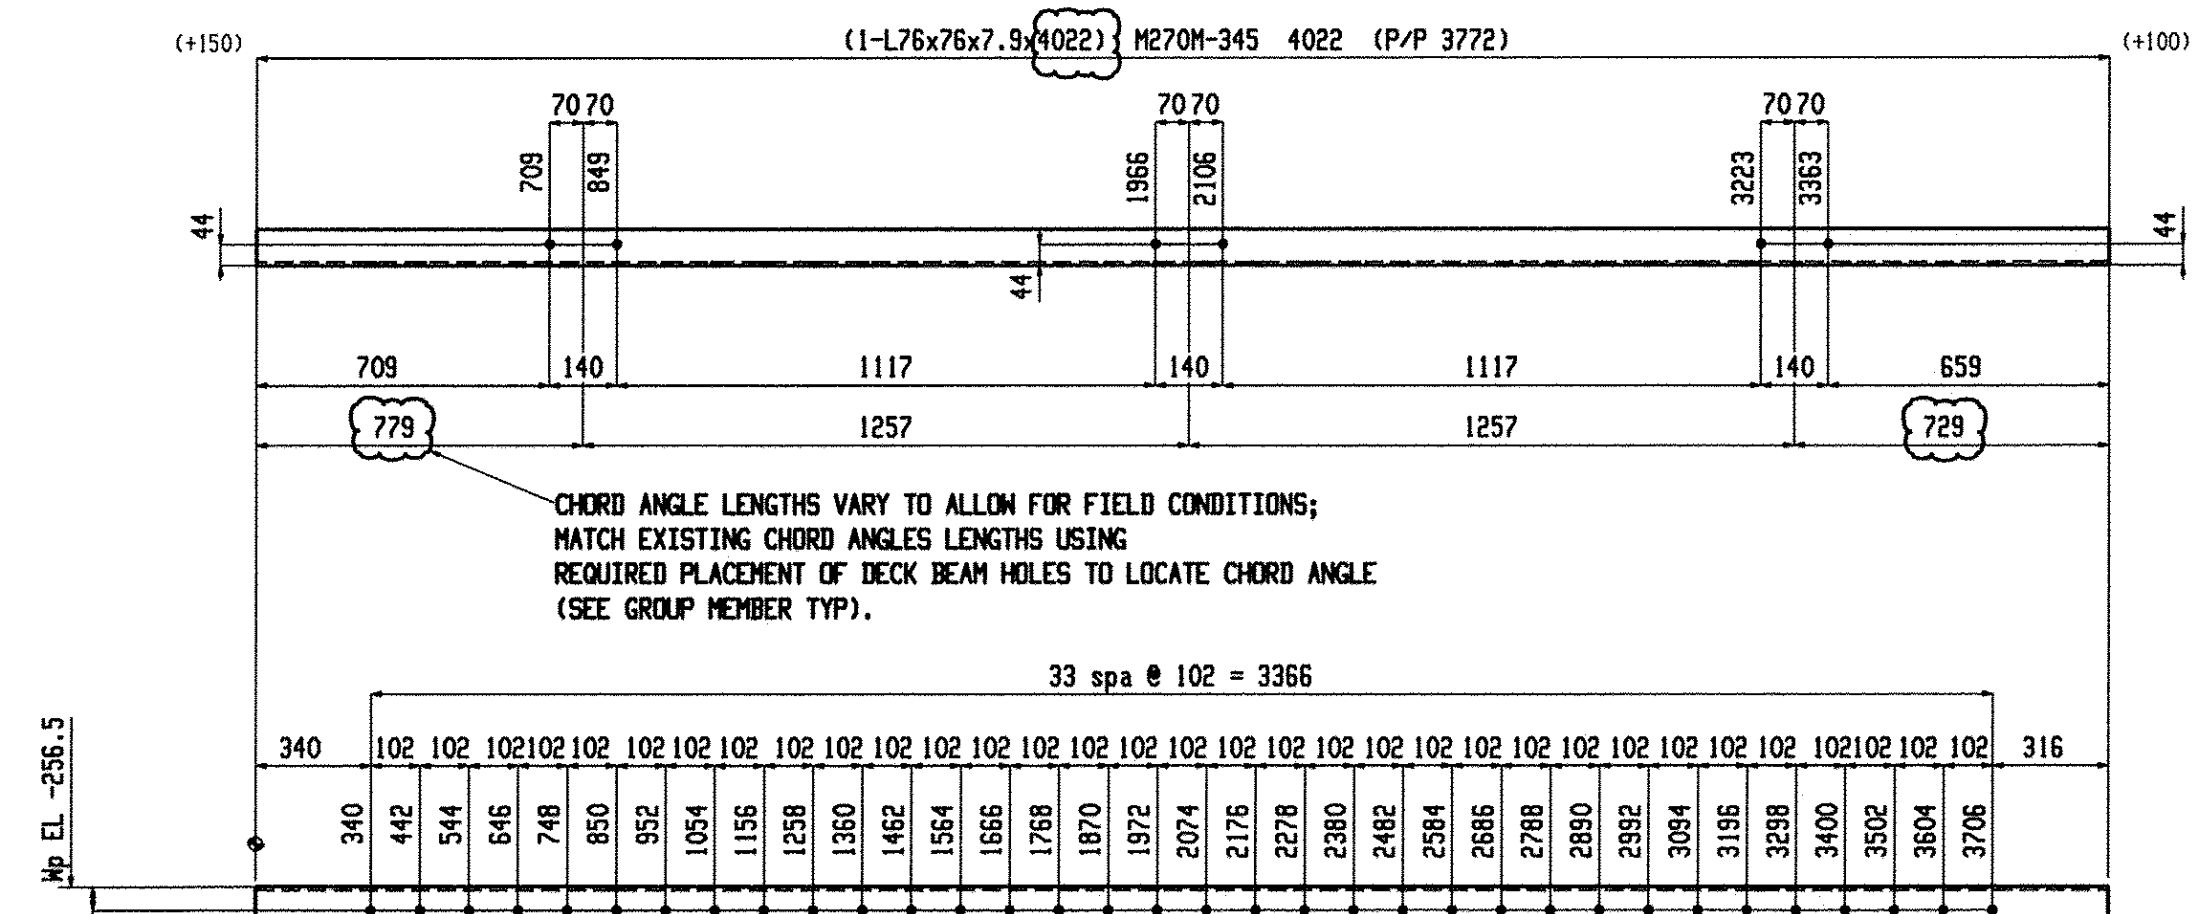

2 ANGLES A23

SHOP NOTE:
TOE DIRECTION FAR SIDE

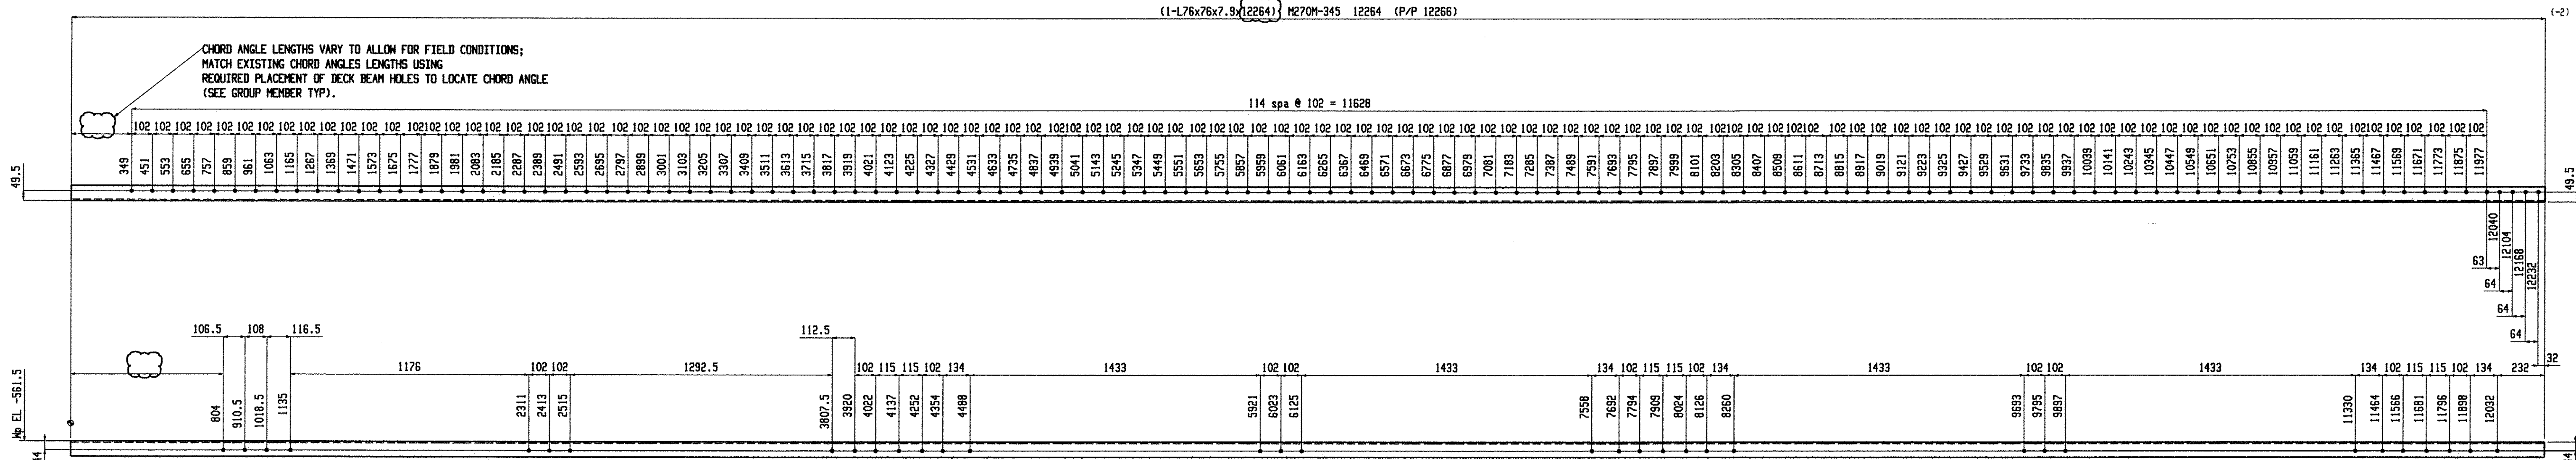

2 ANGLES A25

SHOP NOTE:
TOE DIRECTION FAR SIDE

BILL OF MATERIAL									BILL OF MATERIAL									BILL OF MATERIAL								
Qty	Piece			Seq	Seq	Adv	Steel		Qty	Piece			Seq	Seq	Adv	Steel		Qty	Piece			Seq	Seq	Adv	Steel	
Tot.	Mark	Description	Length	NO.	Qty	ABM #	Grade	Remarks	Tot.	Mark	Description	Length	NO.	Qty	ABM #	Grade	Remarks	Tot.	Mark	Description	Length	NO.	Qty	ABM #	Grade	Remarks
2	A22	ANGLE		1	2				2	A24	ANGLE		1	2												
2	A22	L76x76x7.9	3887				M270M-345		2	A24	L76x76x7.9	4022				M270M-345										
2	A23	ANGLE		1	2				2	A25	ANGLE		1	2												
2	A23	L76x76x7.9	4022				M270M-345		2	A25	L76x76x7.9	12264				M270M-345										

Total weight : 435

RECEIVED

OK'D BY: OK'D BY:

NOV 17 2009

RECEIVED

NOTE: WORK THIS DRAWING WITH
GROUP MEMBER GM6

Renaud Bros. Inc.

283 Fort Bridgeman Rd. #2
Vernon, VT. 05354
Phone 1-802 257-7383

Holes: 21mm UNO

BOLTS: 19mm DIA. M164M-I GALV UNO

Steel GR: M270M-GR345 UNO

Paint: PER SPECS (GREEN) UNO

Surface Prep: PER SPECS

Project:
DUMMERSTON BRIDGE
DUMMERSTON, VT

Date: 9-9-09
Job No.: 340 1442(28)
DWN. BY: EG
Checked: MRS
Sheet No.: 10