



2 ANGLES A39

SHOP NOTE:
TOE DIRECTION FAR SIDE

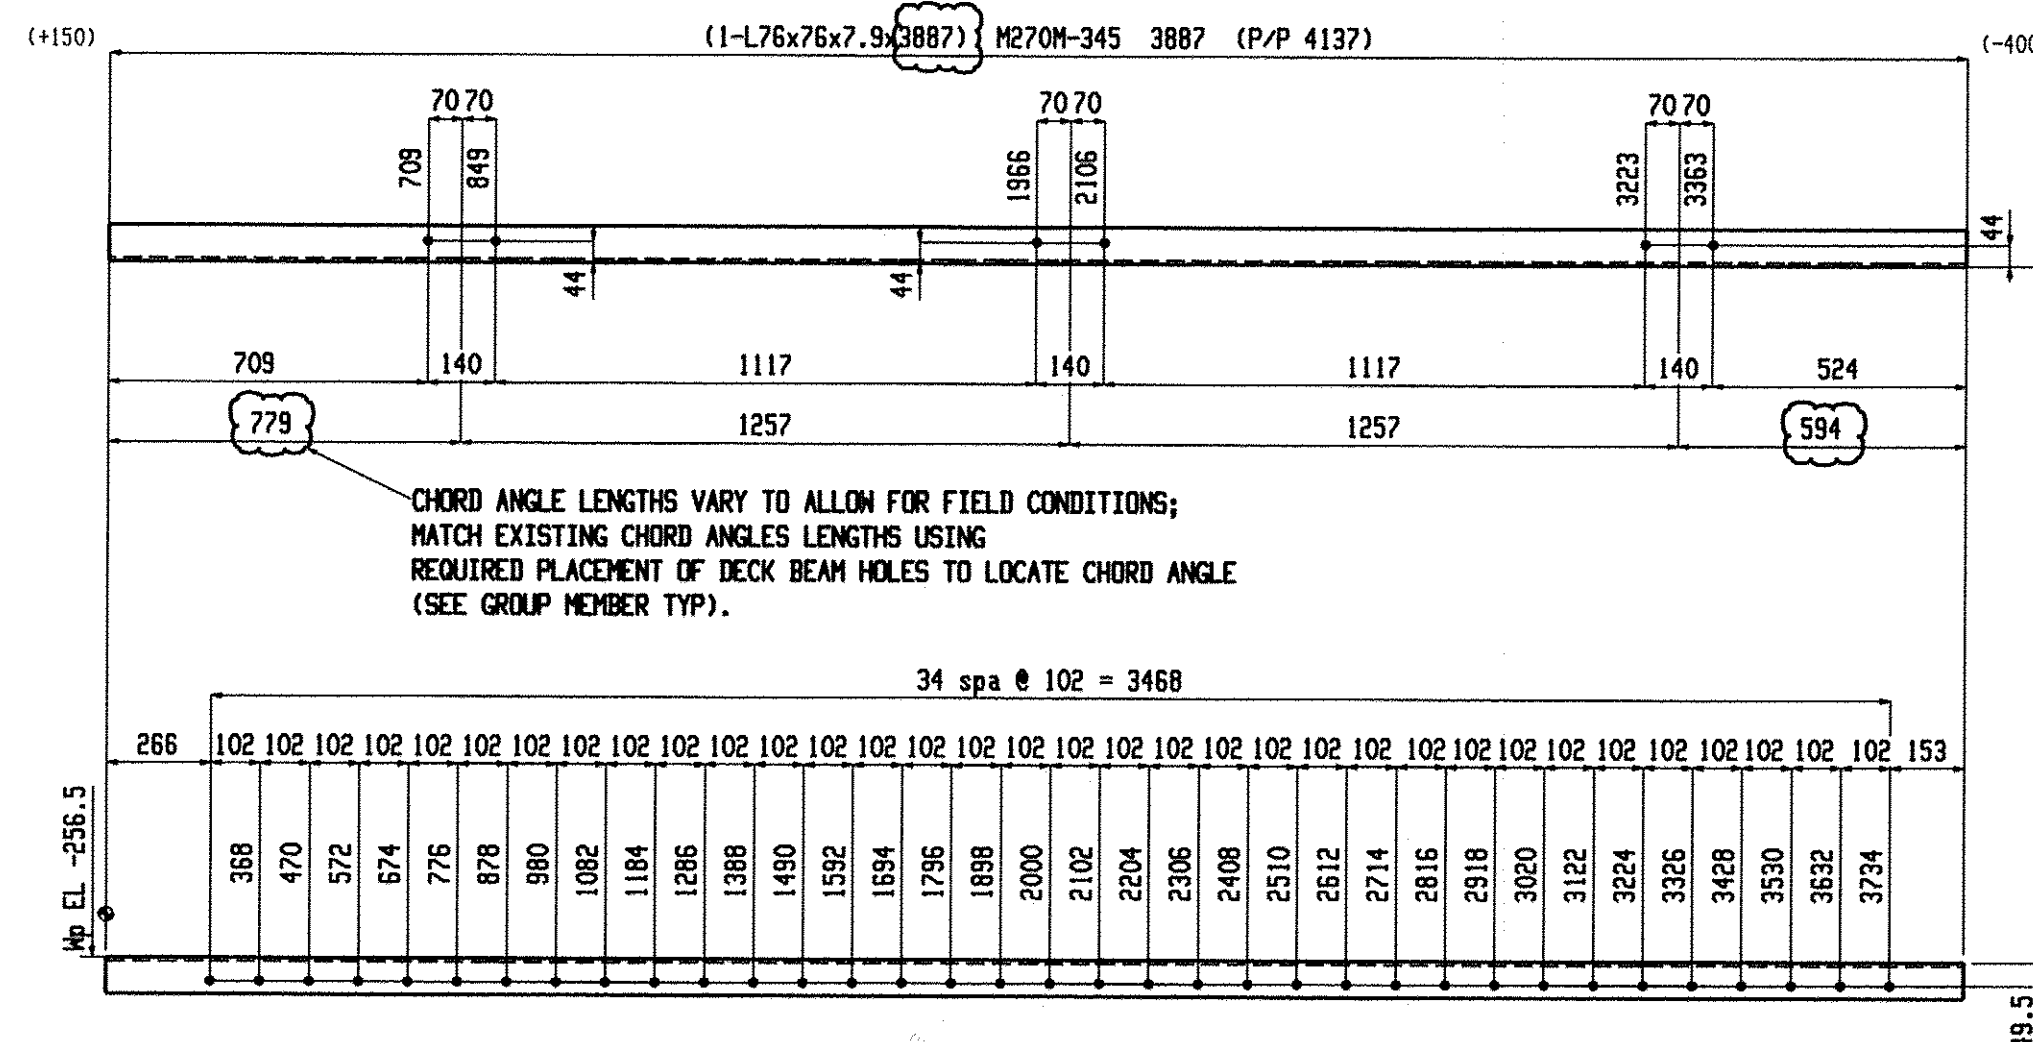


2 ANGLES A41

SHOP NOTE:
TOE DIRECTION FAR SIDE

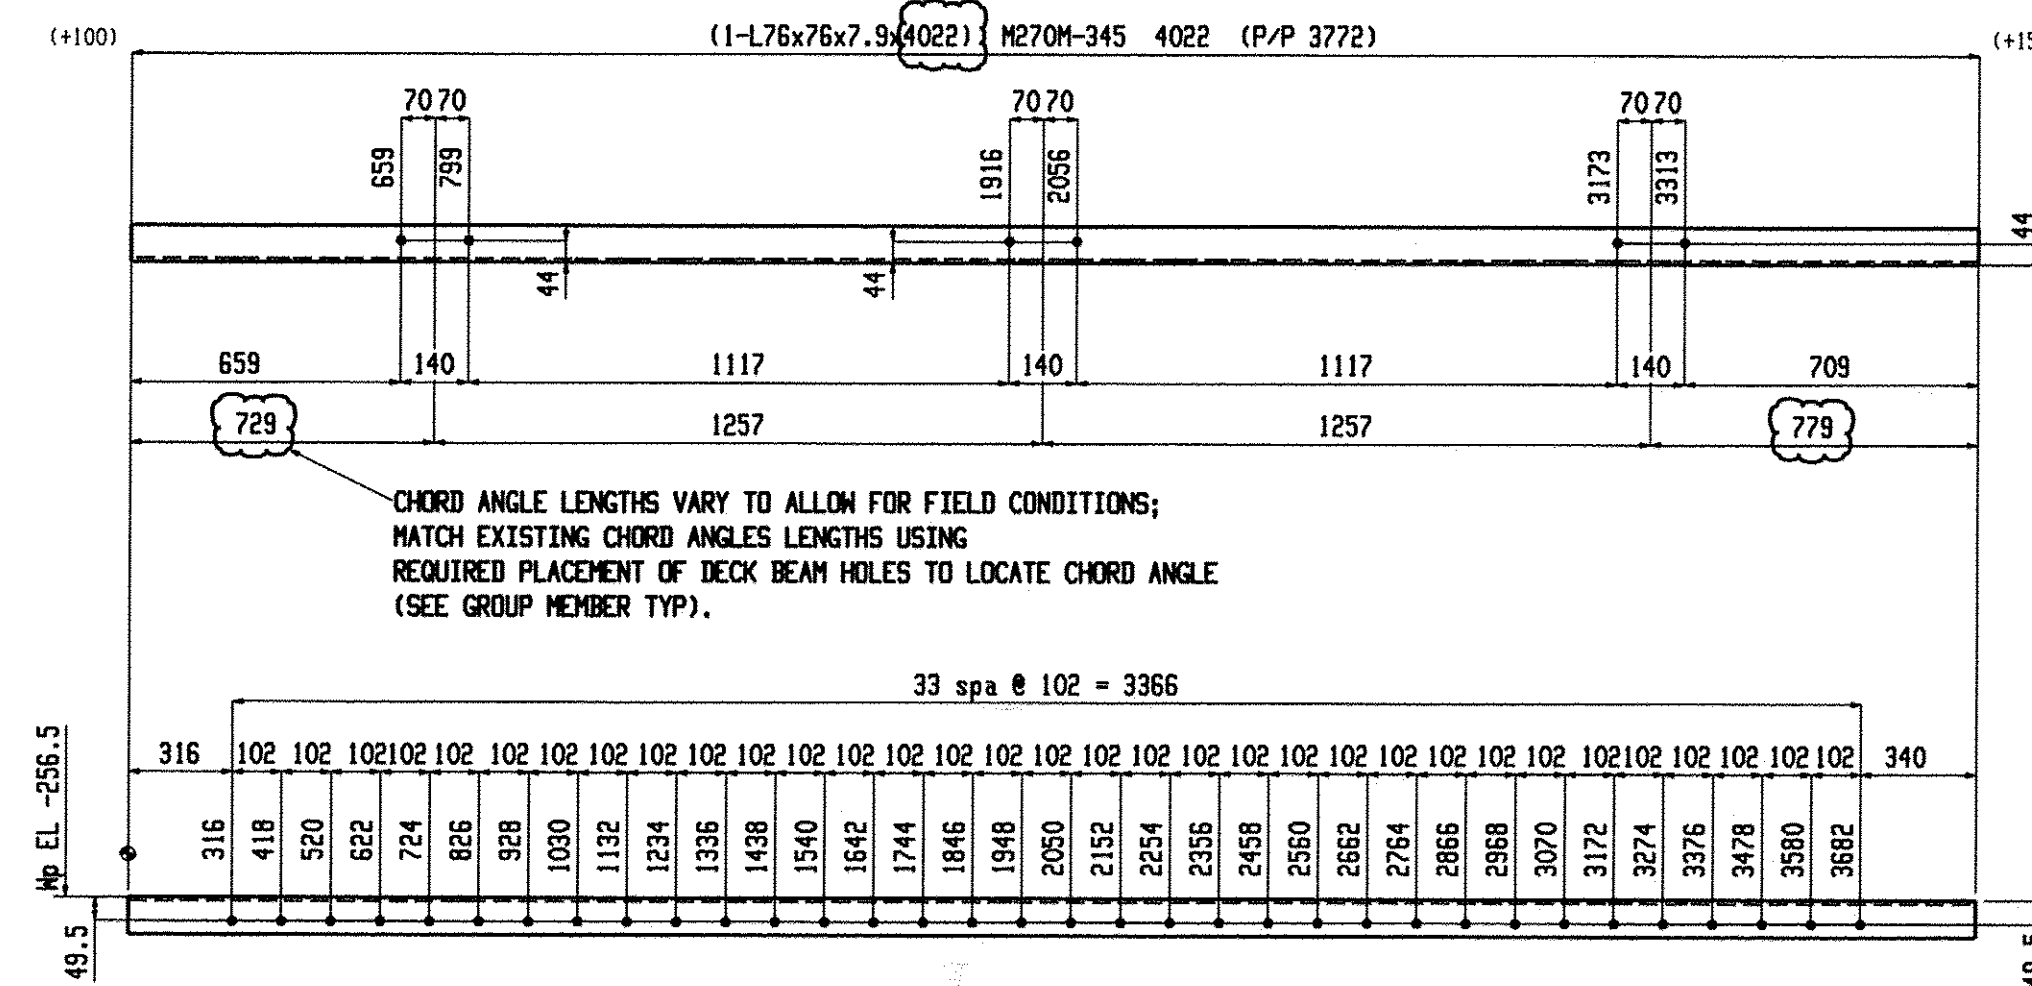

2 ANGLES A40

SHOP NOTE:
TOE DIRECTION FAR SIDE

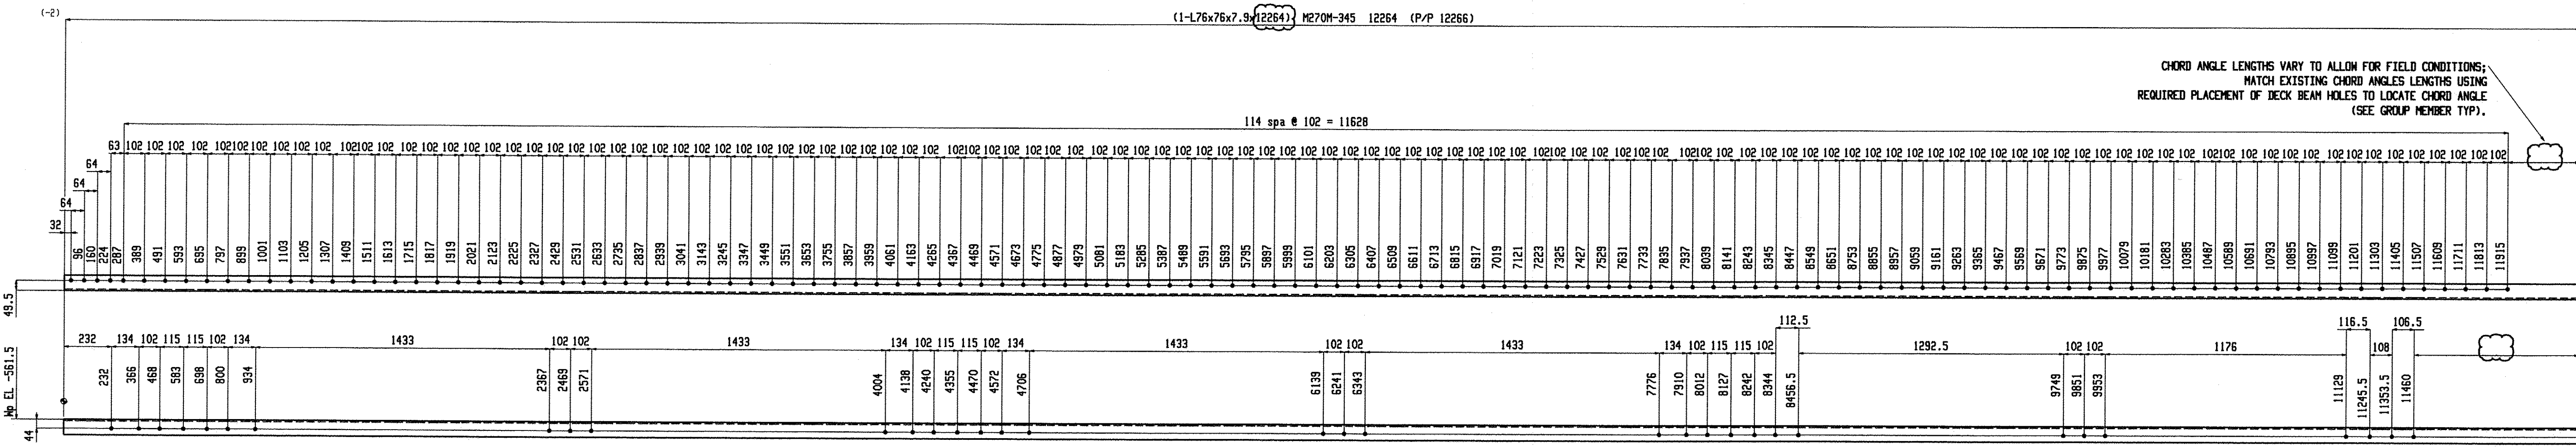

2 ANGLES A42

SHOP NOTE:
TOE DIRECTION FAR SIDE

RECEIVED

CHKD BY: _____
NOV 17 2009
APPROVED BY: _____

NOTE: WORK THIS DRAWING WITH GROUP MEMBER GM10

BILL OF MATERIAL							BILL OF MATERIAL							BILL OF MATERIAL							
Qty	Piece		Seq	Seq	Adv	Steel	Qty	Piece		Seq	Seq	Adv	Steel	Qty	Piece		Seq	Seq	Adv	Steel	
Tot.	Mark	Description	Length	NO.	Qty	ABM #	Grade	Remarks	Tot.	Mark	Description	Length	NO.	Qty	Mark	Description	Length	NO.	Qty	Mark	Description
2	A39	ANGLE		1	2				2	A41	ANGLE		1	2							
2	A39	L76x76x7.9	4022			M270M-345			2	A41	L76x76x7.9	3887			M270M-345						
2	A40	ANGLE		1	2				2	A42	ANGLE		1	2							
2	A40	L76x76x7.9	4022			M270M-345			2	A42	L76x76x7.9	12264			M270M-345						

Total weight : 435

Renaud Bros. Inc.
283 Fort Bridgeman Rd. #2
Vernon, VT. 05354
Phone 1-802 257-7383

Holes: 21mm UNO
BOLTS: 19mm DIA. M164M-I GALV UNO
Steel GR: M270M-GR345 UNO
Paint: PER SPECS (GREEN) UNO
Surface Prep: PER SPECS

Project: **DUMMERSTON BRIDGE**
DUMMERSTON, VT

Date: 9-9-09
Job No. BHO 1442(28)
Sheet No. 14

Rev. No. _____
Date: _____
DWN. BY: EG
Checked: MRS