


EROSION CONTROL LEGEND	
	FILTER CURTAIN
	SILT FENCE
	HAY BALES
	STONE FILL TYPE I
	STONE FILL TYPE IV

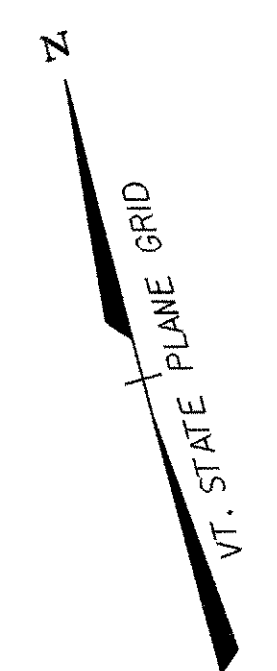

BRIDGE RAILING - HEAVY DUTY STEEL BEAM  
TYPE D WITH BOX BEAM HAND RAIL (MOD)  
STA. 3+019.5 - 3+044.5 LT  
STA. 3+019.7 - 3+044.7 RT


HEAVY DUTY STEEL BEAM GUARDRAIL  
(WEATHERING) W/ WOOD POSTS  
STA. 3+016.1 - 3+019.5 LT  
STA. 3+016.5 - 3+019.7 RT  
STA. 3+044.5 - 3+048.7 LT  
STA. 3+044.7 - 3+058.6 RT

ANCHOR FOR STEEL BEAM GUARD RAIL  
STA. 3+017.6 LT  
STA. 3+017.8 RT  
STA. 3+047.5 LT  
STA. 3+056.8 RT

REMOVE SIGNS  
STA. 3+016 LT AND RT

CONSTRUCT SPECIAL 1000 x 3528 ACCESS RAMP (SEE SHEET 20 FOR DETAILS)  
STA. 3+015.0 RT


CONSTRUCT SPECIAL DITCH WITH STONE FILL TYPE I  
STA. 3+000.0 - 3+020.0 RT

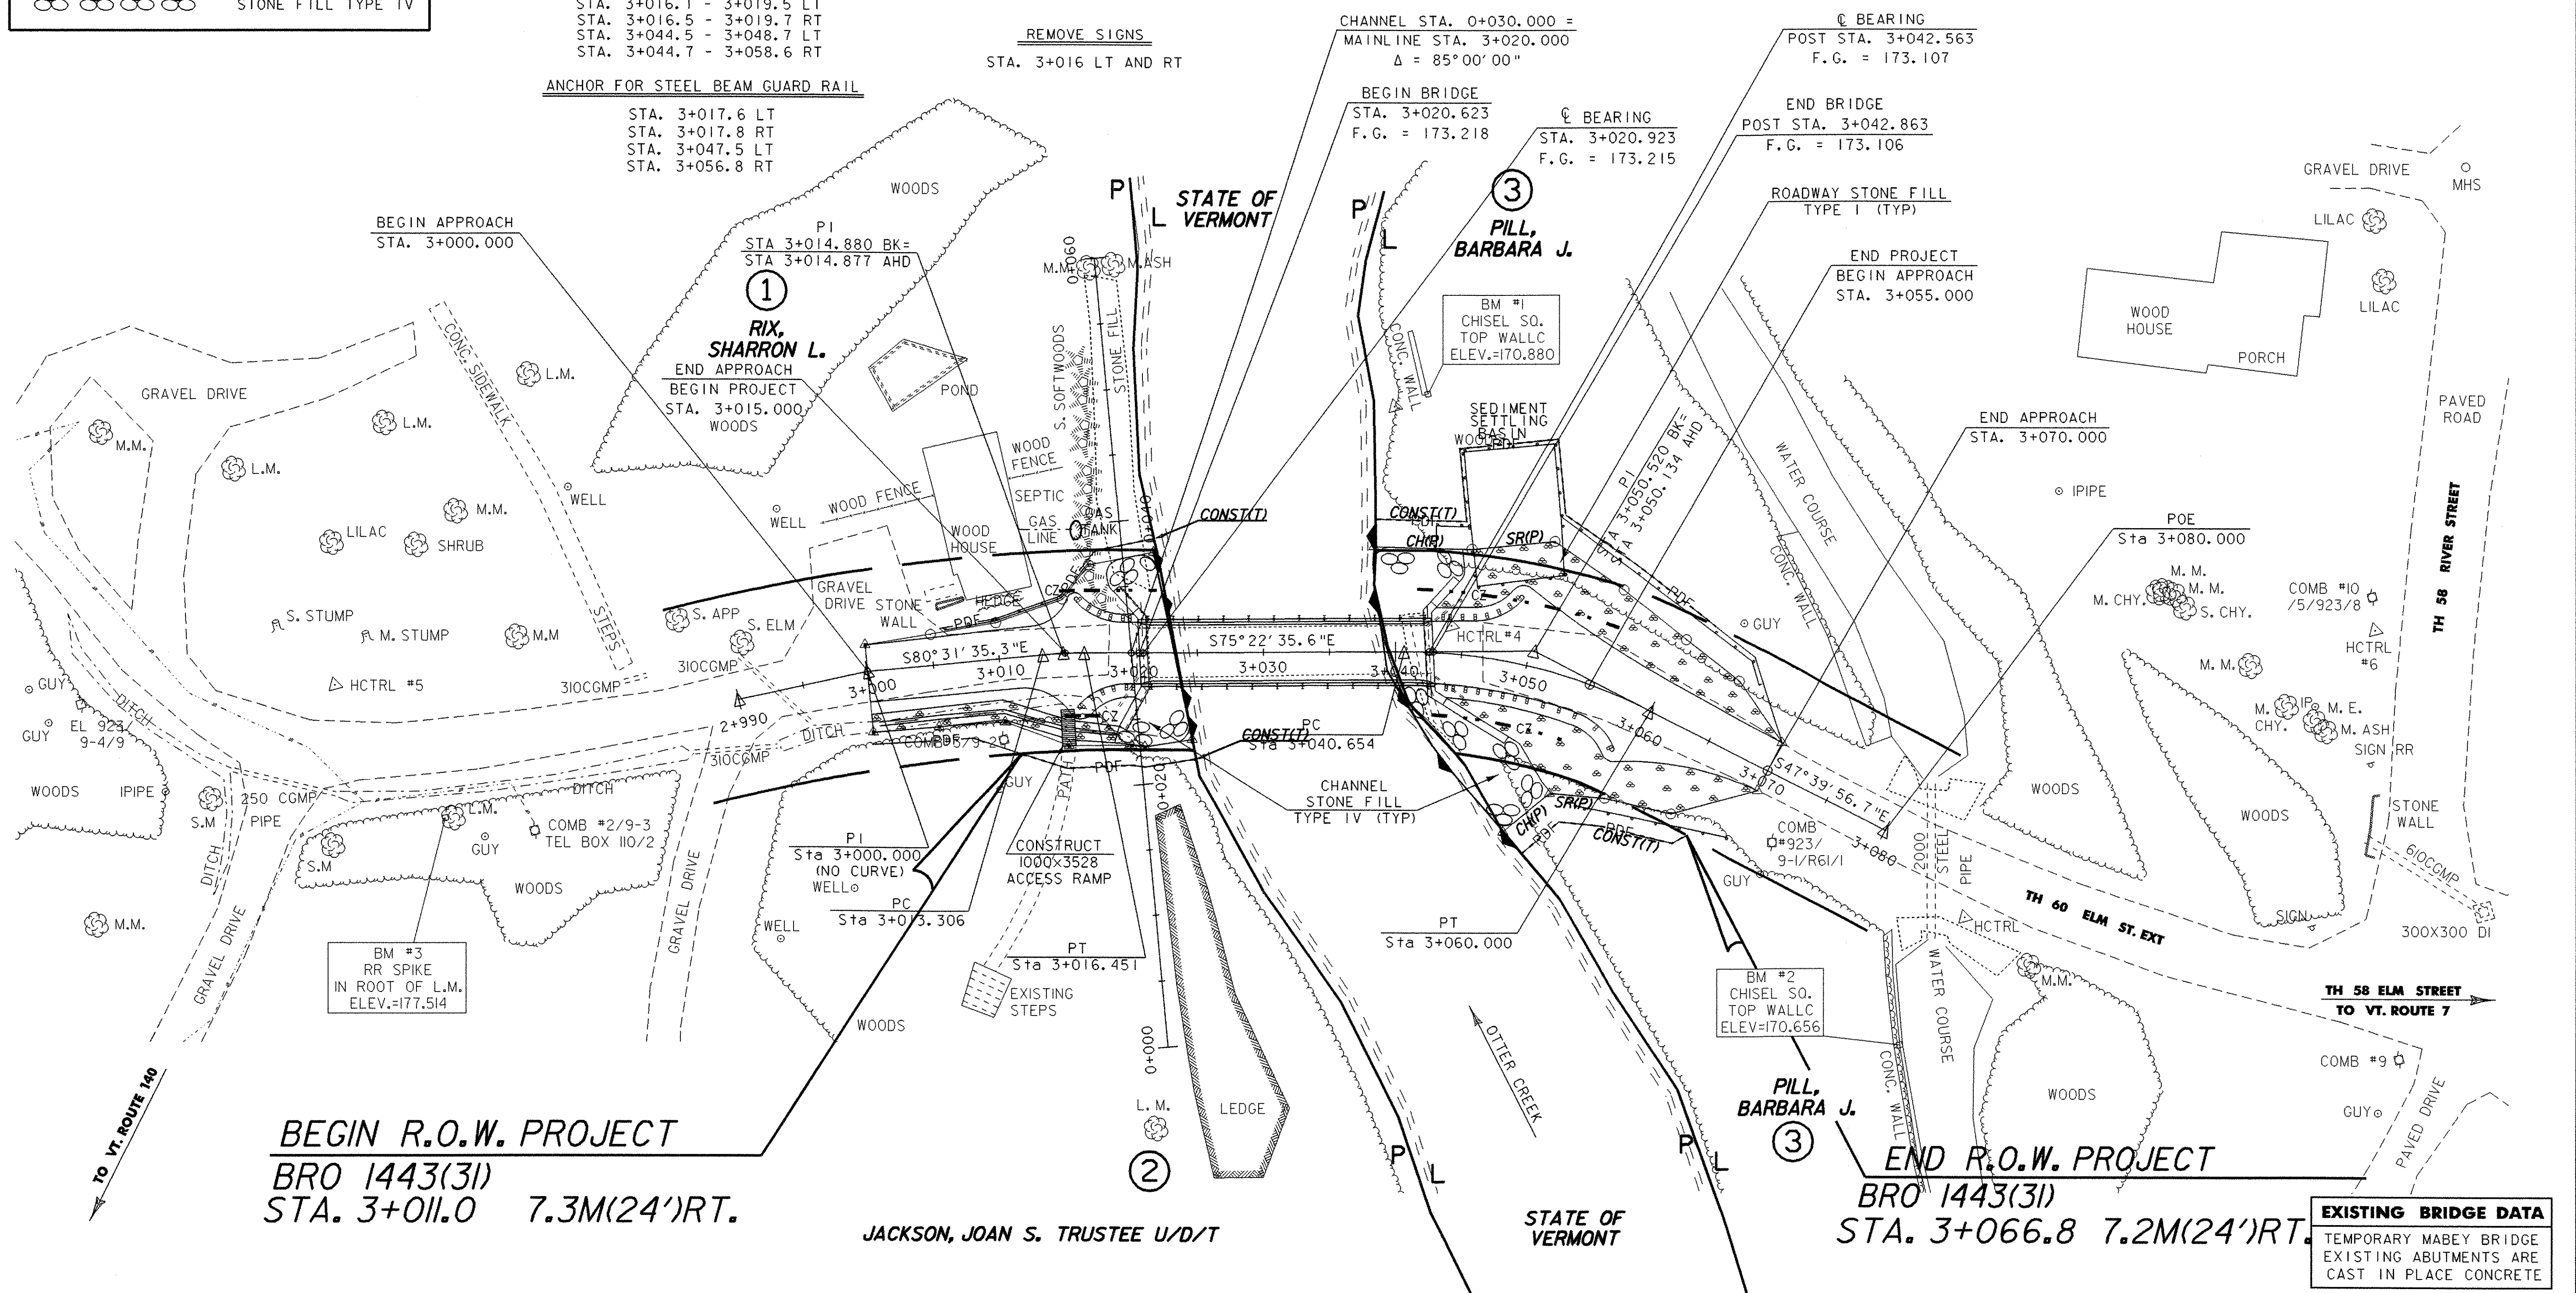

**BEGIN R.O.W. PROJECT**  
BRO 1443(3)  
STA. 3+011.0 7.3M(24')RT.

**END R.O.W. PROJECT**  
BRO 1443(3)  
STA. 3+066.8 7.2M(24')RT.

LINES SHOWN ON THIS PLAN AS EXISTING PROPERTY LINES P/L ARE BELIEVED TO BE ACCURATE BUT SHOULD NOT BE RELIED UPON FOR PURPOSES UNRELATED TO THE TOWN OF WALLINGFORD'S ACQUISITION OF LAND AND RIGHTS FOR THIS PROJECT.

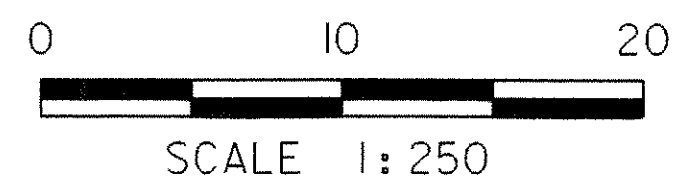

**FOR R.O.W. USE ONLY**

SHEET NAME: PLAN SHEET	
PROJECT NAME: WALLINGFORD	HIGHWAY NO.: TH 60
PROJECT NUMBER: BRO 1443(3)	BRIDGE NO.: 50
	OVER: OTTER CREEK
FILE NAME: /PW/94j084/sj084bdr.dgn	PLOT DATE: 24-OCT-2005
PROJECT MANAGER: R. WHITCOMB	DRAWN BY: J. GILMORE
DESIGNED BY: K. UPMAL	IPARM NAME: sj084pl1
BF R. O. W. SHEET 7 OF 7 SHEETS	SHEET 7 OF 38