


MAINLINE PROFILE

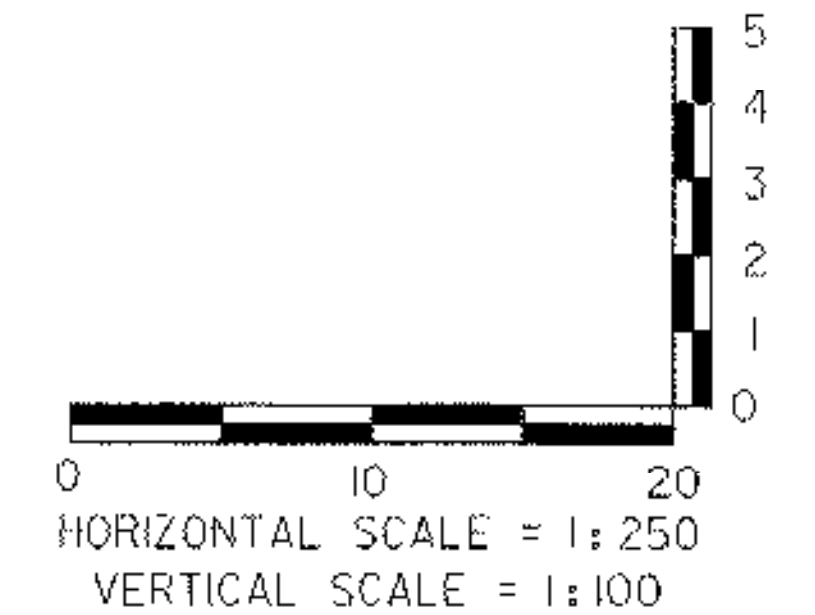

THE GRADES SHOWN TO TWO PLACES ARE THE ORIGINAL GROUND ELEVATIONS ALONG THE PROPOSED ALIGNMENT. THE GRADES SHOWN TO THREE PLACES ARE THE PROPOSED GRADES FOR THE NEW ALIGNMENT.

| | | |
|-------------------------------------|------------------------|--|
| SHEET NAME: MAINLINE PROFILE | | |
| PROJECT NAME: WALLINGFORD | HIGHWAY NO.: TH 60 | |
| PROJECT NUMBER: BRO 1443(3I) | BRIDGE NO.: 50 | |
| | OVER: OTTER CREEK | |
| FILE NAME: /PW/94J084/sJ084xs.dgn | PLOT DATE: 24-OCT-2005 | |
| PROJECT MANAGER: R. WHITCOMB | DRAWN BY: K. UPMAL | |
| DESIGNED BY: K. UPMAL | IPARM NAME: sJ084mp.1 | |
| BRIDGE SHEET NUMBER: | SHEET 10 OF 38 | |