

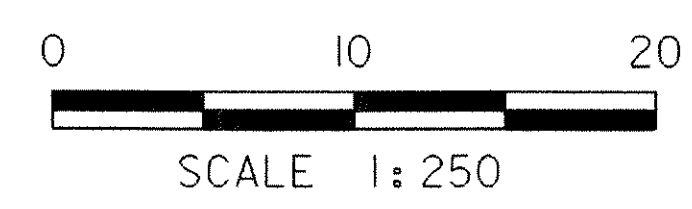
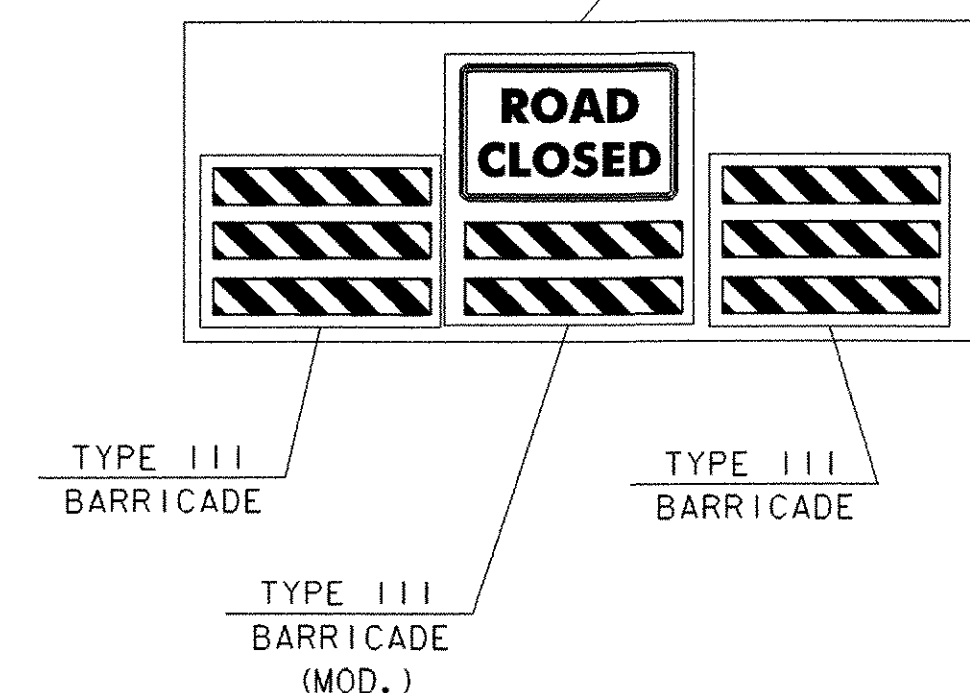
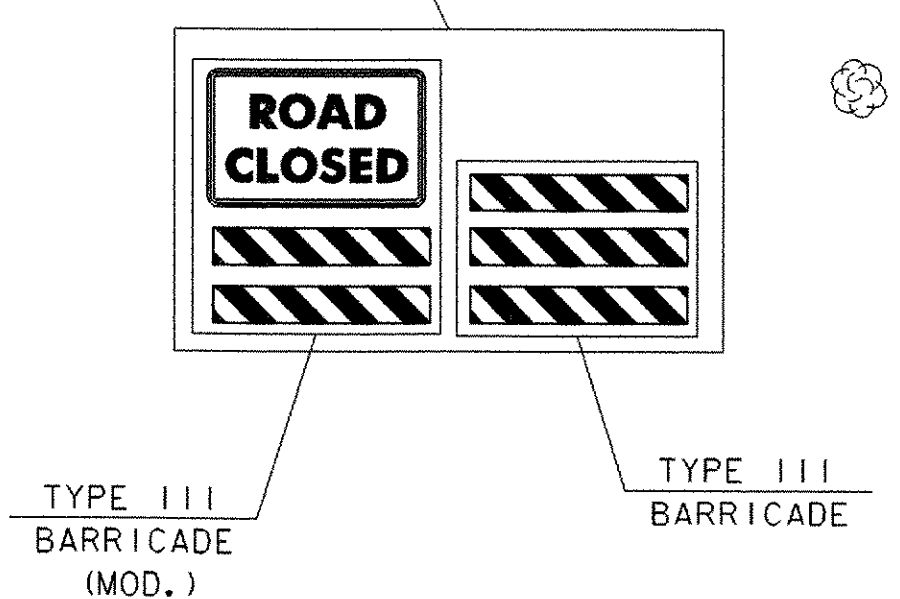
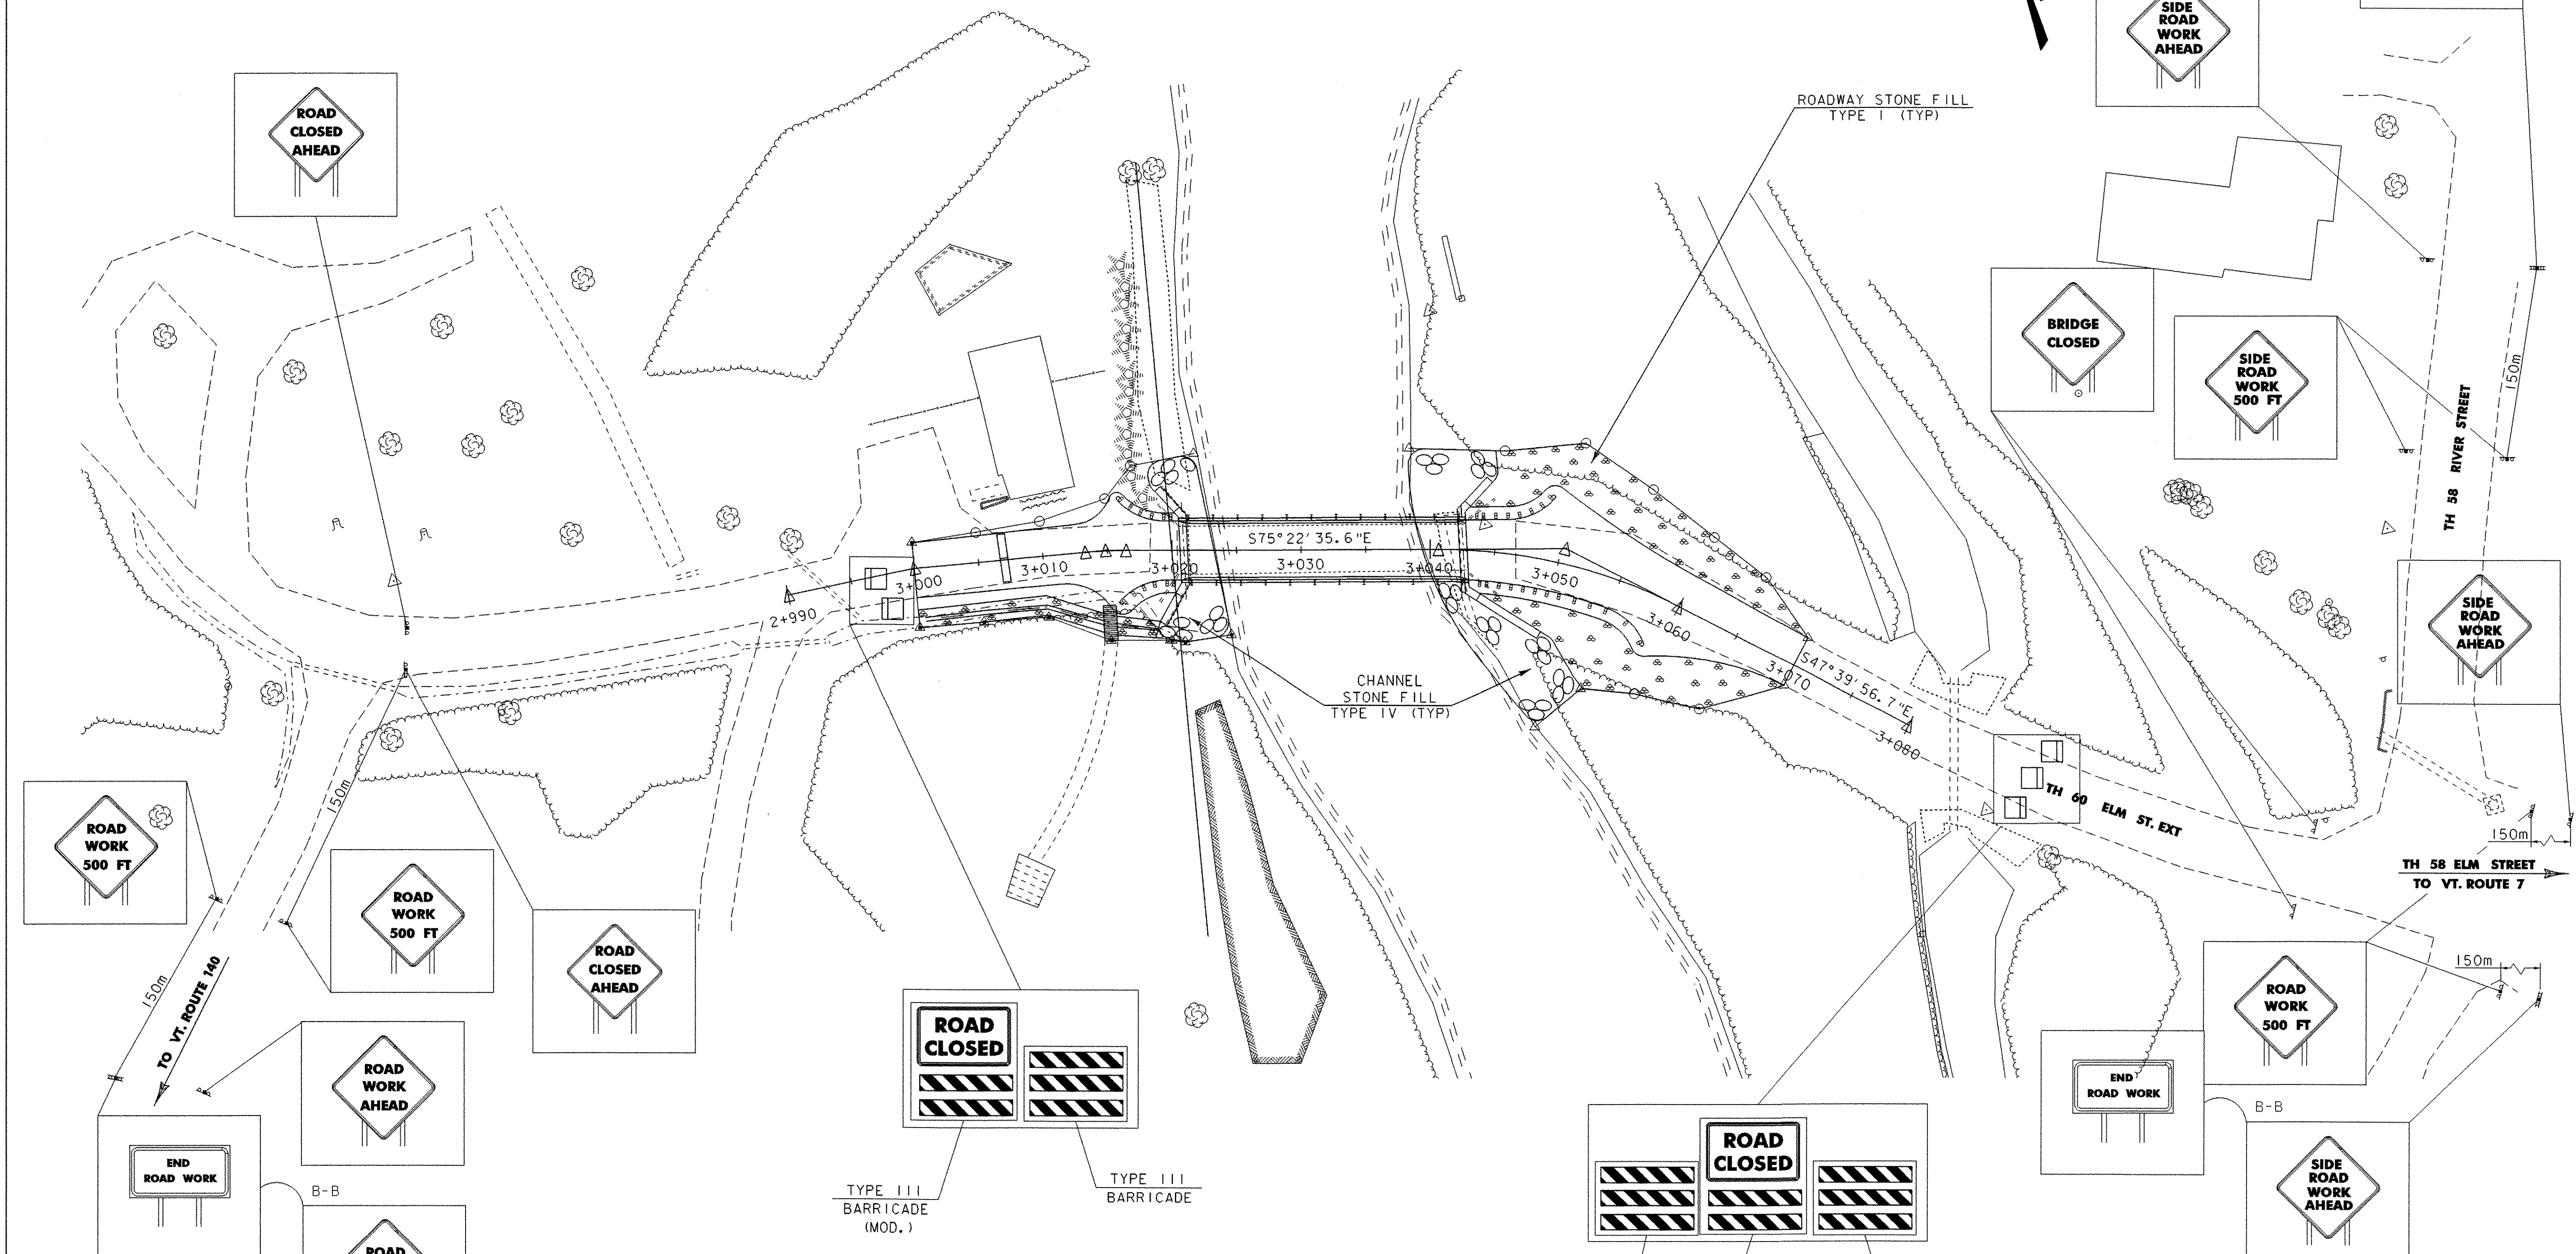
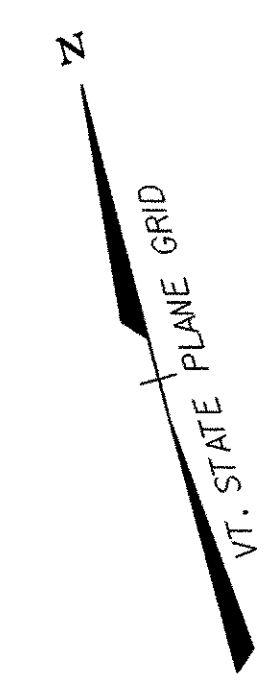


LEGEND

 TYPE III BARRICADES
 TEMPORARY TRAFFIC BARRIER
 B-B BACK TO BACK
 NOTE: ALL SIGNS SHALL BE ASTM TYPE III



TRAFFIC CONTROL/ CONSTRUCTION SIGNING SHEET			
SHEET NAME:			
PROJECT NAME:	WALLINGFORD	HIGHWAY NO.:	TH 60
PROJECT NUMBER:	BRO 1443(31)	BRIDGE NO.:	50
		OVER:	OTTER CREEK
FILE NAME:	/PW/94J084/sj084+cs.dgn	PLOT DATE:	24-OCT-2005
PROJECT MANAGER:	R. WHITCOMB	DRAWN BY:	J. GILMORE
DESIGNED BY:	K. UPMAL	IPARM NAME:	sj084+cs.1
BRIDGE SHEET NUMBER:		SHEET	II OF 38