


JACKSON, JOAN S. TRUSTEE U/D/T

STATE OF VERMONT

DATUM	
VERTICAL	NAVD 88
HORIZONTAL	NAD 83/92

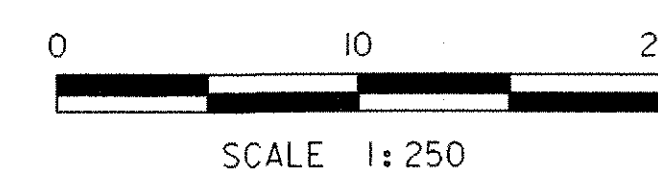

SHEET NAME: <b>FINAL CONDITIONS SITE PLAN</b>	
PROJECT NAME: <b>WALLINGFORD</b>	HIGHWAY NO.: TH 60
PROJECT NUMBER: <b>BRO 1443(31)</b>	BRIDGE NO.: 50
	OVER: OTTER CREEK
FILE NAME: /PW/94J084/sj084ec.dgn	PLOT DATE: 24-OCT-2005
PROJECT MANAGER: R. WHITCOMB	DRAWN BY: STRI
DESIGNED BY: STRI	IPARM NAME: sj084ec4.1
BRIDGE SHEET NUMBER:	SHEET 18 OF 38