




ABUTMENT #2 PLAN
SCALE: 1:40

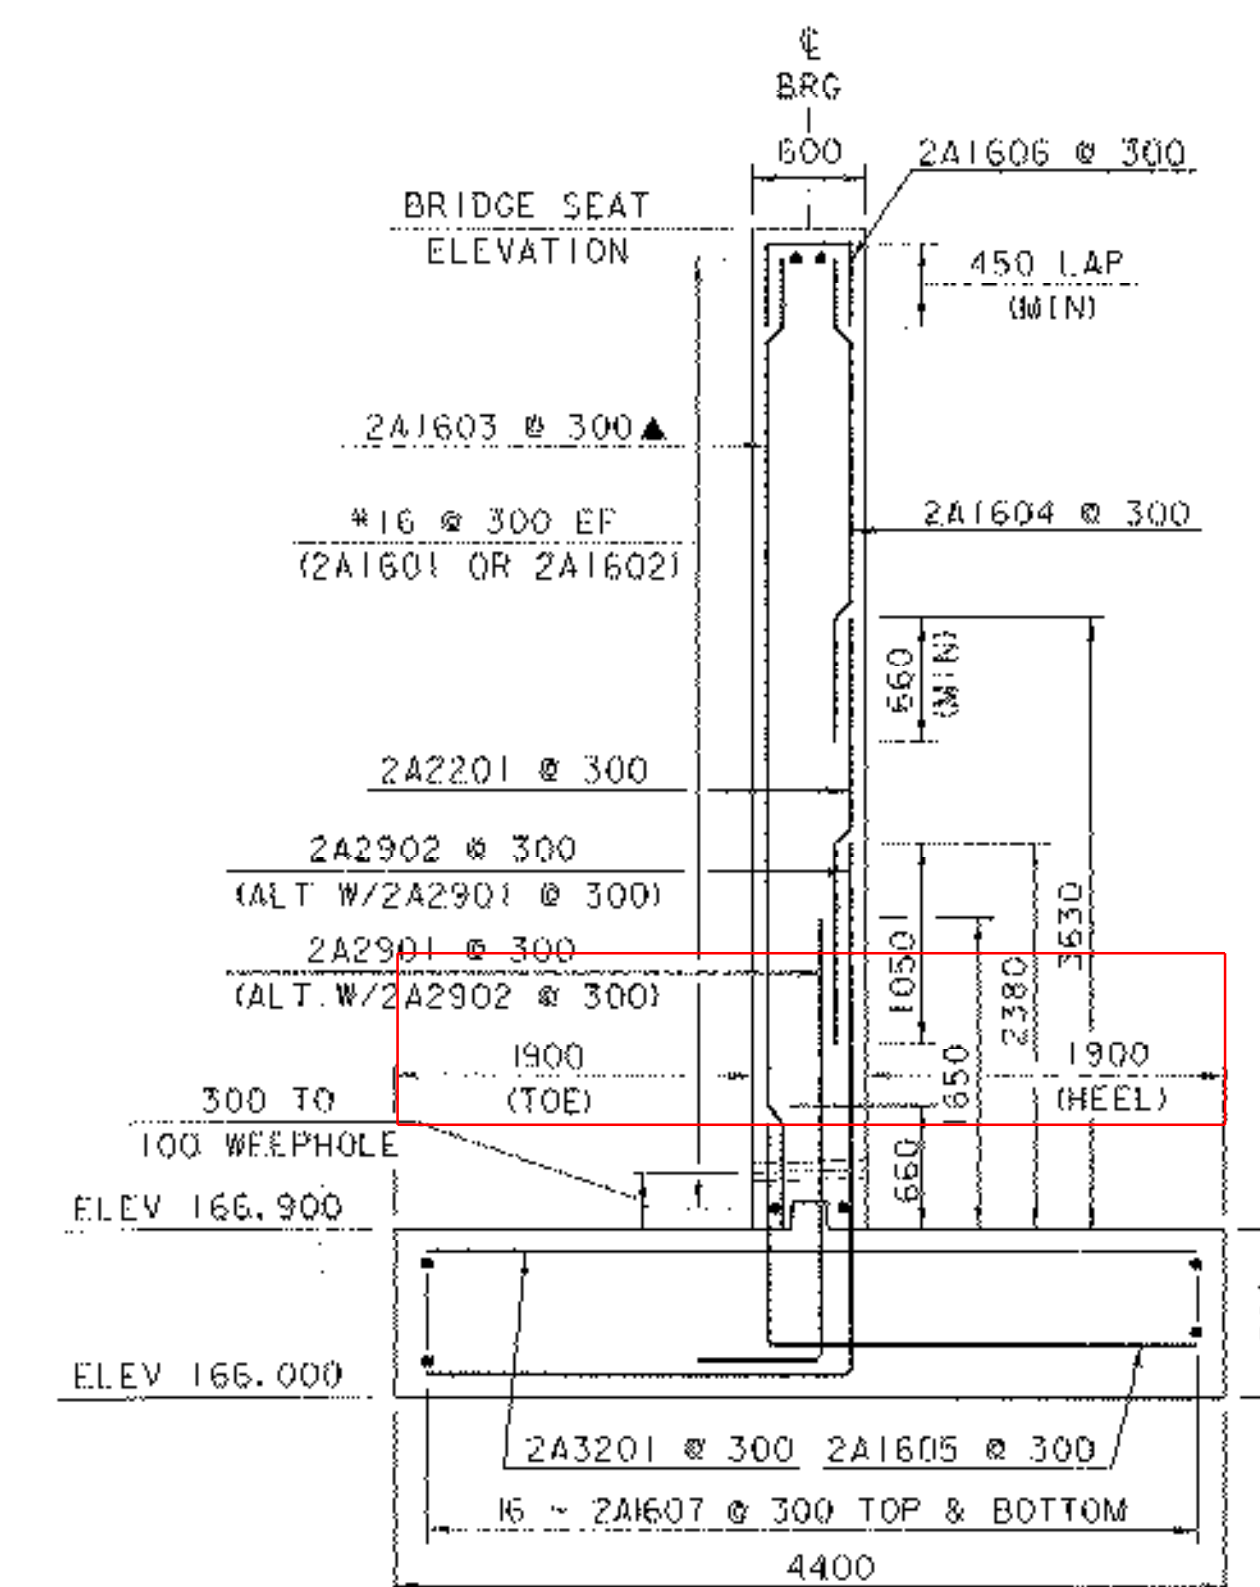

ABUTMENT #2 TYPICAL
SCALE: 1:40

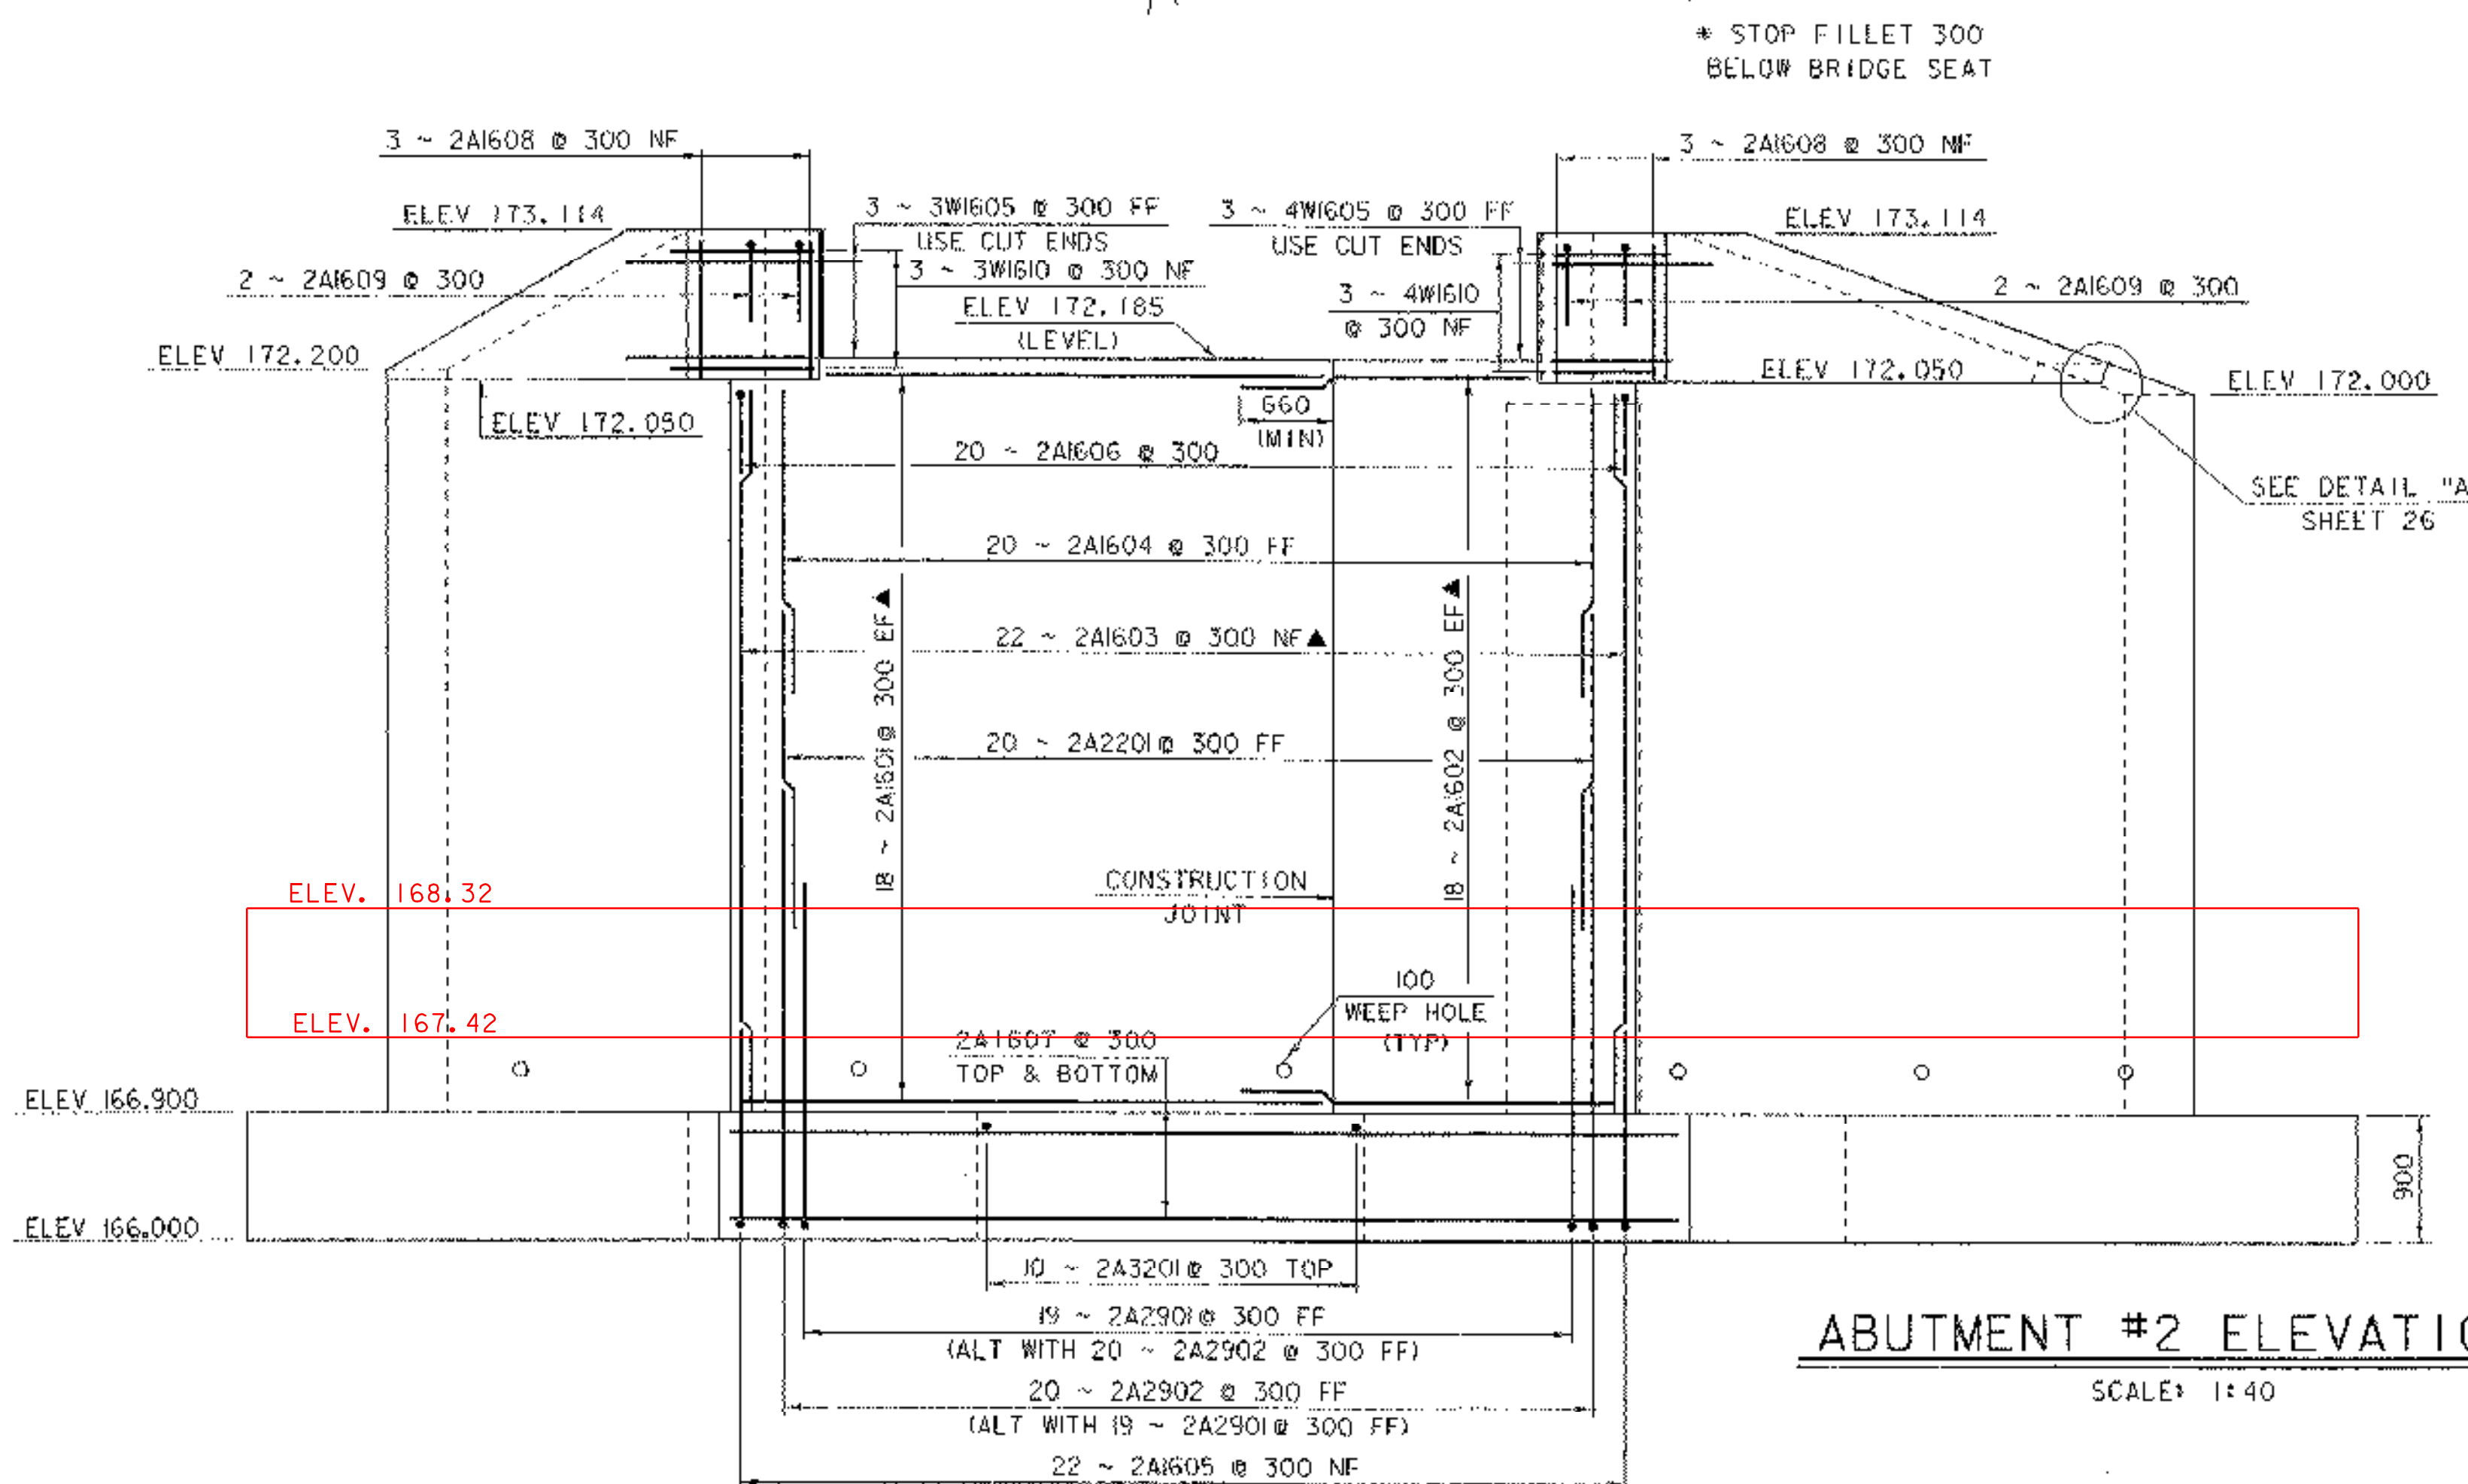

ABUTMENT #2 ELEVATION
SCALE: 1:40

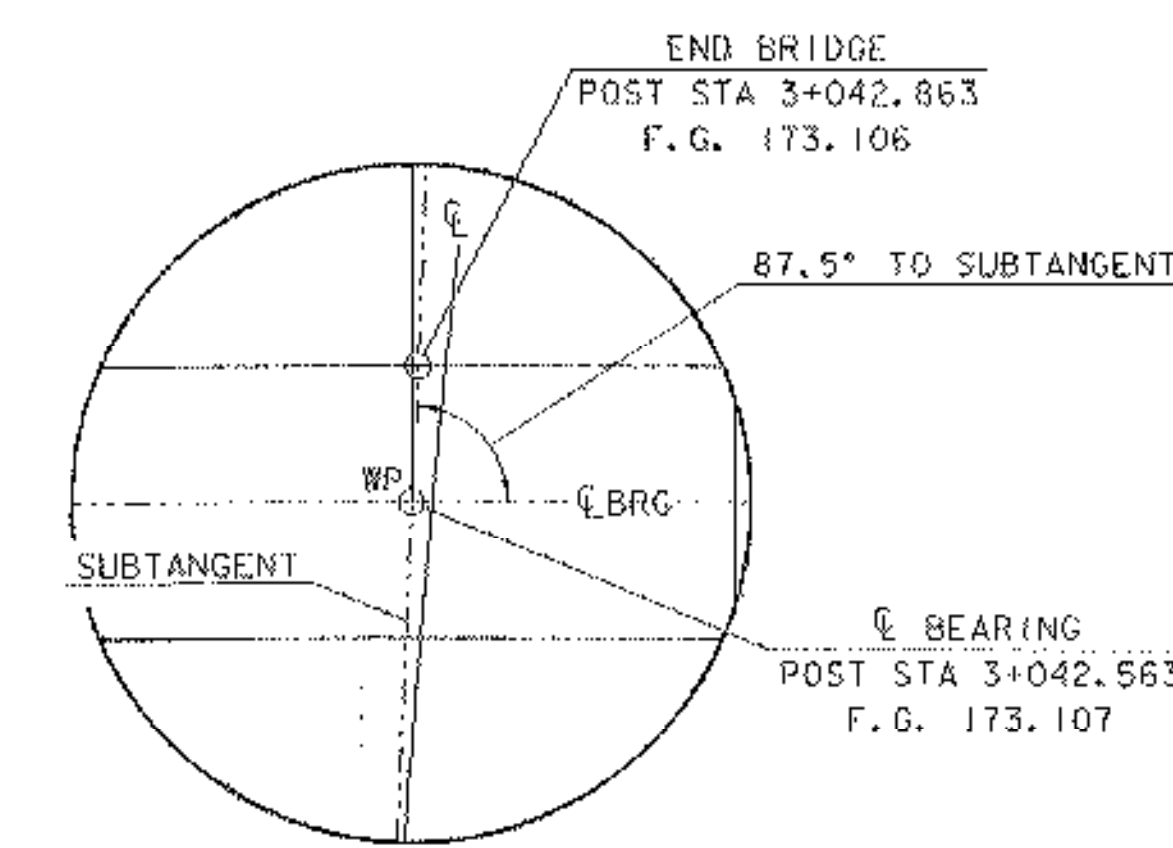

DETAIL "B"

- NOTES:**
1. NF = NEAR FACE
 2. FF = FAR FACE
 3. EF = EACH FACE
 4. ▲ = CUT TO FIT IN FIELD
 5. 80 CLEAR UNLESS OTHERWISE SPECIFIED ON THE PLANS
 6. 3000 MAX WEEPHOLE SPACING
 7. LAPS 660 UNLESS NOTED OTHERWISE
 8. SEE SHEET 28 FOR CORNER DETAILS.

SHEET NAME: ABUTMENT NUMBER 2 DETAILS		
PROJECT NAME: WALLINGFORD	BRIDGE NO.: 50	HIGHWAY NO.: TH 60
PROJECT NUMBER: BRO 1443(31)	OVER: OTTER CREEK	
FILE NAME: /PW/941084/sj084sub.dgn	PLOT DATE: 24-OCT-2005	
PROJECT MANAGER: R. WHITCOMB	DRAWN BY: J. GILMORE	
DESIGNED BY: K. UPMAL	IPARM NAME: sj084nb2.1	
BRIDGE SHEET NUMBER:	SHEET 27 OF 38	