
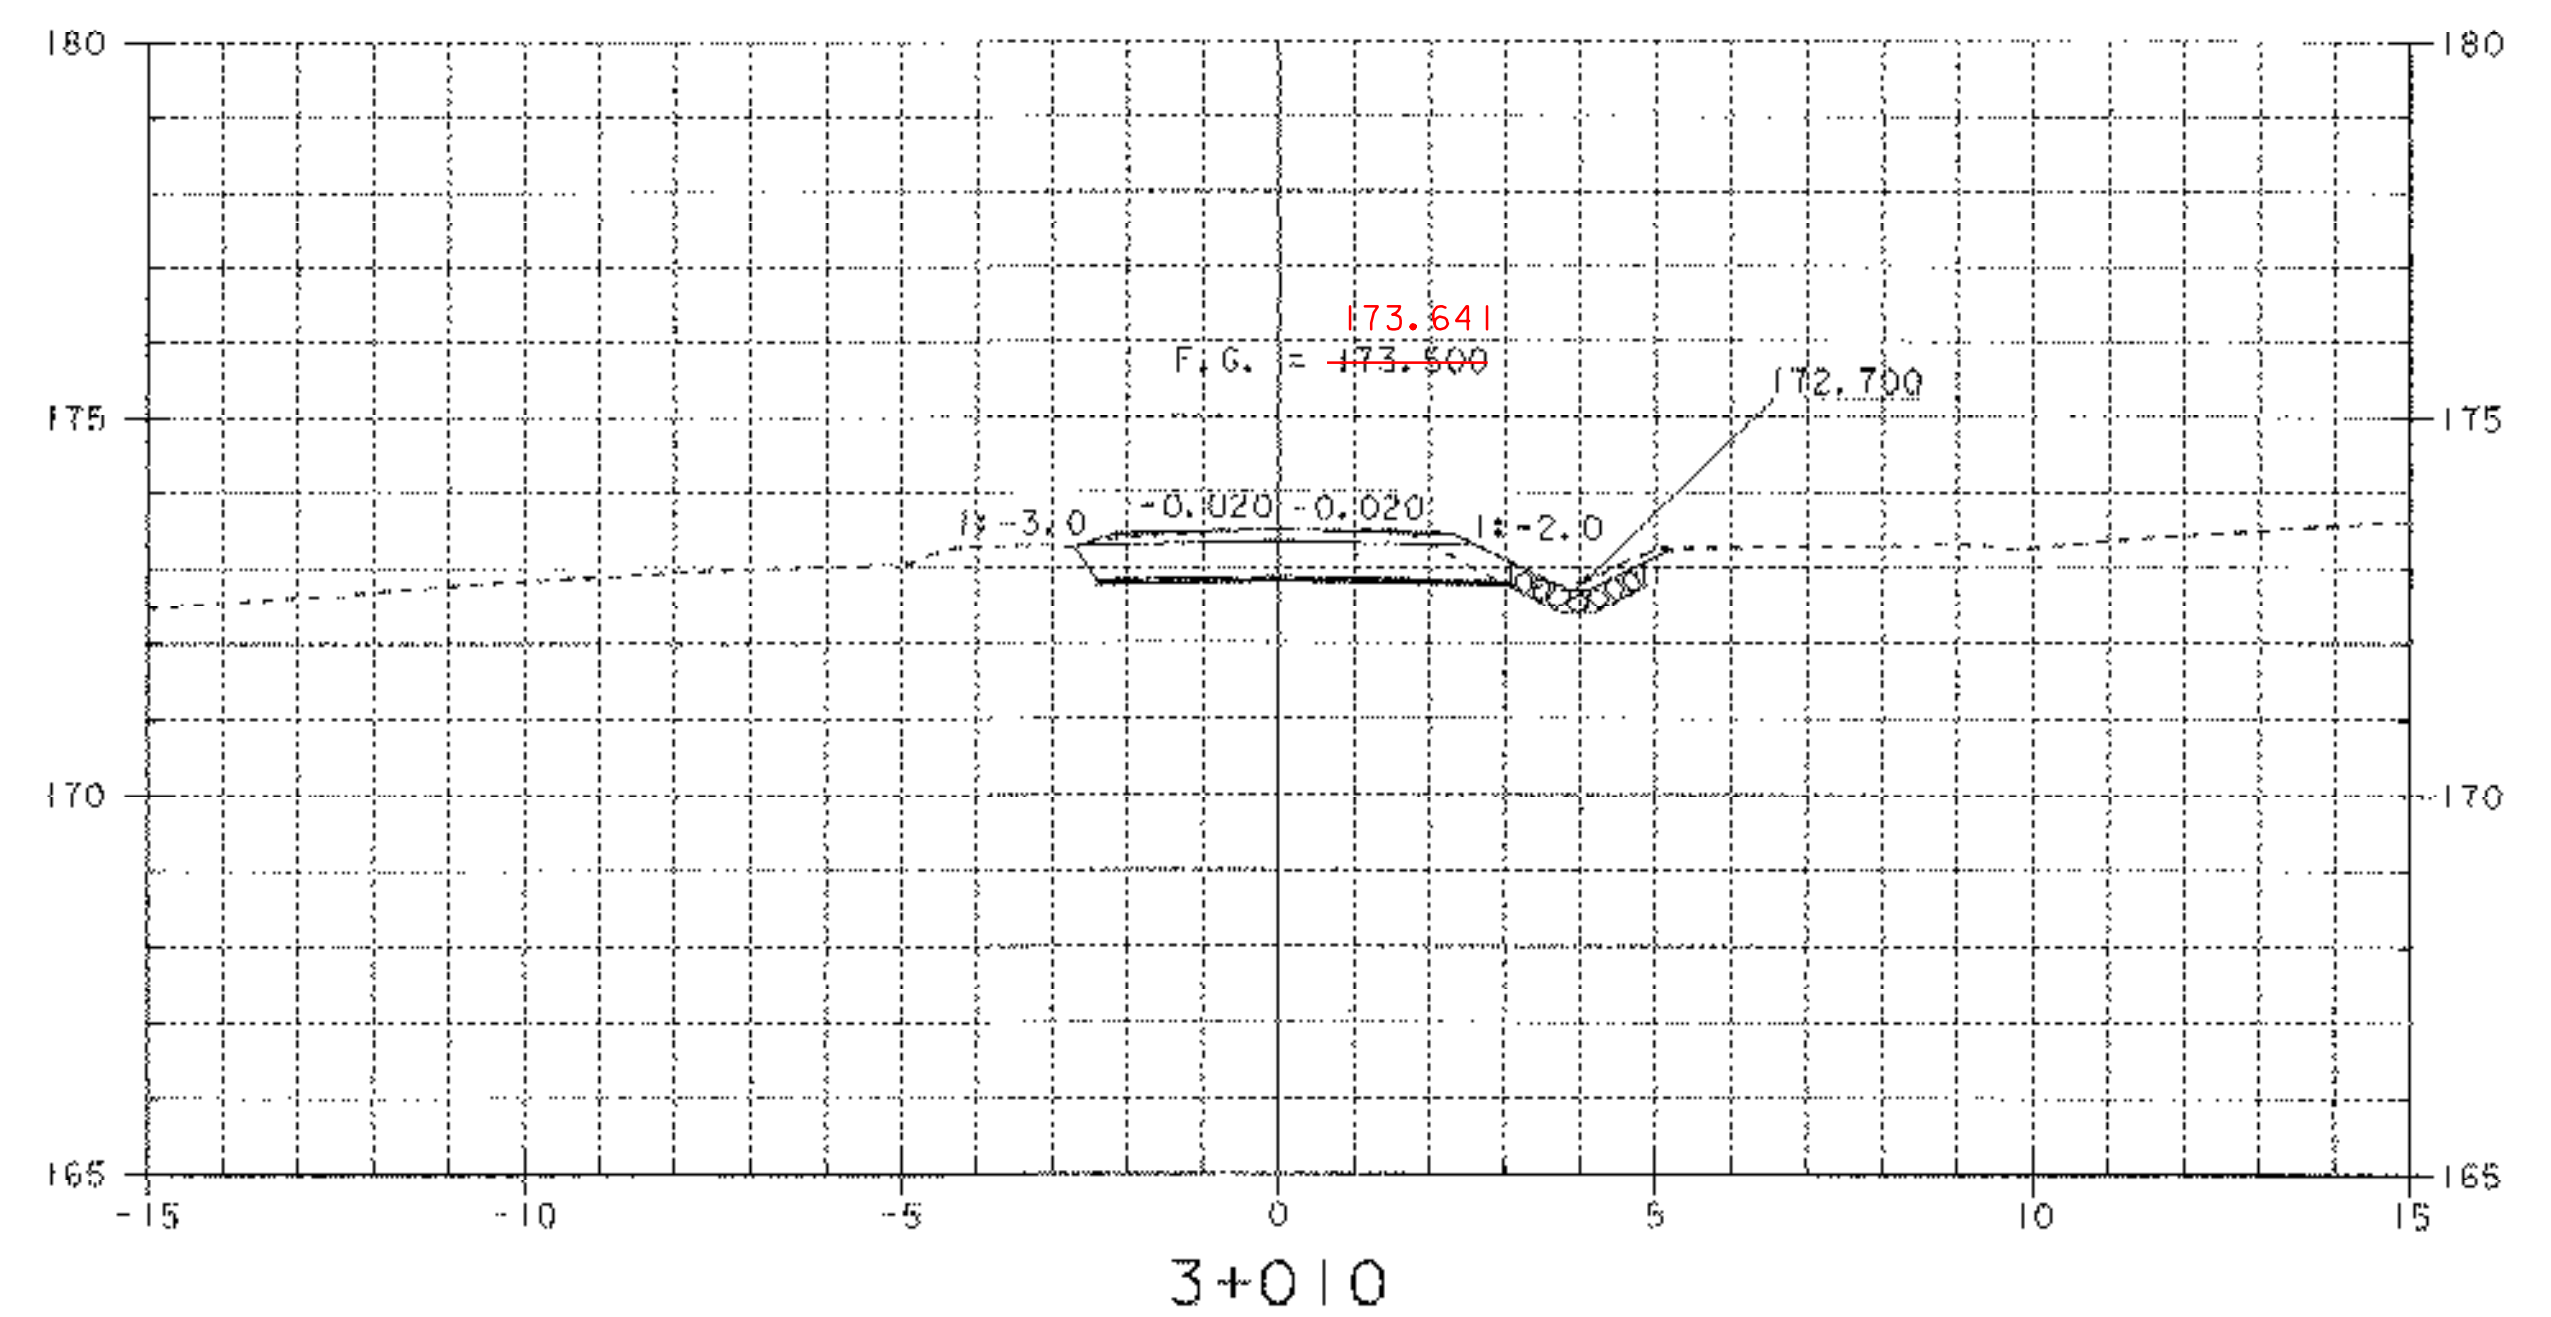
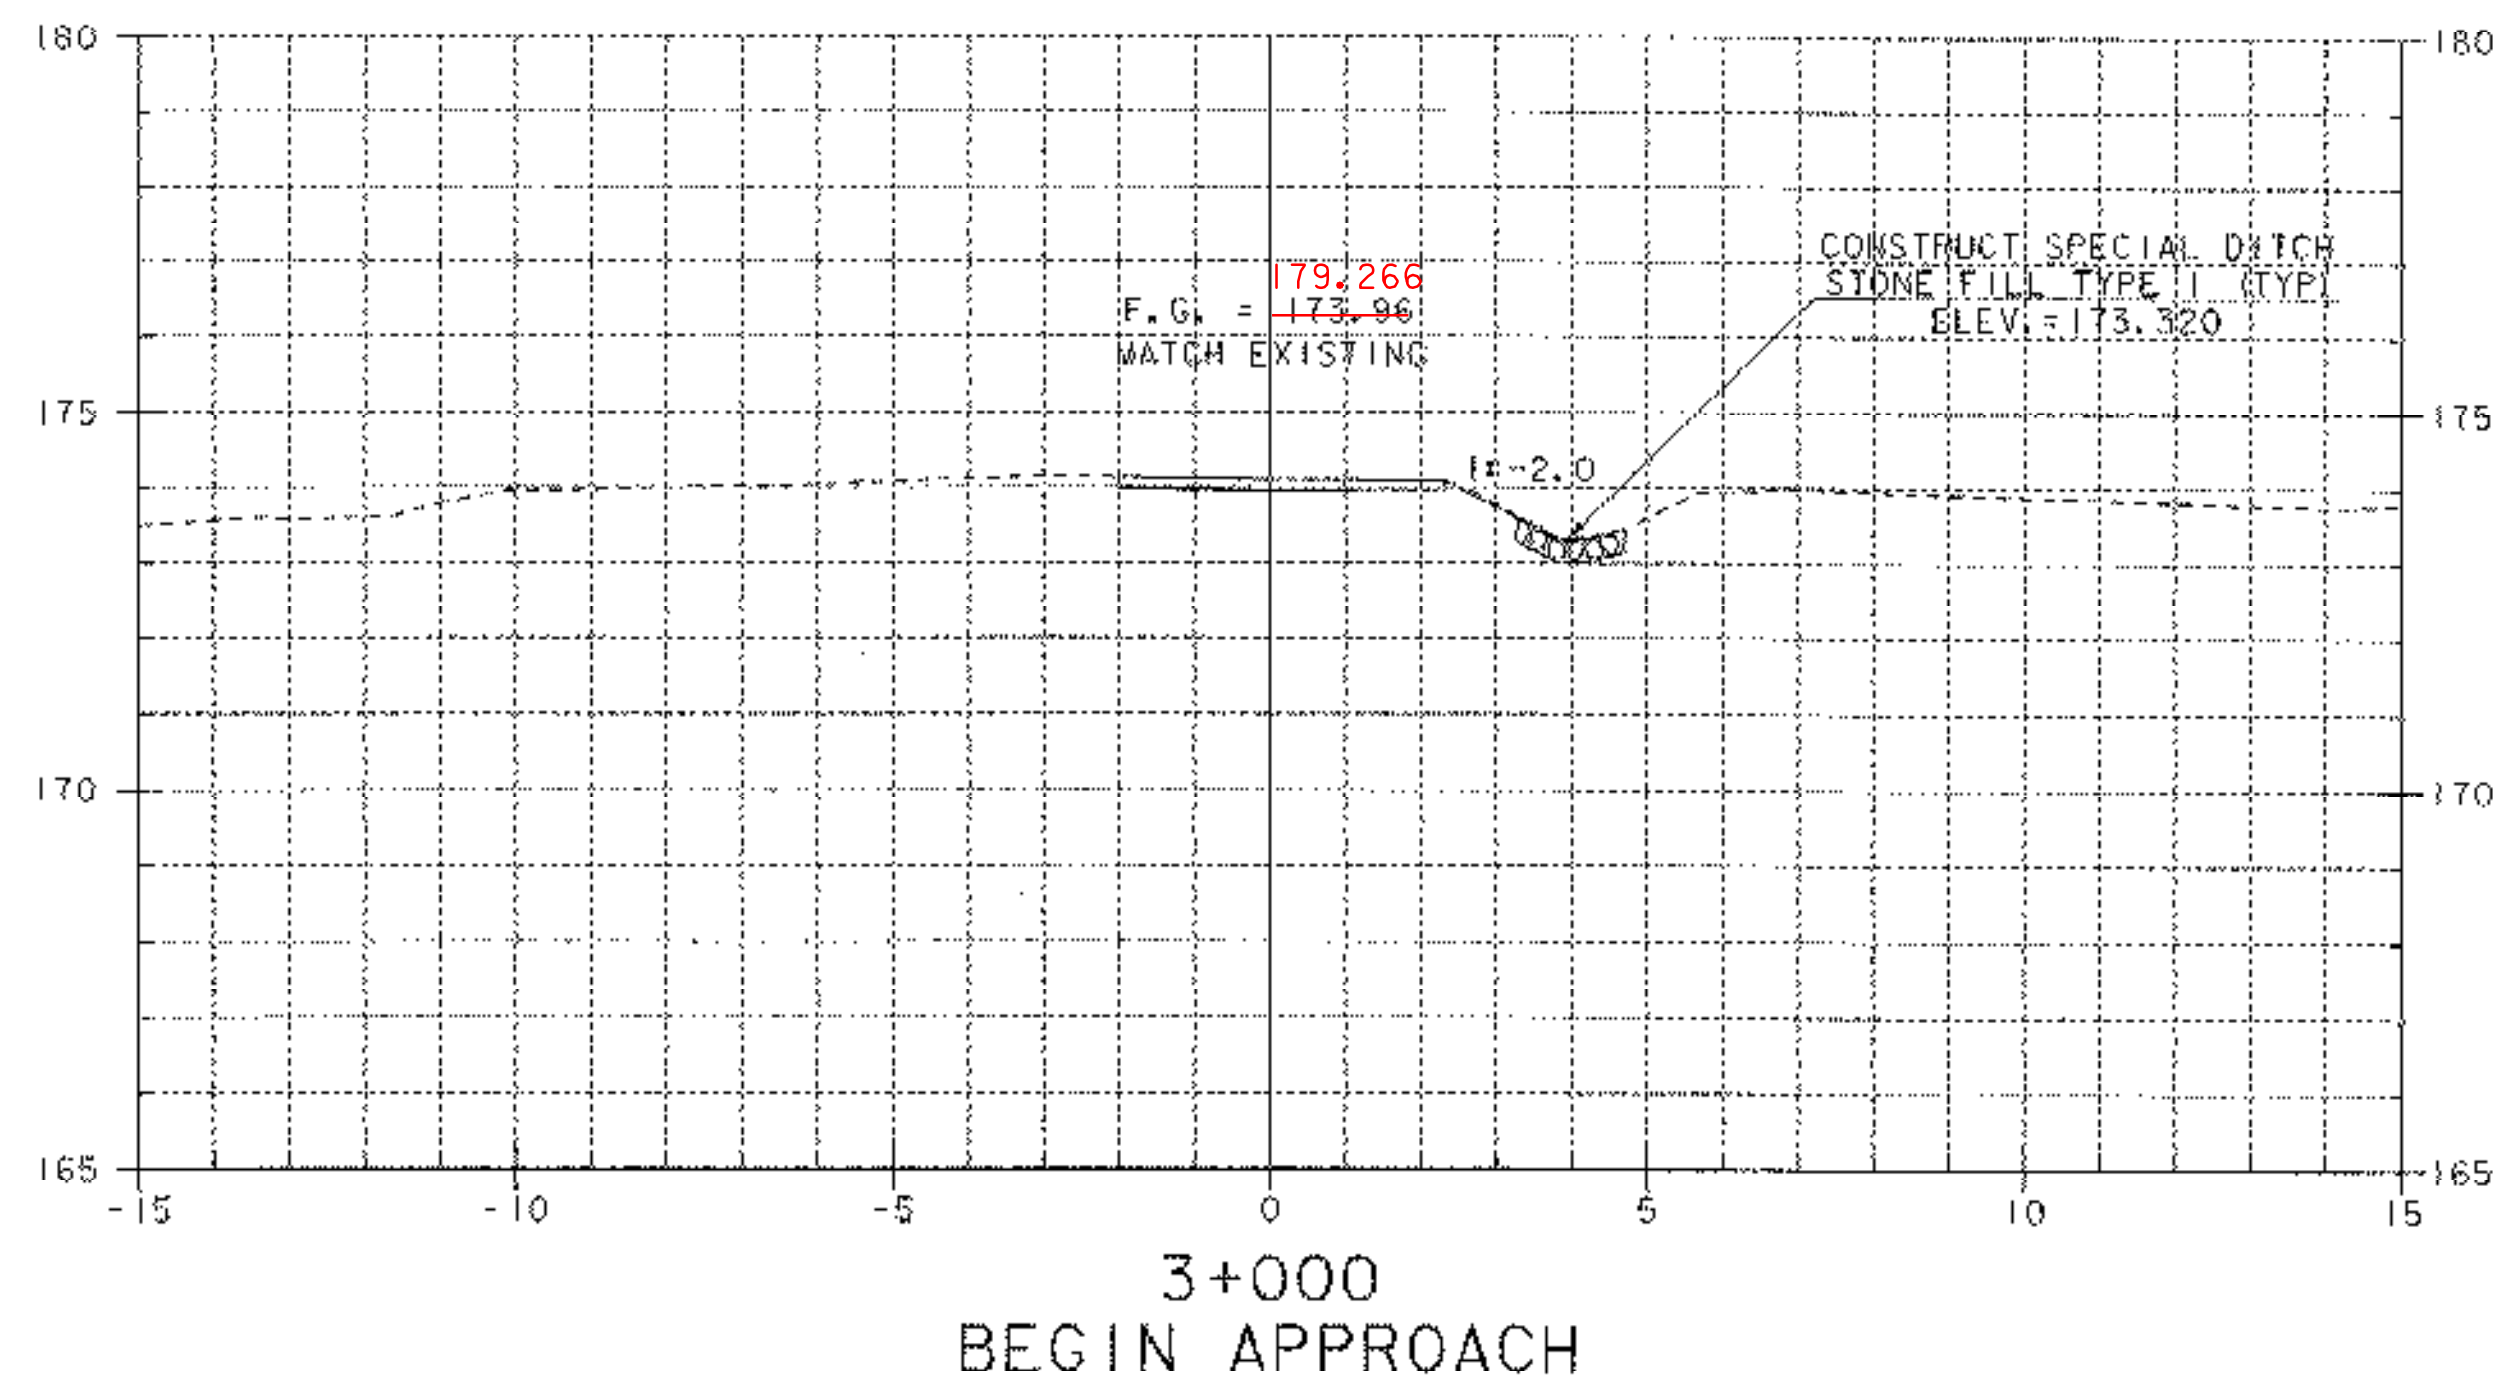
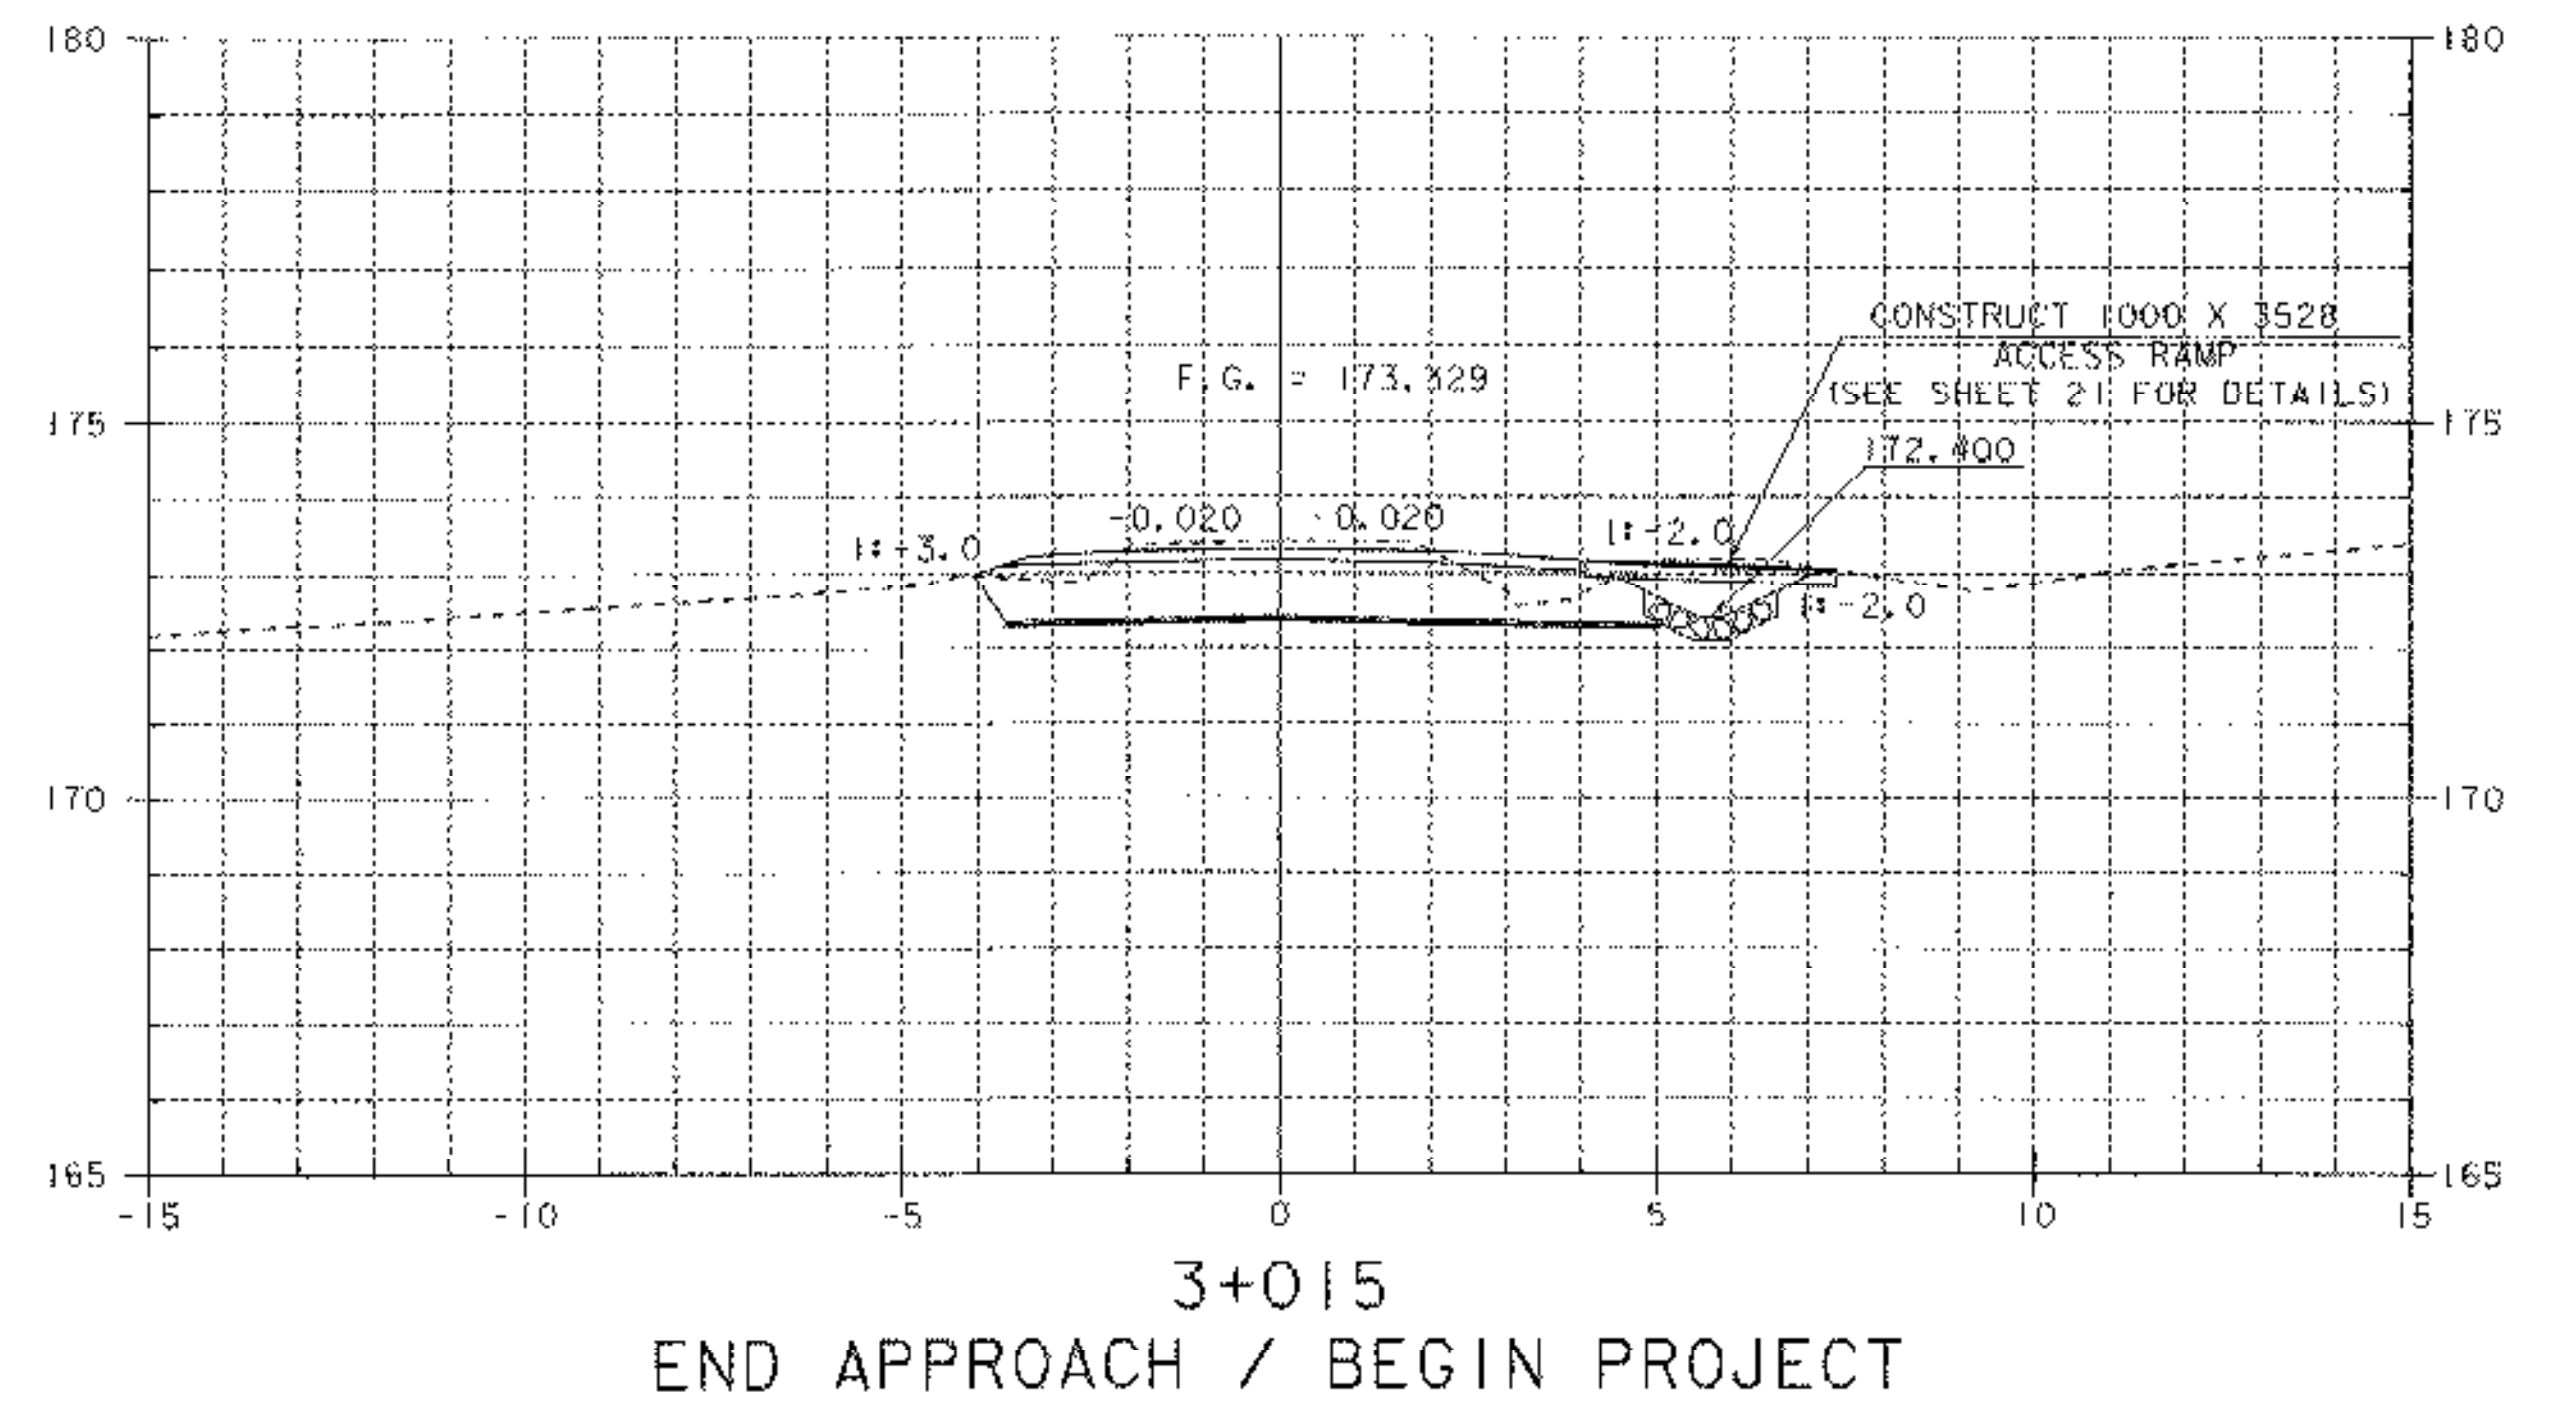


SUBBASE TRANSITION DIAGRAM

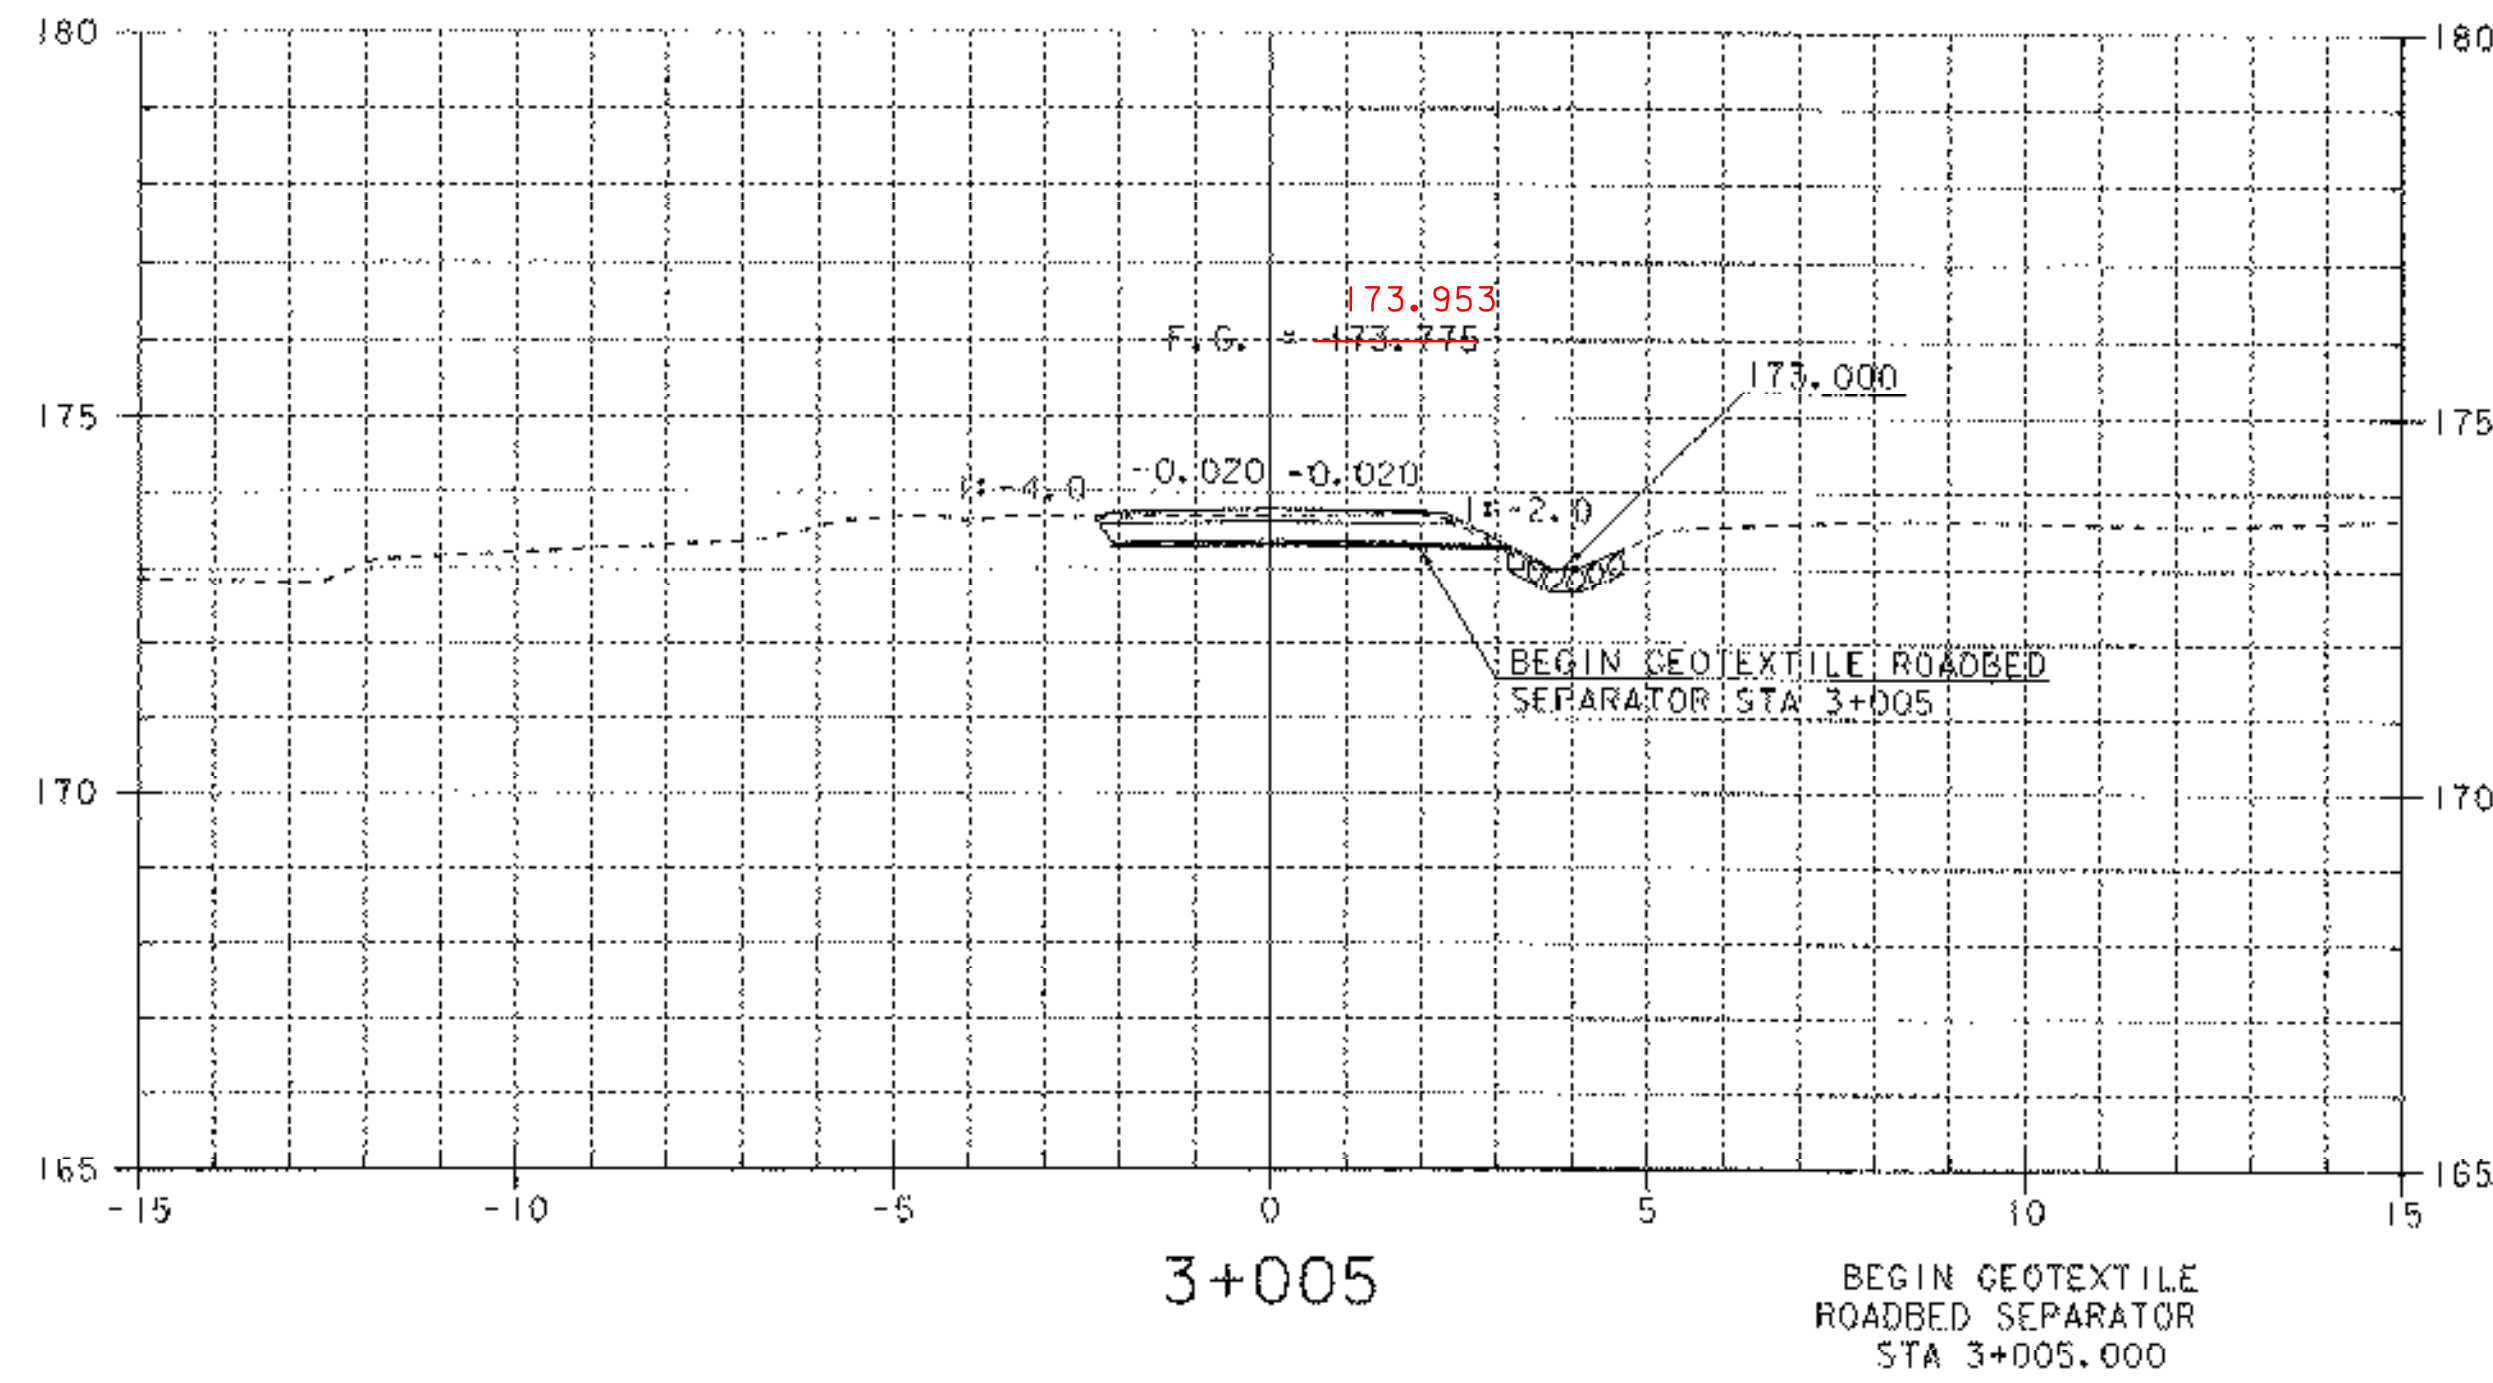

SHEET NAME: MAINLINE CROSS SECTIONS	
PROJECT NAME: WALLINGFORD	HIGHWAY NO.: TH 60
PROJECT NUMBER: BRO 1443(31)	BRIDGE NO.: 50
	OVER: OTTER CREEK
FILE NAME: /PW/94J084/sj084xs.dgn	PLOT DATE: 24-OCT-2005
PROJECT MANAGER: R. WHITCOMB	DRAWN BY: K. UPMAL
DESIGNED BY: K. UPMAL	IPARM NAME: sj084m.xlj
BRIDGE SHEET NUMBER:	SHEET 31 OF 38