
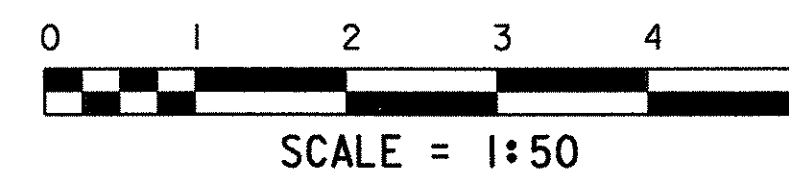
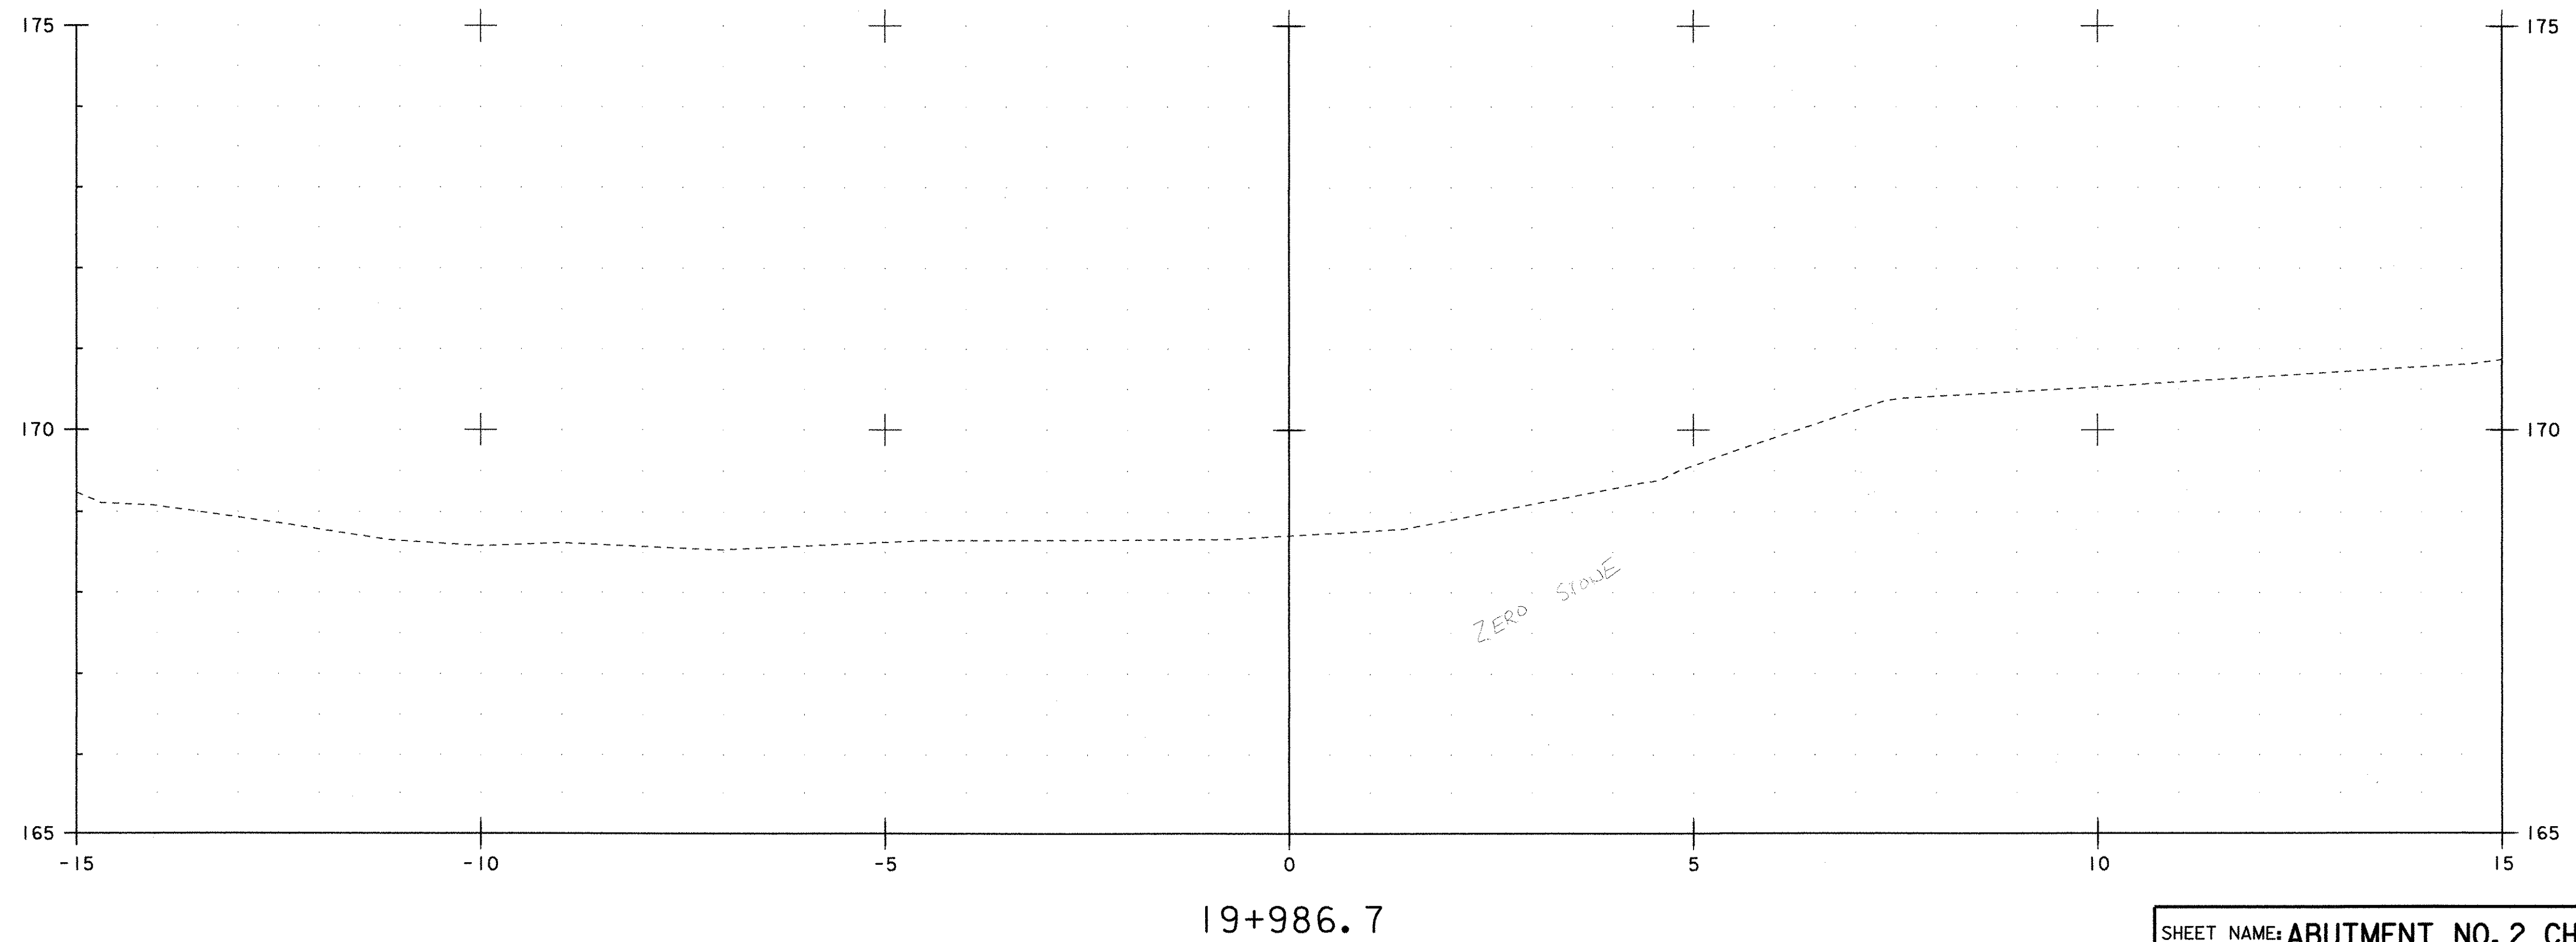


*REDESIGN*

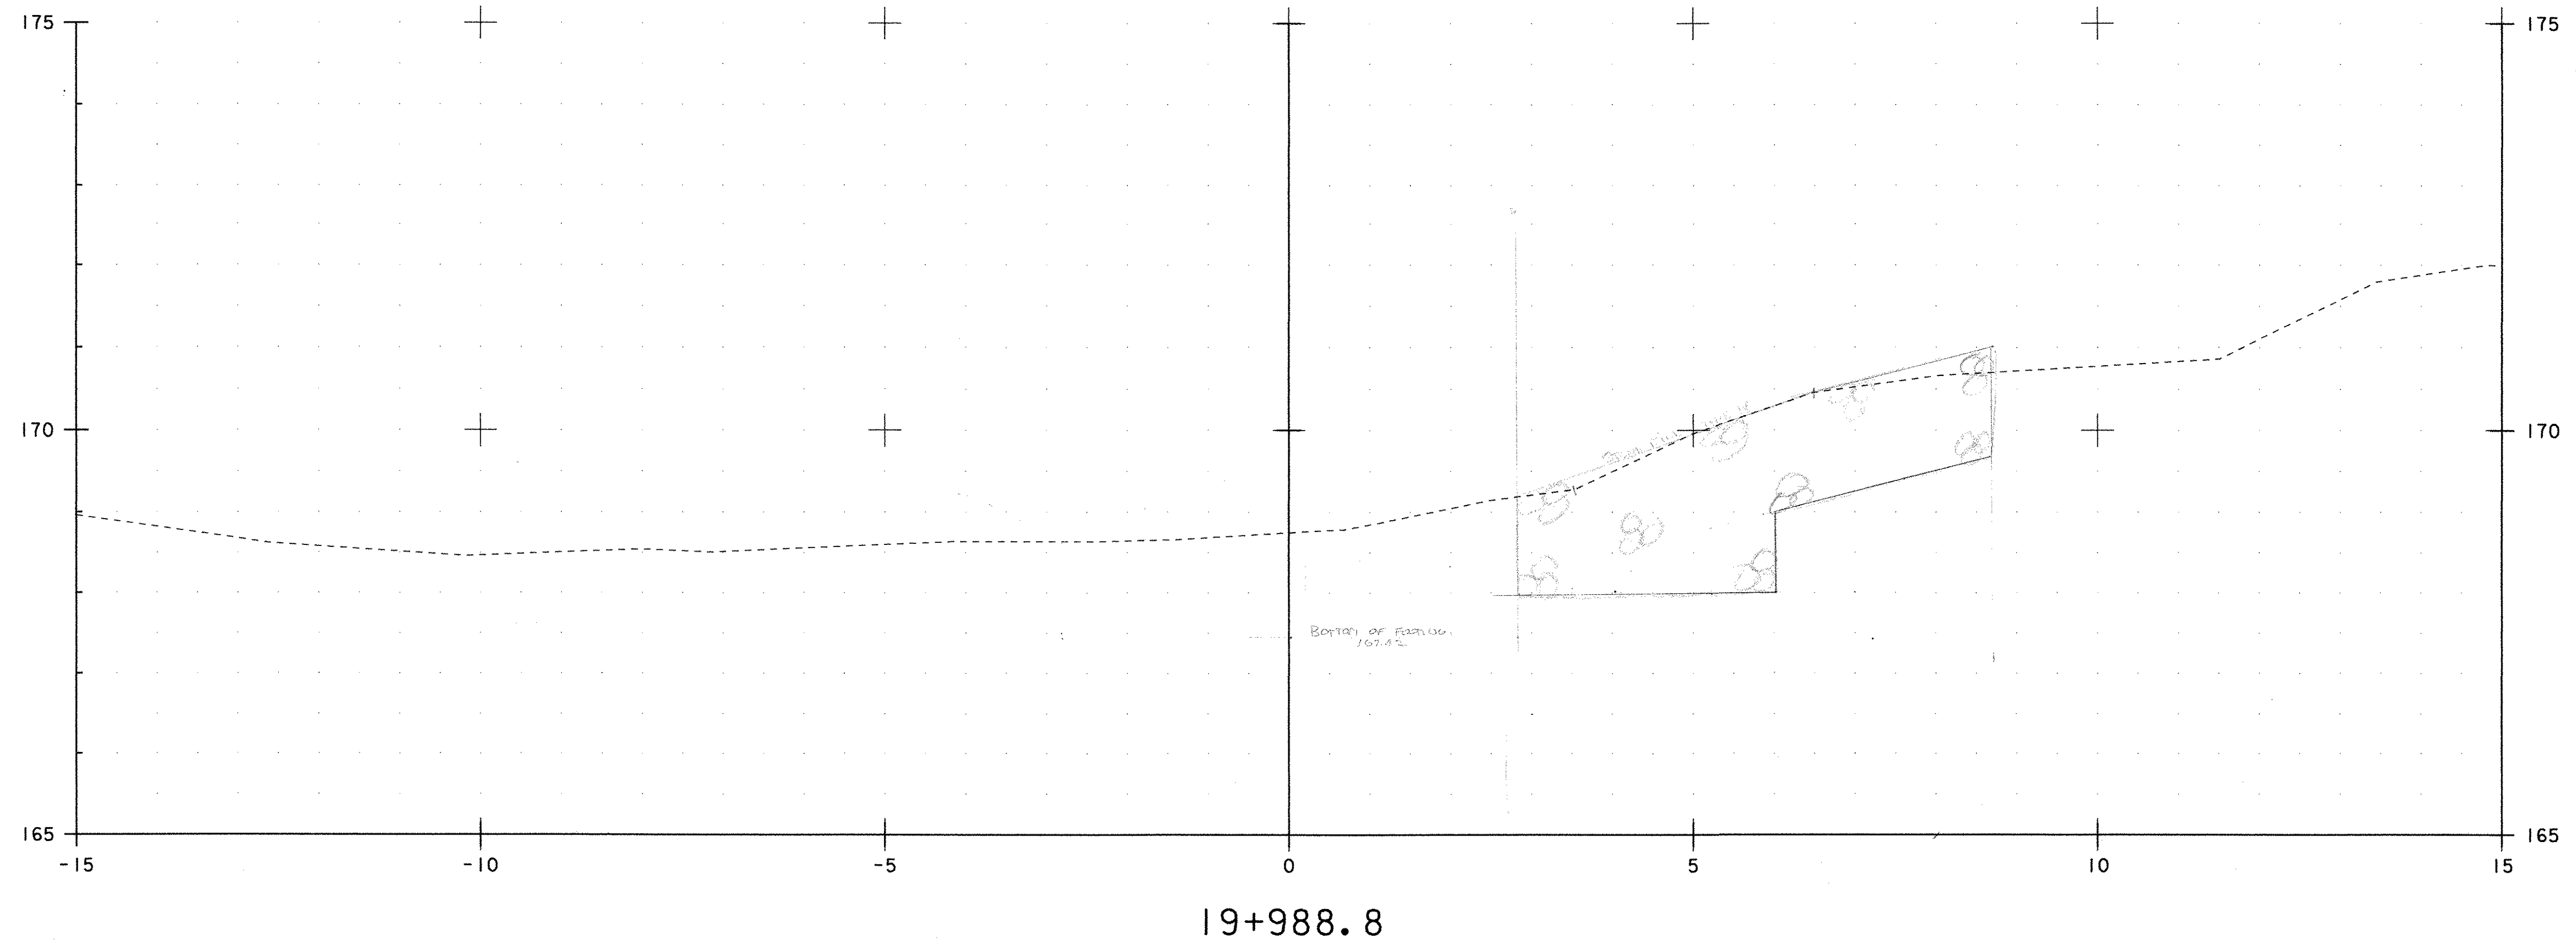

|  |                        |
|--|------------------------|
| SHEET NAME: <b>ABUTMENT NO. 2 CHANNEL SECTIONS (1)</b> |                        |
| PROJECT NAME: <b>WALLINGFORD</b>                       | HIGHWAY NO.: TH 60     |
| PROJECT NUMBER: <b>BRO 1443(3I)</b>                    | BRIDGE NO.: 50         |
|  | OVER: OTTER CREEK      |
| FILE NAME: /PW/94J084/post bid/sj084xs.dgn             | PLOT DATE: 30-JUN-2006 |
| PROJECT MANAGER: R. WHITCOMB                           | DRAWN BY: G. ROY       |
| DESIGNED BY: C. CARLSON                                | IPARM NAME: sj084cx6.1 |
| BRIDGE SHEET NUMBER:                                   | SHEET 6 OF 17          |