

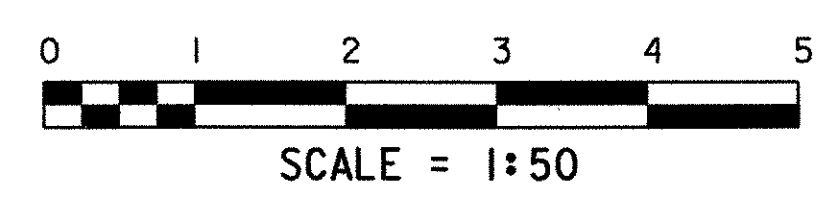


171.756

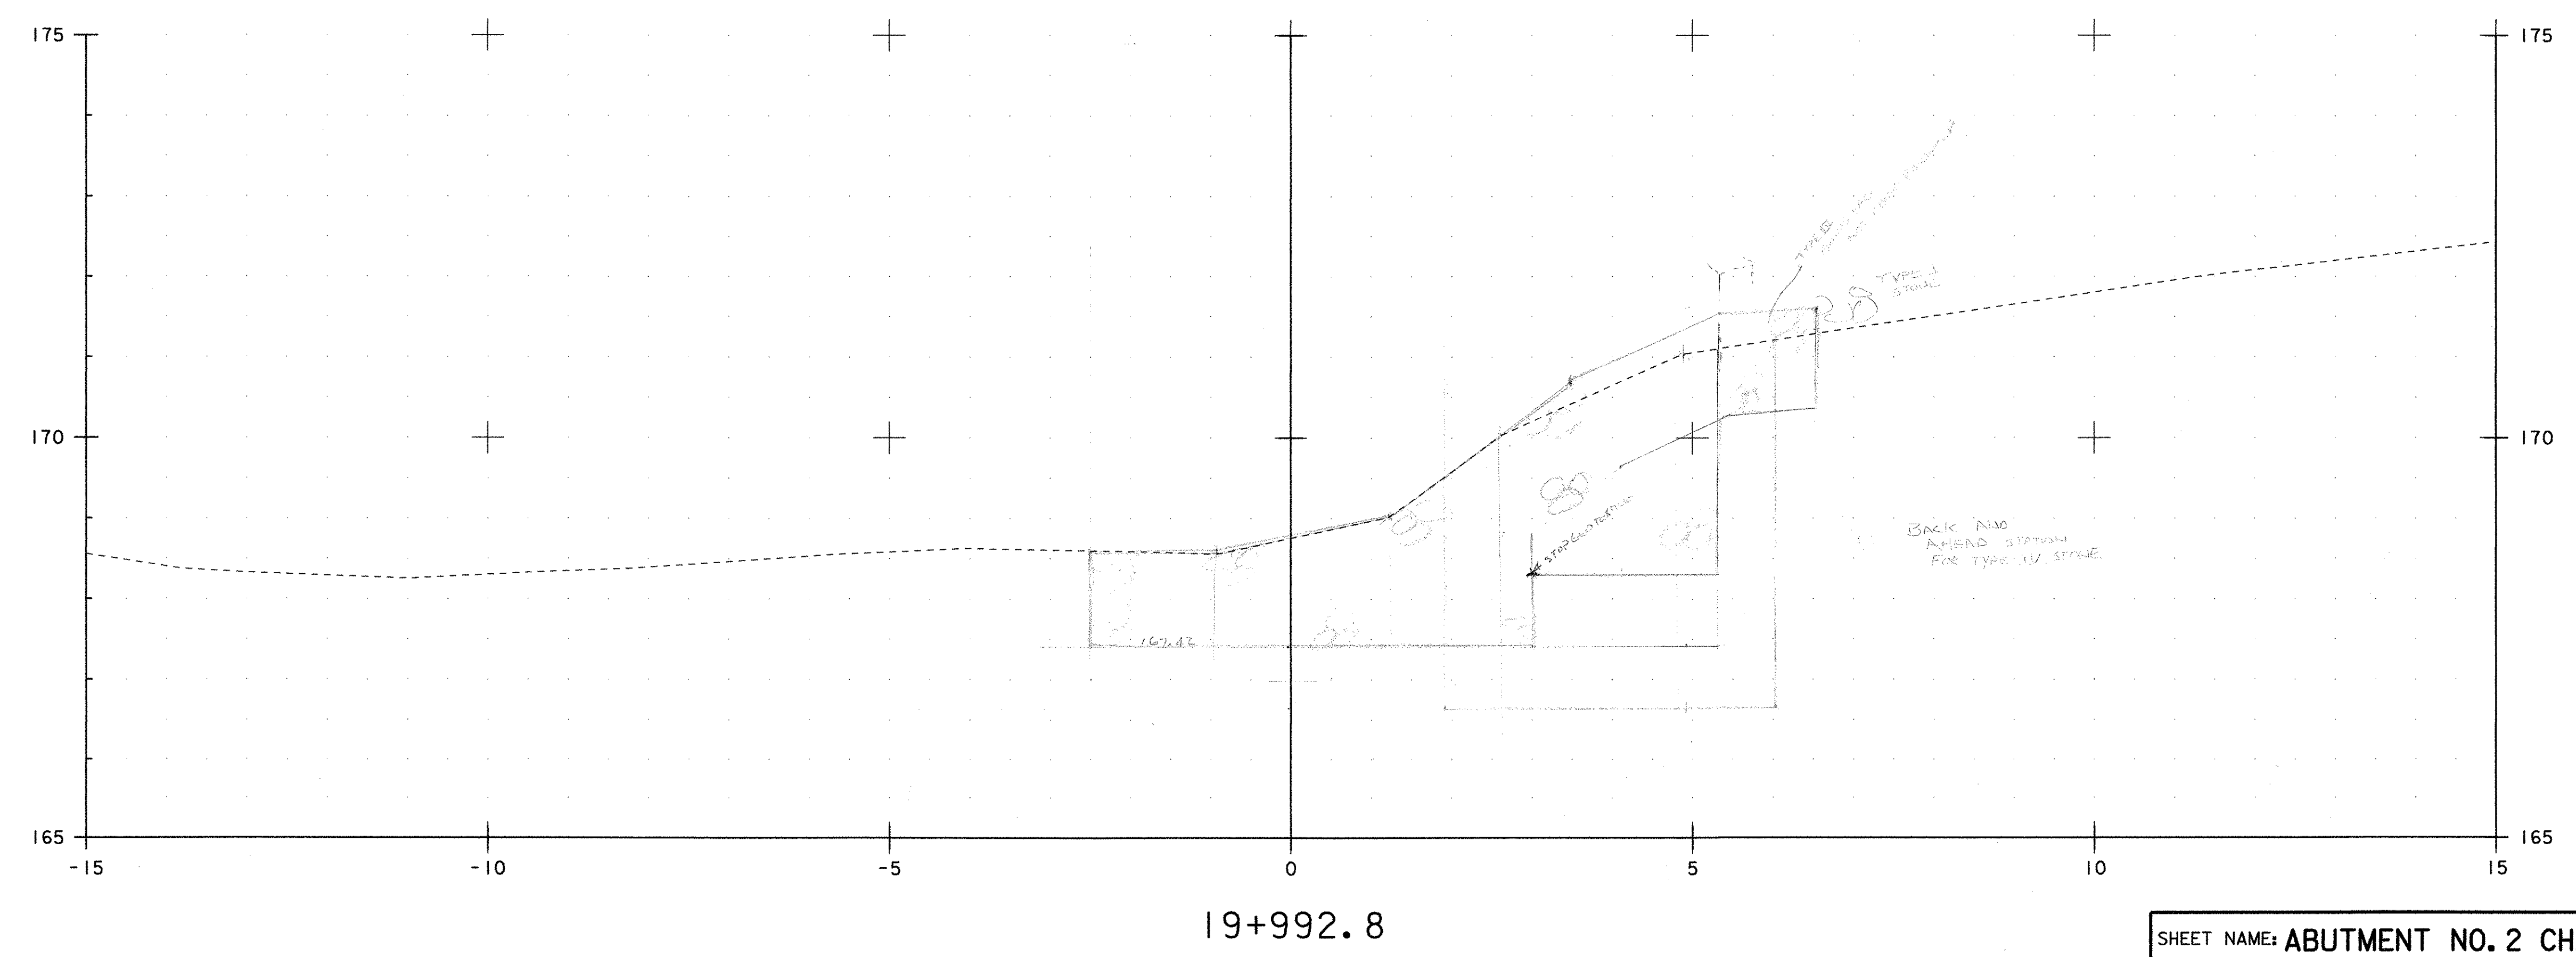

RE-DESIGN

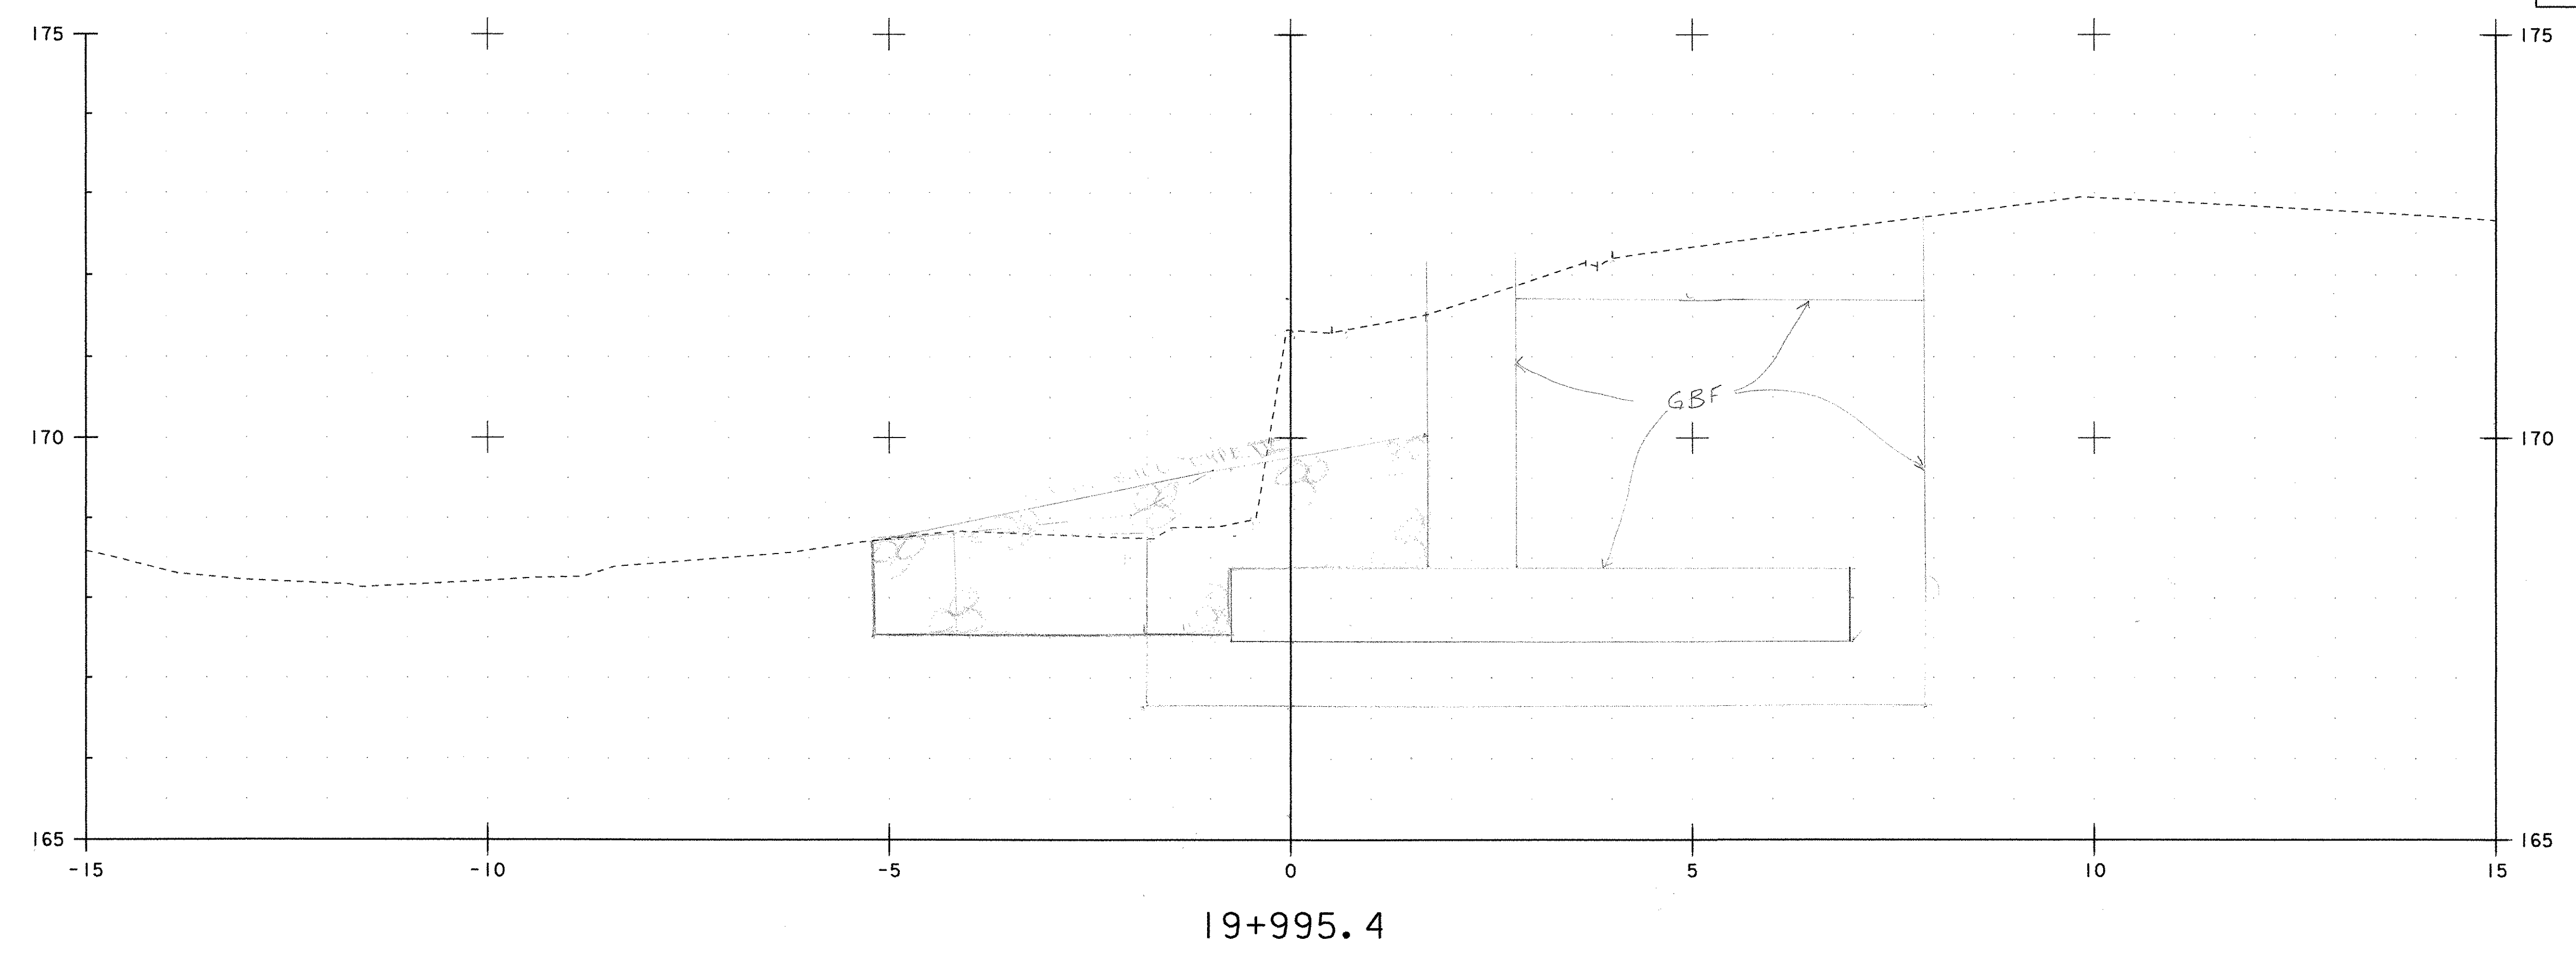

SHEET NAME: ABUTMENT NO. 2 CHANNEL SECTIONS (3)		
PROJECT NAME: WALLINGFORD	HIGHWAY NO.: TH 60	
PROJECT NUMBER: BRO 1443(31)	BRIDGE NO.: 50	
	OVER: OTTER CREEK	
FILE NAME: /PW/94J084/post bid/sj084xs.dgn	PLOT DATE: 30-JUN-2006	
PROJECT MANAGER: R. WHITCOMB	DRAWN BY: G. ROY	
DESIGNED BY: C. CARLSON	IPARM NAME: sj084cx8.1	
BRIDGE SHEET NUMBER:	SHEET 8 OF 17	