
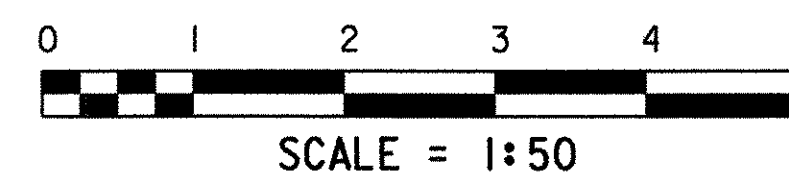
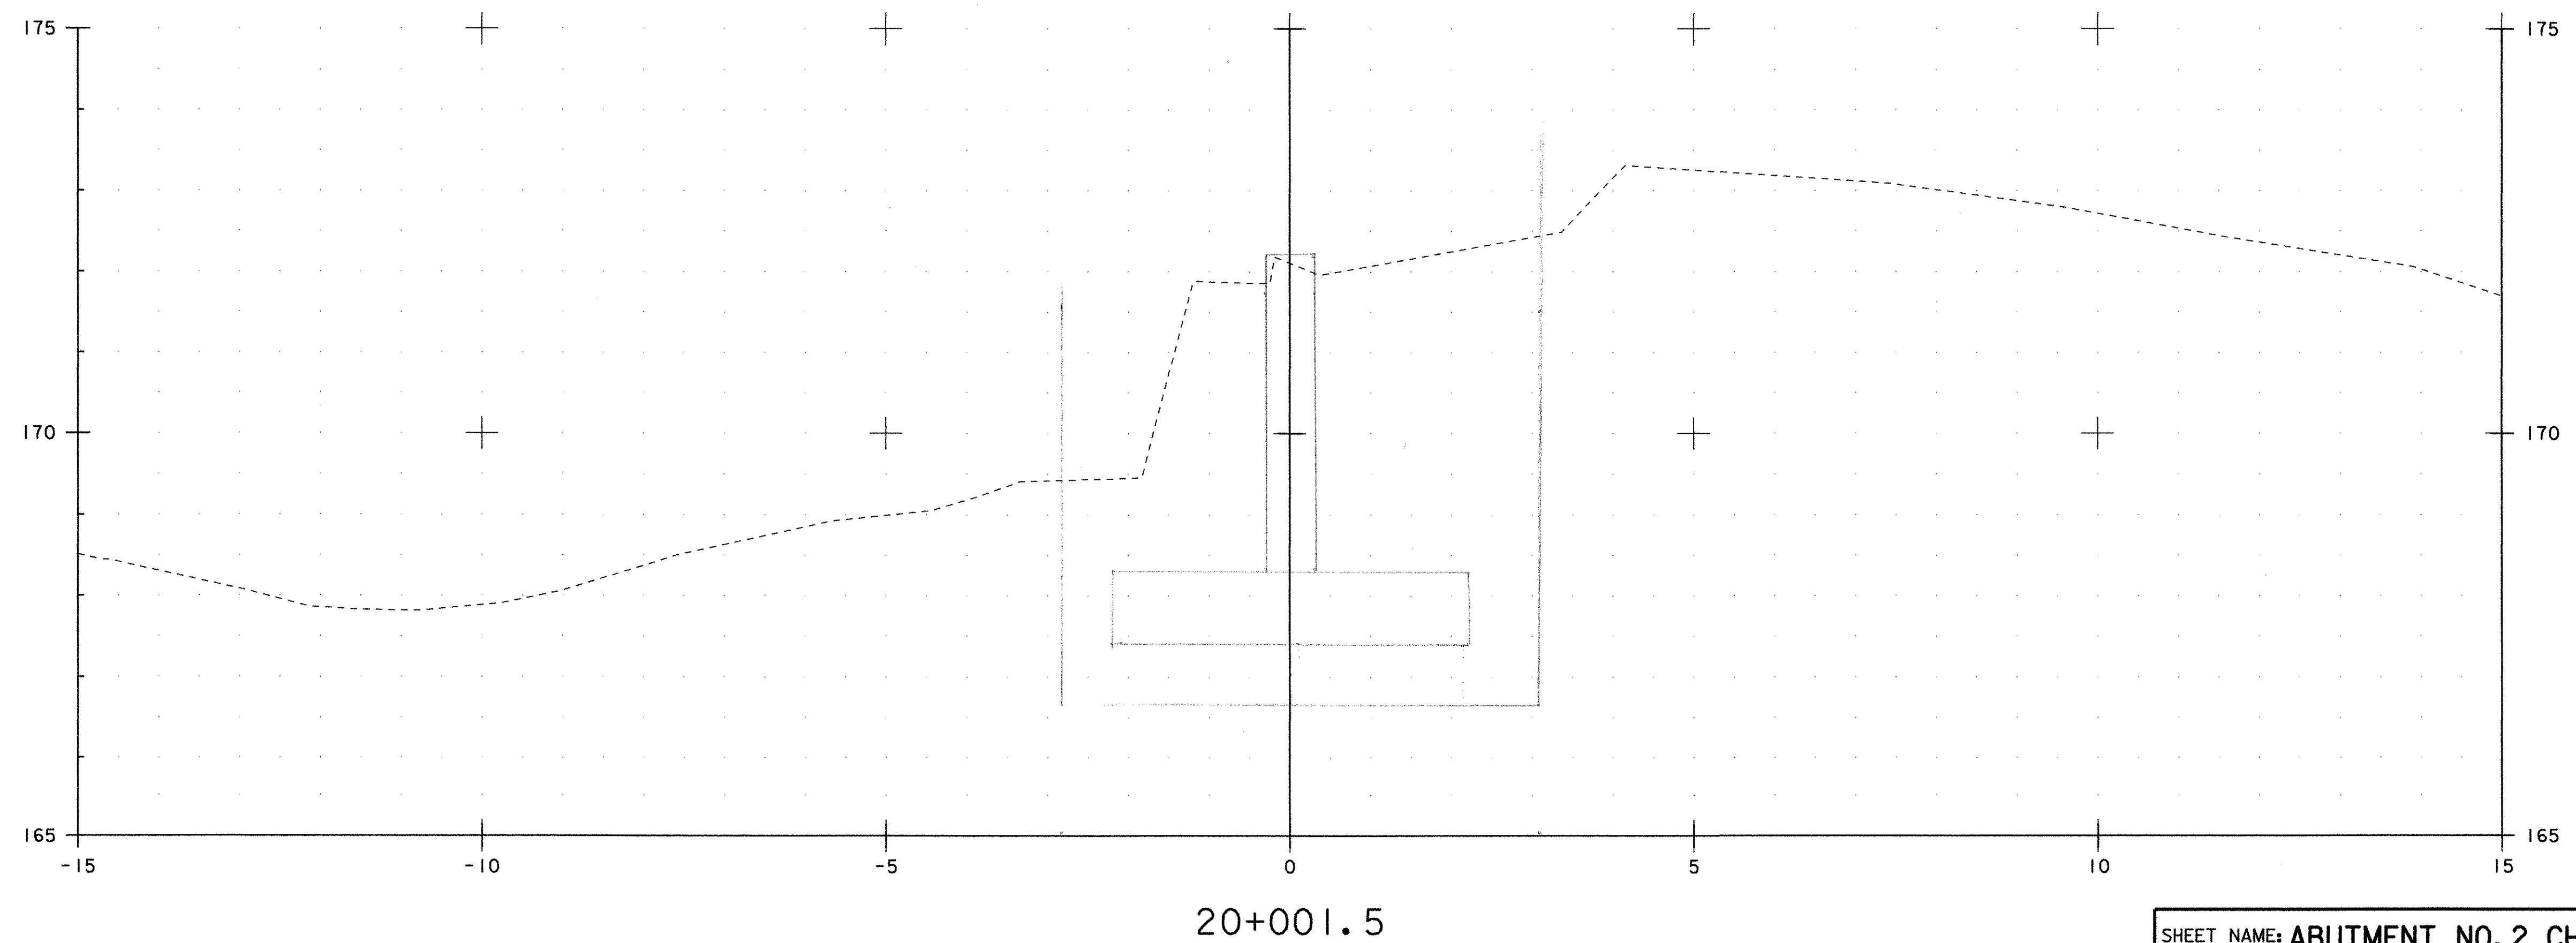


REDESIGN

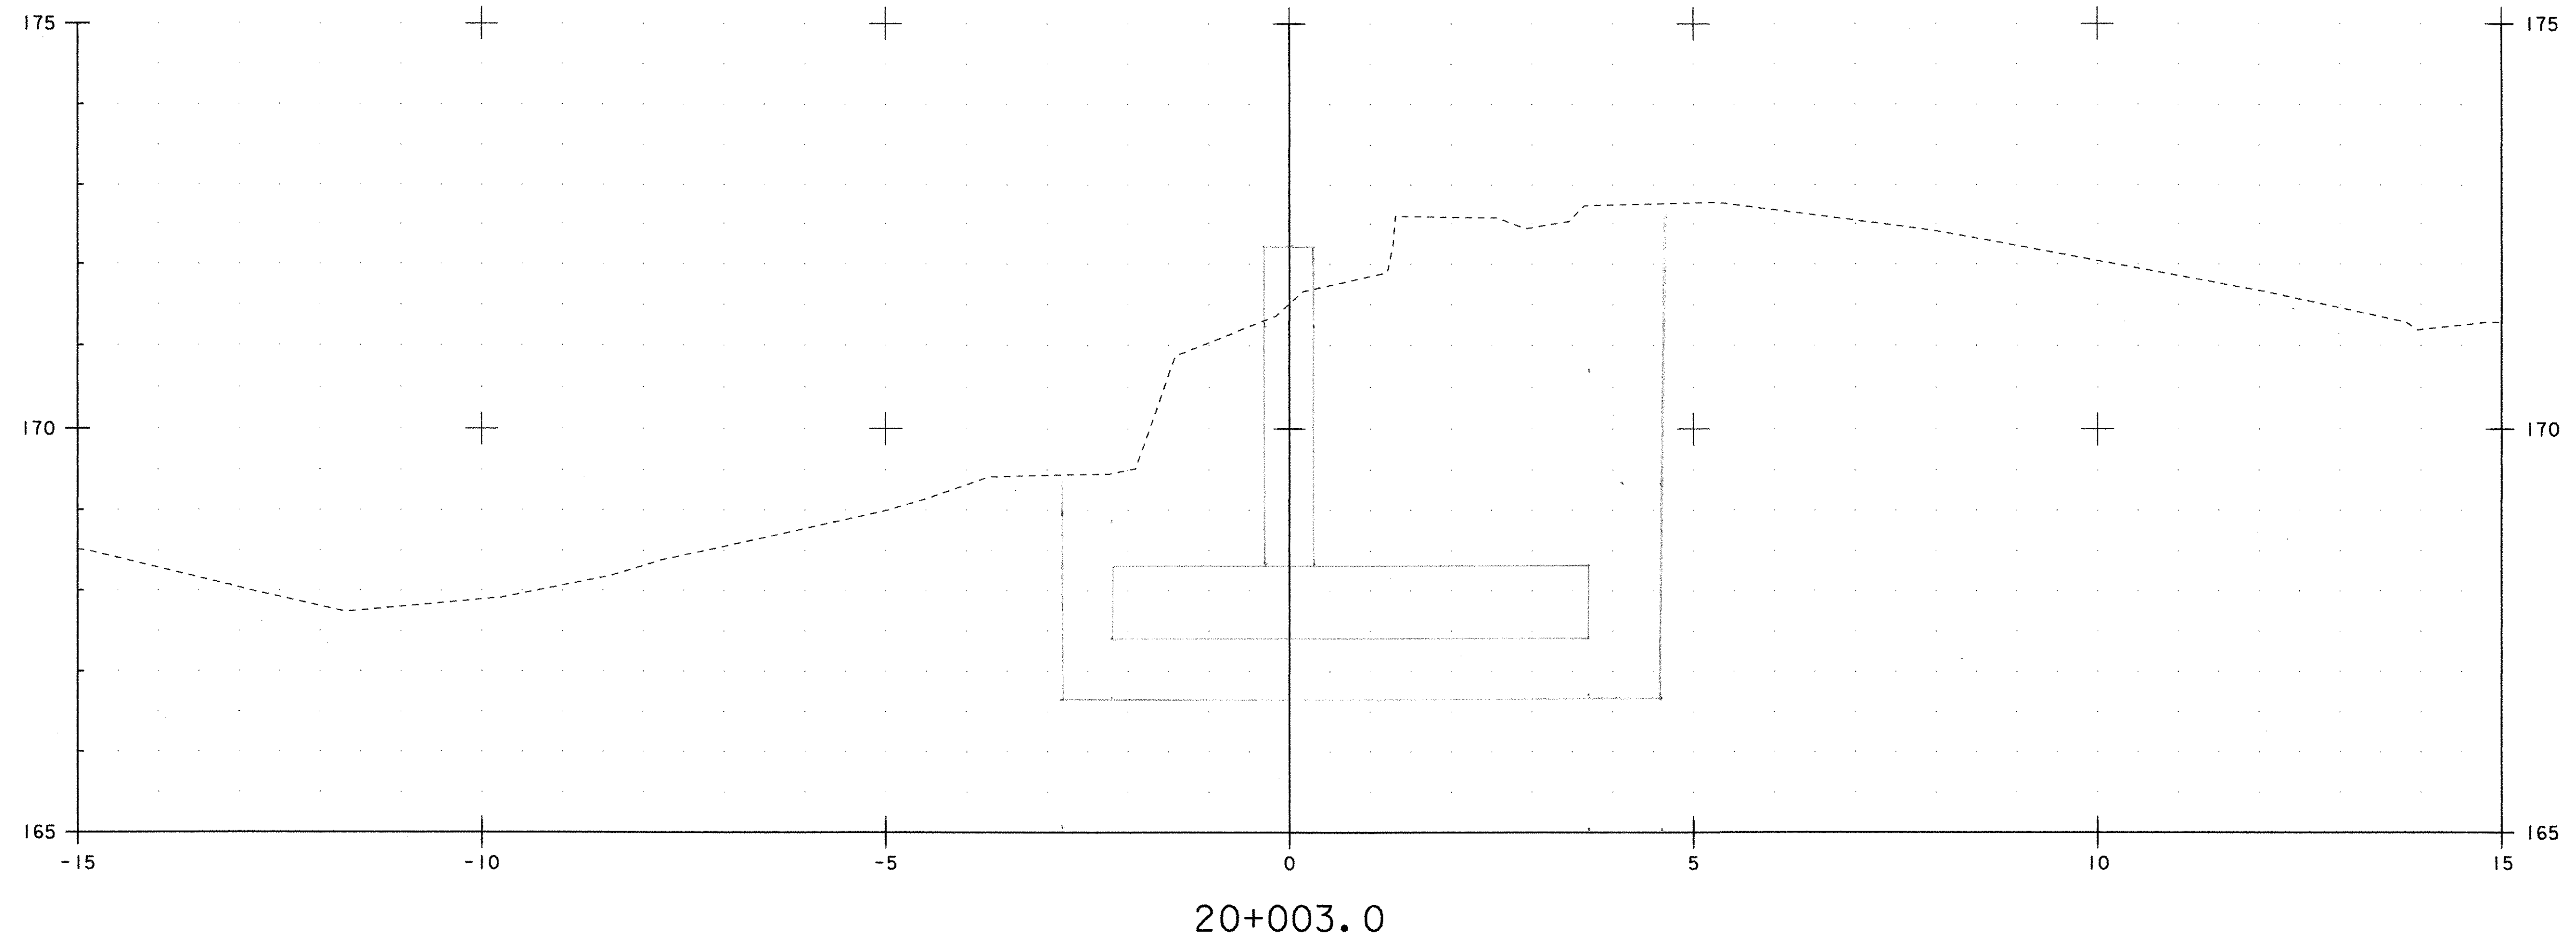

SHEET NAME: ABUTMENT NO. 2 CHANNEL SECTIONS (7)			
PROJECT NAME: WALLINGFORD	HIGHWAY NO.: TH 60		
PROJECT NUMBER: BRO 1443(3I)	BRIDGE NO.: 50		
	OVER: OTTER CREEK		
FILE NAME: /PW/94J084/post bid/sj084xs.dgn	PLOT DATE: 30-JUN-2006		
PROJECT MANAGER: R. WHITCOMB	DRAWN BY: G. ROY		
DESIGNED BY: C. CARLSON	IPARM NAME: sj084cx12.1		
BRIDGE SHEET NUMBER:	SHEET 12 OF 17		