
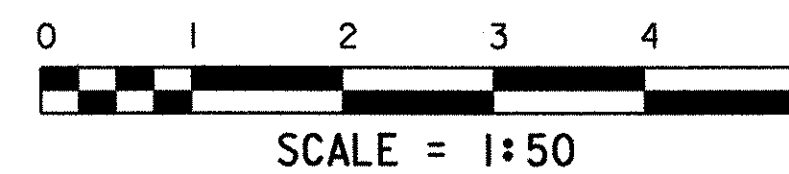
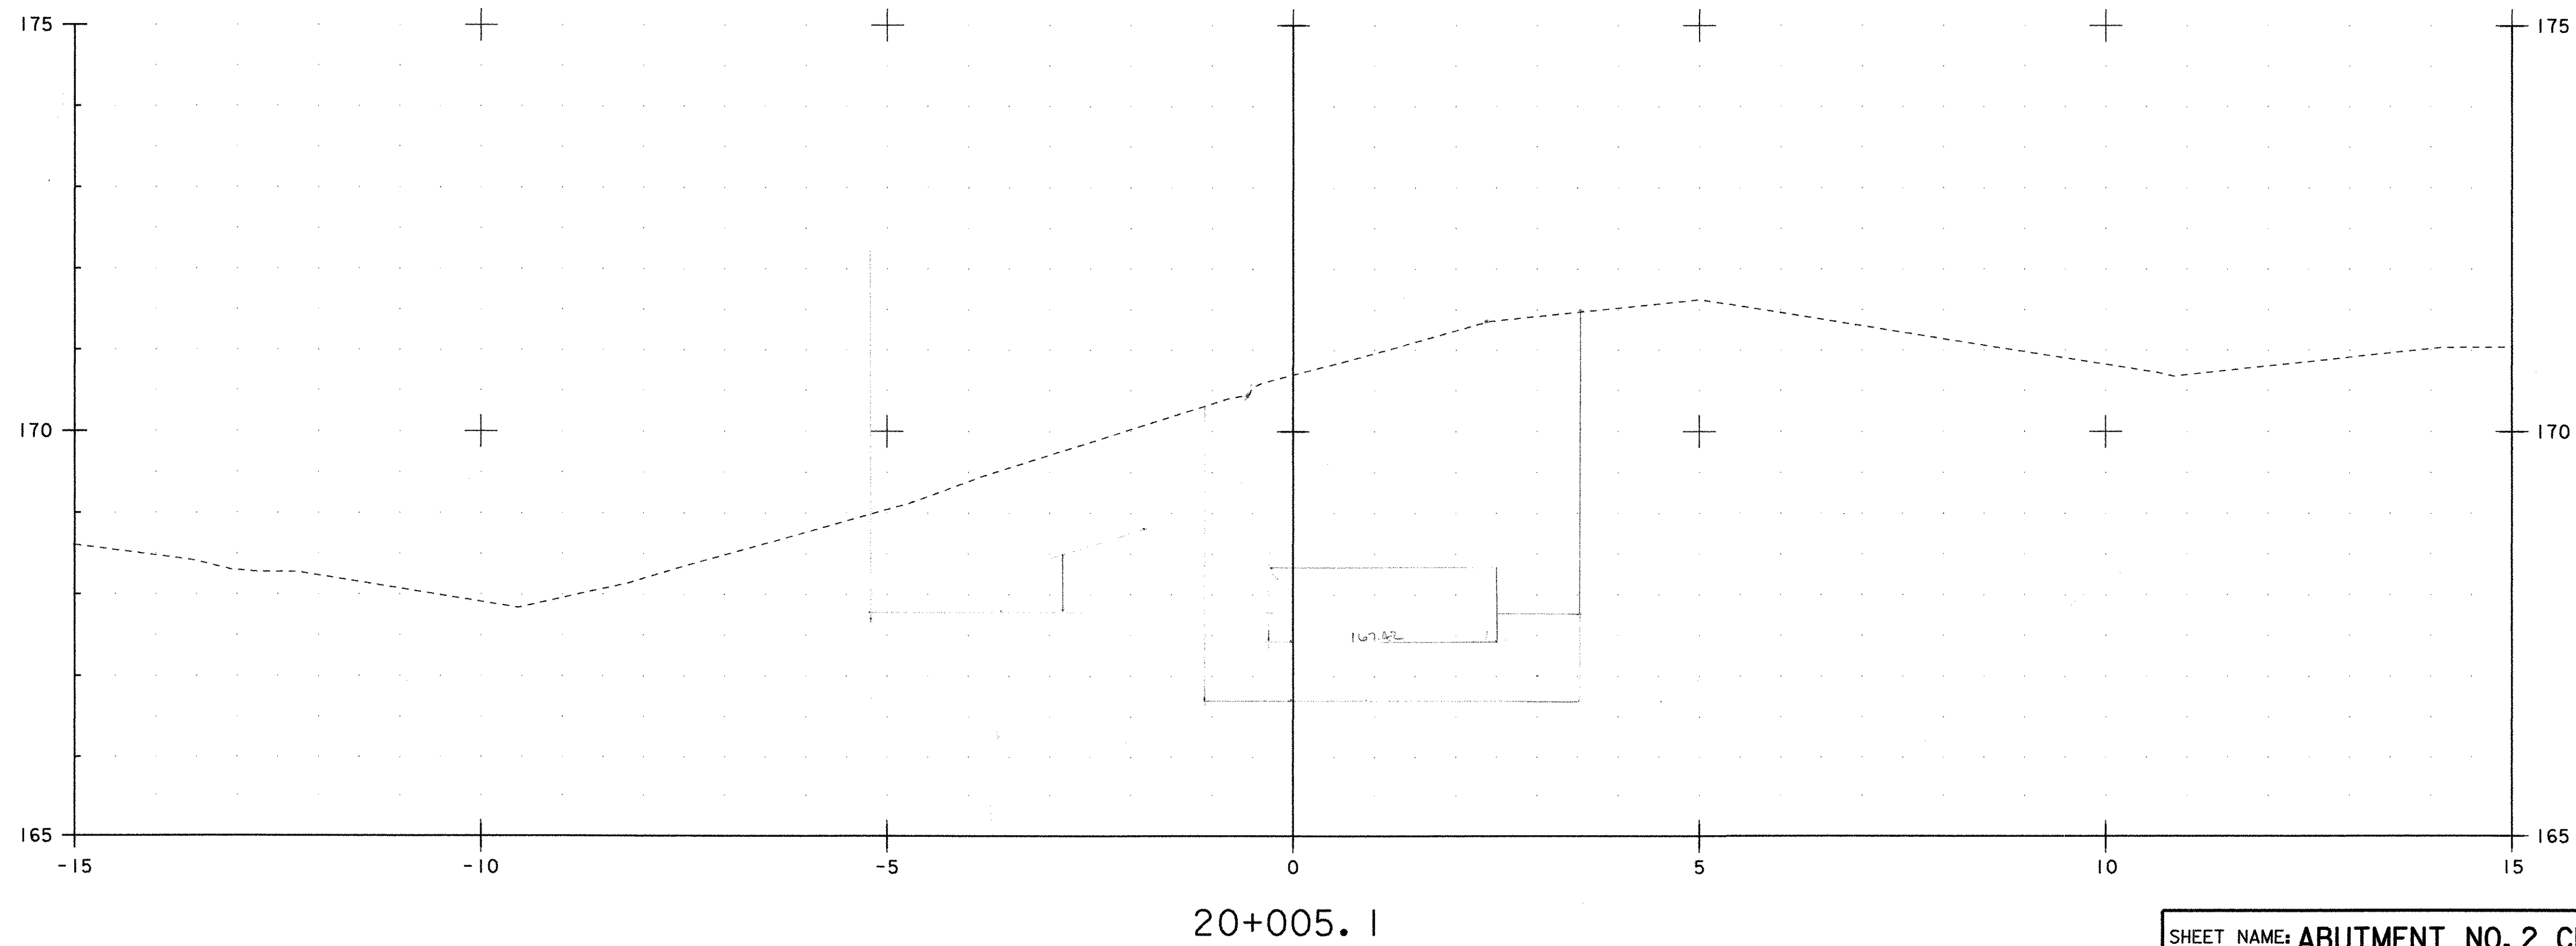


REDESIGN

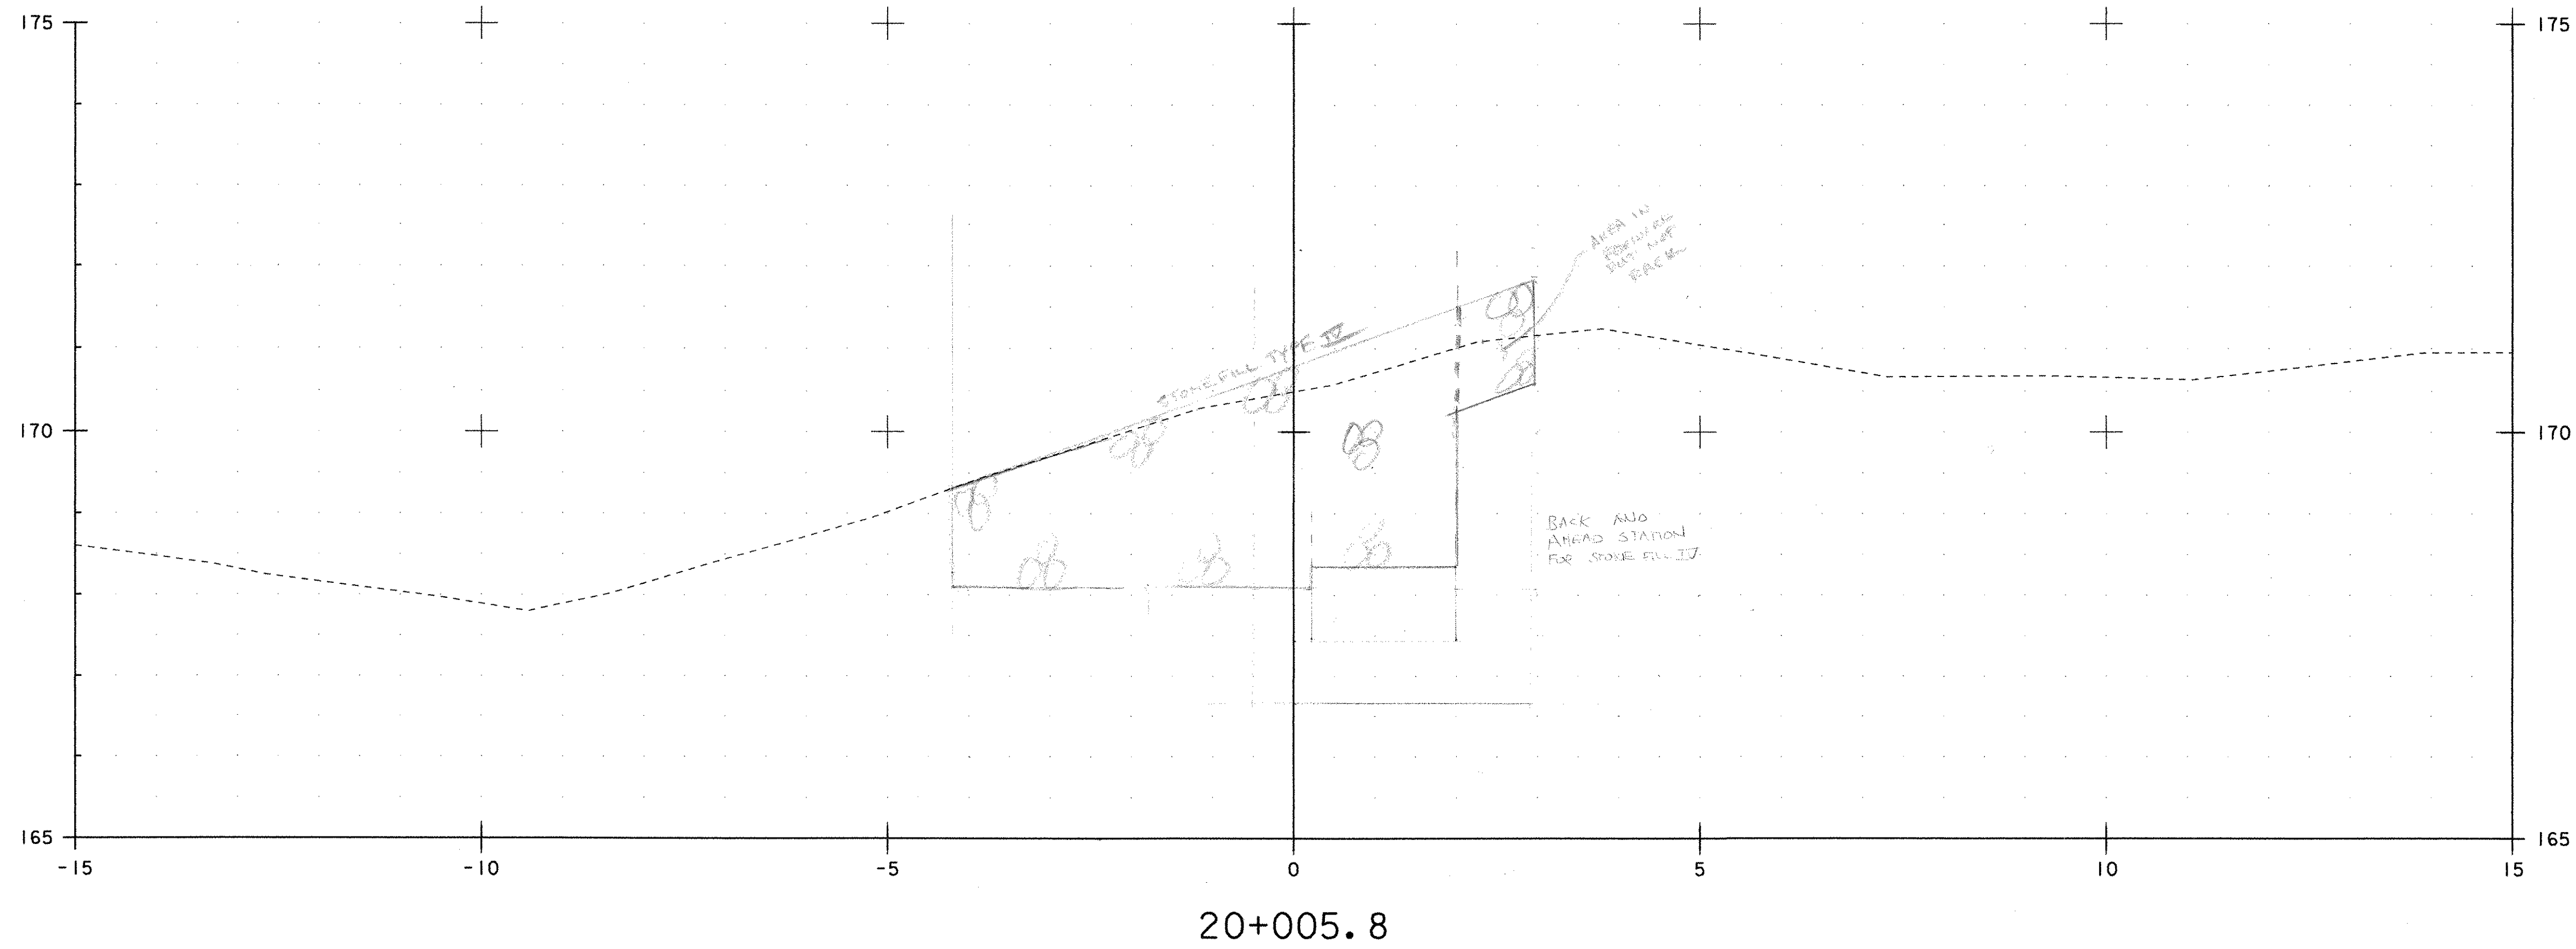

|   |                         |
|---|-------------------------|
| SHEET NAME: ABUTMENT NO. 2 CHANNEL SECTIONS (9) |                         |
| PROJECT NAME: WALLINGFORD                       | HIGHWAY NO.: TH 60      |
| PROJECT NUMBER: BRO 1443(31)                    | BRIDGE NO.: 50          |
|   | OVER: OTTER CREEK       |
| FILE NAME: /PW/94J084/post bid/sj084xs.dgn      | PLOT DATE: 30-JUN-2006  |
| PROJECT MANAGER: R. WHITCOMB                    | DRAWN BY: G. ROY        |
| DESIGNED BY: C. CARLSON                         | IPARM NAME: sj084cx14.I |
| BRIDGE SHEET NUMBER:                            | SHEET 14 OF 17          |