

1. TITLE SHEET
2. INDEX OF SHEETS

# STATE OF VERMONT AGENCY OF TRANSPORTATION



## PROPOSED IMPROVEMENT BRIDGE PROJECT



TOWN OF GRANVILLE  
COUNTY OF ADDISON

ROUTE NO : TH 23, CL 3      BRIDGE NO : 15

PROJECT LOCATION : ON TH 23 APPROXIMATELY 0.02 Km EASTERLY OF  
THE INTERSECTION OF TH 23 AND VT ROUTE 12A, PROCEEDING  
NORTHEASTERLY APPROXIMATELY 35 m.

PROJECT DESCRIPTION : CONSTRUCTION OF A NEW STRUCTURE ALONG  
WITH RELATED ROADWAY AND CHANNEL WORK.

LENGTH OF STRUCTURE :      11.400      METERS  
LENGTH OF ROADWAY :      23.600      METERS  
LENGTH OF PROJECT :      35.000      METERS

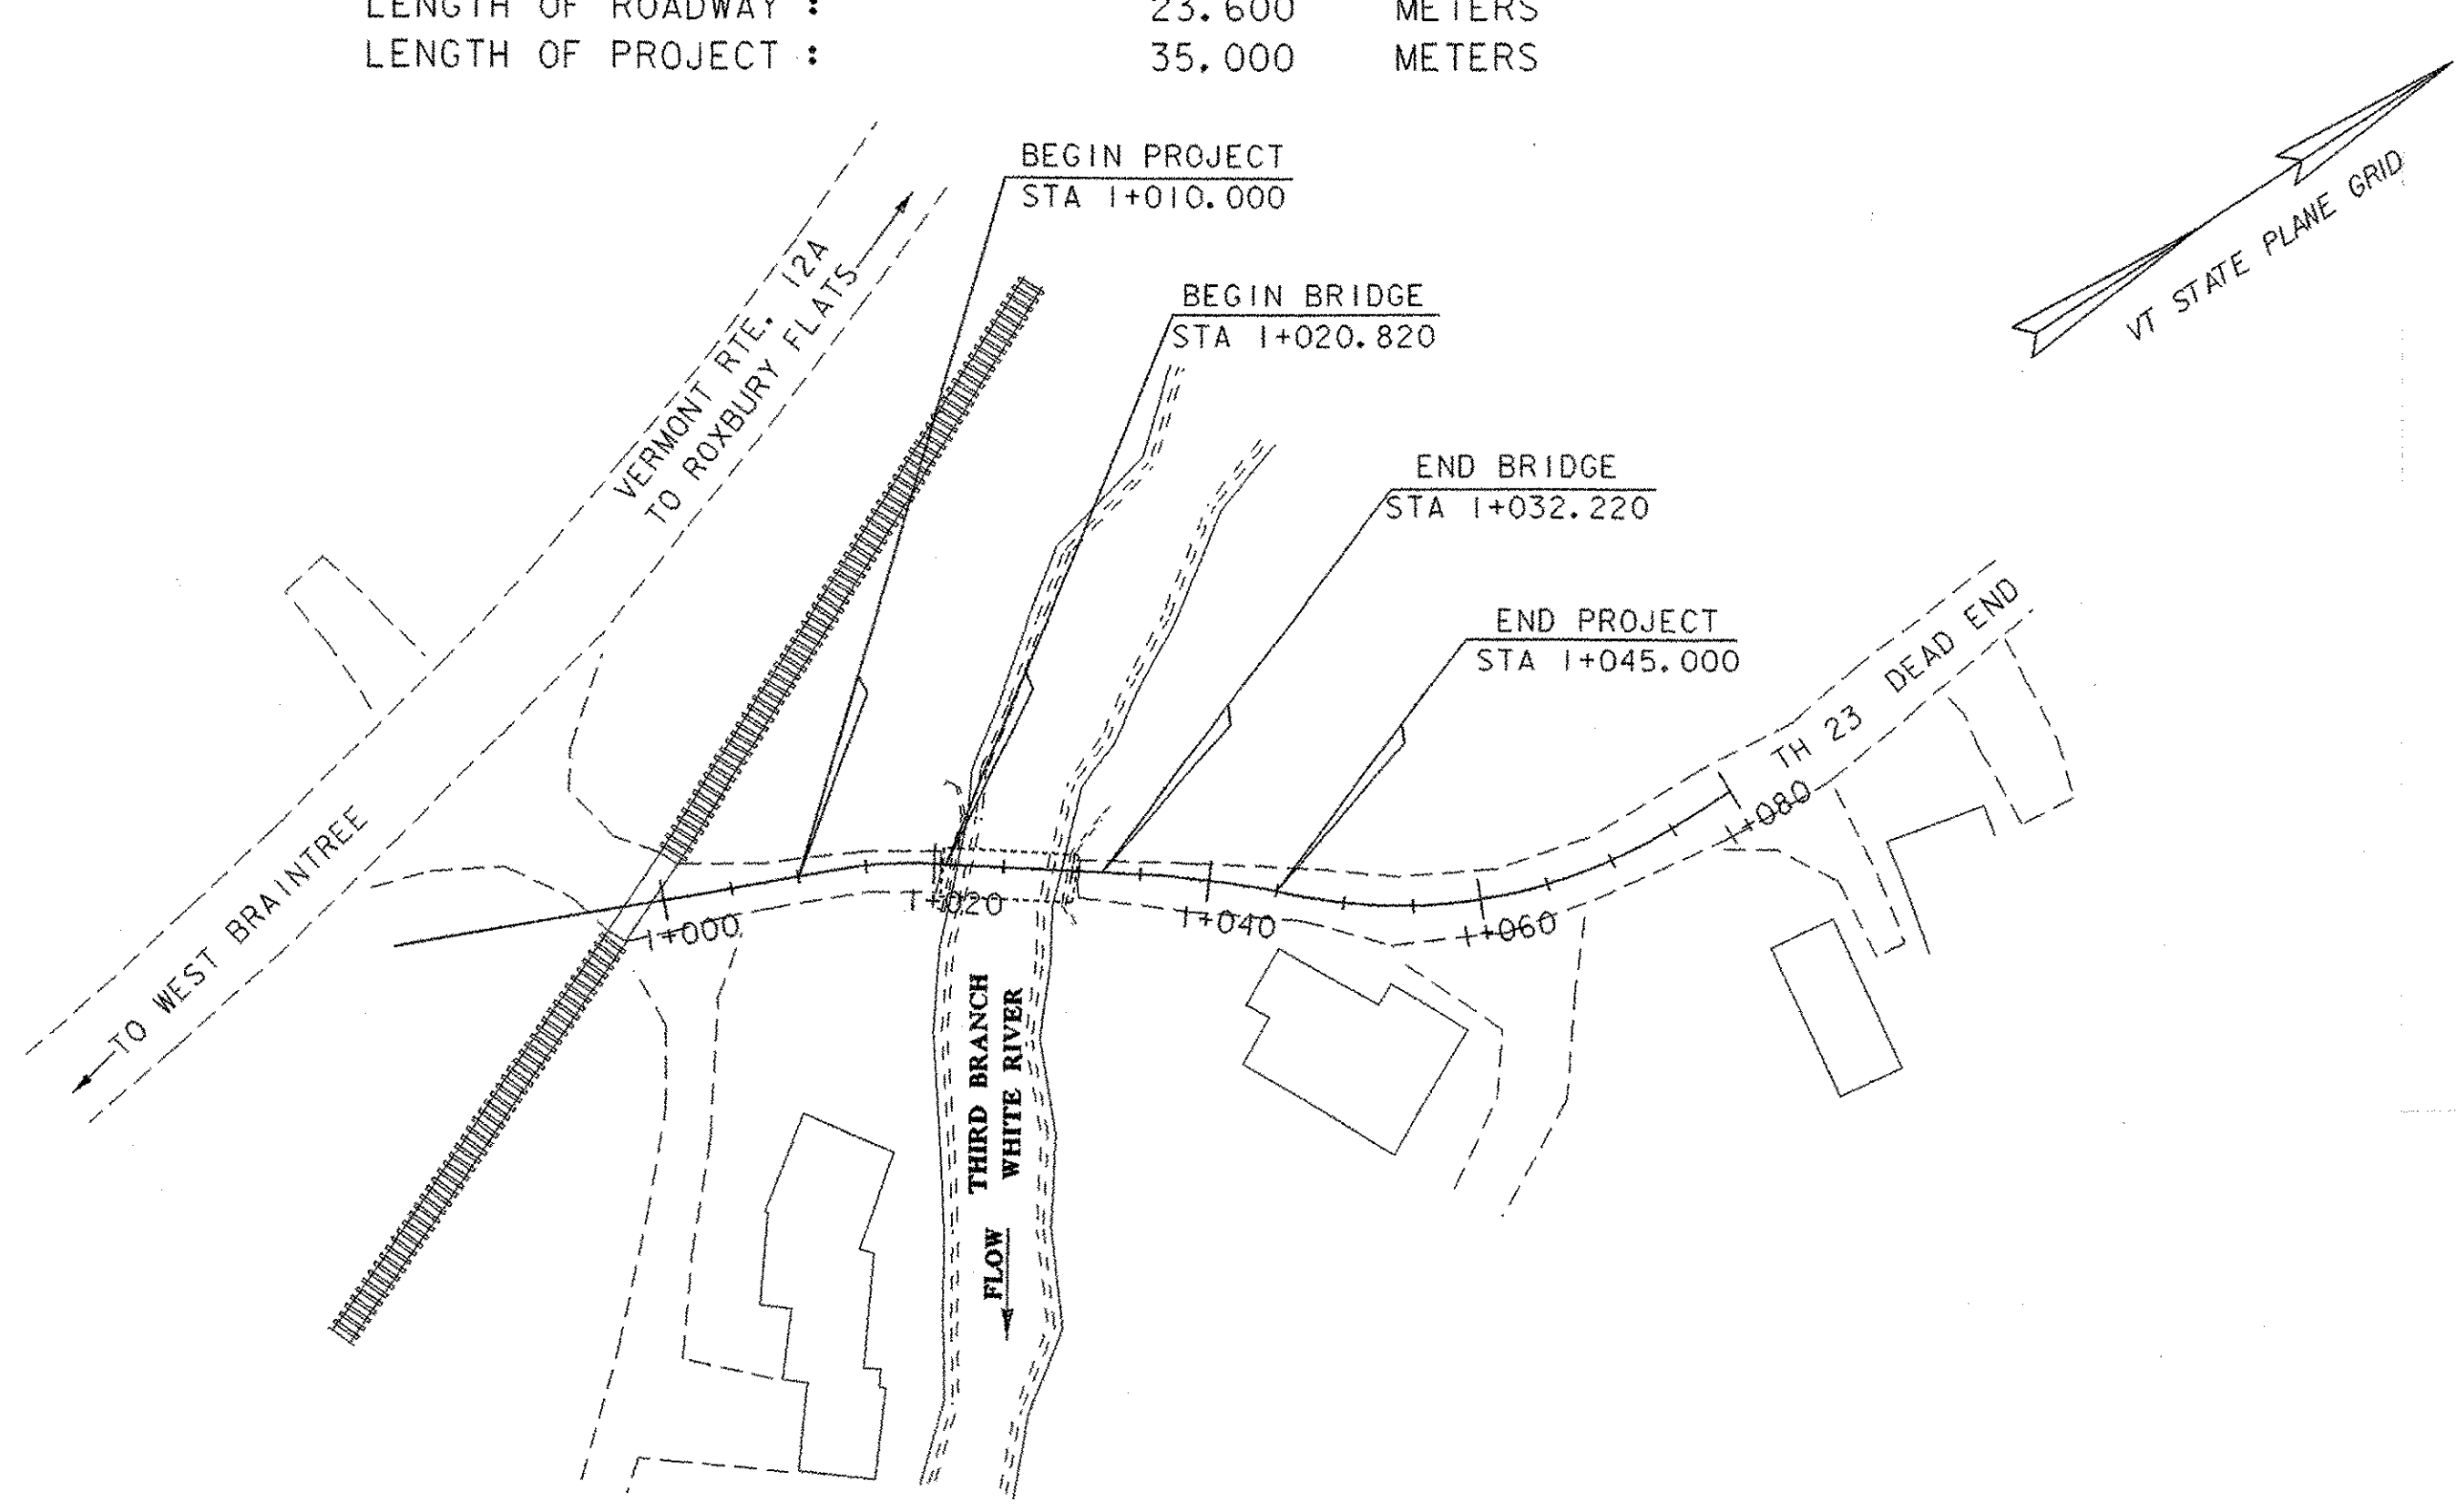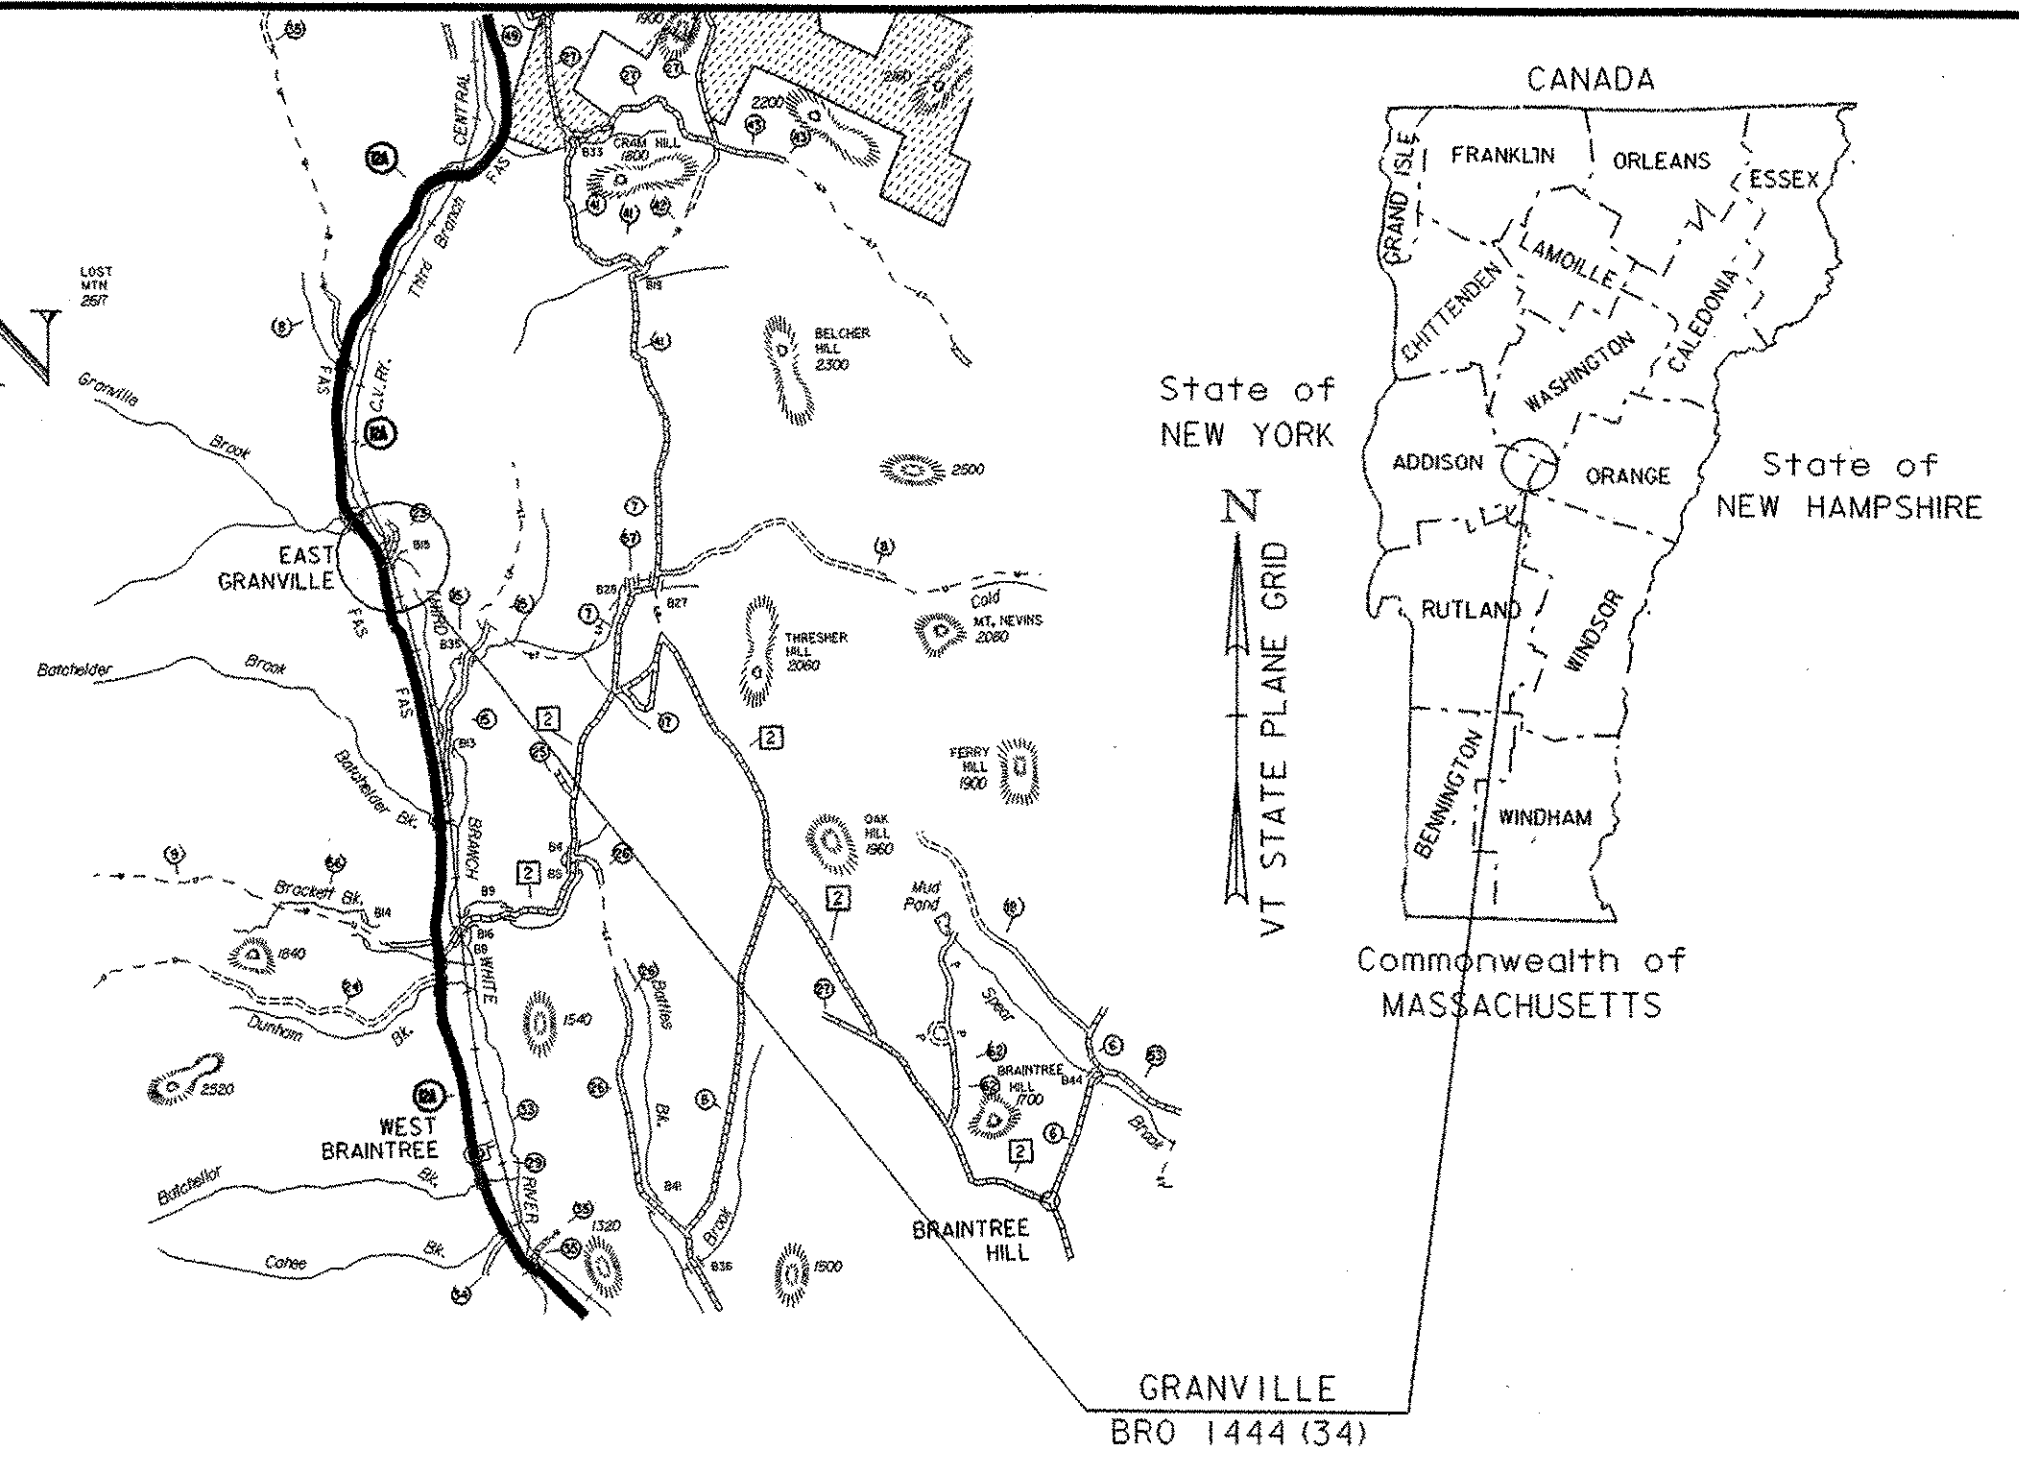

RECORD PLANS	
CONTRACTOR:	MILLER CONSTRUCTION INC. - WINDSOR, VT
RESIDENT ENGINEER:	IAN JENIKE
CONSTRUCTION BEGAN:	APRIL 18, 2007
CONSTRUCTION COMPLETE:	NOVEMBER 30, 2007
RECORD PLANS BY:	IAN JENIKE & C. PIERCE
I HEREBY CERTIFY THAT ALL THE CONSTRUCTION REQUIRED BY THIS SET OF DRAWINGS HAS BEEN ACCOMPLISHED AS INDICATED HEREIN.	
BY:	<i>[Signature]</i> RESIDENT ENGINEER
DATE:	APRIL 14, 2009
NOTE: Any further information concerning final quantities, amounts or other details relative to this project may be found at Central Files in the electronic archives.	

CONVENTIONAL SYMBOLS	
COUNTY LINE	
TOWN LINE	
LIMITS OF ACCESS	
POINT OF ACCESS	
FENCE LINE	
STONE WALL	
TRAVELED WAY	
GUARD RAIL	
RAILROAD	
SURVEY LINE	
CULVERT	
POWER POLE	
TELEPHONE POLE	
TREES	
CONTROL OF ACCESS	
PROPERTY LINE	
R.O.W. TAKING LINE	
SLOPE RIGHTS	
TOP OF CUT	
TOE OF SLOPE	

SURVEYED BY : L. ORVIS  
SURVEYED DATE : 1/96

DATUM  
VERTICAL NAVD 88  
HORIZONTAL NAD 83/92



THESE PLANS ARE SUBJECT TO SUCH ENGINEERING CHANGES AS MAY BE REQUIRED BY THE FEDERAL HIGHWAY ADMINISTRATION OR THE DIRECTOR OF PROGRAM DEVELOPMENT.

CONSTRUCTION IS TO BE CARRIED ON IN ACCORDANCE WITH THESE PLANS AND THE STANDARD SPECIFICATIONS FOR CONSTRUCTION DATED 2001, AS APPROVED BY THE FEDERAL HIGHWAY ADMINISTRATION ON JANUARY 4, 2001 FOR USE ON THIS PROJECT, INCLUDING ALL SUBSEQUENT REVISIONS AND SUCH REVISED SPECIFICATIONS AND SPECIAL PROVISIONS AS ARE INCORPORATED IN THESE PLANS.

**Metric**

UNLESS NOTED OTHERWISE  
STATIONS ARE IN KILOMETERS  
ELEVATIONS ARE IN METERS  
DIMENSIONS ARE IN MILLIMETERS

DIRECTOR OF PROGRAM DEVELOPMENT	
APPROVED:	<i>[Signature]</i> DATE 2-6-06
PROJECT MANAGER : C.P. WILLIAMS	
PROJECT NAME : GRANVILLE	
PROJECT NUMBER : BRO 1444 (34)	
SHEET 1 OF 39 SHEETS	