



### Profile TH 23

NOTE:  
 GRADES SHOWN TO THE NEAREST HUNDREDTH ARE EXISTING GROUND ALONG C.  
 GRADES SHOWN TO THE NEAREST THOUSANDTH ARE FINISH GRADE ALONG C.

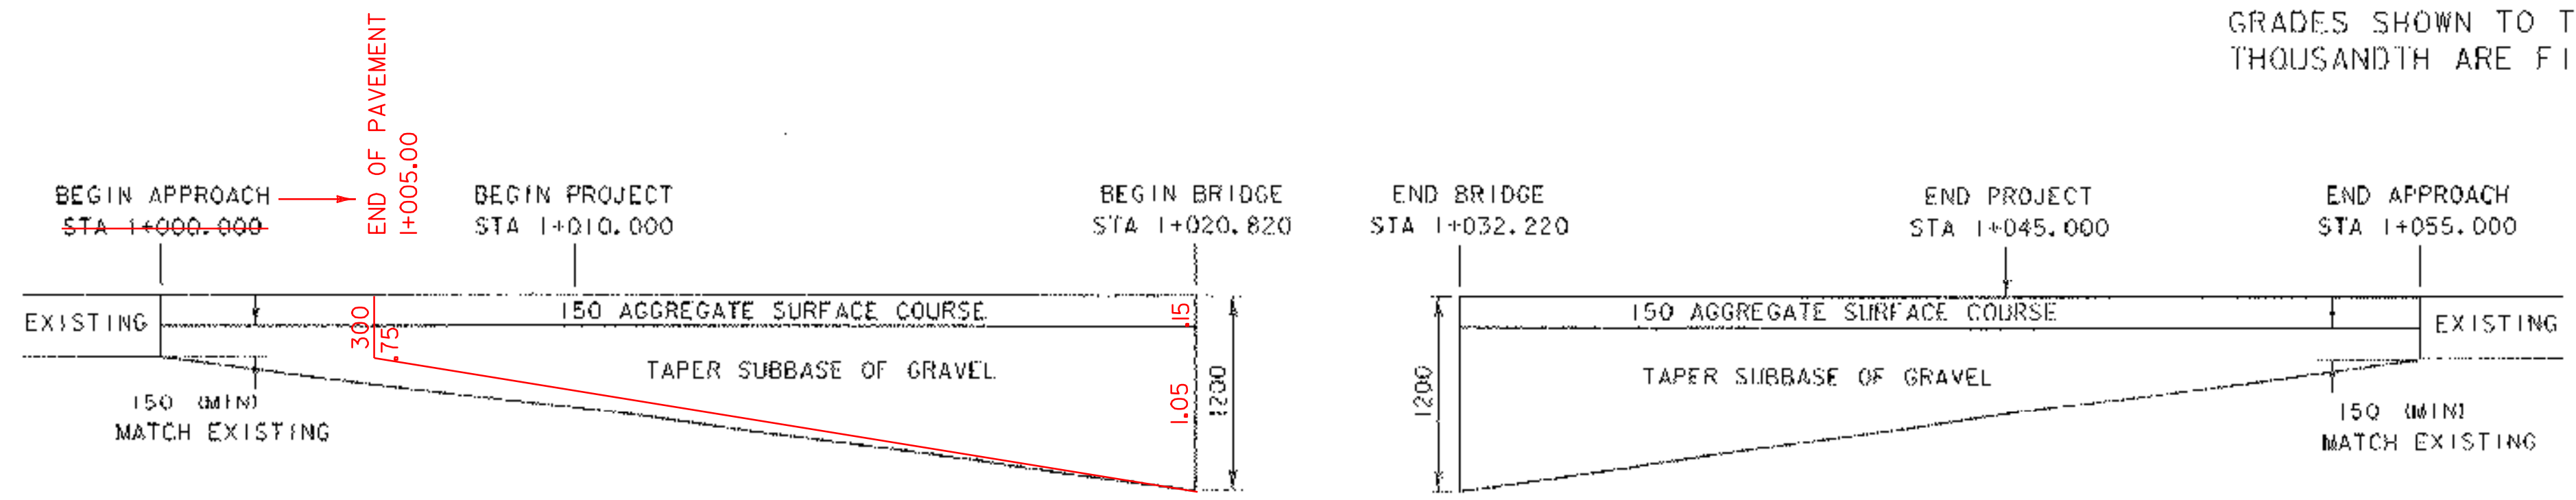

SUBBASE TRANSITION  
 NTS

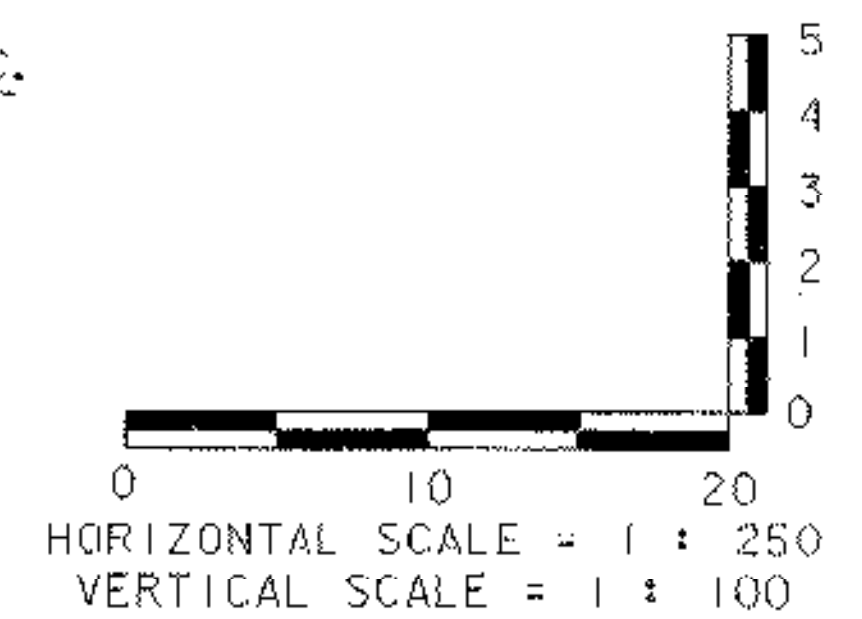

DATUM	
VERTICAL	NAVD 88
HORIZONTAL	NAD 83/92

PROJECT: GRANVILLE	PROJECT NO.: BRO 1444 (34)
DESIGN FILE NAME: 94j100/structures/sj100pro.dgn	PLOT DATE: 03-MAR-2006
IPARM FILE NAME: 94j100pro.i	SURVEY DATE: 1/96
SURVEYED BY: L. ORVIS	DRAWN BY: KMH
SQUAD LEADER: C. P. WILLIAMS	SHEET: 8 OF 39
PROFILE TH 23	