


PLAN

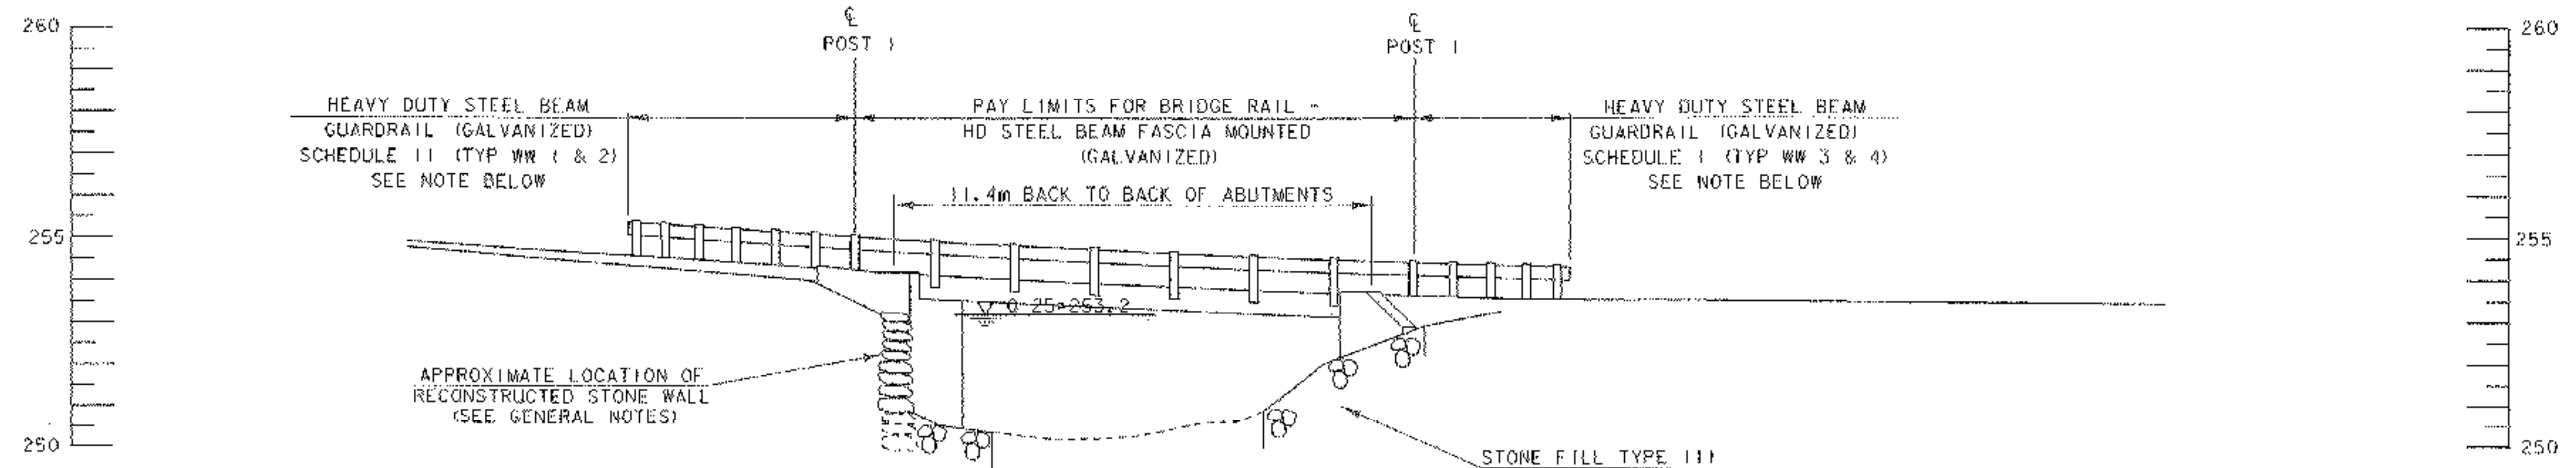

ELEVATION AT DOWNSTREAM FASCIA

NOTE:
POST SPACING FOR ALL APPROACH RAILING AS SHOWN @ 952.5 mm

PROJECT: GRANVILLE	PROJECT NO. # BRO 1444 (34)
DESIGN FILE NAME: 94J100/structures/sj100pe.dgn	PLOT DATE: 03-MAR-2006
IPARM FILE NAME: sj100pe.i	SURVEY DATE: 1/96
SURVEYED BY: L. ORVIS	DRAWN BY: D. G. BASSETT
SQUAD LEADER: C. P. WILLIAMS	SHEET: 14 OF 39
PLAN AND ELEVATION	

DATUM	
VERTICAL	NAVD 88
HORIZONTAL	NAD 83/92