

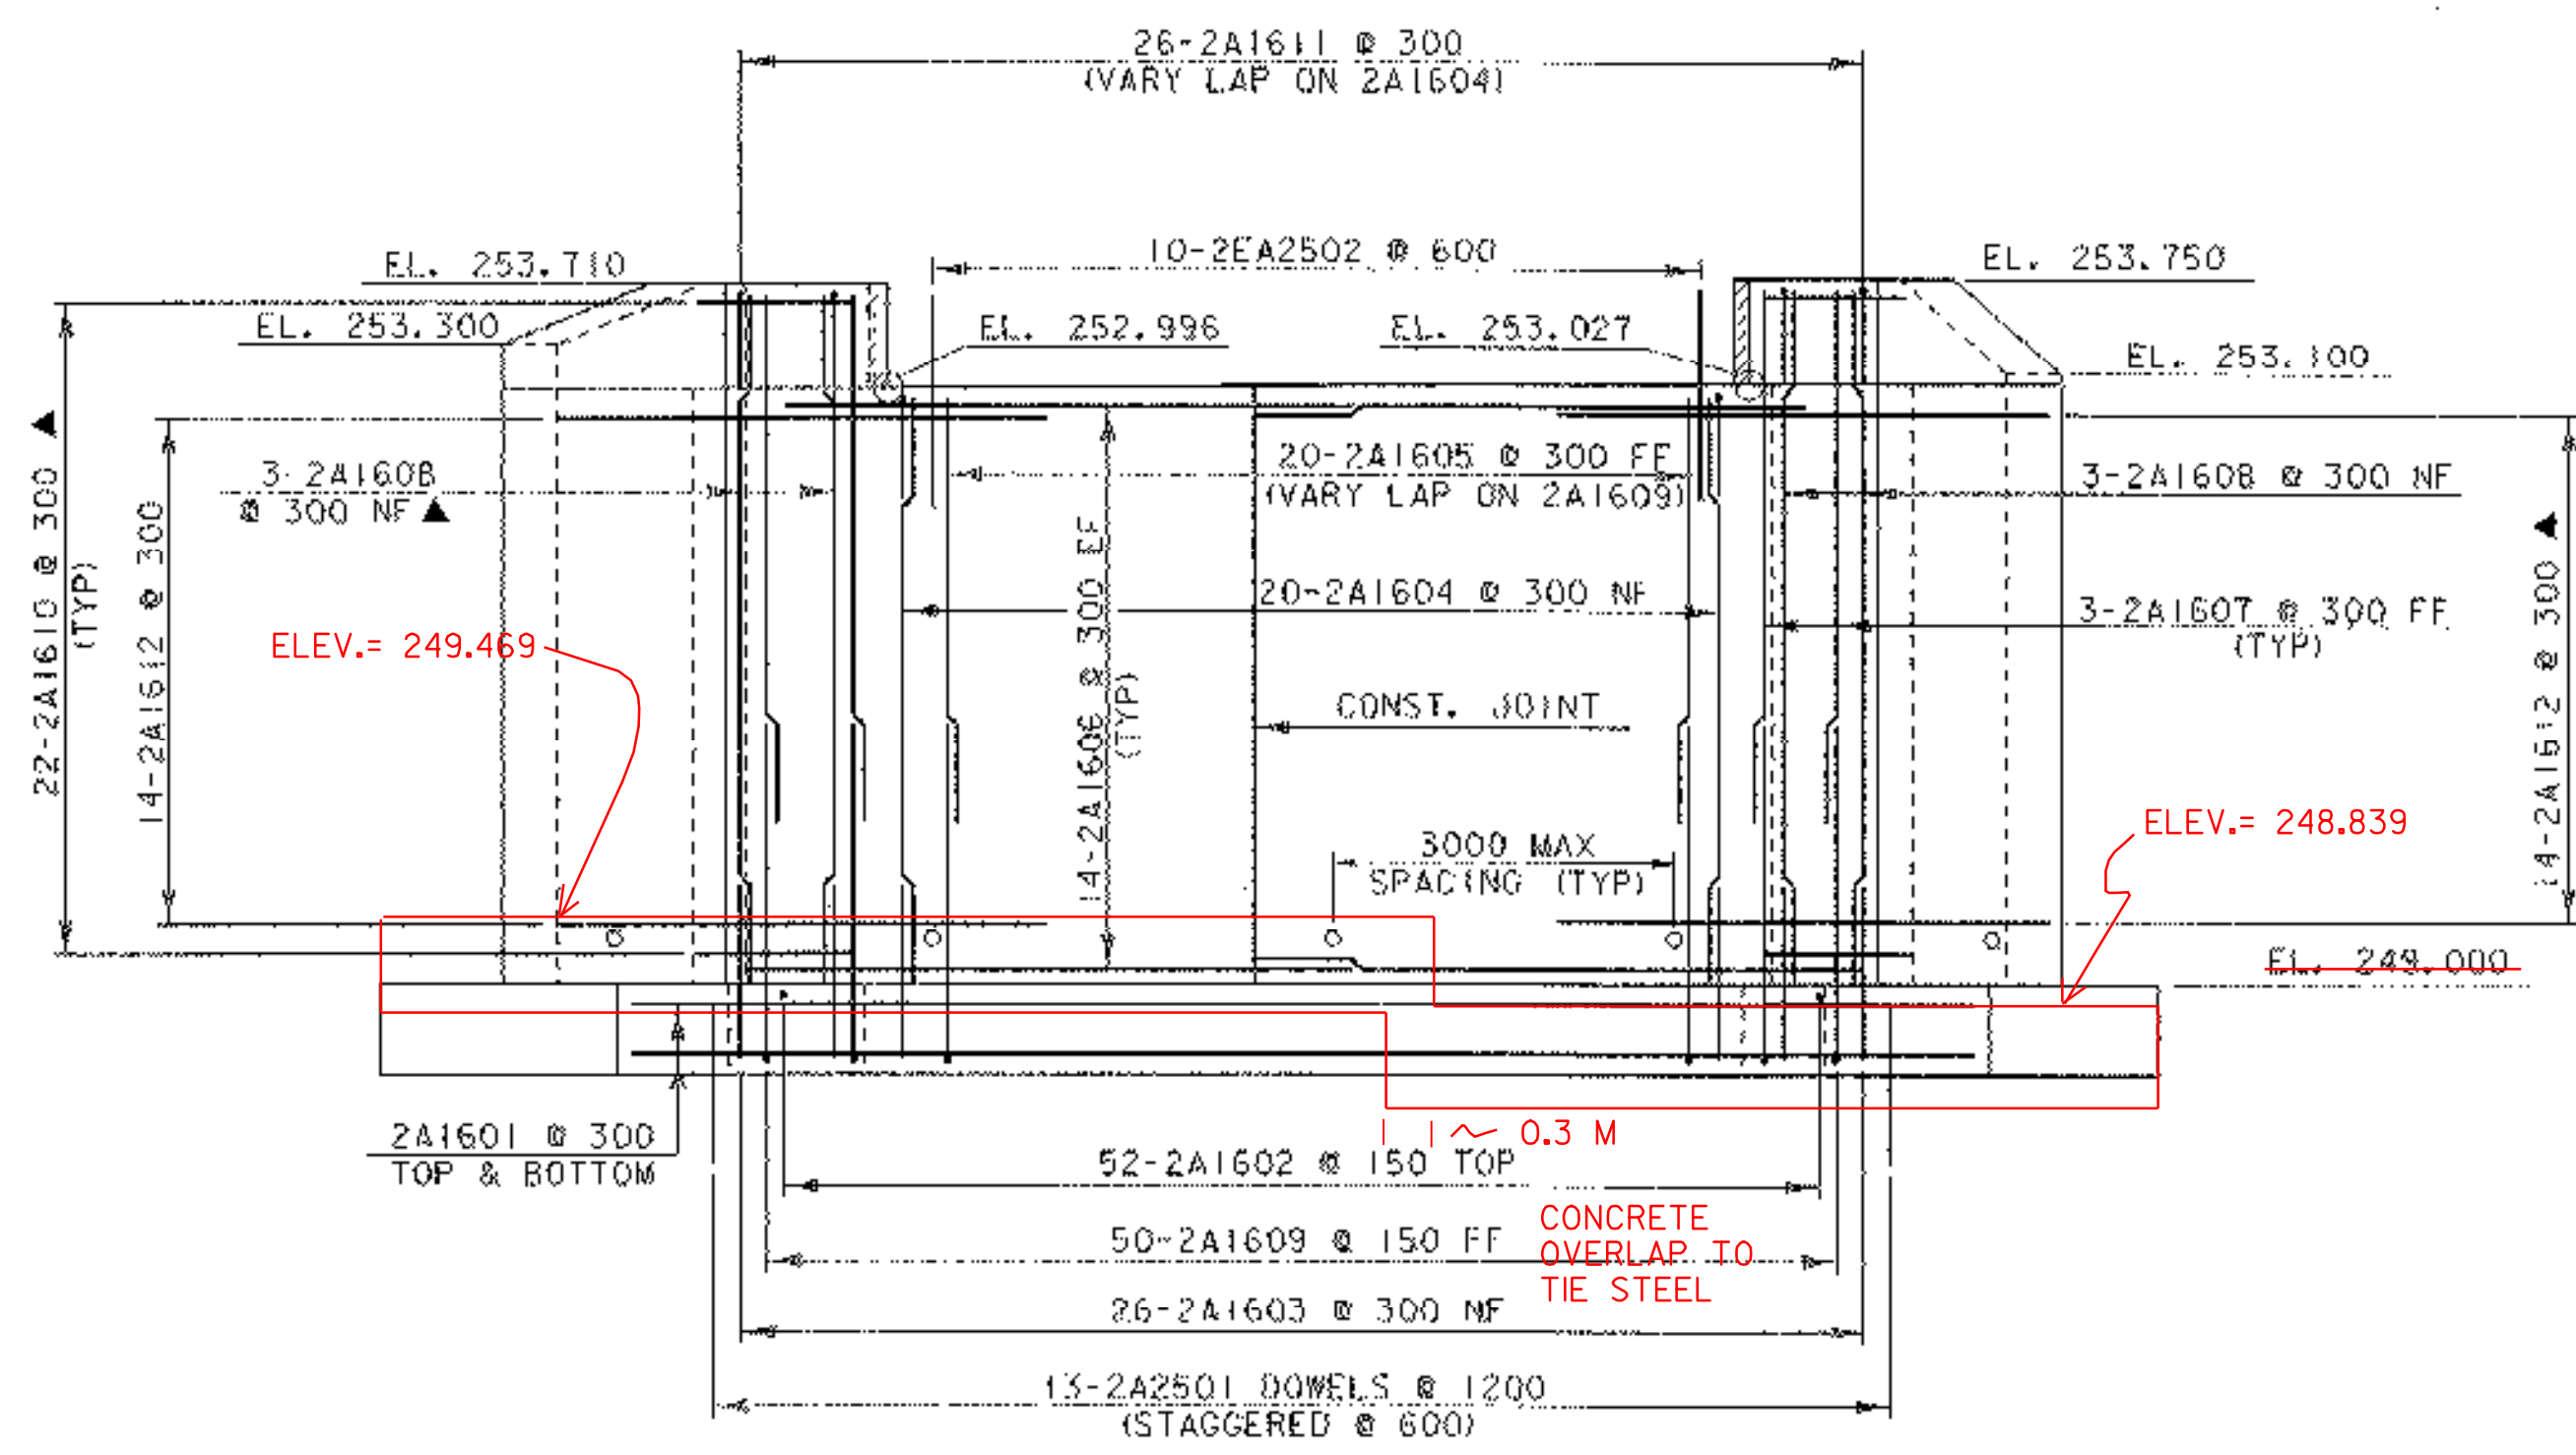
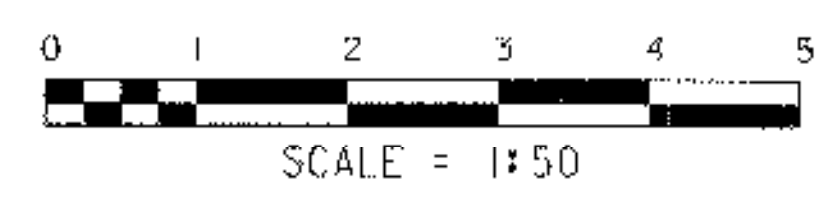


ABUTMENT NO. 2 PLAN

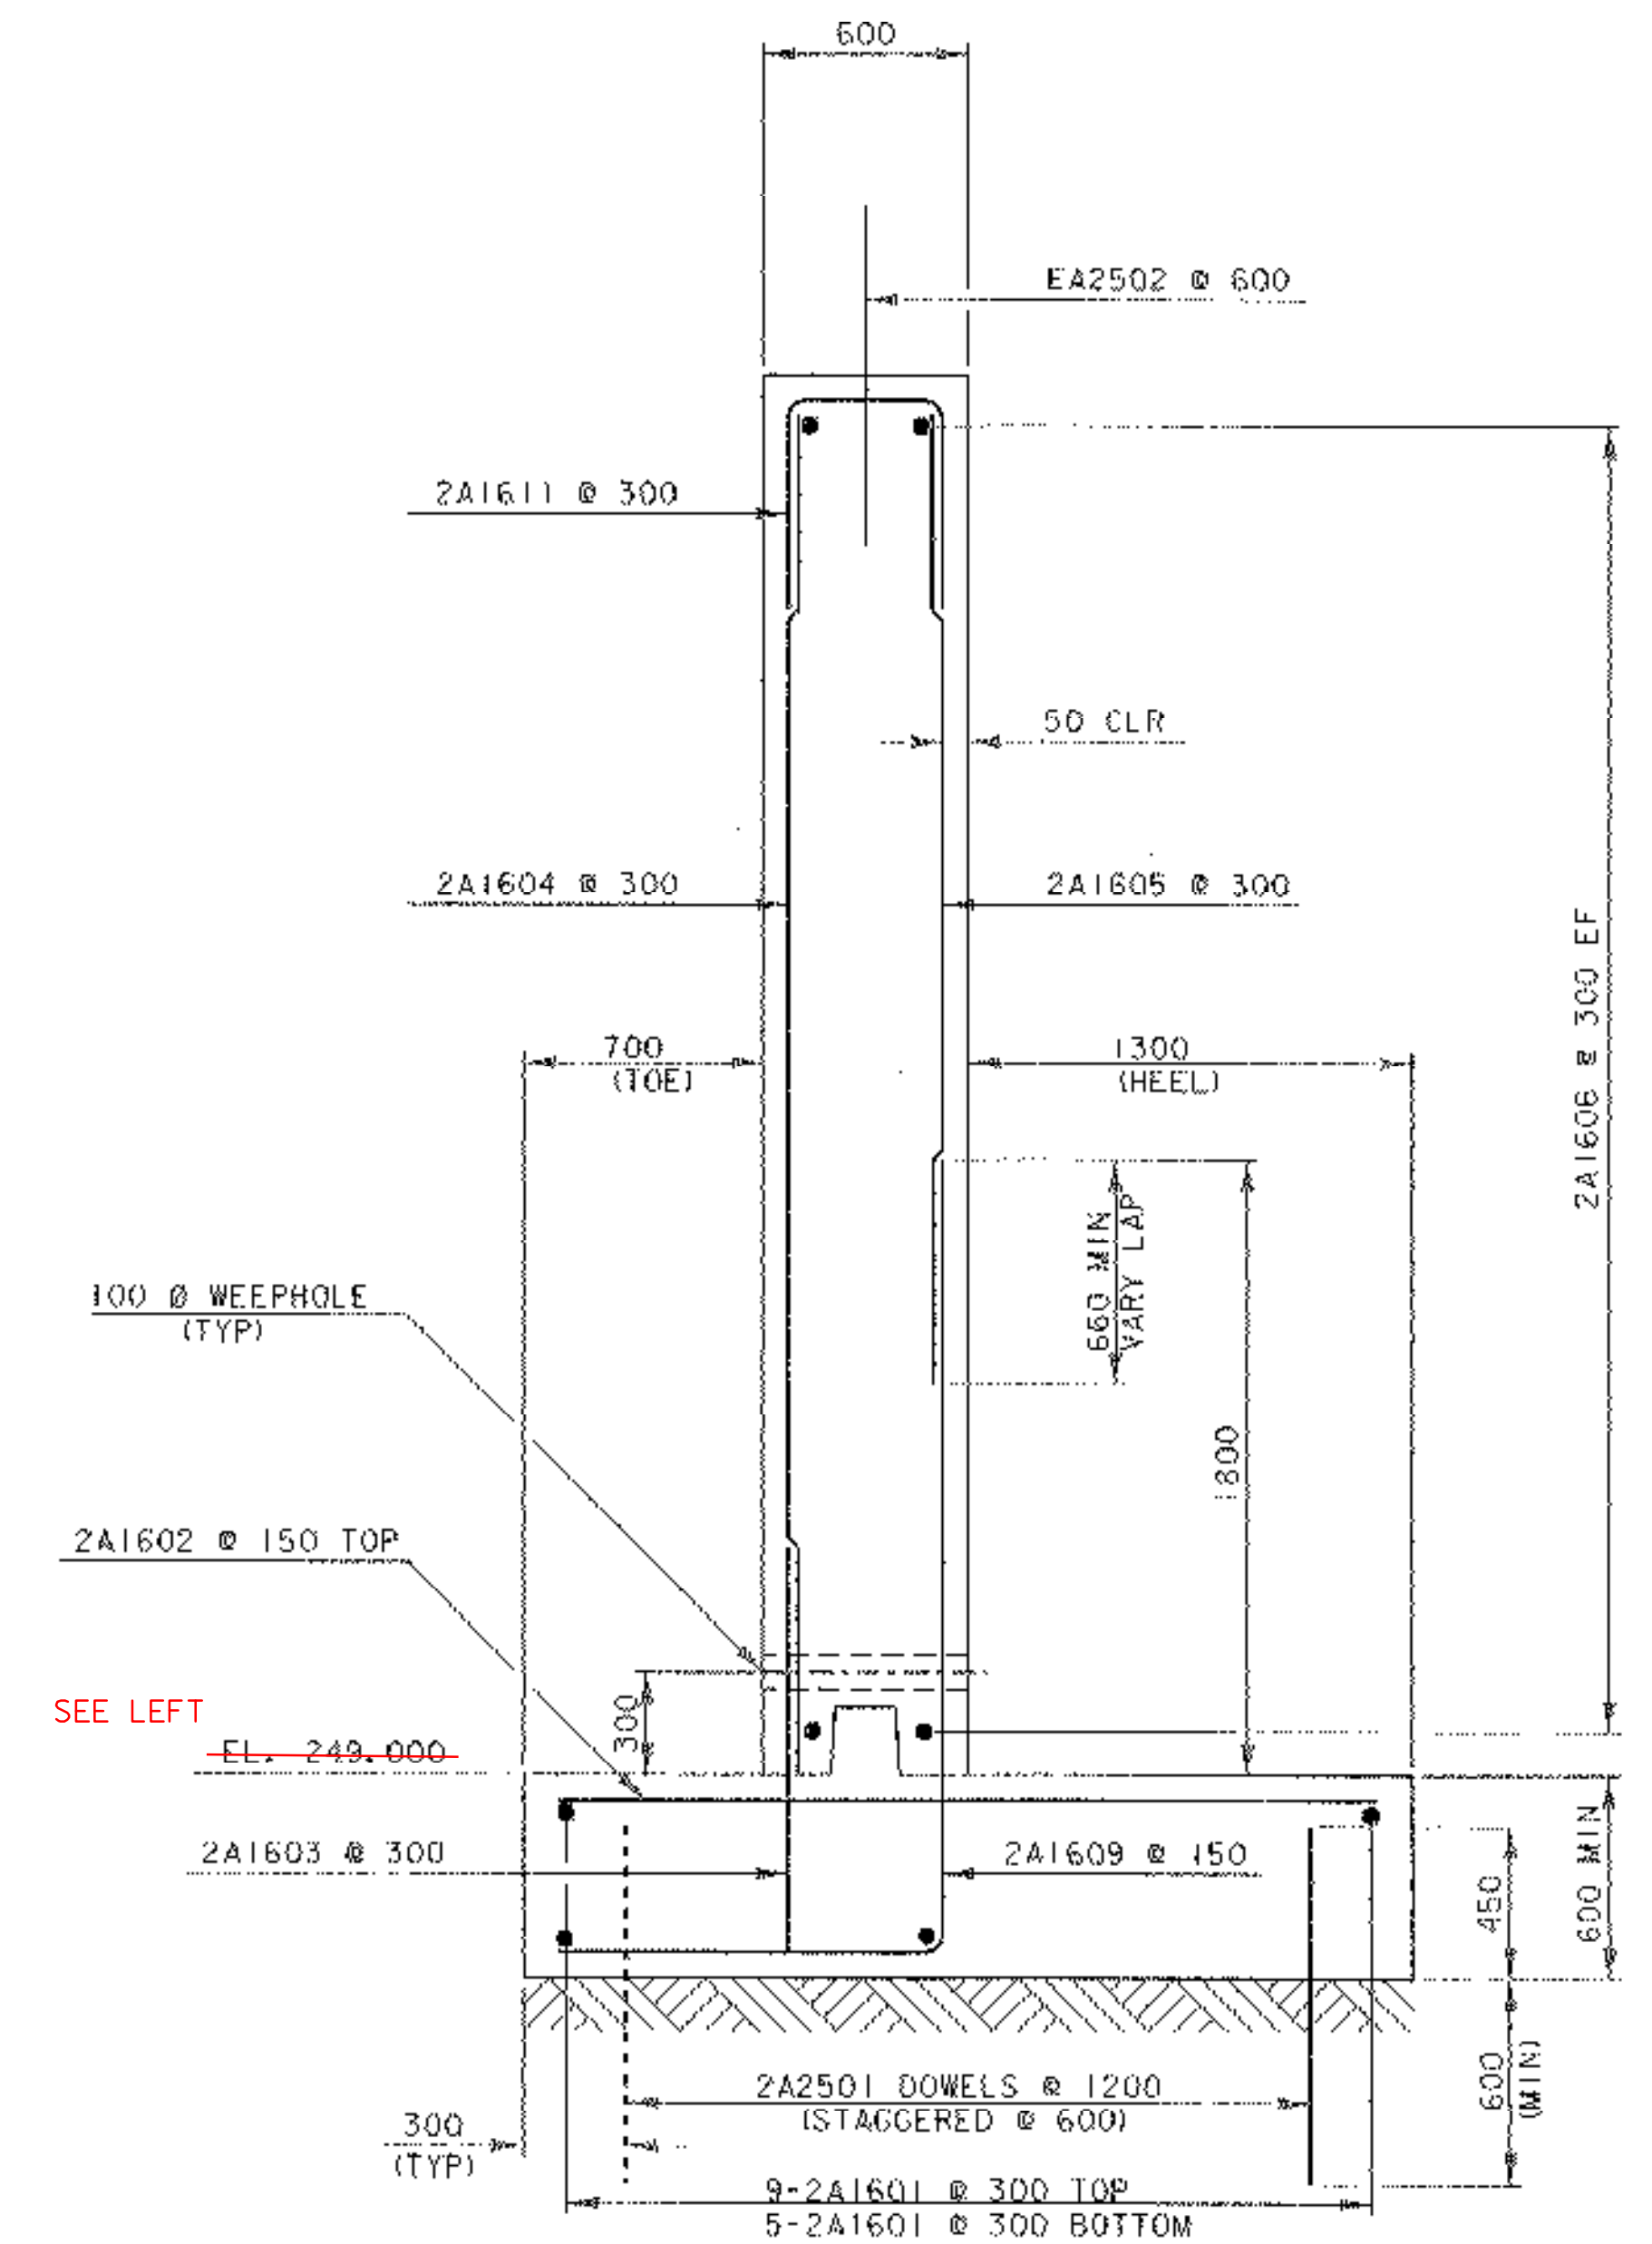

ABUTMENT NO. 2 ELEVATION

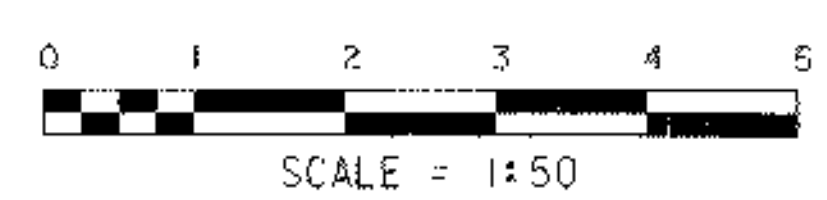

ABUTMENT NO. 2 TYPICAL SECTION



NOTE:
 NF = NEAR FACE
 FF = FAR FACE
 EF = EACH FACE
 ▲ = CUT TO FIT IN FIELD
 75 CLR. UNLESS OTHERWISE SPECIFIED ON THE PLANS.
 ALL LAPS 660 UNLESS OTHERWISE SPECIFIED ON THE PLANS.

PROJECT: GRANVILLE	PROJECT NO.: BRO 1444 (34)
DESIGN FILE NAME: 94j100/structures/sj100sub.dgn	PLOT DATE: 03-MAR-2006
IPARM FILE NAME: sj100ab2.i	DRAWN BY: N. WARR
DESIGNED BY: N. WARR	CHECKED BY: K. HIGGINS
SQUAD LEADER: C.P. WILLIAMS	SHEET: 18 OF 39
ABUTMENT NO. 2 DETAILS	