


EXISTING BRIDGE DATA
 6 STEEL BEAMS
 TIMBER DECK
 SPAN LENGTH = 10.7 m
 ROADWAY WIDTH = 3.5 m
 DECK WIDTH = 3.7 m

EXISTING CONDITIONS

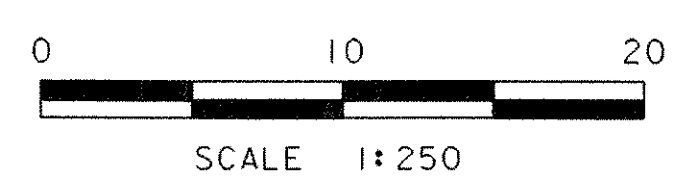

DATUM	
VERTICAL	NAVD 88
HORIZONTAL	NAD 83/92

PROJECT: GRANVILLE	PROJECT NO.: BRO 1444 (34)
DESIGN FILE NAME: 94j100/structures/sj100bdr ecs.dgn	PLOT DATE: 03-MAR-2006
IPARM FILE NAME: sj100excond.i	SURVEY DATE: 1/96
SURVEYED BY: L. ORVIS	DRAWN BY: M.FESSEL
SQUAD LEADER: C. P. WILLIAMS	EXISTING CONDITIONS
	SHEET: 25 OF 39