



STA. 2+027.000 RT (ABUT. #2)
 END STONE FILL TYPE III
 END GRUBBING MATERIAL
 END GEOTEXTILE UNDER STONE FILL
 END UNCLASSIFIED CHANNEL EXCAVATION

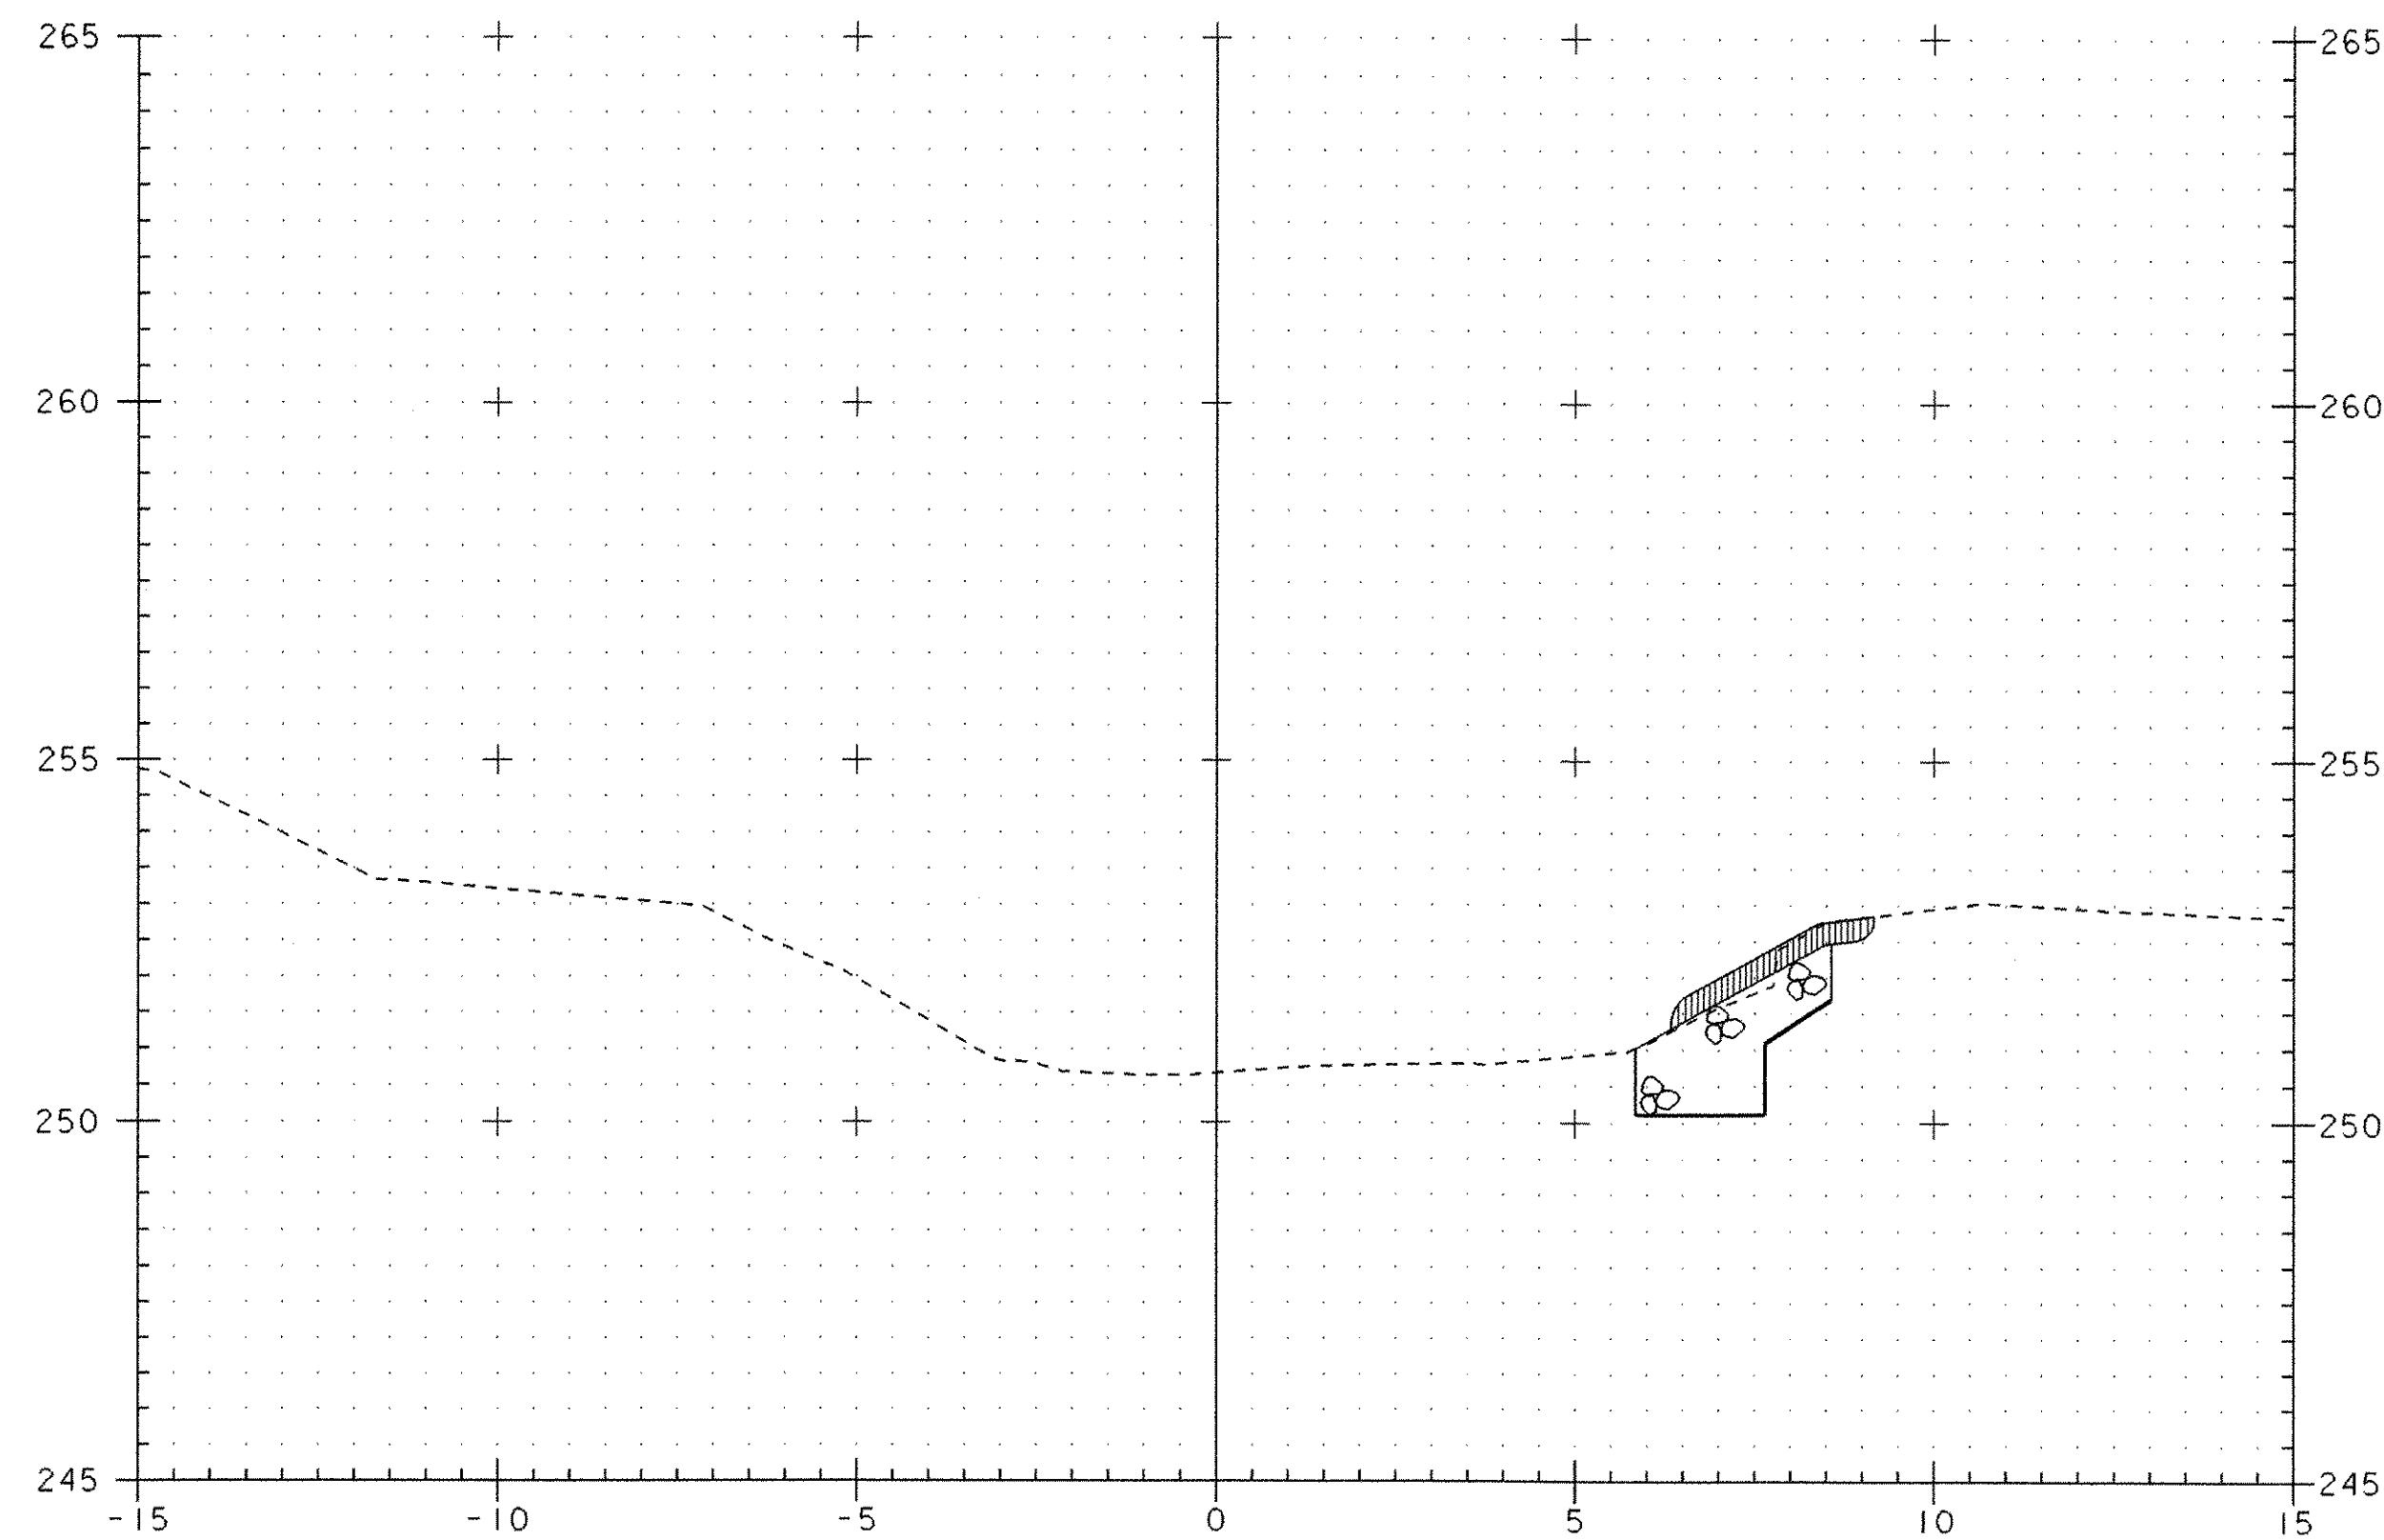


STA. 2+024.500 LT (ABUT #1)
 END STONE FILL TYPE III
 END GRUBBING MATERIAL
 END GEOTEXTILE UNDER STONE FILL
 END UNCLASSIFIED CHANNEL EXCAVATION

2+025

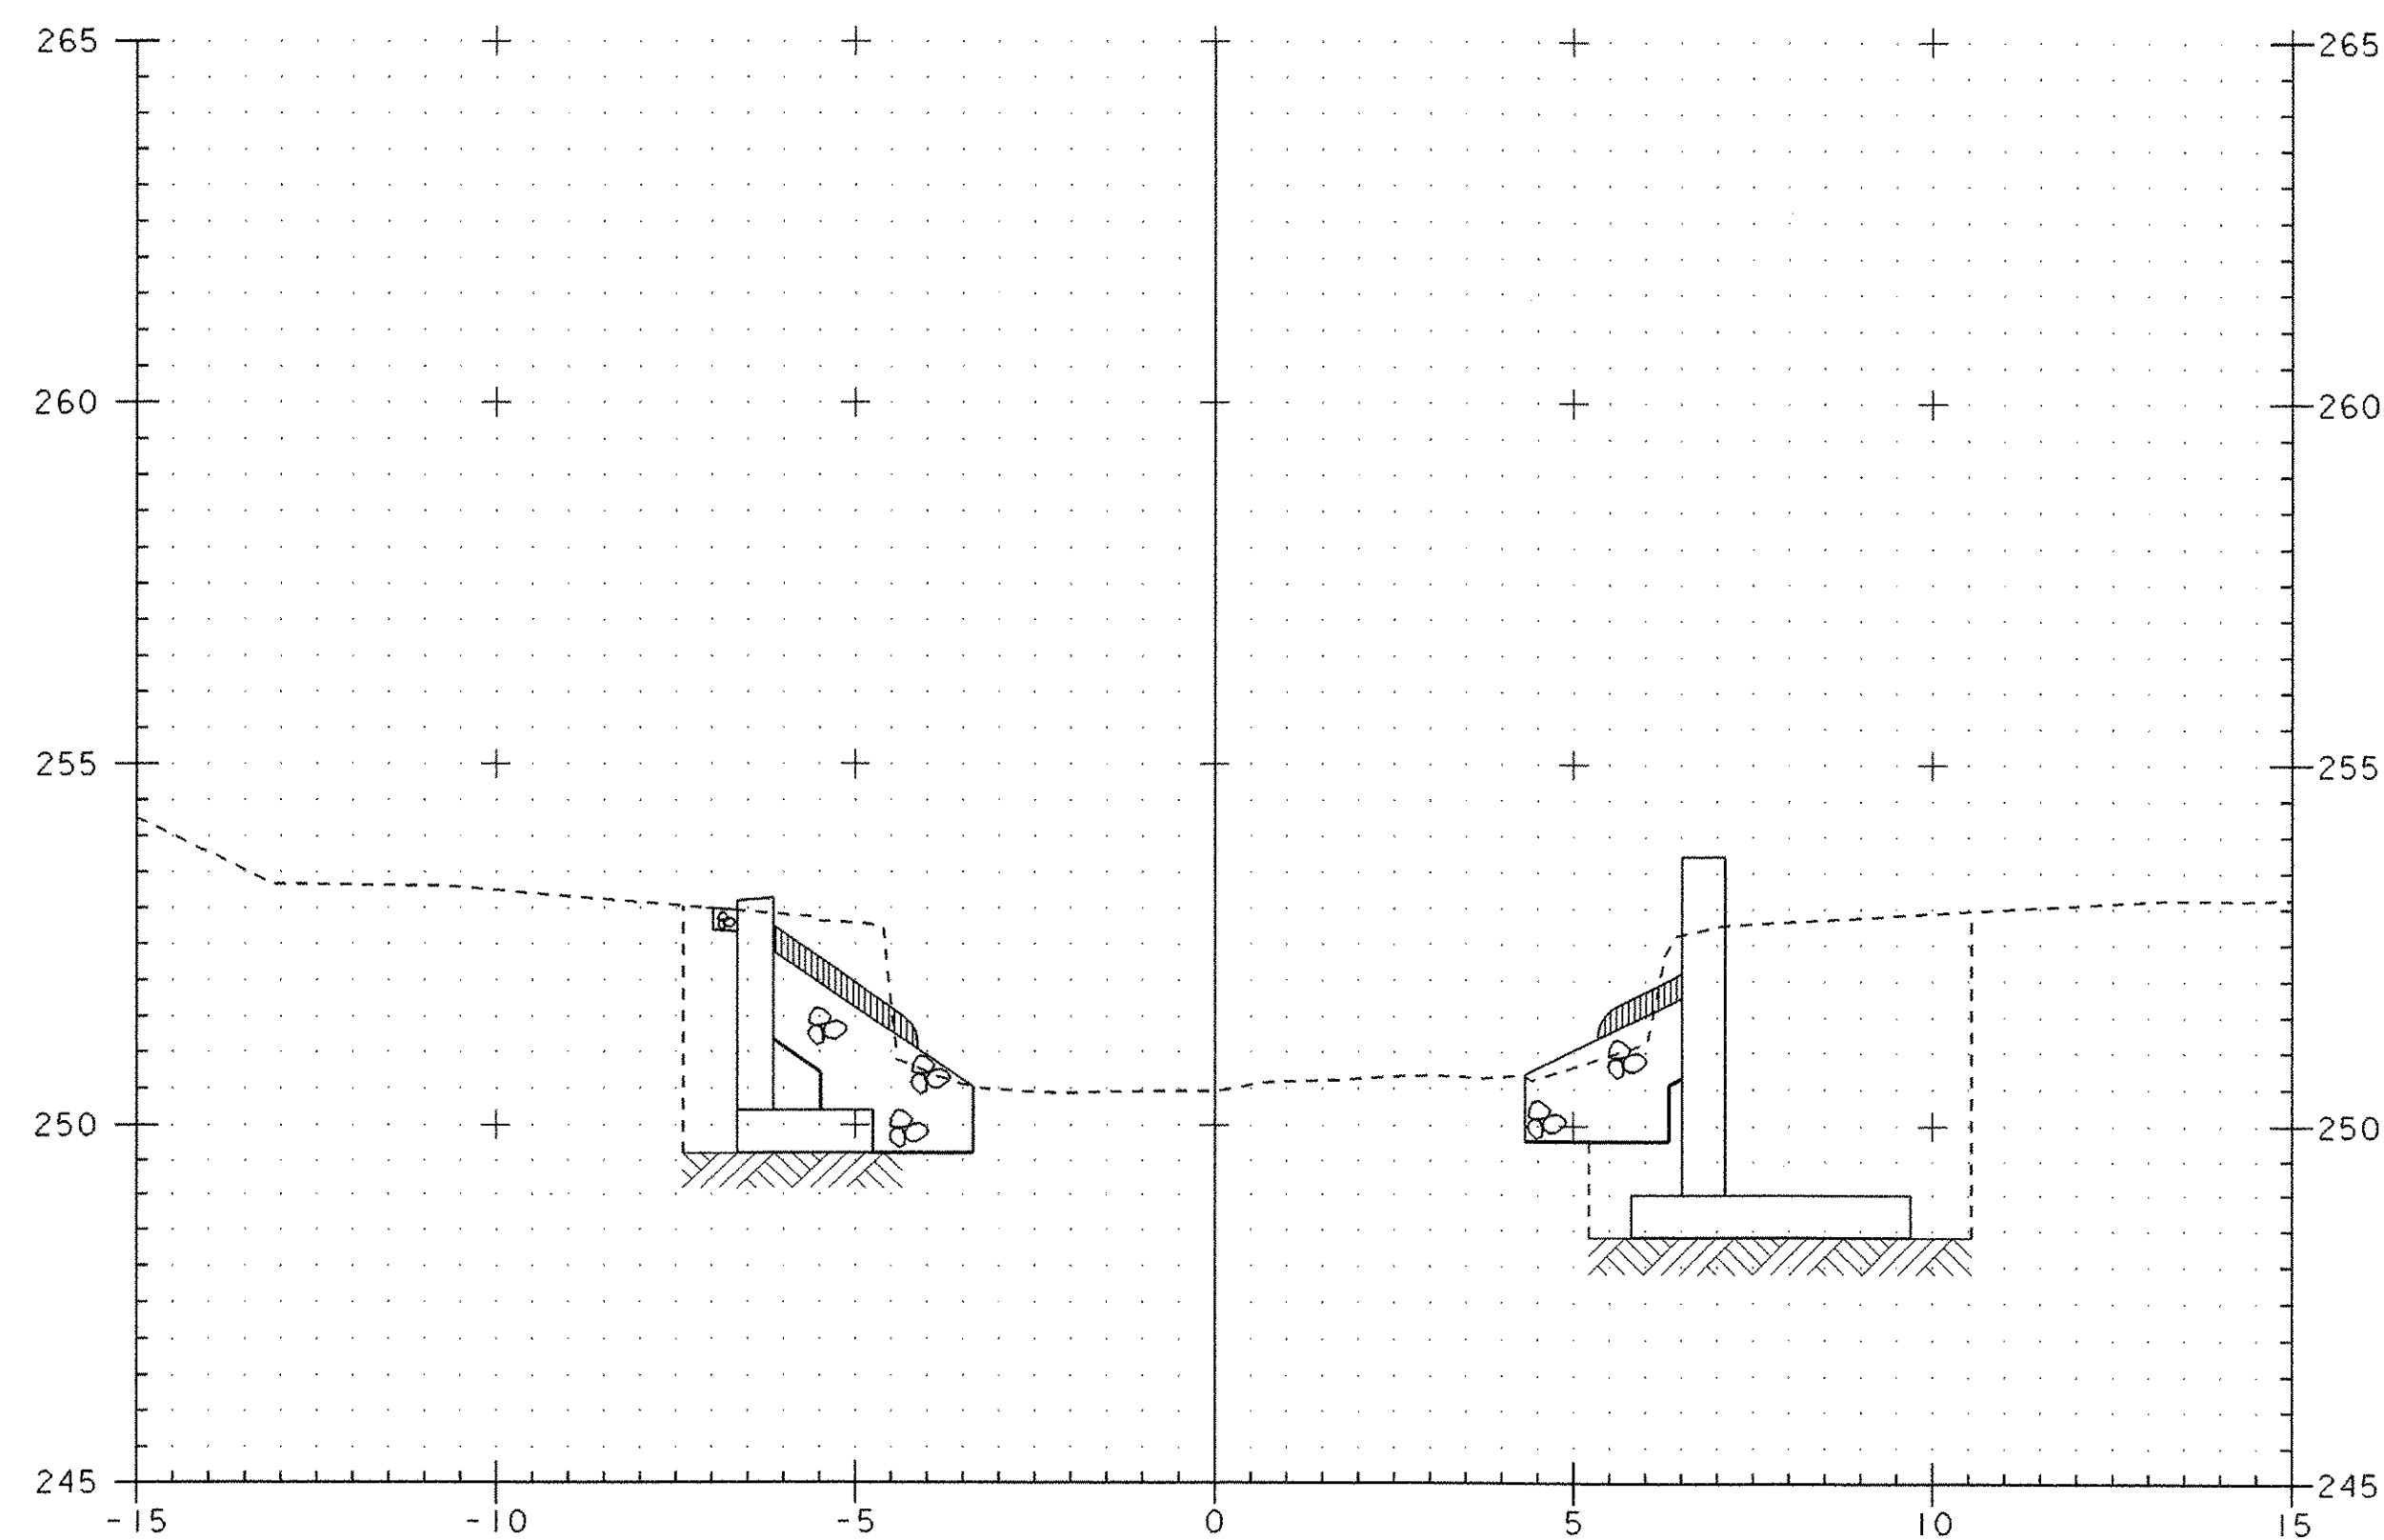

STA. 2+017.400 LT (ABUT #1)
 BEGIN GRUBBING MATERIAL

2+020

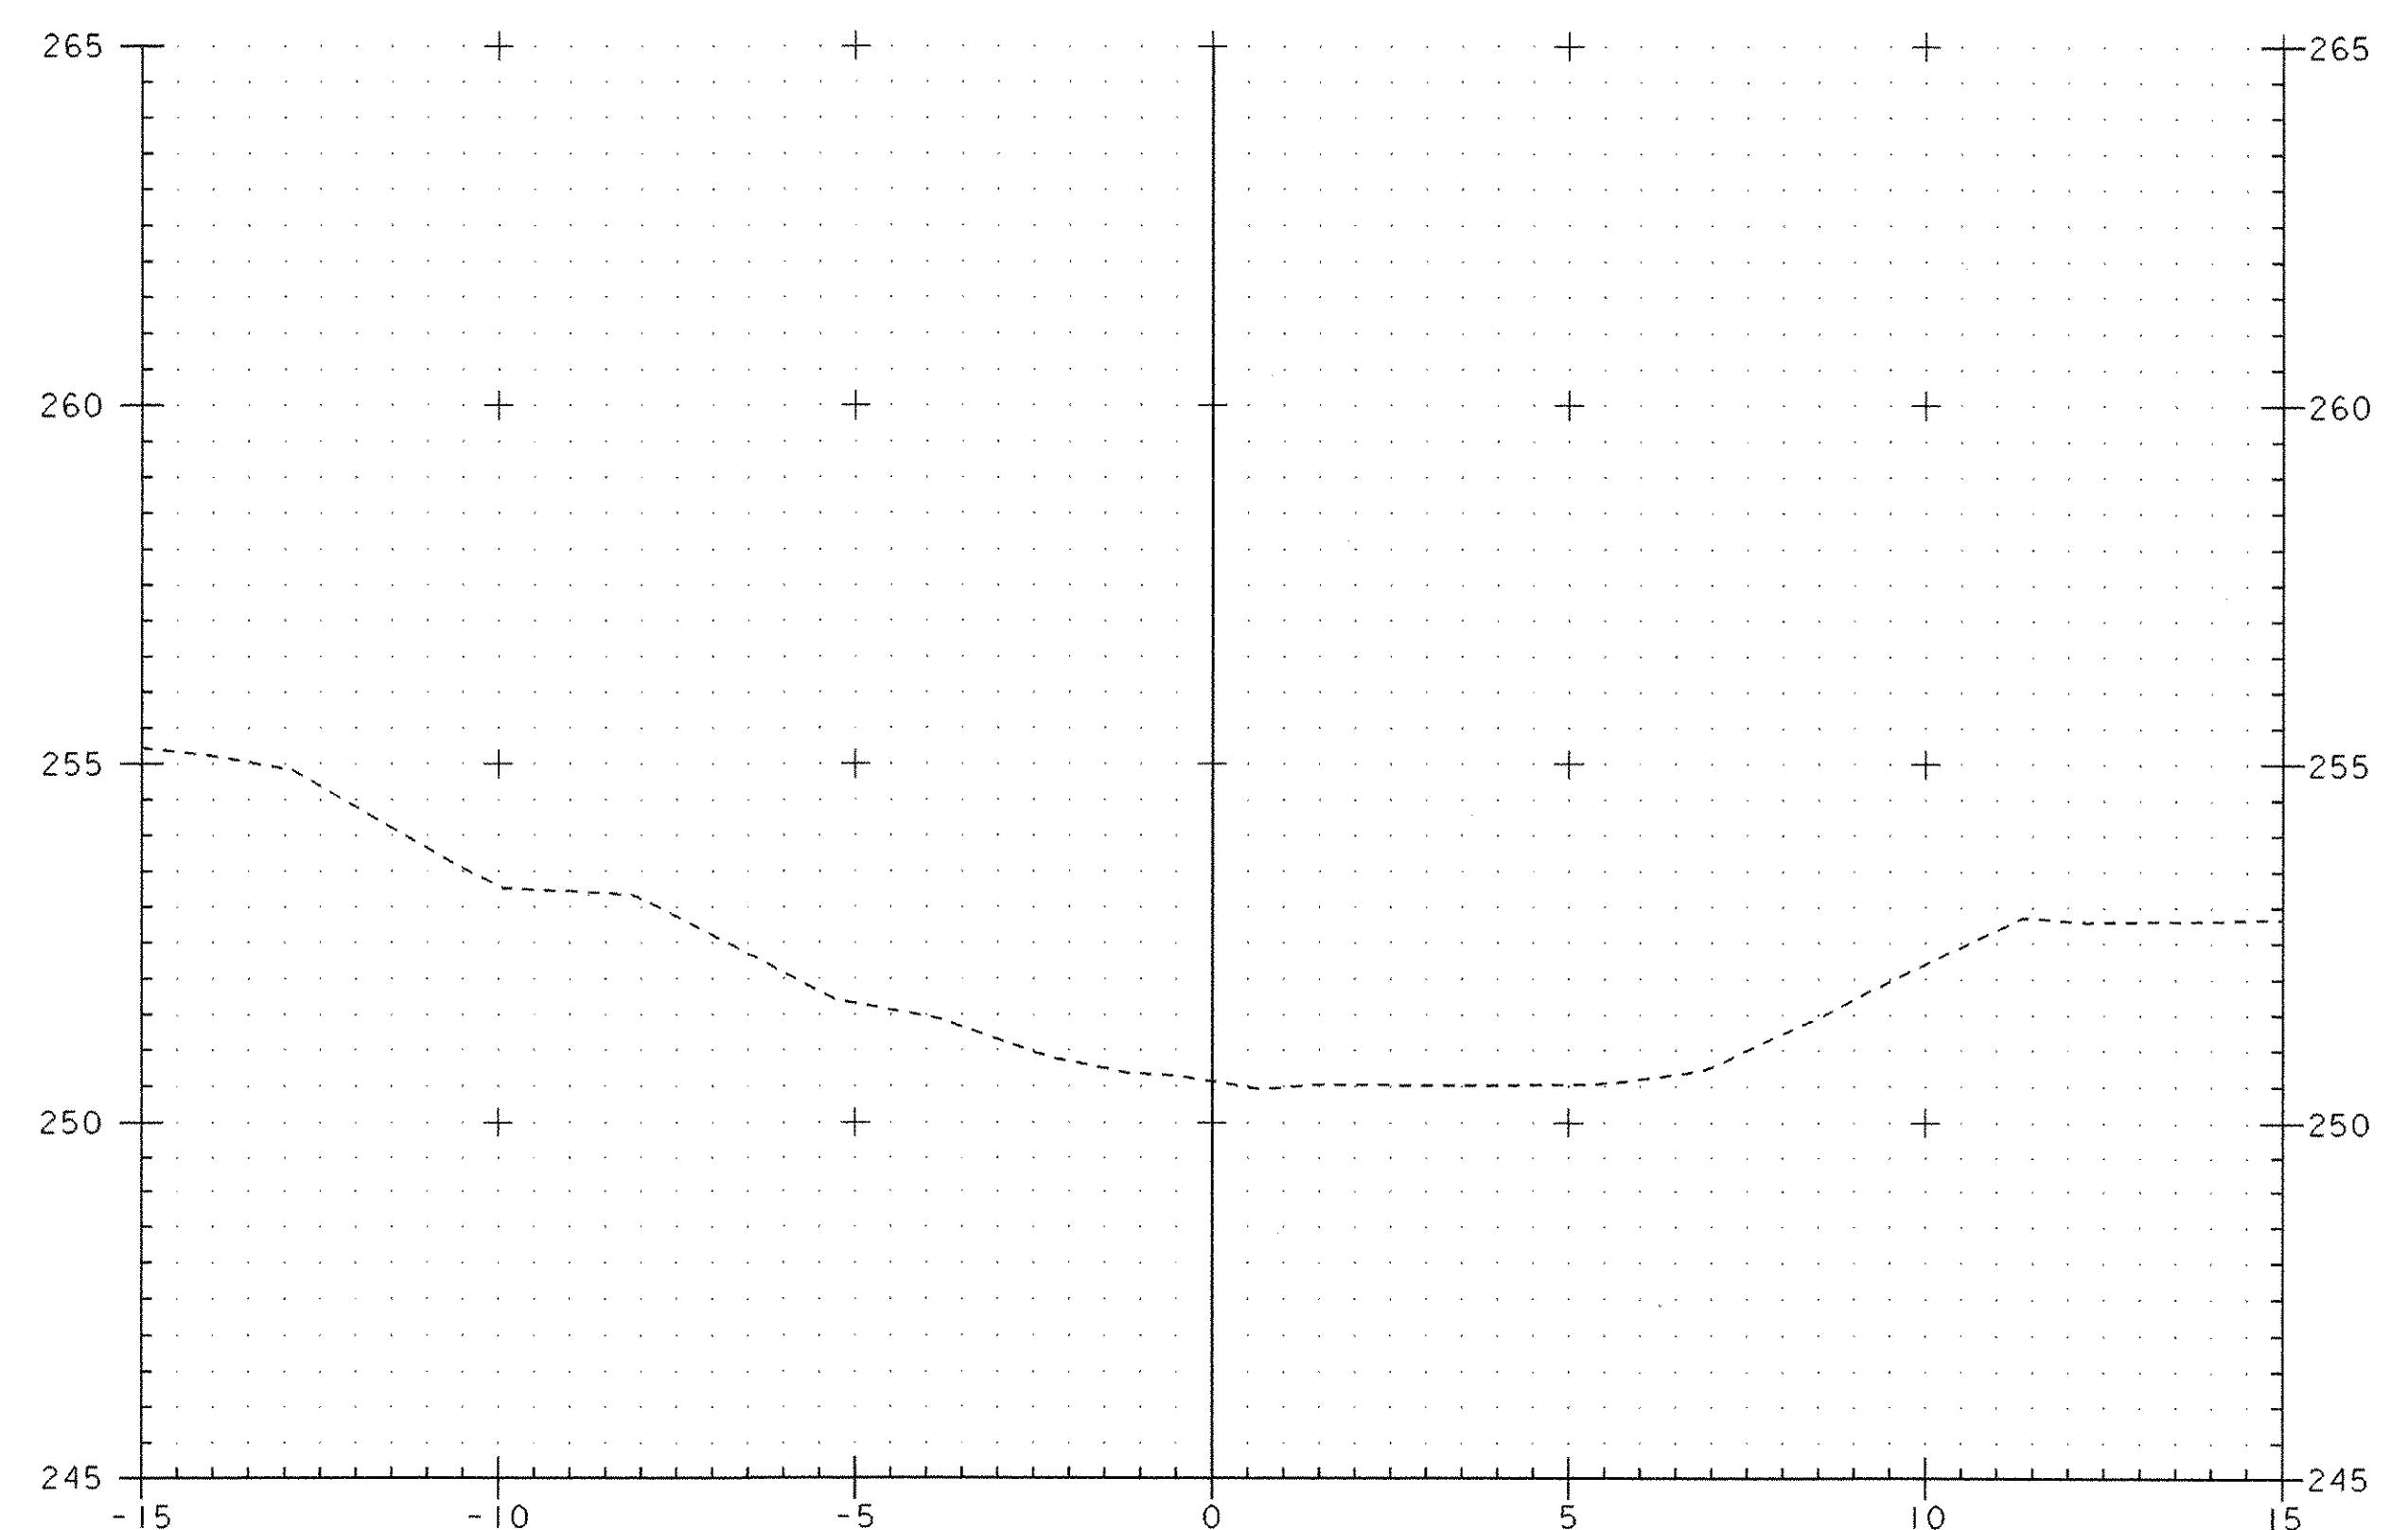

2+030



PROJECT: GRANVILLE	PROJECT NO.: BRO 1444 (34)
DESIGN FILE NAME: 94j100/structures/sj100xsl.dgn	PLOT DATE: 03-MAR-2006
IPARM FILE NAME: sj100ch2.1	
CHANNEL LINE CROSS SECTIONS	
SECTION 2+020 THROUGH 2+030	SHEET: 39 OF 39