


SEE SHEET 2 FOR LIST OF SHEETS  
AND LIST OF STANDARDS

# STATE OF VERMONT AGENCY OF TRANSPORTATION

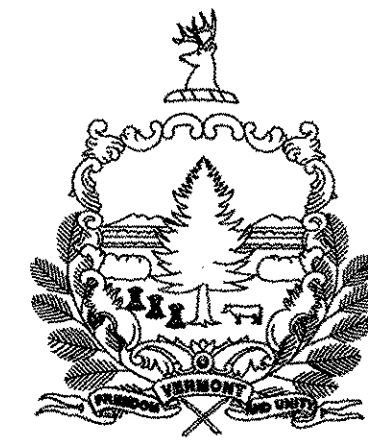


## PROPOSED IMPROVEMENT BRIDGE PROJECT TOWN OF WESTFORD COUNTY OF CHITTENDEN


ROUTE NO : TH 4 (LOCAL ROAD, CLASS 2) BRIDGE NO : 2

PROJECT LOCATION : ON TH 4 APPROXIMATELY AT THE INTERSECTION OF TH 4 AND TH 1.  
PROJECT DESCRIPTION : REPLACEMENT OF EXISTING BRIDGE WITH MINIMAL APPROACH ROADWAY AND CHANNEL WORK.

LENGTH OF STRUCTURE : 8.750 METERS.  
LENGTH OF ROADWAY : 86.25 METERS.  
LENGTH OF PROJECT : 95.00 METERS.

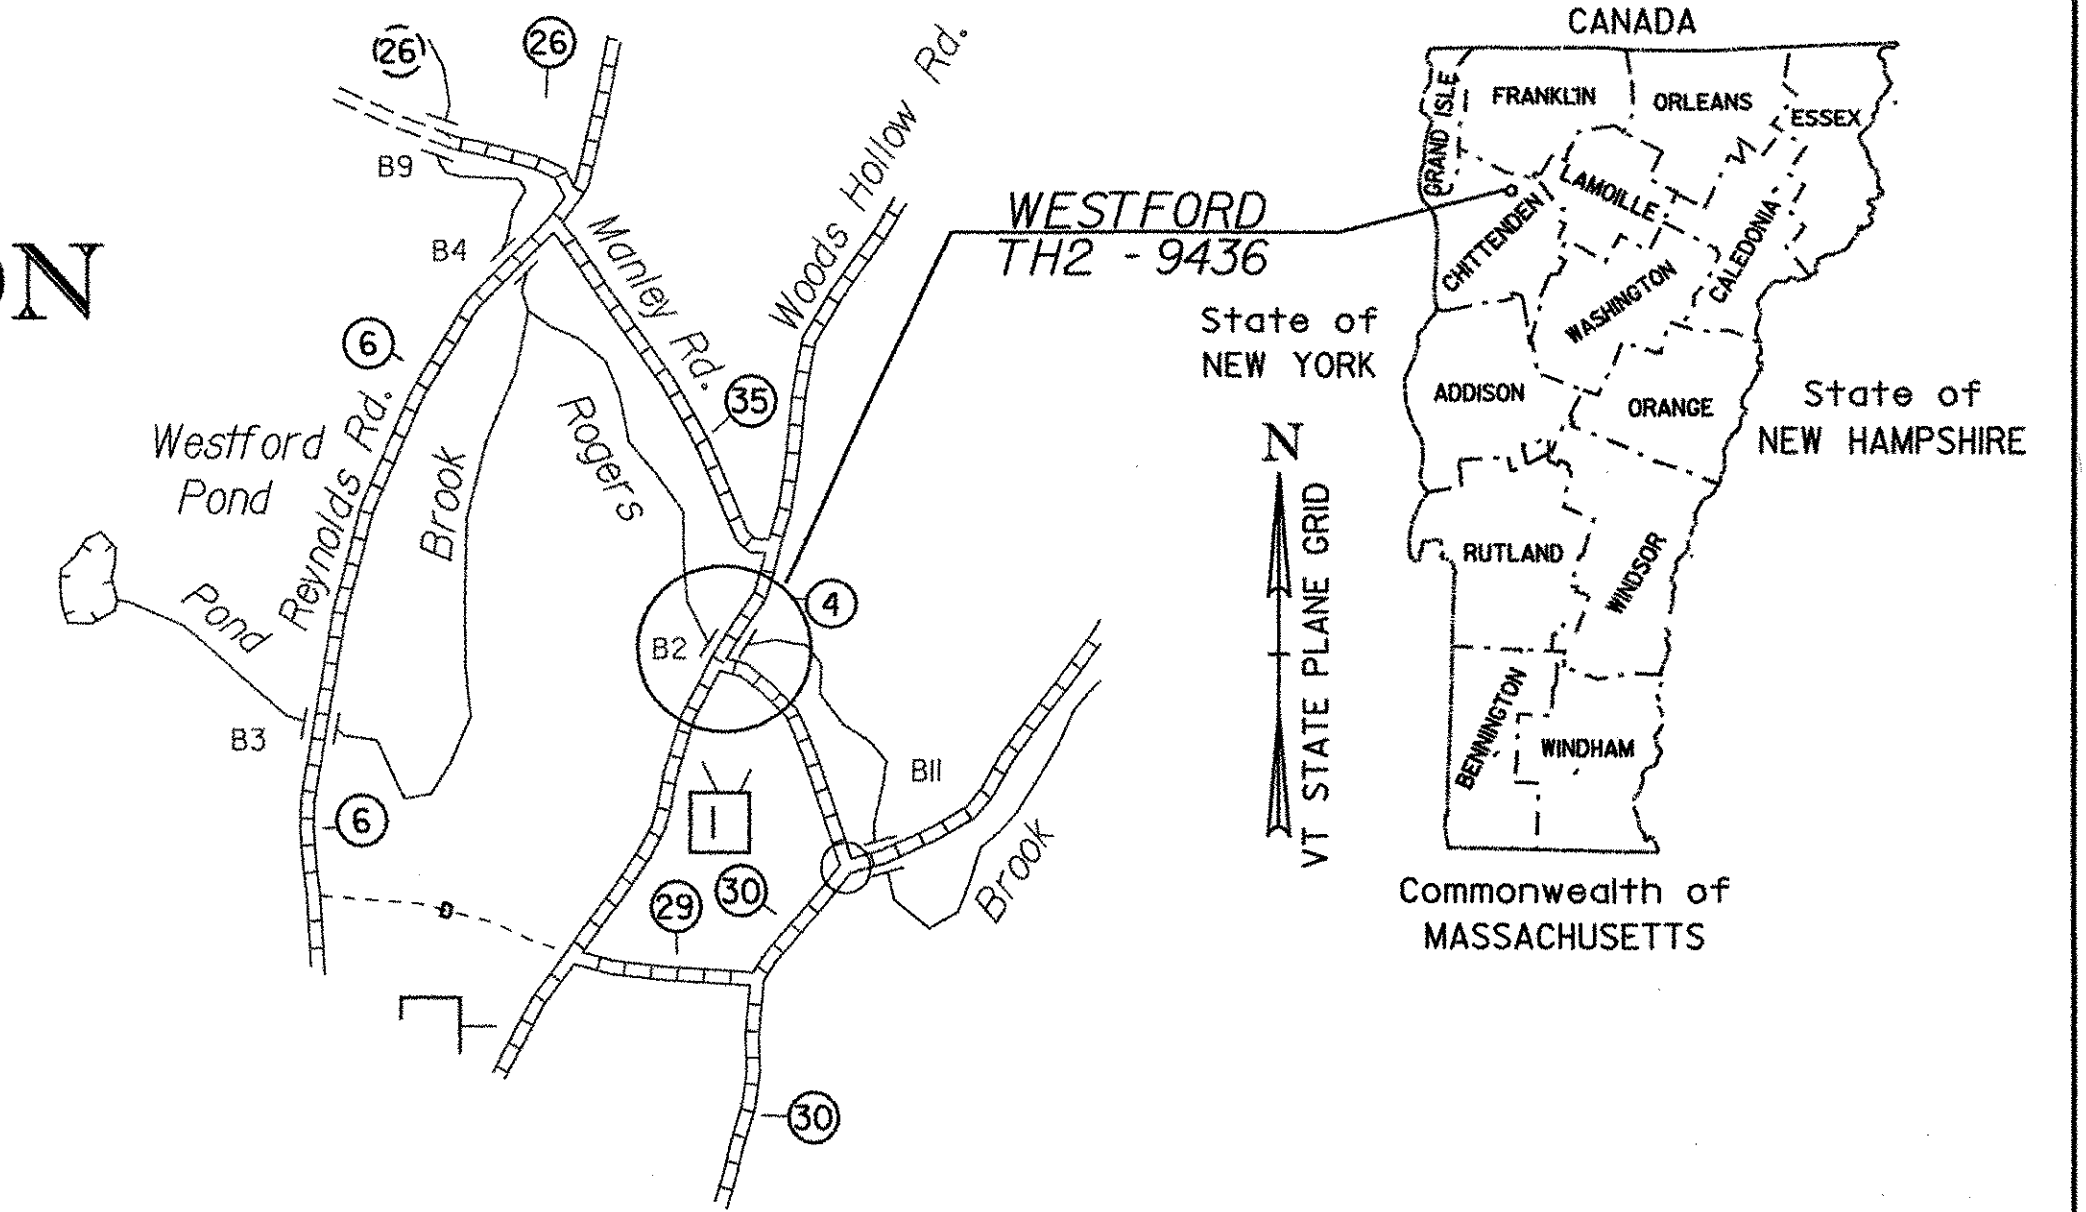

RECORD PLANS	
CONTRACTOR:	TREMBAY CONSTRUCTION, L.L.C. - WASHINGTON, VT
RESIDENT ENGINEER:	JEFF COTA
CONSTRUCTION BEGAN:	JUNE 17, 2005
CONSTRUCTION COMPLETE:	NOVEMBER 01, 2005
RECORD PLANS BY:	JEFF COTA & N. GARBACIK
I HEREBY CERTIFY THAT ALL THE CONSTRUCTION REQUIRED BY THIS SET OF DRAWINGS HAS BEEN ACCOMPLISHED AS INDICATED HEREIN.	
BY:	<i>[Signature]</i> RESIDENT ENGINEER
DATE:	10/15/06
NOTE: Any further information concerning final quantities, amounts or other details relative to this project may be found at Central Files in the electronic archives.	

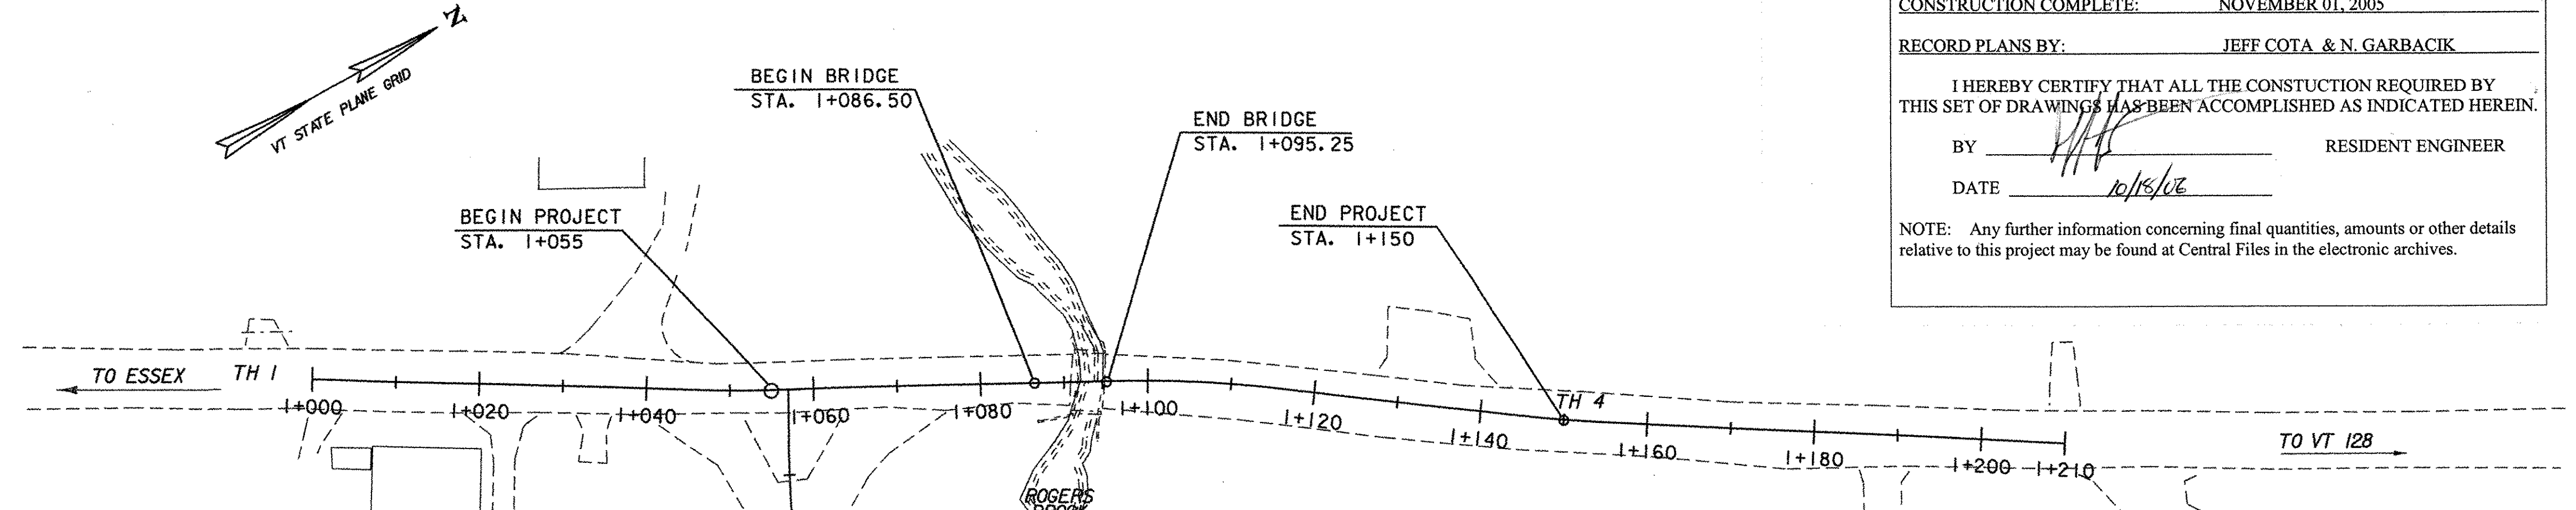

CONVENTIONAL SYMBOLS	
COUNTY LINE	
TOWN LINE	
LIMITS OF ACCESS	
POINT OF ACCESS	
FENCE LINE	
STONE WALL	
TRAVELED WAY	
GUARD RAIL	
RAILROAD	
SURVEY LINE	
CULVERT	
POWER POLE	
TELEPHONE POLE	
TREES	
CONTROL OF ACCESS	
PROPERTY LINE	
R.O.W. TAKING LINE	
SLOPE RIGHTS	
TOP OF CUT	
TOE OF SLOPE	

SURVEYED BY : R. MOREAU  
SURVEYED DATE : SEPT 1995  
DATUM  
VERTICAL NAVD88  
HORIZONTAL NAD83 (92)



THESE PLANS ARE SUBJECT TO SUCH ENGINEERING CHANGES AS MAY BE REQUIRED BY THE FEDERAL HIGHWAY ADMINISTRATION OR THE DIRECTOR OF PROGRAM DEVELOPMENT.  
CONSTRUCTION IS TO BE CARRIED ON IN ACCORDANCE WITH THESE PLANS AND THE STANDARD SPECIFICATIONS FOR CONSTRUCTION DATED 2001, AS APPROVED BY THE FEDERAL HIGHWAY ADMINISTRATION ON JANUARY 4, 2001 FOR USE ON THIS PROJECT, INCLUDING ALL SUBSEQUENT REVISIONS AND SUCH REVISED SPECIFICATIONS AND SPECIAL PROVISIONS AS ARE INCORPORATED IN THESE PLANS.  
PLOTTED: 02-MAR-2005  
/PW/94j22/sj22bdr.dgn sj22ti.1

**Metric**  
UNLESS NOTED OTHERWISE  
STATIONS ARE IN KILOMETERS  
ELEVATIONS ARE IN METERS  
DIMENSIONS ARE IN MILLIMETERS

DIRECTOR OF PROGRAM DEVELOPMENT	
APPROVED <i>[Signature]</i>	DATE 3-2-05
PROJECT MANAGER : ROGER WHITCOMB	
PROJECT NAME : WESTFORD	
PROJECT NUMBER : TH2 - 9436	
SHEET 1 OF 56 SHEETS	