
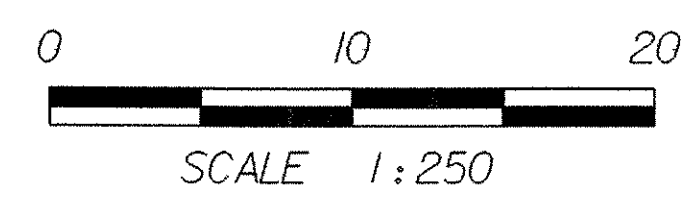
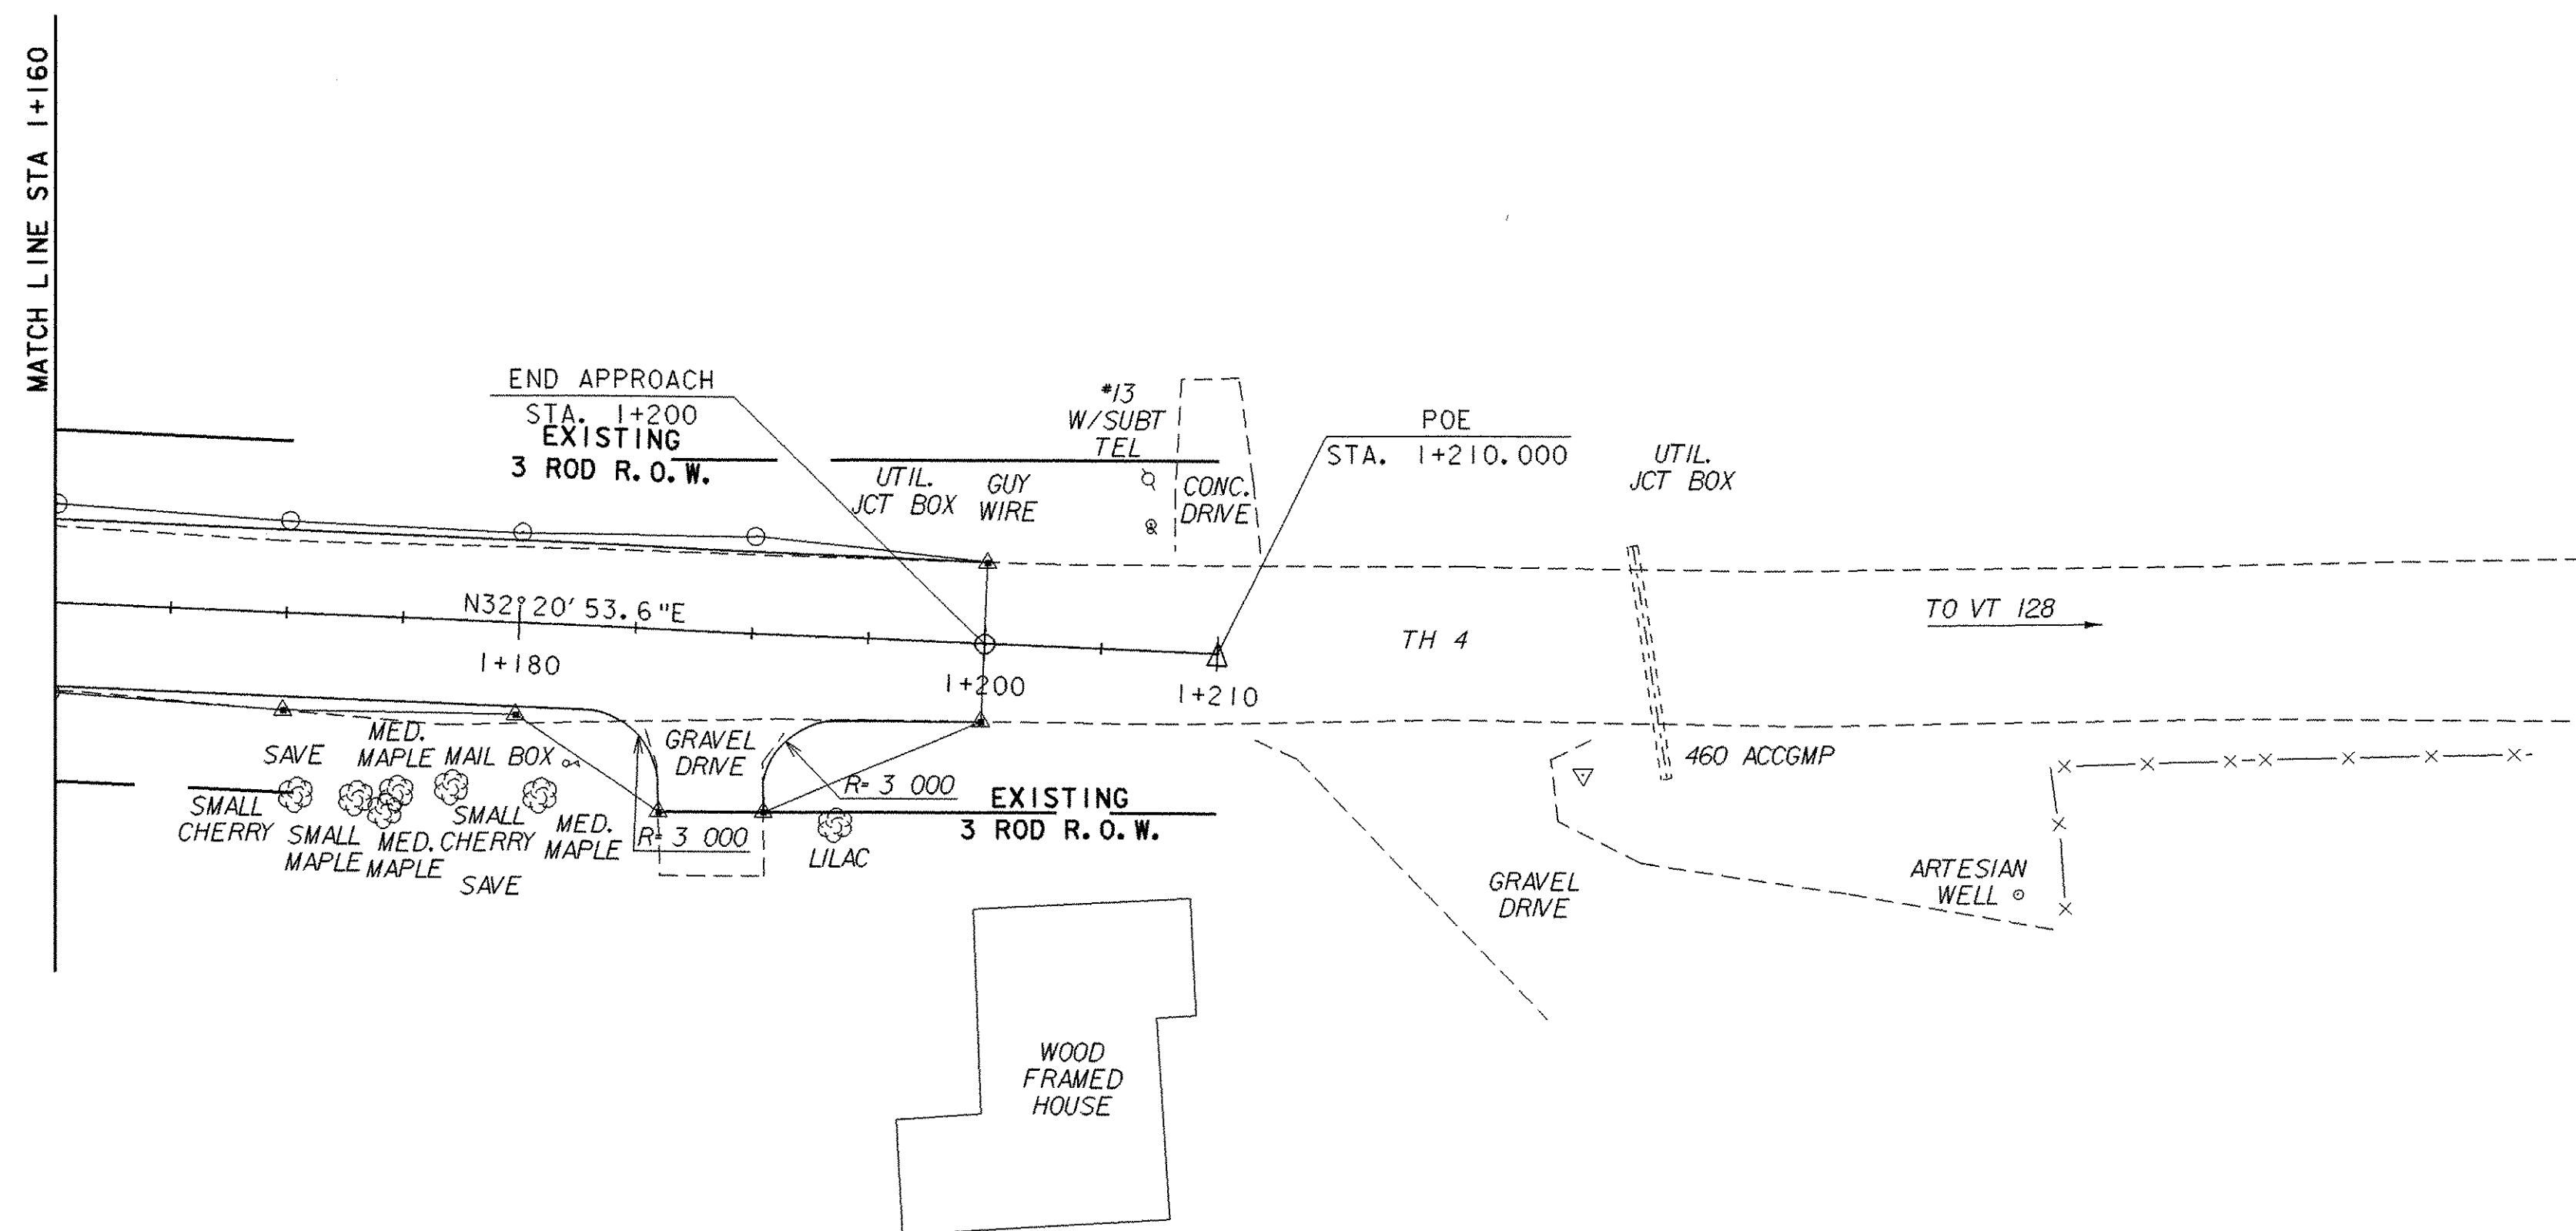


CONSTRUCT DRIVES
STA 1488 RT

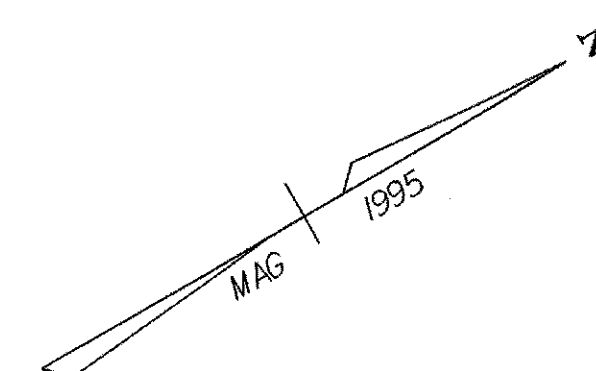

SHEET NAME: LAYOUT SHEET #2	
PROJECT NAME: WESTFORD	HIGHWAY NO.: TH 4
PROJECT NUMBER: TH2 9436	BRIDGE NO.: 2
	OVER: ROGERS BROOK
FILE NAME: /PW/94j22/sj22bdr.dgn	PLOT DATE: 25-MAR-2005
PROJECT MANAGER: R. R. WHITCOMB	DRAWN BY: STRI
DESIGNED BY: C. CARLSON	IPARM NAME: sj221a2.1
BRIDGE SHEET NUMBER:	SHEET 9 OF 56