
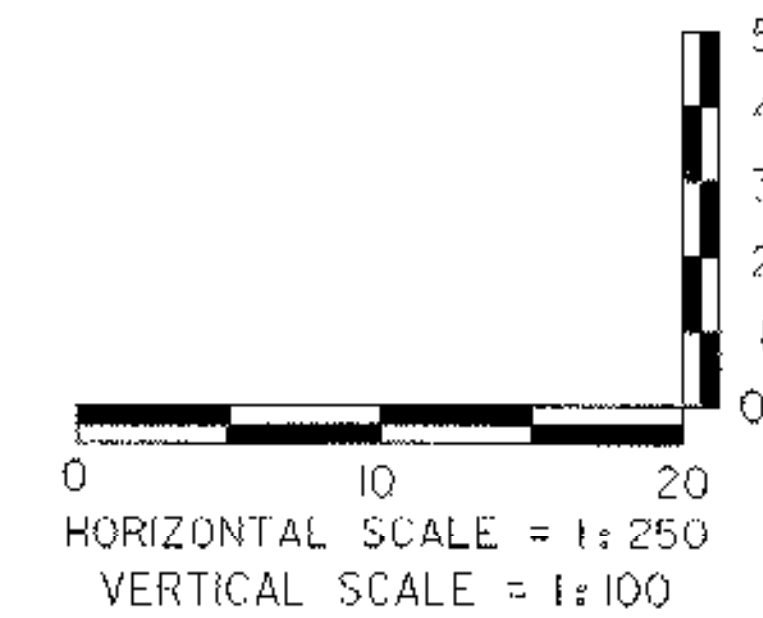
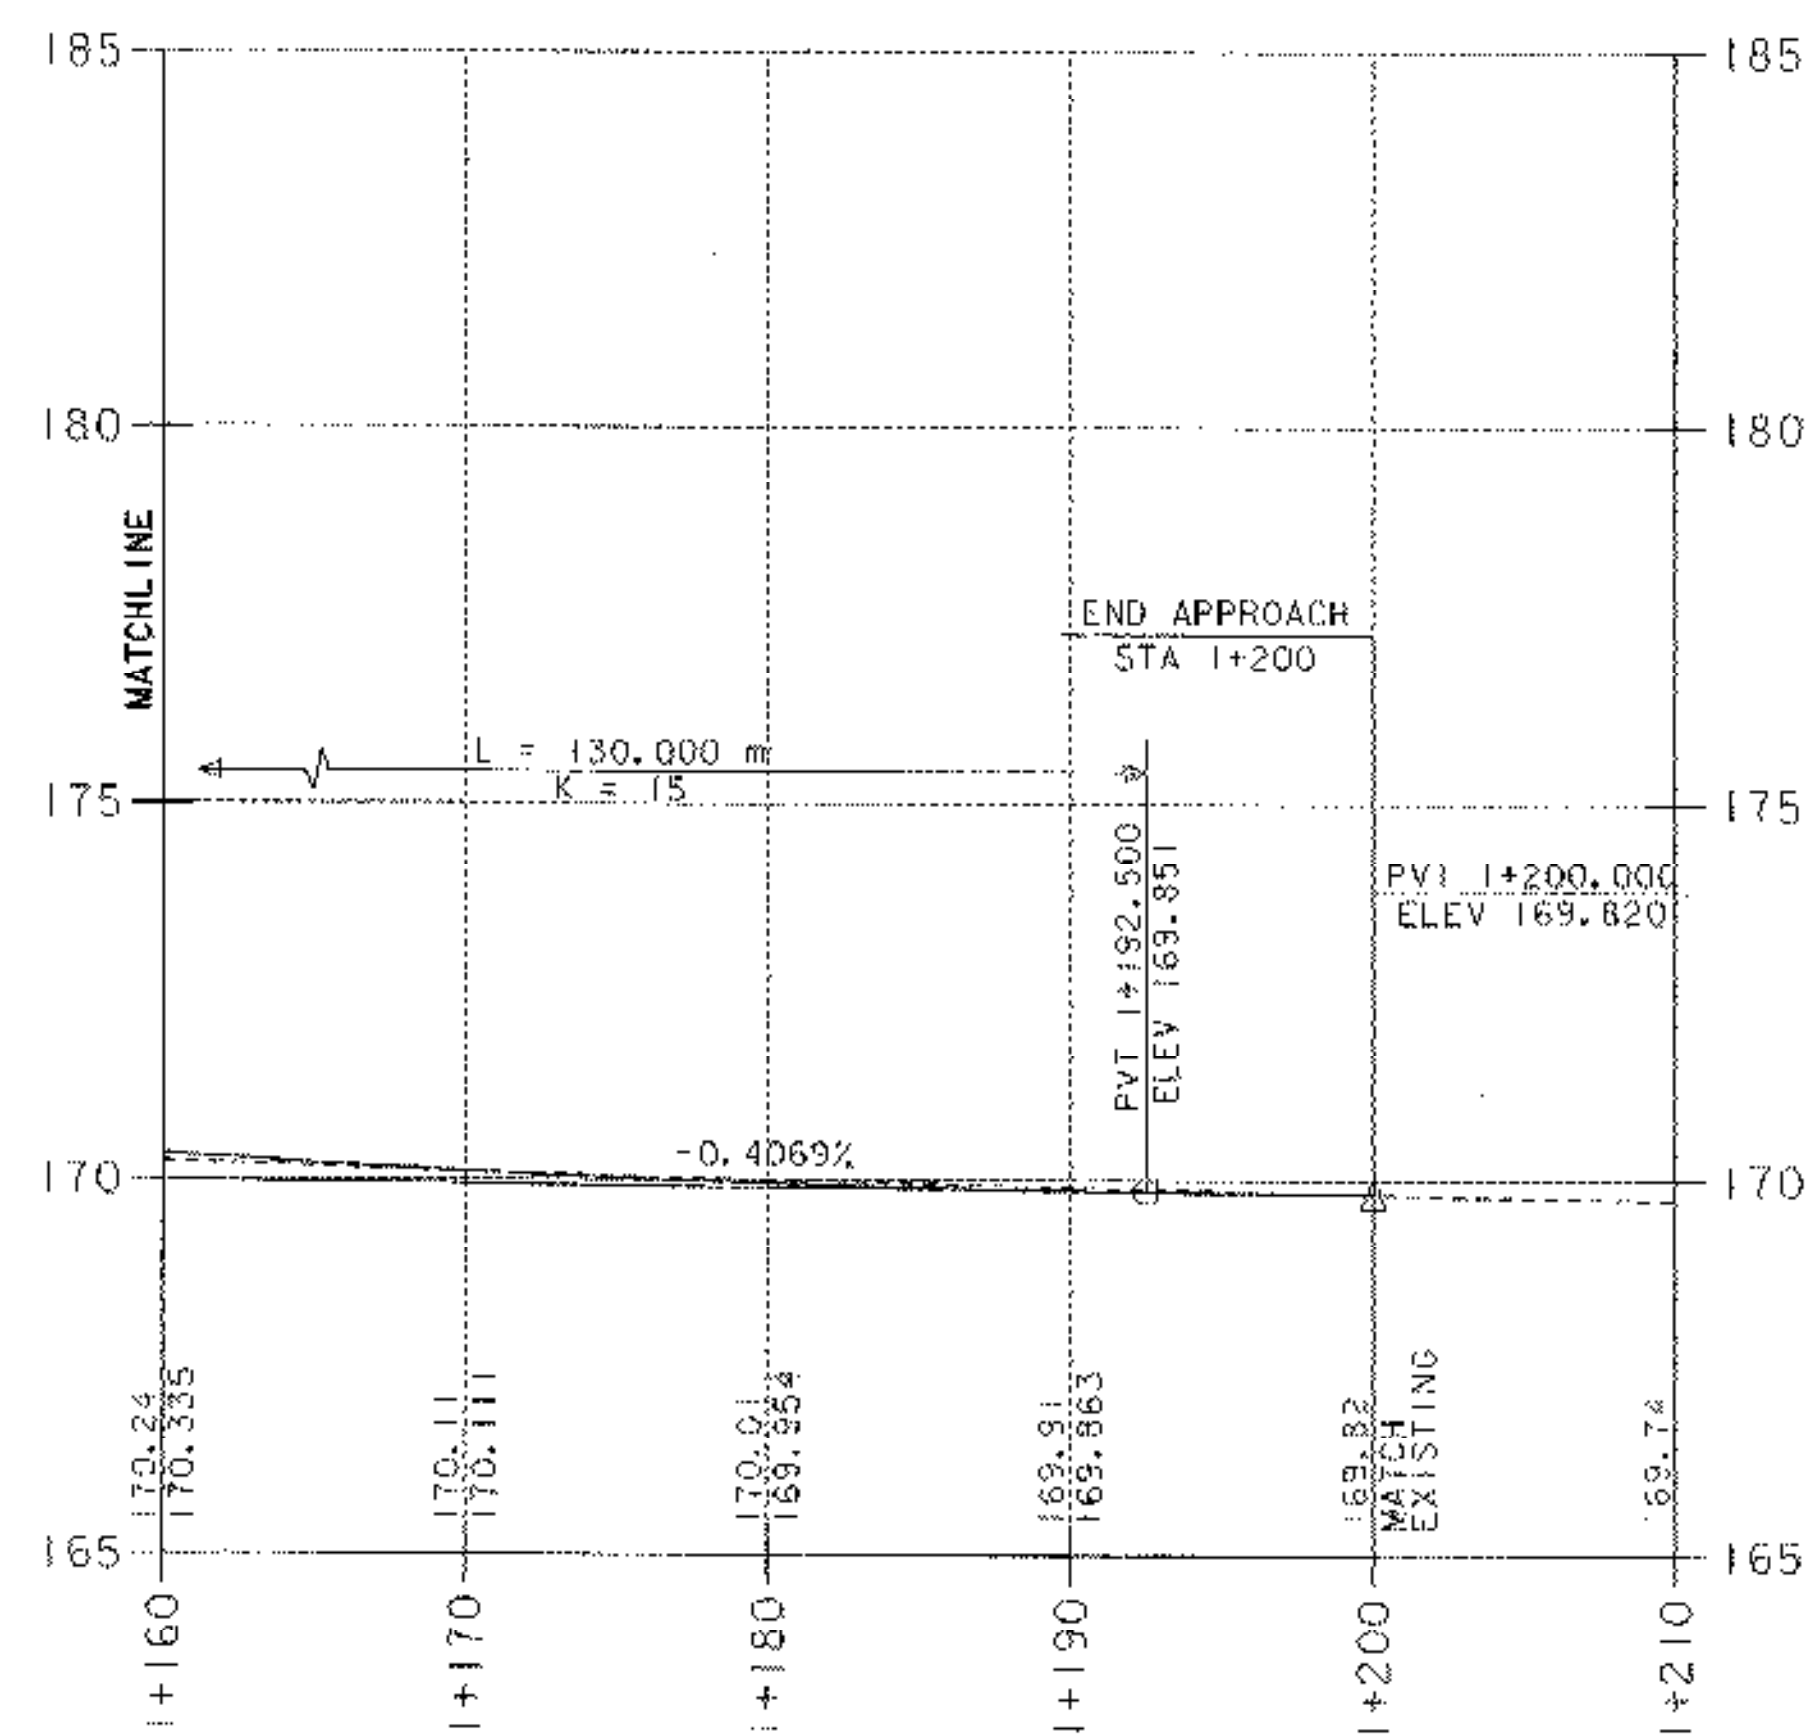


Mainline Profile

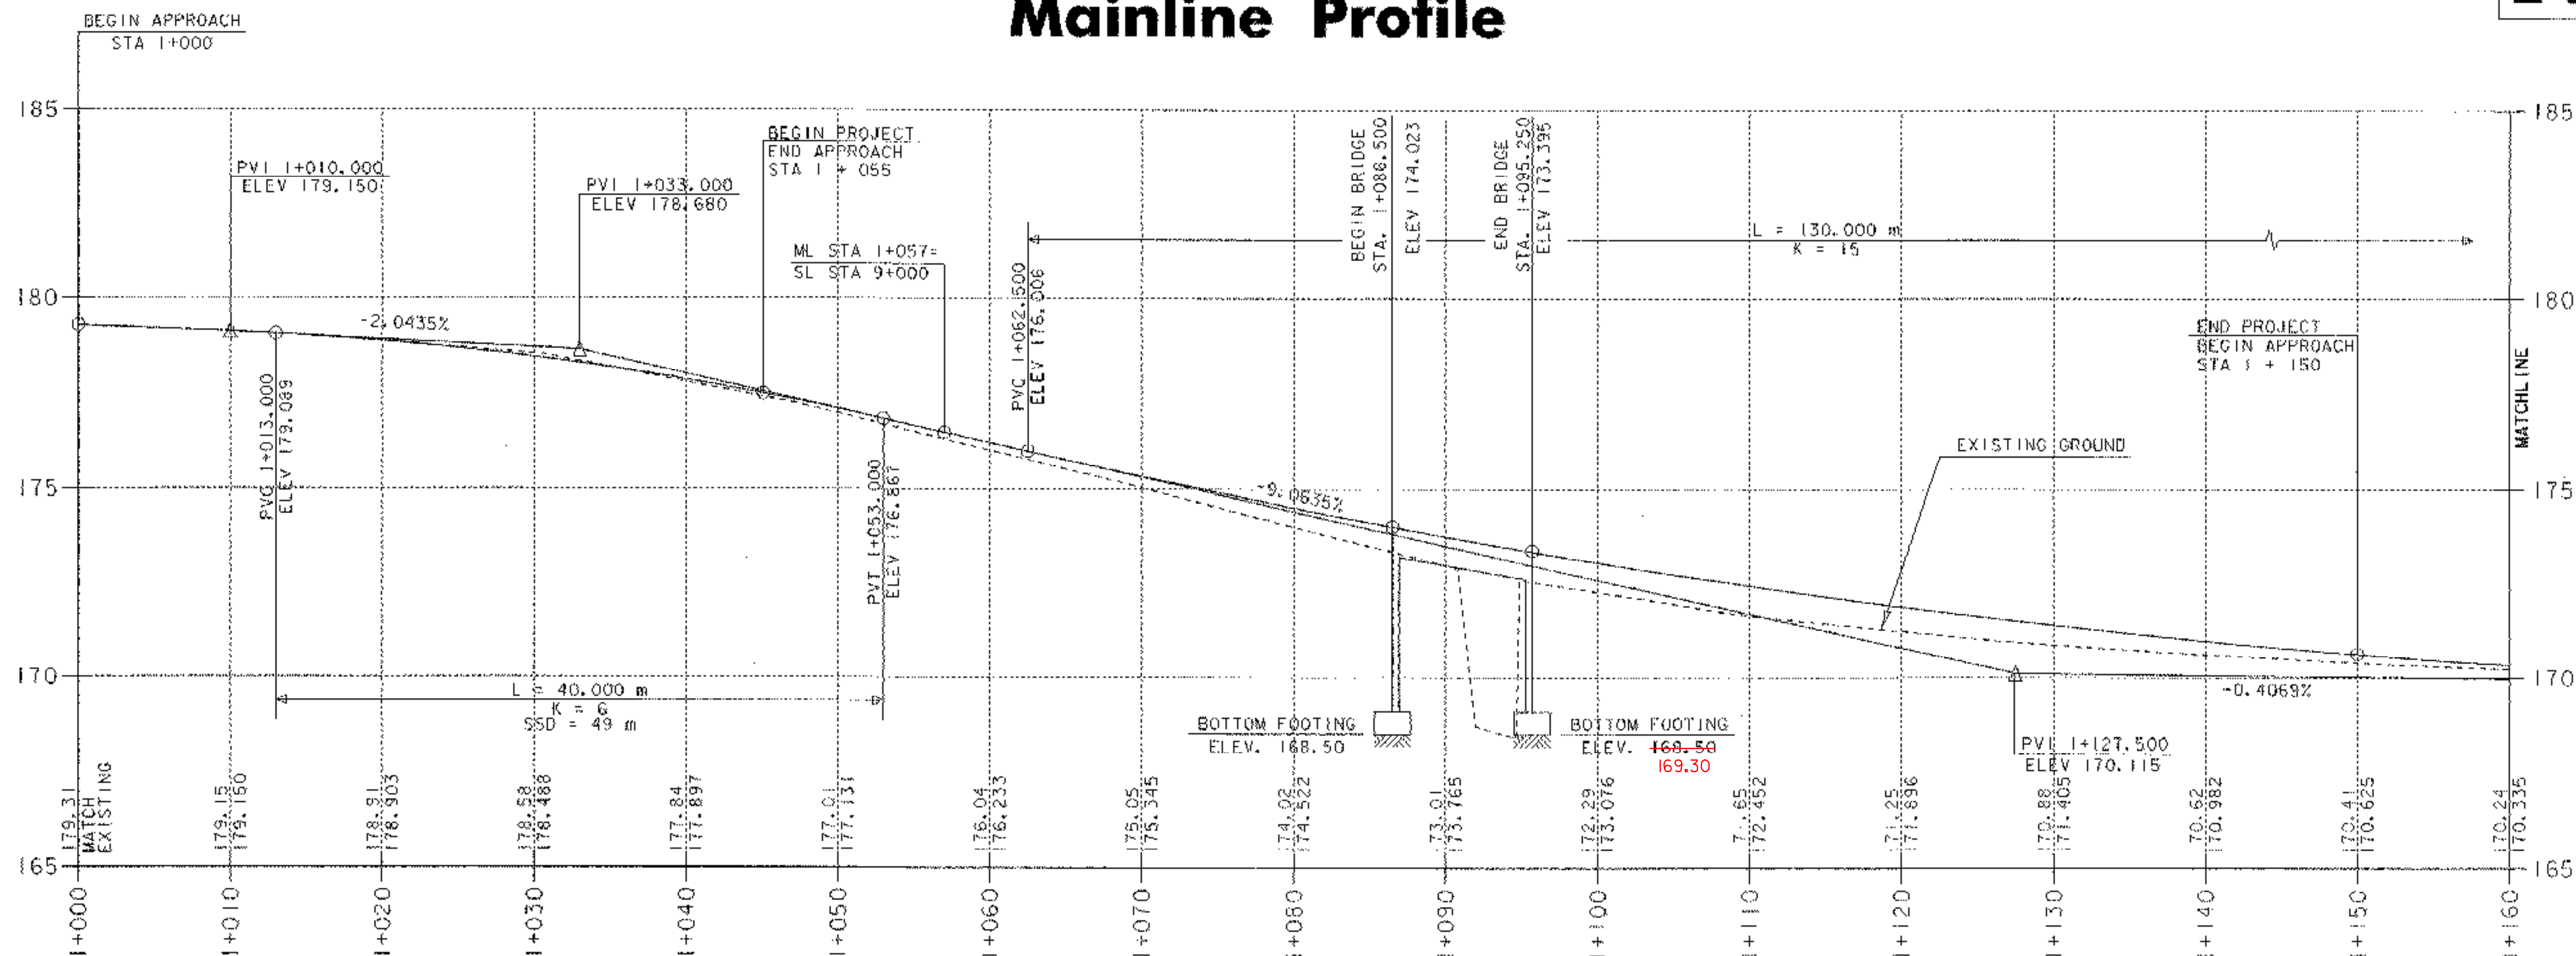

NOTE:
 GRADES SHOWN TO THE NEAREST HUNDREDTH ARE THE OLD GROUND ALONG THE CENTERLINE. GRADES SHOWN TO THE NEAREST THOUSANDTH ARE THE PROPOSED FINISHED GRADE ALONG THE CENTERLINE.

SHEET NAME: MAINLINE PROFILE		
PROJECT NAME: WESTFORD	HIGHWAY NO.: TH 4	
PROJECT NUMBER: TH2 9436	BRIDGE NO.: 2	OVER: ROGERS BROOK
FILE NAME: /PW/94J22/sj22xs2.dgn	PLOT DATE: 25-MAR-2005	
PROJECT MANAGER: R. R. WHITCOMB	DRAWN BY: STRI	
DESIGNED BY: C. CARLSON	IPARM NAME: sj22p-PL1	
BRIDGE SHEET NUMBER:	SHEET 10 OF 56	