


NOTES

SEE SHEET 21 FOR SOILS INFORMATION

DATUM  
 VERTICAL NAVD 88  
 HORIZONTAL NAD 83/92 GPS

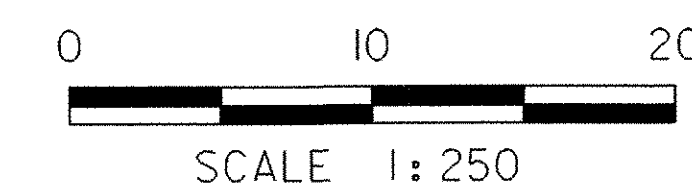

SHEET NAME: <b>EXISTING CONDITIONS SITE PLAN #2</b>	
PROJECT NAME: <b>WESTFORD</b>	HIGHWAY NO.: TH 4
PROJECT NUMBER: <b>TH2 9436</b>	BRIDGE NO.: 2
	OVER: ROGERS BROOK
FILE NAME: 94J22\Structures\sj22ero.dgn	PLOT DATE: 25-MAR-2005
PROJECT MANAGER: R. R. WHITCOMB	DRAWN BY: STRI
DESIGNED BY: C. CARLSON	IPARM NAME: sj22ero2.1
BRIDGE SHEET NUMBER:	SHEET 22 OF 56