


SECTION A-A
NTS

STABILIZED CONSTRUCTION ENTRANCE

NTS

NOTE:
SEE SHEETS 21 AND 23 FOR NOTES.

DATUM	
VERTICAL	NAVD 88
HORIZONTAL	NAD 83/92 GPS

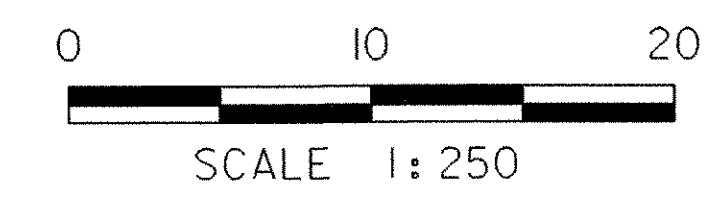

SHEET NAME: EROSION PREVENTION & SEDIMENT CONTROL PLAN #2	
PROJECT NAME: WESTFORD	HIGHWAY NO.: TH 4
PROJECT NUMBER: TH2 9436	BRIDGE NO.: 2
	OVER: ROGERS BROOK
FILE NAME: 94J122\Structures\sj122ero.dgn	PLOT DATE: 25-MAR-2005
PROJECT MANAGER: G.S. ROGERS	DRAWN BY: STRI
DESIGNED BY: C. CARLSON	IPARM NAME: sj122ero4.i
BRIDGE SHEET NUMBER:	SHEET 24 OF 56