


**ABUTMENT #1 PLAN**  
SCALE: 1:25

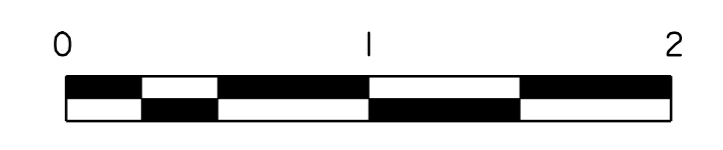

SCALE = 1:25

SHEET NAME: <b>ABUTMENT #1 PLAN</b>	
PROJECT NAME: WESTFORD	HIGHWAY NO.: TH 4
PROJECT NUMBER: TH2 9436	BRIDGE NO.: 2
	OVER: ROGERS BROOK
FILE NAME: 94J122\Structures\sj122sup.dgn	PLOT DATE: 22-DEC-2006
PROJECT MANAGER: R. R. WHITCOMB	DRAWN BY: T. FILLBACH
DESIGNED BY: T. FILLBACH	IPARM NAME: sj122abl.i
BRIDGE SHEET NUMBER:	SHEET 32 OF 56

REVISION	DATE	BY	CHK'D	DESCRIPTION
△	06/27/2005	GFR	CWC	ABUTMENTS MODIFIED DUE TO UPDATED LEDGE INFORMATION.