


SIGN LEGEND

- = EXISTING
- N = NEW
- R = REMOVE
- R&S = REMOVE & SALVAGE
- S = SALVAGE

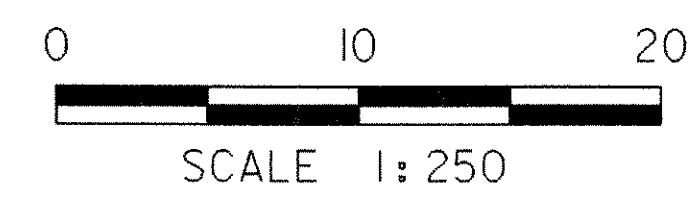

SHEET NAME: SIGN SHEET #2	
PROJECT NAME: WESTFORD	HIGHWAY NO.: TH 4
PROJECT NUMBER: TH2 9436	BRIDGE NO.: 2
	OVER: ROGERS BROOK
FILE NAME: 94J122\Structures\sj122sgn.dgn	PLOT DATE: 25-MAR-2005
PROJECT MANAGER: R. R. WHITCOMB	DRAWN BY: STRI
DESIGNED BY: C. CARLSON	IPARM NAME: sj122sg4.l
BRIDGE SHEET NUMBER:	SHEET 41 OF 56