

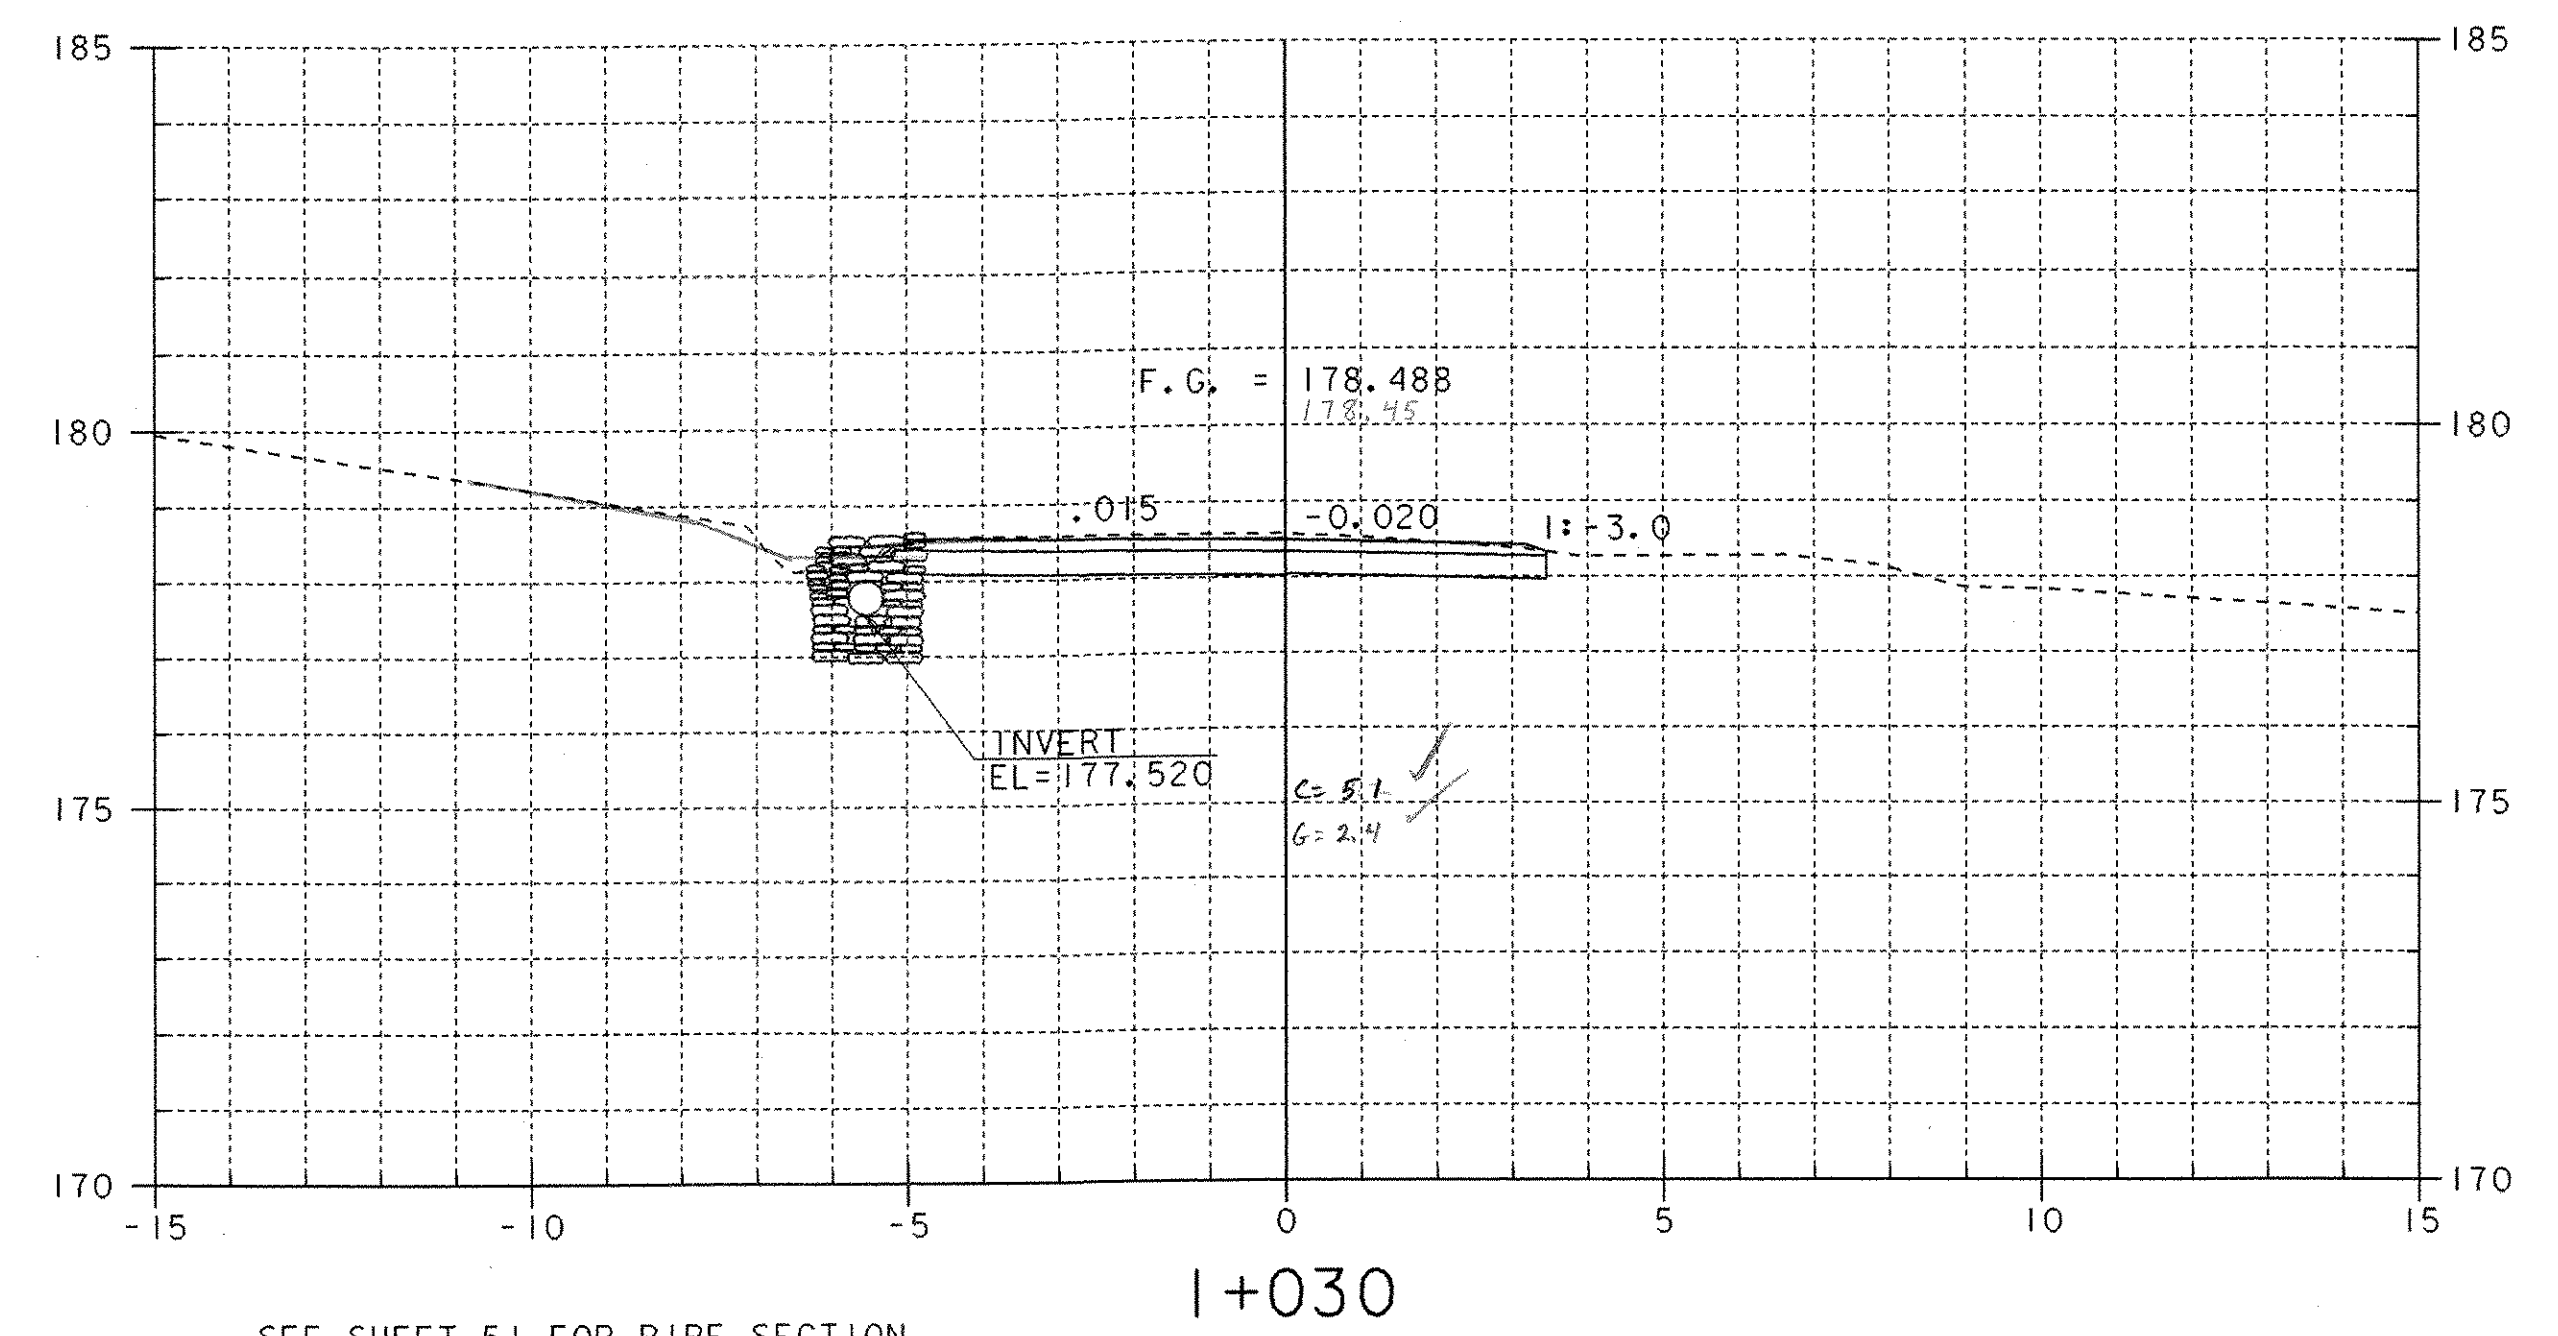
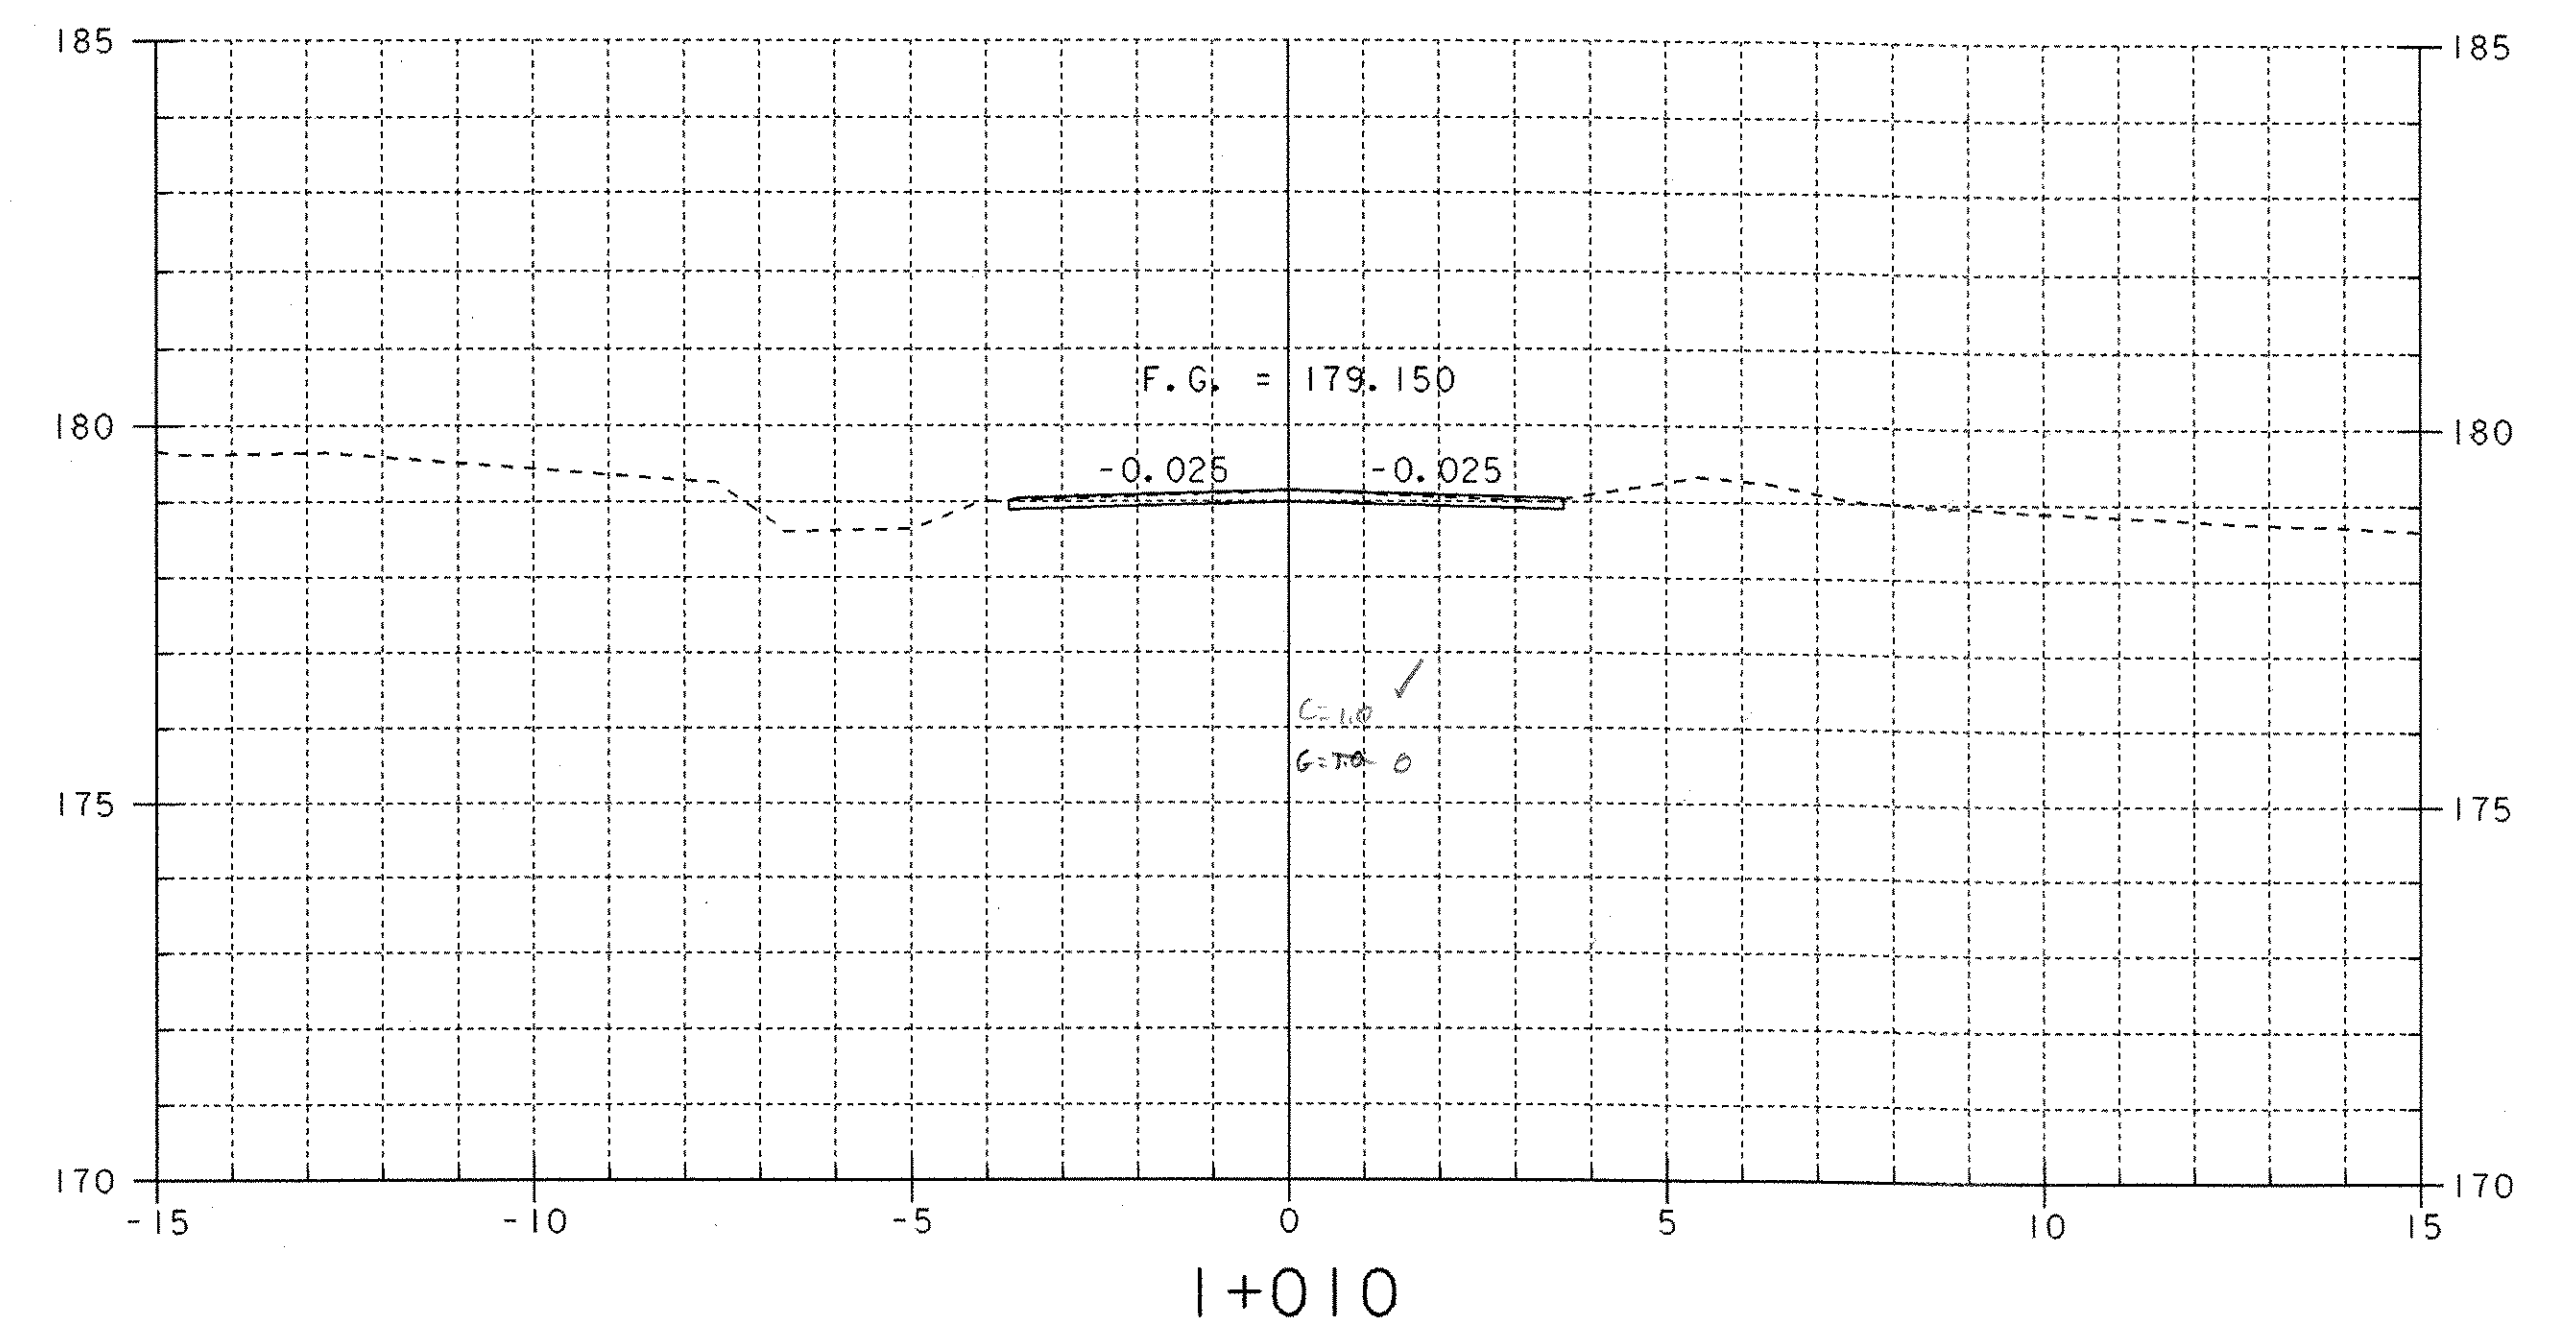


MATERIAL TRANSITION DETAIL

NTS

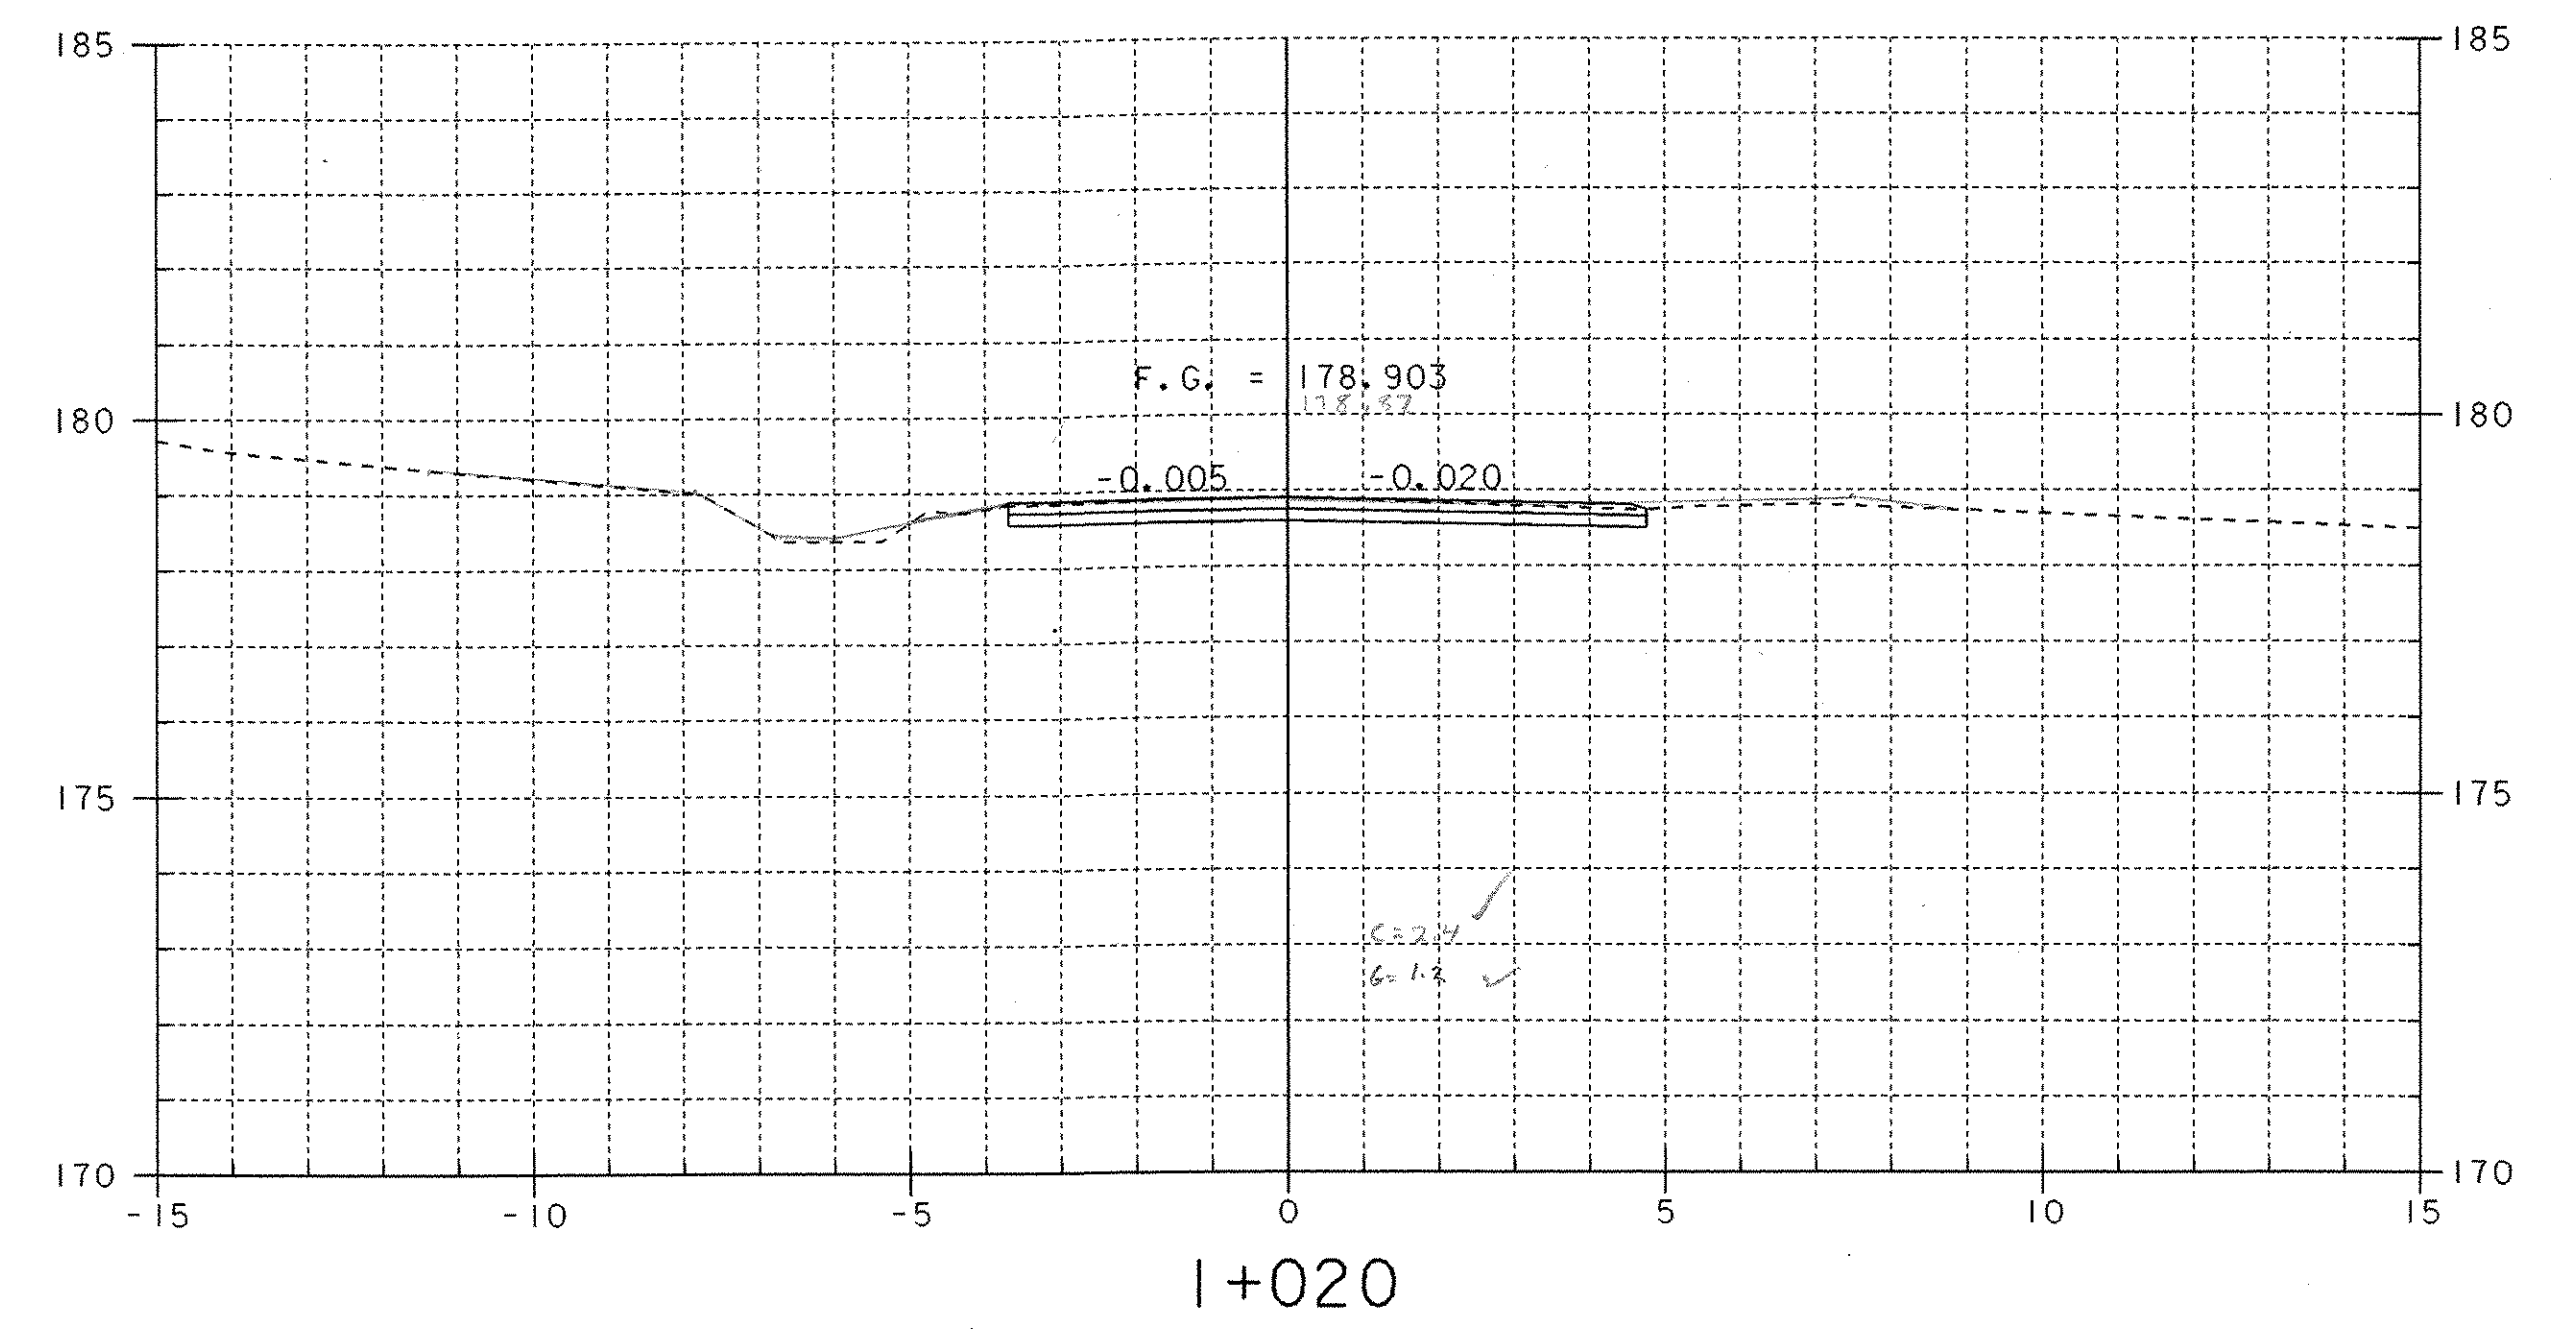

SEE SHEET 51 FOR PIPE SECTION AND STD D-2M FOR HEADWALL DETAILS AT STA 1+037.000 LEFT

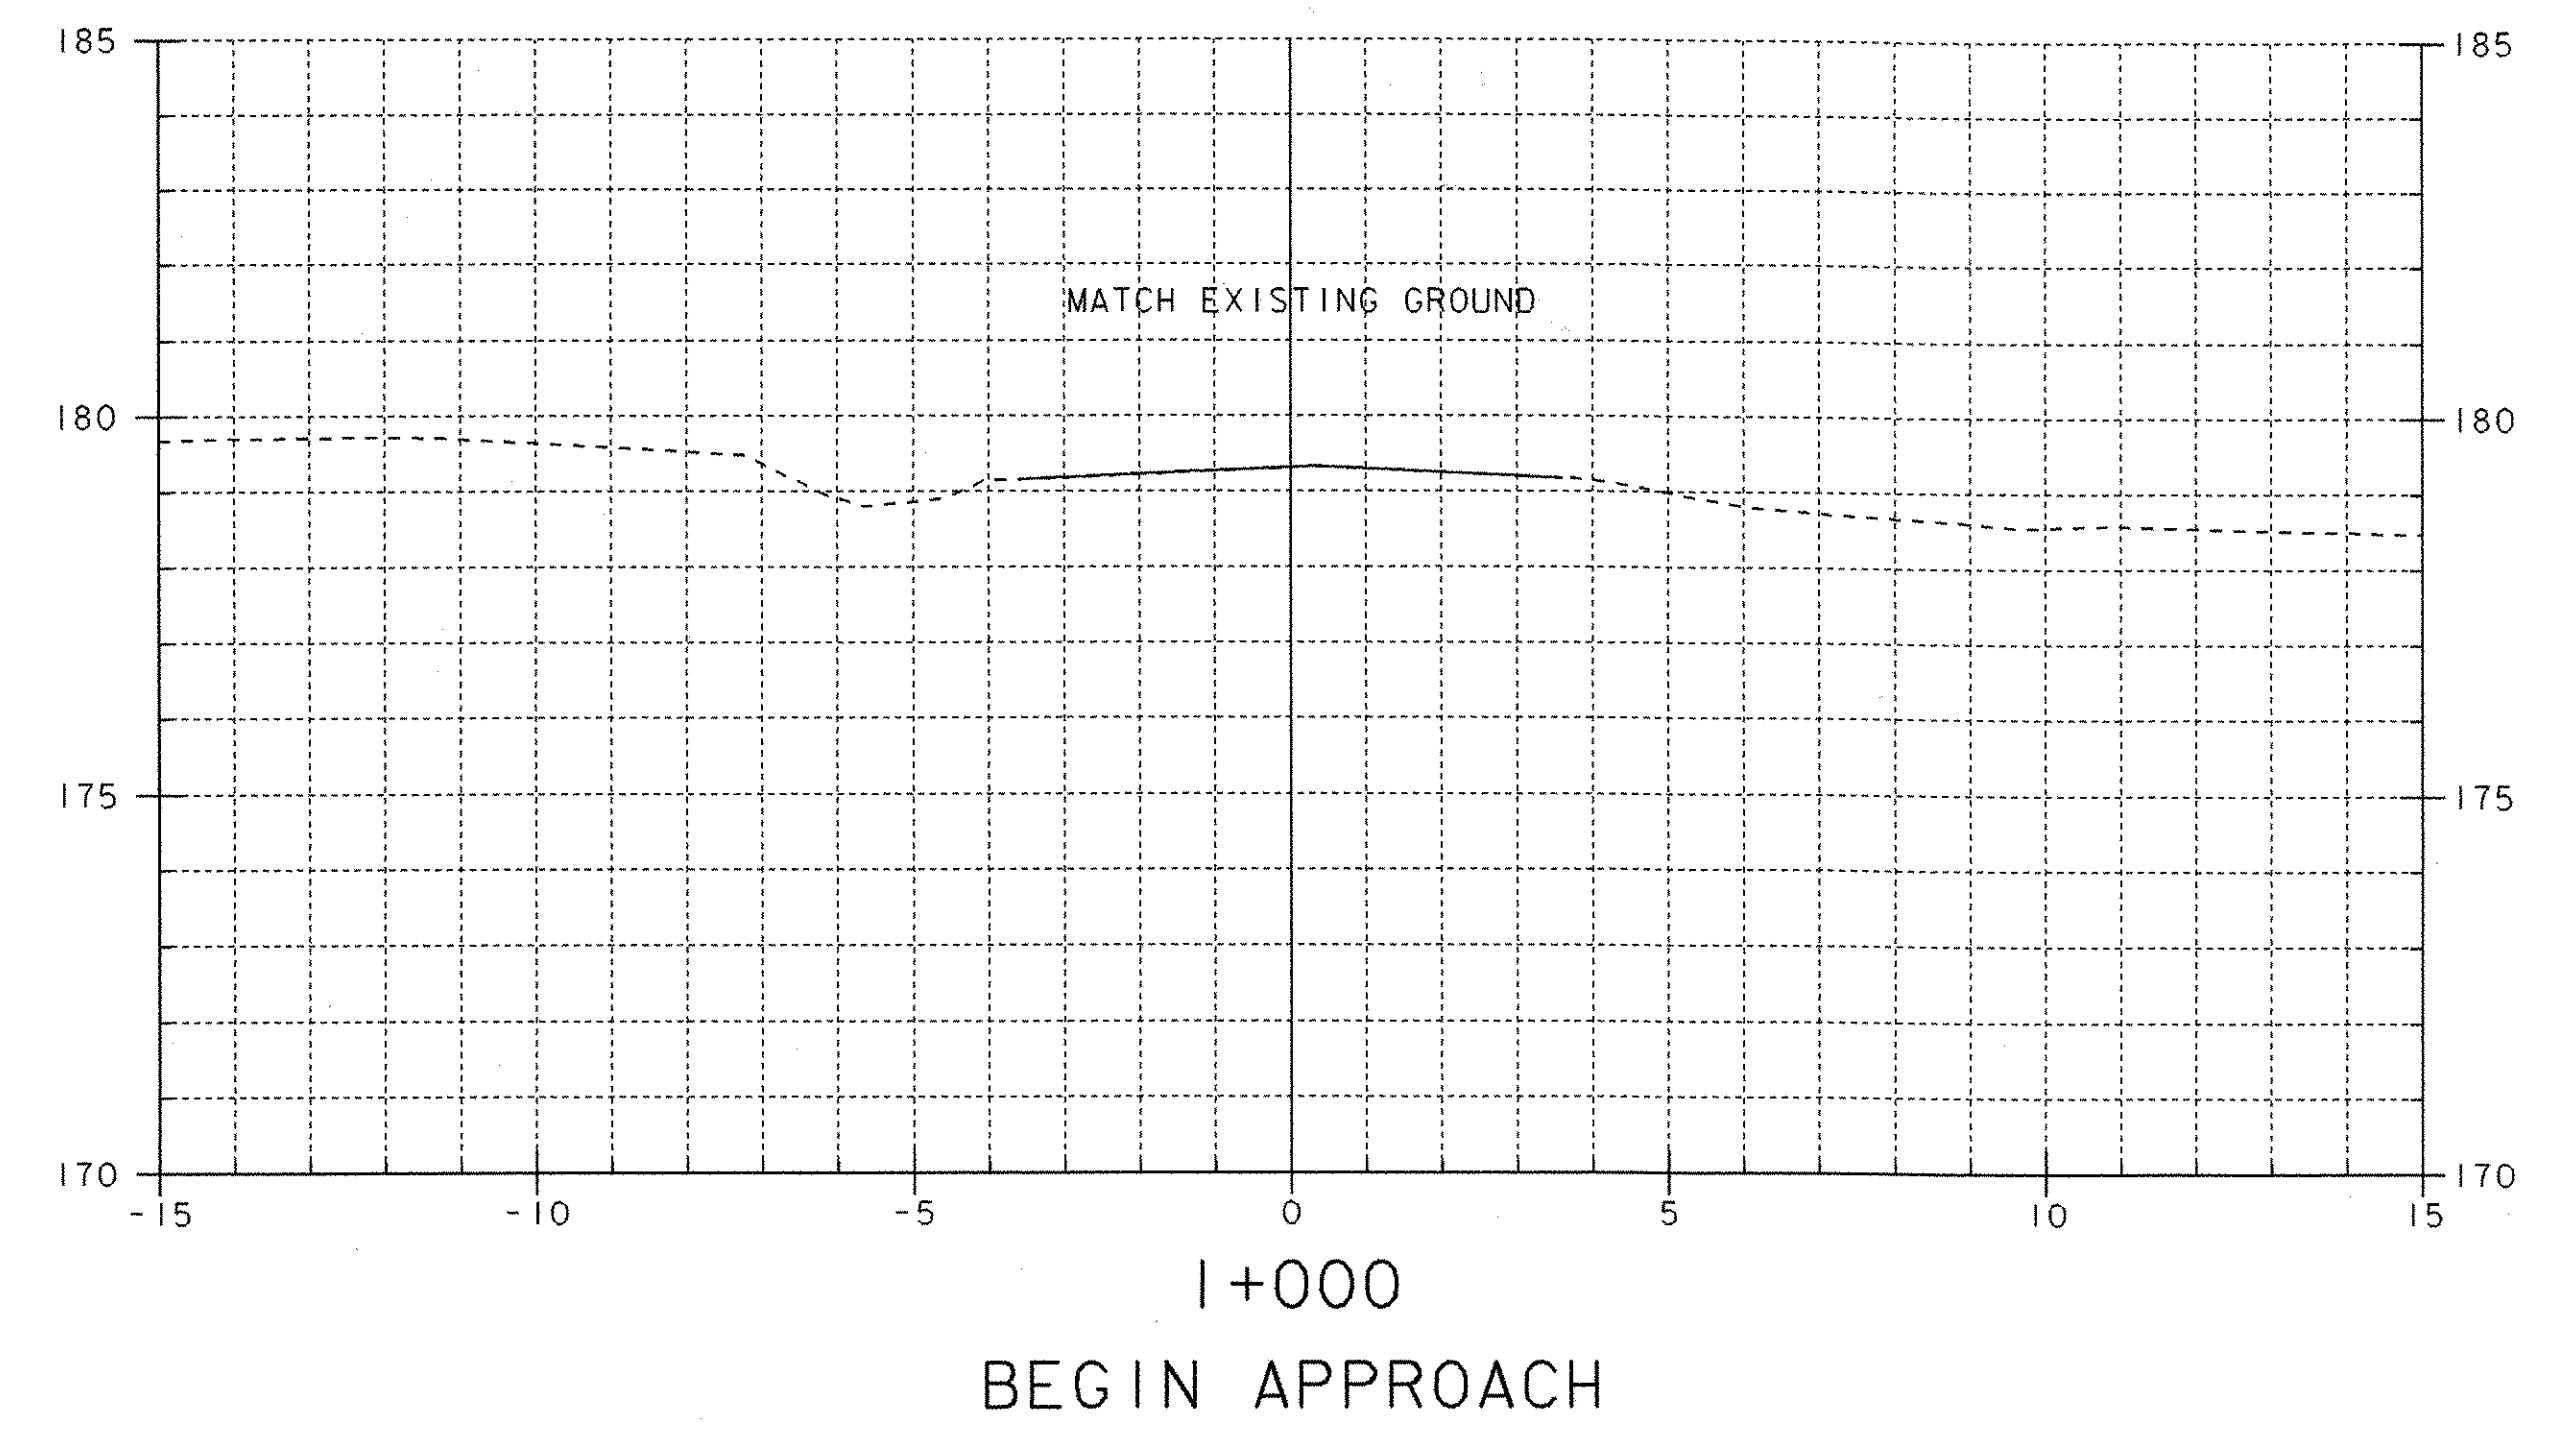

* SEE SHEET 12 FOR BANKING DIAGRAM

SHEET NAME: MAINLINE CROSS SECTIONS	
PROJECT NAME: WESTFORD	HIGHWAY NO.: TH 4
PROJECT NUMBER: TH2 9436	BRIDGE NO.: 2
	OVER: ROGERS BROOK
FILE NAME: /PW/94j122/sj122xs2.dgn	PLOT DATE: 25-MAR-2005
PROJECT MANAGER: R. R. WHITCOMB	DRAWN BY: STRI
DESIGNED BY: C. CARLSON	IPARM NAME: sj122mx1.1
BRIDGE SHEET NUMBER:	SHEET 44 OF 56