




STA 1+044 RIGHT
 BEGIN STONE FILL, TYPE I
 STONE LINED DITCH ALONG SIDELINE

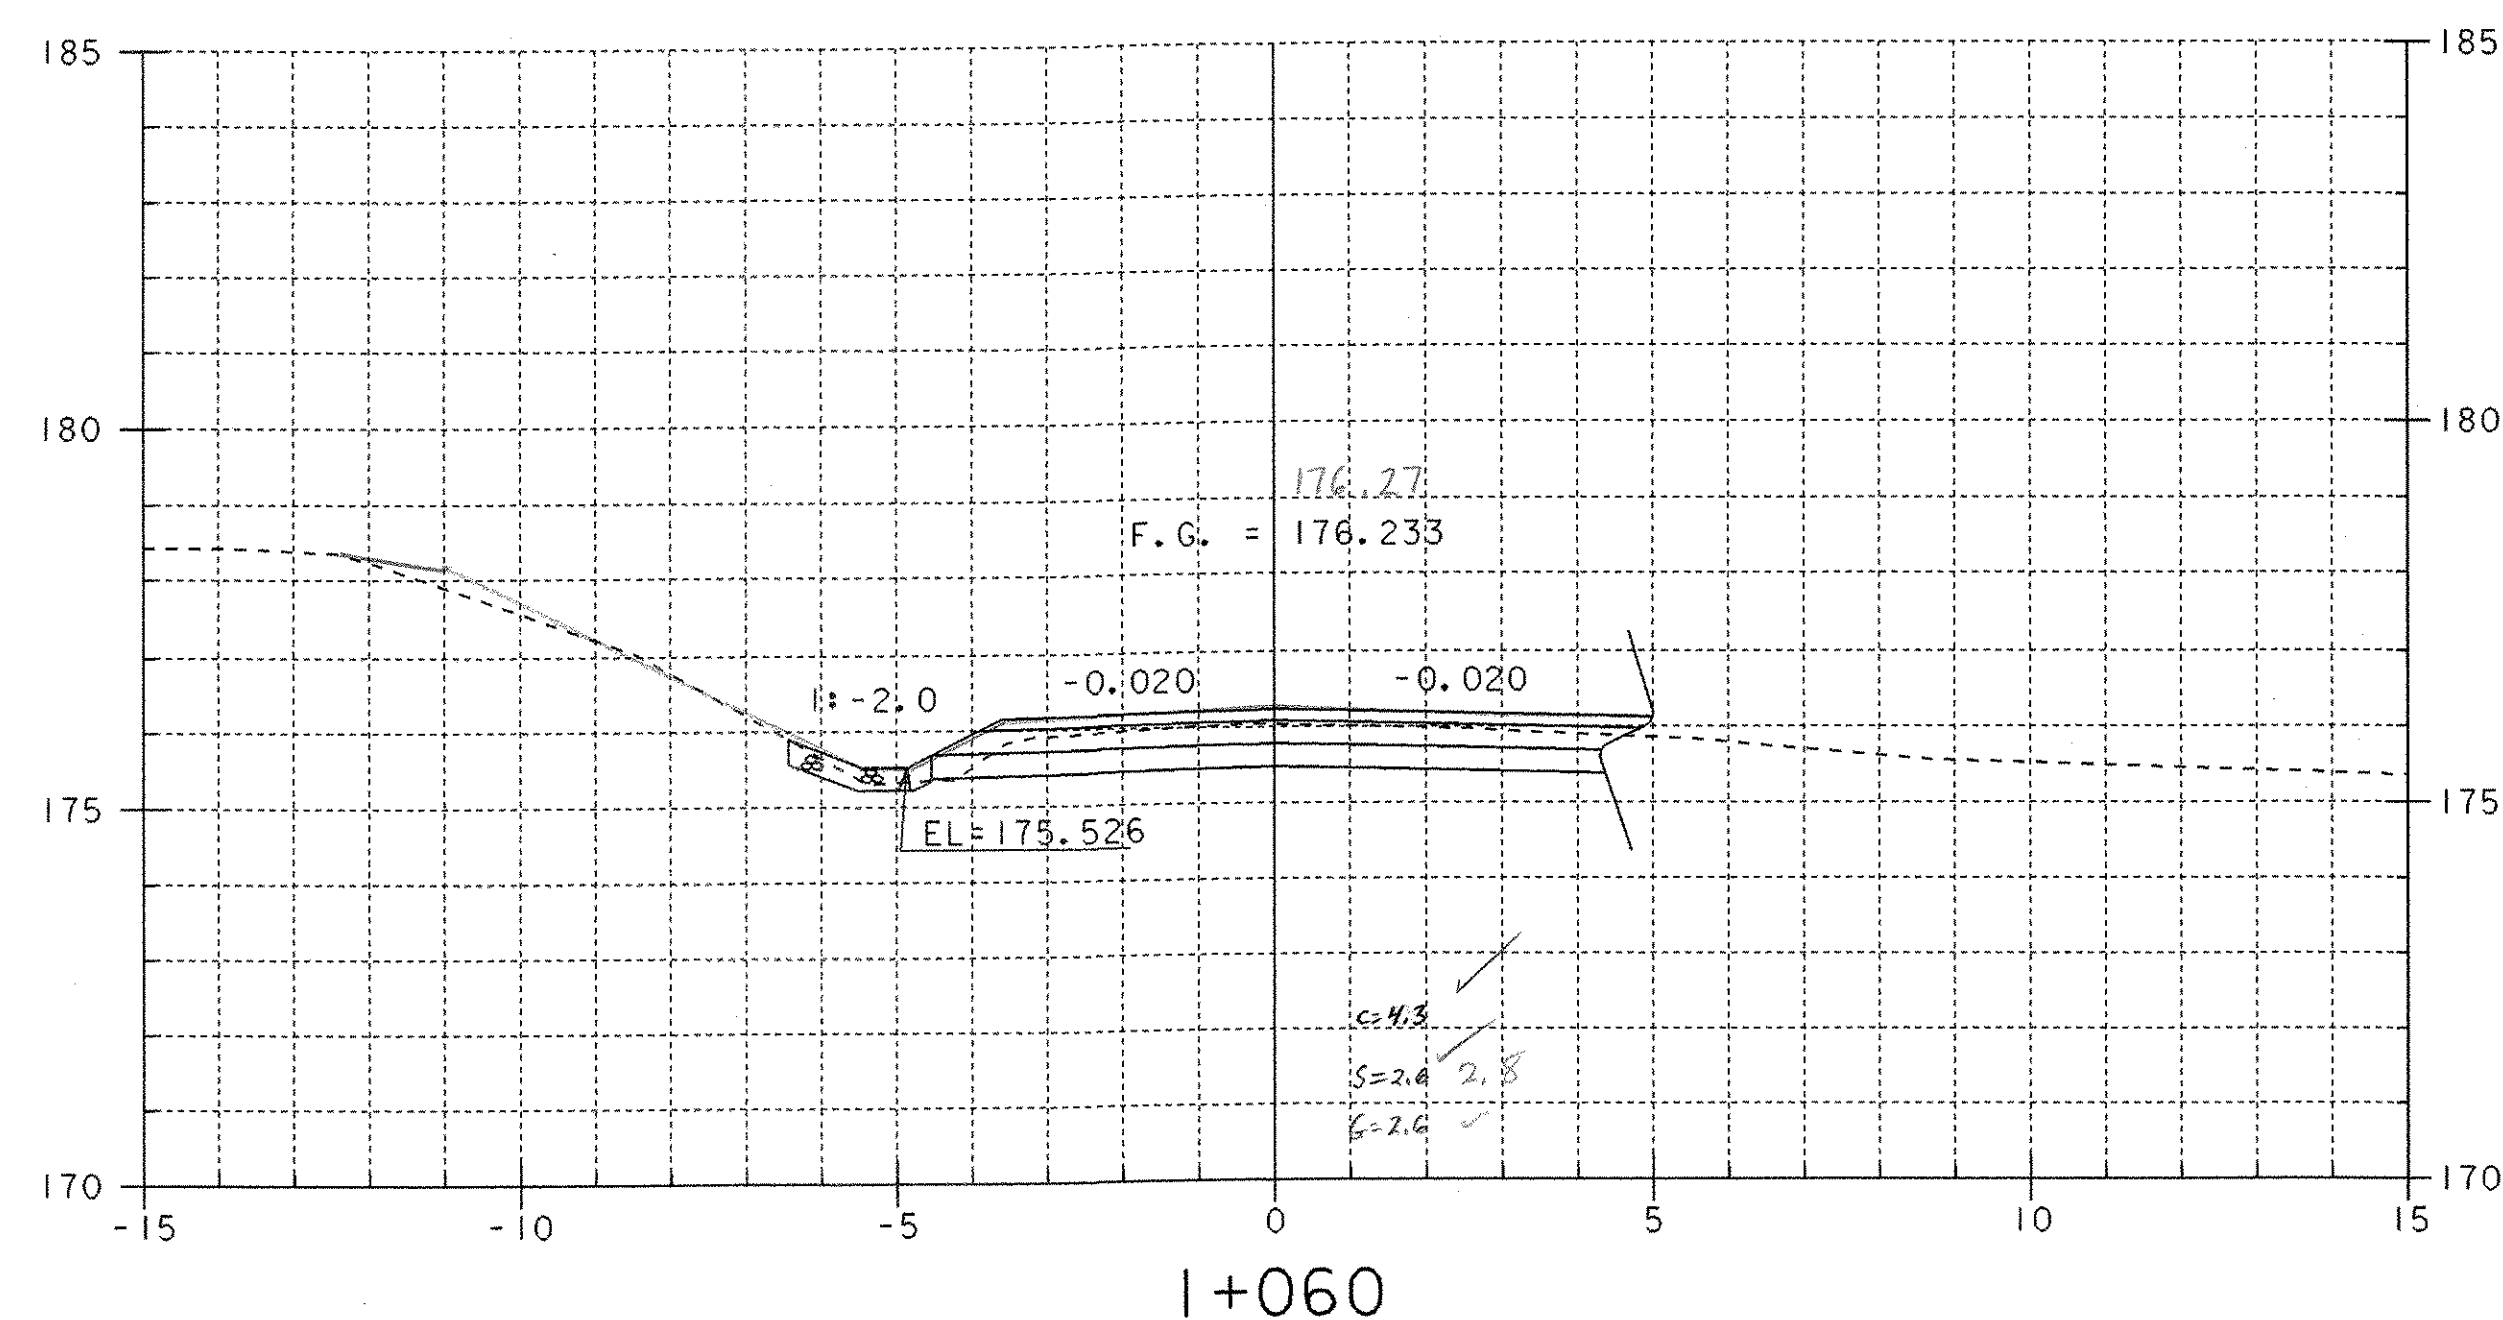

END APPROACH/BEGIN PROJECT
 1+055

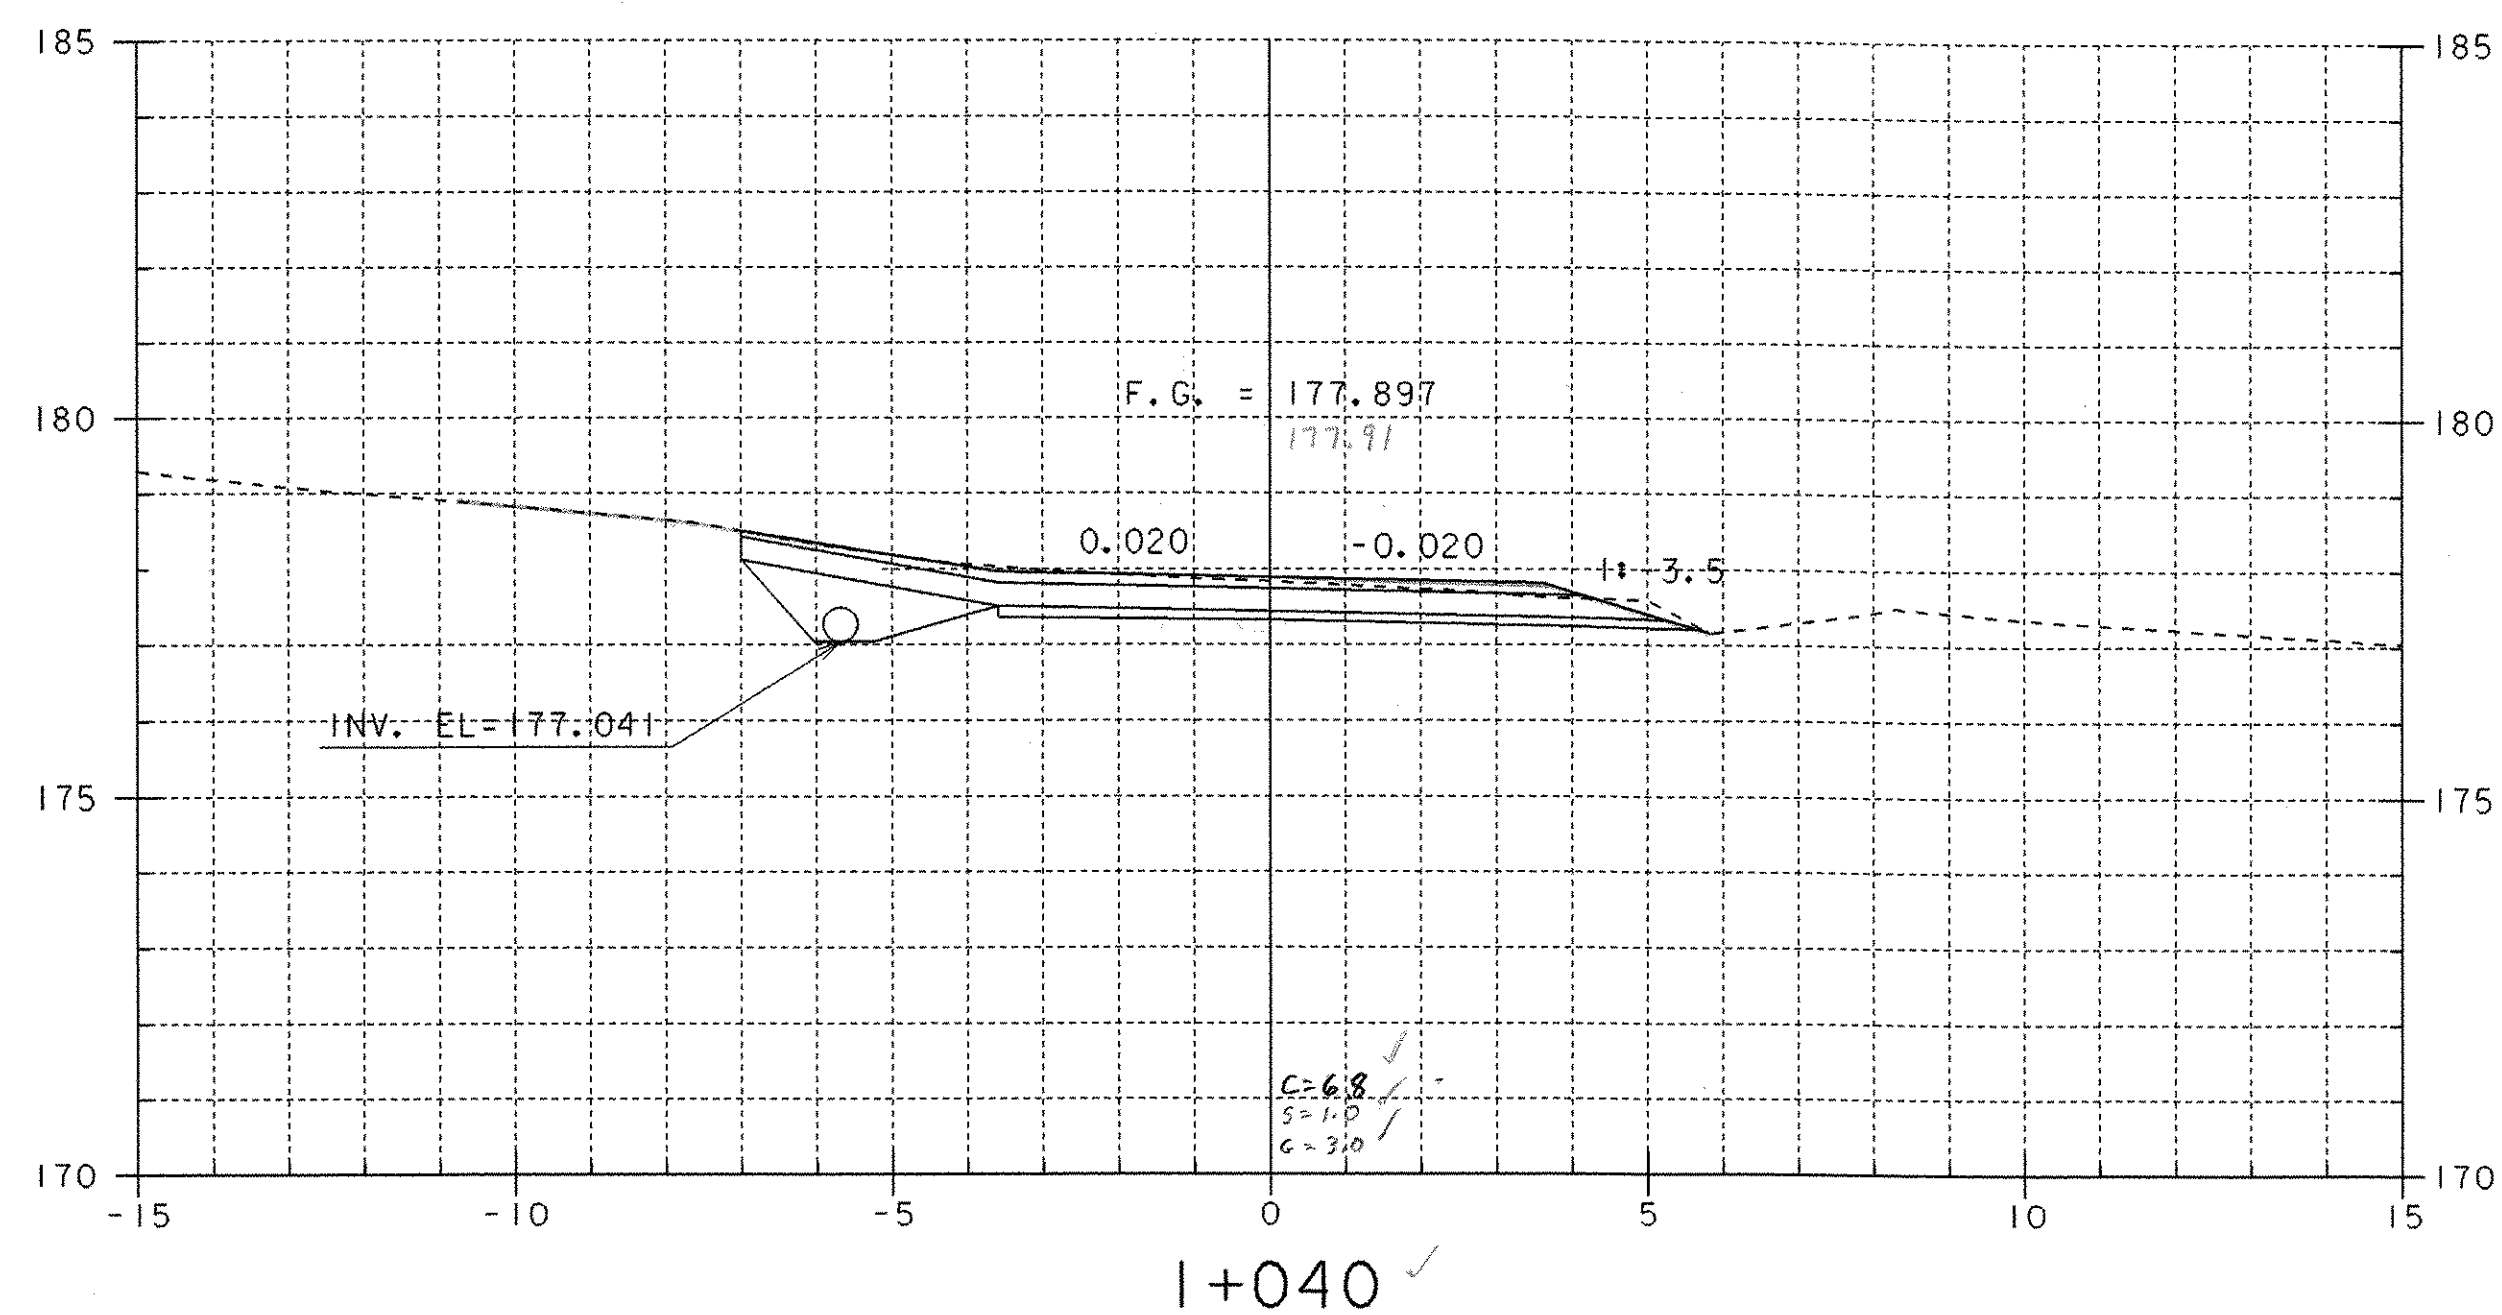

STA 1+037 LT
 CONSTRUCT DRIVE
 (SEE SHT. 50 FOR DETAILS)

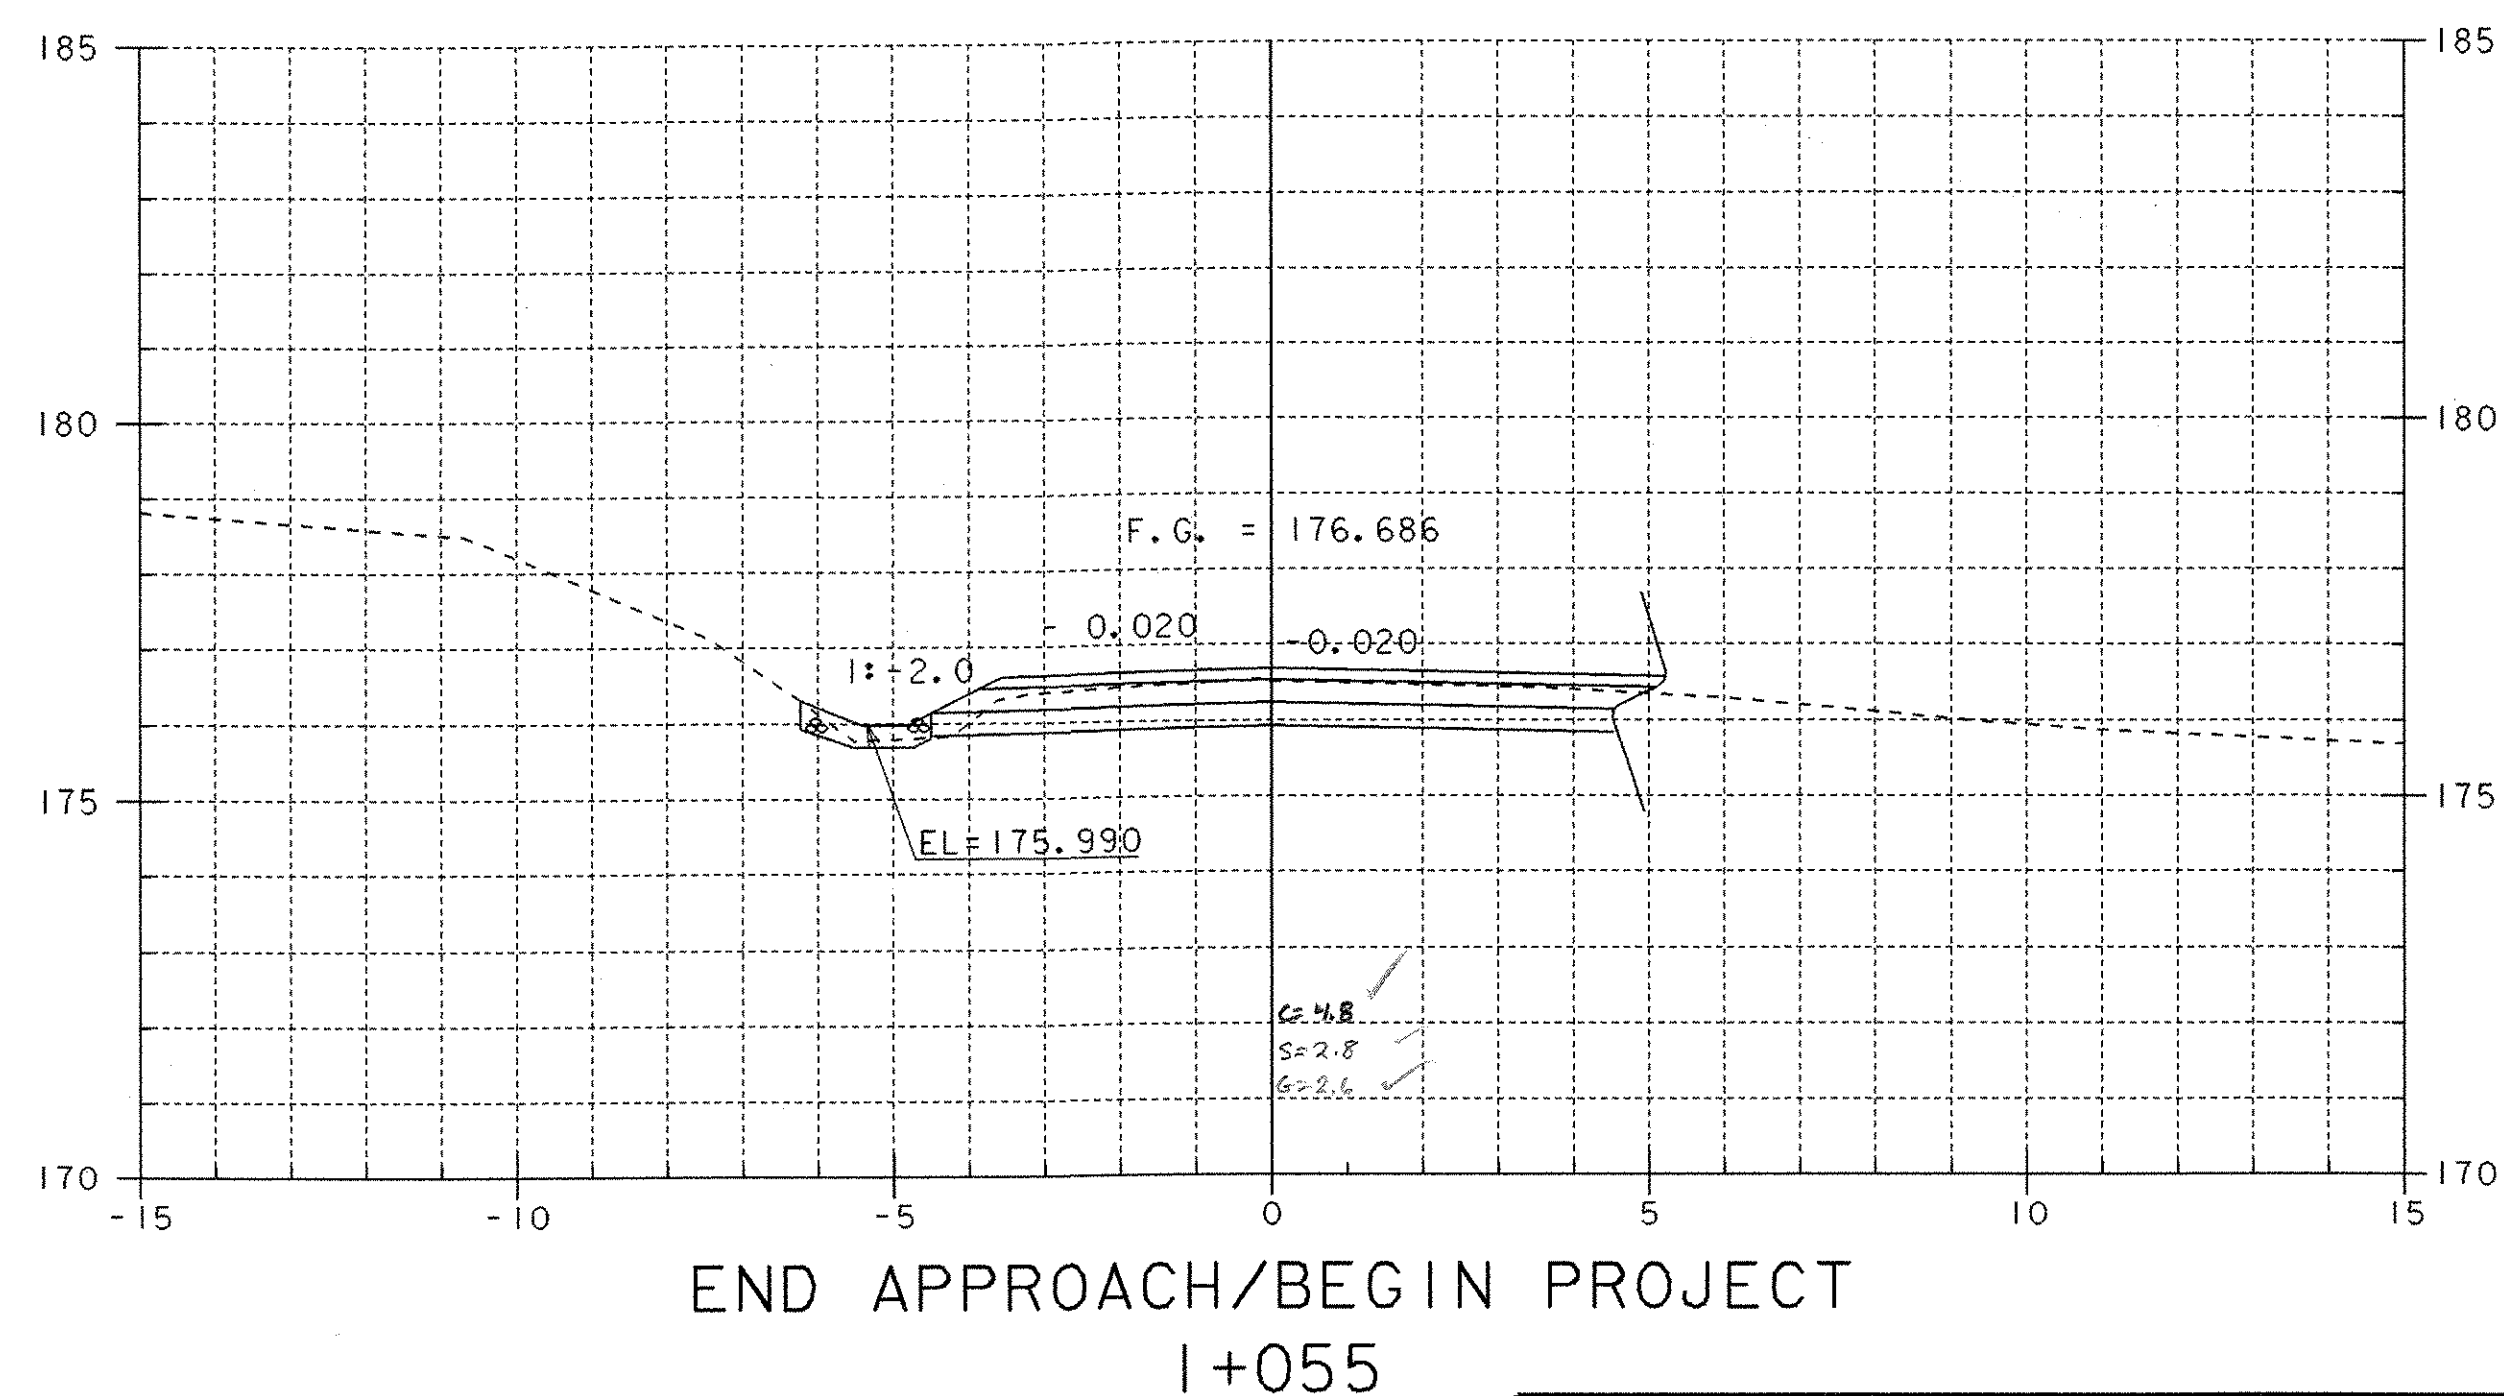

SHEET NAME: MAINLINE CROSS SECTIONS	
PROJECT NAME: WESTFORD	HIGHWAY NO.: TH 4
PROJECT NUMBER: TH2 9436	BRIDGE NO.: 2
	OVER: ROGERS BROOK
FILE NAME: /PW/94J122/sj122xs2.dgn	PLOT DATE: 25-MAR-2005
PROJECT MANAGER: R. R. WHITCOMB	DRAWN BY: STRI
DESIGNED BY: C. CARLSON	IPARM NAME: sj122mx2.1
BRIDGE SHEET NUMBER:	SHEET 45 OF 56