
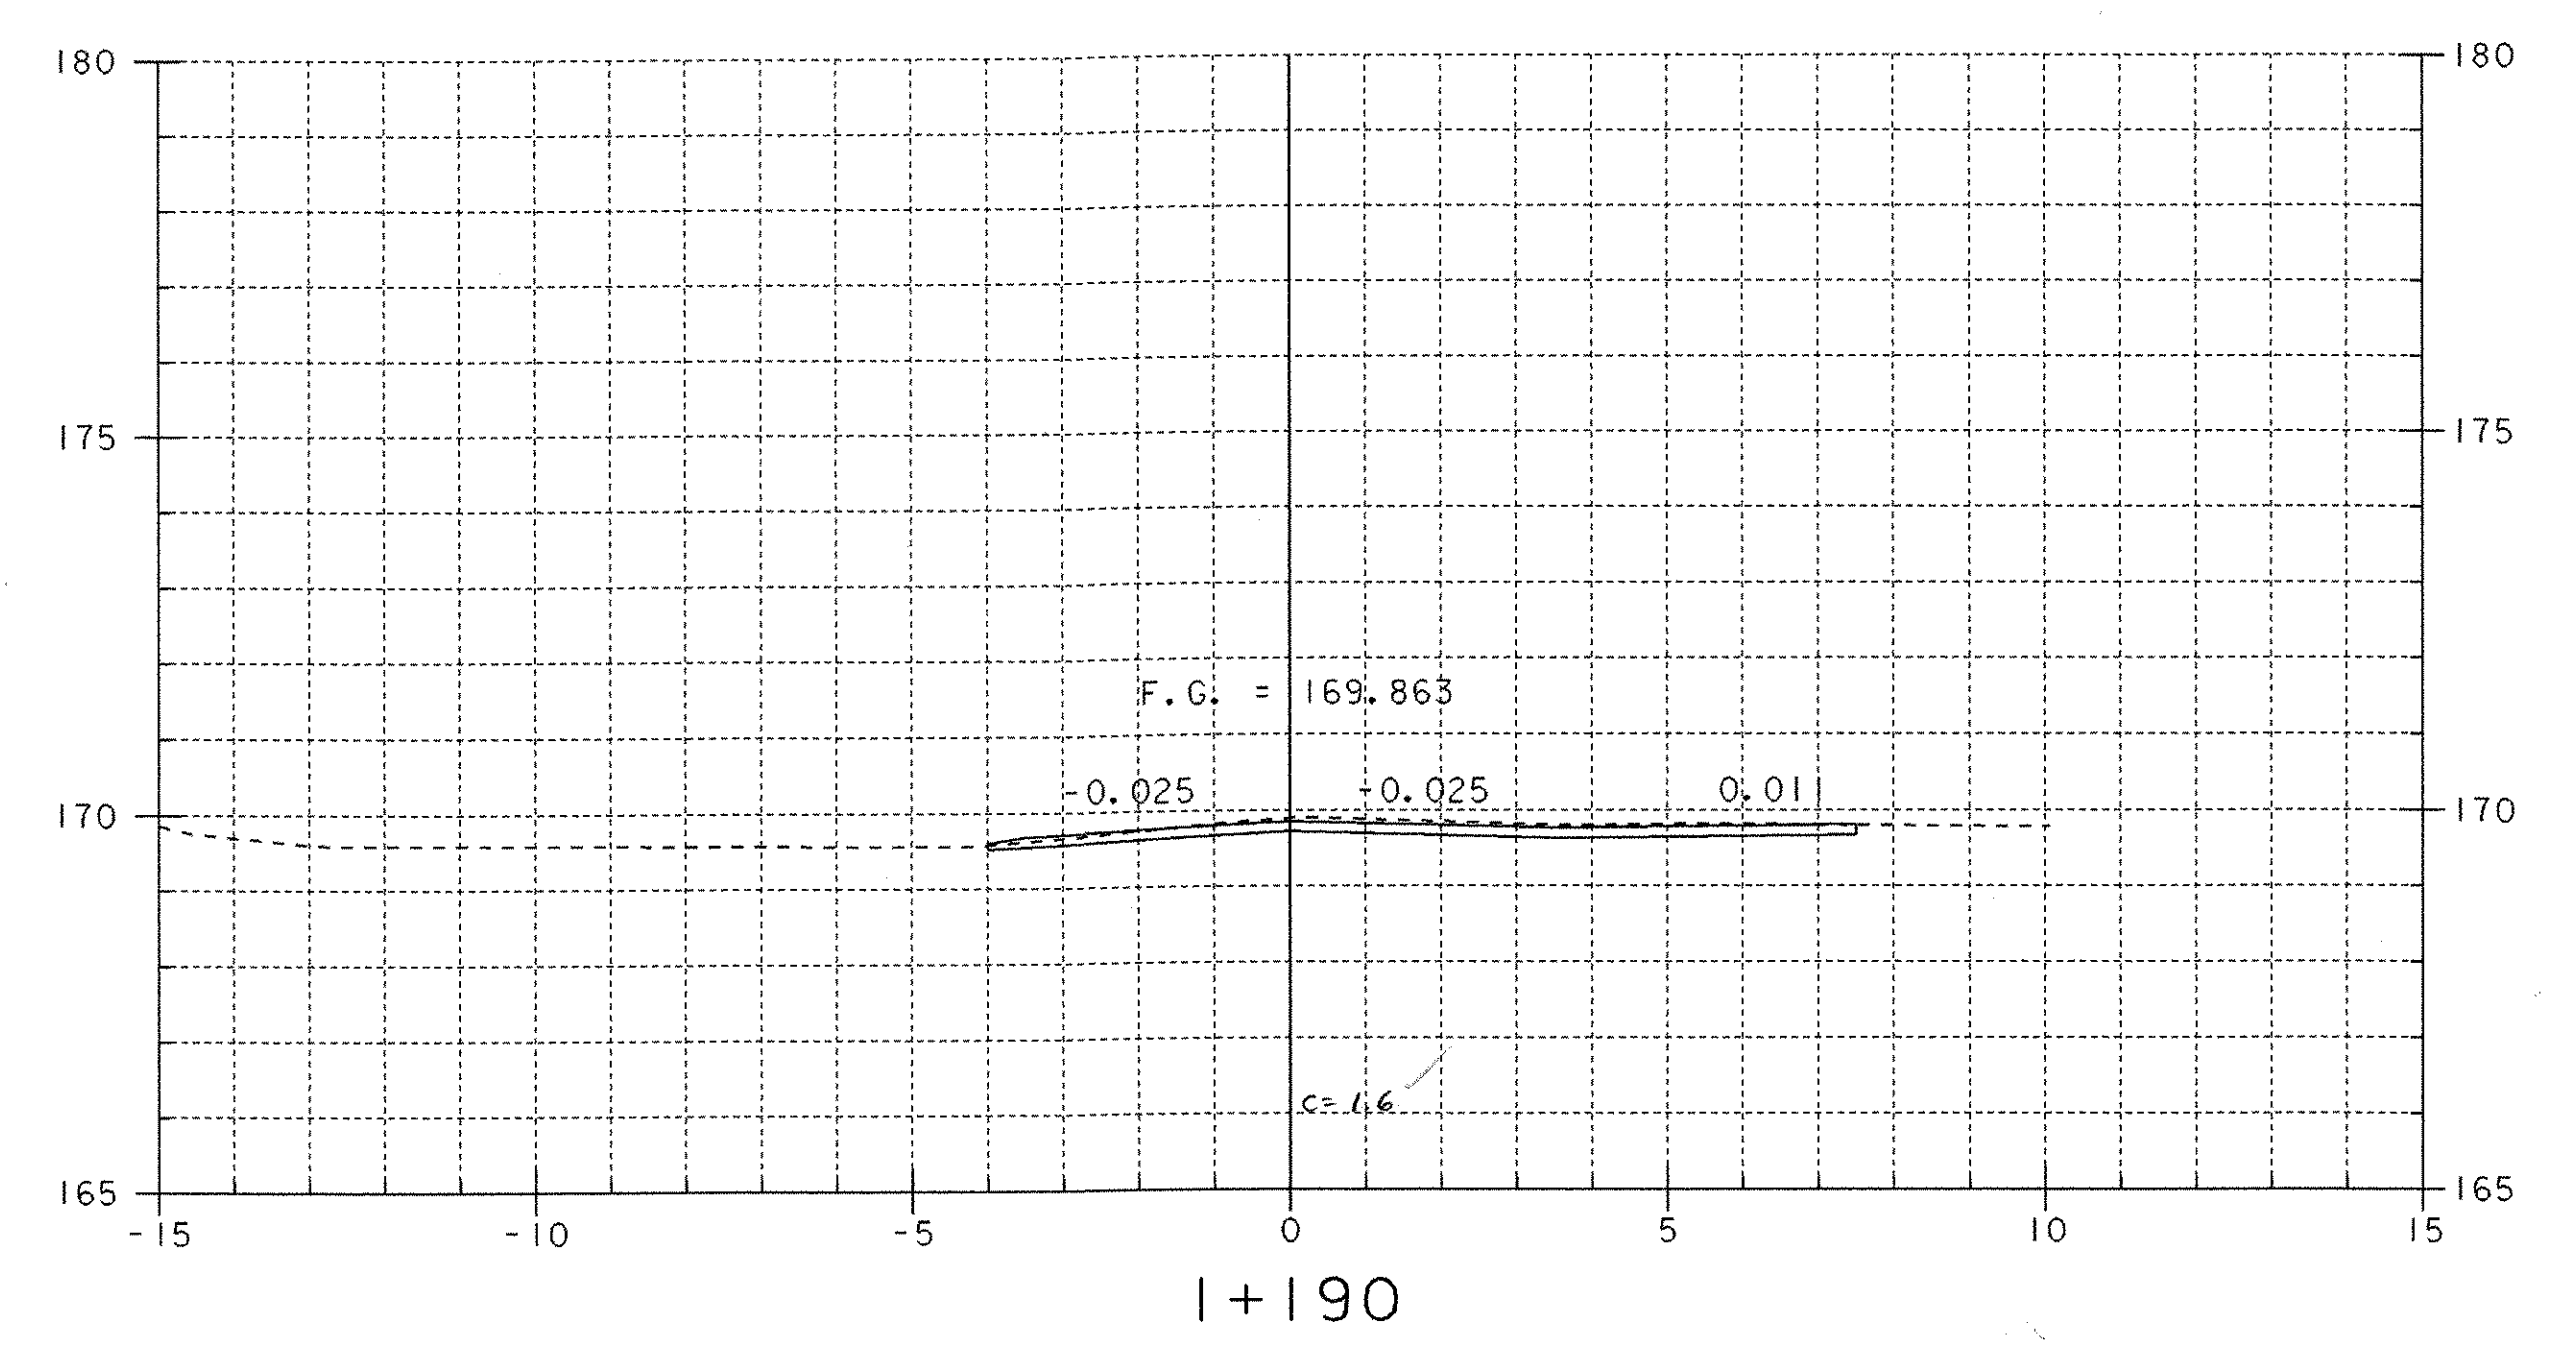
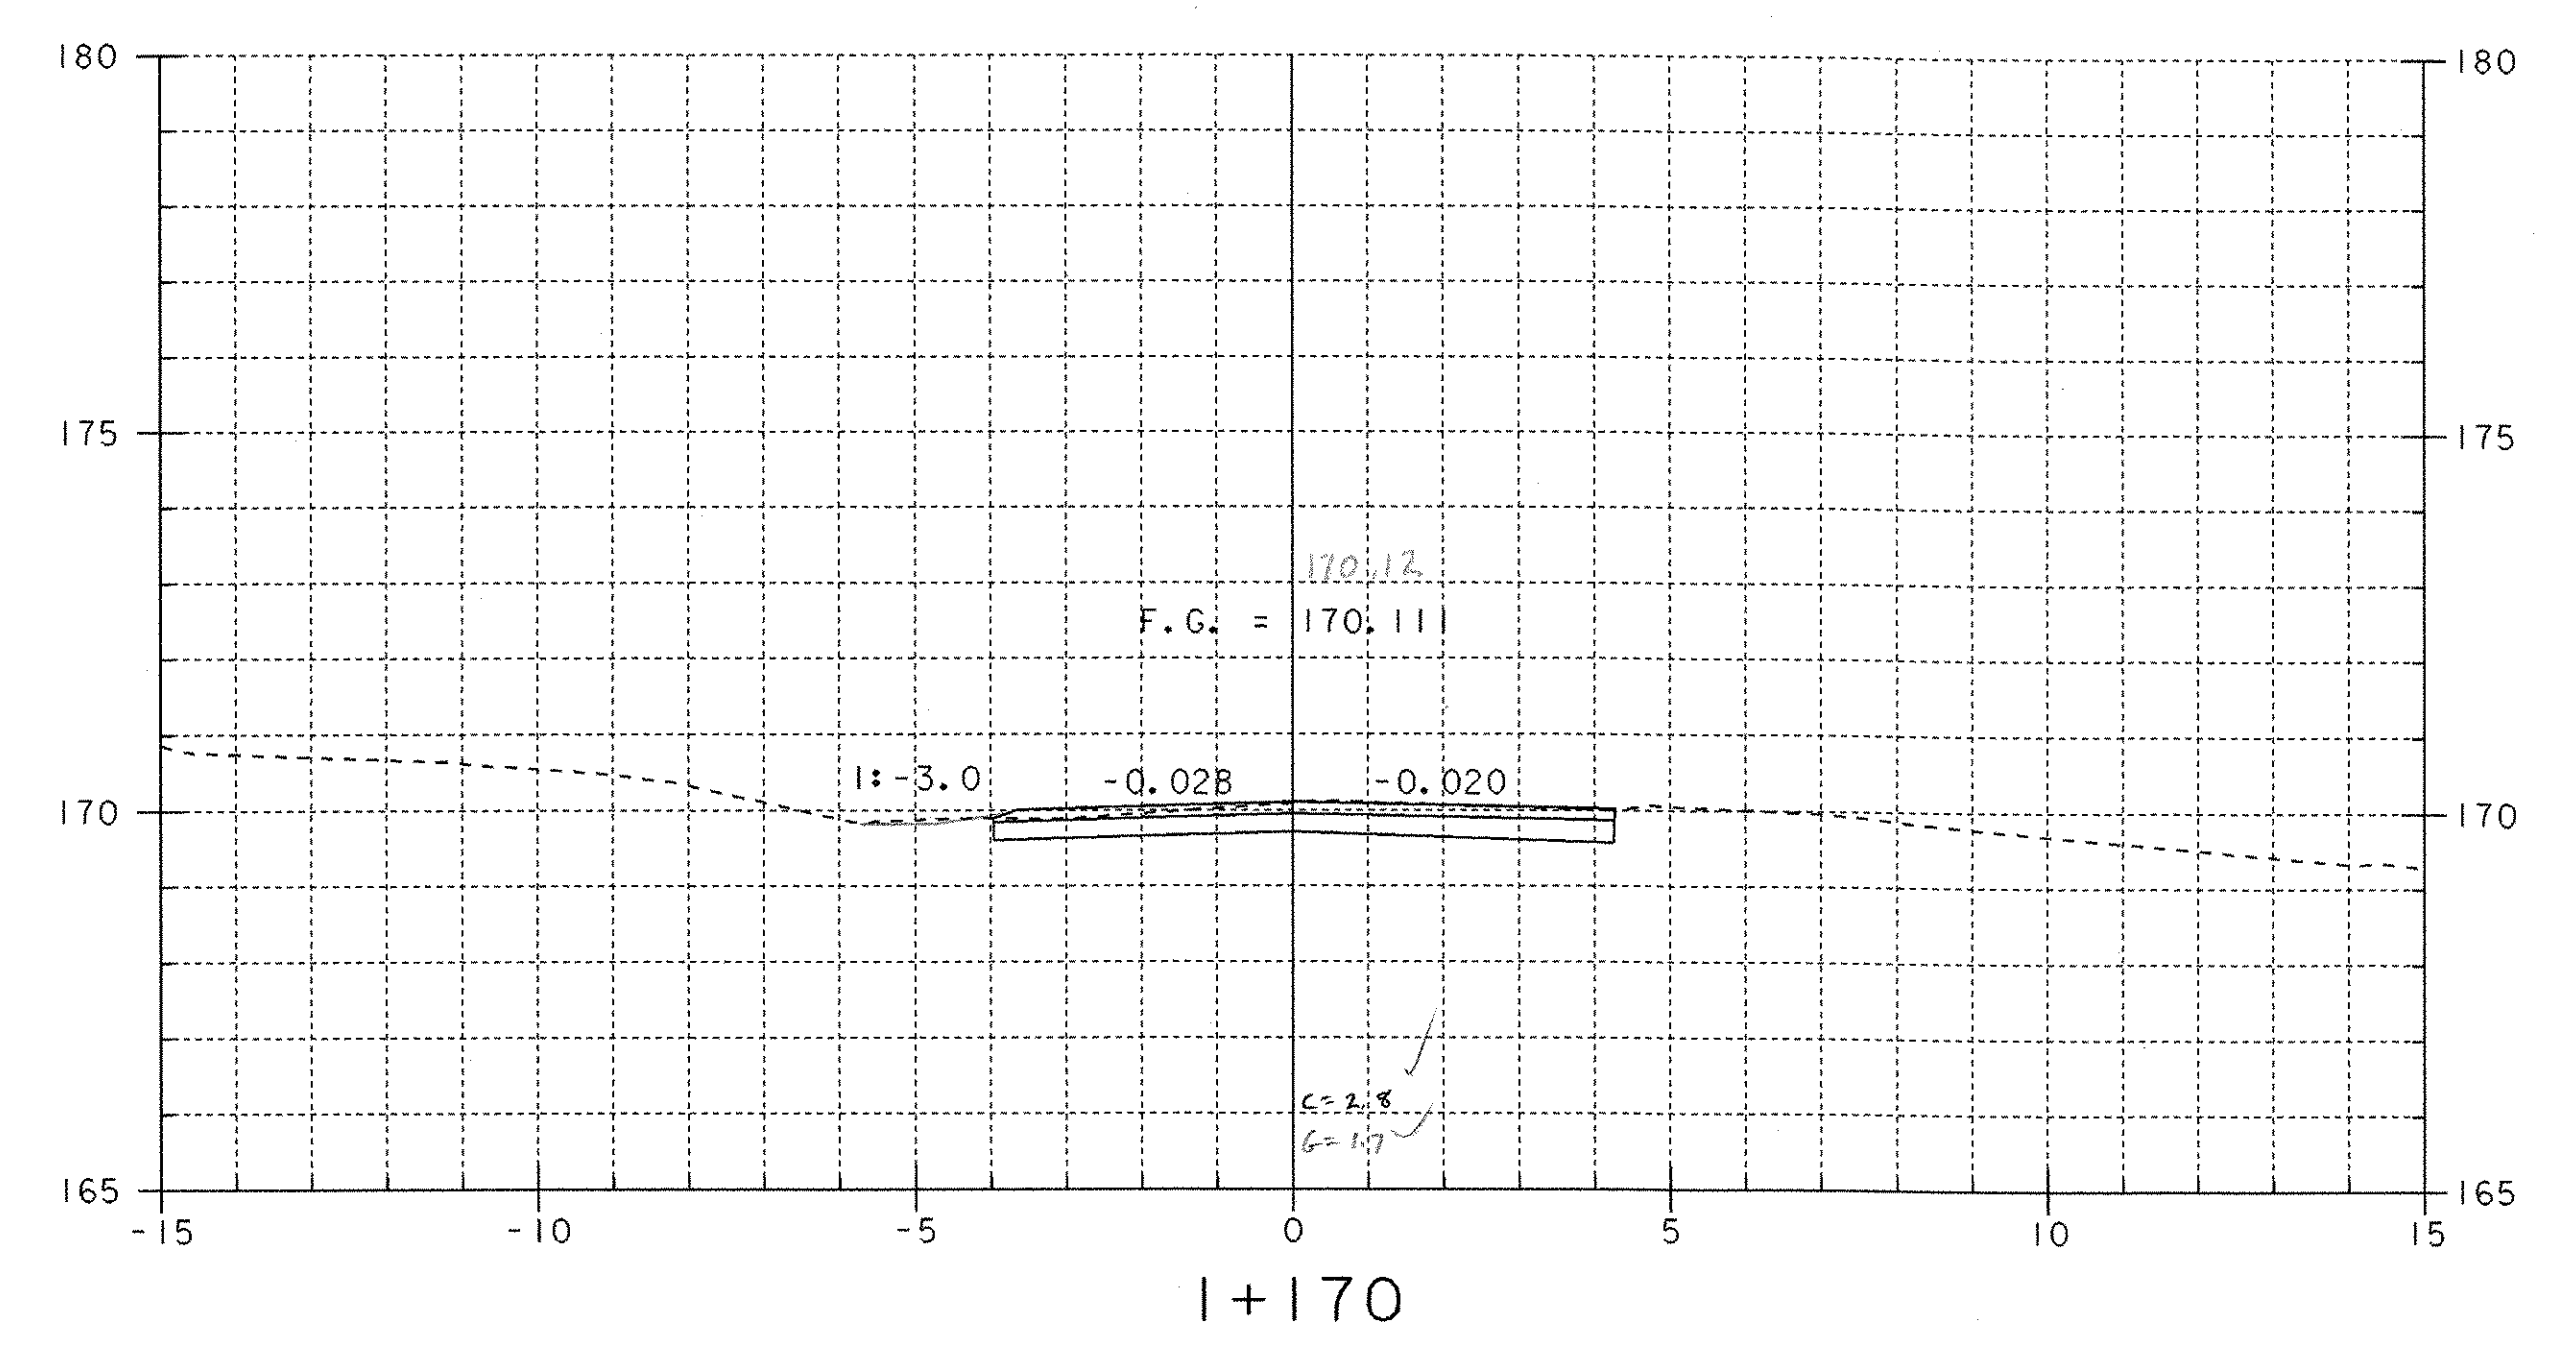
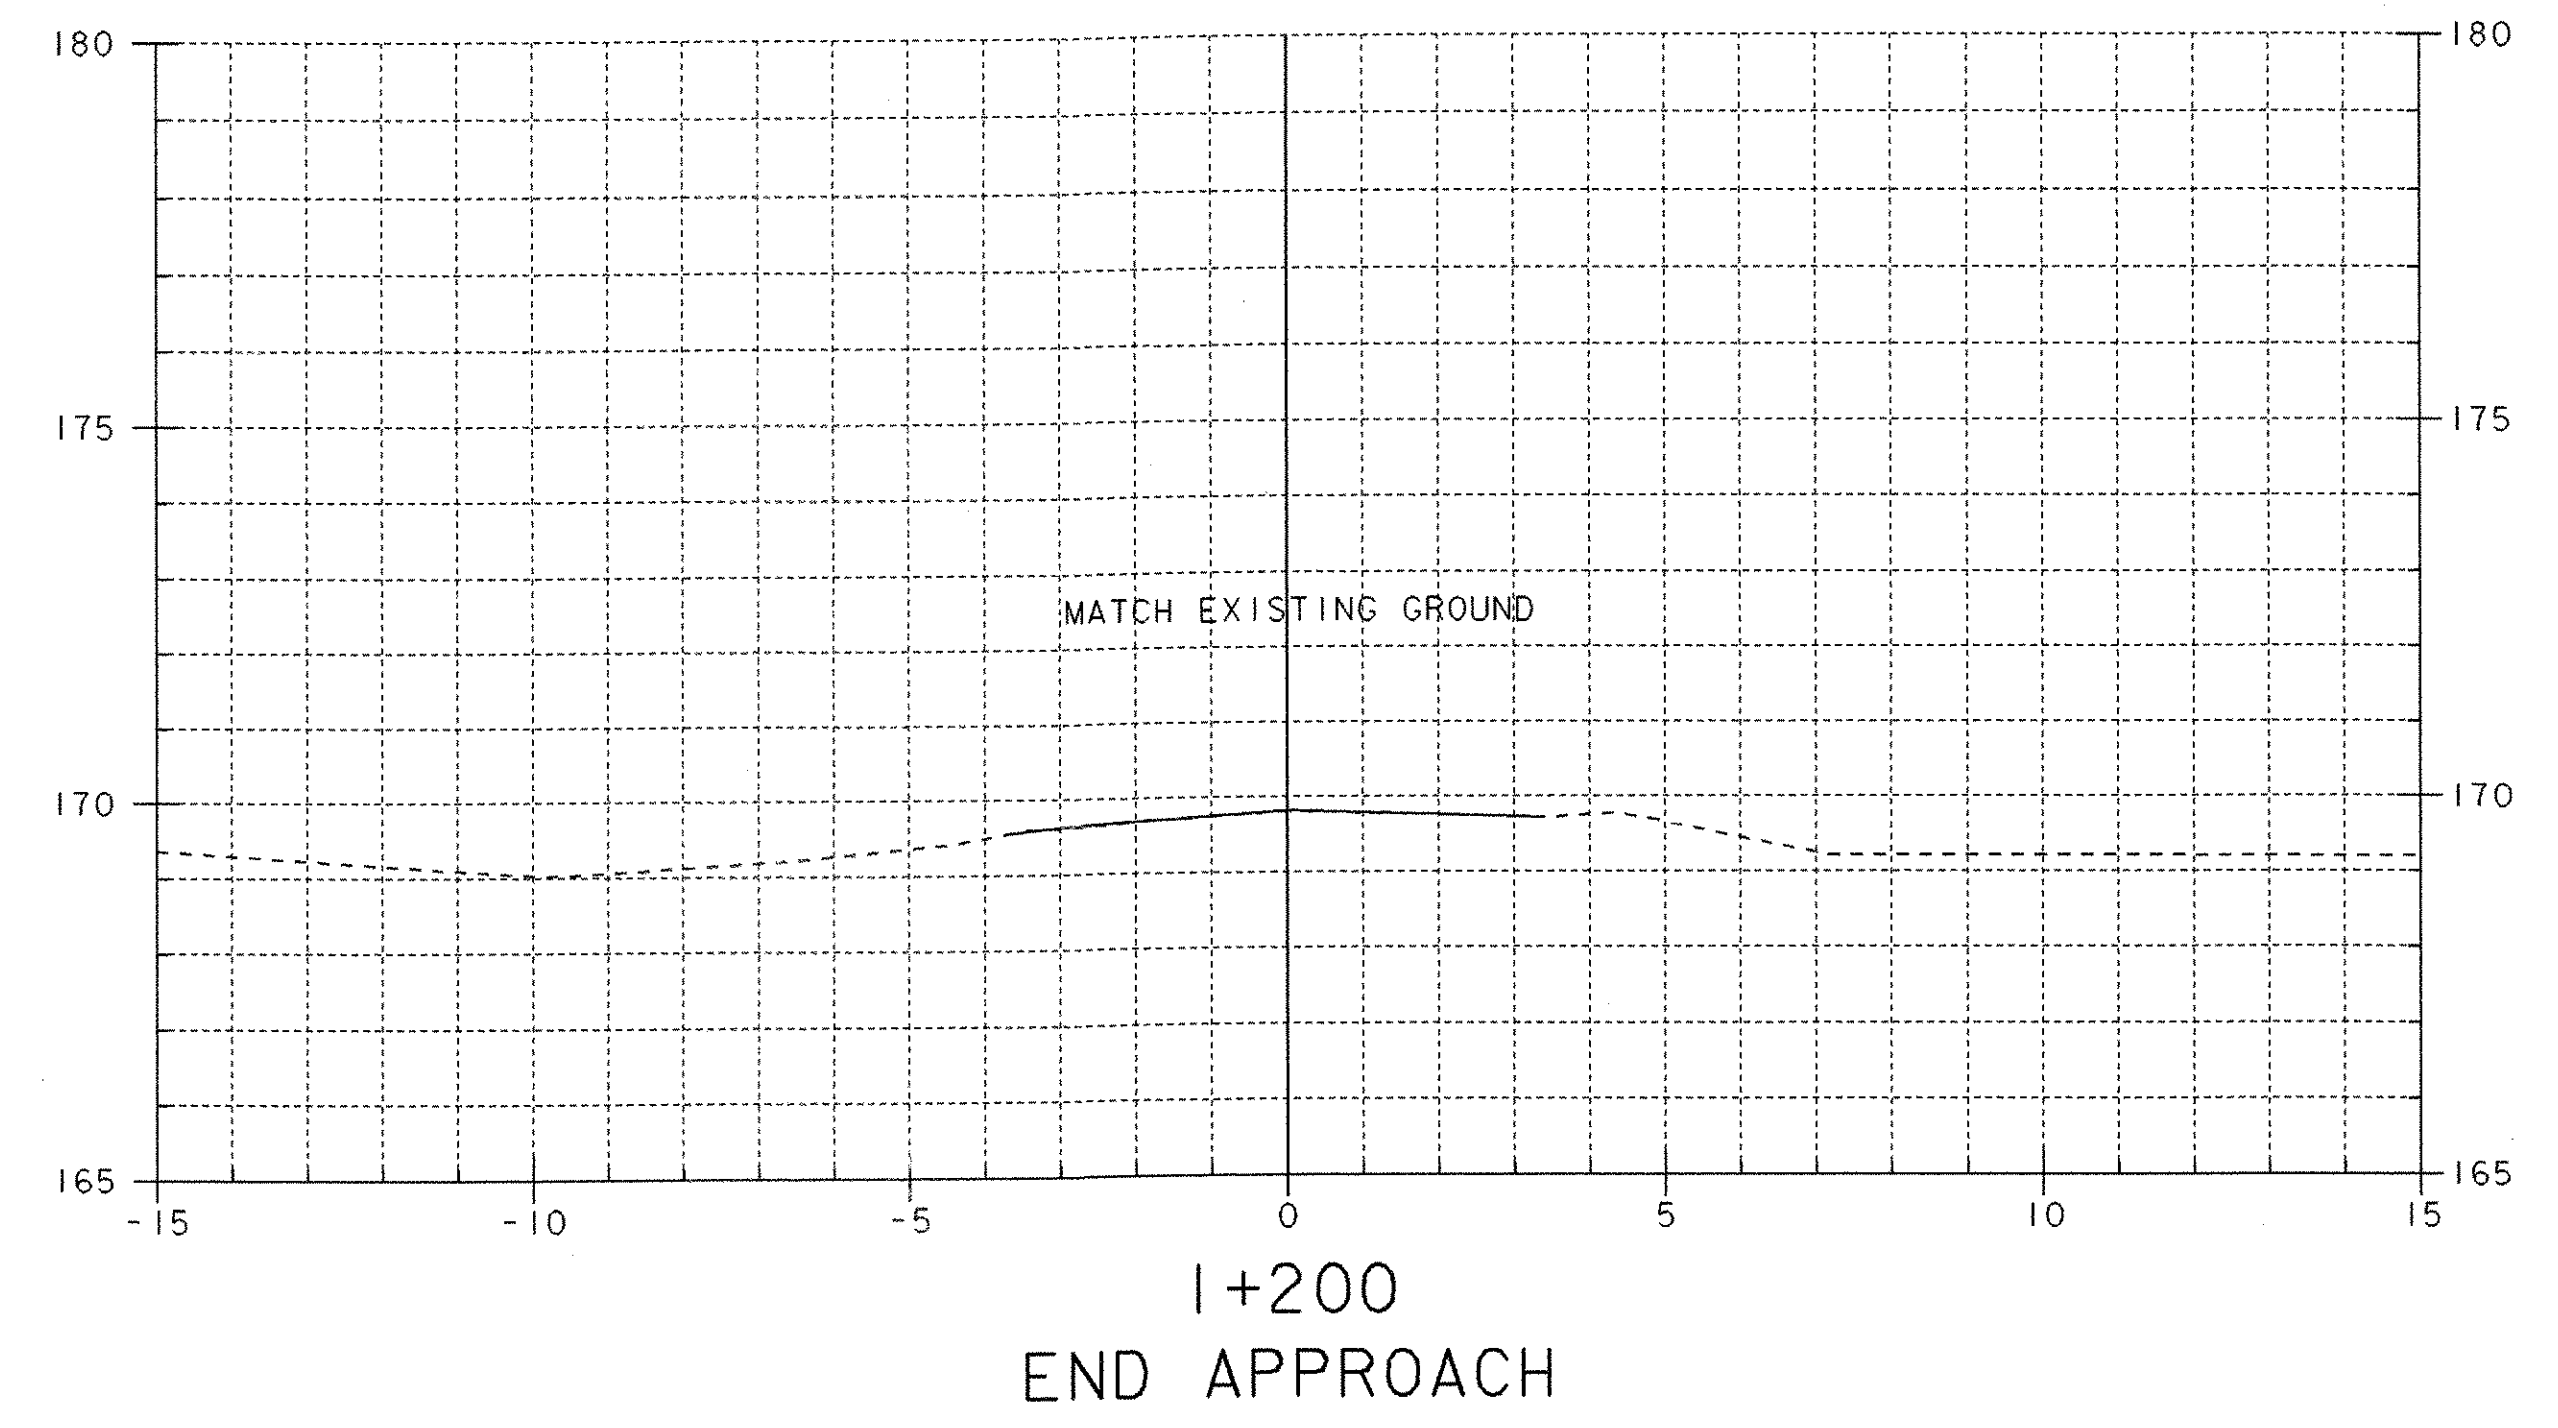


MATERIAL TRANSITION DETAIL
NTS

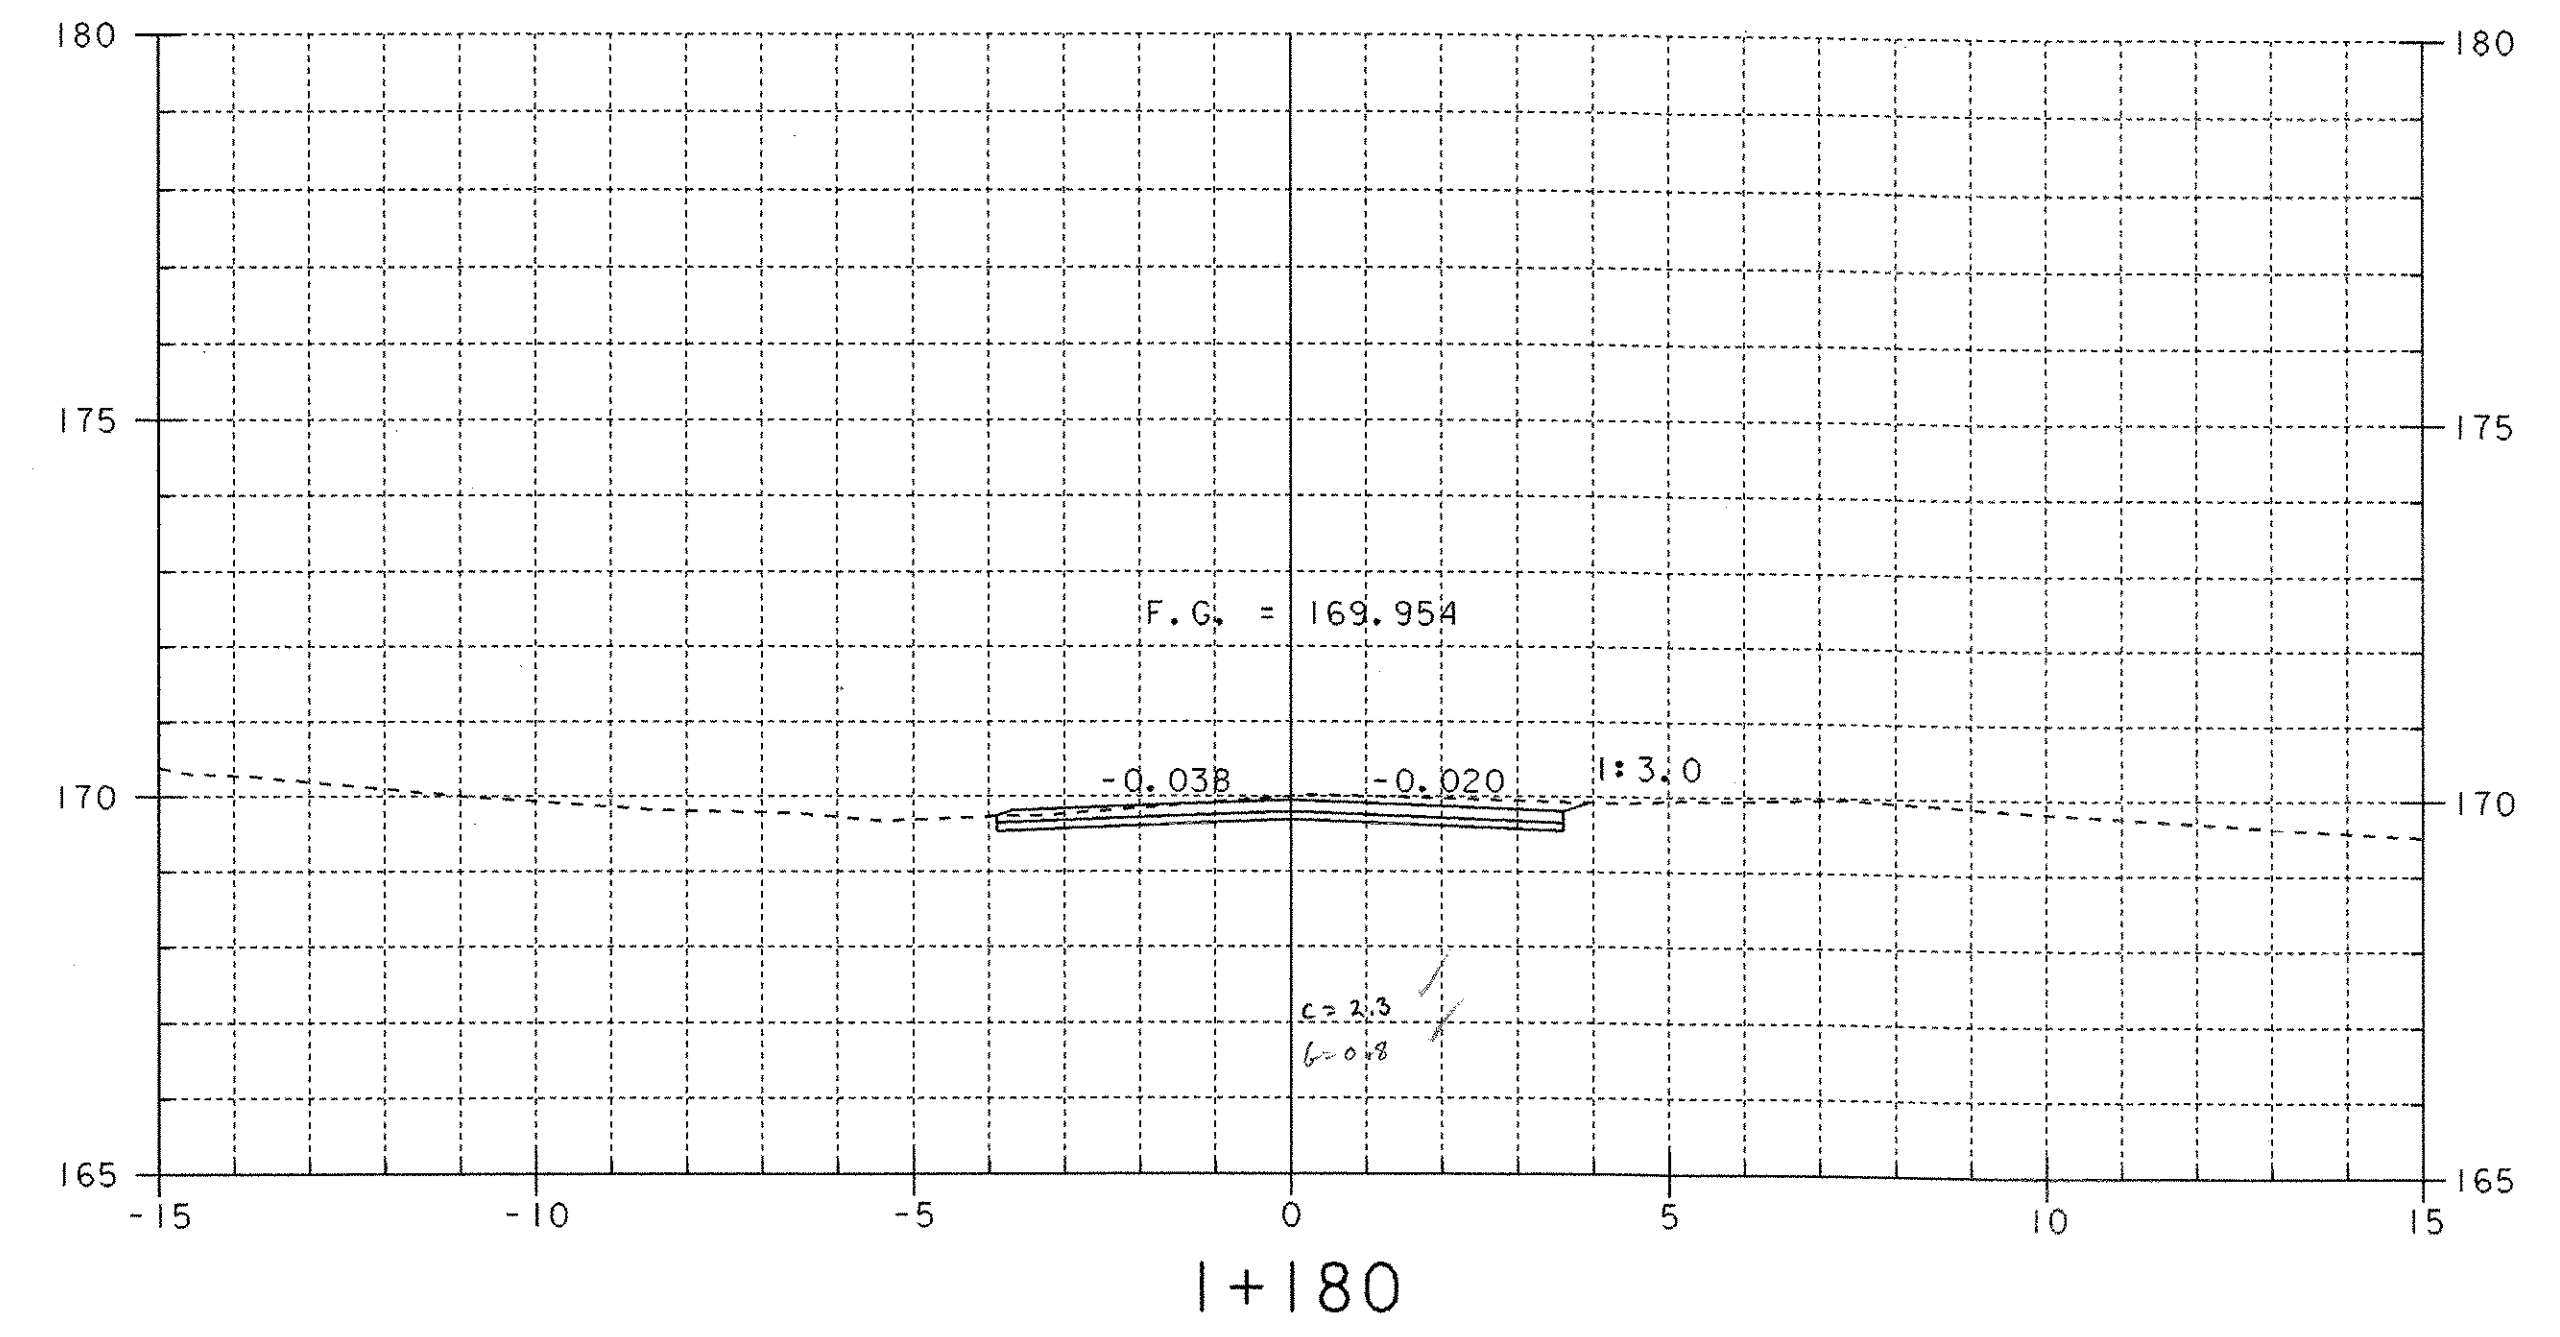

SHEET NAME: MAINLINE CROSS SECTIONS	
PROJECT NAME: WESTFORD	HIGHWAY NO.: TH 4
PROJECT NUMBER: TH2 9436	BRIDGE NO.: 2
	OVER: ROGERS BROOK
FILE NAME: /PW/94/j22/sj22xs2.dgn	PLOT DATE: 25-MAR-2005
PROJECT MANAGER: R. R. WHITCOMB	DRAWN BY: STRI
DESIGNED BY: C. CARLSON	IPARM NAME: sj22m6.i
BRIDGE SHEET NUMBER:	SHEET 49 OF 56