




I+034
DRIVE RIGHT

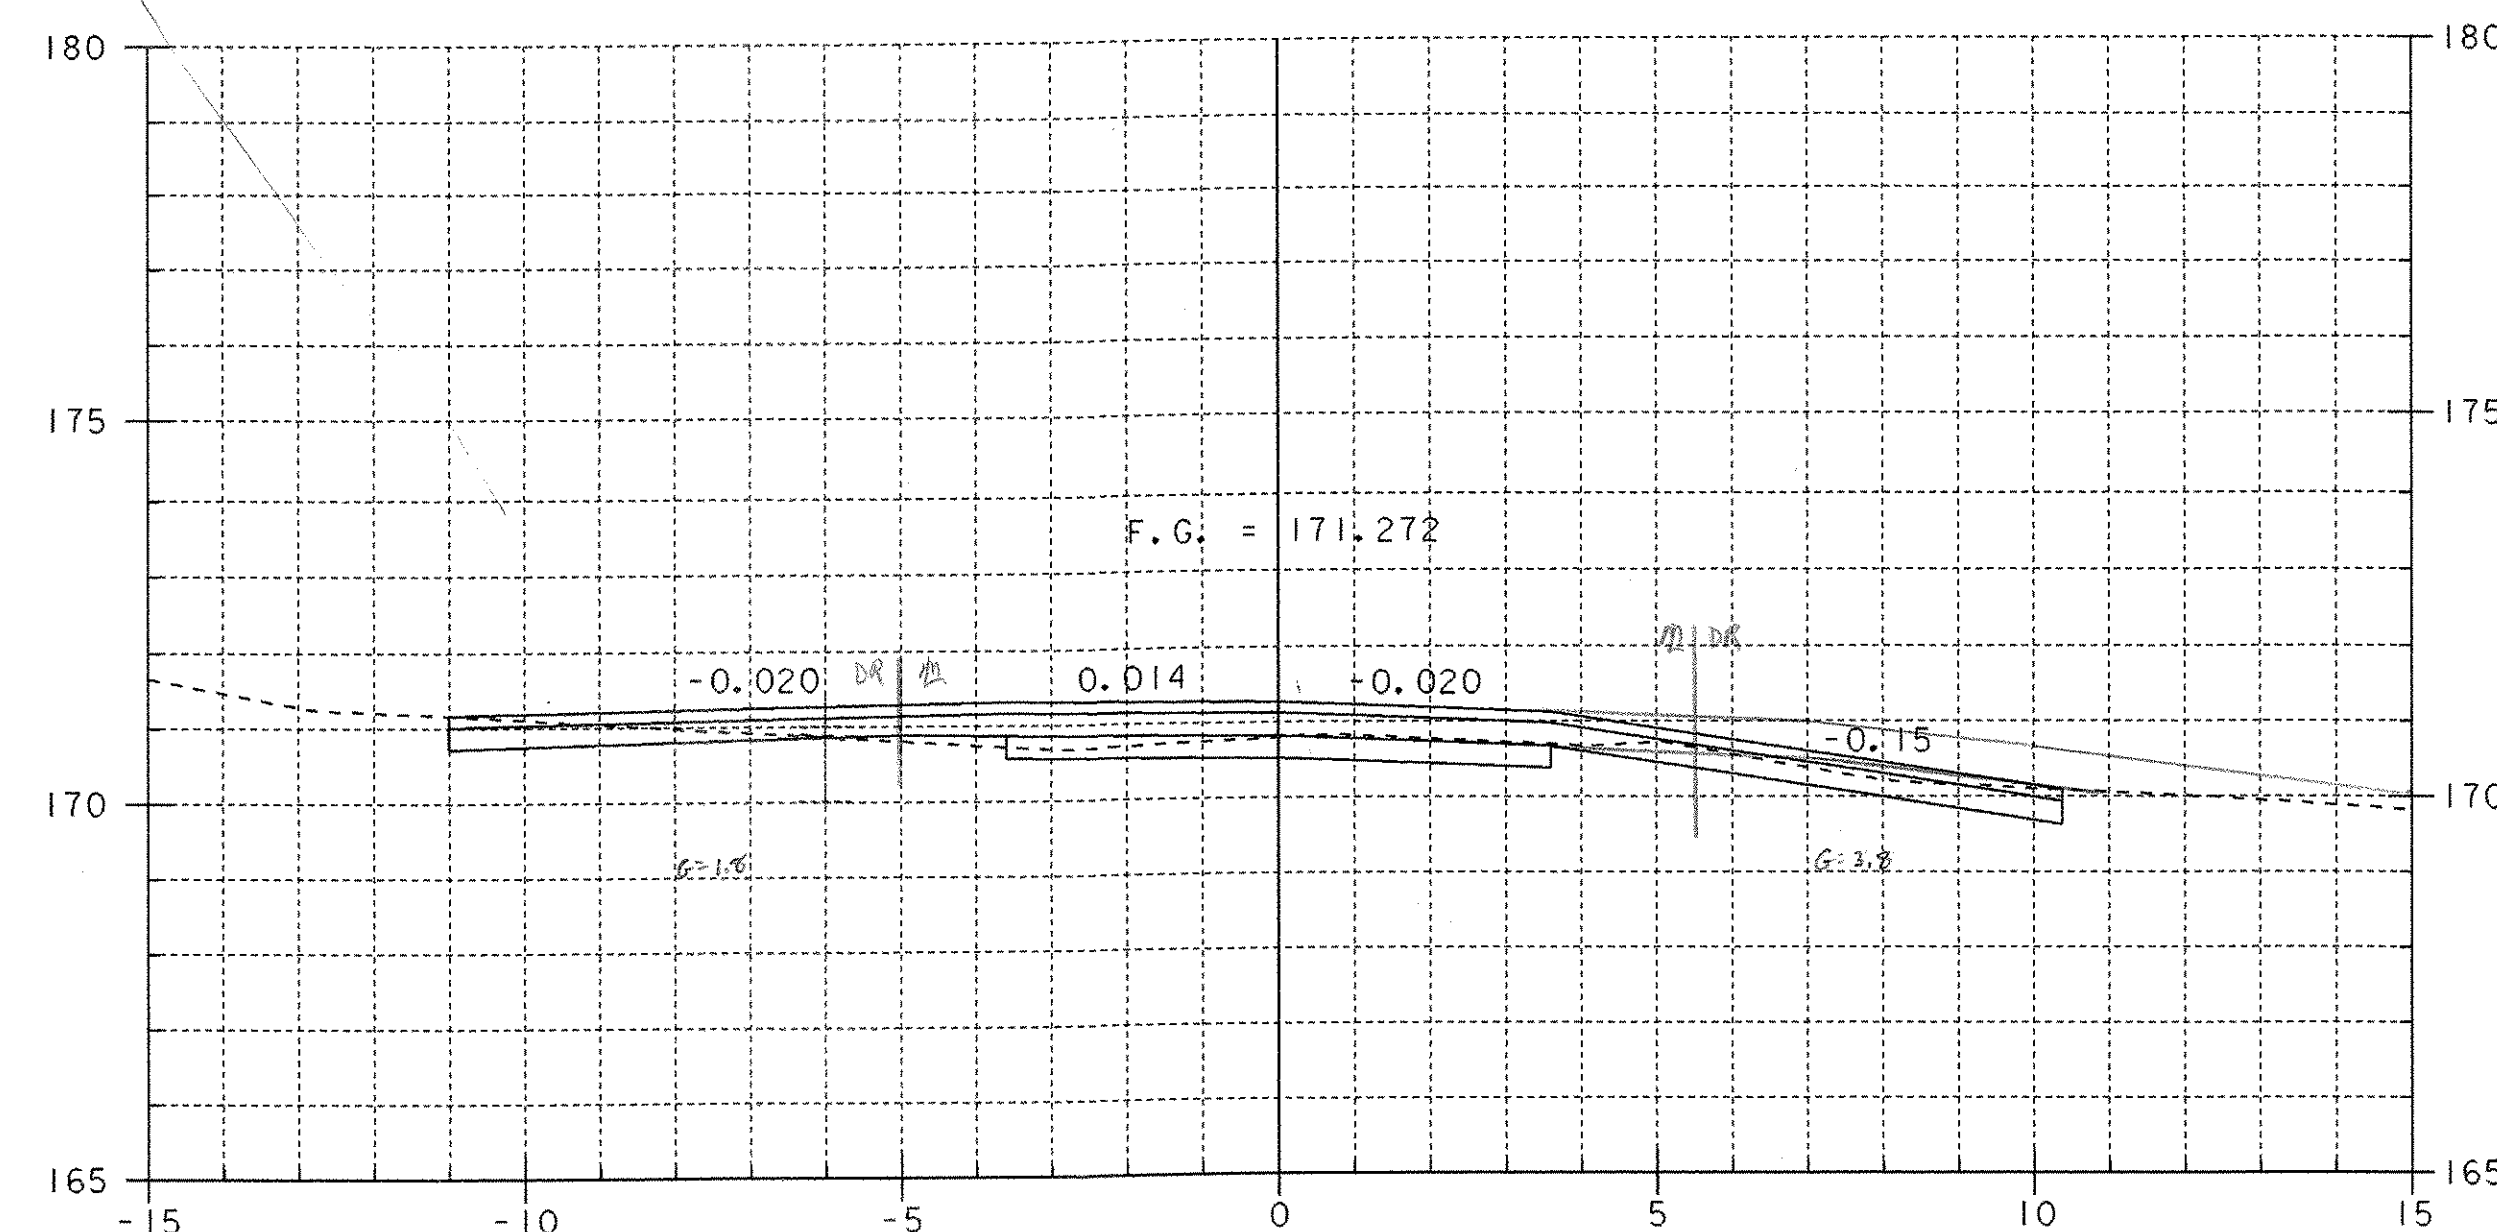

I+133
DRIVE LEFT *RT*

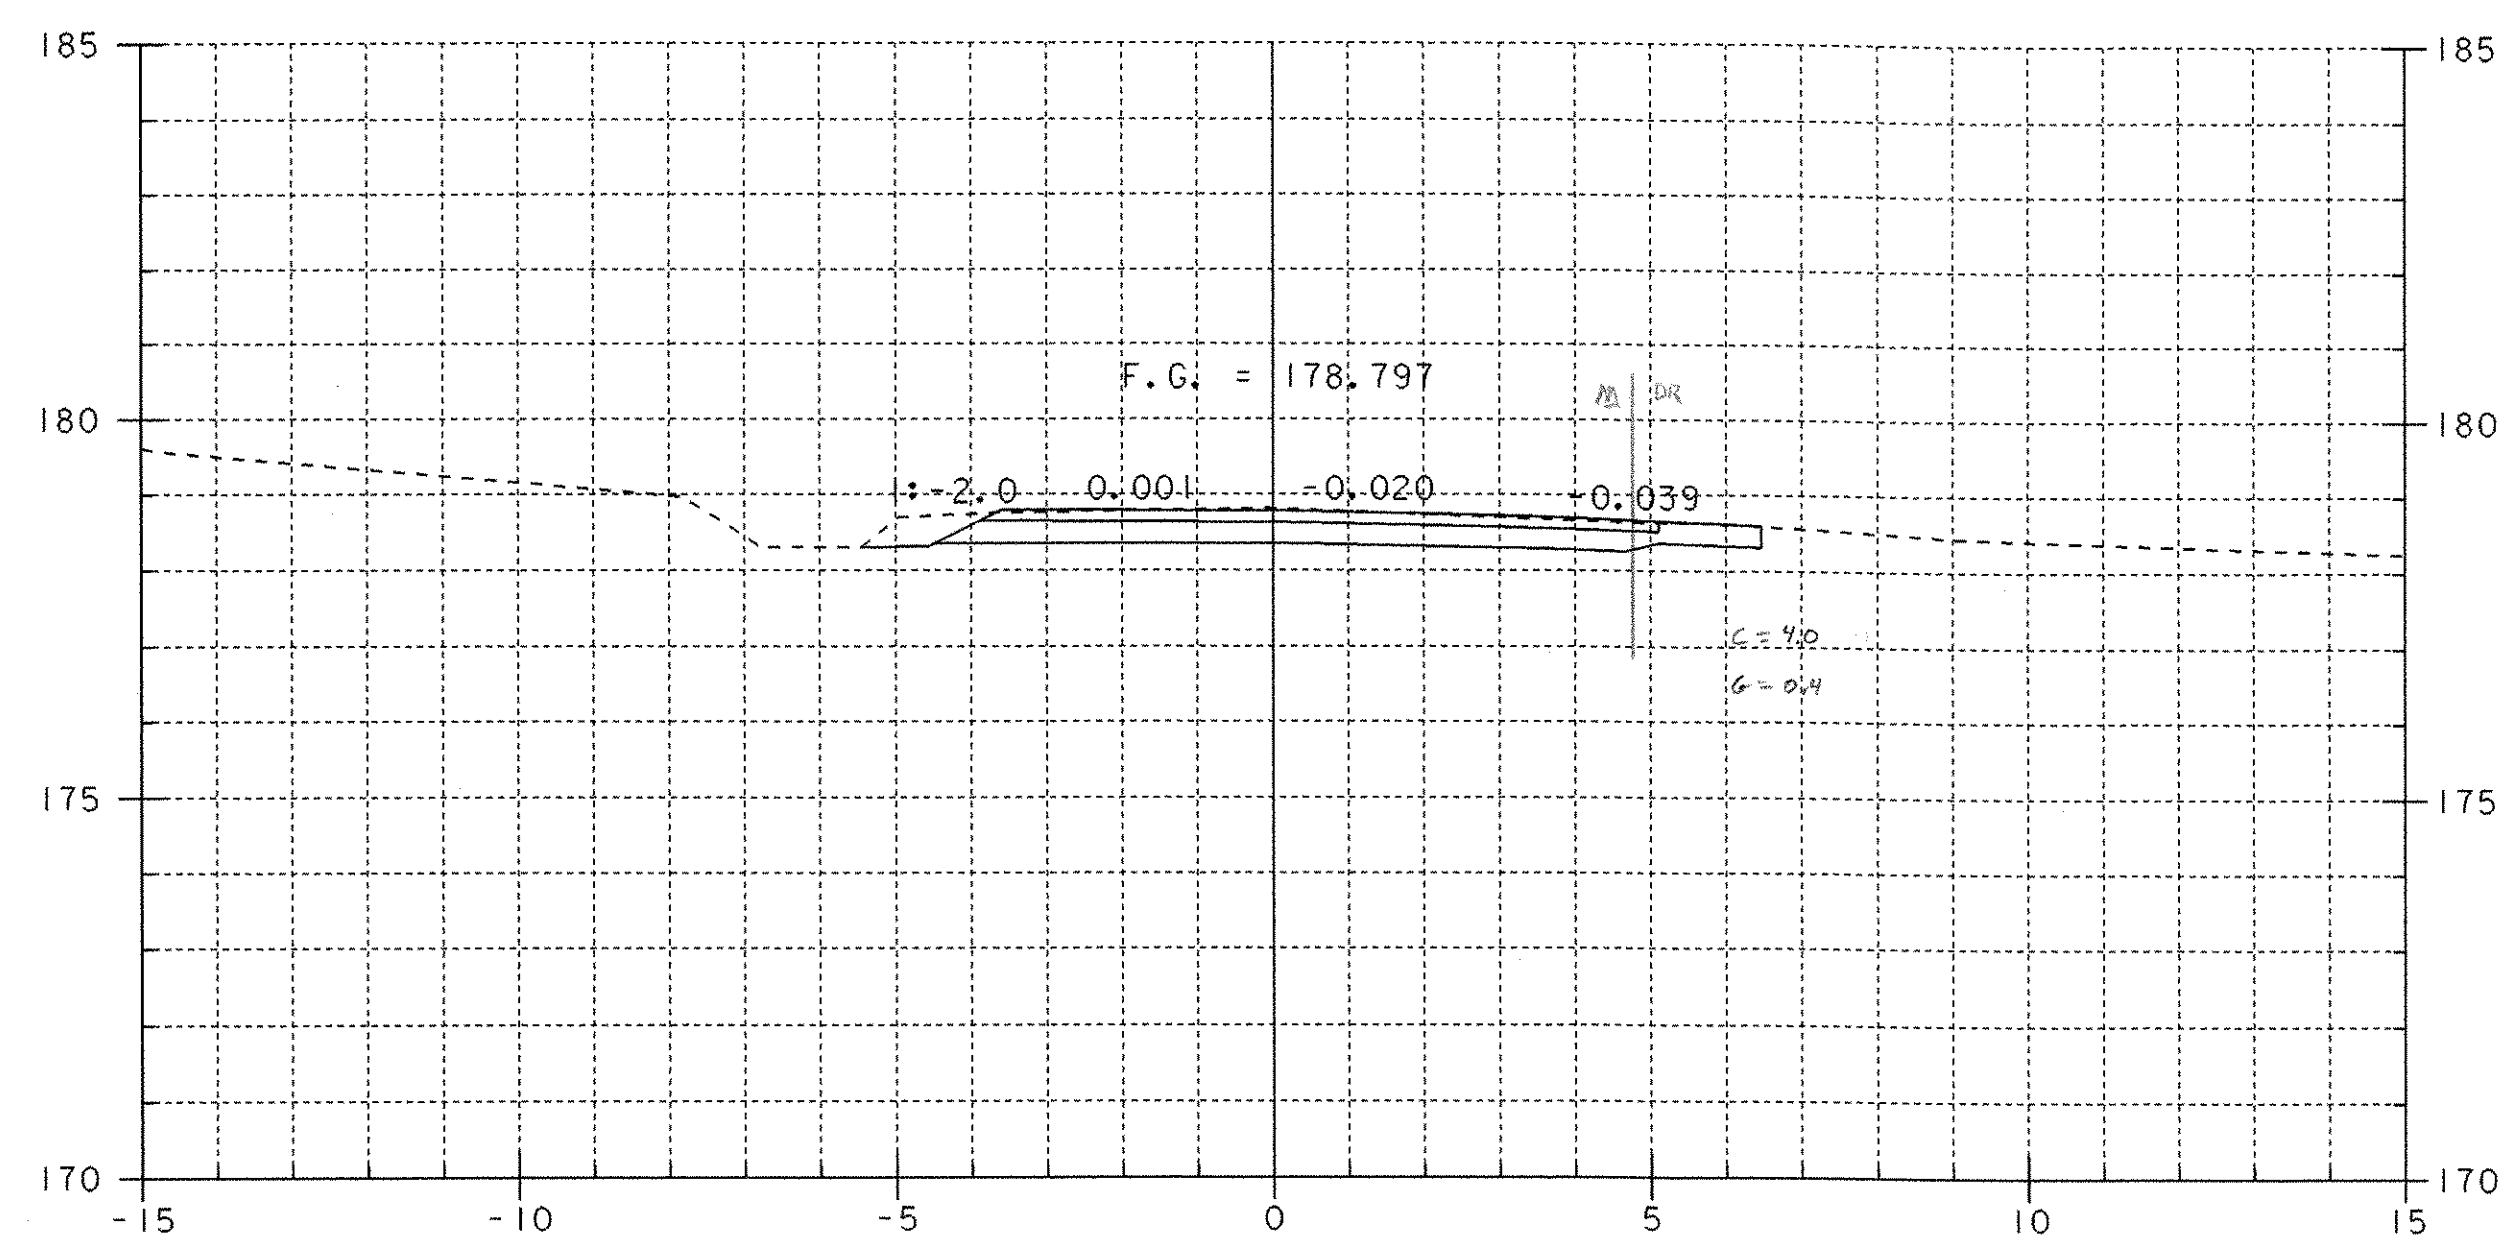

I+023
DRIVE RIGHT

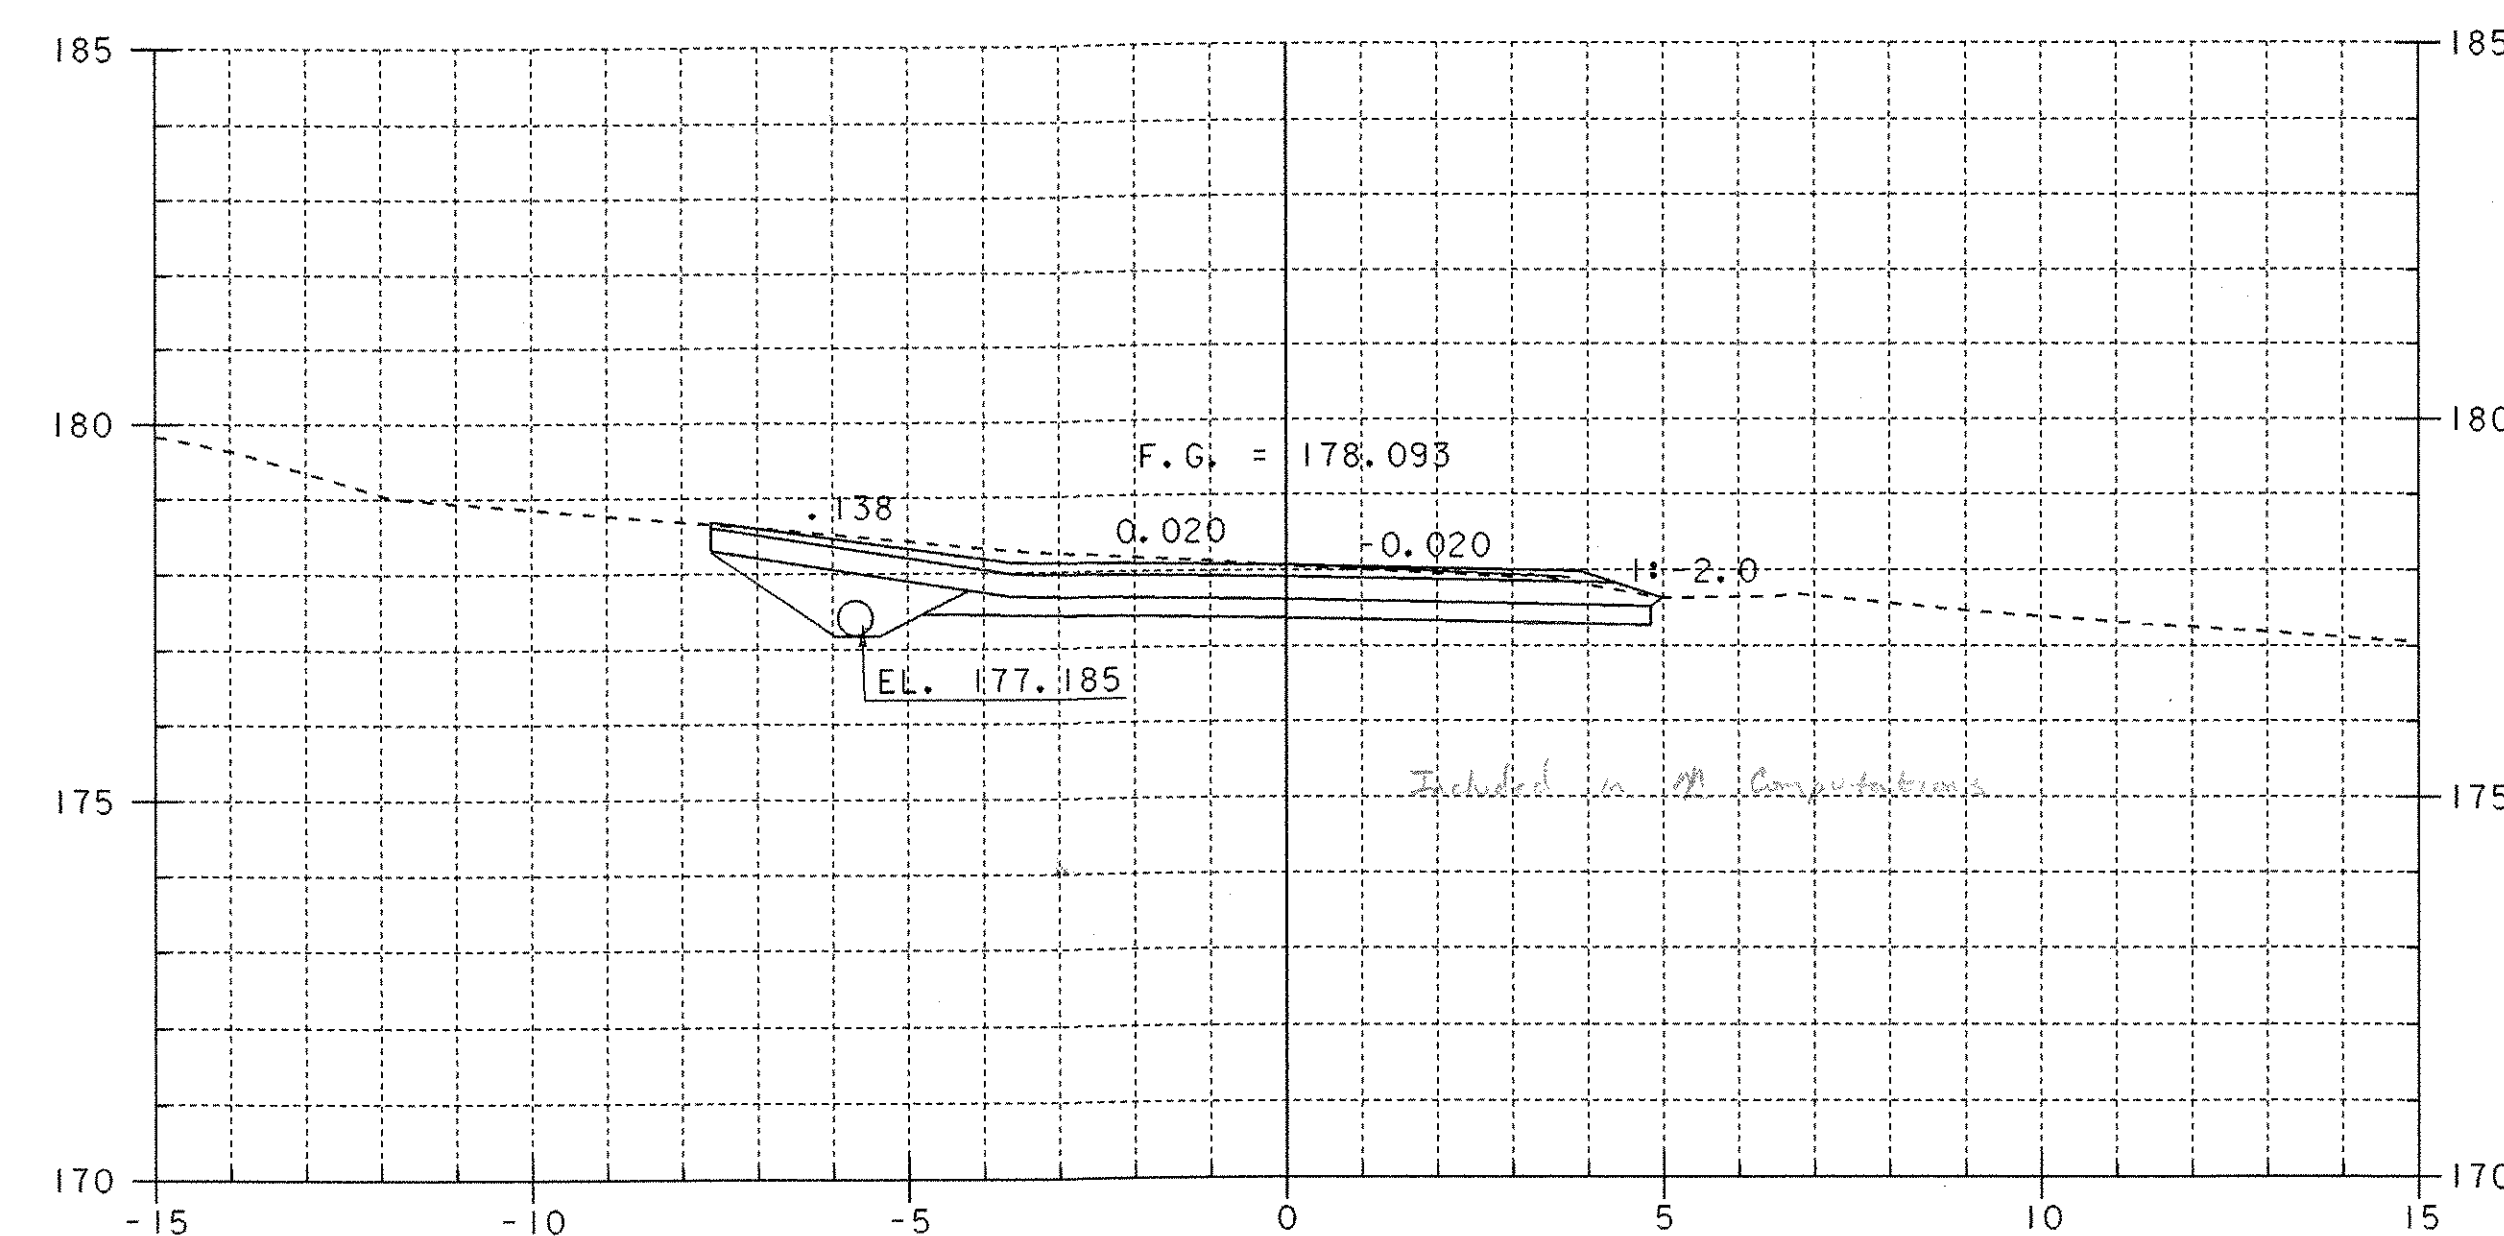

I+037
DRIVE LEFT

SHEET NAME: DRIVE CROSS SECTIONS	
PROJECT NAME: WESTFORD	HIGHWAY NO.: TH 4
PROJECT NUMBER: TH2 9436	BRIDGE NO.: 2
	OVER: ROGERS BROOK
FILE NAME: /PW/941122/sj122xs2.dgn	PLOT DATE: 25-MAR-2005
PROJECT MANAGER: R. R. WHITCOMB	DRAWN BY: STRI
DESIGNED BY: C. CARLSON	IPARM NAME: sj122dx1.1
BRIDGE SHEET NUMBER:	SHEET 50 OF 56