

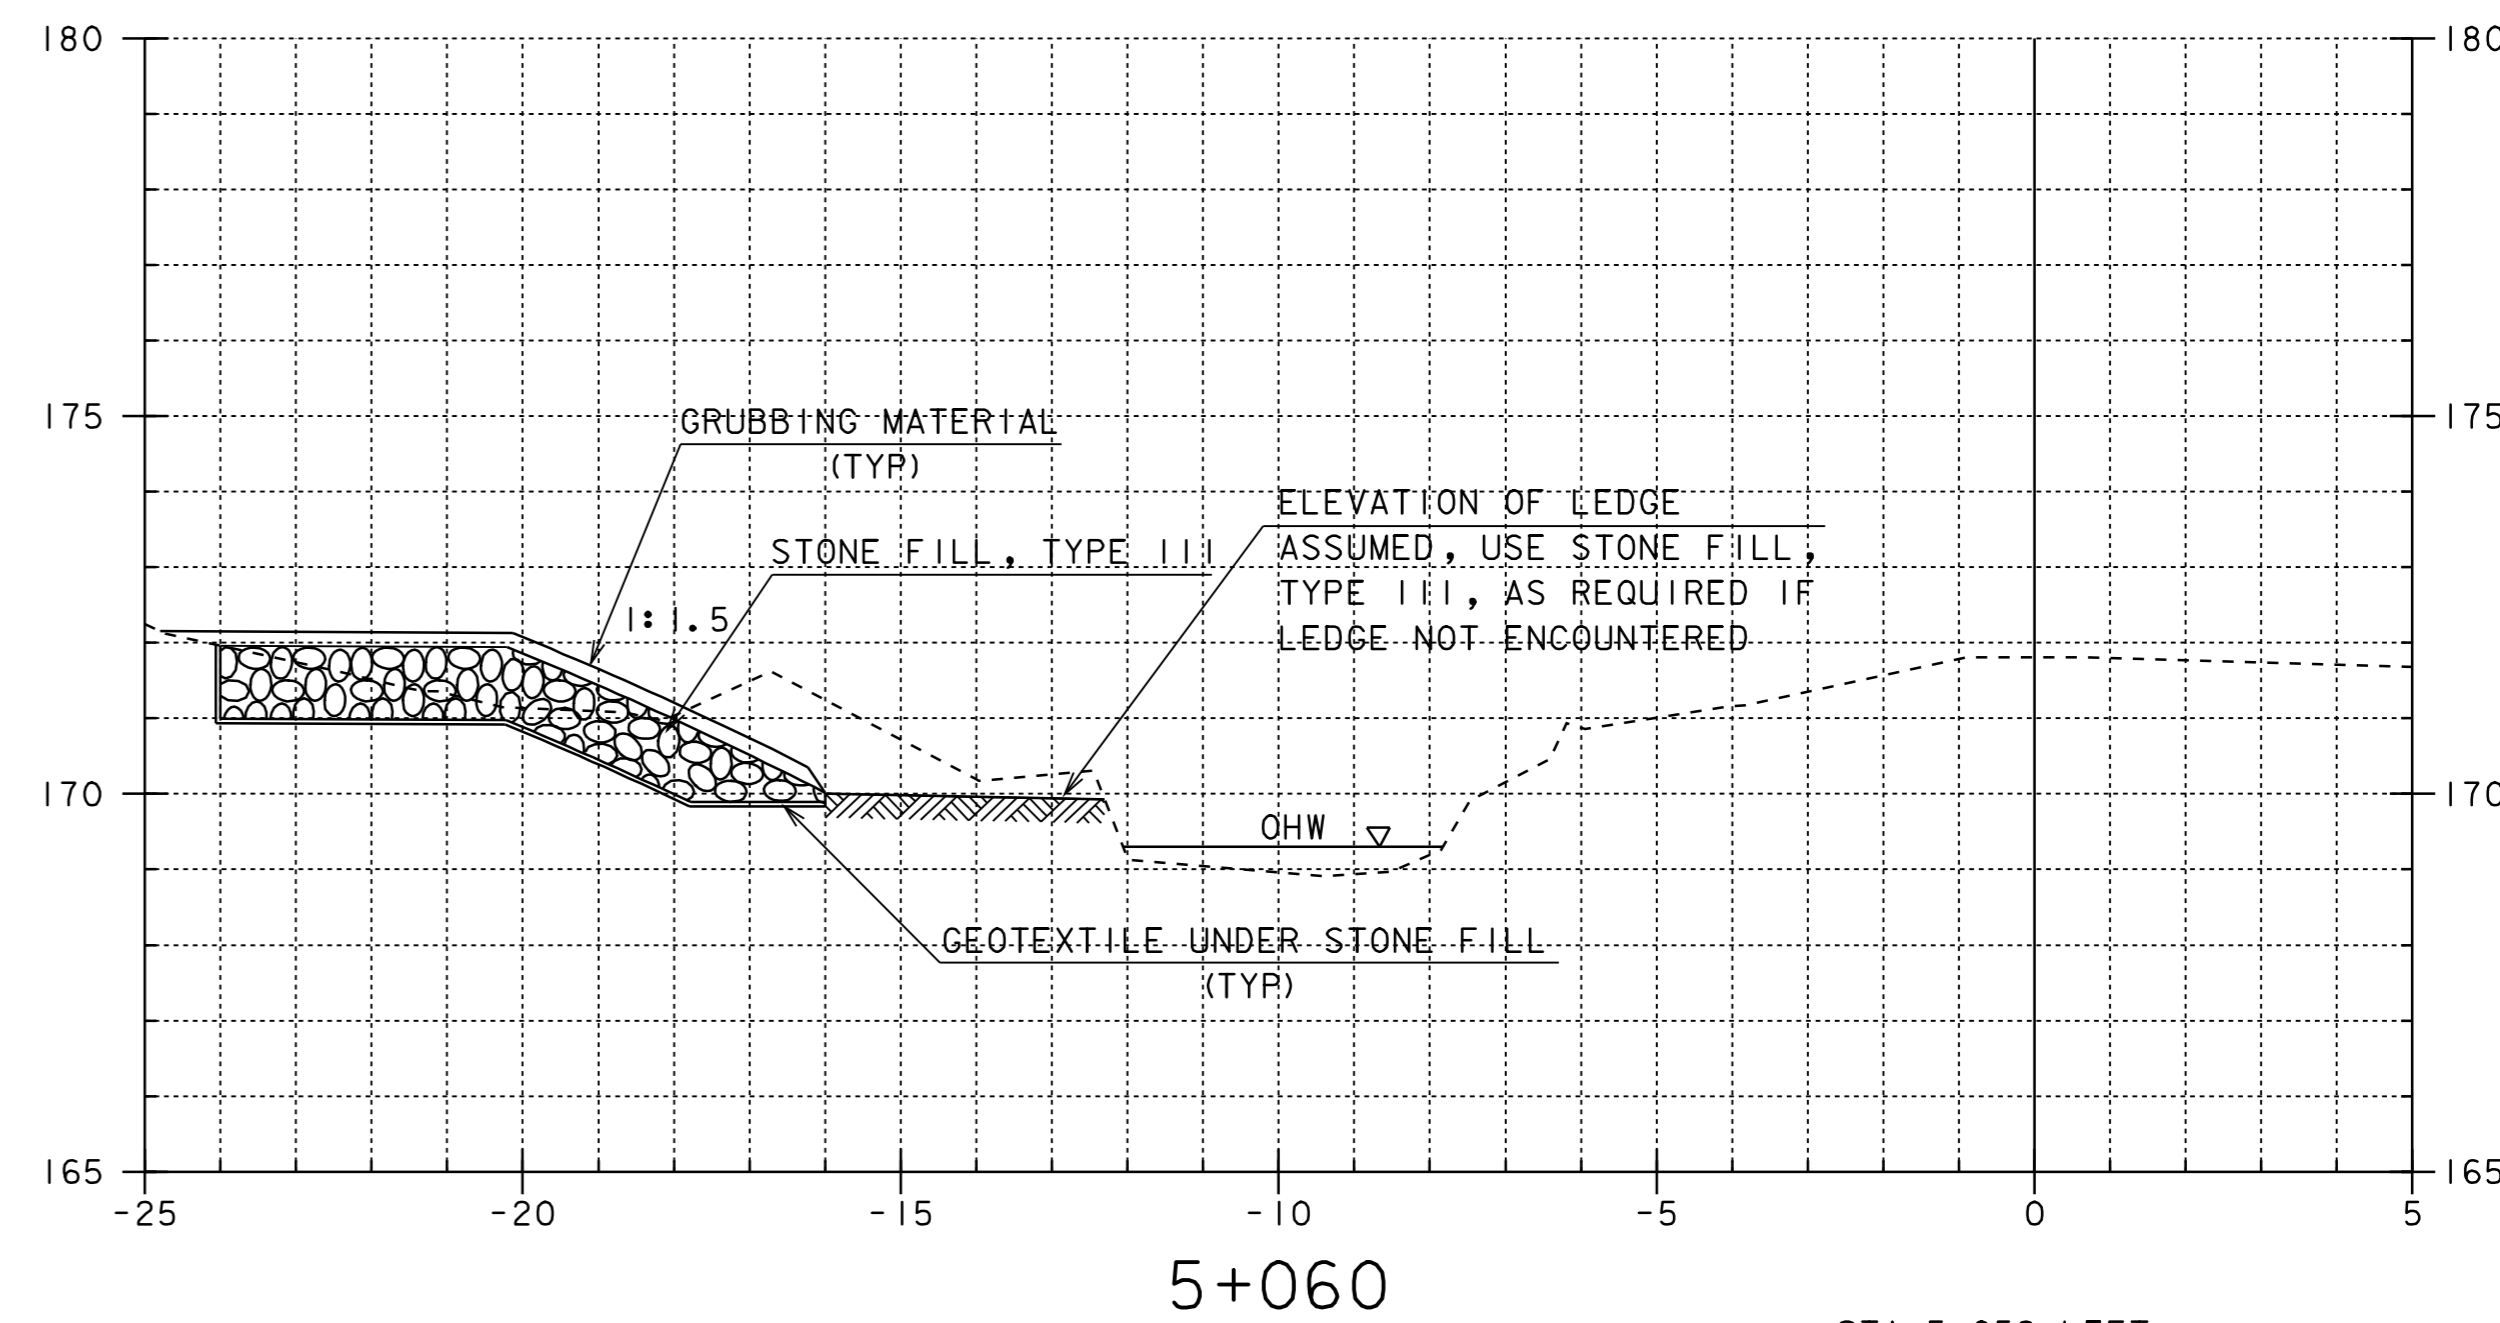


STA 5+062 FAR LEFT  
 END STONE FILL, TYPE III  
 END GRUBBING MATERIAL  
 END GEOTEXTILE FOR STONE  
 END UNCLASSIFIED CHANNEL EXCAVATION

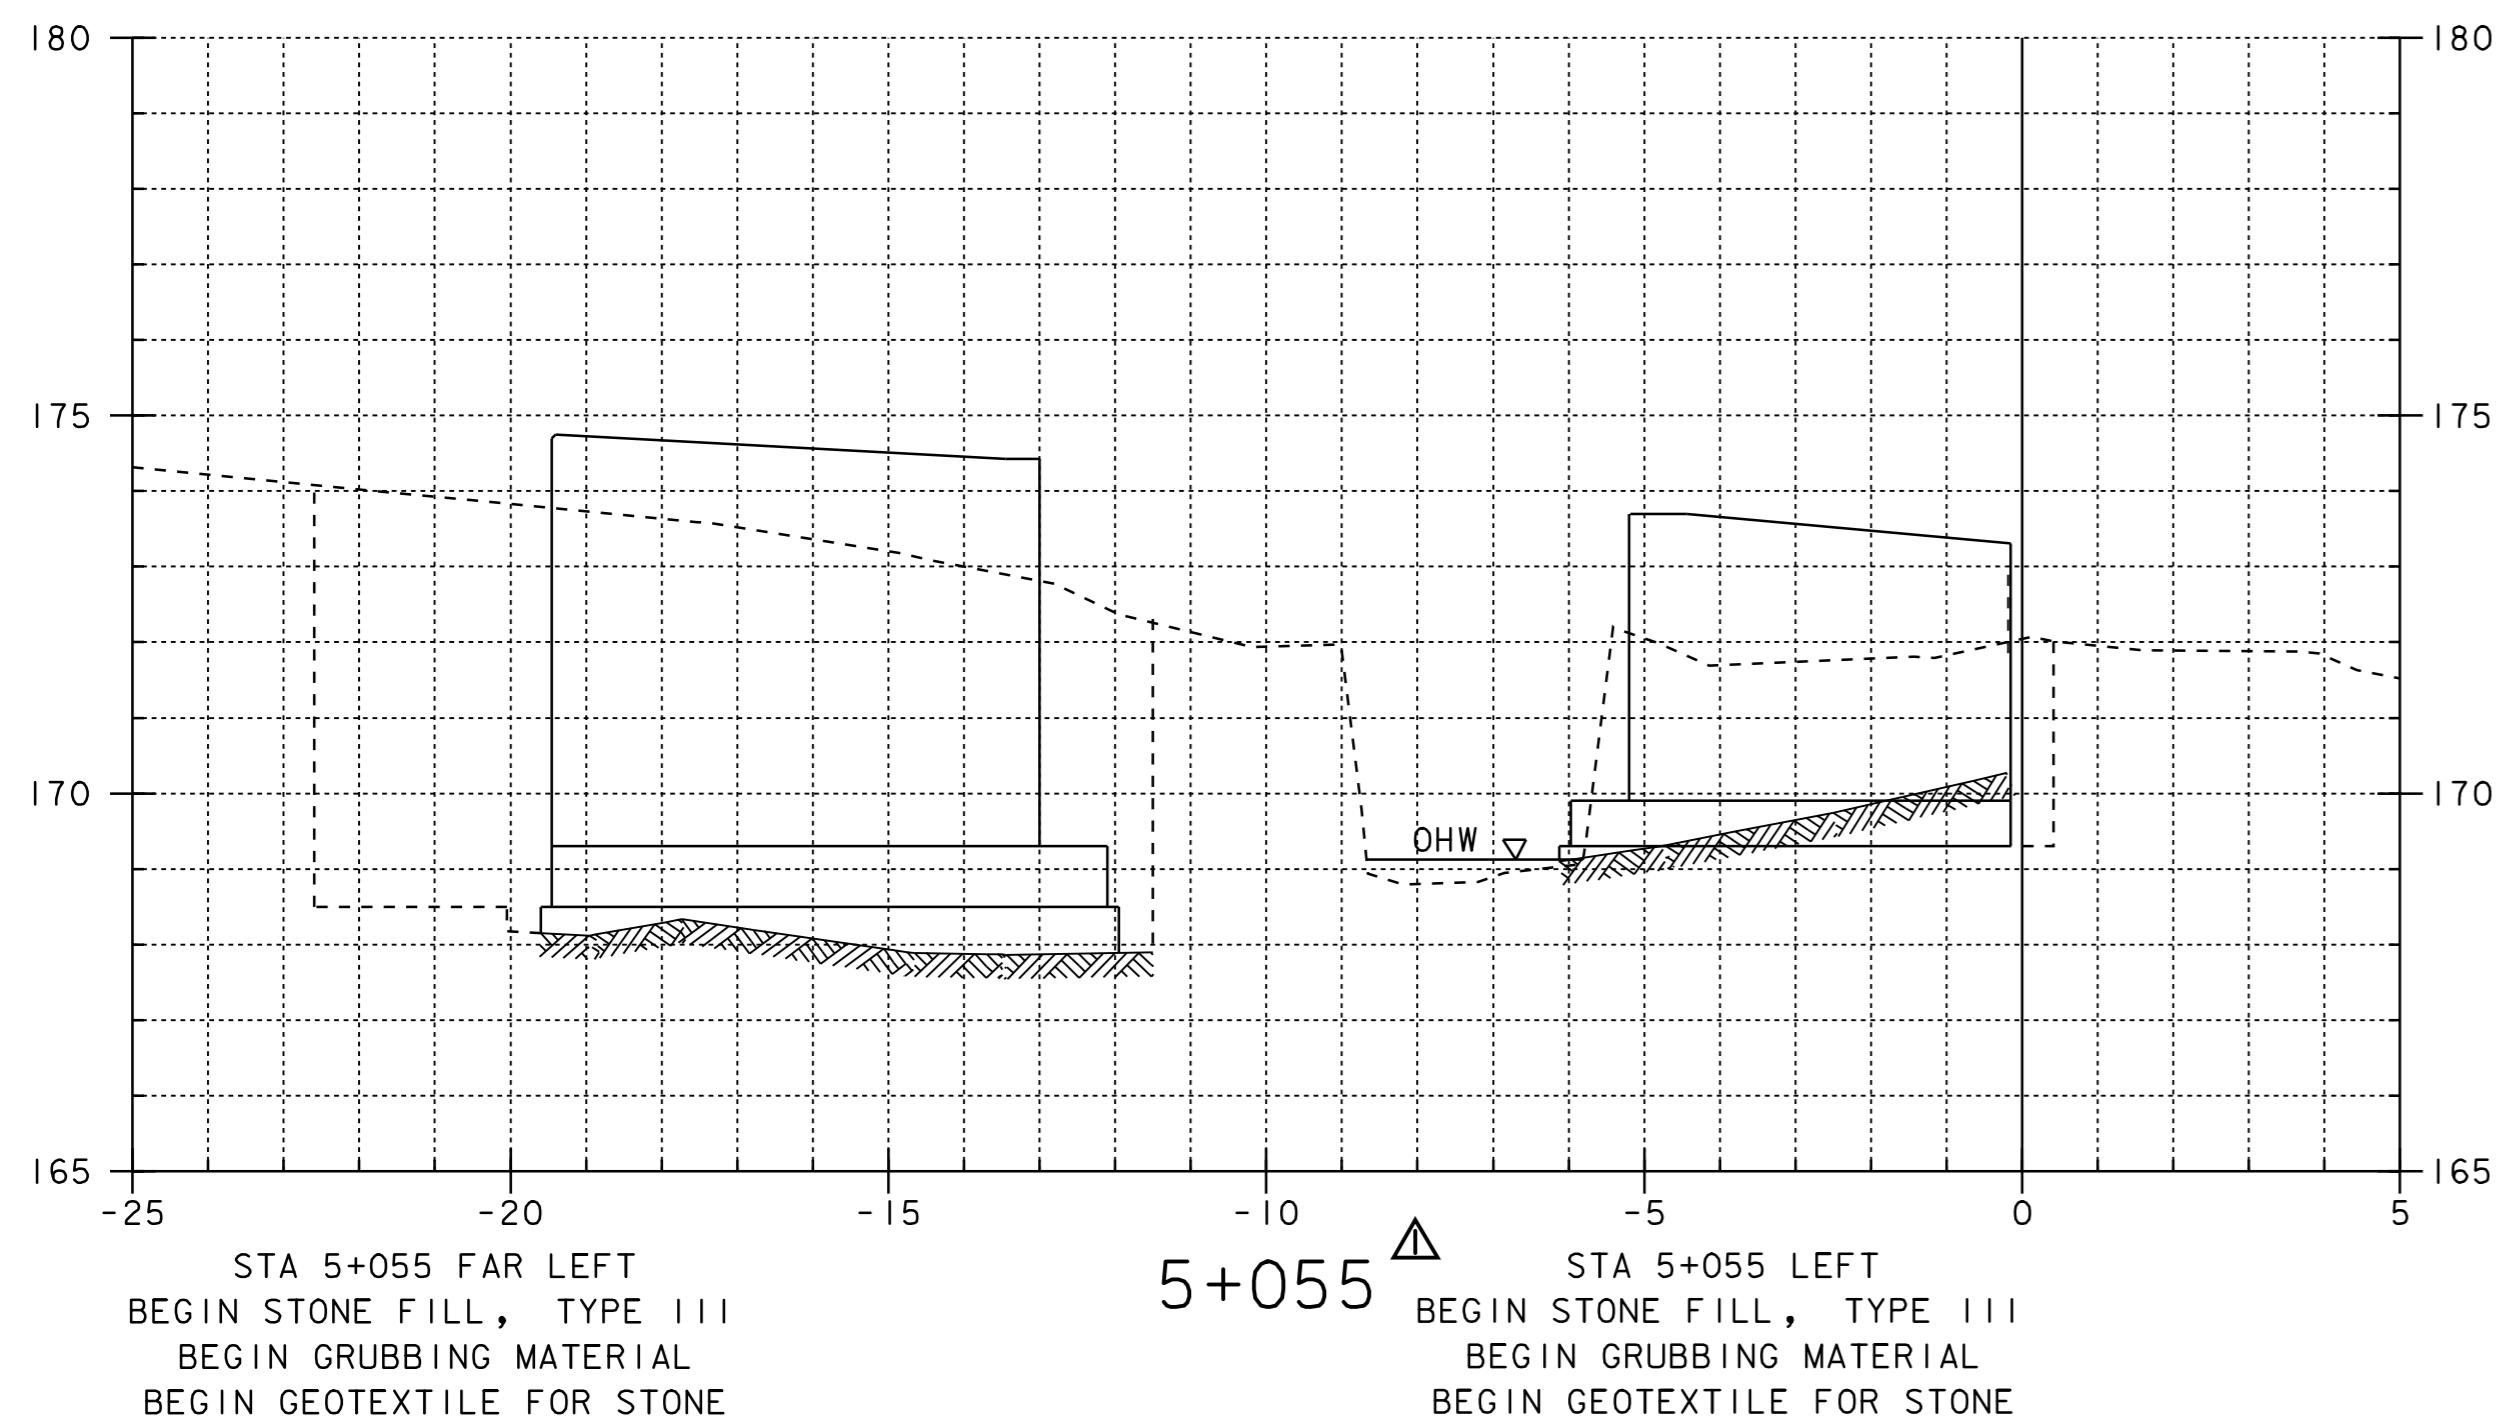

STA 5+058 LEFT  
 END UNCLASSIFIED CHANNEL EXCAVATION  
 END STONE FILL, TYPE III  
 END GRUBBING MATERIAL  
 END GEOTEXTILE FOR STONE

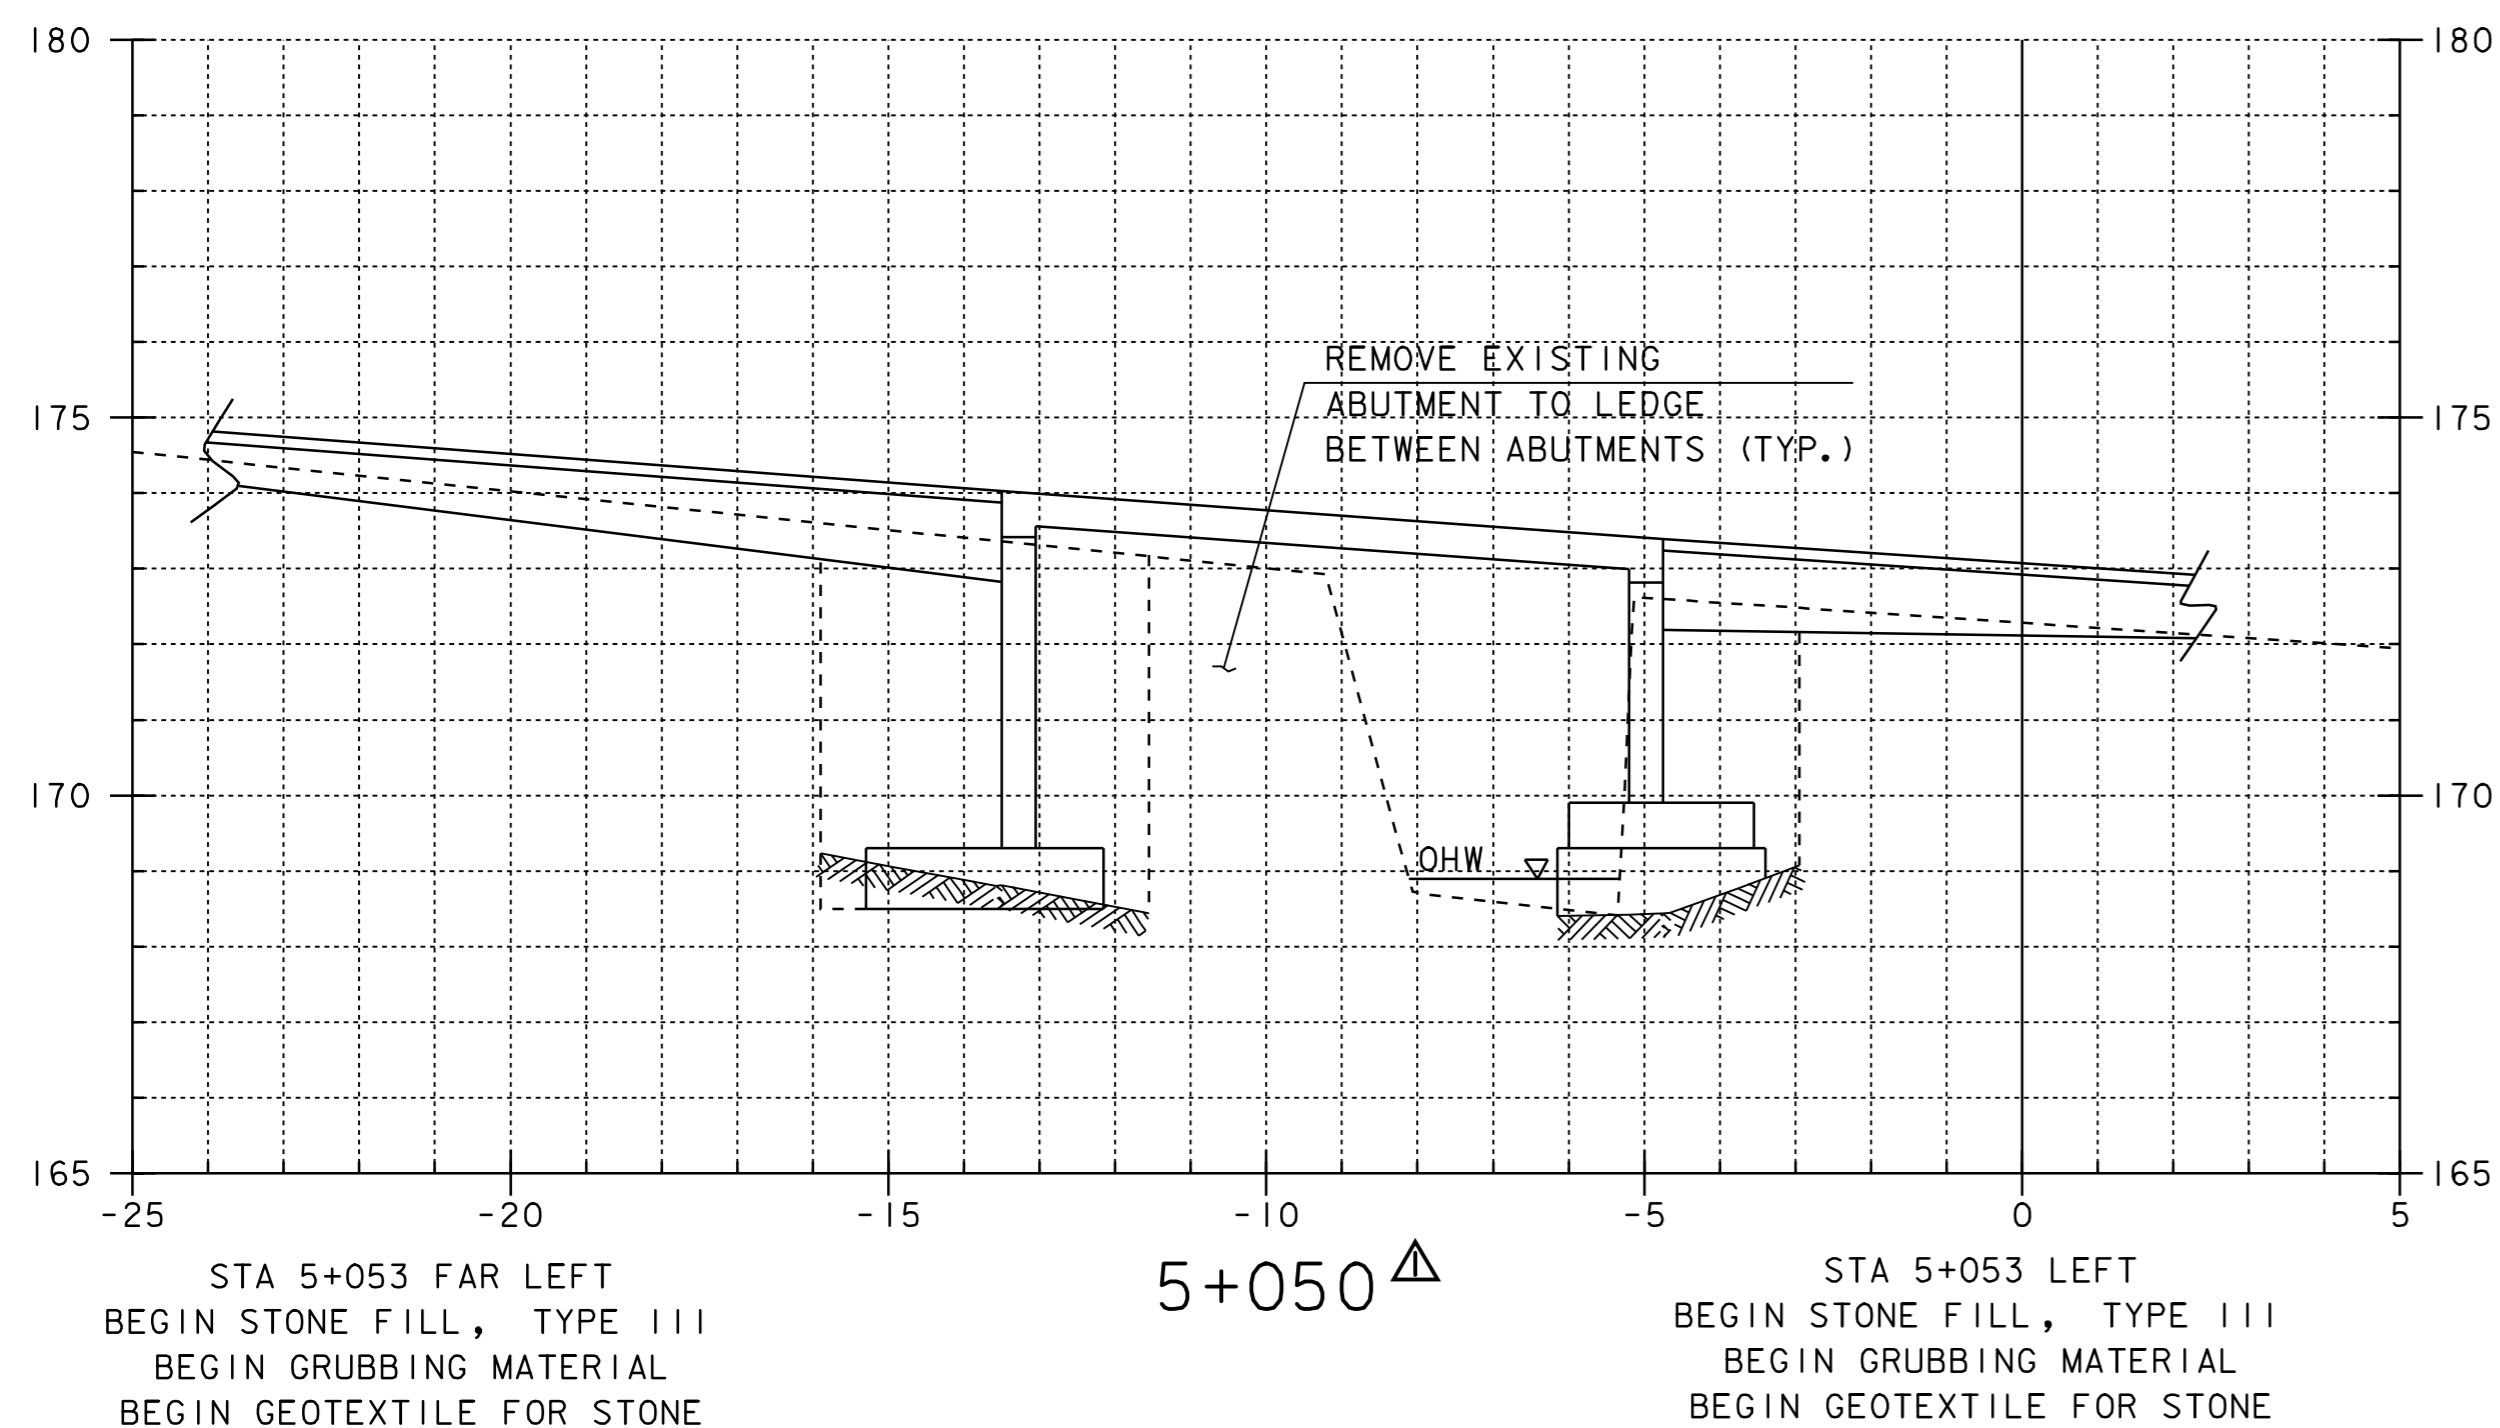

SHEET NAME: <u>CHANNEL CROSS SECTIONS</u>	
PROJECT NAME: <u>WESTFORD</u>	HIGHWAY NO.: <u>IH 4</u>
PROJECT NUMBER: <u>IH2_9436</u>	BRIDGE NO.: <u>2</u>
FILE NAME: <u>ZPW\941122\sj122xs2.dgn</u>	OVER: <u>ROGERS BROOK</u>
PROJECT MANAGER: <u>B.B. WHICOMB</u>	PLOT DATE: <u>22-DEC-2006</u>
DESIGNED BY: <u>C. CARLSON</u>	DRAWN BY: <u>SIRI</u>
BRIDGE SHEET NUMBER: <u>---</u>	IPARM NAME: <u>sj122cx2.1</u>
	SHEET <u>56</u> OF <u>56</u>

REVISION	DATE	BY	CHK'D	DESCRIPTION
△	06/27/2005	GFR	CWC	ABUTMENTS MODIFIED DUE TO UPDATED LEDGE INFORMATION.