


SEE SHEET 2 FOR LIST OF SHEETS
AND LIST OF STANDARDS

STATE OF VERMONT AGENCY OF TRANSPORTATION

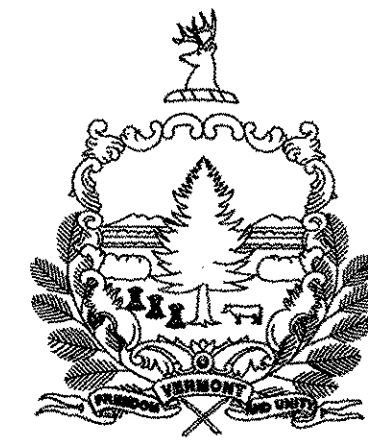


PROPOSED IMPROVEMENT BRIDGE PROJECT TOWN OF WESTFORD COUNTY OF CHITTENDEN


ROUTE NO : TH 4 (LOCAL ROAD, CLASS 2) BRIDGE NO : 2

PROJECT LOCATION : ON TH 4 APPROXIMATELY AT THE INTERSECTION OF TH 4 AND TH 1.
PROJECT DESCRIPTION : REPLACEMENT OF EXISTING BRIDGE WITH MINIMAL APPROACH ROADWAY AND CHANNEL WORK.

LENGTH OF STRUCTURE : 8.750 METERS.
LENGTH OF ROADWAY : 86.25 METERS.
LENGTH OF PROJECT : 95.00 METERS.

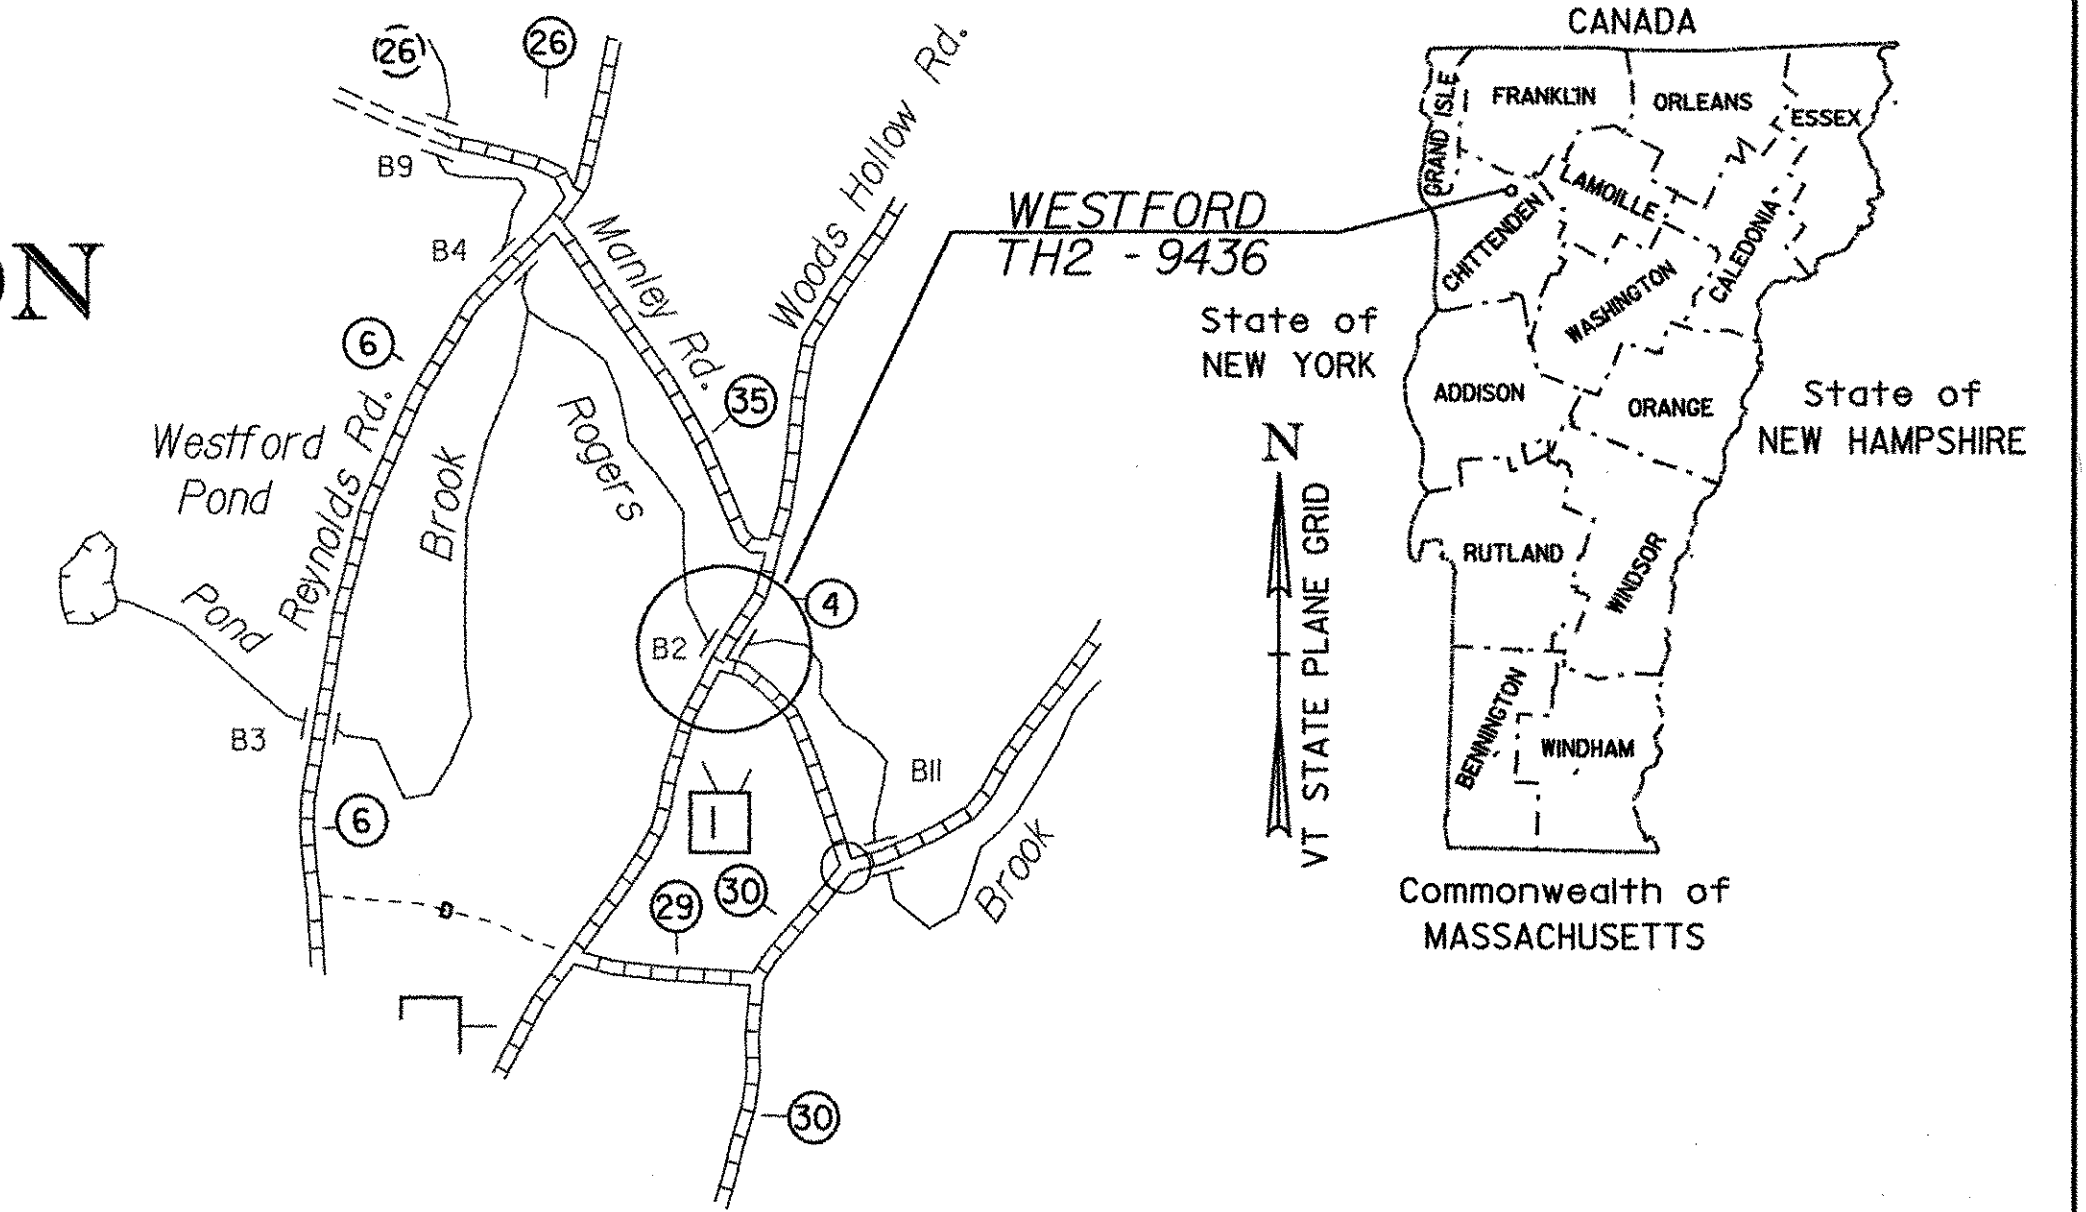

RECORD PLANS	
CONTRACTOR:	TREMBAY CONSTRUCTION, L.L.C. - WASHINGTON, VT
RESIDENT ENGINEER:	JEFF COTA
CONSTRUCTION BEGAN:	JUNE 17, 2005
CONSTRUCTION COMPLETE:	NOVEMBER 01, 2005
RECORD PLANS BY:	JEFF COTA & N. GARBACIK
I HEREBY CERTIFY THAT ALL THE CONSTRUCTION REQUIRED BY THIS SET OF DRAWINGS HAS BEEN ACCOMPLISHED AS INDICATED HEREIN.	
BY:	<i>[Signature]</i> RESIDENT ENGINEER
DATE:	10/15/06
NOTE: Any further information concerning final quantities, amounts or other details relative to this project may be found at Central Files in the electronic archives.	

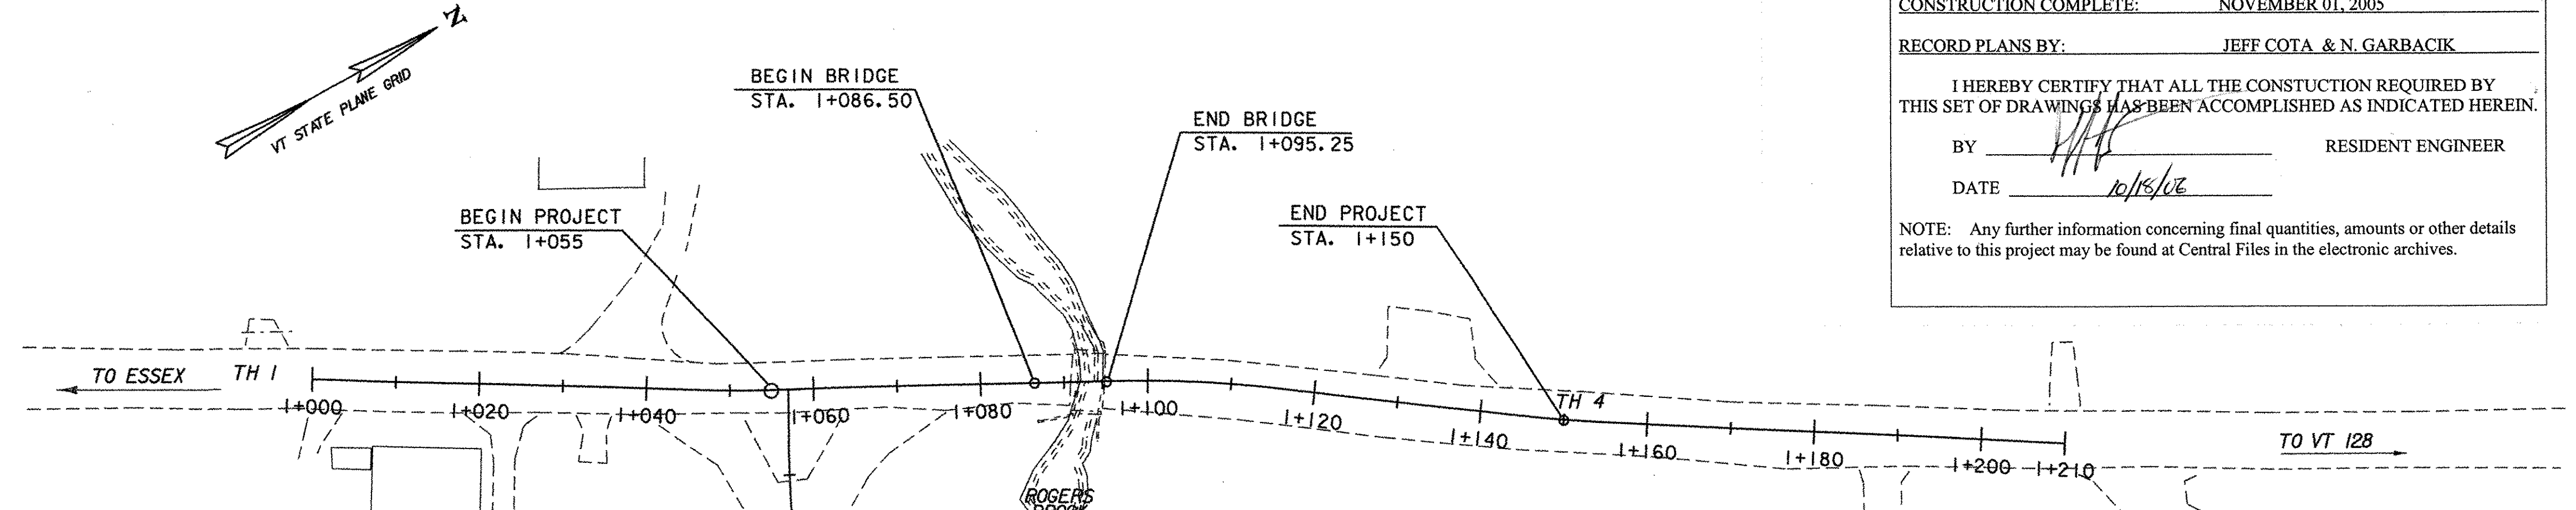

CONVENTIONAL SYMBOLS	
COUNTY LINE	
TOWN LINE	
LIMITS OF ACCESS	
POINT OF ACCESS	
FENCE LINE	
STONE WALL	
TRAVELED WAY	
GUARD RAIL	
RAILROAD	
SURVEY LINE	
CULVERT	
POWER POLE	
TELEPHONE POLE	
TREES	
CONTROL OF ACCESS	
PROPERTY LINE	
R.O.W. TAKING LINE	
SLOPE RIGHTS	
TOP OF CUT	
TOE OF SLOPE	

SURVEYED BY : R. MOREAU
SURVEYED DATE : SEPT 1995

DATUM
VERTICAL NAVD88
HORIZONTAL NAD83 (92)



THESE PLANS ARE SUBJECT TO SUCH ENGINEERING CHANGES AS MAY BE REQUIRED BY THE FEDERAL HIGHWAY ADMINISTRATION OR THE DIRECTOR OF PROGRAM DEVELOPMENT.

CONSTRUCTION IS TO BE CARRIED ON IN ACCORDANCE WITH THESE PLANS AND THE STANDARD SPECIFICATIONS FOR CONSTRUCTION DATED 2001, AS APPROVED BY THE FEDERAL HIGHWAY ADMINISTRATION ON JANUARY 4, 2001 FOR USE ON THIS PROJECT, INCLUDING ALL SUBSEQUENT REVISIONS AND SUCH REVISED SPECIFICATIONS AND SPECIAL PROVISIONS AS ARE INCORPORATED IN THESE PLANS.

PLOTTED: 02-MAR-2005
/PW/94j22/sj22bdr.dgn sj22ti.1



UNLESS NOTED OTHERWISE
STATIONS ARE IN KILOMETERS
ELEVATIONS ARE IN METERS
DIMENSIONS ARE IN MILLIMETERS

DIRECTOR OF PROGRAM DEVELOPMENT	
APPROVED <i>[Signature]</i>	DATE 3-2-05
PROJECT MANAGER : ROGER WHITCOMB	
PROJECT NAME : WESTFORD	
PROJECT NUMBER : TH2 - 9436	
SHEET 1 OF 56 SHEETS	

INDEX OF SHEETS

1. TITLE SHEET
2. PRELIMINARY INFORMATION SHEET
3. TYPICAL DETAIL SHEET
4. QUANTITY SHEET #1
5. QUANTITY SHEET #2
6. RIGHT OF WAY
7. TIE SHEET
8. LAYOUT SHEET #1
9. LAYOUT SHEET #2
10. MAINLINE PROFILE
11. SIDELINE PROFILE
12. BANKING DIAGRAM
13. TRAFFIC CONTROL SHEET #1
14. TRAFFIC CONTROL SHEET #2
15. TRAFFIC CONTROL SIGN SUMMARY SHEET
16. BORING LAYOUT SHEET
17. BORING LOG SHEET #1
18. BORING LOG SHEET #2
19. PLAN AND ELEVATION
20. EROSION CONTROL NARRATIVE
21. EXISTING CONDITIONS SITE PLAN #1
22. EXISTING CONDITIONS SITE PLAN #2
23. EROSION PREVENTION & SEDIMENT CONTROL PLAN #1
24. EROSION PREVENTION & SEDIMENT CONTROL PLAN #2
25. FINAL CONDITIONS SITE PLAN #1
26. FINAL CONDITIONS SITE PLAN #2
27. EROSION CONTROL DETAILS
28. DRAINAGE DETAIL SHEET
29. GENERAL NOTES
30. SLAB DETAILS
31. CURB DETAILS
32. ABUTMENT #1 PLAN
33. ABUTMENT #1 ELEVATION
34. WW 1 & WW 2 ELEVATIONS
35. FOOTING REINFORCING
36. ABUTMENT #2 PLAN
37. ABUTMENT #2 ELEVATION
38. WW #3 & WW #4 ELEVATIONS
39. REINFORCING STEEL SCHEDULE SHEET
40. SIGN SHEET #1
41. SIGN SHEET #2
42. SIGN SUMMARY SHEET
43. MANUFACTURED END TERMINAL
- 44-49. MAINLINE CROSS SECTIONS
- 50-51. DRIVE CROSS SECTIONS
- 52-54. SIDELINE CROSS SECTIONS
- 55-56. CHANNEL CROSS SECTIONS

LIST OF STANDARDS

D-2M	06/13/97
E-100A	01/02/04
E-100	01/02/04
E-101	05/30/03
E-102A	05/01/04
E-102	06/30/03
E-106	03/01/04
E-107A	08/08/95
E-107	06/30/03
E-121	08/08/95
E-143	06/15/04
E-150	05/01/04
E-155	05/01/04
E-160	05/20/99
G-1dM	01/03/00
G-1M	01/03/00
J-3M	06/13/97
SB-R6-82M	07/10/97

FINAL HYDRAULIC REPORT

HYDROLOGIC DATA

Date: 7-26-02

DRAINAGE AREA : 9.8 sq. km
 CHARACTER OF TERRAIN : Hilly, a mixture of forested and agricultural cover.
 STREAM CHARACTERISTICS : Small, sinuous, semi-alluvial, not braided or anabranching.
 NATURE OF STREAMBED : Mostly ledge through the bridge, some cobbles & boulders.

PEAK FLOW DATA

Q 2.33 =	4.8 cms	Q 50 =	19.8 cms
Q 10 =	10.6 cms	Q 100 =	24.8 cms
Q 25 =	14.7 cms	Q 500 =	40.0 cms

DATE OF FLOOD OF RECORD : Unknown
 ESTIMATED DISCHARGE : Unknown
 WATER SURFACE ELEV. : Unknown
 NATURAL STREAM VELOCITY : @ Q25 = 4.4 mps
 ICE CONDITIONS : Moderate
 DEBRIS : Moderate
 DOES THE STREAM REACH MAXIMUM HIGHWATER ELEV. RAPIDLY? Yes
 IS ORDINARY RISE RAPID? Yes
 IS STAGE AFFECTED BY UPSTREAM OR DOWNSTREAM CONDITIONS? No
 IF YES, DESCRIBE :

WATERSHED STORAGE : 1% HEADWATERS :
 UNIFORM : X
 IMMEDIATELY ABOVE SITE :

EXISTING STRUCTURE INFORMATION

STRUCTURE TYPE : Concrete slab bridge
 YEAR BUILT : Unknown
 CLEAR SPAN(NORMAL TO STREAM): 3.6 m
 VERTICAL CLEARANCE ABOVE STREAMBED: 3.9 m (Bot. of slab elev. 172.6 m)
 WATERWAY OF FULL OPENING: 14.0 sq. m
 DISPOSITION OF STRUCTURE: Remove
 TYPE OF MATERIAL UNDER SUBSTRUCTURE: Probably ledge.

WATER SURFACE ELEVATIONS AT:

Q2.33 =	169.6 m	VELOCITY =	3.7 mps
Q10 =	170.2 m	"	4.5 mps
Q25 =	170.6 m	"	4.9 mps
Q50 =	171.0 m	"	5.2 mps
Q100 =	171.4 m	"	5.5 mps

LONG TERM STREAMBED CHANGES: None noted or anticipated.

IS THE ROADWAY OVERTOPPED BELOW Q100: No
 FREQUENCY: Above Q100
 RELIEF ELEVATION: 171.8 m (Controlled by upstream channel banks)
 DISCHARGE OVER ROAD @Q100: None

UPSTREAM STRUCTURE

TOWN: Westford DISTANCE: 1460 m
 HIGHWAY #: T.H. 6 STRUCTURE #: 4
 CLEAR SPAN: 1.8 m CLEAR HEIGHT: 1.8 m
 YEAR BUILT: Unknown FULL WATERWAY: 5.3 sq. m
 STRUCTURE TYPE: ACCGMP

DOWNSTREAM STRUCTURE

TOWN: Westford DISTANCE: 980 m
 HIGHWAY #: T.H. 1 STRUCTURE #: 11
 CLEAR SPAN: 3.6 m CLEAR HEIGHT: 3.6 m
 YEAR BUILT: Unknown FULL WATERWAY: 13.4 sq. m
 STRUCTURE TYPE: box

LOAD FACTOR - LOAD RATING (METRIC TONS)

LOADING LEVELS	TRUCK						
	M	MS	3S2	6 AXLE	3A. STR.	4A. STR.	SA SEMI
INVENTORY	31	52					
POSTED	44	73	89		52	54	89
OPERATING		87	107	97	62	64	

COMMENTS: STRENGTH RFS = 1.5 M_{DL} / A X M_{LL+1}

TRAFFIC DATA

YEAR	ADT	DHV	% D	% T	ADTT
1999	370	50	66	3	<1
2019	500	70	66	4	<1

20 year ESAL for flexible pavement from to :
 40 year ESAL for flexible pavement from to :
 Design Speed : 60 km/h

PROPOSED STRUCTURE

STRUCTURE TYPE: Concrete slab bridge
 CLEAR SPAN(NORMAL TO STREAM): 7.8 m
 VERTICAL CLEARANCE ABOVE STREAMBED: 4.1 m
 WATERWAY OF FULL OPENING: 32 sq. m

WATER SURFACE ELEVATIONS AT:

Q2.33 =	169.6 m	VELOCITY =	3.0 mps
Q10 =	169.9 m	"	3.9 mps
Q25 =	170.2 m	"	4.3 mps
Q50 =	170.4 m	"	4.7 mps
Q100 =	170.6 m	"	4.9 mps

IS THE ROADWAY OVERTOPPED BELOW Q100: No
 FREQUENCY: Above Q100
 RELIEF ELEVATION: 171.8 m (Controlled by upstream channel banks)
 DISCHARGE OVER ROAD @Q100: None

AVERAGE LOW ELEVATION OF SUPERSTRUCTURE: 173.1 m
 VERTICAL CLEARANCE: @ Q100 = 2.5 m

SCOUR: Minimal scour due to ledge in the channel. Abutments will be poured on ledge.

REQUIRED CHANNEL PROTECTION: Stone Fill, Type III

PERMIT INFORMATION

AVERAGE DAILY FLOW: 0.2 cms DEPTH OR ELEVATION:
 ORDINARY LOW WATER: 0.1 cms 0.1 m
 ORDINARY HIGH WATER: 2.1 cms 0.3 m

TEMPORARY BRIDGE REQUIREMENTS

STRUCTURE TYPE: No temporary bridge. The road will be closed and traffic detoured.
 CLEAR SPAN (NORMAL TO STREAM):
 VERTICAL CLEARANCE ABOVE STREAMBED:
 WATERWAY AREA OF FULL OPENING:

ADDITIONAL INFORMATION

DESIGN CRITERIA

1. DESIGN LIVE LOAD AASHTO MS 22.5
2. DESIGN SPAN 8.75m BACK TO BACK
3. ALLOWABLE LOAD FOR SPREAD FOOTINGS ON SOIL 190 kPa
ON LEDGE 480 kPa
4. ALLOWABLE LOAD FOR PILING N/A
TYPE
ESTIMATED LENGTH
5. STRUCTURAL STEEL AASHTO M270MM270 GRADE N/A
6. REINFORCING STEEL GRADE 420
7. CONCRETE, HIGH PERFORMANCE CLASS A fc: 30 Mpa
CONCRETE, HIGH PERFORMANCE CLASS B fc: 25 Mpa
8. DESIGN SOIL UNIT WEIGHT 22.00 kN/m³
9. DESIGN LOAD FOR SPREAD FOOTINGS ON LEDGE 276 kPa


TRAFFIC MAINTENANCE

1. IS TRAFFIC TO BE MAINTAINED? NO
 IF YES, ON EXISTING STRUCTURE?
 OR ON TEMPORARY BRIDGE?
 ONE OR TWO-WAY TRAVEL?
2. TRAFFIC CONTROL SIGNALS REQUIRED? NO
3. ARE SIDEWALKS REQUIRED? NO
 IF SO, ON WHAT SIDE?


PROJECT NAME: WESTFORD

PROJECT NUMBER: TH2 9436


FILE NAME: I94j122StructuresIsj122pi.xls PLOT DATE: 02/23/2005
 PROJECT MANAGER: R. R. WHITCOMB DRAWN BY: J. GILMORE
 DESIGNED BY: C. CARLSON CHECKED BY: C. CARLSON
 PRELIMINARY INFORMATION SHEET SHEET 2 OF 56

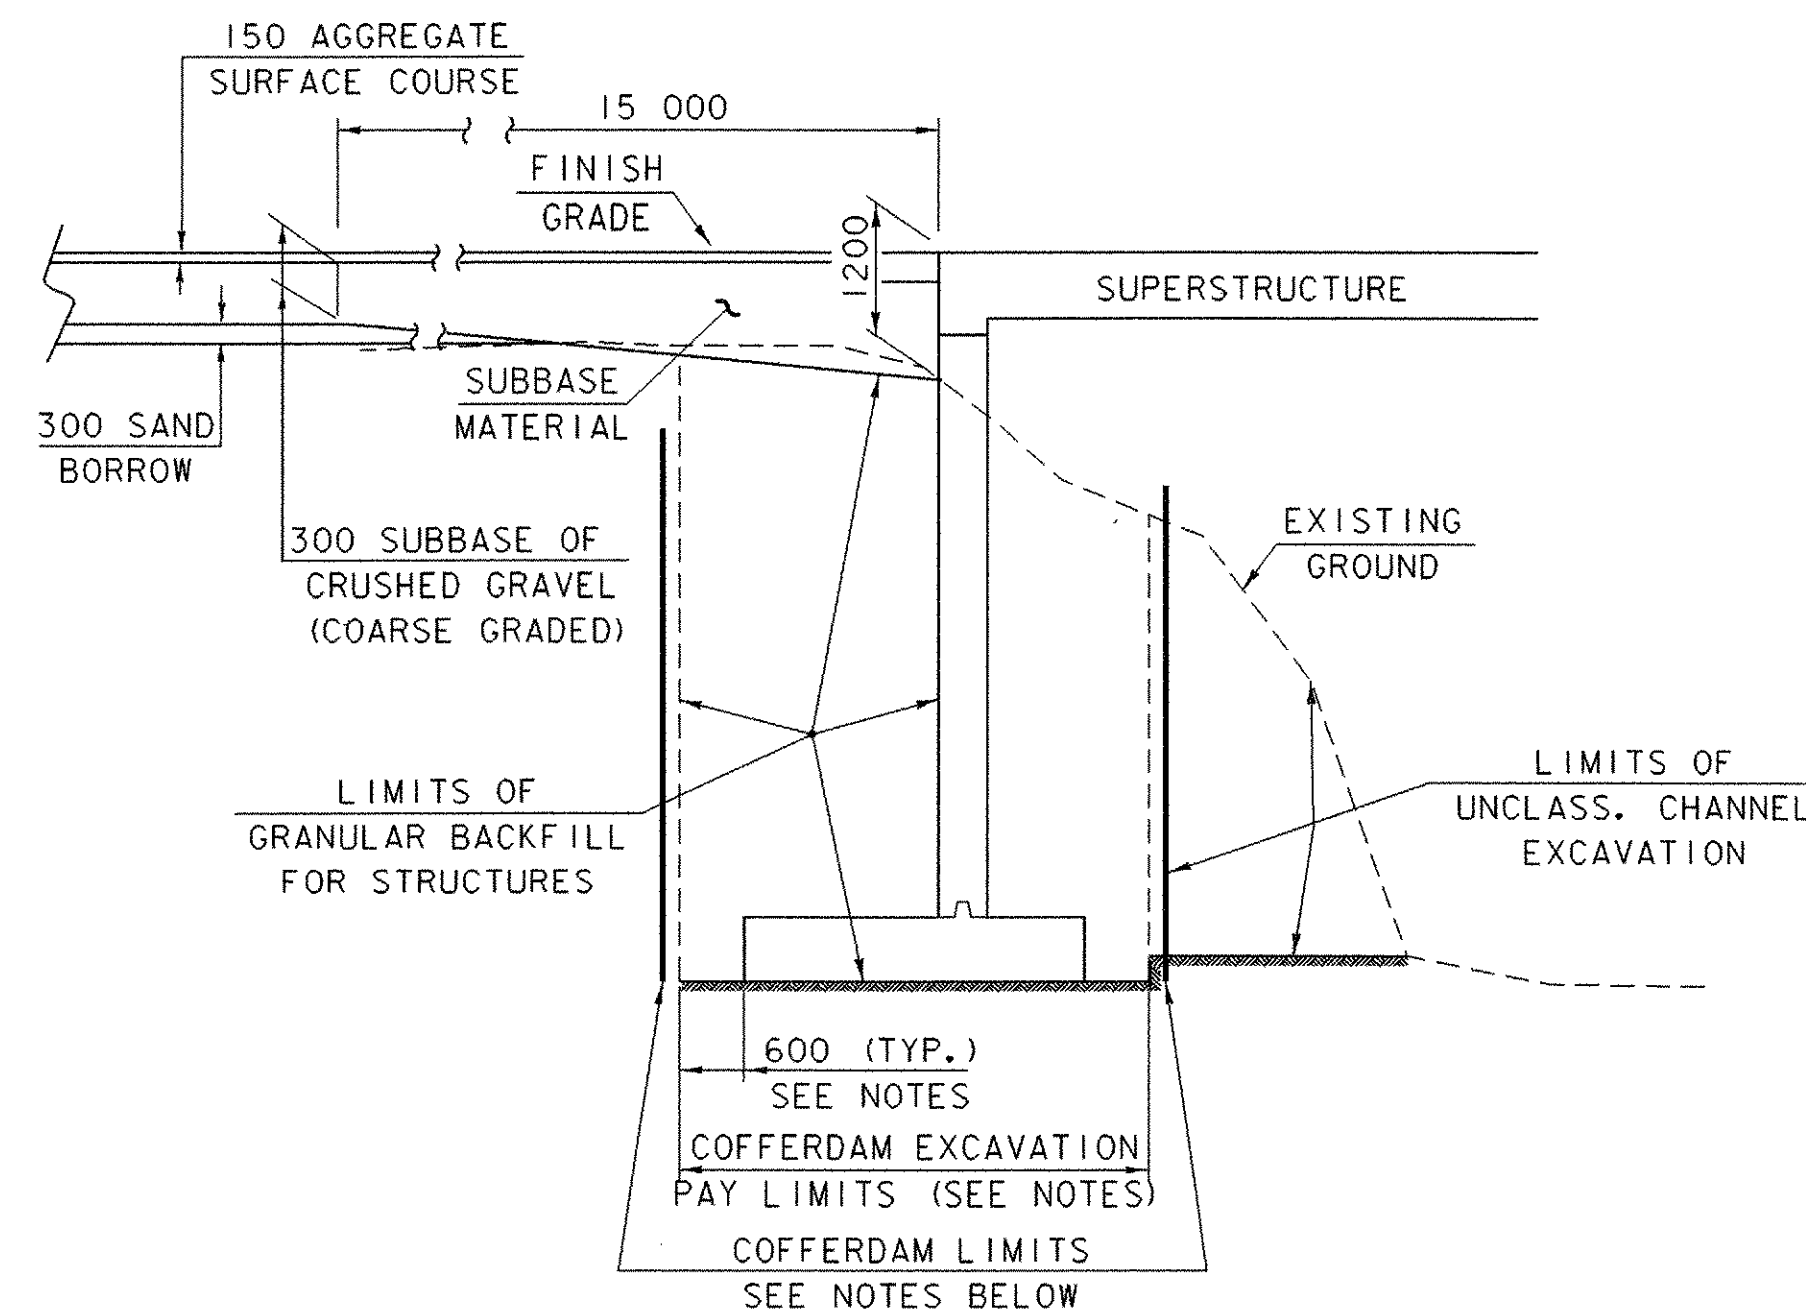

TYPICAL ABUTMENT SECTION
(NOT TO SCALE)

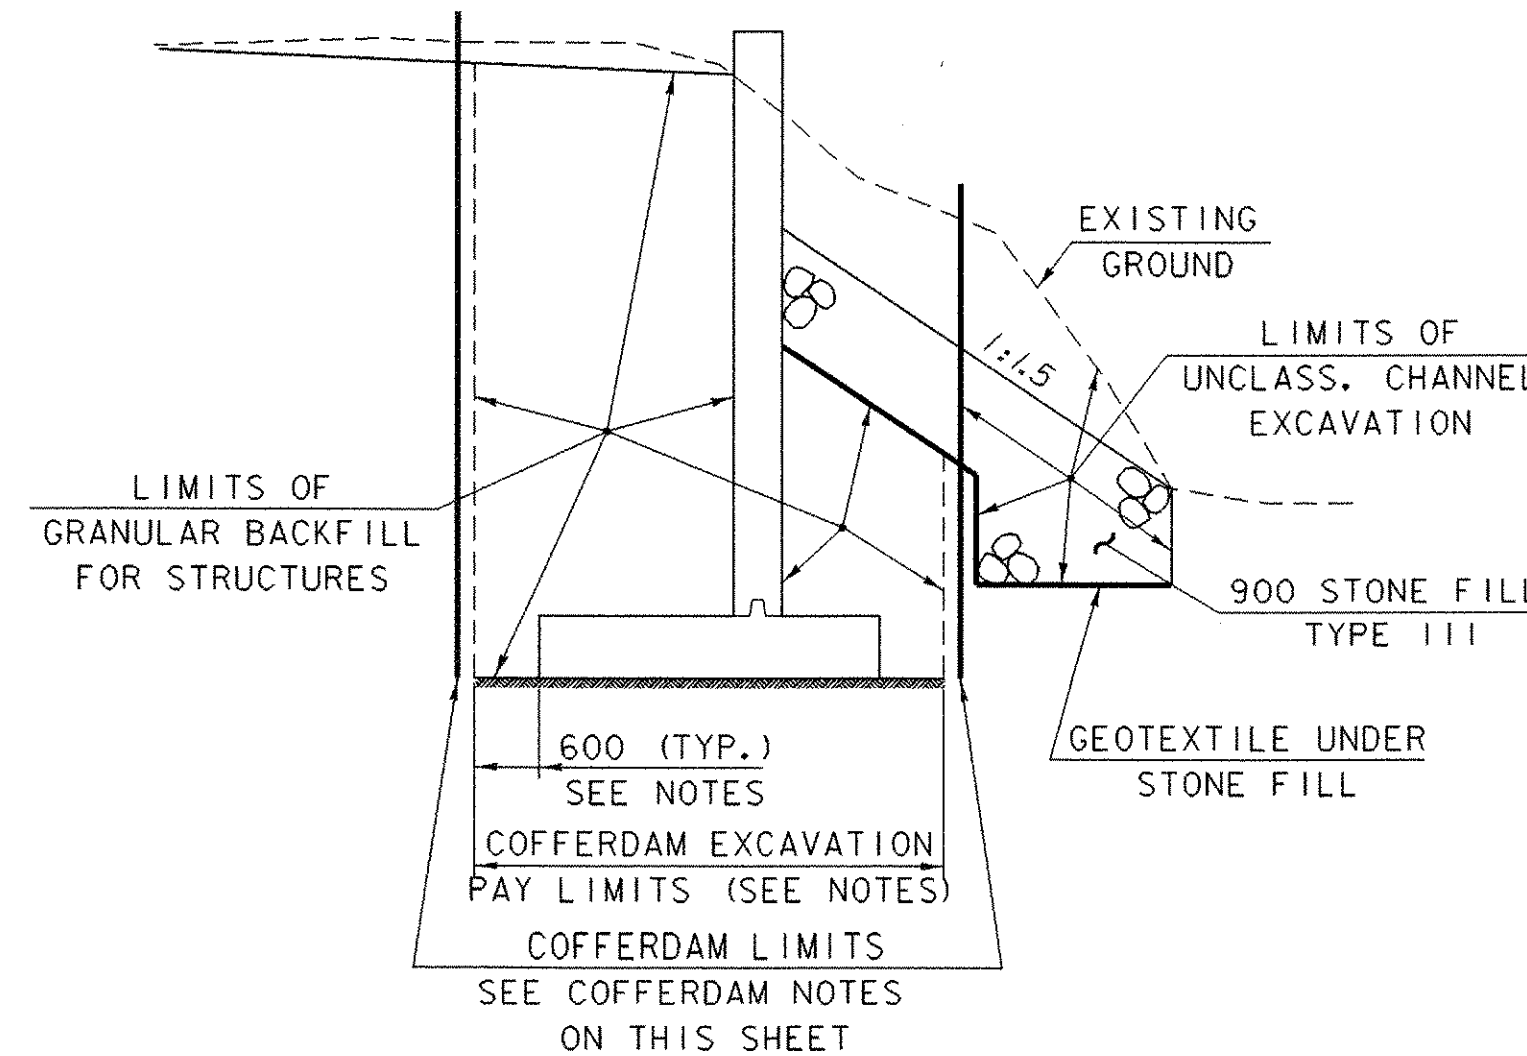

TYPICAL WINGWALL SECTION
(NOT TO SCALE)

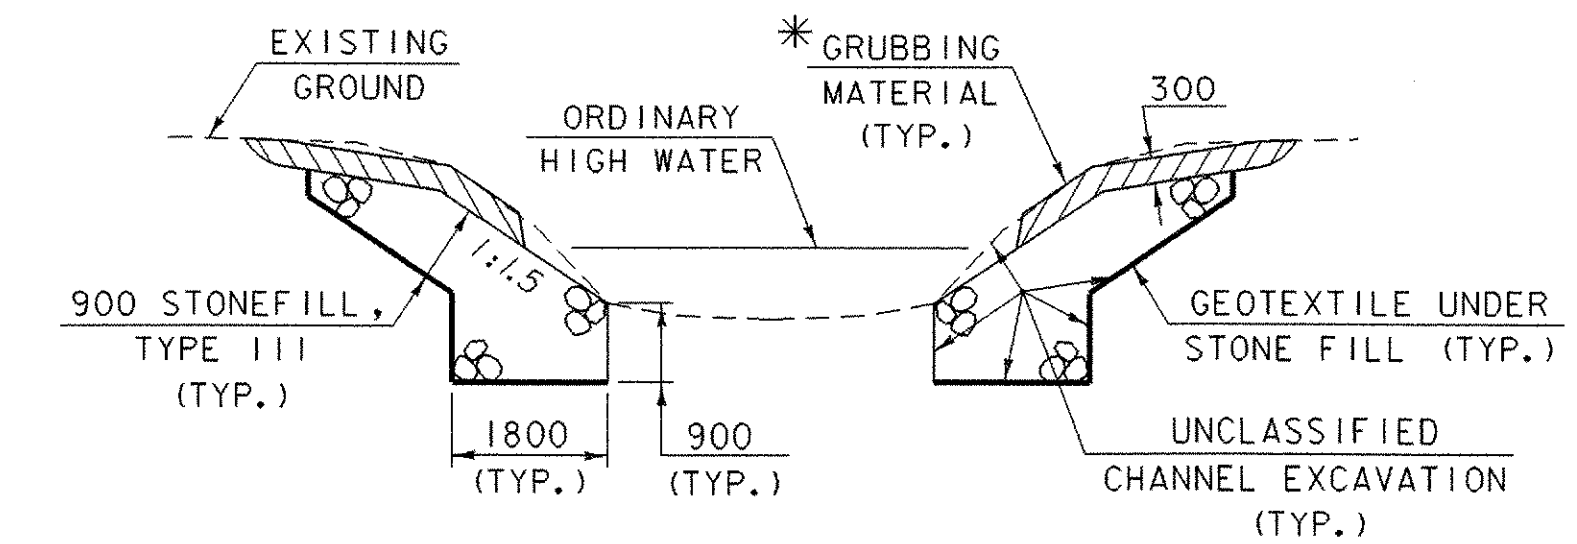

TYPICAL CHANNEL SECTION
(NOT TO SCALE)


* WHENEVER CHANNEL SLOPE INTERSECTS ROADWAY SUBBASE, GRUBBING MATERIAL SHALL BEGIN AT THE BOTTOM OF SUBBASE.

NOTE: LEDGE EXISTS THROUGHOUT MUCH OF THE PROJECT LIMITS. STONE FILL NEED NOT REPLACE LEDGE ALONG CHANNEL.

COFFERDAM NOTES:


1. COFFERDAM LIMITS TO BE DETERMINED BY THE CONTRACTOR.
2. THE PAY LIMITS OF "COFFERDAM EXCAVATION, EARTH" AND "COFFERDAM EXCAVATION, ROCK" SHALL BE 600 OUTSIDE THE PERIMETER OF THE FOOTING, UP TO EXISTING GROUND OR BOTTOM OF SUBBASE, WHICHEVER IS LOWER.
3. IF A COFFERDAM IS CONSTRUCTED WHICH IS LARGER THAN THE INDICATED COFFERDAM EXCAVATION PAY LIMITS, PAYMENT FOR ALL UNCLASSIFIED CHANNEL EXCAVATION, INCLUDING THAT PORTION WHICH IS INSIDE THE COFFERDAM BUT OUTSIDE THE COFFERDAM EXCAVATION PAY LIMITS, WILL BE MADE AT THE CONTRACT UNIT PRICE FOR UNCLASSIFIED CHANNEL EXCAVATION.
4. FOOTINGS SHALL BE PLACED ON SOUND, CLEAN LEDGE, ALL OVER BREAKAGE BELOW INDICATED BOTTOM OF FOOTING SHALL BE REPLACED WITH "HIGH PERFORMANCE CONCRETE, CLASS B". A MAXIMUM OF 150 mm AVERAGE DEPTH SHALL BE PAID FOR AS "HIGH PERFORMANCE CONCRETE, CLASS B". ANY ADDITIONAL CONCRETE REQUIRED SHALL BE PLACED AT THE CONTRACTOR'S EXPENSE. THE QUANTITIES SHOWN FOR "HIGH PERFORMANCE CONCRETE, CLASS B" AND "COFFERDAM EXCAVATION, ROCK" INCLUDE ADDITIONAL VOLUMES THAT MAY BE INCURRED DUE TO THE OVER BREAKAGE.
5. WHEN SOUND LEDGE IS ENCOUNTERED, PROFILES OF THE LEDGE SHALL BE SUBMITTED TO THE STRUCTURES SECTION TO DETERMINE WHETHER THE FOOTINGS FOR THE ABUTMENTS NEED TO BE ADJUSTED. NO FURTHER WORK SHALL BE DONE ON THE FOOTINGS UNTIL A REPLY IS RECEIVED FROM THE STRUCTURES SECTION.
6. IN LIEU OF THE USE OF COFFERDAMS, THE CONTRACTOR MAY ELECT TO USE A PIPE TO MAINTAIN THE FLOW OF WATER DURING CONSTRUCTION. THE RECOMMENDED HYDRAULIC OPENING MUST BE AT LEAST 2.5 SQ. METERS. THE LIMITS OF THE COFFERDAM REMAIN THE SAME AS SHOWN IN THE ABUTMENT/WINGWALL TYPICAL SECTIONS EVEN IF A PIPE IS UTILIZED. ALL THE WORK ASSOCIATED WITH THIS WORK WILL BE PAID FOR UNDER THE ITEMS, "COFFERDAM (STA. 1+086.50)", "COFFERDAM (STA. 1+095.25)", "COFFERDAM EXCAVATION, EARTH" AND "COFFERDAM EXCAVATION, ROCK."

BRIDGE RAILING - HEAVY DUTY
STEEL BEAM/ FASCIA MOUNTED WITH
HANDRAIL (SEE STD SB-R6-82M)
(TYP)

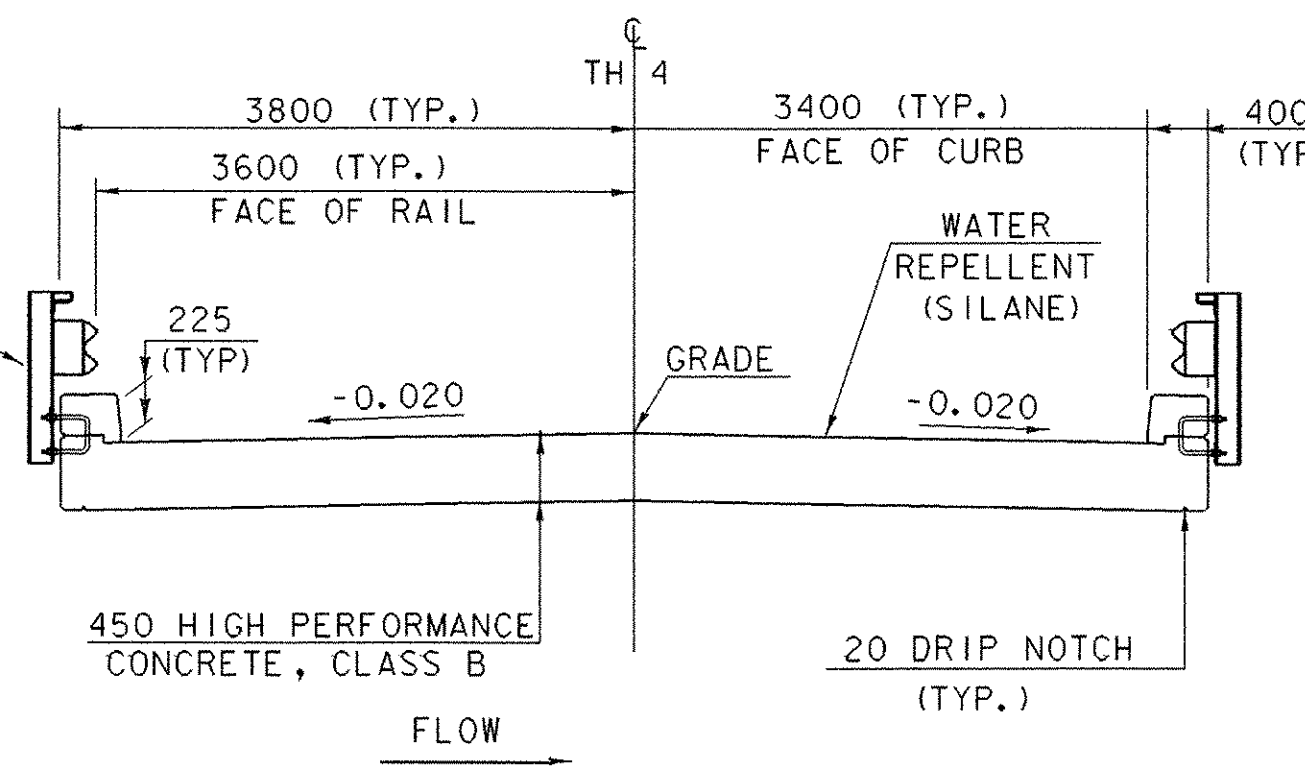

TYPICAL BRIDGE SECTION

SCALE 1:50

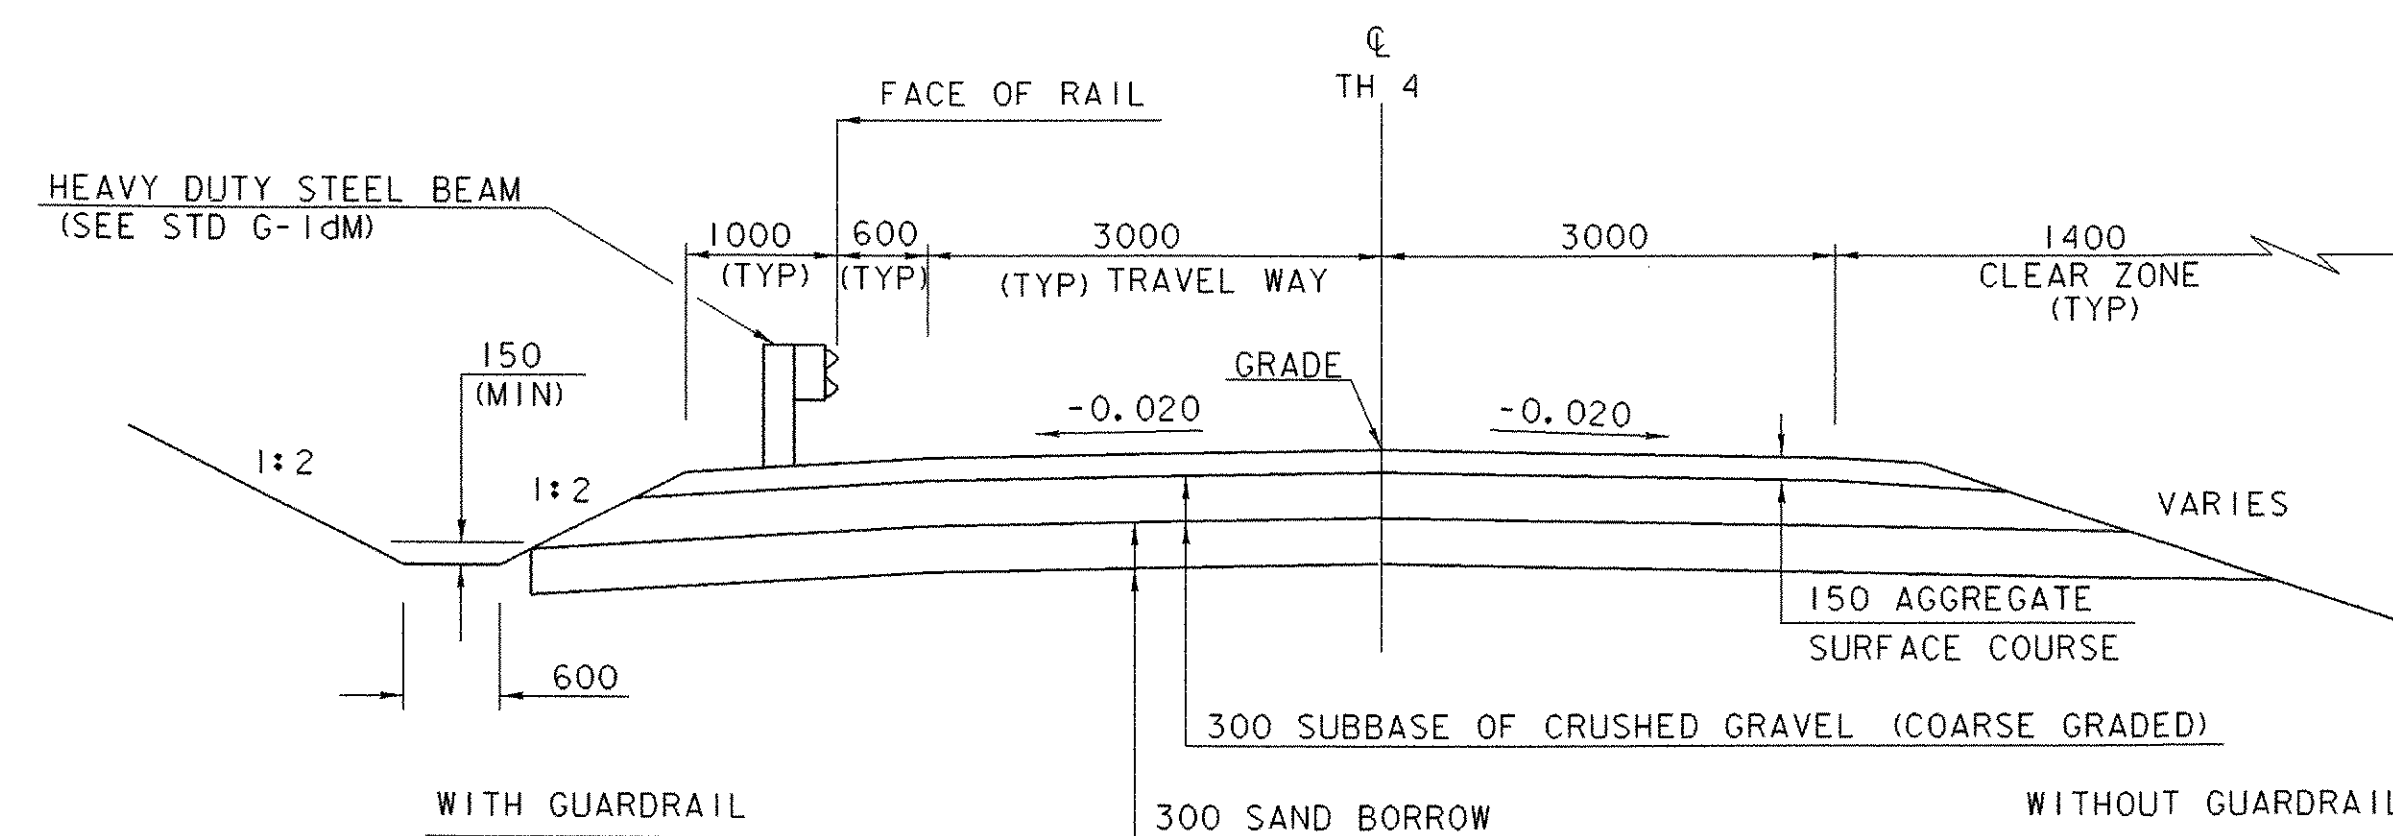

TYPICAL ROADWAY SECTION (TH 4)

SCALE 1:50

MATERIAL ITEM	TOLERANCE
SUBBASE	± 30 mm
SAND BORROW	± 30 mm
AGGREGATE SURFACE COURSE	± 15 mm

**** ROADWAY TYPICAL FOR TOWN HIGHWAY #1 IS IN TRANSITION FOR THE LENGTH OF SIDELINE APPROACH. FOR INFORMATION REGARDING THE TYPICAL REFER TO THE SIDELINE CROSS SECTIONS.

SHEET NAME: TYPICAL DETAIL SHEET	
PROJECT NAME: WESTFORD	HIGHWAY NO.: TH 4
PROJECT NUMBER: TH2 9436	BRIDGE NO.: 2
	OVER: ROGERS BROOK
FILE NAME: /PW/94j122/sj122pi.dgn	PLOT DATE: 25-MAR-2005
PROJECT MANAGER: R. R. WHITCOMB	DRAWN BY: C.C.RICE
DESIGNED BY: C. CARLSON	IPARM NAME: sj122+yp.1
BRIDGE SHEET NUMBER:	SHEET 3 OF 56

QUANTITY SHEET



SUMMARY OF ESTIMATED QUANTITIES										TOTALS			DESCRIPTIONS			DETAILED SUMMARY OF QUANTITIES		
ROADWAY	CHANNEL	SUPER STRUCTURE	ABUT. #1	ABUT. #2	EROSION CONTROL	FULL C&E	BRIDGE QUANTITY	ROUND	GRAND TOTAL	FINAL	UNIT	ITEMS	ITEM NUMBER	QUANTITIES	UNIT	ITEMS		
1									1		LS	CLEARING AND GRUBBING (INCL. INDV. TREES & SHRUBS)	201.10					
780									780		CM	COMMON EXCAVATION	203.15					
	250								250		CM	UNCLASSIFIED CHANNEL EXCAVATION	203.27					
340									340		CM	SAND BORROW	203.31					
30					10				40		CM	TRENCH EXCAVATION OF EARTH	204.20					
10									10		CM	STRUCTURE EXCAVATION	204.25					
30			300	180					480	510	CM	GRANULAR BACKFILL FOR STRUCTURES	204.30					
			130	60					190	190	CM	COFFERDAM EXCAVATION, EARTH	208.30					
			380	180					560	560	CM	COFFERDAM EXCAVATION, ROCK	208.35					
			1						1	1	LS	COFFERDAM (ABUT. #1 STA 1+086.500)	208.40					
				1					1	1	LS	COFFERDAM (ABUT. #2 STA 1+095.250)	208.40					
670					10				680	680	CM	SUBBASE OF CRUSHED GRAVEL (COARSE GRADED)	301.25					
310									310	310	CM	AGGREGATE SURFACE COURSE	401.10					
		30	136	87					253	253	CM	CONCRETE, HIGH PERFORMANCE CLASS B	501.34					
		2							2	2	CM	CONCRETE, HIGH PERFORMANCE CLASS B (MOD.)	501.34					
			8340	5350					13690	13690	KG	REINFORCING STEEL	507.15					
		3520	65	65					3650	3650	KG	EPOXY COATED REINFORCING STEEL	507.17					
		30	40	30					100	100	L	WATER REPELLENT (MOD. - SILANE)	514.10					
		20							20	20	M	BRIDGE RAILING - HDSB/FASCIA MOUNTED/HANDRAIL	525.43					
		1							1	1	EACH	PARTIAL REMOVAL OF STRUCTURE	529.20					
												BEGIN PIPE OPTIONS						
14									14	14	M	450 mm CAAP 1.52 mm (68 mm X 12 mm)	601.0215					
14									14	14	M	450 mm PCCSP 1.63 mm (68 mm X 12 mm)	601.0415					
14									14	14	M	450 mm CPEP	601.0915					
												END PIPE OPTIONS						
5									5	5	CM	DRY RUBBLE MASONRY	602.20					
					10				10	10	HR	ALL PURPOSE EXCAVATOR RENTAL, TYPE I	608.25					
420									420	420	CM	DUST CONTROL WITH WATER	609.10					
40	130				10				130	180	CM	STONE FILL, TYPE I	613.10					
	200								200	200	CM	STONE FILL, TYPE III	613.12					
1									1	1	EACH	RELOCATE MAIL BOX, SINGLE SUPPORT	617.10					
10									10	10	SM	PORTLAND CEMENT CONCRETE SIDEWALK, 125 MM (MOD.)	618.10					
160									160	160	M	SNOW FENCE (MOD. - ARCH.)	620.70					
					150				150	150	M	SNOW FENCE (MOD. - PDF)	620.70					
81									81	81	M	HEAVY DUTY STEEL BEAM GUARD RAIL (GALVANIZED)	621.21					
1									1	1	EACH	MANUFACTURED TERMINAL SECTION (TANGENT)	621.505					
3									3	3	EACH	ANCHOR FOR STEEL BEAM RAIL	621.60					
50									50	50	HR	FLAGGERS	630.15					
						1			1	1	LS	FIELD OFFICE-ENGINEERS	631.10					
						1			1	1	LS	TESTING EQUIPMENT - CONCRETE	631.16					
						1			1	1	LU	FIELD OFFICE - TELEPHONE (NABI)	631.25					
1									1	1	LS	MOBILIZATION/DEMOBILIZATION	635.11					
1									1	1	LS	TRAFFIC CONTROL	641.10					
	280								280	280	SM	GEOTEXTILE UNDER STONE FILL	649.31					
					200				200	200	SM	GEOTEXTILE FOR SILT FENCE	649.51					


PROJECT NAME:	WESTFORD
PROJECT NUMBER:	TH2 9436
FILE NAME:	\\94j122\Structures\sj122qnt.xls
PROJECT LEADER:	R. R. WHITCOMB
DESIGNED BY:	C. CARLSON
QUANTITY SHEET #1	
PLOT DATE:	3/22/2005
DRAWN BY:	J. GILMORE
CHECKED BY:	C. CARLSON
SHEET	4 OF 56

QUANTITY SHEET




SUMMARY OF ESTIMATED QUANTITIES									TOTALS			DESCRIPTIONS			DETAILED SUMMARY OF QUANTITIES			
ROADWAY	CHANNEL	SUPER STRUCTURE	ABUT. #1	ABUT. #2	EROSION CONTROL	FULL C&E			BRIDGE QUANTITY	ROUND	GRAND TOTAL	FINAL	UNIT	ITEMS	ITEM NUMBER	QUANTITIES	UNIT	ITEMS
					15						15		KG	SEED	651.15			
					5						5		KG	SEED-WINTER RYE	651.17			
					70						70		KG	FERTILIZER	651.18			
					0.5						0.5		T	AGRICULTURAL LIMESTONE	651.20			
					0.5						0.5		T	HAY MULCH	651.25			
20					60						80		CM	TOPSOIL	651.35			
	230								230		230		SM	GRUBBING MATERIAL	651.40			
					1						1		LS	EROSION PREVENTION AND SEDIMENT CONTROL PLAN	652.10			
					50						50		HR	MONITORING EROSION PREVENTION AND SEDIMENT CONTROL PLAN	652.20			
					1						1		LU	MAINTENANCE OF EROSION PREVENTION & SEDIMENT CONTROL PLAN (N.A.B.I.)	652.30			
110					30						140		SM	EROSION MATTING	654.10			
2											2		EACH	EVERGREEN TREES (WHITE SPRUCE, PICEA GLAUCA, B & B, 1.5-2.0 M)	656.20			
2											2		EACH	DECIDUOUS TREES (SUGAR MAPLE, ACER SACCHARUM, B & B, 50-75 mm CAL.)	656.30			
2.3											2.3		SM	TRAFFIC SIGNS, TYPE A	675.20			
25											25		SM	TRAFFIC SIGNS, TYPE A (MOD)	675.20			
19											19		M	FLANGED CHANNEL SIGN POSTS	675.301			
156											156		M	FLANGED CHANNEL SIGN POST (MOD)	675.301			
5											5		EACH	REMOVING SIGNS	675.50			
2											2		EACH	ERECTING SALVAGED SIGNS	675.60			

PROJECT NAME: WESTFORD
 PROJECT NUMBER: TH2 9436
 FILE NAME: \\94j122\Structures\sj122qnt.xls PLOT DATE: 3/22/2005
 PROJECT LEADER: R. R. WHITCOMB DRAWN BY: J. GILMORE
 DESIGNED BY: C. CARLSON CHECKED BY: C. CARLSON
 QUANTITY SHEET #2 SHEET 5 OF 56

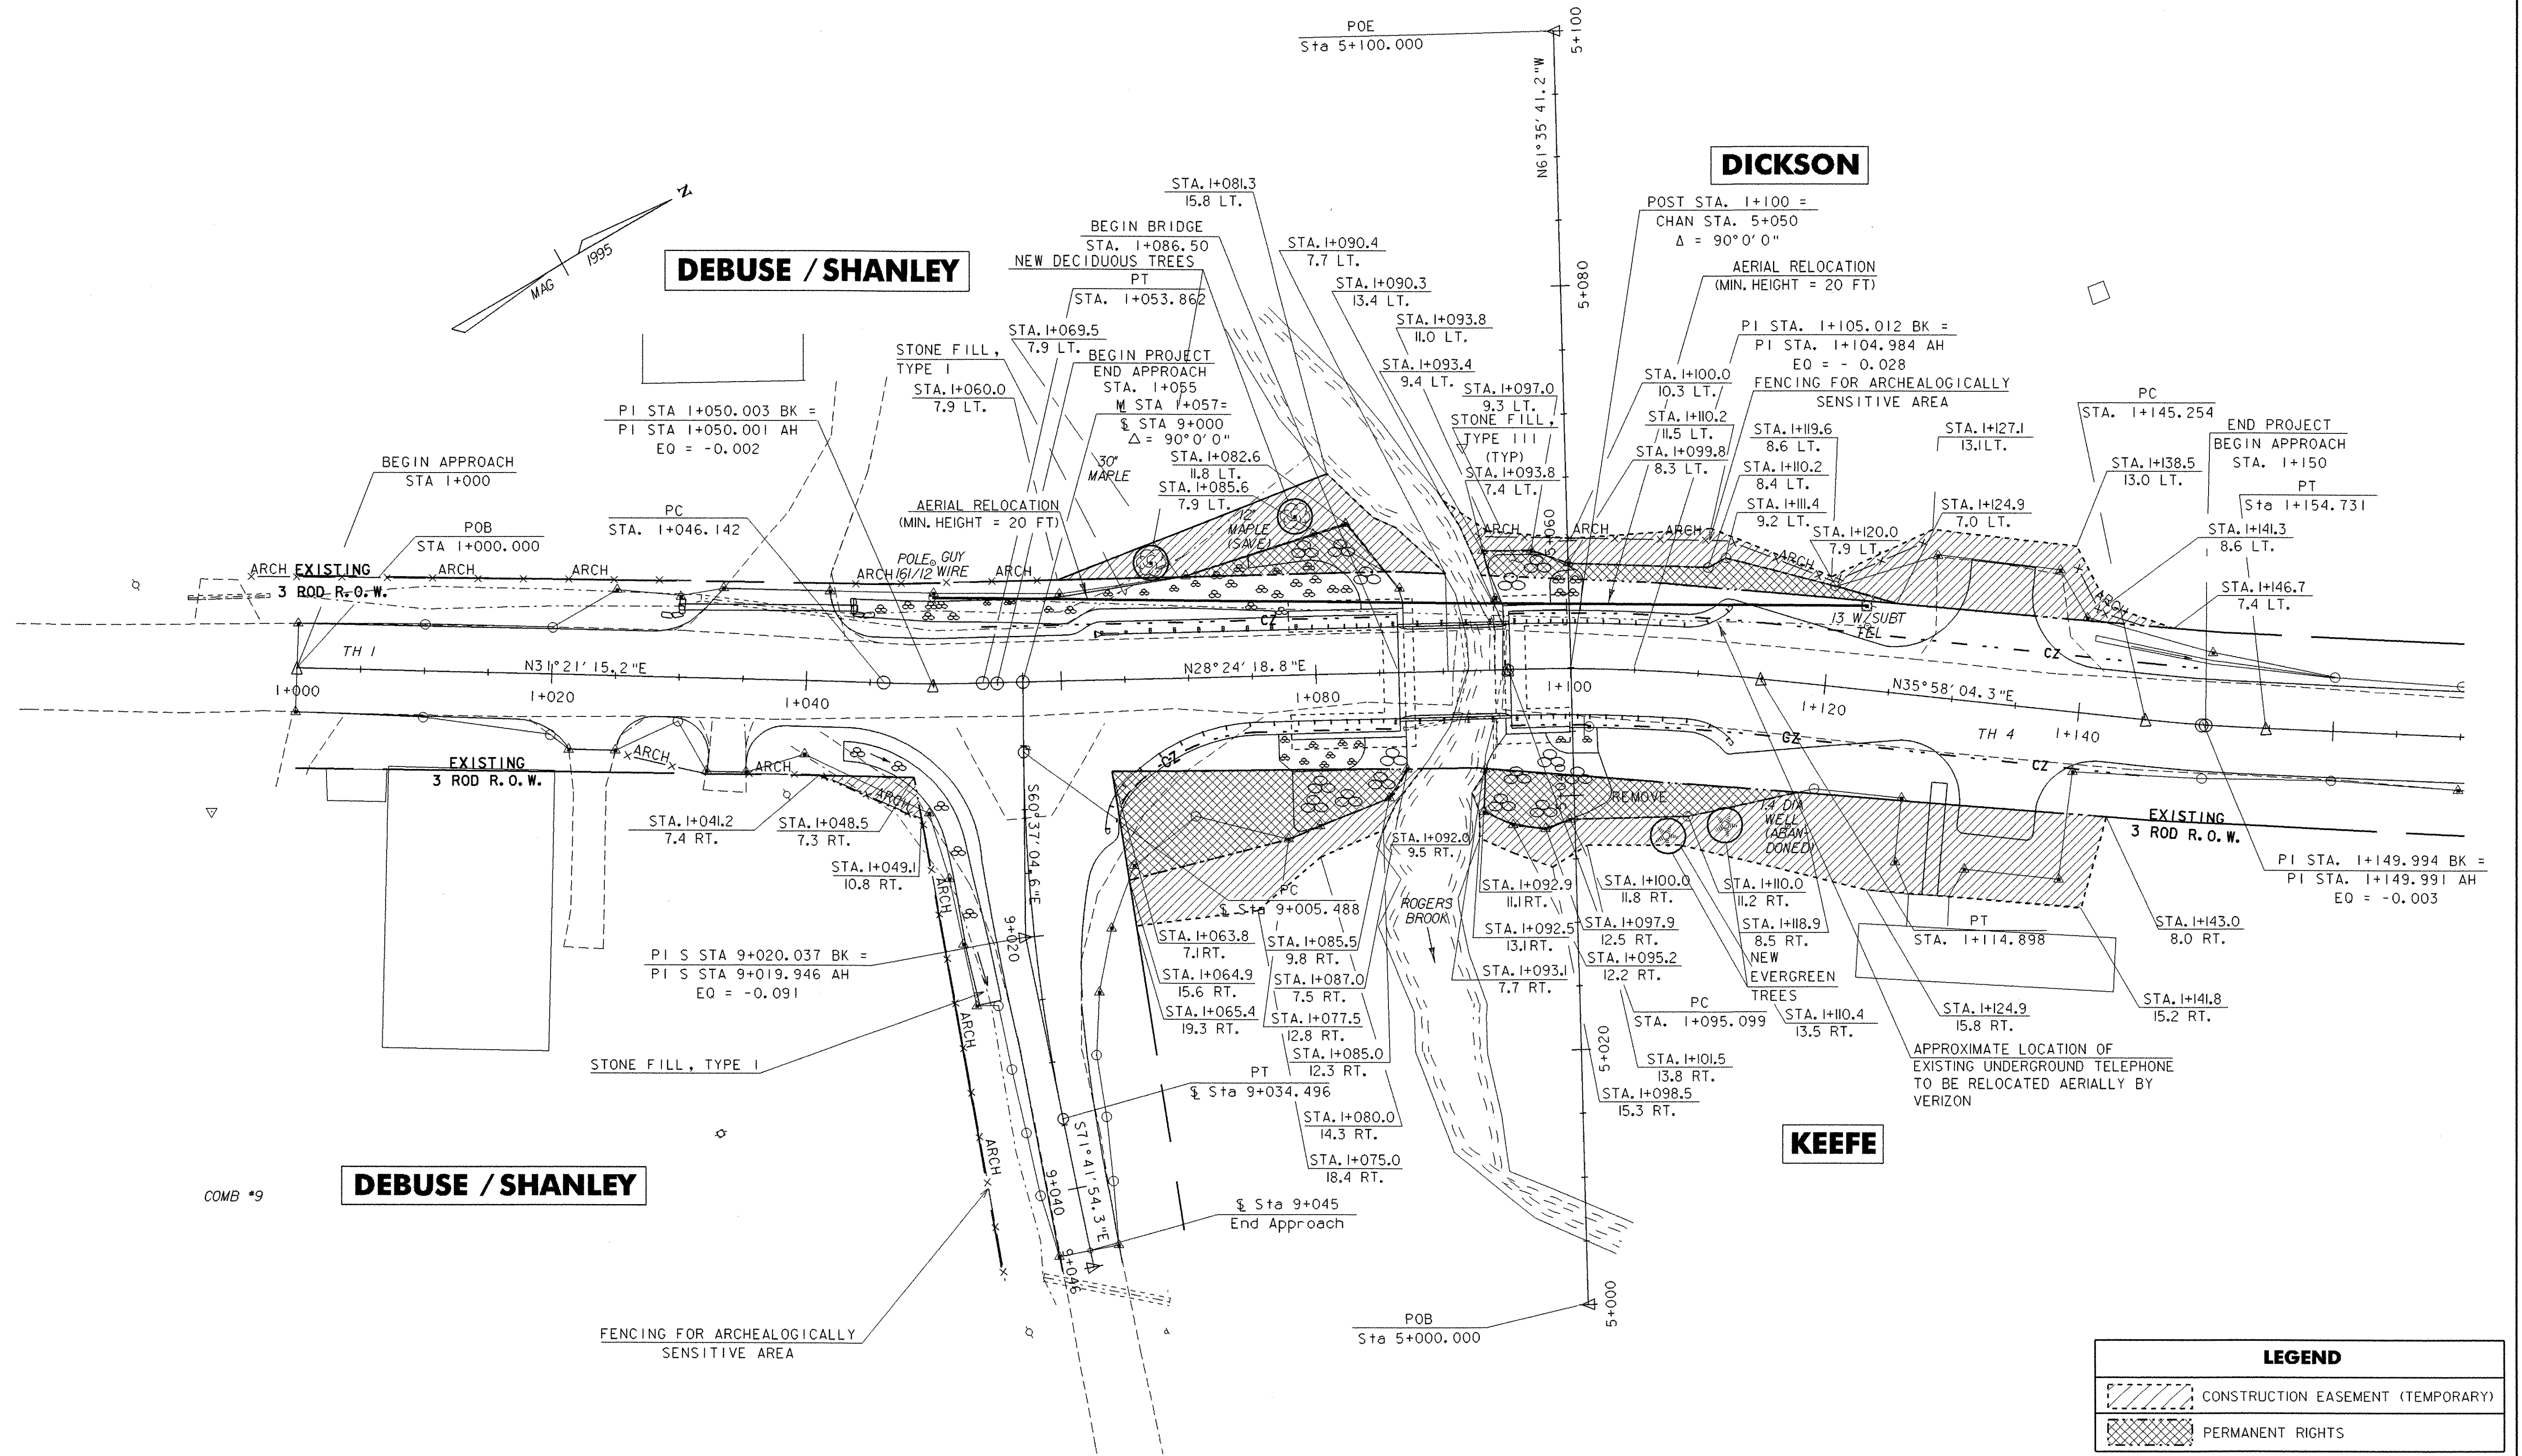

COMB *9

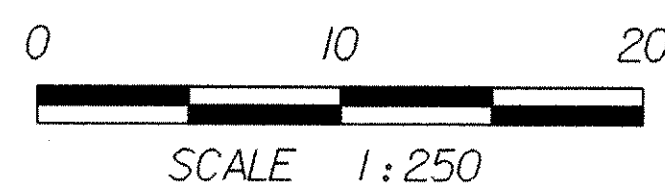

LEGEND	
	CONSTRUCTION EASEMENT (TEMPORARY)
	PERMANENT RIGHTS

TOTAL AREAS		
PROPERTY OWNER	TEMPORARY EASEMENT	PERMANENT RIGHTS
DEBUSE/SHANLEY	98.2 Square Meters (0.024 Acres)	30.8 Square Meters (0.008 Acres)
KEEFE	320.2 Square Meters (0.079 Acres)	191.7 Square Meters (0.047 Acres)
DICKSON	165.7 Square Meters (0.041 Acres)	45.5 Square Meters (0.011 Acres)

SHEET NAME: RIGHT OF WAY		
PROJECT NAME: WESTFORD	HIGHWAY NO.: TH 4	
PROJECT NUMBER: TH2 9436	BRIDGE NO.: 2	
	OVER: ROGERS BROOK	
FILE NAME: /PW/94J22/sj22r.w.dgn	PLOT DATE: 25-MAR-2005	
PROJECT MANAGER: R. R. WHITCOMB	DRAWN BY: T. HUSK	
DESIGNED BY: C. CARLSON	IPARM NAME: sj22r.w.j	
BRIDGE SHEET NUMBER:	SHEET 6 OF 56	

GPS CONTROL POINT INFORMATION

#1: BARKYUMB AZ MK - SSN 0085 - METAL PIPE IN CONCRETE

NORTHING - 231789.6440
 EASTING - 457093.0670
 ELEVATION - 185.830 m

LOCATION - WESTFORD, VT., APPROXIMATELY 20.1 km (12.5 MILES) NORTHEAST OF BURLINGTON, APPROXIMATELY 22.5 km (14.0 MILES) SOUTH OF ST. ALBANS AND ABOUT 41.0 km (25.5 MILES) WEST OF MORRISVILLE.

TO REACH FROM THE MOST WESTERLY INTERSECTION OF VT. ROUTES 104 AND 128 IN FAIRFAX, GO SOUTH ALONG VT. ROUTE 128 FOR 5.1 km (3.2 MILES) TO THE INTERSECTION OF BROOKSIDE ROAD RIGHT, AT THE NORTHWEST CORNER OF THE COMMON IN WESTFORD VILLAGE, OPPOSITE THE WESTFORD LIBRARY AND TOWN OFFICES. TURN RIGHT AND GO SOUTHWEST ALONG BROOKSIDE ROAD FOR 1.1 km (0.7 MILES) TO THE WESTFORD SCHOOL ON THE LEFT. CONTINUE STRAIGHT AHEAD ALONG BROOKSIDE ROAD FOR 2.3 km (1.4 MILES) TO THE INTERSECTION OF PETTINGILL ROAD STRAIGHT AHEAD AND BROOKSIDE ROAD RIGHT. CONTINUE STRAIGHT AHEAD ON PETTINGILL ROAD FOR 0.5 km (0.3 MILES) TO THE INTERSECTION OF PHELPS ROAD RIGHT. TURN RIGHT AND GO WEST ALONG PHELPS ROAD FOR 0.08 km (0.05 MILES) TO THE MARK ON THE LEFT IN THE TOP OF THE ROUNDED 10 m (32.8 FEET) X 2 m (6.6 FEET) LEDGE OUTCROP WHICH PROJECTS APPROXIMATELY 1m (3.3 FEET) ABOVE GROUND SURFACE.

THE MARK IS 7.9 m (25.9 FEET) SOUTH OF AND APPROXIMATELY 1m (3.3 FEET) HIGHER THAN THE CENTERLINE OF PHELPS ROAD, 9.3 m (30.5 FEET) EAST OF POLE NO. 16/29, 10.2 m (33.5 FEET) NORTH OF A TWIN 15 cm CHERRY, 4.7 m (15.4 FEET) SOUTH OF THE NORTH END OF THE LEDGE OUTCROP AND 1.1m (3.6 FEET) EAST OF A FIBERGLASS WITNESS POST.

#2: BARKYUMB - SSN 0085 - METAL PIPE IN CONCRETE

NORTHING - 232735.3160
 EASTING - 457085.4250
 ELEVATION - 171.770 m

LOCATION - WESTFORD, VT., APPROXIMATELY 19.3 km (12 MILES) NORTHEAST OF BURLINGTON, APPROXIMATELY 23.3 km (14.5 MILES) SOUTH OF ST. ALBANS AND APPROXIMATELY 41.0 km (25.5 MILES) WEST OF MORRISVILLE.

TO REACH FROM THE MOST WESTERLY INTERSECTION OF VT. ROUTES 104 AND 128 IN FAIRFAX, GO SOUTH ALONG VT. ROUTE 128 FOR 5.1 km (3.2 MILES) TO THE INTERSECTION OF BROOKSIDE ROAD RIGHT, AT THE NORTHWEST CORNER OF THE COMMON IN WESTFORD VILLAGE, OPPOSITE THE WESTFORD LIBRARY AND TOWN OFFICES. TURN RIGHT AND GO SOUTHWEST ALONG BROOKSIDE ROAD FOR 1.1 km (0.7 MILES) TO THE WESTFORD SCHOOL ON THE LEFT. CONTINUE STRAIGHT AHEAD ALONG BROOKSIDE ROAD FOR 2.3 km (1.4 MILES) TO THE INTERSECTION OF PETTINGILL ROAD STRAIGHT AHEAD AND BROOKSIDE ROAD RIGHT. TURN RIGHT AND GO NORTHWEST ALONG BROOKSIDE ROAD FOR 0.6 km (0.4 MILES) TO THE TWO STORY HOUSE OF JOHN BARKYUMB ON THE RIGHT AND THE MARK ON THE RIGHT IN THE LAWN SOUTH OF THE HOUSE. IT IS APPROXIMATELY 0.2 km (0.1 MILE) EAST OF THE INTERSECTION OF BROOKSIDE ROAD AND WOODS HOLLOW ROAD.

THE MARK IS 20.0 m (65.6 FEET) NORTH OF AND ABOUT LEVEL WITH THE CENTERLINE OF BROOKSIDE ROAD, 5.4 m (17.7 FEET) SOUTH OF THE SOUTHWEST CORNER OF BARKYUMB'S HOUSE, 11.1 m (36.4 FEET) SOUTHWEST OF THE SOUTHEAST CORNER OF THE HOUSE, 14.4 m (47.2 FEET) WEST OF THE CENTERLINE OF THE GRAVEL DRIVE TO THE HOUSE AND 27.6 m (90.6 FEET) NORTHEAST OF A FIBERGLASS WITNESS POST. IT IS IN THE TOP OF A CAST ALUMINUM MONUMENT.

MAINLINE POT	MAINLINE PC	MAINLINE PT	MAINLINE POT=SIDELINE POB	MAINLINE PC	MAINLINE PT
STA. 1+000.000	STA. 1+046.142	STA. 1+053.862	STA. 1+057.000 = STA. 9+000.000	STA. 1+095.099	STA. 1+114.898
N = 232695.0390	N = 232734.4430	N = 232741.360	N = 232743.8950	N = 232777.4080	N = 232794.1520
E = 456979.7560	E = 457003.7650	E = 457007.6110	E = 457009.0990	E = 457027.2270	E = 457037.7660
MAINLINE PC	MAINLINE PT	MAINLINE POT	SIDELINE PC	SIDELINE PT	SIDELINE POT
STA. 1+145.254	STA. 1+154.731	STA. 1+210.000	STA. 9+005.488	STA. 9+034.496	STA. 9+046.305
N = 232818.7210	N = 232826.5610	N = 232873.2540	N = 232741.2030	N = 232729.4950	N = 232725.7870
E = 457055.5950	E = 457060.9150	E = 457090.4880	E = 457013.8810	E = 457040.3730	E = 457051.5840

NOTE: TIE DISTANCES ARE IN METERS.

DATUM
 VERTICAL NAVD 88
 HORIZONTAL NAD 83/92 GPS

SHEET NAME: TIE SHEET		
PROJECT NAME: WESTFORD	HIGHWAY NO.: TH 4	
PROJECT NUMBER: TH2 9436	BRIDGE NO.: 2	
	OVER: ROGERS BROOK	
FILE NAME: /PW/94j122/sj122+tie.dgn	PLOT DATE: 25-MAR-2005	
PROJECT MANAGER: R. R. WHITCOMB	DRAWN BY: STRI	
DESIGNED BY: C. CARLSON	IPARM NAME: sj122+tie.i	
BRIDGE SHEET NUMBER:	SHEET 7 OF 56	

CONSTRUCT DRIVES
 STA 1+023 RT
 STA 1+034 RT
 STA 1+037 LT
 STA 1+133 LT
 STA 1+134 RT

HEAVY DUTY STEEL BEAM GUARD RAIL
 STA 1+078.6 LT - STA 1+086 LT
 STA 1+095.6 LT - STA 1+112.1 LT
 STA 9+012.2 LT - STA 1+086 RT
 STA 1+095.6 RT - STA 1+113.3 RT

BRIDGE RAIL
 HEAVY DUTY STEEL BEAM RAIL
 WITH HAND RAIL
 STA 1+086 RT - STA 1+095.6 RT
 STA 1+086 LT - STA 1+095.6 LT

RELOCATE MAILBOX
 STA 1+139 RT

MANUFACTURED TERMINAL SECTION (TANGENT)
 STA 1+060.8 - 1+078.6 LT

CURVE #2
 RADIUS: 150
 DELTA: 7°33'45" R
 LENGTH: 19.799
 TANGENT: 9.914
 CHORD: 19.785
 ORDINATE: 0.327
 EXTERNAL: 0.327
 BANK = NORMAL

CONSTRUCT DITCHES
 STA 1+025 LT - STA 1+030 LT
 STA 1+044 LT - STA 1+075 LT
 STA 1+043 RT - STA 9+025 RT

ANCHOR FOR STEEL BEAM RAIL
 STA 1+110.5 LT
 STA 1+111.4 RT
 STA 9+010.0 LT


DECIDUOUS TREES
 STA 1+067.3 LT (+/-) O/S 9.1 m (+/-)
 STA 1+079.5 LT (+/-) O/S 12.5 m (+/-)

CURVE #1
 RADIUS: 150
 DELTA: 2°56'57" L
 LENGTH: 7.72
 TANGENT: 3.861
 CHORD: 7.72
 ORDINATE: 0.05
 EXTERNAL: 0.050
 BANK = NORMAL

CONSTRUCT WALKWAY
 STA 1+129.6 RT

PIPE OPTIONS - STA 1+037 LT
 450 PCCSP x 14 000
 450 CAAP x 14 000
 450 CPEP x 14 000

CONSTRUCT LAID UP STONE HEADWALL
 (ITEM #602, 20, DRY RUBBLE MASONRY)
 STA 1+030 LT
 STA 1+043.5 LT

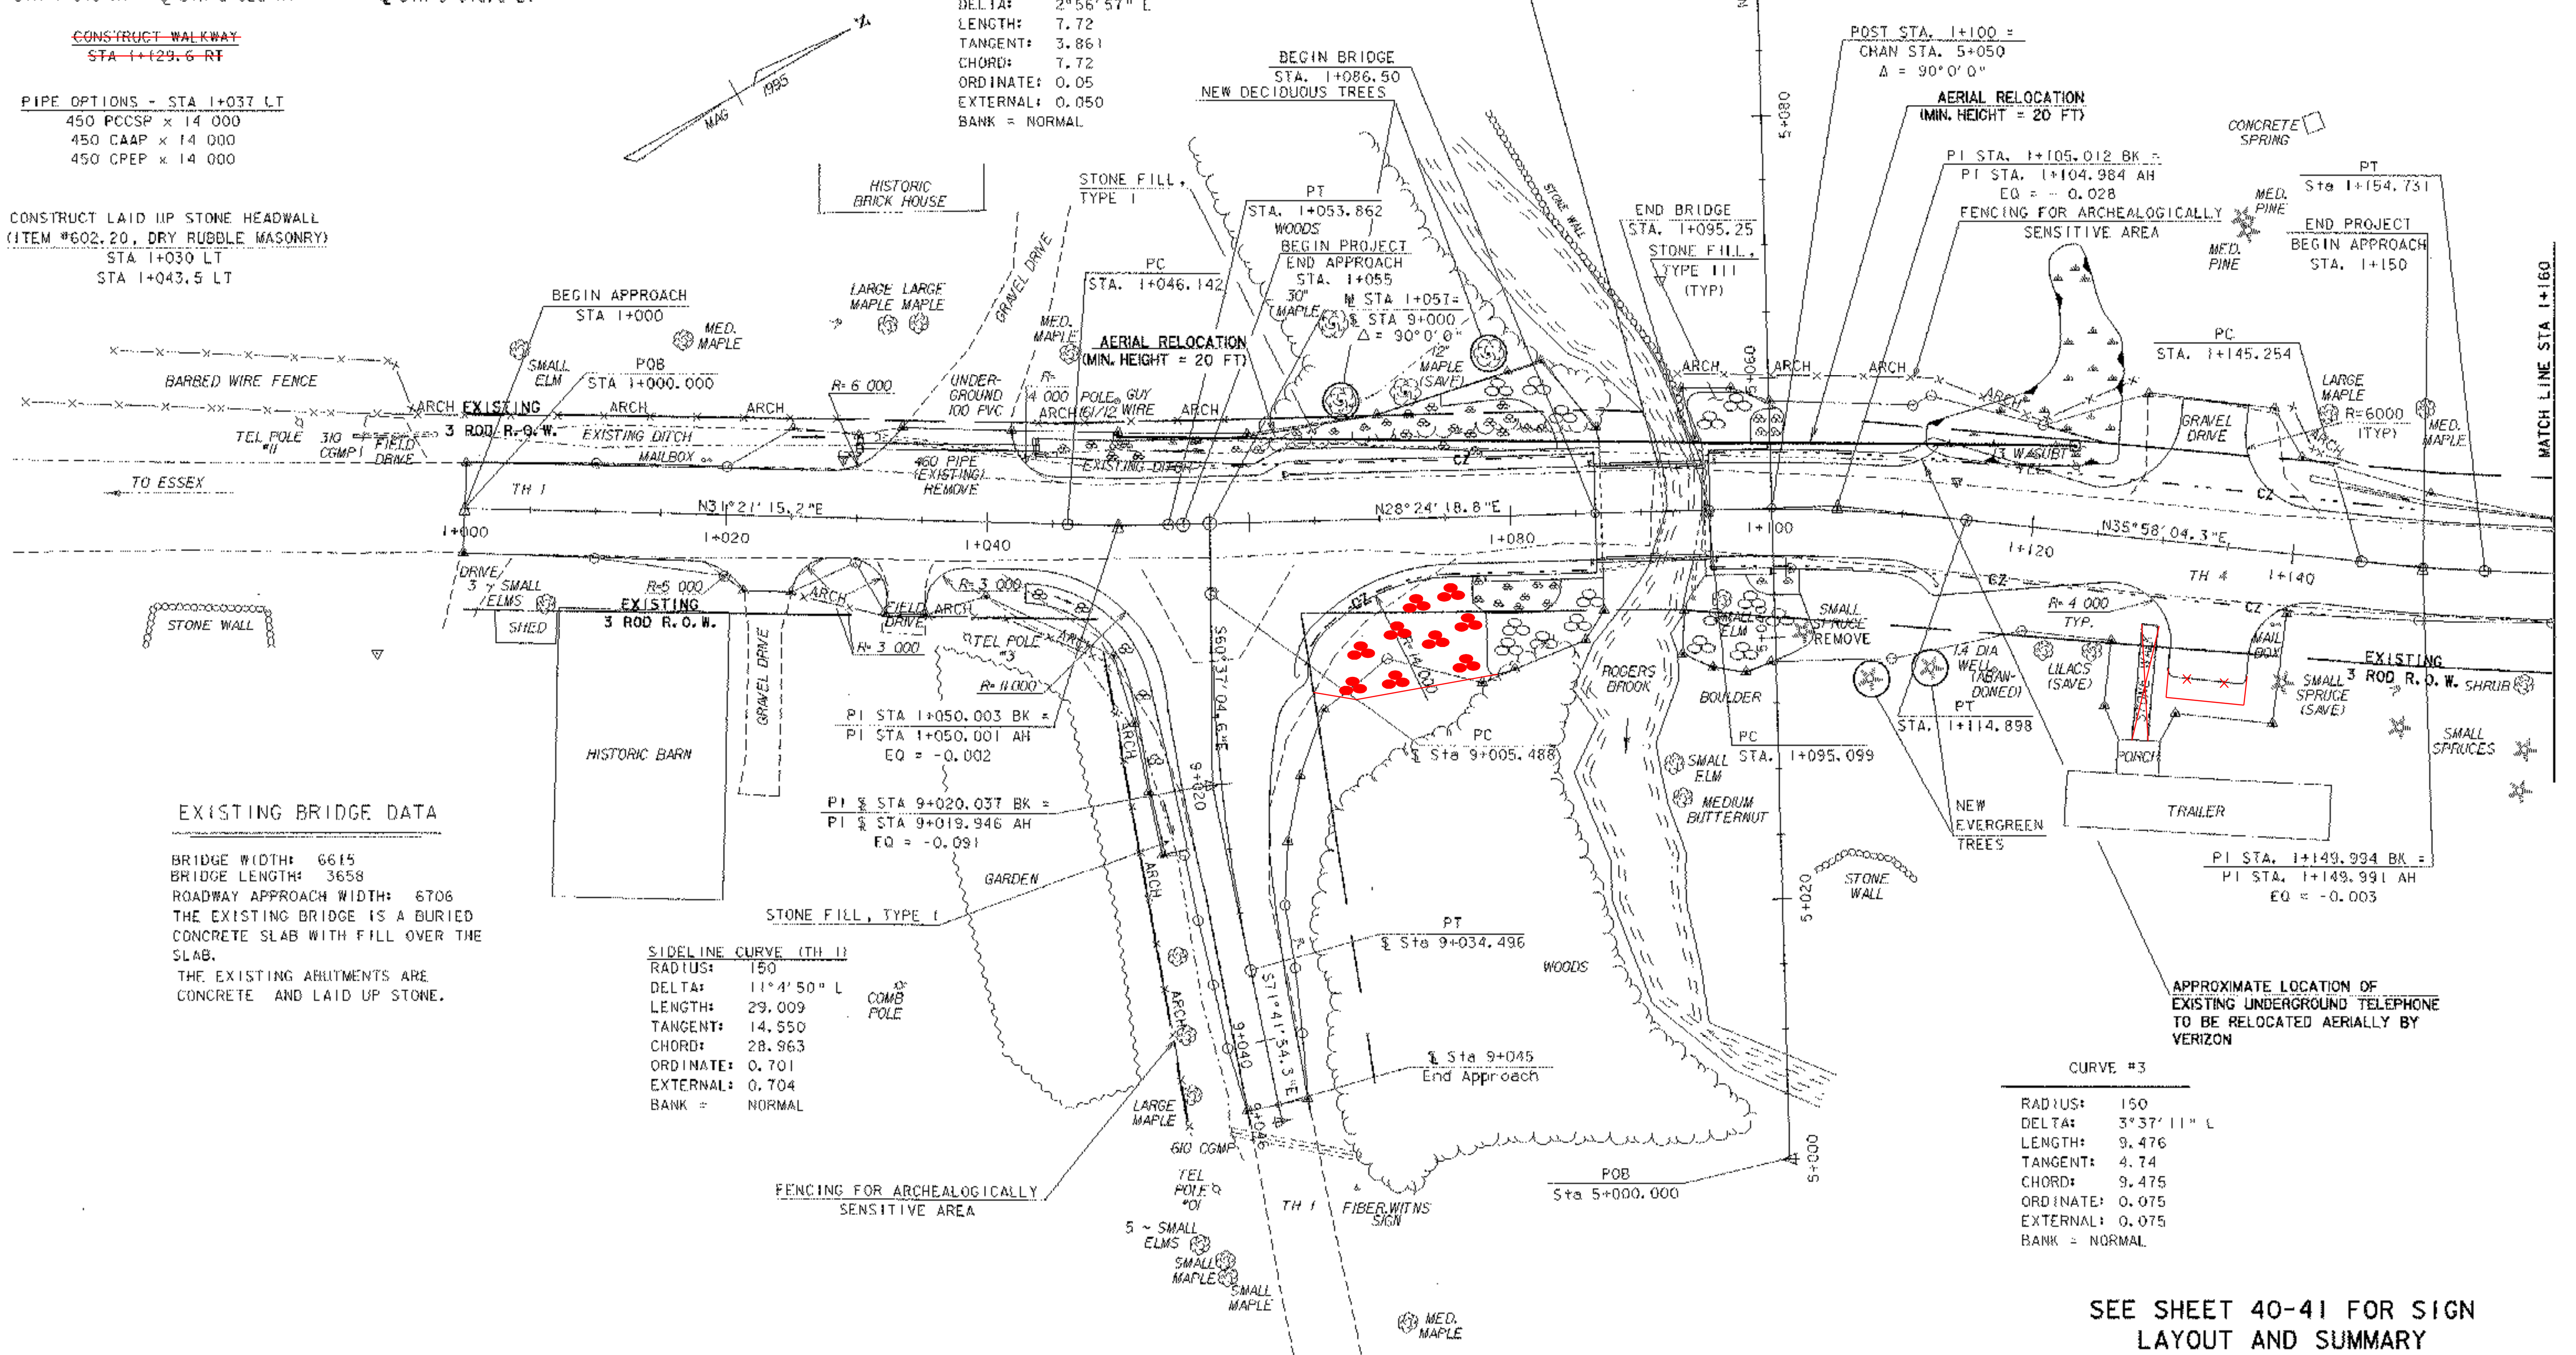


EXISTING BRIDGE DATA
 BRIDGE WIDTH: 6615
 BRIDGE LENGTH: 3658
 ROADWAY APPROACH WIDTH: 6706
 THE EXISTING BRIDGE IS A BURIED CONCRETE SLAB WITH FILL OVER THE SLAB.
 THE EXISTING ABUTMENTS ARE CONCRETE AND LAID UP STONE.

SIDELINE CURVE (TH 1)
 RADIUS: 150
 DELTA: 11°4'50" L
 LENGTH: 29.009
 TANGENT: 14.550
 CHORD: 28.963
 ORDINATE: 0.701
 EXTERNAL: 0.704
 BANK = NORMAL

APPROXIMATE LOCATION OF EXISTING UNDERGROUND TELEPHONE TO BE RELOCATED AERIALY BY VERIZON




CURVE #3
 RADIUS: 150
 DELTA: 3°37'11" L
 LENGTH: 9.476
 TANGENT: 4.74
 CHORD: 9.475
 ORDINATE: 0.075
 EXTERNAL: 0.075
 BANK = NORMAL

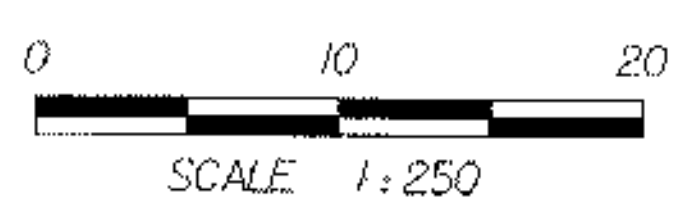

SEE SHEET 40-41 FOR SIGN LAYOUT AND SUMMARY




SHEET NAME: LAYOUT SHEET #1	
PROJECT NAME: WESTFORD	HIGHWAY NO.: TH 4
PROJECT NUMBER: TH2 9436	BRIDGE NO.: 2
	OVER: ROGERS BROOK
FILE NAME: /PW/94122/s1122bdr.dgn	PLOT DATE: 25-MAR-2005
PROJECT MANAGER: R. R. WHITCOMB	DRAWN BY: STRI
DESIGNED BY: C. CARLSON	IPARM NAME: s1122tbl1
BRIDGE SHEET NUMBER:	SHEET 8 OF 56

CONSTRUCT DRIVES
STA 1488 RT

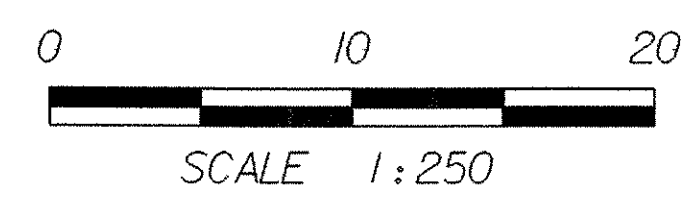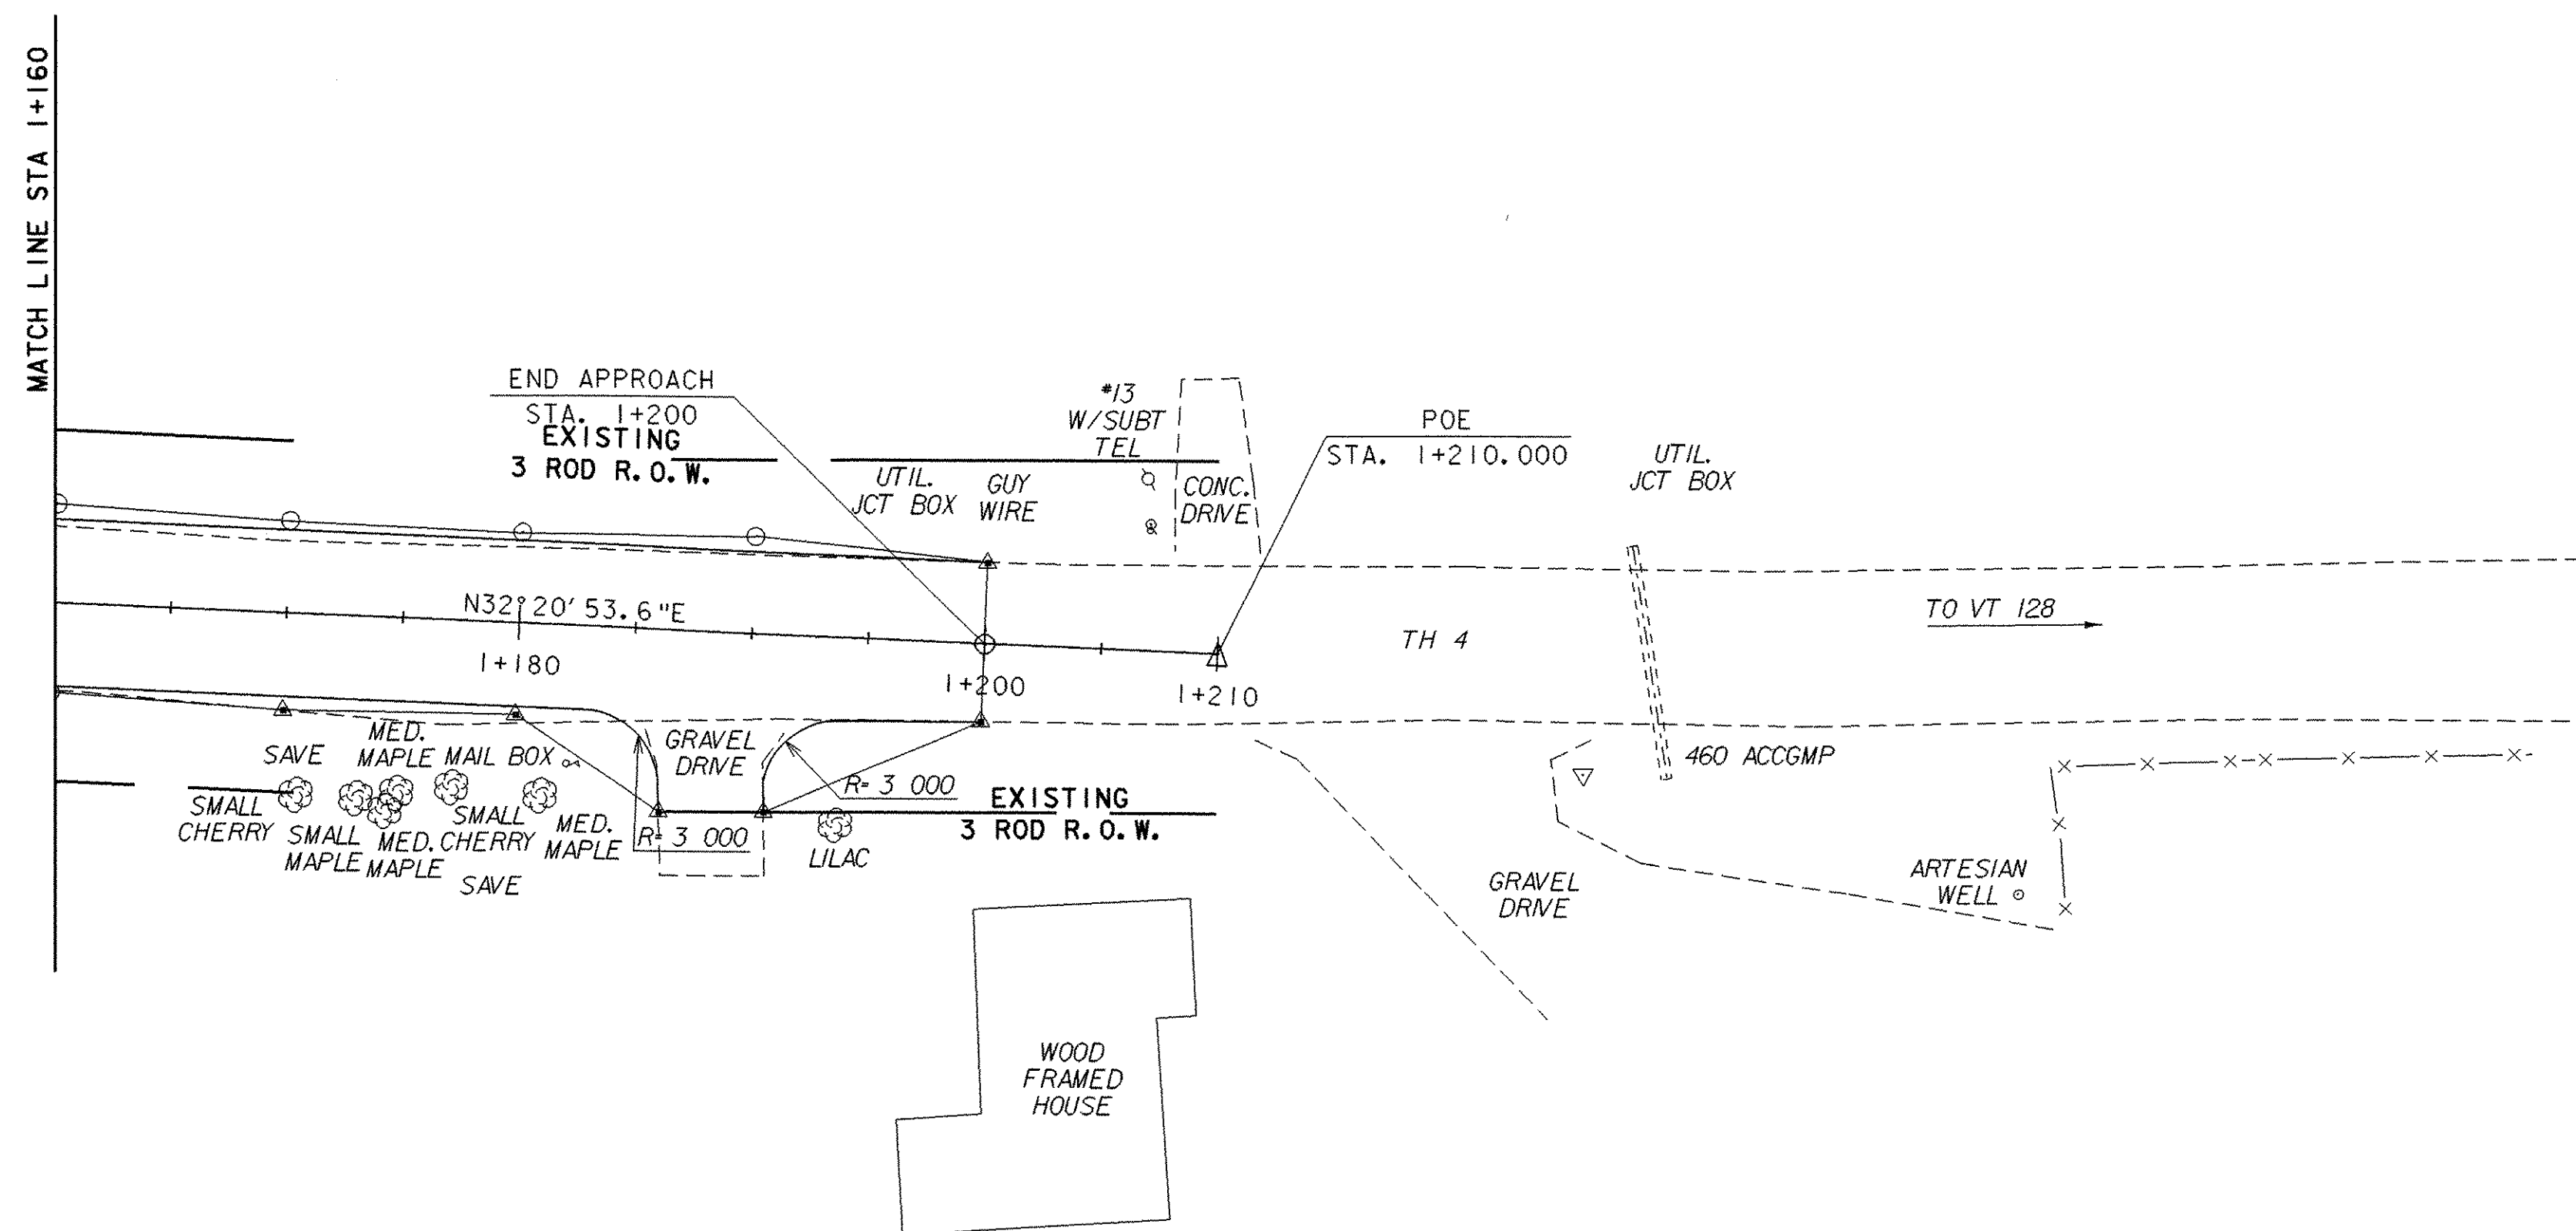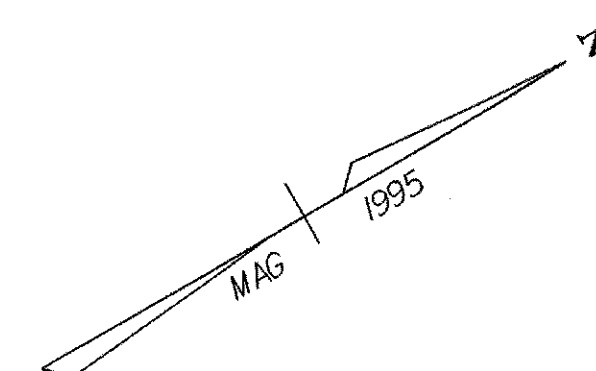

SHEET NAME: LAYOUT SHEET #2	
PROJECT NAME: WESTFORD	HIGHWAY NO.: TH 4
PROJECT NUMBER: TH2 9436	BRIDGE NO.: 2
	OVER: ROGERS BROOK
FILE NAME: /PW/94j22/sj22bdr.dgn	PLOT DATE: 25-MAR-2005
PROJECT MANAGER: R. R. WHITCOMB	DRAWN BY: STRI
DESIGNED BY: C. CARLSON	IPARM NAME: sj221a2.1
BRIDGE SHEET NUMBER:	SHEET 9 OF 56



Mainline Profile

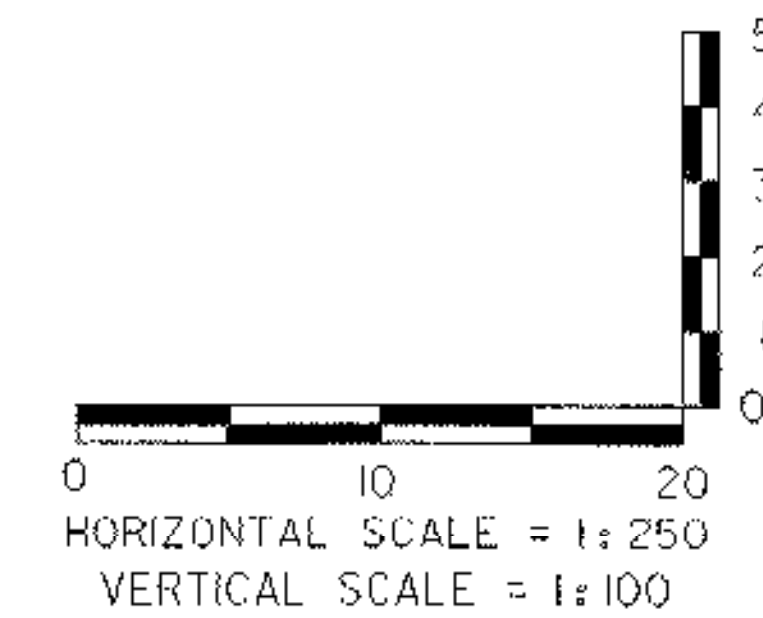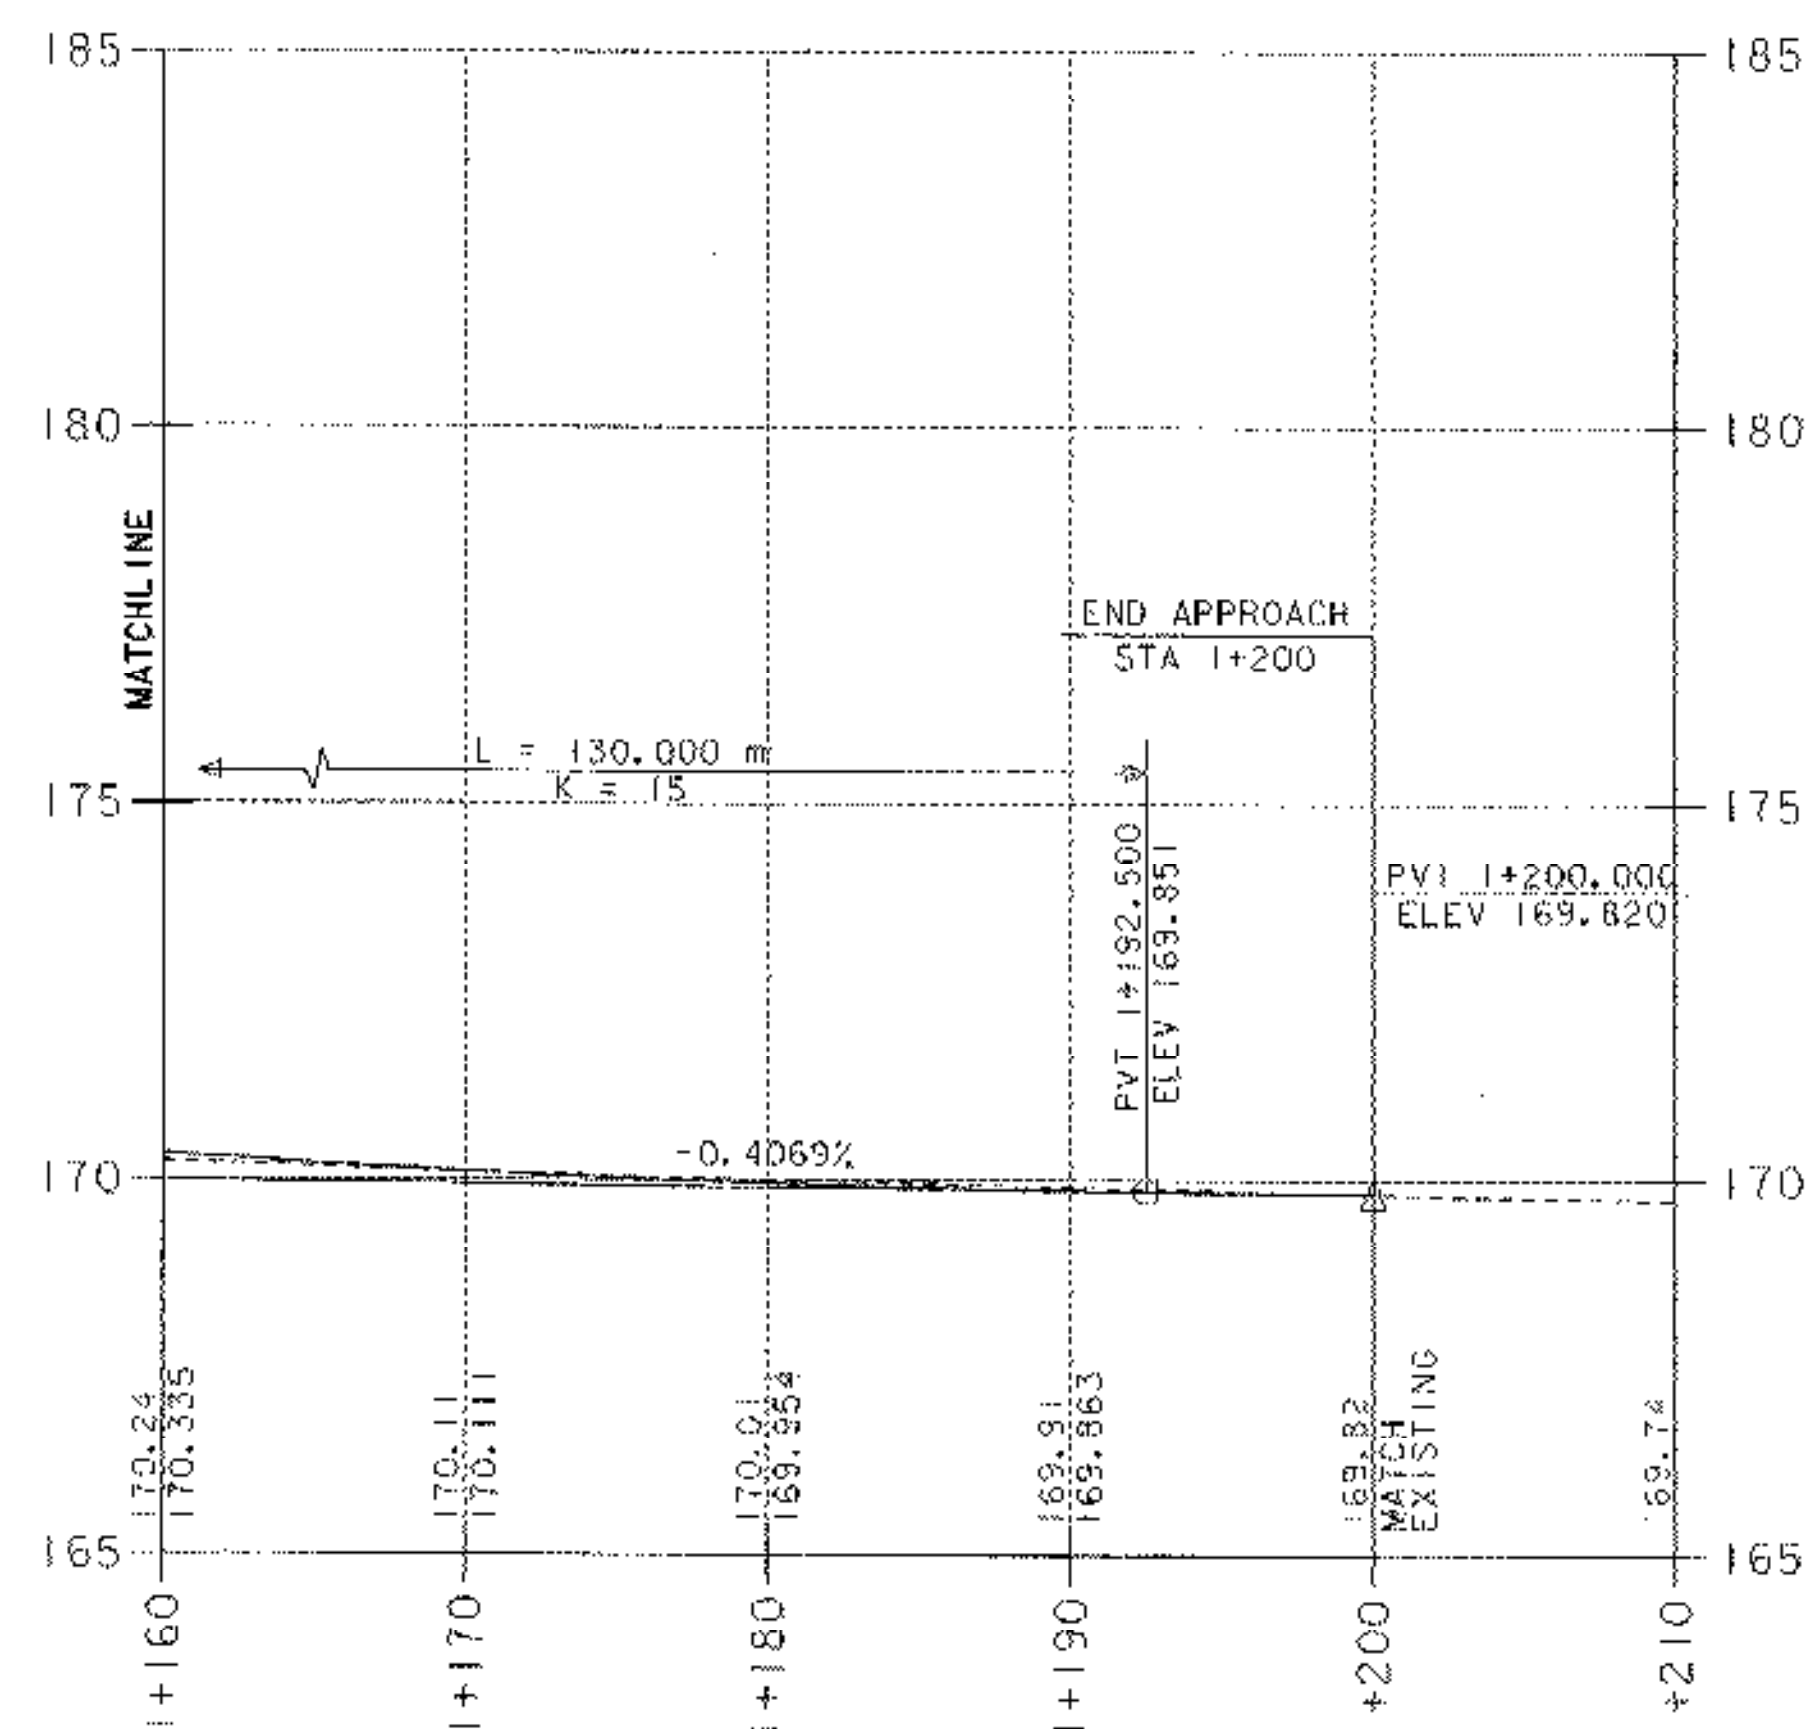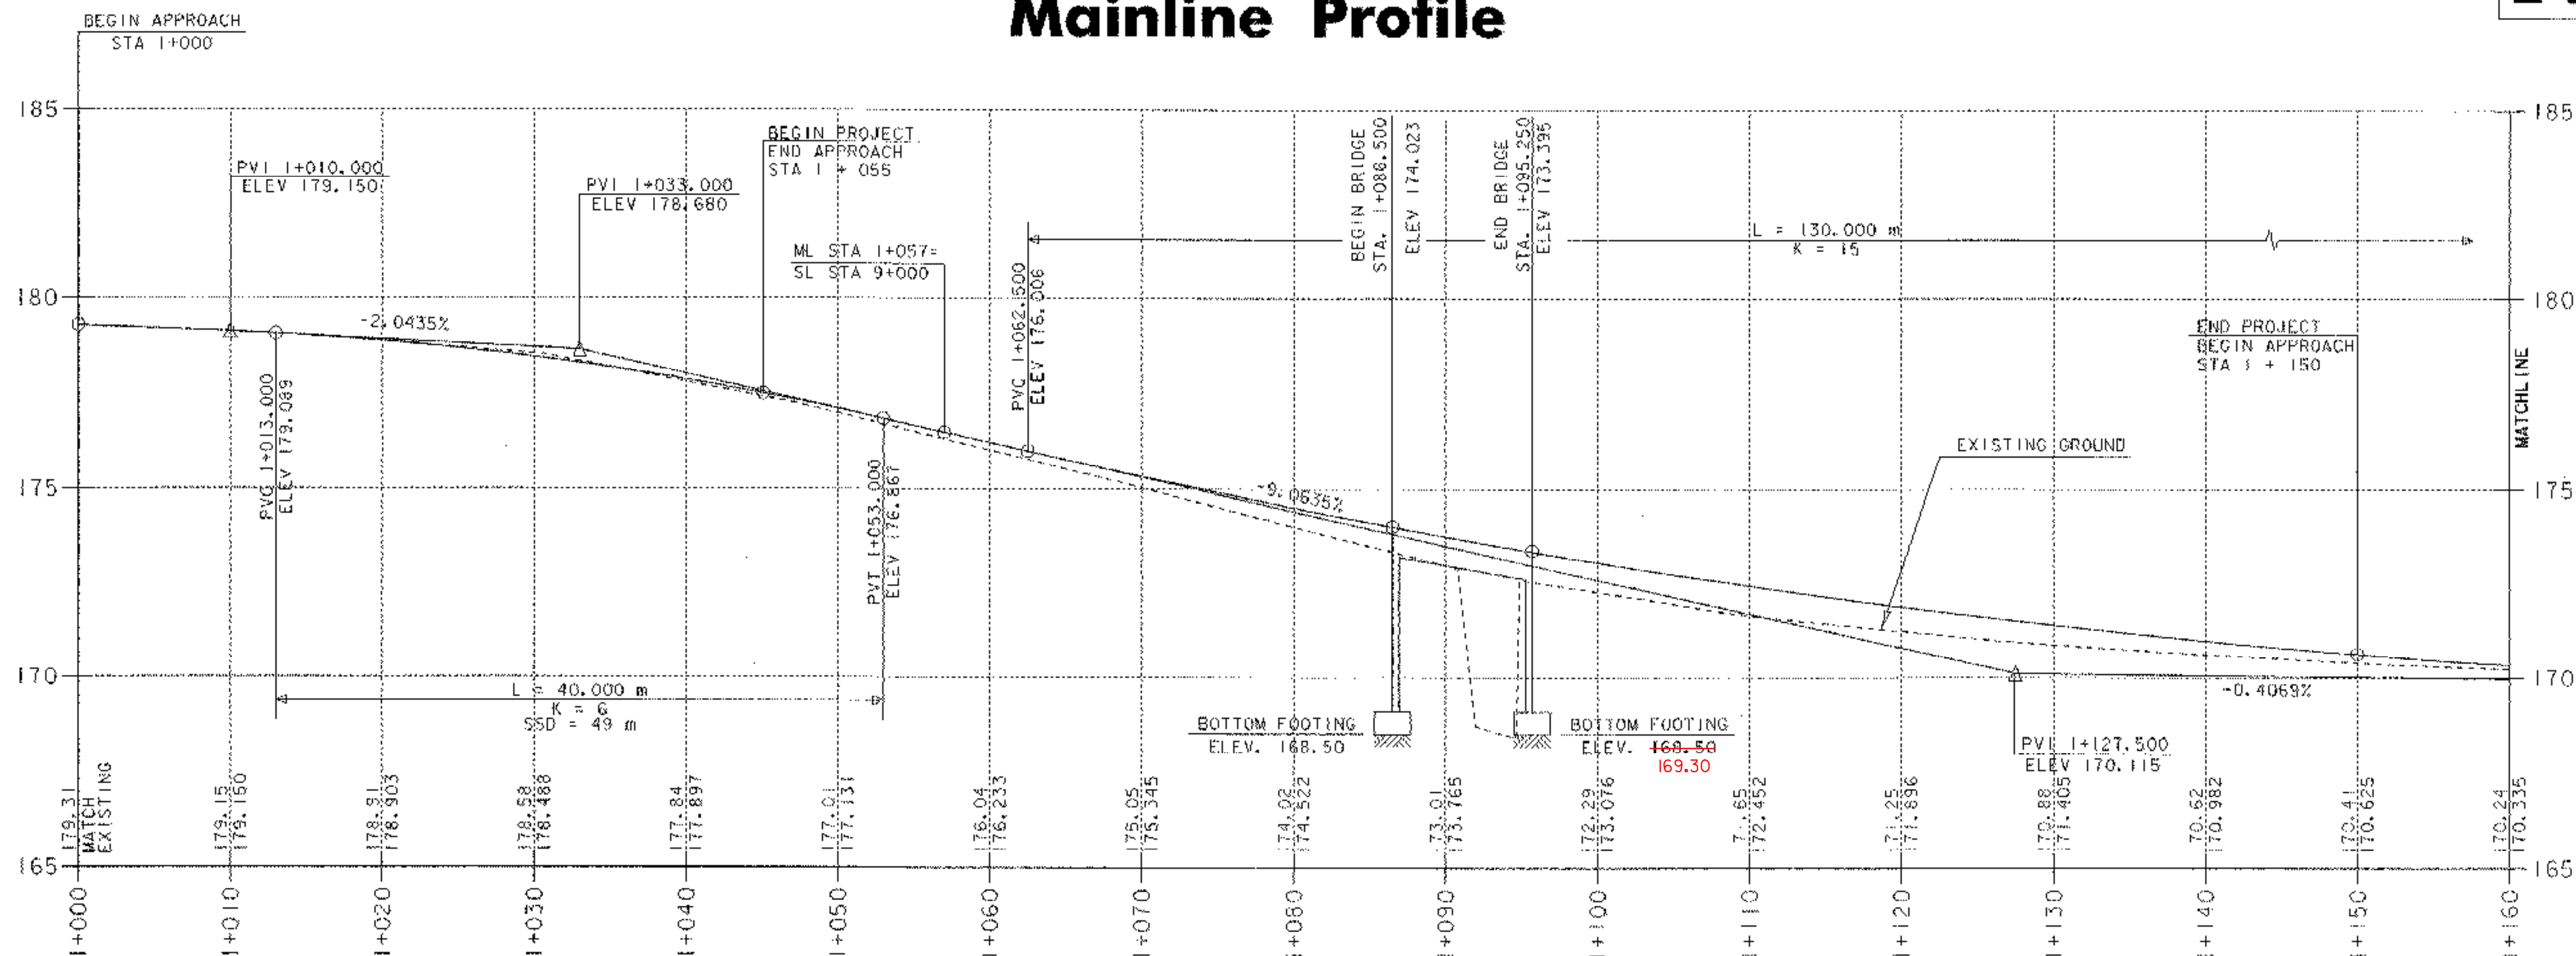

NOTE:
 GRADES SHOWN TO THE NEAREST HUNDREDTH ARE THE OLD GROUND ALONG THE CENTERLINE. GRADES SHOWN TO THE NEAREST THOUSANDTH ARE THE PROPOSED FINISHED GRADE ALONG THE CENTERLINE.

SHEET NAME: MAINLINE PROFILE		
PROJECT NAME: WESTFORD	HIGHWAY NO.: TH 4	
PROJECT NUMBER: TH2 9436	BRIDGE NO.: 2	OVER: ROGERS BROOK
FILE NAME: /PW/94J22/sj22xs2.dgn	PLOT DATE: 25-MAR-2005	
PROJECT MANAGER: R. R. WHITCOMB	DRAWN BY: STRI	
DESIGNED BY: C. CARLSON	IPARM NAME: sj22p-flj	
BRIDGE SHEET NUMBER:	SHEET 10 OF 56	



Sideline Profile (TH 1 Intersection with TH 4)

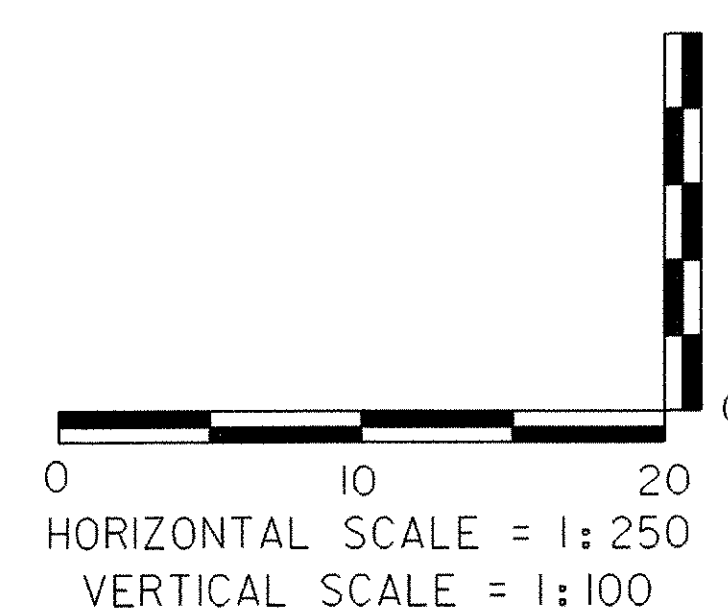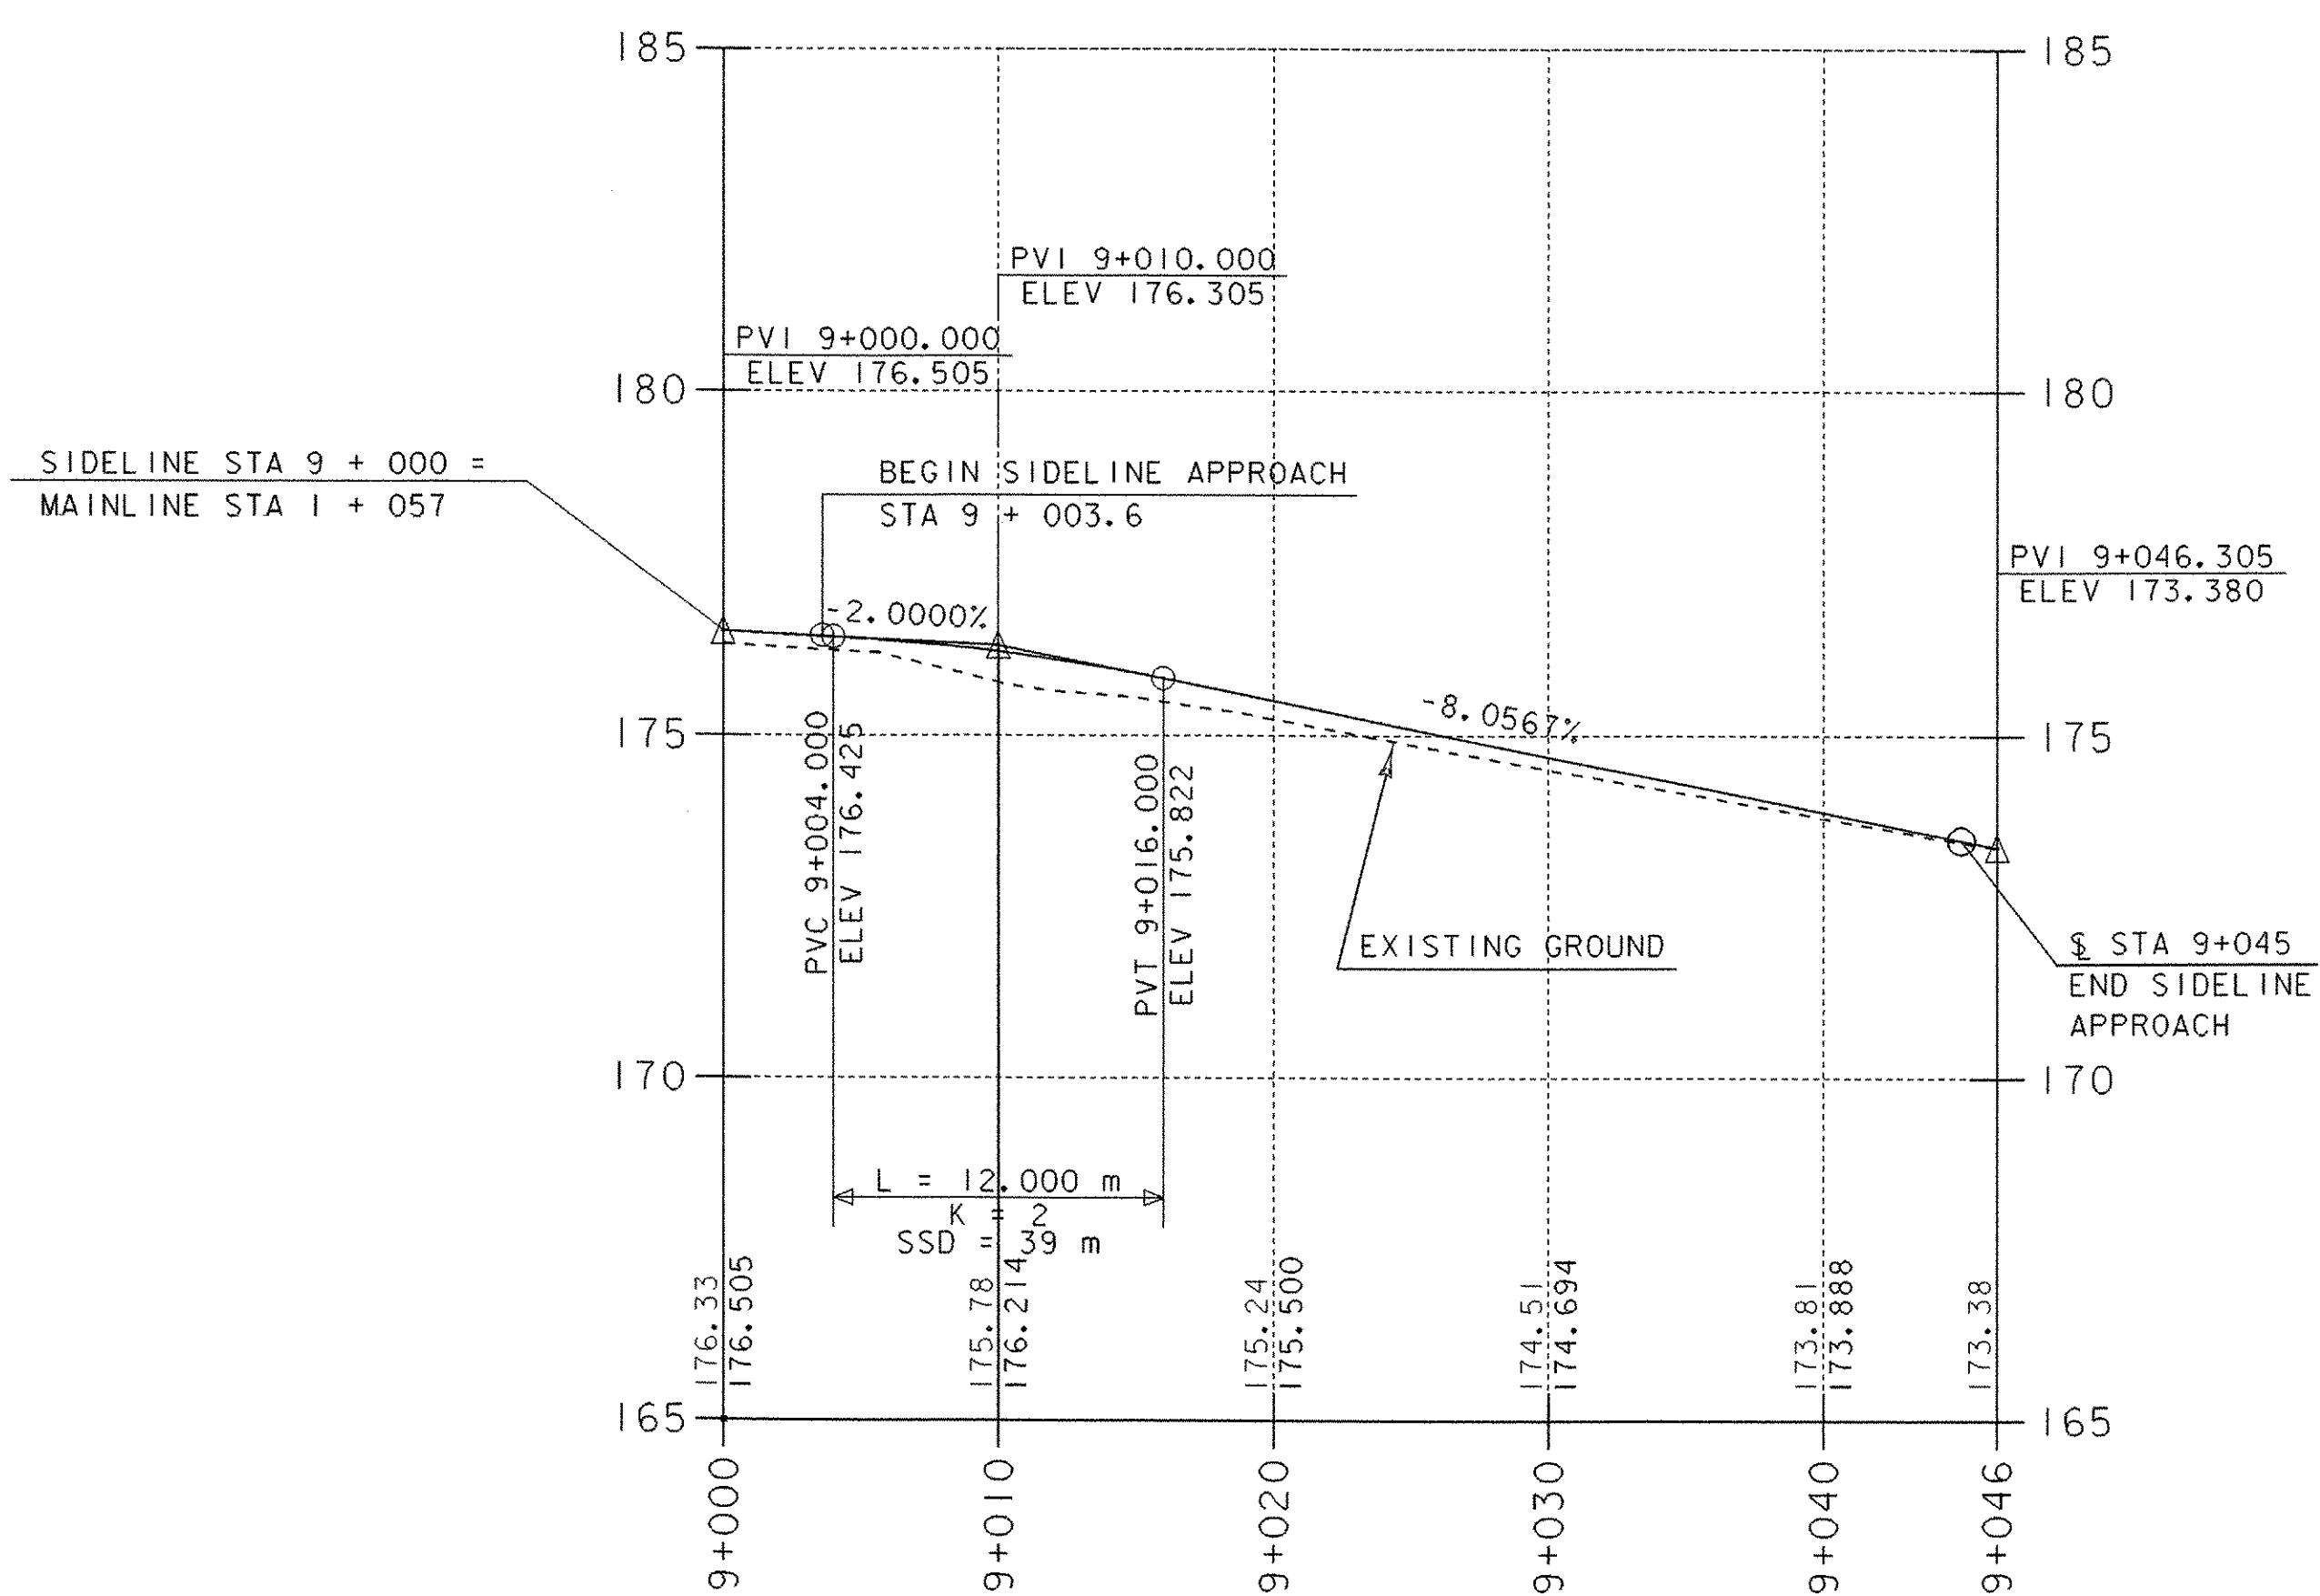

NOTE:

GRADES SHOWN TO THE NEAREST HUNDREDTH ARE THE OLD GROUND ALONG THE CENTERLINE. GRADES SHOWN TO THE NEAREST THOUSANDTH ARE THE PROPOSED FINISHED GRADE ALONG THE CENTERLINE.


SHEET NAME: SIDELINE PROFILE	
PROJECT NAME: WESTFORD	HIGHWAY NO.: TH 4
PROJECT NUMBER: TH2 9436	BRIDGE NO.: 2
	OVER: ROGERS BROOK
FILE NAME: /PW/94J122/sj122xs2.dgn	PLOT DATE: 25-MAR-2005
PROJECT MANAGER: R. R. WHITCOMB	DRAWN BY: STRI
DESIGNED BY: C. CARLSON	IPARM NAME: sj122pf2.1
BRIDGE SHEET NUMBER:	SHEET 11 OF 56

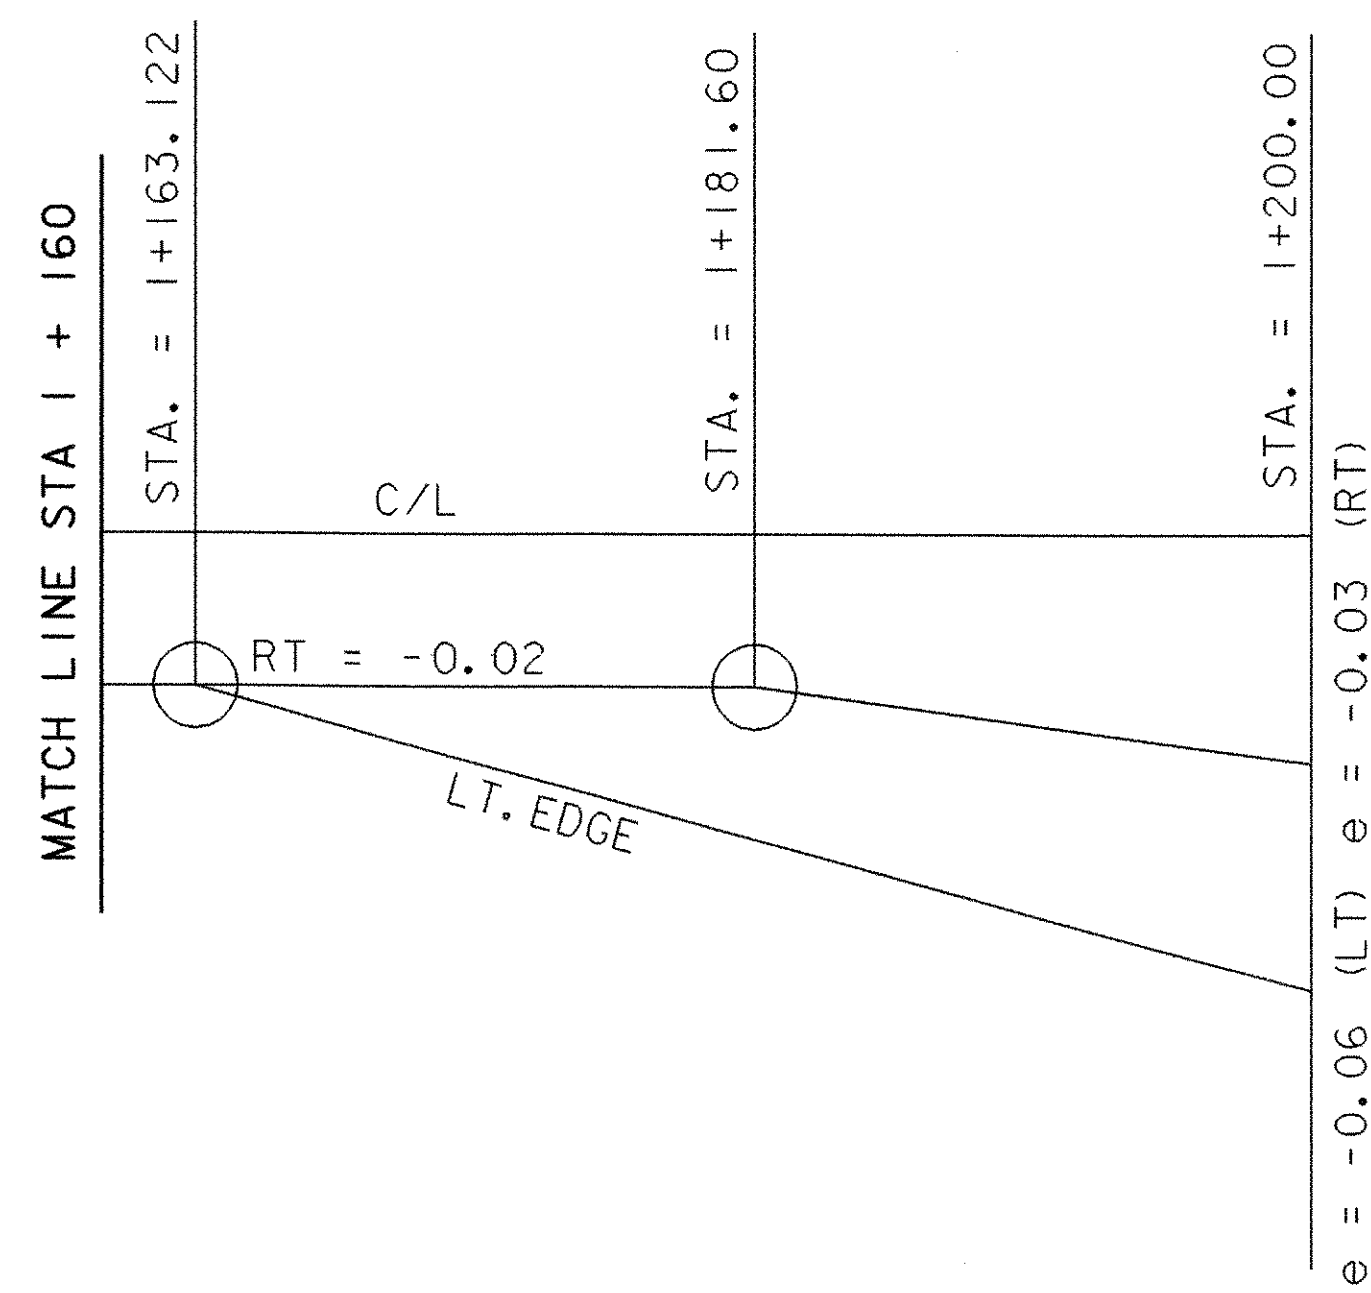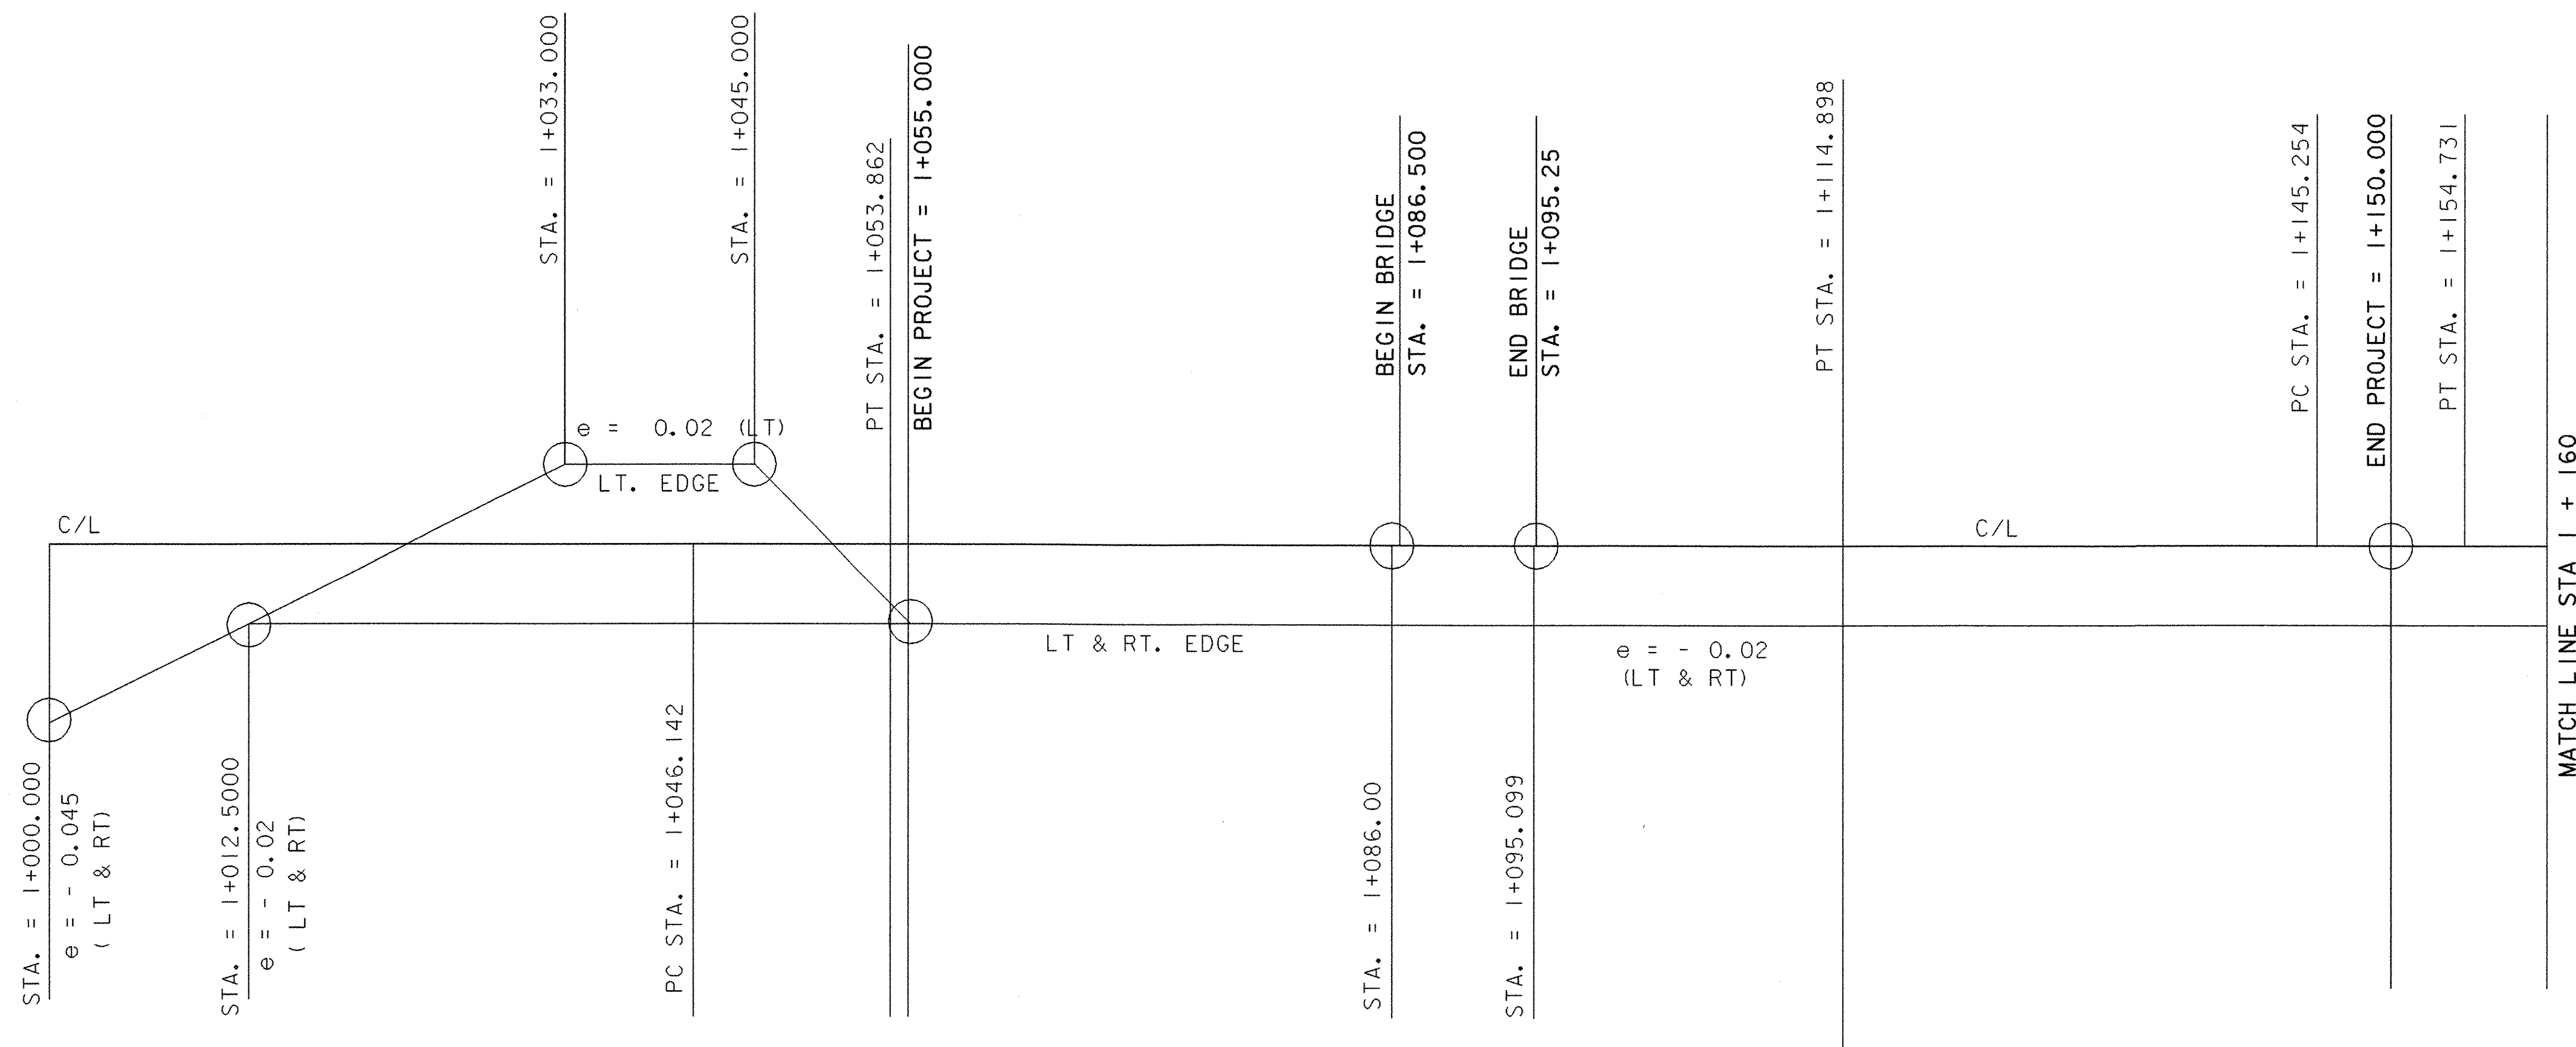

BANKING DIAGRAM

SCALE:
 1:250 HORIZONTALLY
 1:100 VERTICALLY

SHEET NAME: BANKING DIAGRAM	
PROJECT NAME: WESTFORD	HIGHWAY NO.: TH 4
PROJECT NUMBER: TH2 9436	BRIDGE NO.: 2
	OVER: ROGERS BROOK
FILE NAME: /PW/94J122/sj122xs2.dgn	PLOT DATE: 25-MAR-2005
PROJECT MANAGER: R. R. WHITCOMB	DRAWN BY: STR3
DESIGNED BY: C. CARLSON	IPARM NAME: sj122bk.1
BRIDGE SHEET NUMBER:	SHEET 12 OF 56

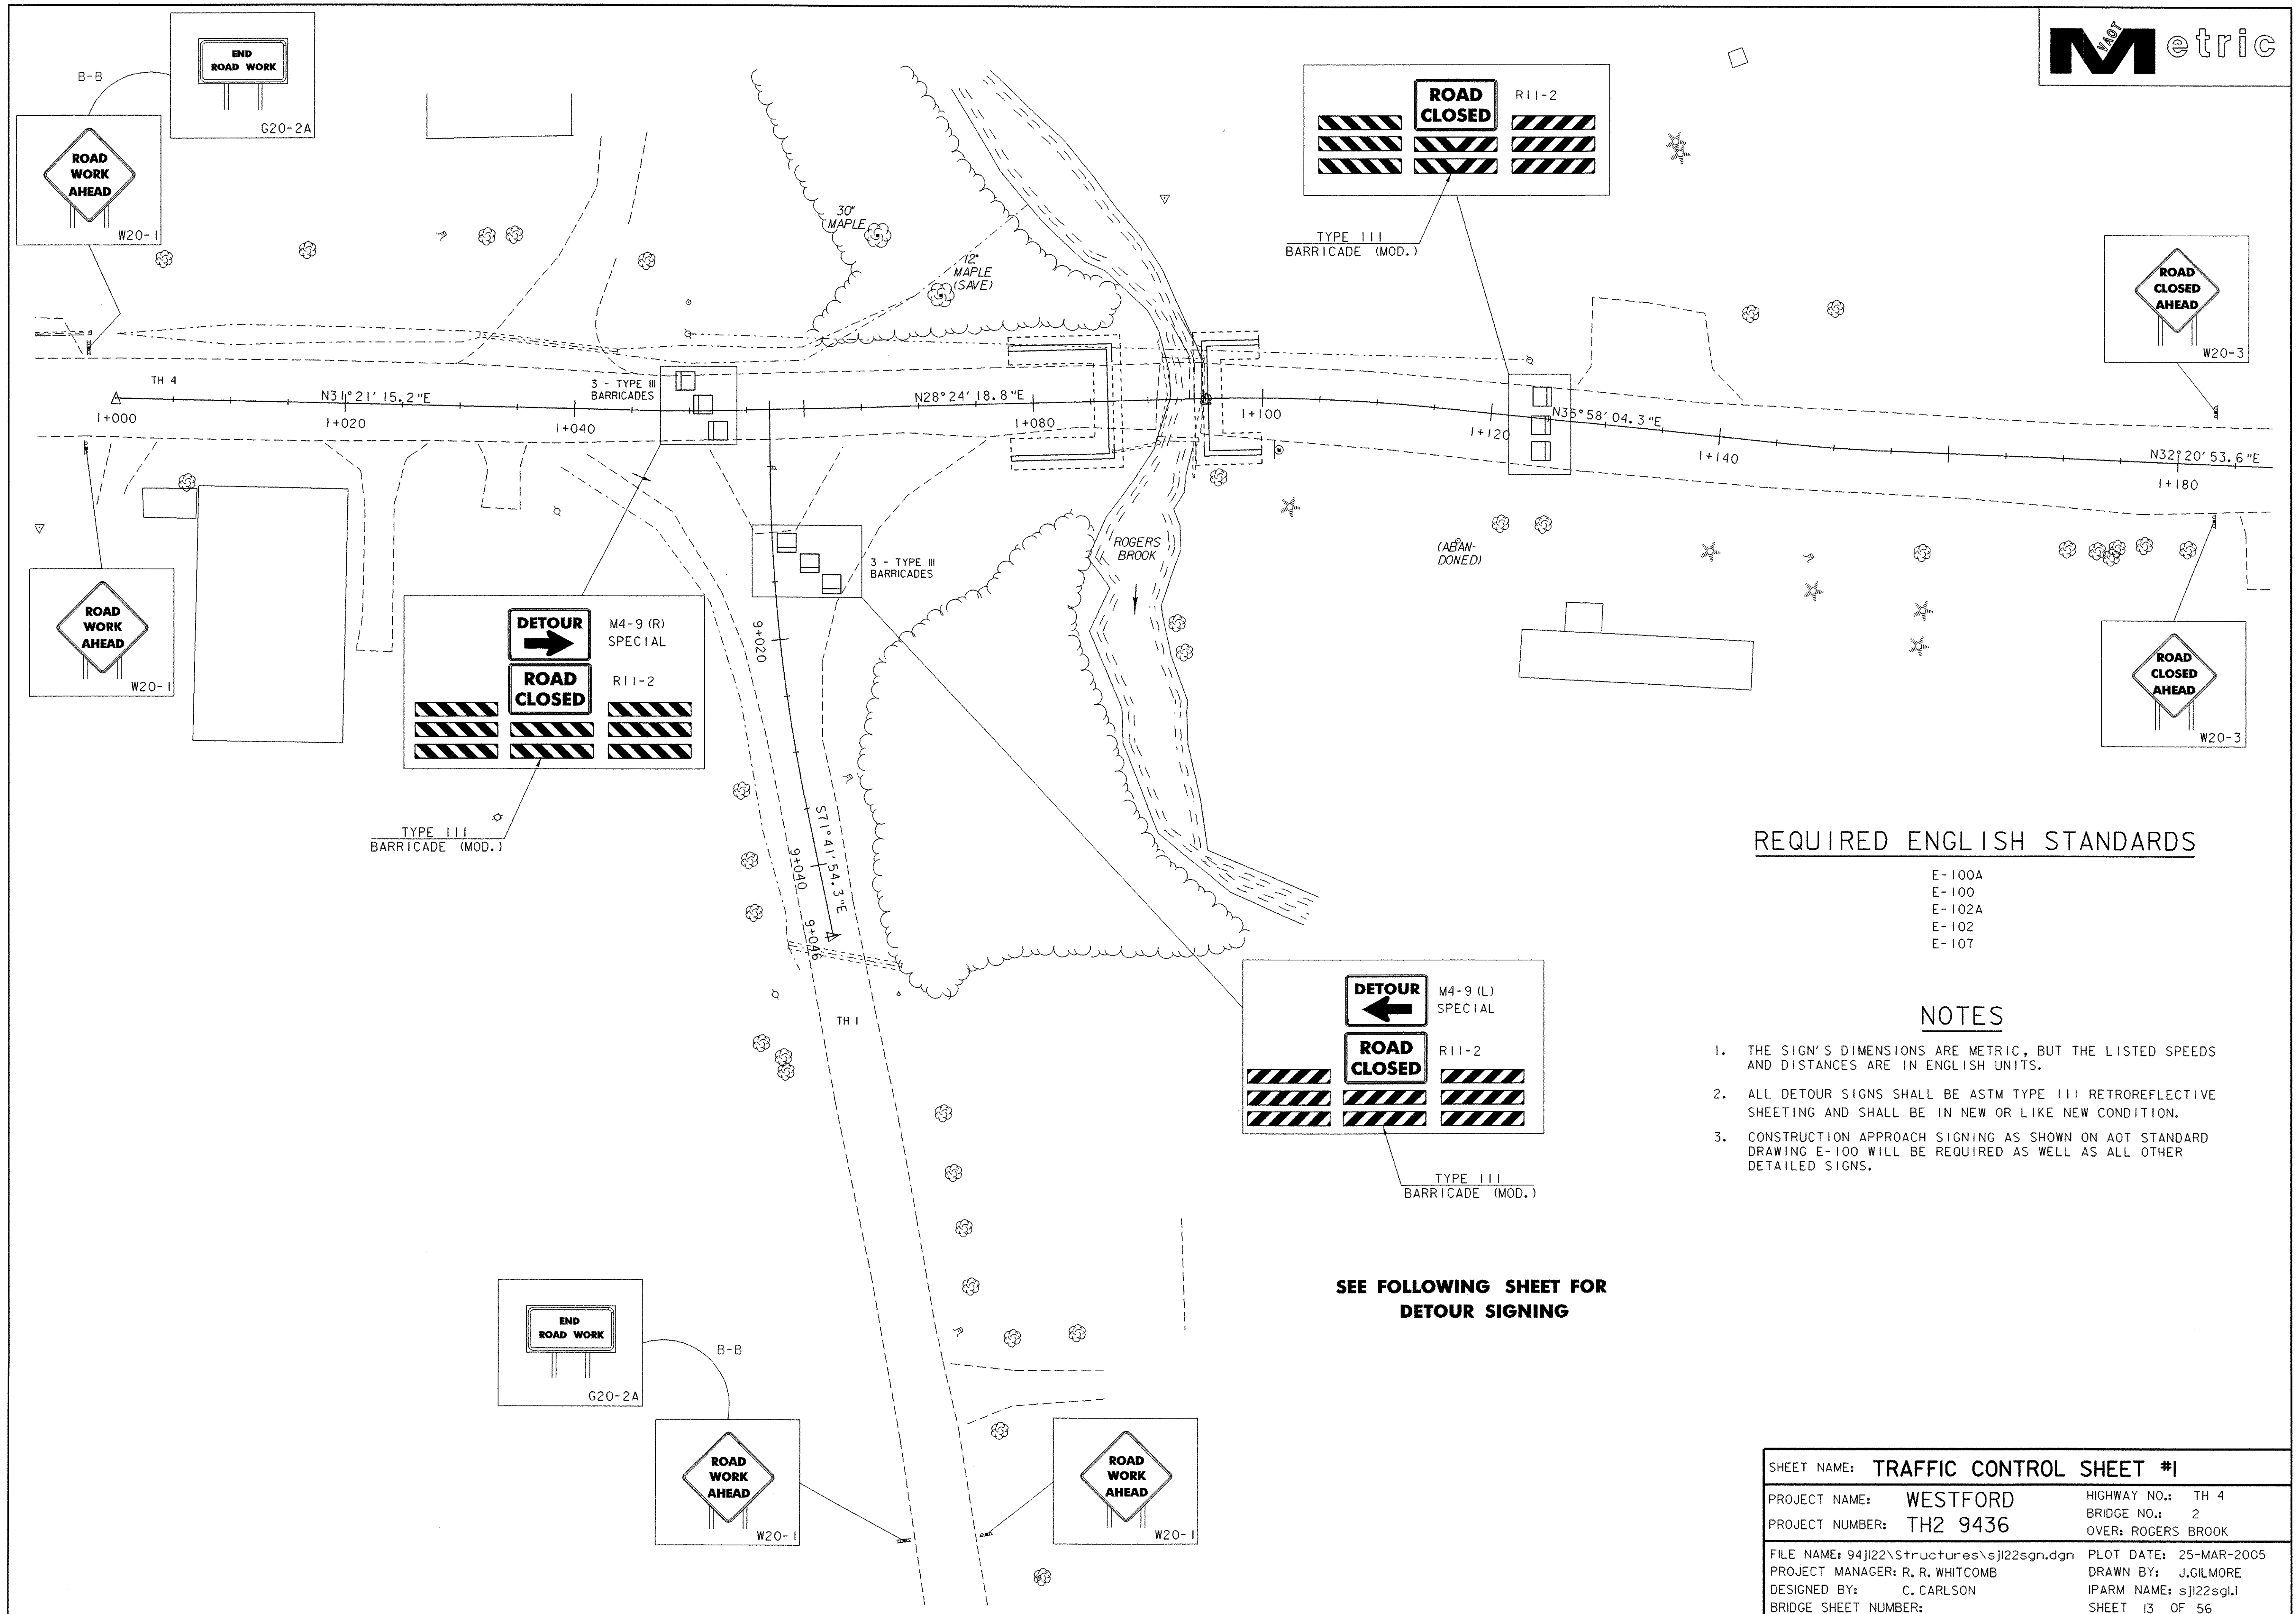

REQUIRED ENGLISH STANDARDS


- E-100A
- E-100
- E-102A
- E-102
- E-107

NOTES

1. THE SIGN'S DIMENSIONS ARE METRIC, BUT THE LISTED SPEEDS AND DISTANCES ARE IN ENGLISH UNITS.
2. ALL DETOUR SIGNS SHALL BE ASTM TYPE III RETROREFLECTIVE SHEETING AND SHALL BE IN NEW OR LIKE NEW CONDITION.
3. CONSTRUCTION APPROACH SIGNING AS SHOWN ON AOT STANDARD DRAWING E-100 WILL BE REQUIRED AS WELL AS ALL OTHER DETAILED SIGNS.


**SEE FOLLOWING SHEET FOR
DETOUR SIGNING**

SHEET NAME: TRAFFIC CONTROL SHEET #1	
PROJECT NAME: WESTFORD	HIGHWAY NO.: TH 4
PROJECT NUMBER: TH2 9436	BRIDGE NO.: 2
	OVER: ROGERS BROOK
FILE NAME: 94J122\Structures\sj122sqn.dgn	PLOT DATE: 25-MAR-2005
PROJECT MANAGER: R. R. WHITCOMB	DRAWN BY: J. GILMORE
DESIGNED BY: C. CARLSON	IPARM NAME: sj122sgl.l
BRIDGE SHEET NUMBER:	SHEET 13 OF 56

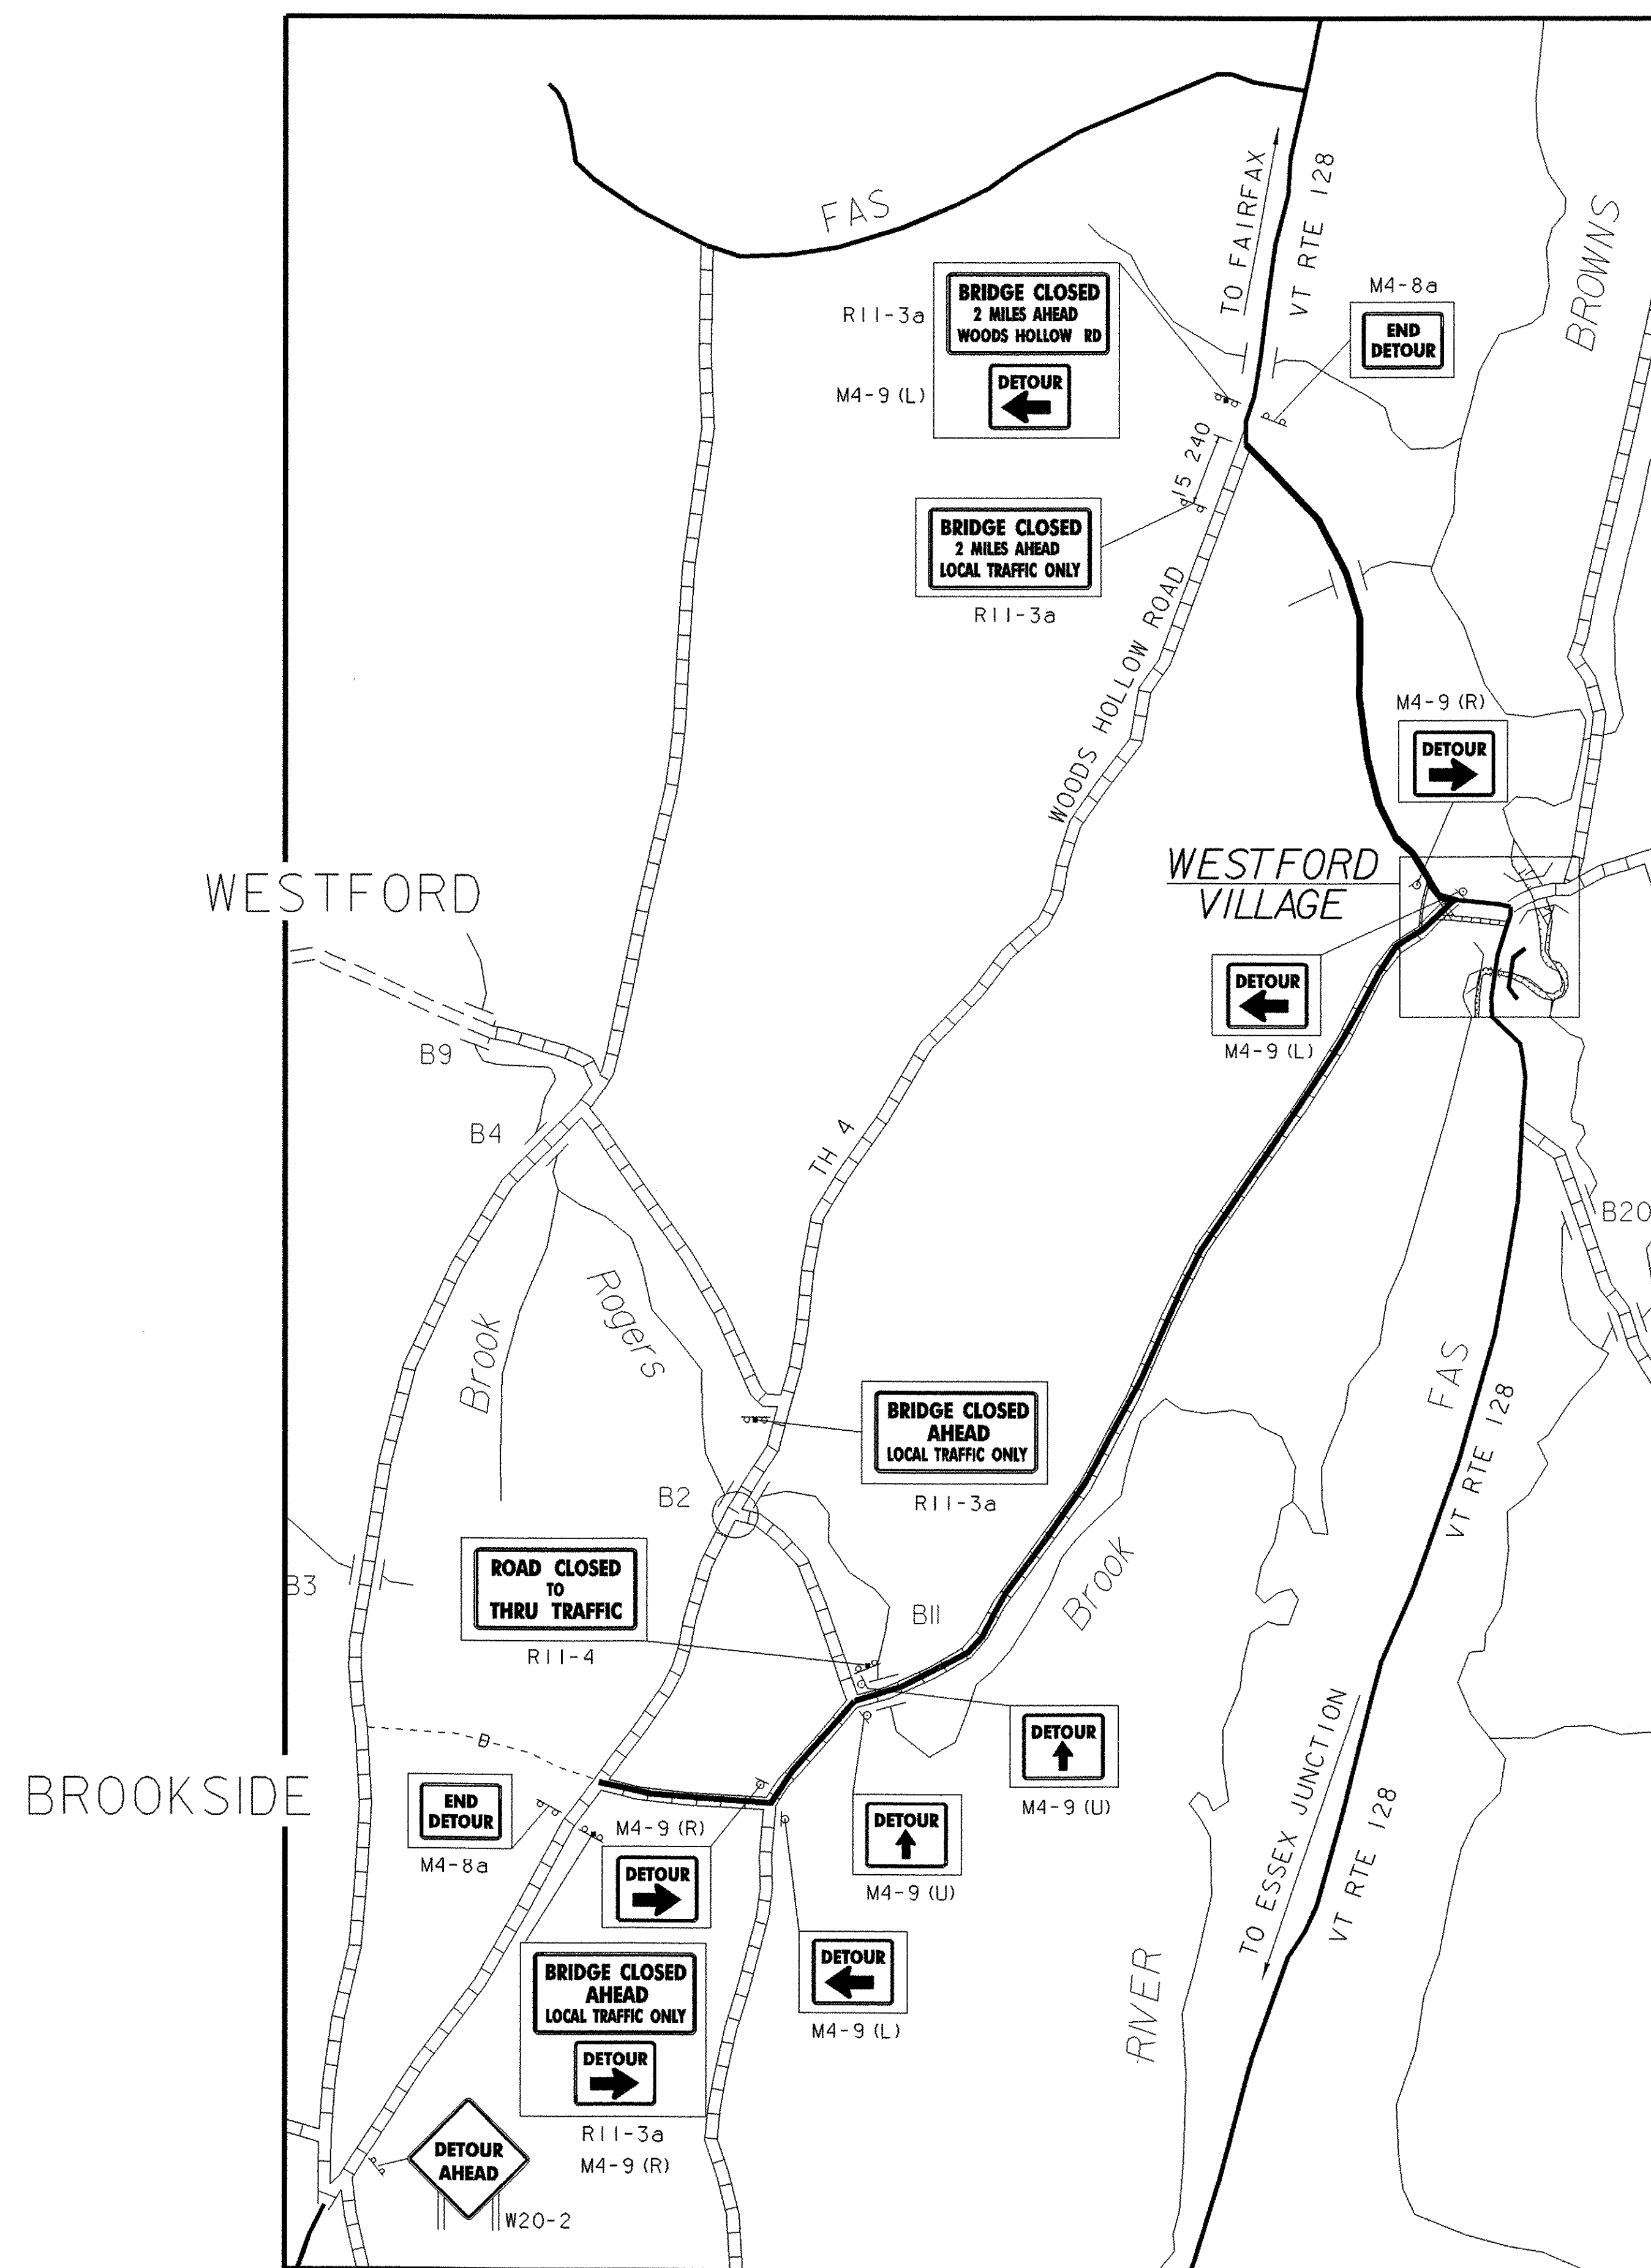


SHEET NAME: TRAFFIC CONTROL SHEET #2	
PROJECT NAME: WESTFORD	HIGHWAY NO.: TH 4
PROJECT NUMBER: TH2 9436	BRIDGE NO.: 2
	OVER: ROGERS BROOK
FILE NAME: 94J122\Structures\sj122sgn.dgn	PLOT DATE: 25-MAR-2005
PROJECT MANAGER: R. R. WHITCOMB	DRAWN BY: J. GILMORE
DESIGNED BY: C. CARLSON	IPARM NAME: sj122sg2.1
BRIDGE SHEET NUMBER:	SHEET 14 OF 56


QUANTITY	SIGN LEGEND	SIGN DIMENSIONS		FLANGED CHANNEL	TOTAL AREA SIGNS	
		WIDTH (mm)	HEIGHT (mm)			
4	(M4-9L)	765	610	3	1.867	
4	(M4-9R)	765	610	3	1.867	
3	(R11-2)	1200	750		2.7	
4	(W20-1)	1200	1200	8	5.76	
2	(G20-2A)	600	450		0.54	
2	(W20-3)	1200	1200	4	2.88	
1	(1525x765)	1525	765	2	1.167	
2	(600x450)	600	450	4	0.54	
1	(1525x765)	1525	765	2	1.167	
2	(1525x765)	1525	765	4	2.33	
1	(1525x765)	1525	765	2	1.167	
2	(M4-9U)	765	610	2	0.933	
1	(W20-2)	1200	1200	2	1.44	
				156	24.358	SUBTOTAL
					0.642	ROUNDING
				156 M	25 SM	TOTAL

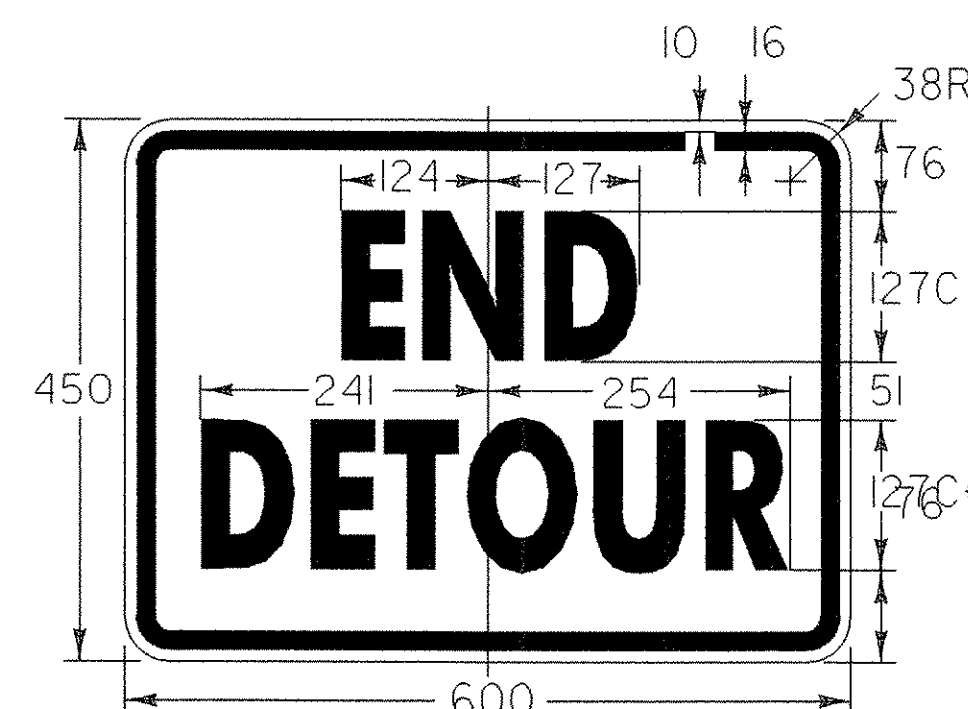


M4-8a
BLACK TEXT & BORDER
WITH ORANGE BACKGROUND
* REDUCE SPACING BY 25%

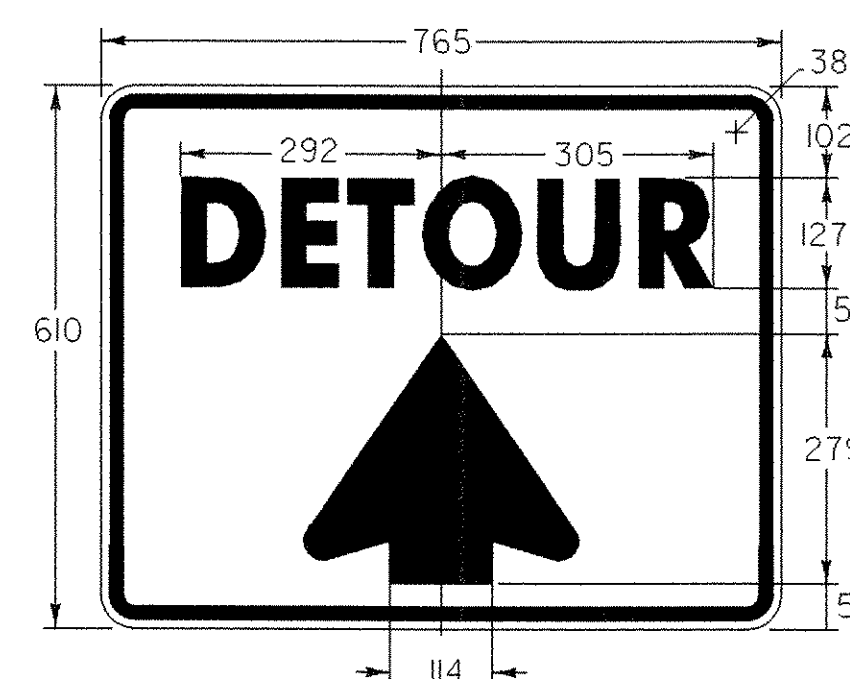

M4-9(U)
BLACK TEXT & BORDER
WITH ORANGE BACKGROUND

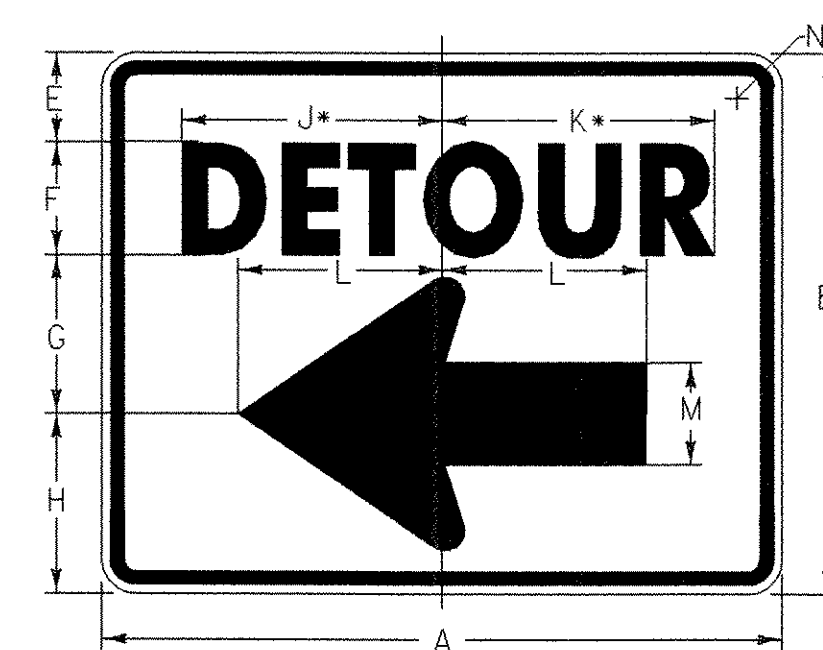



M4-9(L)

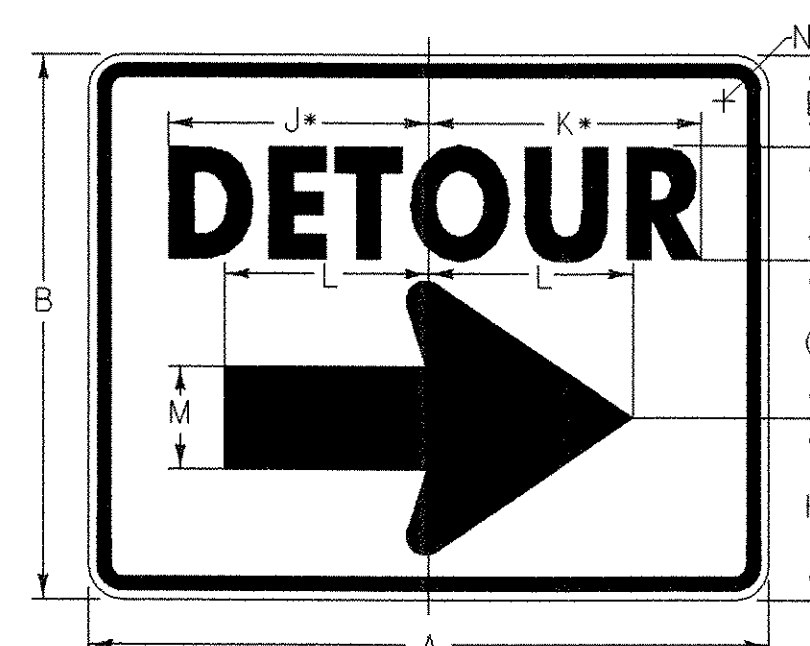

M4-9(R)
BLACK TEXT & BORDER
WITH ORANGE BACKGROUND


SIGN	DIMENSIONS (MM)													
	A	B	C	D	E	F	G	H	J	K	L	M	N	
STD.	765	610	10	15	100	1300	175	205	295	305	230	115	40	
SPECIAL	1220	915	15	25	155	2050	255	305	495	515	345	180	60	
SPECIAL	1525	1220	20	35	202	2550	355	410	585	610	460	230	80	

* REDUCE SPACING 40%

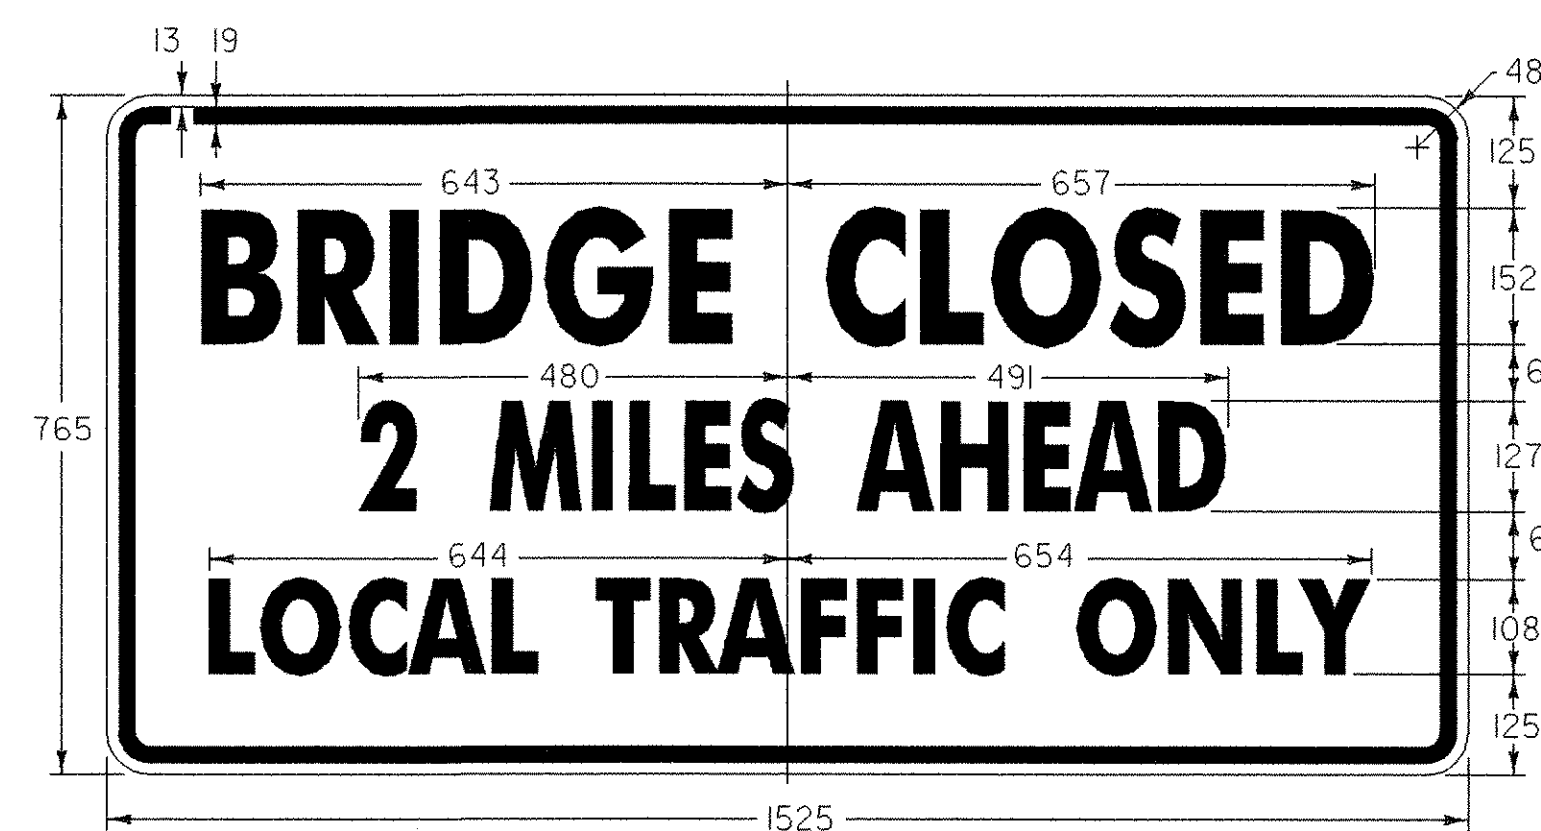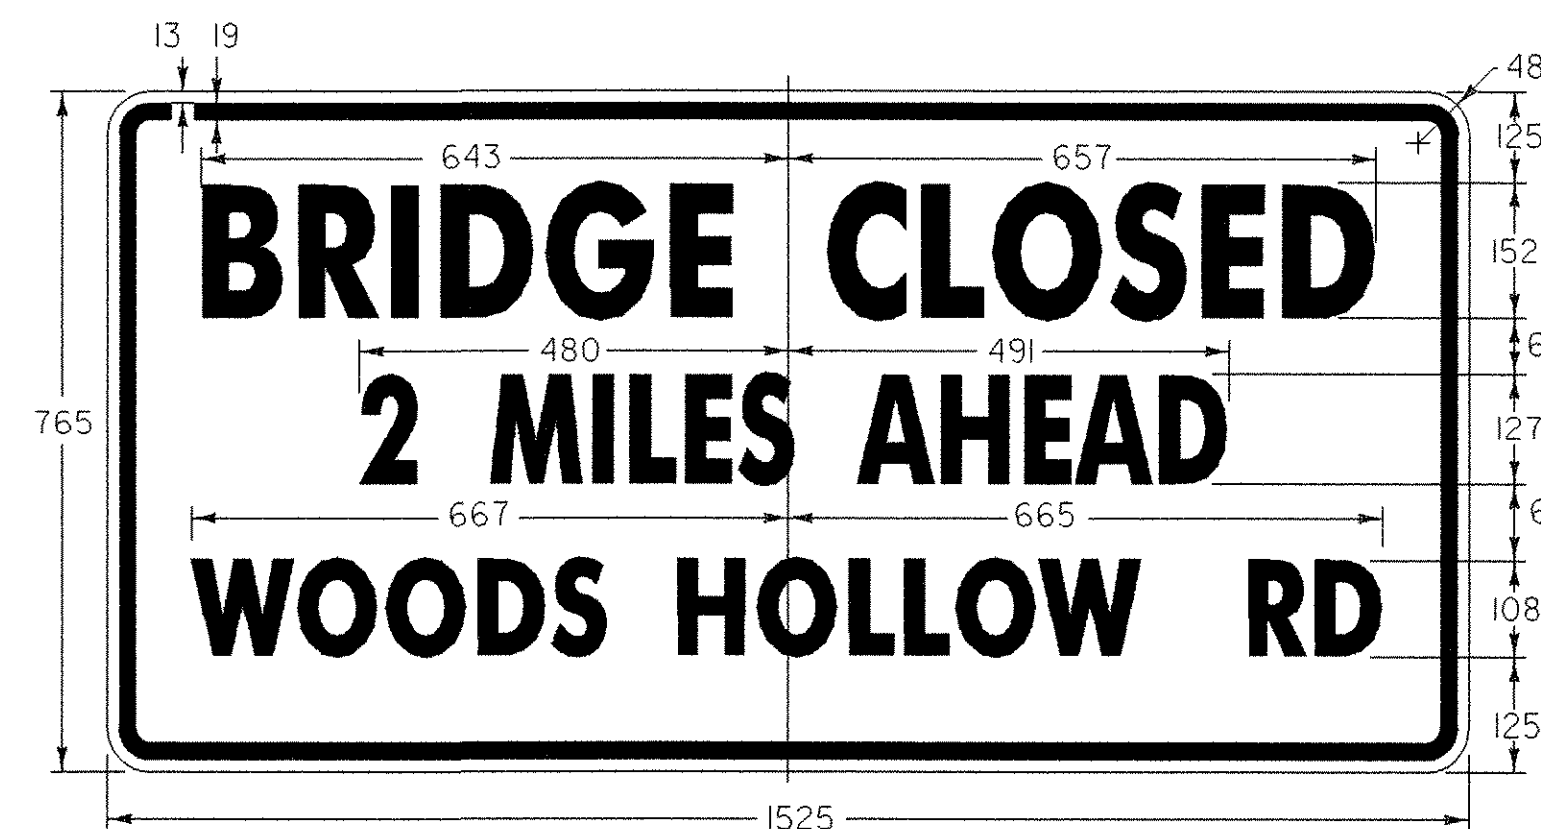

NOTE: ALL SIGNS ARE TO HAVE BLACK TEXT AND BORDER WITH ORANGE BACKGROUND

SHEET NAME: TRAFFIC CONTROL SIGN SUMMARY SHEET			
PROJECT NAME: WESTFORD	HIGHWAY NO.: TH 4		
PROJECT NUMBER: TH2 9436	BRIDGE NO.: 2	OVER: ROGERS BROOK	
FILE NAME: 94J122\Structures\sj122sgn.dgn	PLOT DATE: 25-MAR-2005		
PROJECT MANAGER: R. R. WHITCOMB	DRAWN BY: STR 1		
DESIGNED BY: C. CARLSON	IPARM NAME: sj122+c3.1		
BRIDGE SHEET NUMBER:	SHEET 15 OF 56		

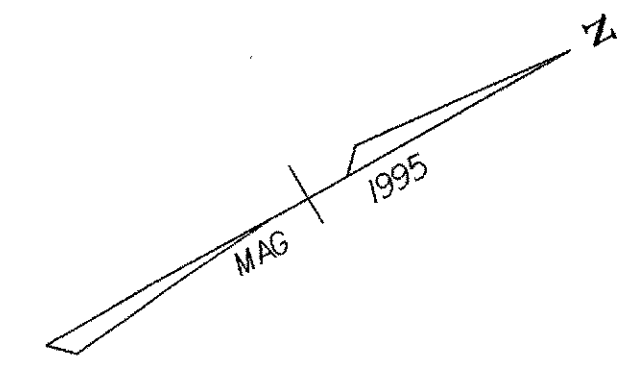

SOIL CLASSIFICATION

AASHTO

A1	Gravel and Sand
A3	Fine Sand
A2	Silty or Clayey Gravel and Sand
A4	Silty Soil - Low Compressibility
A5	Silty Soil - Highly Compressible
A6	Clayey Soil - Low Compressibility
A7	Clayey Soil - Highly Compressible

ROCK QUALITY DESIGNATION

R.Q.D. (%)	ROCK DESCRIPTION
<25	Very Poor
25 to 50	Poor
51 to 75	Fair
76 to 90	Good
>90	Excellent

SHEAR STRENGTH

UNDRAINED SHEAR STRENGTH IN kPa	CONSISTENCY
<12	Very Soft
12-24	Soft
24-48	Med. Stiff
48-96	Stiff
96-192	Very Stiff
>192	Hard

CORRELATION GUIDE OF "N" TO DENSITY/CONSISTENCY


DENSITY (GRANULAR SOILS)		CONSISTENCY (COHESIVE SOILS)	
N	DESCRIPTIVE TERM	N	DESCRIPTIVE TERM
<5	Very Loose	<2	Very Soft
5-10	Loose	2-4	Soft
11-24	Med. Dense	5-8	Med. Stiff
25-50	Dense	9-15	Stiff
>50	Very Dense	16-30	Very Stiff
		31-60	Hard
		>60	Very Hard

COMMONLY USED SYMBOLS


- ▼ Water Elevation
- ⊕ Standard Penetration Boring
- ⊕ Auger Boring
- ⊕ Rod Sounding
- S Sample
- N Standard Penetration Test
- Blow Count Per 300 mm For:
- 50.8 mm O.D. Sampler
- 35.0 mm I.D. Sampler
- Hammer Weight Of 63.5 kg.
- Hammer Fall Of 762 mm
- VS Field Vane Shear Test
- US Undisturbed Soil Sample
- B Blast
- DC Diamond Core
- MD Mud Drill
- WA Wash Ahead
- HSA Hollow Stem Auger
- AX Core Size 30.1mm
- BX Core Size 42.0 mm
- NX Core Size 54.7 mm
- M Double Tube Core Barrel Used
- LL Liquid Limit
- PL Plastic Limit
- PI Plasticity Index
- NP Non Plastic
- w Moisture Content (Dry Wgt. Basis)
- D Dry
- M Moist
- MTW Moist To Wet
- W Wet
- Sat Saturated
- Bo Boulder
- Gr Gravel
- Sa Sand
- Sl Silt
- Cl Clay
- HP Hardpan
- Le Ledge
- NLTD No Ledge To Depth
- CNPF Can Not Penetrate Further
- TLOB To Ledge Or Boulder
- NR No Recovery
- Rec. Recovery
- %Rec. Percent Recovery
- ROD Rock Quality Designation
- CBR California Bearing Ratio
- < Less Than
- > Greater Than
- R Refusal (N > 100)

COLOR

blk	Black	pnk	Pink
bl	Blue	pu	Purple
brn	Brown	rd	Red
dk	Dark	tn	Tan
gry	Gray	wh	White
gn	Green	yel	Yellow
lt	Light	mltc	Multicolored
or	Orange		

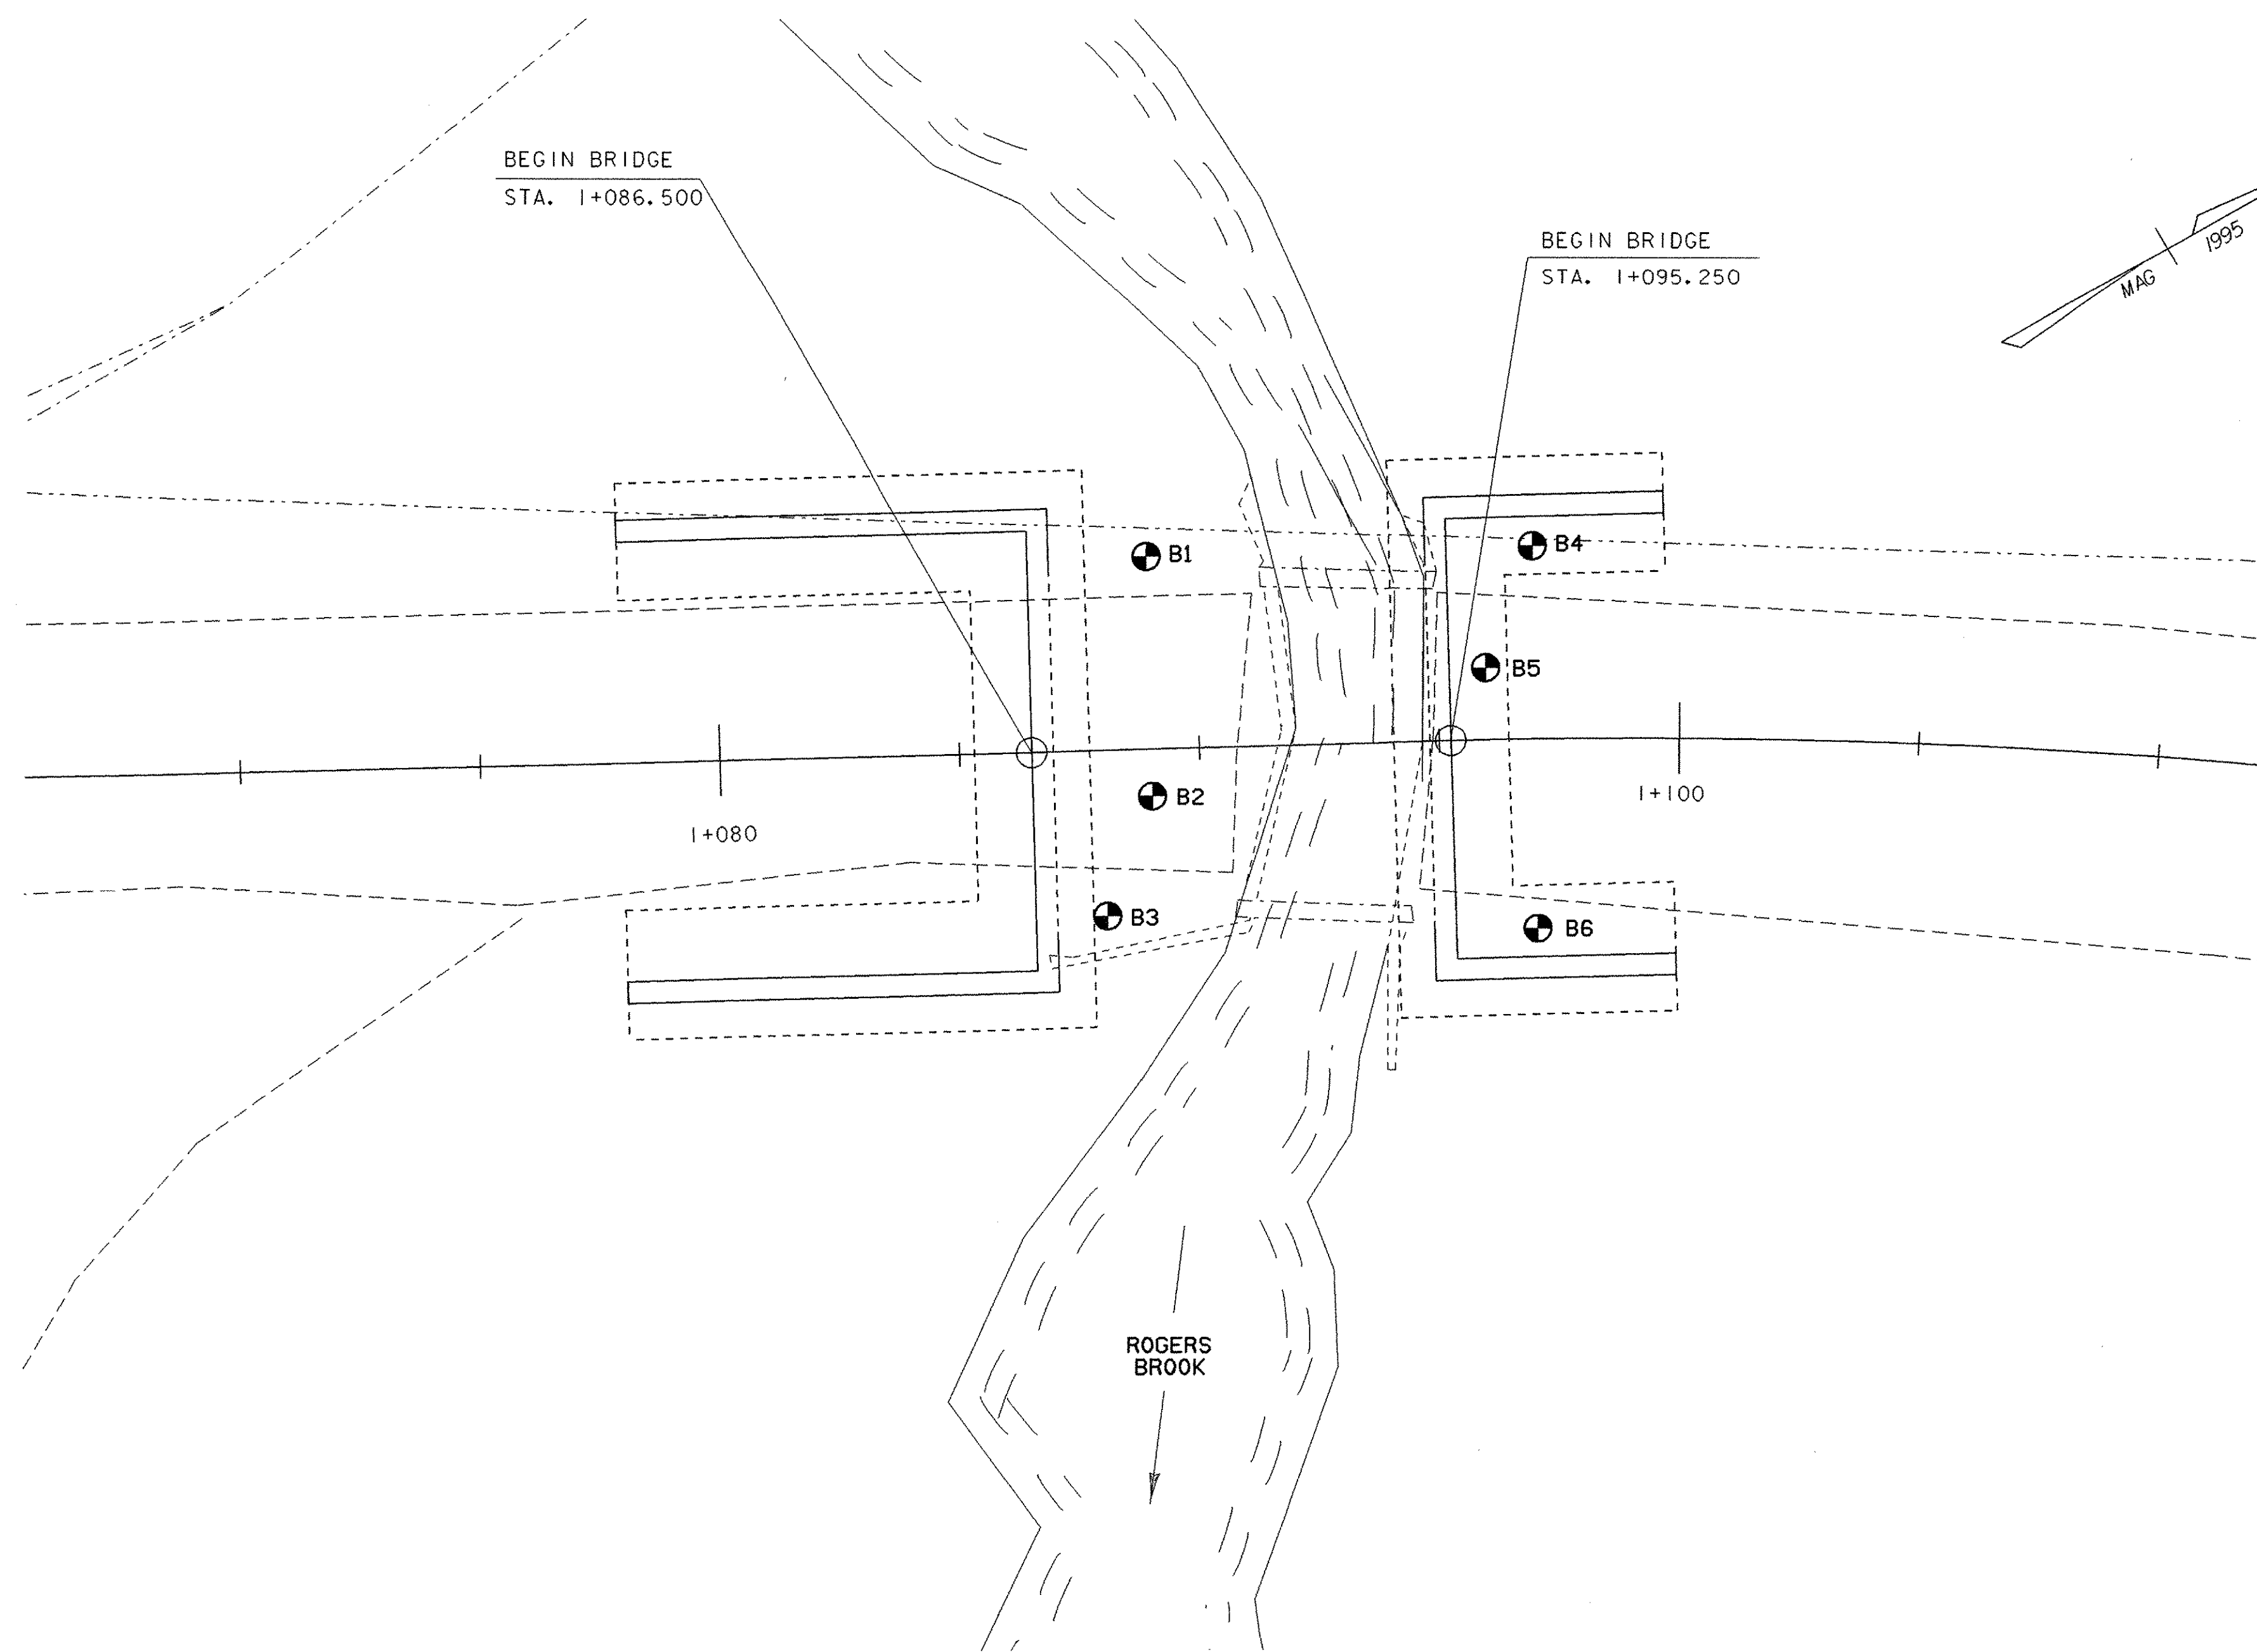

BORING LAYOUT

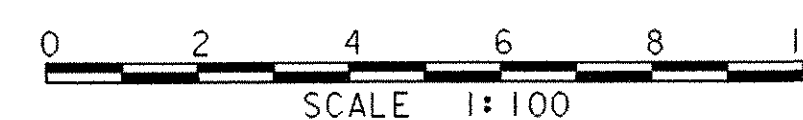

BORING CHART

HOLE NO.	STATION	OFFSET (m)	GROUND ELEV.	TLOB
B1	1+089 LT	4.0	173.098	169.37
B2	1+089 RT	1.0	172.964	169.04
B3	1+088 RT	3.5	172.948	167.76
B4	1+097 LT	4.0	171.635	169.27
B5	1+096 LT	1.5	172.561	169.05
B6	1+097 RT	4.0	172.062	169.06

DEFINITIONS (AASHTO)

- BEDROCK (LEDGE)** - Rock in its native location of indefinite thickness.
- BOULDER** - A rock fragment with an average dimension > 304.8 mm.
- COBBLE** - Rock fragments with an average dimension between 76.2 and 304.8 mm.
- GRAVEL** - Rounded particles of rock < 76.2 mm and > 2 mm (#10 sieve).
- SAND** - Particles of rock < 2 mm (#10 sieve) and > 75 μm (#200 sieve).
- SILT** - Soil < 75 μm (#200 sieve), non or slightly plastic and exhibits no strength when air-dried.
- CLAY** - Fine grained soil, exhibits plasticity when moist and considerable strength when air-dried.

- VARVED** - Alternate layers of silt and clay.
- HARDPAN** - Extremely dense soil, cemented layer, not softened when wet.
- MUCK** - Soft organic soil (containing > 10% organic material).
- MOISTURE CONTENT** - Weight of water divided by dry weight of soil.
- FLOWING SAND** - Granular soil so saturated (loose) that it flows into drill casing during extraction of wash rod.
- STRIKE** - Angle from magnetic north to line of intersection of bed with a horizontal plane.
- DIP** - Inclination of bed with a horizontal plane.

GENERAL NOTES

- The subsurface explorations shown herein were made between 04/21/99 and 04/28/99 by the Agency.
- Soil and rock classifications, properties and descriptions are based on engineering interpretation from available subsurface information by the Agency and may not necessarily reflect actual variations in subsurface conditions that may be encountered between individual boring or sample locations.
- Observed water levels and/or conditions indicated are as recorded at the time of exploration and may vary according to the prevailing rainfall, methods of exploration and other factors.
- Engineering judgement was exercised in preparing the subsurface information presented herein. Analysis and interpretation of subsurface data was performed and interpreted for Agency design and estimating purposes. Presentation of the information in the Contract is intended to provide the Contractor access to the same data available to the Agency. The subsurface information is presented in good faith and is not intended as a substitute for personal investigation, independent interpretation, independent analysis or judgement by the Contractor.
- Pictorial structure details shown on the boring plan layout or soils profile are for illustrative purposes only and may not accurately portray final contract details.
- Terminology used on boring logs to describe the hardness, degree of weathering, and spacing of fractures, joints and other discontinuities in the bedrock is defined in the AASHTO Manual on Subsurface Investigations, 1988.

SHEET NAME: BORING LAYOUT SHEET

PROJECT NAME: WESTFORD	HIGHWAY NO.: TH 4
PROJECT NUMBER: TH2 9436	BRIDGE NO.: 2
	OVER: ROGERS BROOK
FILE NAME: 94J22\Structures\sj22bor.dgn	PLOT DATE: 25-MAR-2005
PROJECT MANAGER: R. R. WHITCOMB	DRAWN BY: STRI
DESIGNED BY: C. CARLSON	IPARM NAME: sj22bor.1
BRIDGE SHEET NUMBER:	SHEET 16 OF 56



STATE OF VERMONT AGENCY OF TRANSPORTATION MATERIALS & RESEARCH DIVISION SUBSURFACE INFORMATION		HOLE NO.: B1 SHEET 1 OF 1 DATE STARTED: 4/27/99 DATE COMPLETED: 4/27/99							
PROJECT NAME: WESTFORD SITE NAME: BR #2 STATION: I+089.00 GROUND EL.: 173.098		PROJECT NUMBER: TH3-9436 SITE NO.: TH #7 (NOW TH #4) OFFSET: -3.00 G.W. DEPTH:							
BORING CREW CREW CHIEF: MCGLYNN DRILLER: MCGLYNN LOGGER: CHABOT ADDITIONAL CREW: YOUNG		BORING RIG: SKID RIG BORING TYPE: WASH BORE SAMPLE TYPE: SPLIT BARREL							
DEPTH	SYMBOL	CLASSIFICATION OF MATERIALS (Description)	BLOWS PER 0.3 m	M.C. %	GRAVEL %	SAND %	FINES %	LL	PI
		A-2-4, SiGrSa, W, brn, rec. = 0.18m	5	14.2	35.1	41.8	23.1		
		A-2-4, SiSa, M, brn, rec. = 0.20m Trace of Organics (wood)	6	25.5	16.4	56.3	27.3		
		RUN#1: BXMDC 3.73m-4.80m rec. = 0.46m See Geologist's Report							
		RUN#2: BXMDC 4.80m-6.02m rec. = 1.09m See Geologist's Report							
		RUN#3: BXMDC 6.02m-6.66m rec. = 0.29m See Geologist's Report							
Hole Stopped @ 6.66m									
GEOLOGISTS REPORT:									
Run #1: Gray, metagraywacke. Moderately hard. Moderately weathered. Poor competency.									
Run #2: Gray, metagraywacke. Moderately hard. Unweathered. Fair competency.									
Run #3: Gray phyllite with quartz veins. Unweathered. Fair competency.									

STATE OF VERMONT AGENCY OF TRANSPORTATION MATERIALS & RESEARCH DIVISION SUBSURFACE INFORMATION		HOLE NO.: B2 SHEET 1 OF 1 DATE STARTED: 4/23/99 DATE COMPLETED: 4/23/99							
PROJECT NAME: WESTFORD SITE NAME: BR #2 STATION: I+089.00 GROUND EL.: 172.964		PROJECT NUMBER: TH3-9436 SITE NO.: TH #7 (NOW TH #4) OFFSET: 1.00 G.W. DEPTH:							
BORING CREW CREW CHIEF: MCGLYNN DRILLER: MCGLYNN LOGGER: CHABOT ADDITIONAL CREW: YOUNG		BORING RIG: SKID RIG BORING TYPE: WASH BORE SAMPLE TYPE: SPLIT BARREL							
DEPTH	SYMBOL	CLASSIFICATION OF MATERIALS (Description)	BLOWS PER 0.3 m	M.C. %	GRAVEL %	SAND %	FINES %	LL	PI
		A-2-4, GrSiSa, MTW, brn rec. = 0.45m	9	17.8	20.3	53.1	26.6		
		A-1-b, SaGr, W, brn, rec. = 0.27m	12	16.5	41	33.8	25.2		
		BXMDC 3.72m-3.92m, Boulders							
		RUN#1: BXMDC 4.17m-5.69m rec. = 0.54m See Geologist's Report							
		RUN#2: BXMDC 5.69m-6.63m rec. = 0.73m See Geologist's Report							
		RUN#3: BXMDC 6.63m-7.23m rec. = 0.60m. See Geologist's Report							
Hole Stopped @ 7.23m									
GEOLOGISTS REPORT:									
Run #1: Gray, metagraywacke with quartz veins. Moderately hard. unweathered. Poor recovery. Drillers reported that drilling breaks were encountered. Poor competency.									
Run #2: Gray, metagraywacke with quartz veins. Moderately hard. unweathered. Competent.									
Run #3: Same as Run #2.									


STATE OF VERMONT AGENCY OF TRANSPORTATION MATERIALS & RESEARCH DIVISION SUBSURFACE INFORMATION		HOLE NO.: B3 SHEET 1 OF 1 DATE STARTED: 4/28/99 DATE COMPLETED: 4/28/99							
PROJECT NAME: WESTFORD SITE NAME: BR #2 STATION: I+089.00 GROUND EL.: 172.948		PROJECT NUMBER: TH3-9436 SITE NO.: TH #7 (NOW TH #4) OFFSET: 3.00 G.W. DEPTH:							
BORING CREW CREW CHIEF: MCGLYNN DRILLER: MCGLYNN LOGGER: CHABOT ADDITIONAL CREW: YOUNG		BORING RIG: SKID RIG BORING TYPE: WASH BORE SAMPLE TYPE: SPLIT BARREL							
DEPTH	SYMBOL	CLASSIFICATION OF MATERIALS (Description)	BLOWS PER 0.3 m	M.C. %	GRAVEL %	SAND %	FINES %	LL	PI
		A-1-a, SaGr, W, brn, rec. = 0.15m	9	17.8	20.3	53.1	26.6		
		No Sample, Boulders	12	16.5	41	33.8	25.2		
		RUN#1: BXMDC 5.18m-5.63m, rec. = 0.39m							
		RUN#2: BXMDC 5.63m-6.83m rec. = 0.50m. See Geologist's Report							
		RUN#3: BXMDC 6.83m-8.03m rec. = 0.70m. See Geologist's Report							
Hole Stopped @ 8.03m									
GEOLOGISTS REPORT:									
Run #1: Gray, metagraywacke. Moderately hard. Unweathered. Competent.									
Run #2: Gray, metagraywacke. Moderately hard. Unweathered. Fair to poor recovery. Fair to poor competency.									
Run #3: Gray, metagraywacke. Moderately hard. Unweathered. Fair competency.									

SHEET NAME: BORING LOG SHEET #1	
PROJECT NAME: WESTFORD	HIGHWAY NO.: TH 4
PROJECT NUMBER: TH2 9436	BRIDGE NO.: 2
	OVER: ROGERS BROOK
FILE NAME: 94J122\Structures\sj122bor.dgn	PLOT DATE: 25-MAR-2005
PROJECT MANAGER: R. R. WHITCOMB	DRAWN BY: C. ALLEN
DESIGNED BY: C. CARLSON	IPARM NAME: sj122br1.f
BRIDGE SHEET NUMBER:	SHEET 17 OF 56

STATE OF VERMONT AGENCY OF TRANSPORTATION MATERIALS & RESEARCH DIVISION SUBSURFACE INFORMATION		HOLE NO.: B4 SHEET 1 OF 1 DATE STARTED: 4/26/99 DATE COMPLETED: 4/26/99							
PROJECT NAME: WESTFORD SITE NAME: BR #2 STATION: I+097.00 GROUND EL.: 171.635		PROJECT NUMBER: TH3-9436 SITE NO.: TH #7 (NOW TH #4) OFFSET: -5.00 G.W. DEPTH:							
BORING CREW CREW CHIEF: MCGLYNN DRILLER: MCGLYNN LOGGER: CHABOT ADDITIONAL CREW: YOUNG		BORING RIG: SKID RIG BORING TYPE: WASH BORE SAMPLE TYPE: SPLIT BARREL							
DEPTH	SYMBOL	CLASSIFICATION OF MATERIALS (Description)	BLOWS PER 0.3 m	M.C. %	GRAVEL %	SAND %	FINES %	LL	PI
		1.50m-1.58m: A-8, Organic (28.6%) Silt, W, brn, rec.=0.08m.		127.8					
		A-1-a, SaGr, W, brn, rec.=0.32m.	R	10.6	60.9	29.4	9.7		
		Top of Bedrock @ 2.36m							
		RUN#1: BXMDC 2.36m-3.12m rec.=0.70m See Geologist's Report.							
		RUN#2: BXMDC 3.12m-4.03m rec.=0.85m See Geologist's Report.							
		RUN#3: BXMDC 4.03m-4.23m, rec.=0.15m							
		RUN#4: BXMDC 4.23m-4.38m, rec.=0.13m							
		RUN#5: BXMDC 4.38m-5.59m rec.=1.14m See Geologist's Report.							
Hole Stopped @ 5.59m									
GEOLOGISTS REPORT:									
Run #1: Gray, metagraywacke. Moderately hard. Unweathered. Competent.									
Run #2: Same as Run #1.									
Run #3: Same as Run #1.									
Run #4: Same as Run #1.									
Run #5: 4.38m-5.02m, Gray phyllite. Medium hard. Unweathered. Competent. 5.02m-5.59m, Gray, metagraywacke. Moderately hard. Unweathered. Competent.									



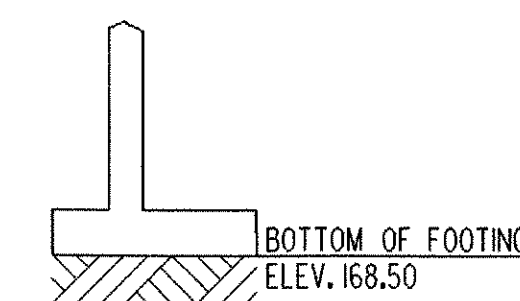
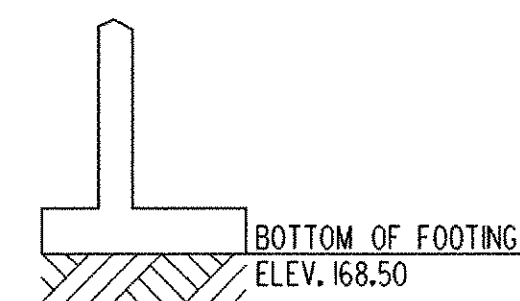


STATE OF VERMONT AGENCY OF TRANSPORTATION MATERIALS & RESEARCH DIVISION SUBSURFACE INFORMATION		HOLE NO.: B5 SHEET 1 OF 1 DATE STARTED: 4/21/99 DATE COMPLETED: 4/21/99							
PROJECT NAME: WESTFORD SITE NAME: BR #2 STATION: I+096.00 GROUND EL.: 172.561		PROJECT NUMBER: TH3-9436 SITE NO.: TH #7 (NOW TH #4) OFFSET: -1.50 G.W. DEPTH:							
BORING CREW CREW CHIEF: MCGLYNN DRILLER: MCGLYNN LOGGER: CHABOT ADDITIONAL CREW: YOUNG		BORING RIG: SKID RIG BORING TYPE: WASH BORE SAMPLE TYPE: SPLIT BARREL							
DEPTH	SYMBOL	CLASSIFICATION OF MATERIALS (Description)	BLOWS PER 0.3 m	M.C. %	GRAVEL %	SAND %	FINES %	LL	PI
		* - Visual Classification							
		*Broken Rock, rec.=0.10m.	70	2					
		*Broken Rock, rec.=0.20m.	26	2.9					
		*Broken Rock, rec.=0.15m.	R						
		Top of Bedrock @ 3.51m							
		RUN#1: BXMDC 3.51m-4.72m rec.=0.80m. See Geologist's Report							
		RUN#2: BXMDC 4.72m-5.79m rec.=0.97m. See Geologist's Report							
		RUN#3: BXMDC 5.79m-6.86m rec.=0.72m. See Geologist's Report							
Hole Stopped @ 6.86m									
GEOLOGISTS REPORT:									
Run #1: Gray, metagraywacke. Moderately hard. Unweathered. Top 0.7m broken up along quartz lenses. Top 0.7m uncompetent. Remainder of Run is competent.									
Run #2: Gray, metagraywacke. Moderately hard. Unweathered. Competent.									
Run #3: Same as Run #2, but with quartz veins. Competent.									

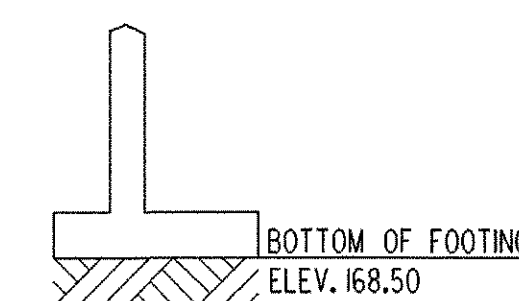

STATE OF VERMONT AGENCY OF TRANSPORTATION MATERIALS & RESEARCH DIVISION SUBSURFACE INFORMATION		HOLE NO.: B6 SHEET 1 OF 1 DATE STARTED: 4/22/99 DATE COMPLETED: 4/22/99							
PROJECT NAME: WESTFORD SITE NAME: BR #2 STATION: I+096.00 GROUND EL.: 172.062		PROJECT NUMBER: TH3-9436 SITE NO.: TH #7 (NOW TH #4) OFFSET: 4.00 G.W. DEPTH:							
BORING CREW CREW CHIEF: MCGLYNN DRILLER: MCGLYNN LOGGER: CHABOT ADDITIONAL CREW: YOUNG		BORING RIG: SKID RIG BORING TYPE: WASH BORE SAMPLE TYPE: SPLIT BARREL							
DEPTH	SYMBOL	CLASSIFICATION OF MATERIALS (Description)	BLOWS PER 0.3 m	M.C. %	GRAVEL %	SAND %	FINES %	LL	PI
		* - Visual Classification							
		*Broken rock, rec.=0.03m	8	7.2					
		Top of Bedrock @ 3.00m							
		RUN#1: BXMDC 3.00m-4.37m rec.=0.87m. See Geologist's Report							
		RUN#2: BXMDC 4.37m-5.89m rec.=1.52m. See Geologist's Report							
		RUN#3: BXMDC 5.89m-6.49m rec.=0.60m. See Geologist's Report							
Hole Stopped @ 6.49m									
GEOLOGISTS REPORT:									
Run #1: 3.0m-3.5m, Gray, phyllite with quartz veins. Medium hard. Unweathered. Fair competency. 3.5m-4.37m, Gray, metagraywacke. Moderately hard. Unweathered. Competent.									
Run #2: 4.37m-5.15m, Gray, metagraywacke. Moderately hard. Unweathered. Competent. 5.15m-5.50m, Gray, phyllite. Medium hard. Unweathered. 5.50m-5.89m, Same as top of run.									
Run #3: Same as top of Run #2. Competent.									

SHEET NAME: BORING LOG SHEET #2	
PROJECT NAME: WESTFORD	HIGHWAY NO.: TH 4
PROJECT NUMBER: TH2 9436	BRIDGE NO.: 2
	OVER: ROGERS BROOK
FILE NAME: 94J22\Structures\sj22bor.dgn	PLOT DATE: 25-MAR-2005
PROJECT MANAGER: R. R. WHITCOMB	DRAWN BY: C. ALLEN
DESIGNED BY: C. CARLSON	IPARM NAME: sj22br2.i
BRIDGE SHEET NUMBER:	SHEET 18 OF 56

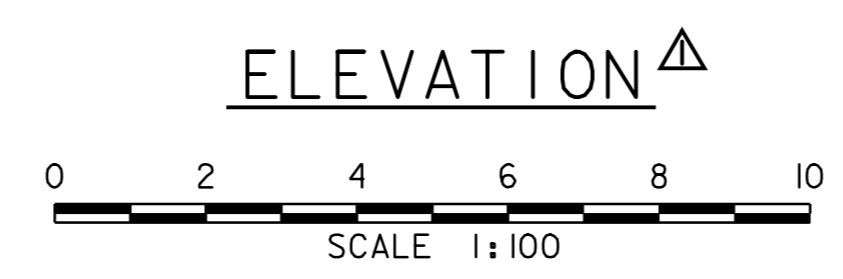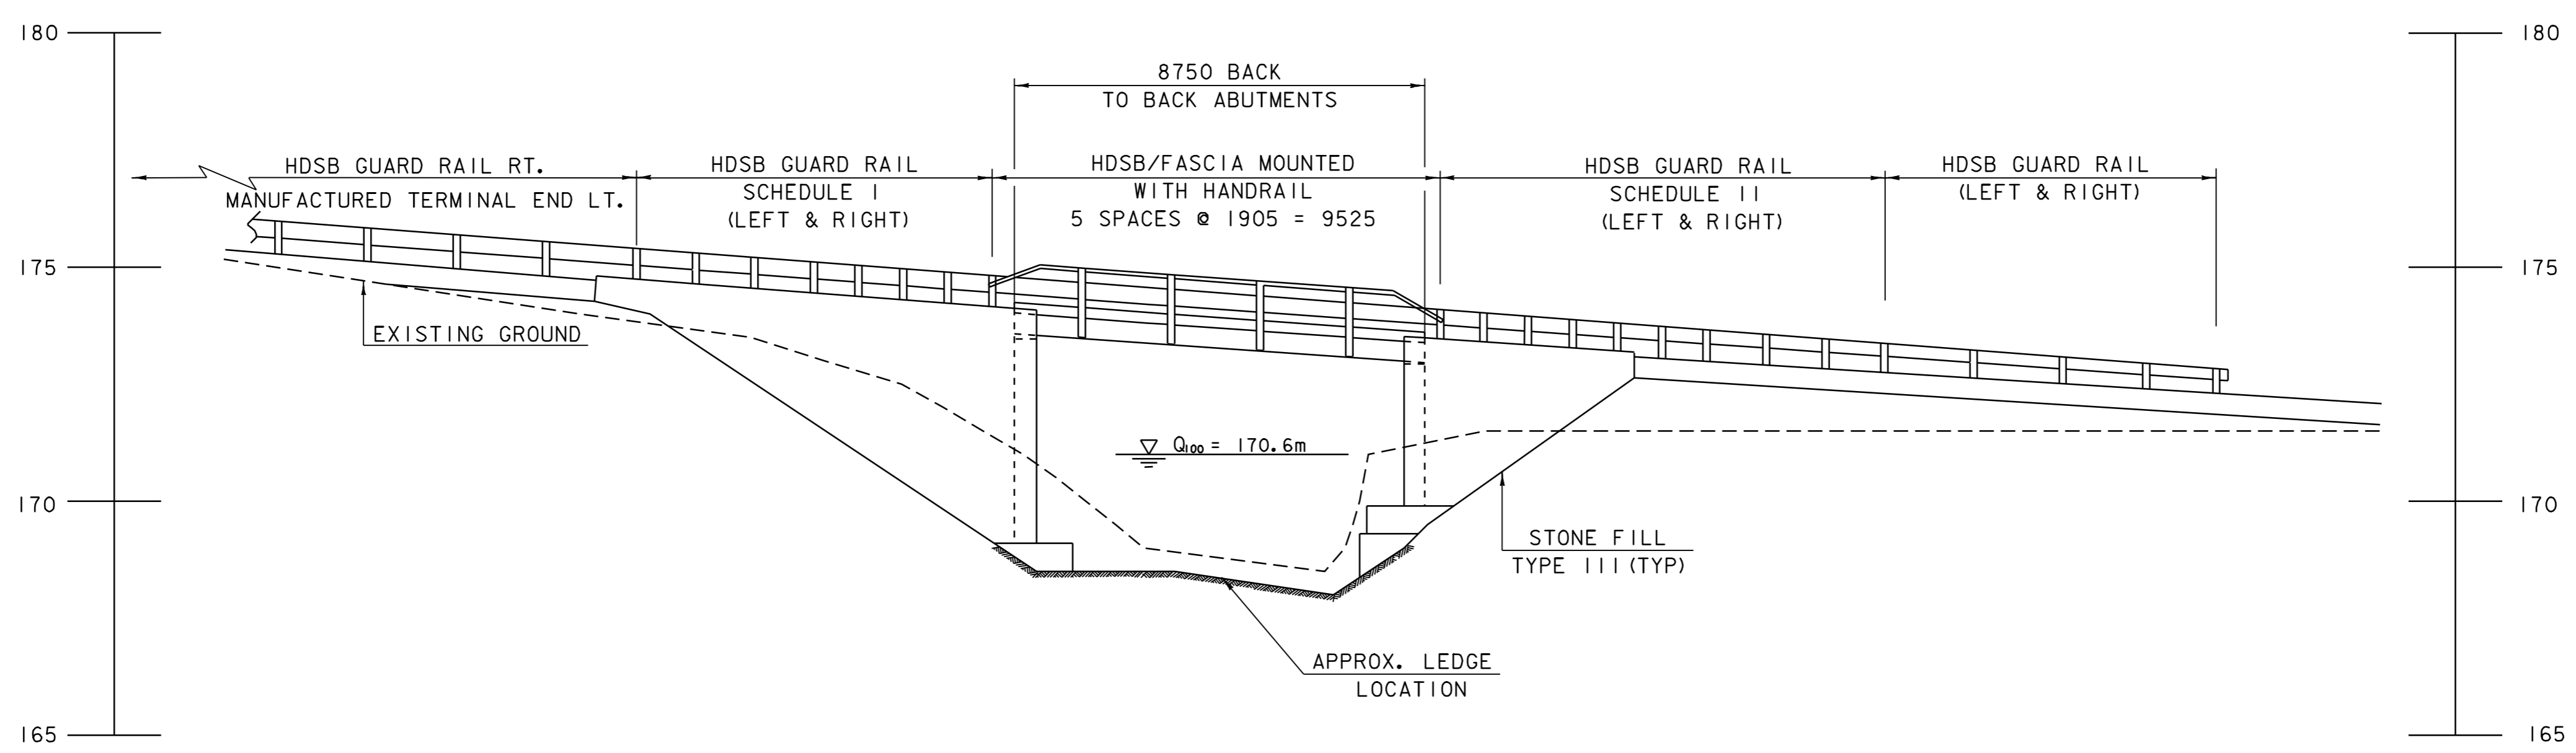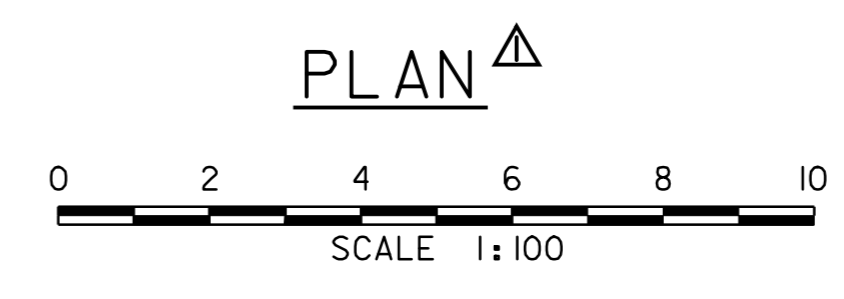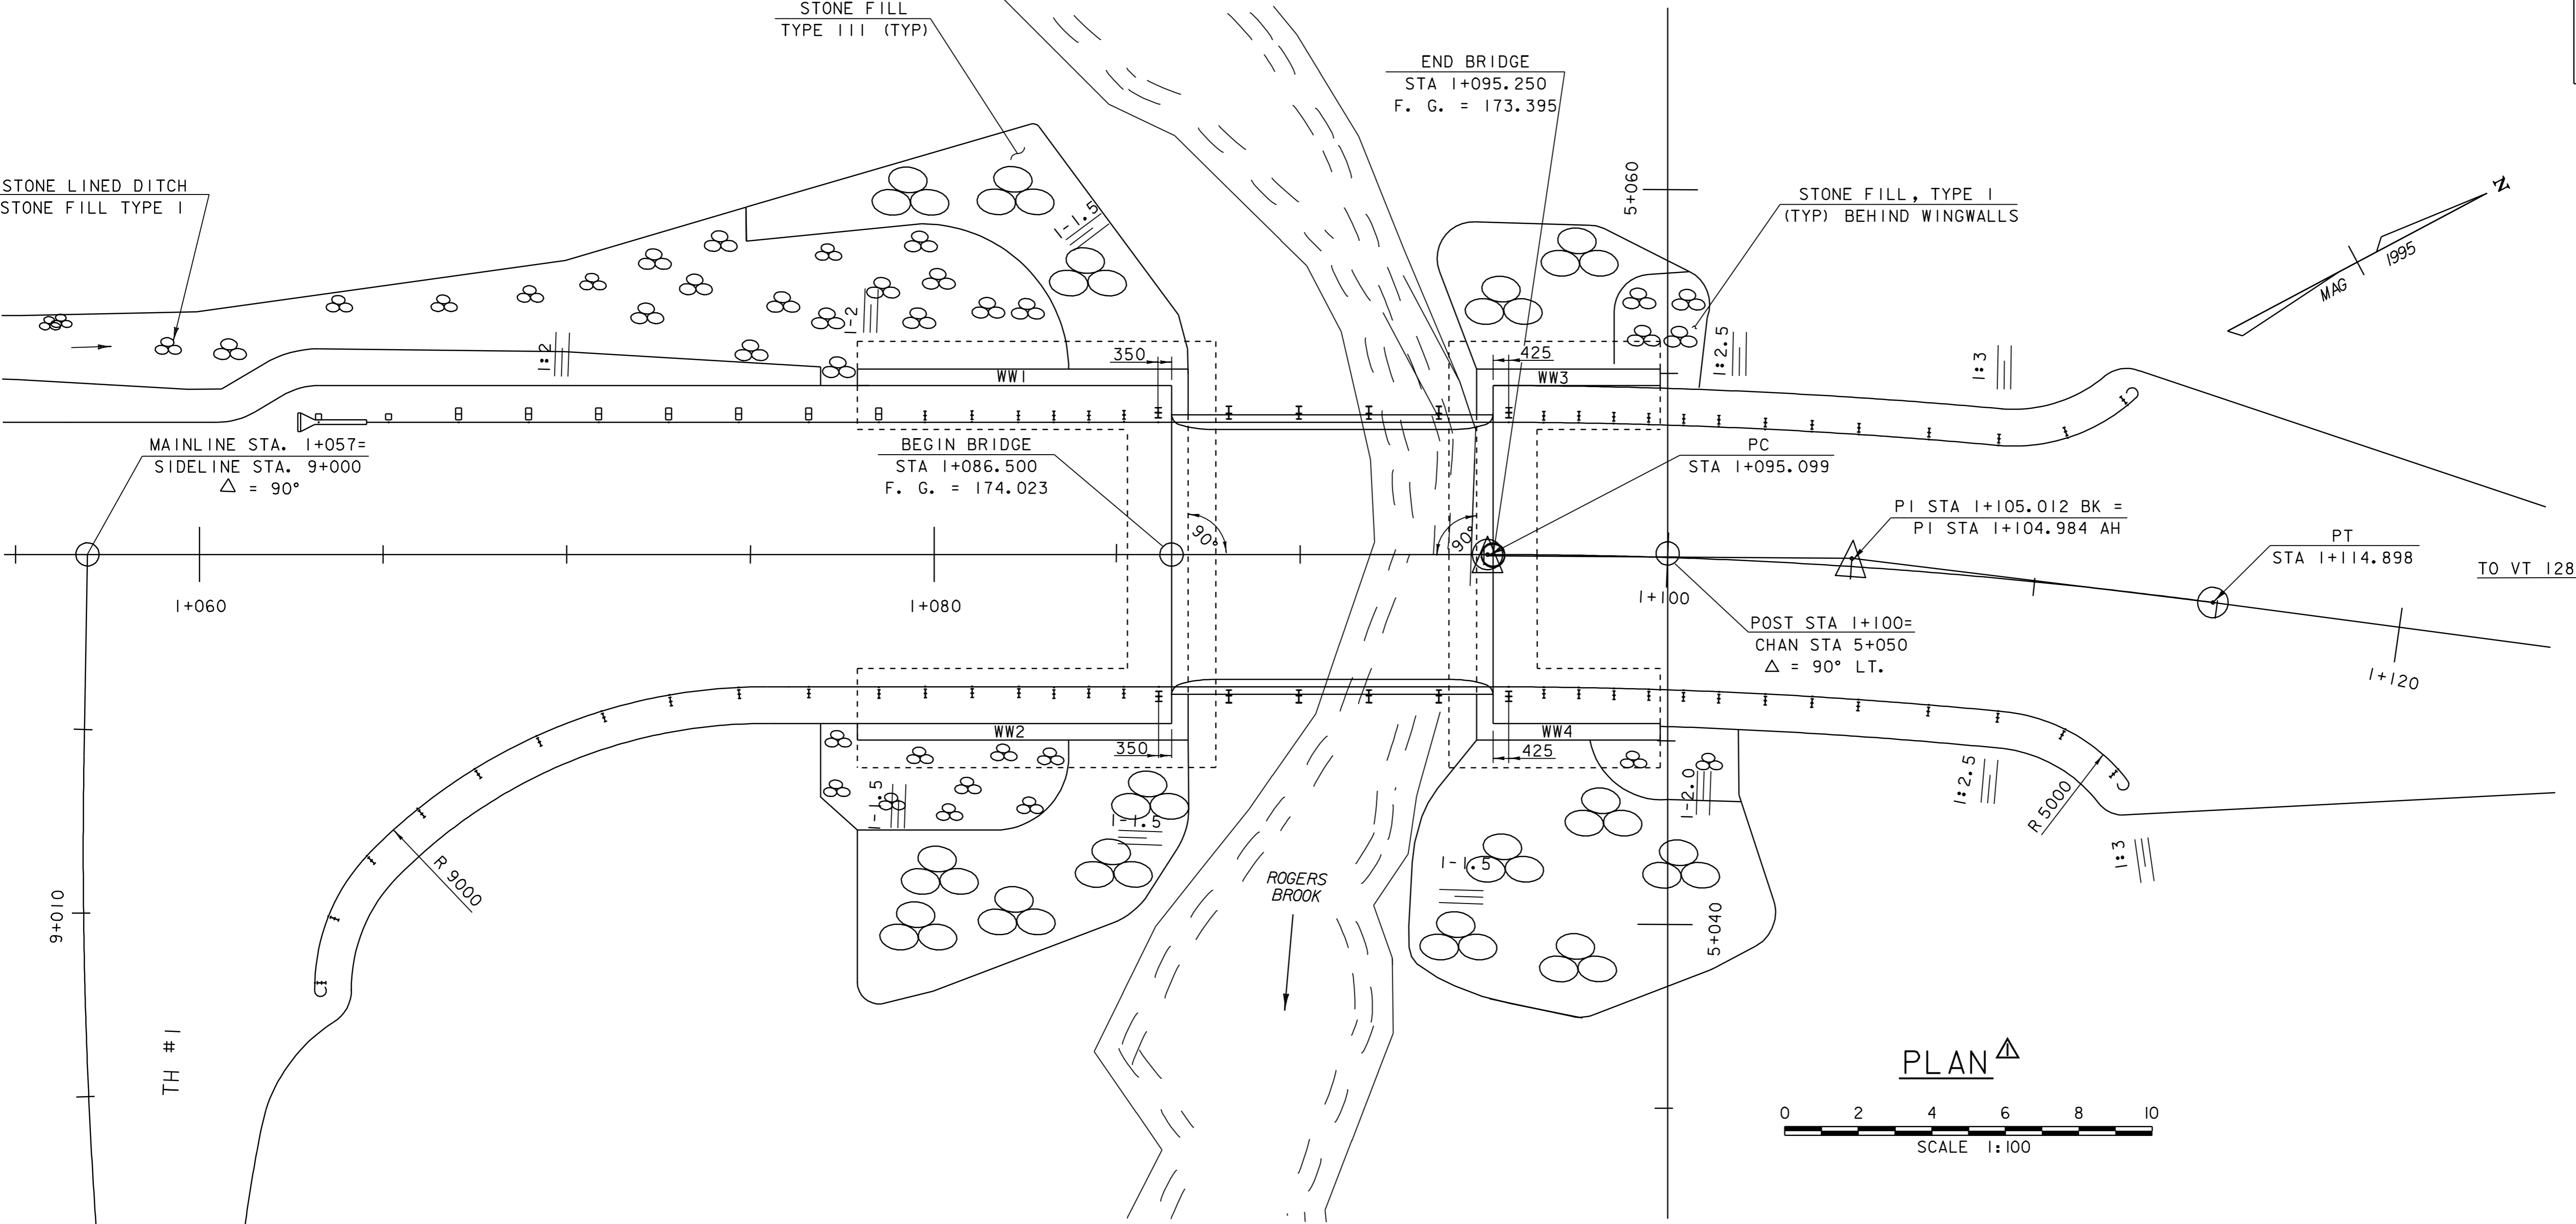

SHEET NAME: **PLAN AND ELEVATION**

PROJECT NAME: WESTFORD
 PROJECT NUMBER: TH2 9436
 HIGHWAY NO.: TH 4
 BRIDGE NO.: 2
 OVER: ROGERS BROOK

FILE NAME: 94J122\Structures\sj122pe.dgn
 PROJECT MANAGER: R. R. WHITCOMB
 DESIGNED BY: C. CARLSON
 BRIDGE SHEET NUMBER:
 PLOT DATE: 22-DEC-2006
 DRAWN BY: J.GILMORE
 IPARM NAME: sj122pe.i
 SHEET 19 OF 56

REVISION	DATE	BY	CHK'D	DESCRIPTION
Δ	06/27/2005	GFR	CWC	ABUTMENTS MODIFIED DUE TO UPDATED LEDGE INFORMATION.

PROJECT DESCRIPTION

This project is located on Town Highway 4 near the intersection of Town Highway 1 and Town Highway 4. The purpose of this project is the replacement of the existing concrete slab bridge with a new 8.75 meter concrete slab bridge. The bridge replacement will occur on alignment with minimal roadwork. The road will be closed during construction and traffic will be detoured. No temporary bridge will be utilized.

This project includes the relocation of a mailbox, replacement of the steel beam guardrail, and the construction of six drive approaches and a walkway. Ditch work and several pipes will be installed on the project. Two deciduous trees and two evergreen trees will be planted and the existing underground telephone utility will be relocated aerially by Verizon.

The total disturbed area, excluding waste, borrow and staging areas, is 0.31 hectares.

SITE INVENTORY AND ANALYSIS

OFF SITE DRAINAGE CHARACTERISTICS

Currently, off-site water draining towards the project is limited to the Debuse/Shanley property in the southwest quadrant of the project. Runoff from the other three quadrants of the project either drains away from the project limits or is intercepted by the Rogers Brook prior to entering the project site.

DRAINAGE, WATERWAYS, BODIES OF WATER

The project site includes Rogers Brook, which is characterized as a small, sinuous, semi-alluvial stream. The streambed consists mostly of ledge through the site with some cobbles and boulders. The drainage area is 9.8 square kilometers. There are no state significant wetlands in the project site. There is one small Class III wetland (less than ¼ acre) in the NW quadrant. This wetland is currently part of an active pasture and has a very low functional value.

TOPOGRAPHY, EXISTING ROADS, BUILDINGS, UTILITIES

The terrain is generally hilly and sloping and slopes steeply along the bank of Rogers Brook within the project site. Town Highway 1 and Town Highway 4 are Class II dirt roads. There are three houses and a barn within the project site. The overhead electrical lines and underground telephone utilities are located along the left side of Town Highway 4.

VEGETATION

The project site contains a mix of agricultural and forested lands. There are several grass lawns and a grass field. There is a scattering of small to medium size hard and softwood trees along the roadways. And there is a denser arrangement of small to medium trees and a tangle of underbrush along the banks of Rogers Brook.

No trees are specifically marked for removal and every reasonable effort should be taken to retain the existing trees. Several deciduous trees are included in the project plans to restore the project site. The impacts to all other vegetation will be limited to that which is necessary for the construction of the new bridge.

SOILS

The soil in the project area is labeled StB, Stetson gravelly fine sandy loam, 5 to 12 percent slopes.

The Stetson series consists of very deep, well drained and somewhat excessively drained soils on outwash plains, terraces, kames, and eskers. These soils formed in glaciofluvial deposits derived mainly from slate, shale and phyllite, with lesser amounts of gneiss, granite and limestone. Slope ranges from 0 to 60 percent. Permeability is moderate or moderately rapid in the solum and rapid or very rapid in the substratum. Well drained and somewhat excessively drained. Many areas are used for hay, pasture, and cultivated crops. Common crops are potatoes, oats, and silage corn. Remaining areas are wooded. Common tree species are eastern white pine, white spruce, red spruce, and sugar maple. The shrink-swell potential of the soil is low. Soil erodibility is low. (USDA Soil Conservation Service, 1967)

SENSITIVE RESOURCE AREAS

On the southern approach to the bridge, a historic barn is only three meters from the eastern edge of the roadway, and there are large maple trees in the front yard of a historic house which is within nine meters of the western edge of the roadway.

On the northern approach, along the west side of TH 4, three resource areas have been identified. A historic stone wall, an area that is archaeologically sensitive and a class III wetland have each been identified and labeled on the project plans.

Rogers Brook is also considered a sensitive resource being a cold water fishery.

Temporary protective fencing will be placed as shown on the Erosion Control Sheets between stations 1+000 and 1+060 LT, stations 1+095 and 1+150 LT, and between station 1+025 RT and sideline station 9-045 RT in order to protect sensitive resource areas from accidental impacts.

No 'Threatened & Endangered Species' or deer wintering areas have been identified within the project limits.

PROXIMITY TO NATURAL OR MAN-MADE WATER FEATURES

The removal of the existing structure and the construction of the proposed structure will take place on the banks and over Rogers Brook.

TEMPORARY EROSION PREVENTION AND SEDIMENT CONTROL

SEEDING AND MULCHING

Mulch should be applied when phasing of earth grading activities dictates that the slopes will be exposed for several days or when a rainfall event is forecast. Seed and mulch should be applied as soon as possible upon reaching final grade. Stockpiles of topsoil and fine grained materials shall be protected from eroding.

PROJECT DEMARCATION FENCE

Project demarcation fencing will be utilized as shown on the plans to limit the area that construction equipment may disturb during construction. Archaeological fencing is also used extensively on this project and acts to serve the same purpose as Project Demarcation Fencing yet at a higher level of visibility.

SURFACE ROUGHENING

The slopes being built up near the bridge approaches between stations 1+075 - 1+130 should be roughened by tracking up and down the slope with a bulldozer or by scarifying with the teeth of the excavator such that small grooves perpendicular to the flow of runoff. This technique should be used daily as the slopes are built until the stone fill is placed.

COFFERDAMS

The contractor has the option of providing a cofferdam at each abutment or piping the water through the abutment areas.

CHECK DAM

Temporary stone check dams shall be used in the ditch along the mainline from stations 1+045 LT. - 1+080 LT. as well as along the sideline from stations 9+005 RT. - 9+025 RT. while the roadwork is in progress. The check dams may be removed once the stone lining of the ditches is accomplished.

SILT FENCE

Silt fencing shall be installed near the downhill limits of construction activity and shall be installed in lines parallel with the contours. Particular areas requiring silt fence on this project are indicated on the plan set. No particular stations are listed as silt fencing may need to be moved or installed in phases to maximize its effectiveness. Additional areas may require protection with the use of silt fencing as the project progresses.

STABILIZED CONSTRUCTION ENTRANCE

Stabilized construction entrances to the project site, staging areas, as well as to waste and borrow areas shall be established. The purpose of a stabilized entrance is to reduce or eliminate the tracking of sediment onto public rights-of-way. See the typical detail on the 'Erosion Prevention & Sediment Control Plan #2' sheet for materials to be used and standard construction techniques.

PERMANENT EROSION CONTROL MEASURES

STONE FILL

Stone fill, Type III, will be placed around Abutments #1 and #2 at STA 1+075 - STA 1+087 LT & RT and STA 1+093 - STA 1+103 LT & RT. This will prevent runoff from eroding the steep banks and will also act as a buffer to prevent Rogers Brook from scouring the soil around the abutments.

STONE LINED DITCHES

Stone lined ditches will be constructed along the sides of the roads to convey concentrated runoff in areas that are too steep for grass lining. They will be constructed from STA 1+044 LT - STA 1+075 LT and STA 1+043 RT - SL STA 9+025 RT.

SEED AND MULCH

Seeding and mulching is one of the most effective means of controlling erosion. Therefore, all exposed surfaces outside of the roadway limits, which are not specified to be covered by stone, will be seeded and mulched.

GENERAL EROSION & SEDIMENT CONTROL GUIDELINES

The Erosion Control Plans are meant as a guideline for preventing erosion and controlling sediment transport. The work outlined in this narrative consists of applying measures throughout the life of the project to control erosion and minimize the sedimentation of receiving waters. The measures include stabilization and structural practices, storm water controls and other pollution prevention controls.

Coordinate the installation, use, and removal of erosion and sediment control measures with construction activities to ensure economical, effective and continuous erosion and sediment control. Employ temporary stabilization practices in incremental stages as construction proceeds. The contractor will use additional erosion control measures as necessitated by the sequence of construction and as directed by the Engineer and On-site Coordinator. See section 105.23 of the Vermont AOT Standard Specifications for Construction, dated 2001.

Install all erosion and sediment control measures as shown in the Erosion Control Plan or as directed by the Engineer and On-site Coordinator. Do not modify the type, size or location of any control or practice without approval of the Engineer and On-site Coordinator. Any changes shall be noted on the plans, in the weekly inspection report, and reported to the appropriate authority in a timely manner. Inspect all control measures weekly and after each rainfall event. Repair or replace any damaged measures.

Preventing initial soil erosion is much more effective than treating eroded sediment. Therefore, stabilize all disturbed areas promptly after construction activity has temporarily or permanently ceased. Temporary vegetation shall be established if the area is to be without construction activity for a period of 14 days. Perimeter control measures shall be installed following clearing, but prior to the start of any grubbing or grading activity, install other temporary controls in incremental stages as construction proceeds.

Maintaining vegetated buffers along stream banks, wetlands or other sensitive areas is a crucial erosion and sediment control measure that should be established wherever possible.

Control only sediment-laden runoff generated by the project site. Collect and route clean offsite runoff around or through the project site using diversion berms, diversion channels, culverts and/or temporary pipes.

Do not allow construction equipment to operate on the down slope side of perimeter control measures.

SEDIMENT SETTLING BASIN SIZING CRITERIA

PUMP FLOW RATE Q(gpm)	REQUIRED SURFACE AREA Q(m ³ /s)	LENGTH WIDTH = 2:1					
		L (ft)	W (ft)	L (m)	W (m)		
50	0.0032	595	55	35.0	17.0	10.6	5.3
100	0.0063	1200	111	49.0	24.5	15.0	7.5
150	0.0095	1776	165	59.6	29.8	18.2	9.1
200	0.0126	2368	220	68.8	34.4	21.0	10.5
250	0.0158	2970	276	77.0	38.5	23.4	11.7
300	0.0189	3560	330	84.4	42.2	25.8	12.9
350	0.0221	4155	386	91.2	45.6	27.8	13.9


SHEET NAME:	EROSION CONTROL NARRATIVE	
PROJECT NAME:	WESTFORD	HIGHWAY NO.: TH 4
PROJECT NUMBER:	TH2 9436	BRIDGE NO.: 2
		OVER: ROGERS BROOK
FILE NAME:	94j22\Structures\sj22ero.dgn	PLOT DATE: 25-MAR-2005
PROJECT MANAGER:	R. R. WHITCOMB	DRAWN BY: STRI
DESIGNED BY:	C. CARLSON	IPARM NAME: sj22ero.I
BRIDGE SHEET NUMBER:		SHEET 20 OF 56

DICKSON

DEBUSE / SHANLEY

KEEFE

BENCH MARK
CHIS. SQ.
Elev. 173.613

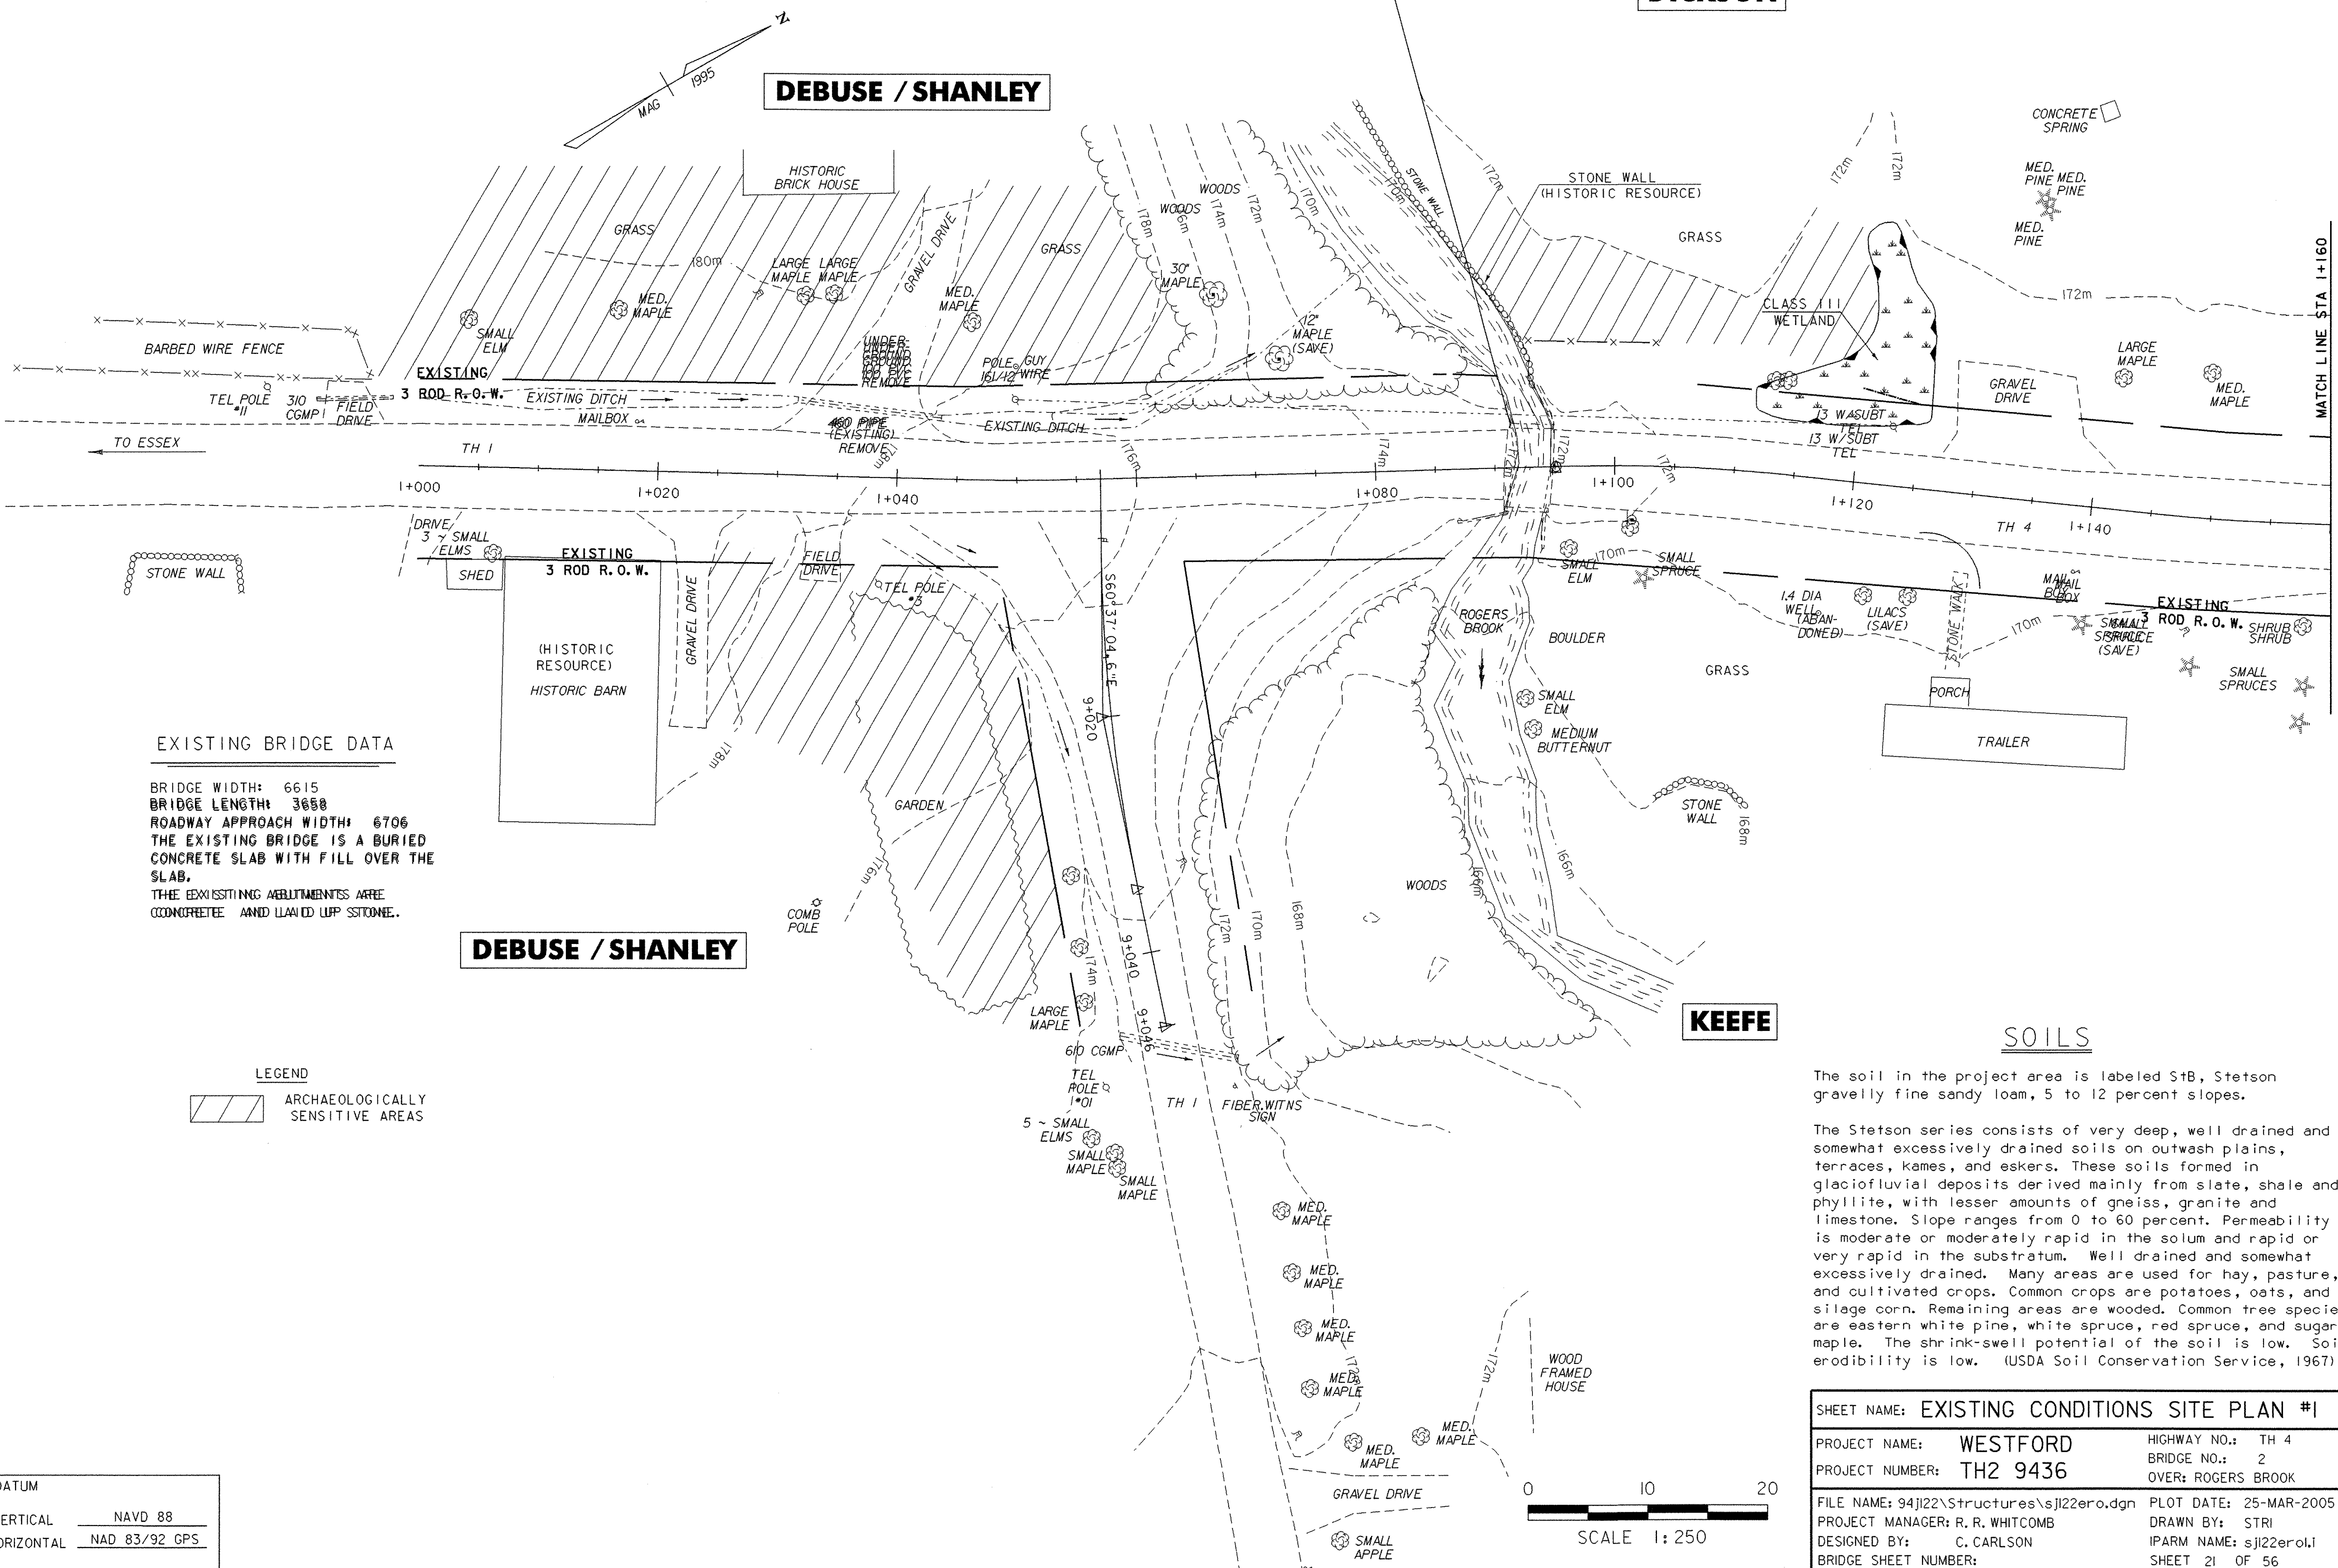

EXISTING BRIDGE DATA

BRIDGE WIDTH: 6615
 BRIDGE LENGTH: 3688
 ROADWAY APPROACH WIDTH: 6706
 THE EXISTING BRIDGE IS A BURIED CONCRETE SLAB WITH FILL OVER THE SLAB.
 THE EXISTING ABUTMENTS ARE CONCRETE AND LINED UP STONE.

LEGEND

ARCHAEOLOGICALLY SENSITIVE AREAS

SOILS

The soil in the project area is labeled StB, Stetson gravelly fine sandy loam, 5 to 12 percent slopes.



The Stetson series consists of very deep, well drained and somewhat excessively drained soils on outwash plains, terraces, kames, and eskers. These soils formed in glaciofluvial deposits derived mainly from slate, shale and phyllite, with lesser amounts of gneiss, granite and limestone. Slope ranges from 0 to 60 percent. Permeability is moderate or moderately rapid in the solum and rapid or very rapid in the substratum. Well drained and somewhat excessively drained. Many areas are used for hay, pasture, and cultivated crops. Common crops are potatoes, oats, and silage corn. Remaining areas are wooded. Common tree species are eastern white pine, white spruce, red spruce, and sugar maple. The shrink-swell potential of the soil is low. Soil erodibility is low. (USDA Soil Conservation Service, 1967)

DATUM

VERTICAL NAVD 88
 HORIZONTAL NAD 83/92 GPS

0 10 20
 SCALE 1: 250


SHEET NAME: EXISTING CONDITIONS SITE PLAN #1		
PROJECT NAME: WESTFORD	HIGHWAY NO.: TH 4	
PROJECT NUMBER: TH2 9436	BRIDGE NO.: 2	OVER: ROGERS BROOK
FILE NAME: 94J22\Structures\sj22ero.dgn	PLOT DATE: 25-MAR-2005	
PROJECT MANAGER: R. R. WHITCOMB	DRAWN BY: STRI	
DESIGNED BY: C. CARLSON	IPARM NAME: sj22ero.l	
BRIDGE SHEET NUMBER:	SHEET 21 OF 56	

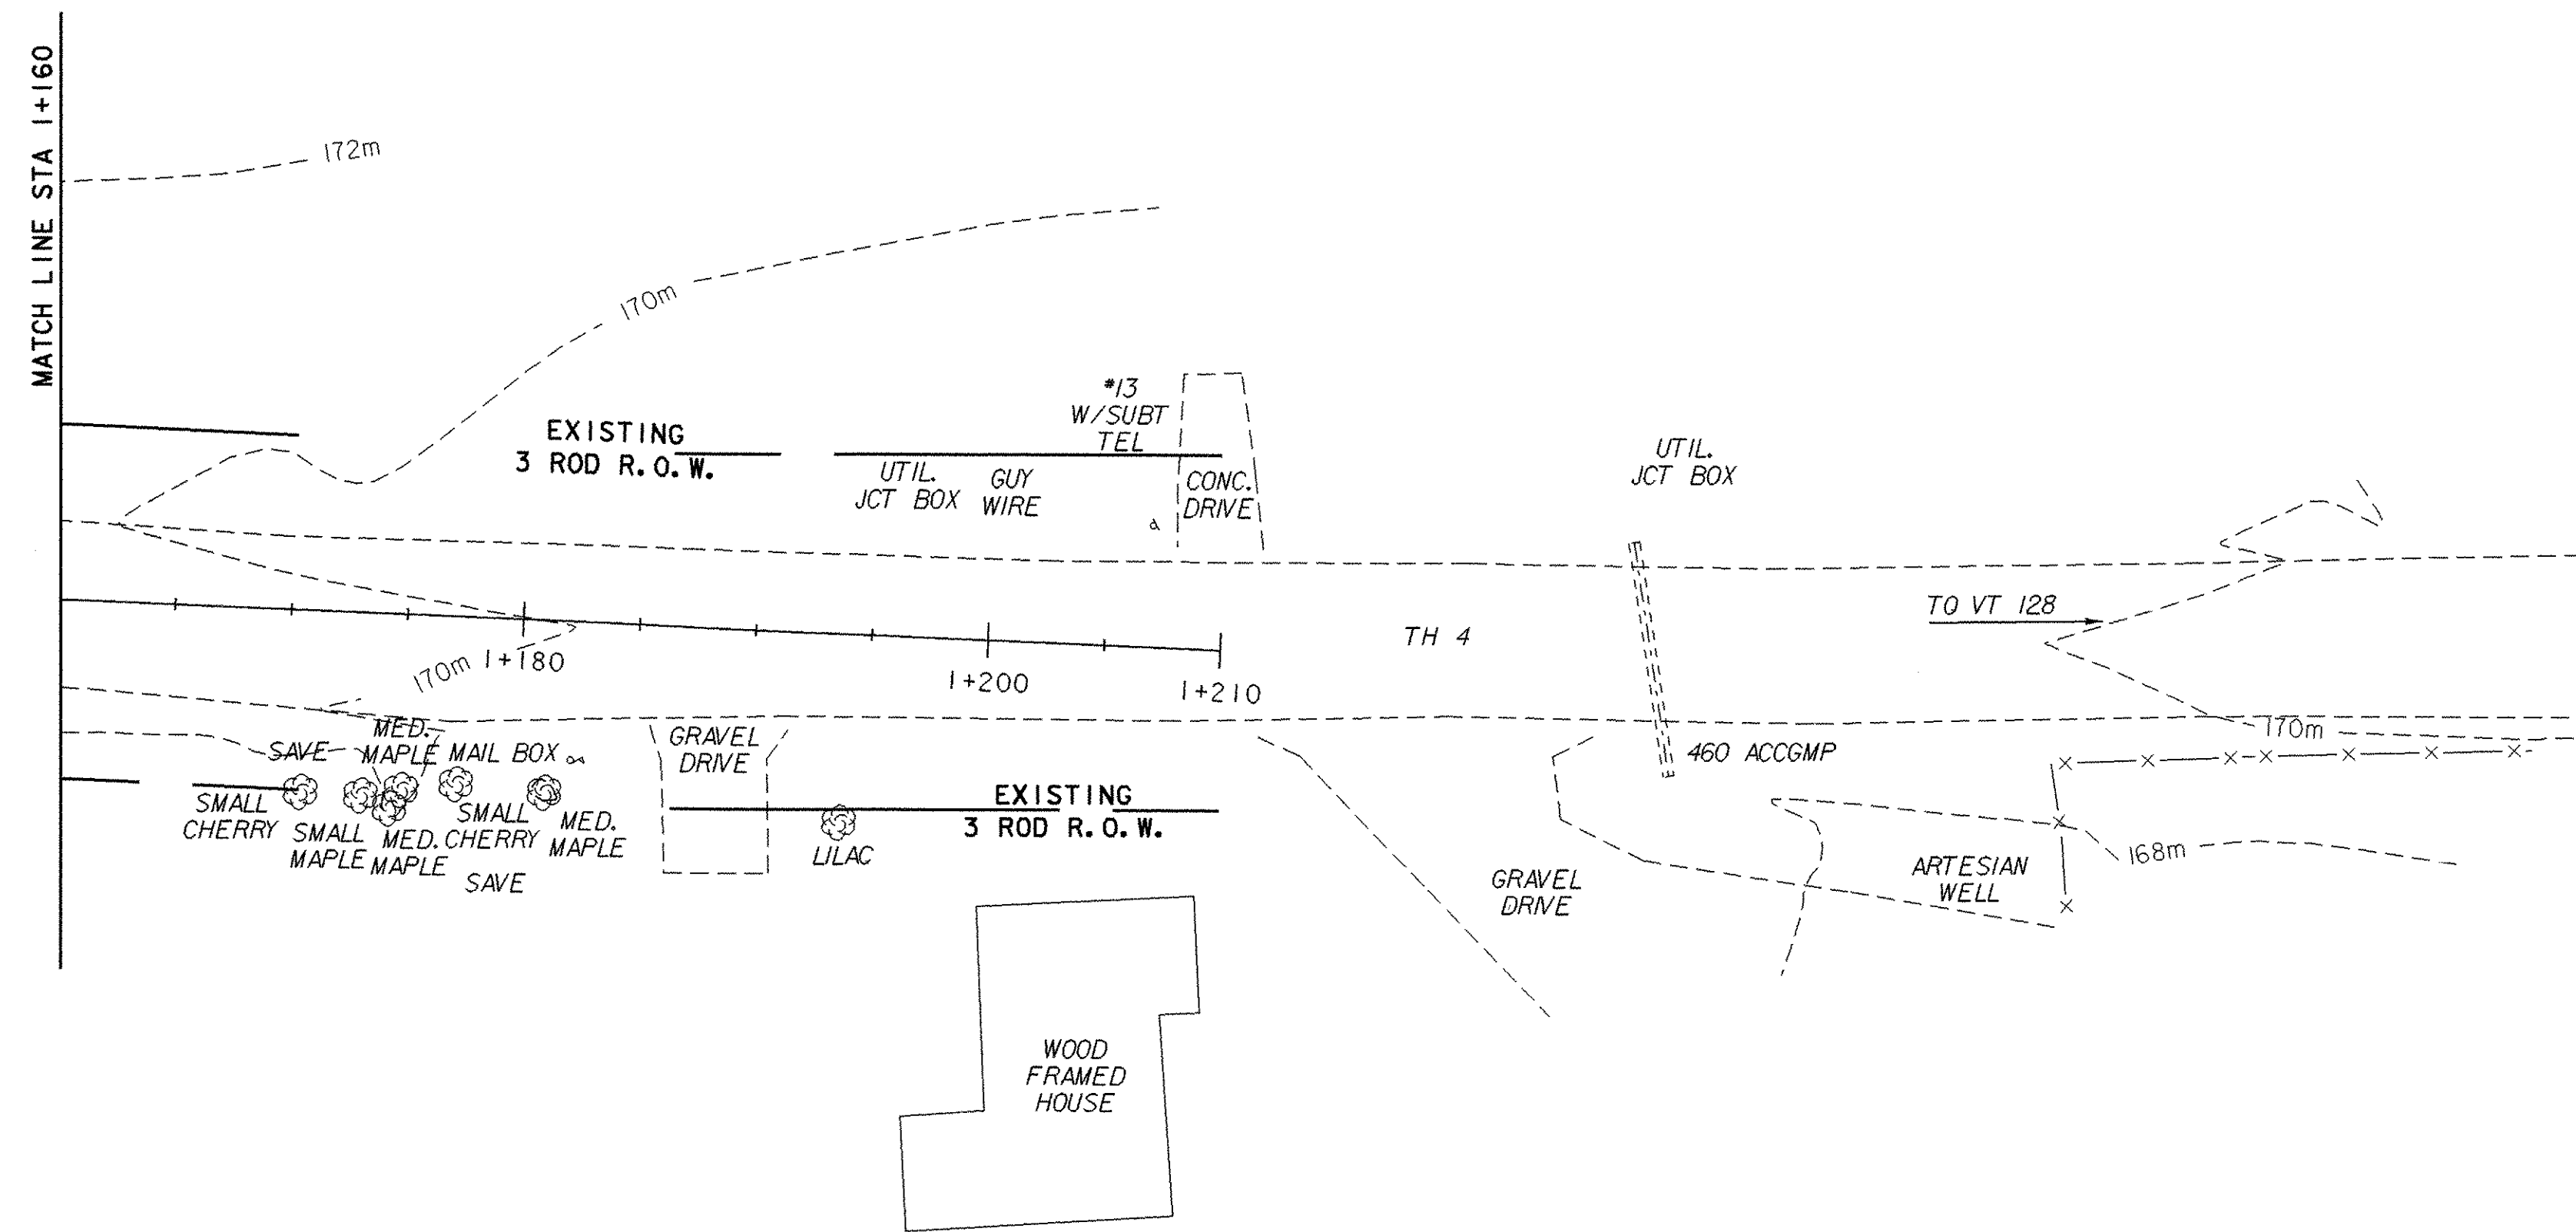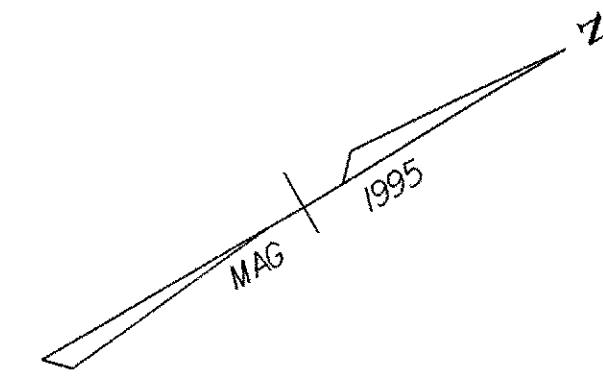

NOTES

SEE SHEET 21 FOR SOILS INFORMATION


DATUM	
VERTICAL	NAVD 88
HORIZONTAL	NAD 83/92 GPS

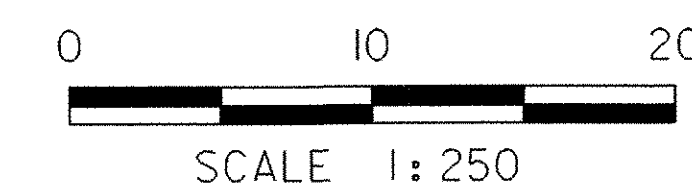

SHEET NAME: EXISTING CONDITIONS SITE PLAN #2	
PROJECT NAME: WESTFORD	HIGHWAY NO.: TH 4
PROJECT NUMBER: TH2 9436	BRIDGE NO.: 2
	OVER: ROGERS BROOK
FILE NAME: 94J22\Structures\sj22ero.dgn	PLOT DATE: 25-MAR-2005
PROJECT MANAGER: R. R. WHITCOMB	DRAWN BY: STRI
DESIGNED BY: C. CARLSON	IPARM NAME: sj22ero2.1
BRIDGE SHEET NUMBER:	SHEET 22 OF 56

EROSION AND SEDIMENT CONTROL INDEX	
NO.	DESCRIPTION
1	INSTALL ARCH. FENCE ALONG ARCHEOLOGICALLY SENSITIVE AREA
2	INSTALL SILT FENCE AT DOWNSLOPE SIDE OF DISTURBANCE LIMITS
3	ENDS OF FENCE TURNED UPHILL TO CREATE PONDING
4	INSTALL ROCK CHECK DAMS IN DITCHES
5	PROJECT LIMIT DEMARCATION FENCE (SNOW FENCE (MOD-PDF))
6	EROSION CONTROL MATTING

NOTE: ALL DISTURBED AREAS WITH SLOPES GREATER THAN 1:3 WILL REQUIRE TEMPORARY EROSION MATTING (SEE EROSION CONTROL DETAILS SHEET)

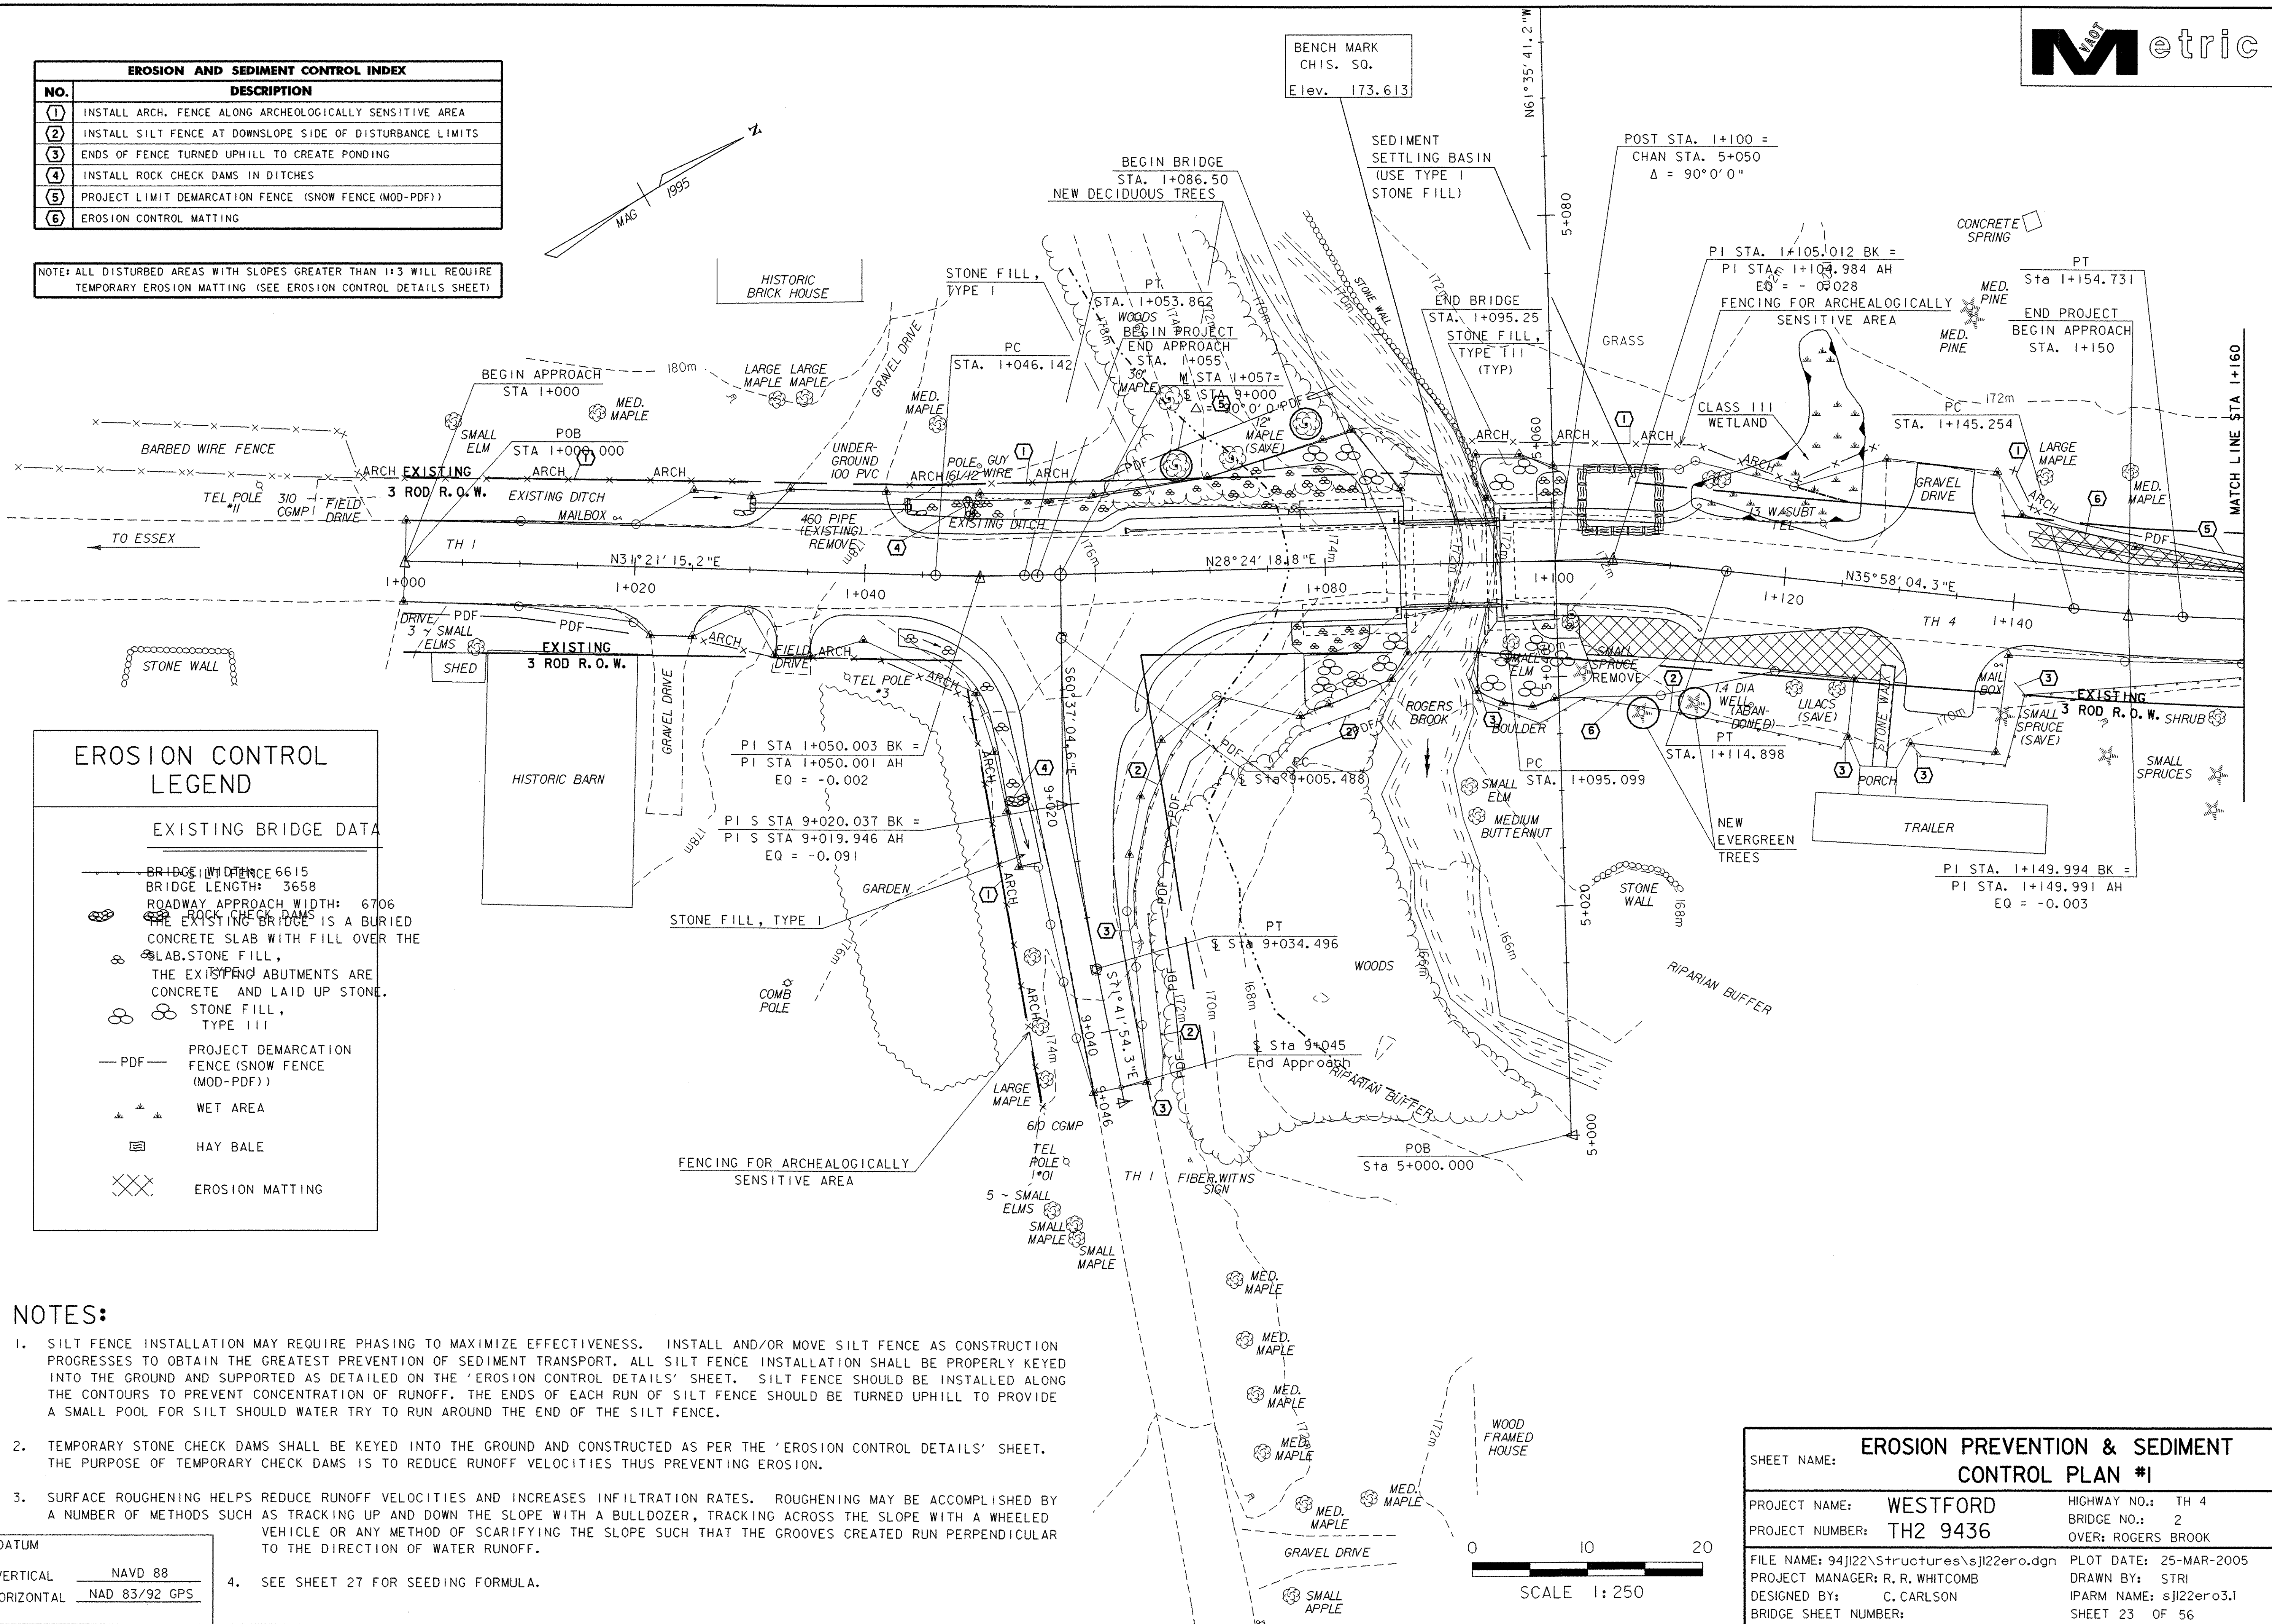


EROSION CONTROL LEGEND





EXISTING BRIDGE DATA

- BRIDGE WIDTH: 66.15
- BRIDGE LENGTH: 365.8
- ROADWAY APPROACH WIDTH: 67.06
- THE EXISTING BRIDGE IS A BURIED CONCRETE SLAB WITH FILL OVER THE SLAB. STONE FILL, THE EXISTING ABUTMENTS ARE CONCRETE AND LAID UP STONE.
- STONE FILL, TYPE III
- PROJECT DEMARCATION FENCE (SNOW FENCE (MOD-PDF))
- WET AREA
- HAY BALE
- EROSION MATTING

- NOTES:**
- SILT FENCE INSTALLATION MAY REQUIRE PHASING TO MAXIMIZE EFFECTIVENESS. INSTALL AND/OR MOVE SILT FENCE AS CONSTRUCTION PROGRESSES TO OBTAIN THE GREATEST PREVENTION OF SEDIMENT TRANSPORT. ALL SILT FENCE INSTALLATION SHALL BE PROPERLY KEYED INTO THE GROUND AND SUPPORTED AS DETAILED ON THE 'EROSION CONTROL DETAILS' SHEET. SILT FENCE SHOULD BE INSTALLED ALONG THE CONTOURS TO PREVENT CONCENTRATION OF RUNOFF. THE ENDS OF EACH RUN OF SILT FENCE SHOULD BE TURNED UPHILL TO PROVIDE A SMALL POOL FOR SILT SHOULD WATER TRY TO RUN AROUND THE END OF THE SILT FENCE.
 - TEMPORARY STONE CHECK DAMS SHALL BE KEYED INTO THE GROUND AND CONSTRUCTED AS PER THE 'EROSION CONTROL DETAILS' SHEET. THE PURPOSE OF TEMPORARY CHECK DAMS IS TO REDUCE RUNOFF VELOCITIES THUS PREVENTING EROSION.
 - SURFACE ROUGHENING HELPS REDUCE RUNOFF VELOCITIES AND INCREASES INFILTRATION RATES. ROUGHENING MAY BE ACCOMPLISHED BY A NUMBER OF METHODS SUCH AS TRACKING UP AND DOWN THE SLOPE WITH A BULLDOZER, TRACKING ACROSS THE SLOPE WITH A WHEELED VEHICLE OR ANY METHOD OF SCARIFYING THE SLOPE SUCH THAT THE GROOVES CREATED RUN PERPENDICULAR TO THE DIRECTION OF WATER RUNOFF.
- DATUM
 VERTICAL NAVD 88
 HORIZONTAL NAD 83/92 GPS
4. SEE SHEET 27 FOR SEEDING FORMULA.

EROSION PREVENTION & SEDIMENT CONTROL PLAN #1		
SHEET NAME:	EROSION PREVENTION & SEDIMENT CONTROL PLAN #1	
PROJECT NAME:	WESTFORD	HIGHWAY NO.: TH 4
PROJECT NUMBER:	TH2 9436	BRIDGE NO.: 2
		OVER: ROGERS BROOK
FILE NAME:	94J122\Structures\sj122ero.dgn	PLOT DATE: 25-MAR-2005
PROJECT MANAGER:	R. R. WHITCOMB	DRAWN BY: STRI
DESIGNED BY:	C. CARLSON	IPARM NAME: sj122ero3.i
BRIDGE SHEET NUMBER:		SHEET 23 OF 56

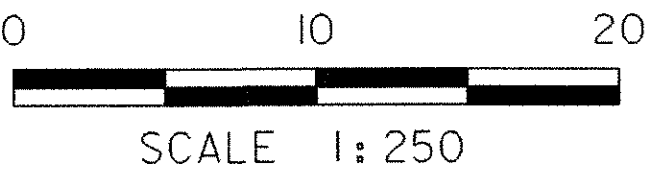

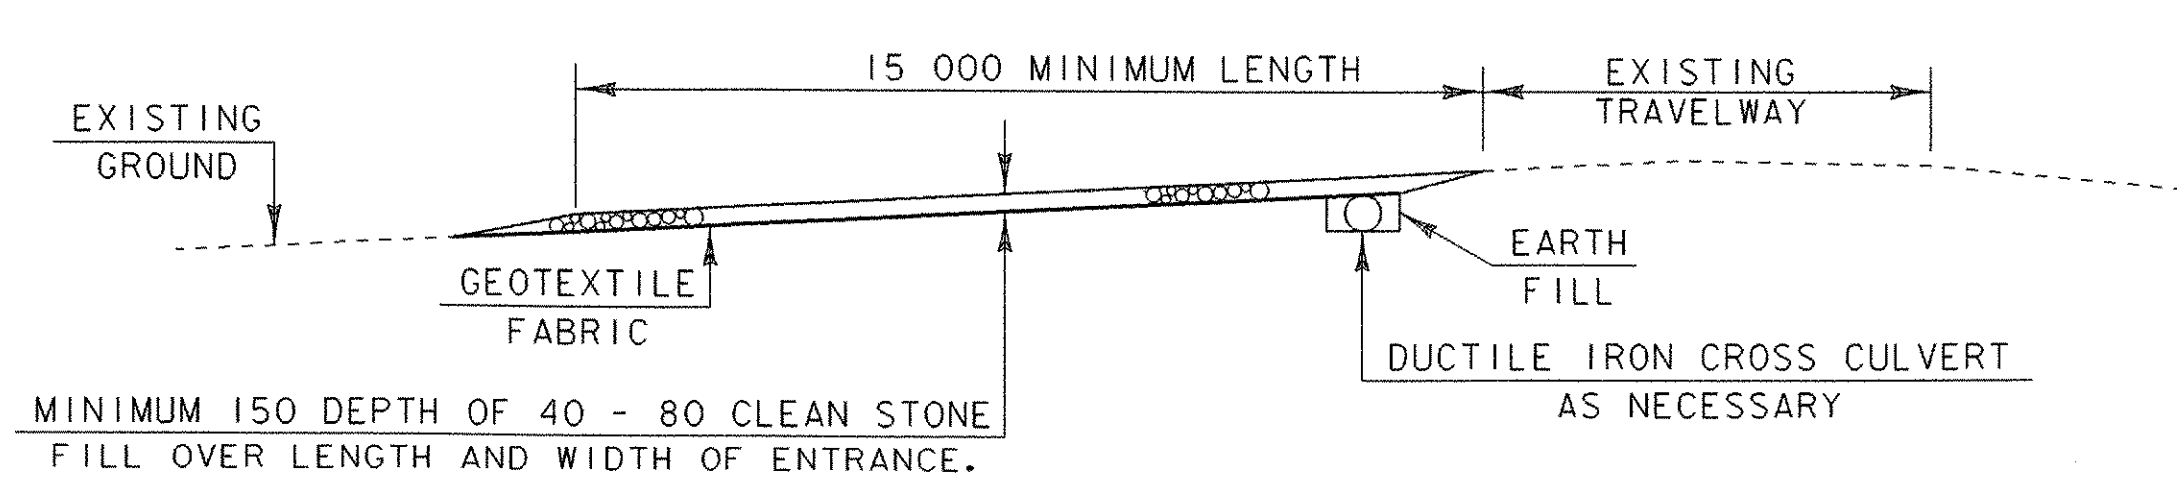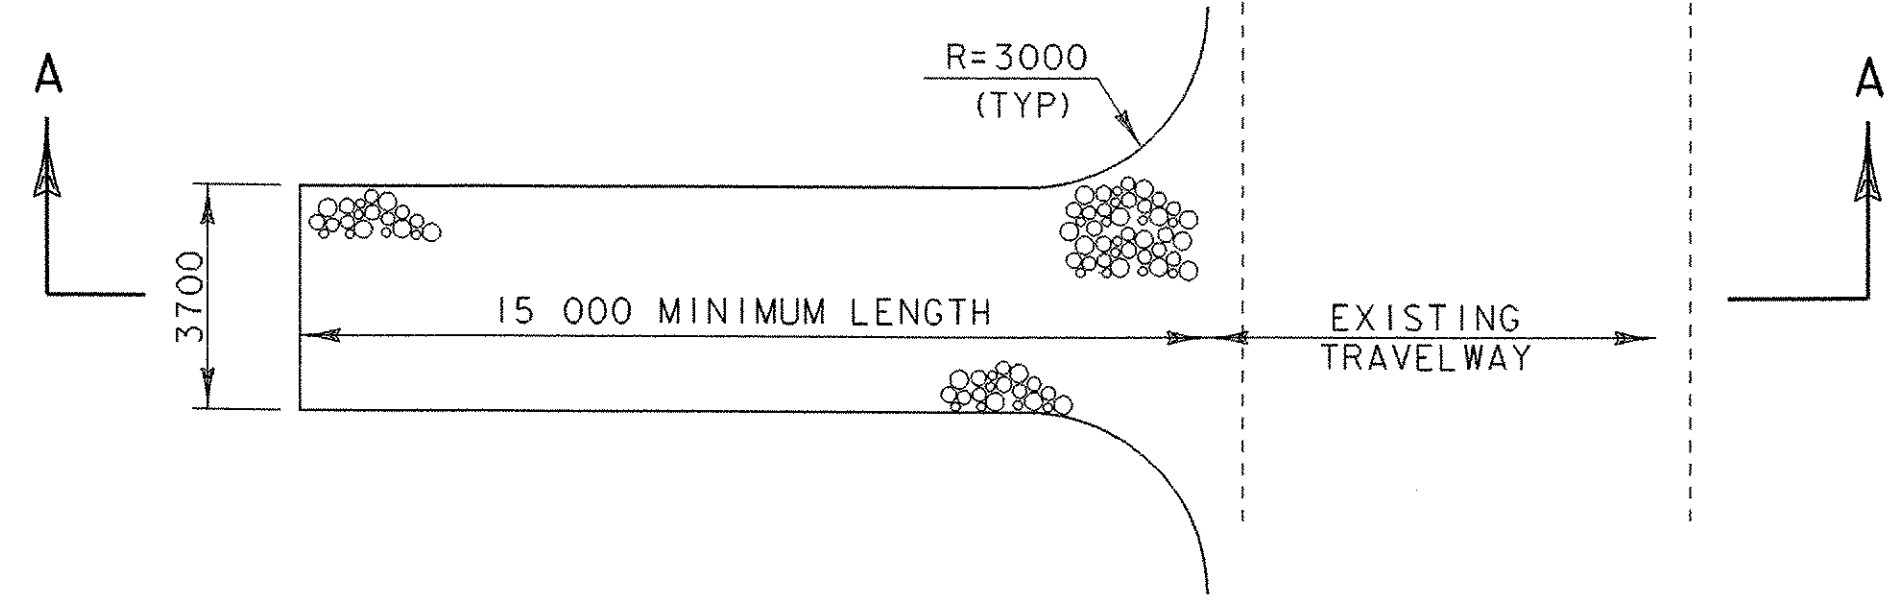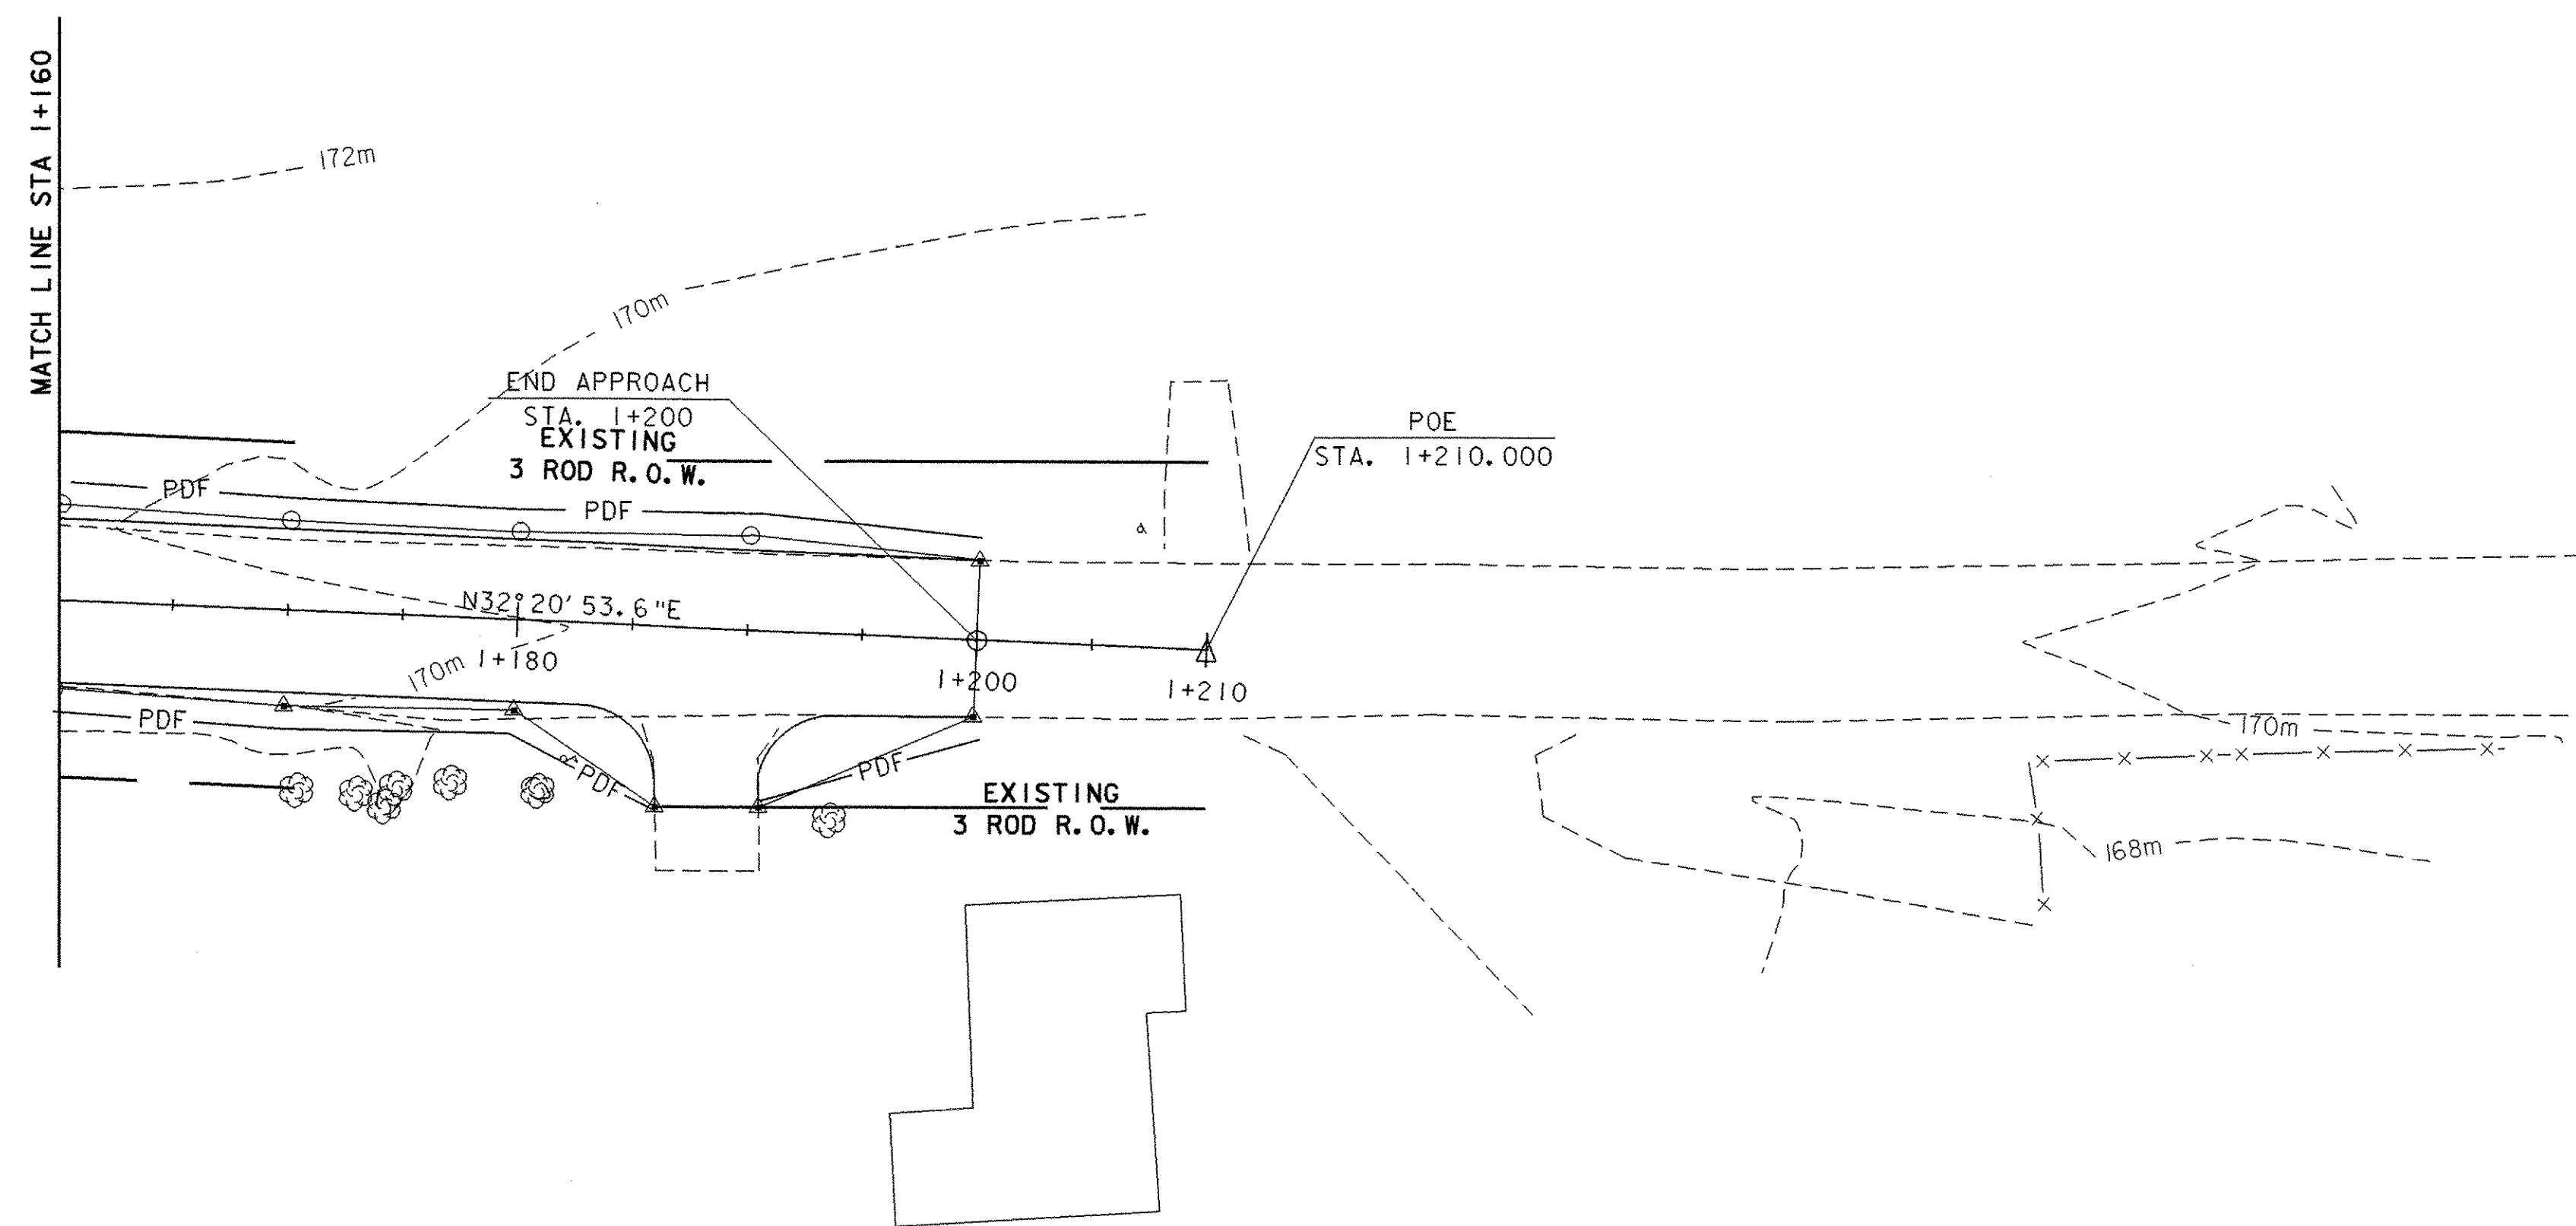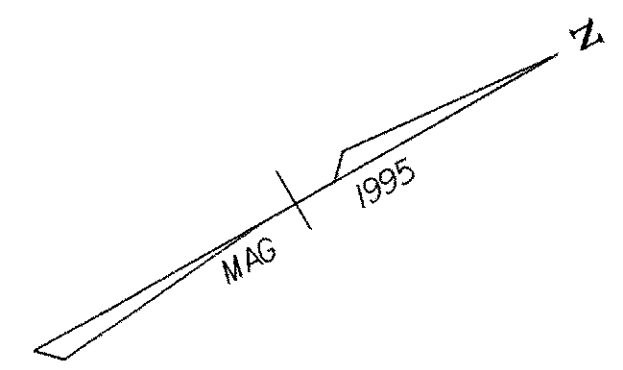


SECTION A-A
NTS

STABILIZED CONSTRUCTION ENTRANCE

NTS

NOTE:
SEE SHEETS 21 AND 23 FOR NOTES.

DATUM	
VERTICAL	NAVD 88
HORIZONTAL	NAD 83/92 GPS

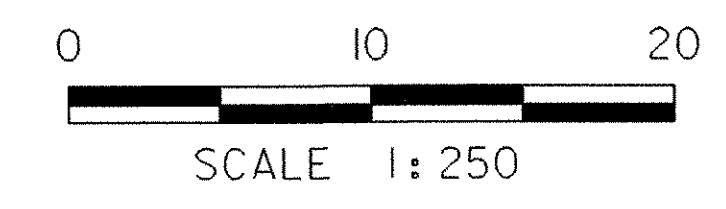


SHEET NAME: EROSION PREVENTION & SEDIMENT CONTROL PLAN #2	
PROJECT NAME: WESTFORD	HIGHWAY NO.: TH 4
PROJECT NUMBER: TH2 9436	BRIDGE NO.: 2
	OVER: ROGERS BROOK
FILE NAME: 94J122\Structures\sj122ero.dgn	PLOT DATE: 25-MAR-2005
PROJECT MANAGER: G.S. ROGERS	DRAWN BY: STRI
DESIGNED BY: C. CARLSON	IPARM NAME: sj122ero4.i
BRIDGE SHEET NUMBER:	SHEET 24 OF 56

DICKSON

POST STA. 1+100 =
CHAN STA. 5+050
 $\Delta = 90^\circ 0' 0''$

BENCH MARK
CHIS. SQ.
Elev. 173.613

DEBUSE / SHANLEY

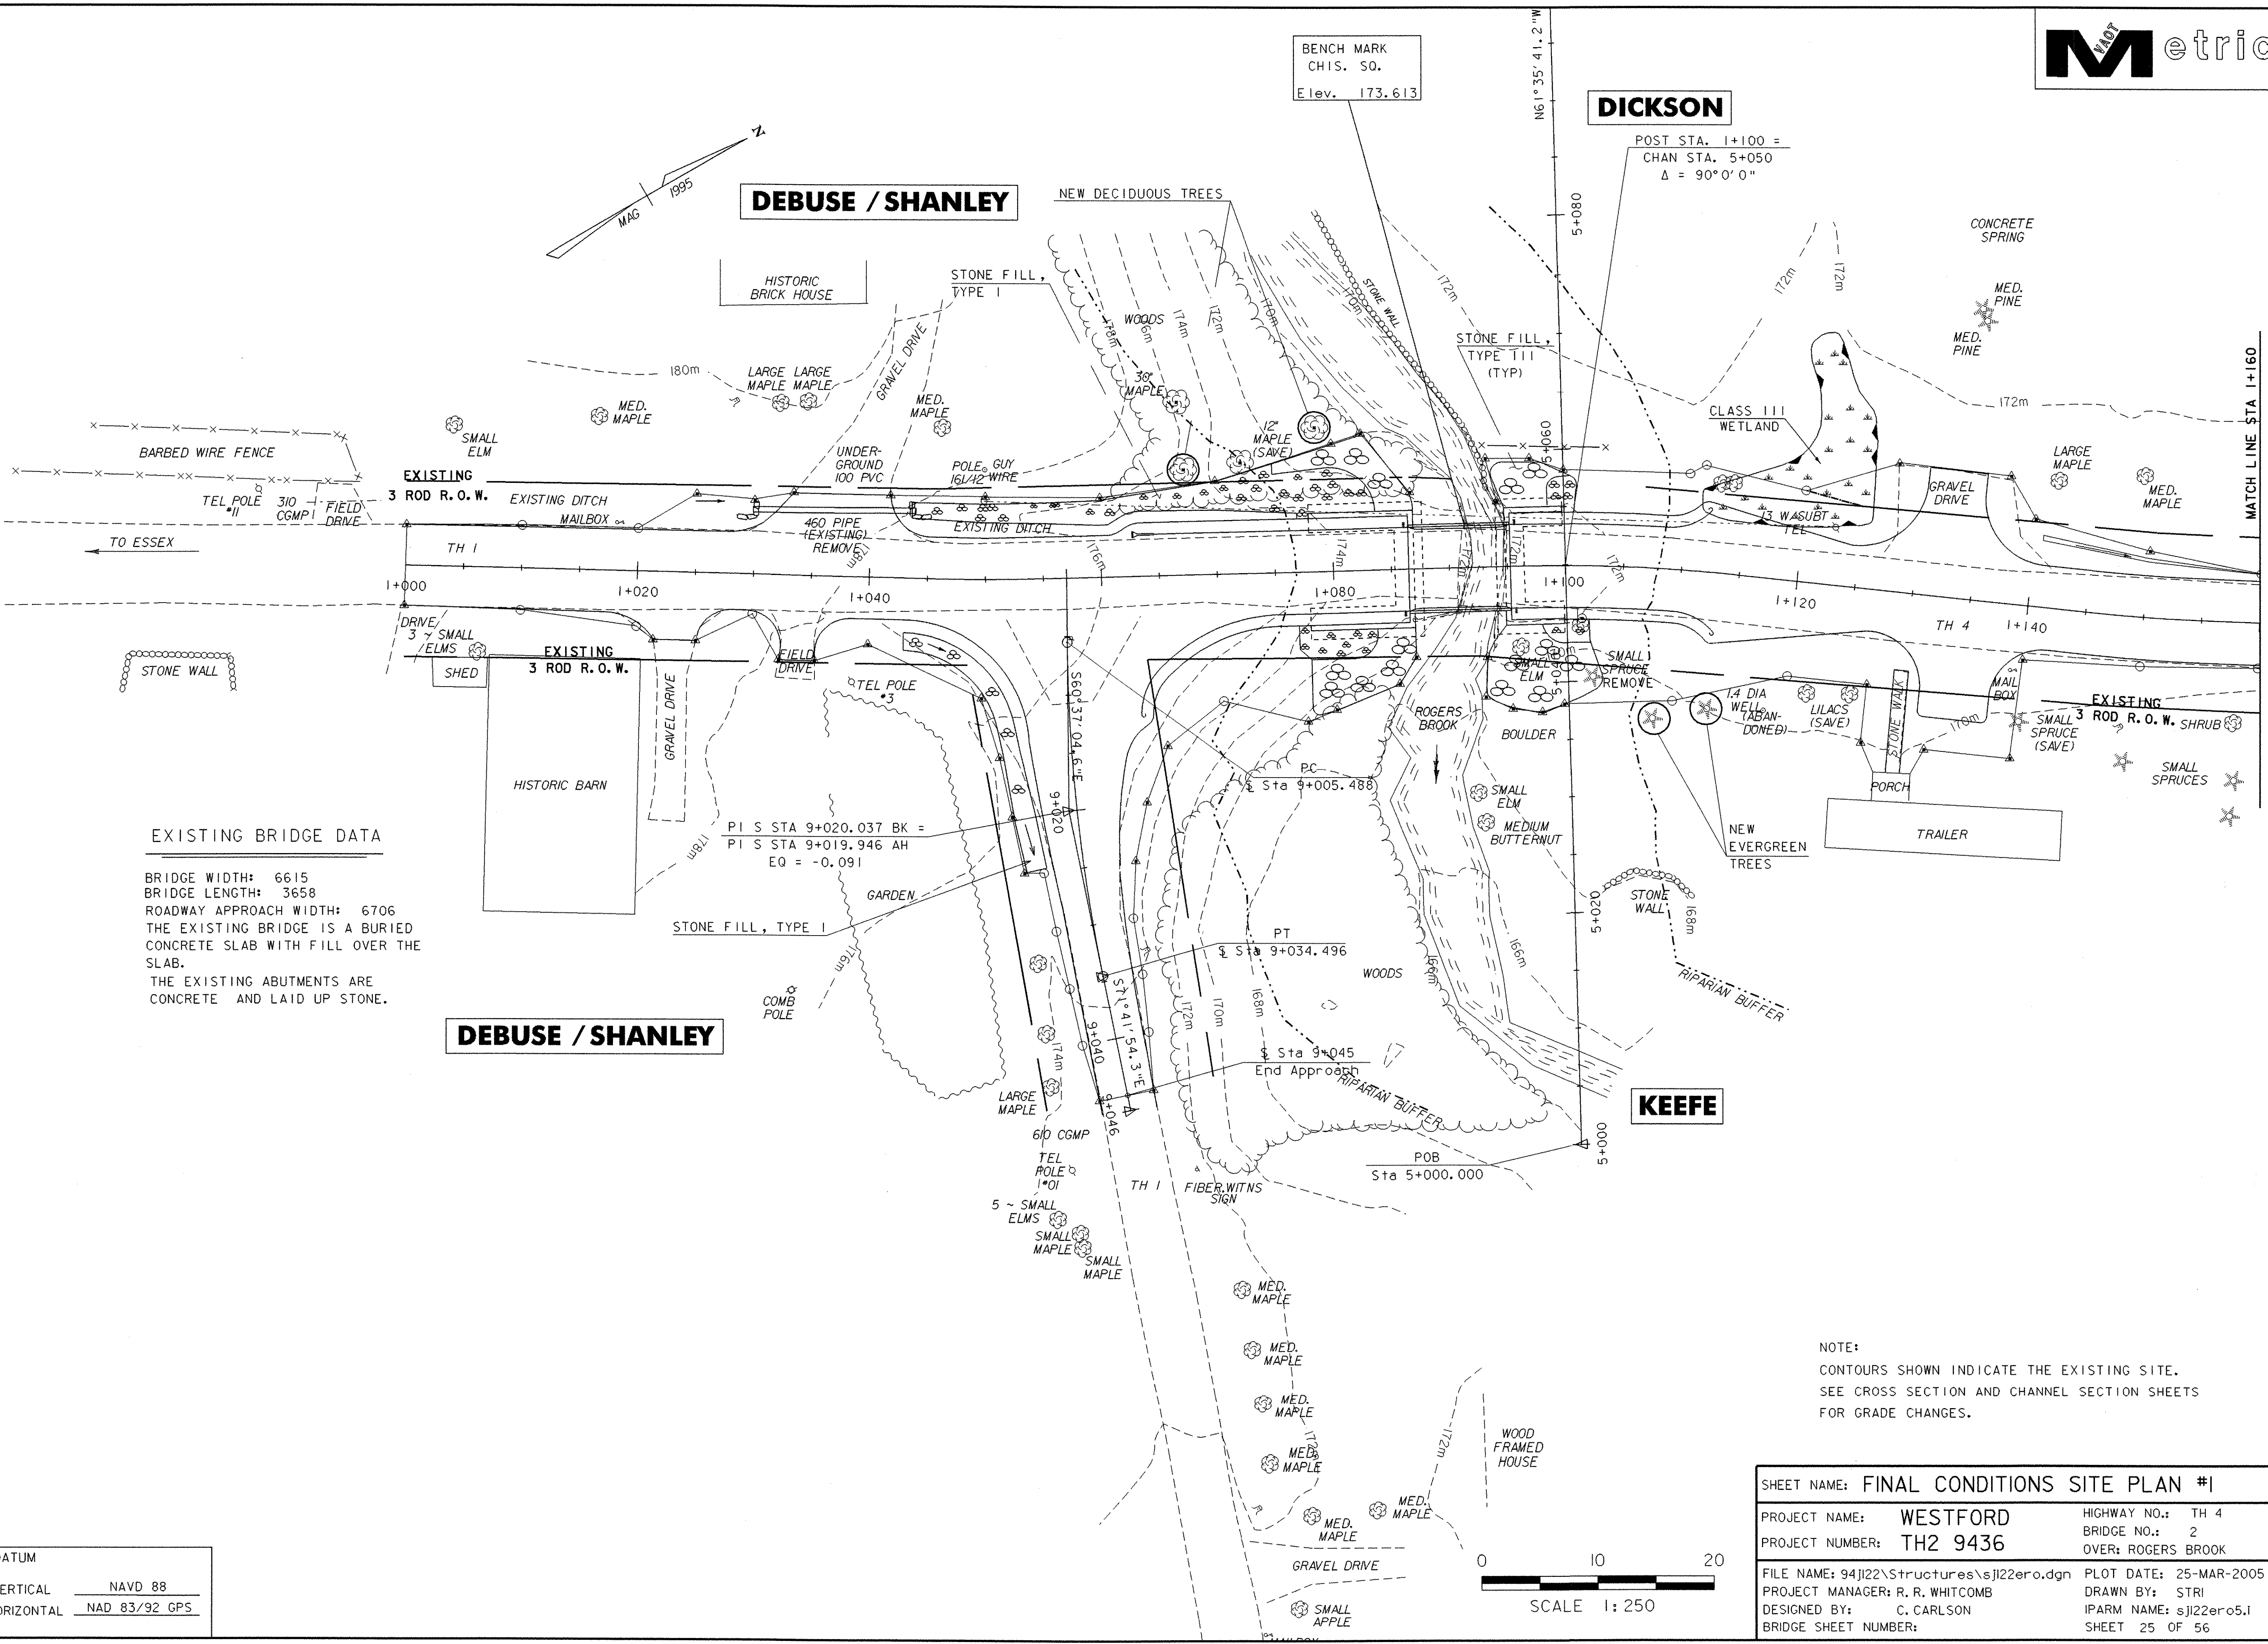

EXISTING BRIDGE DATA

BRIDGE WIDTH: 6615
BRIDGE LENGTH: 3658
ROADWAY APPROACH WIDTH: 6706
THE EXISTING BRIDGE IS A BURIED CONCRETE SLAB WITH FILL OVER THE SLAB.
THE EXISTING ABUTMENTS ARE CONCRETE AND LAID UP STONE.

DEBUSE / SHANLEY



KEEFE

NOTE:
CONTOURS SHOWN INDICATE THE EXISTING SITE.
SEE CROSS SECTION AND CHANNEL SECTION SHEETS FOR GRADE CHANGES.


DATUM
VERTICAL NAVD 88
HORIZONTAL NAD 83/92 GPS

0 10 20
SCALE 1: 250

SHEET NAME: FINAL CONDITIONS SITE PLAN #1		
PROJECT NAME: WESTFORD	HIGHWAY NO.: TH 4	
PROJECT NUMBER: TH2 9436	BRIDGE NO.: 2	OVER: ROGERS BROOK
FILE NAME: 94j122\Structures\sj122ero.dgn	PLOT DATE: 25-MAR-2005	
PROJECT MANAGER: R. R. WHITCOMB	DRAWN BY: STRI	
DESIGNED BY: C. CARLSON	IPARM NAME: sj122ero5.1	
BRIDGE SHEET NUMBER:	SHEET 25 OF 56	

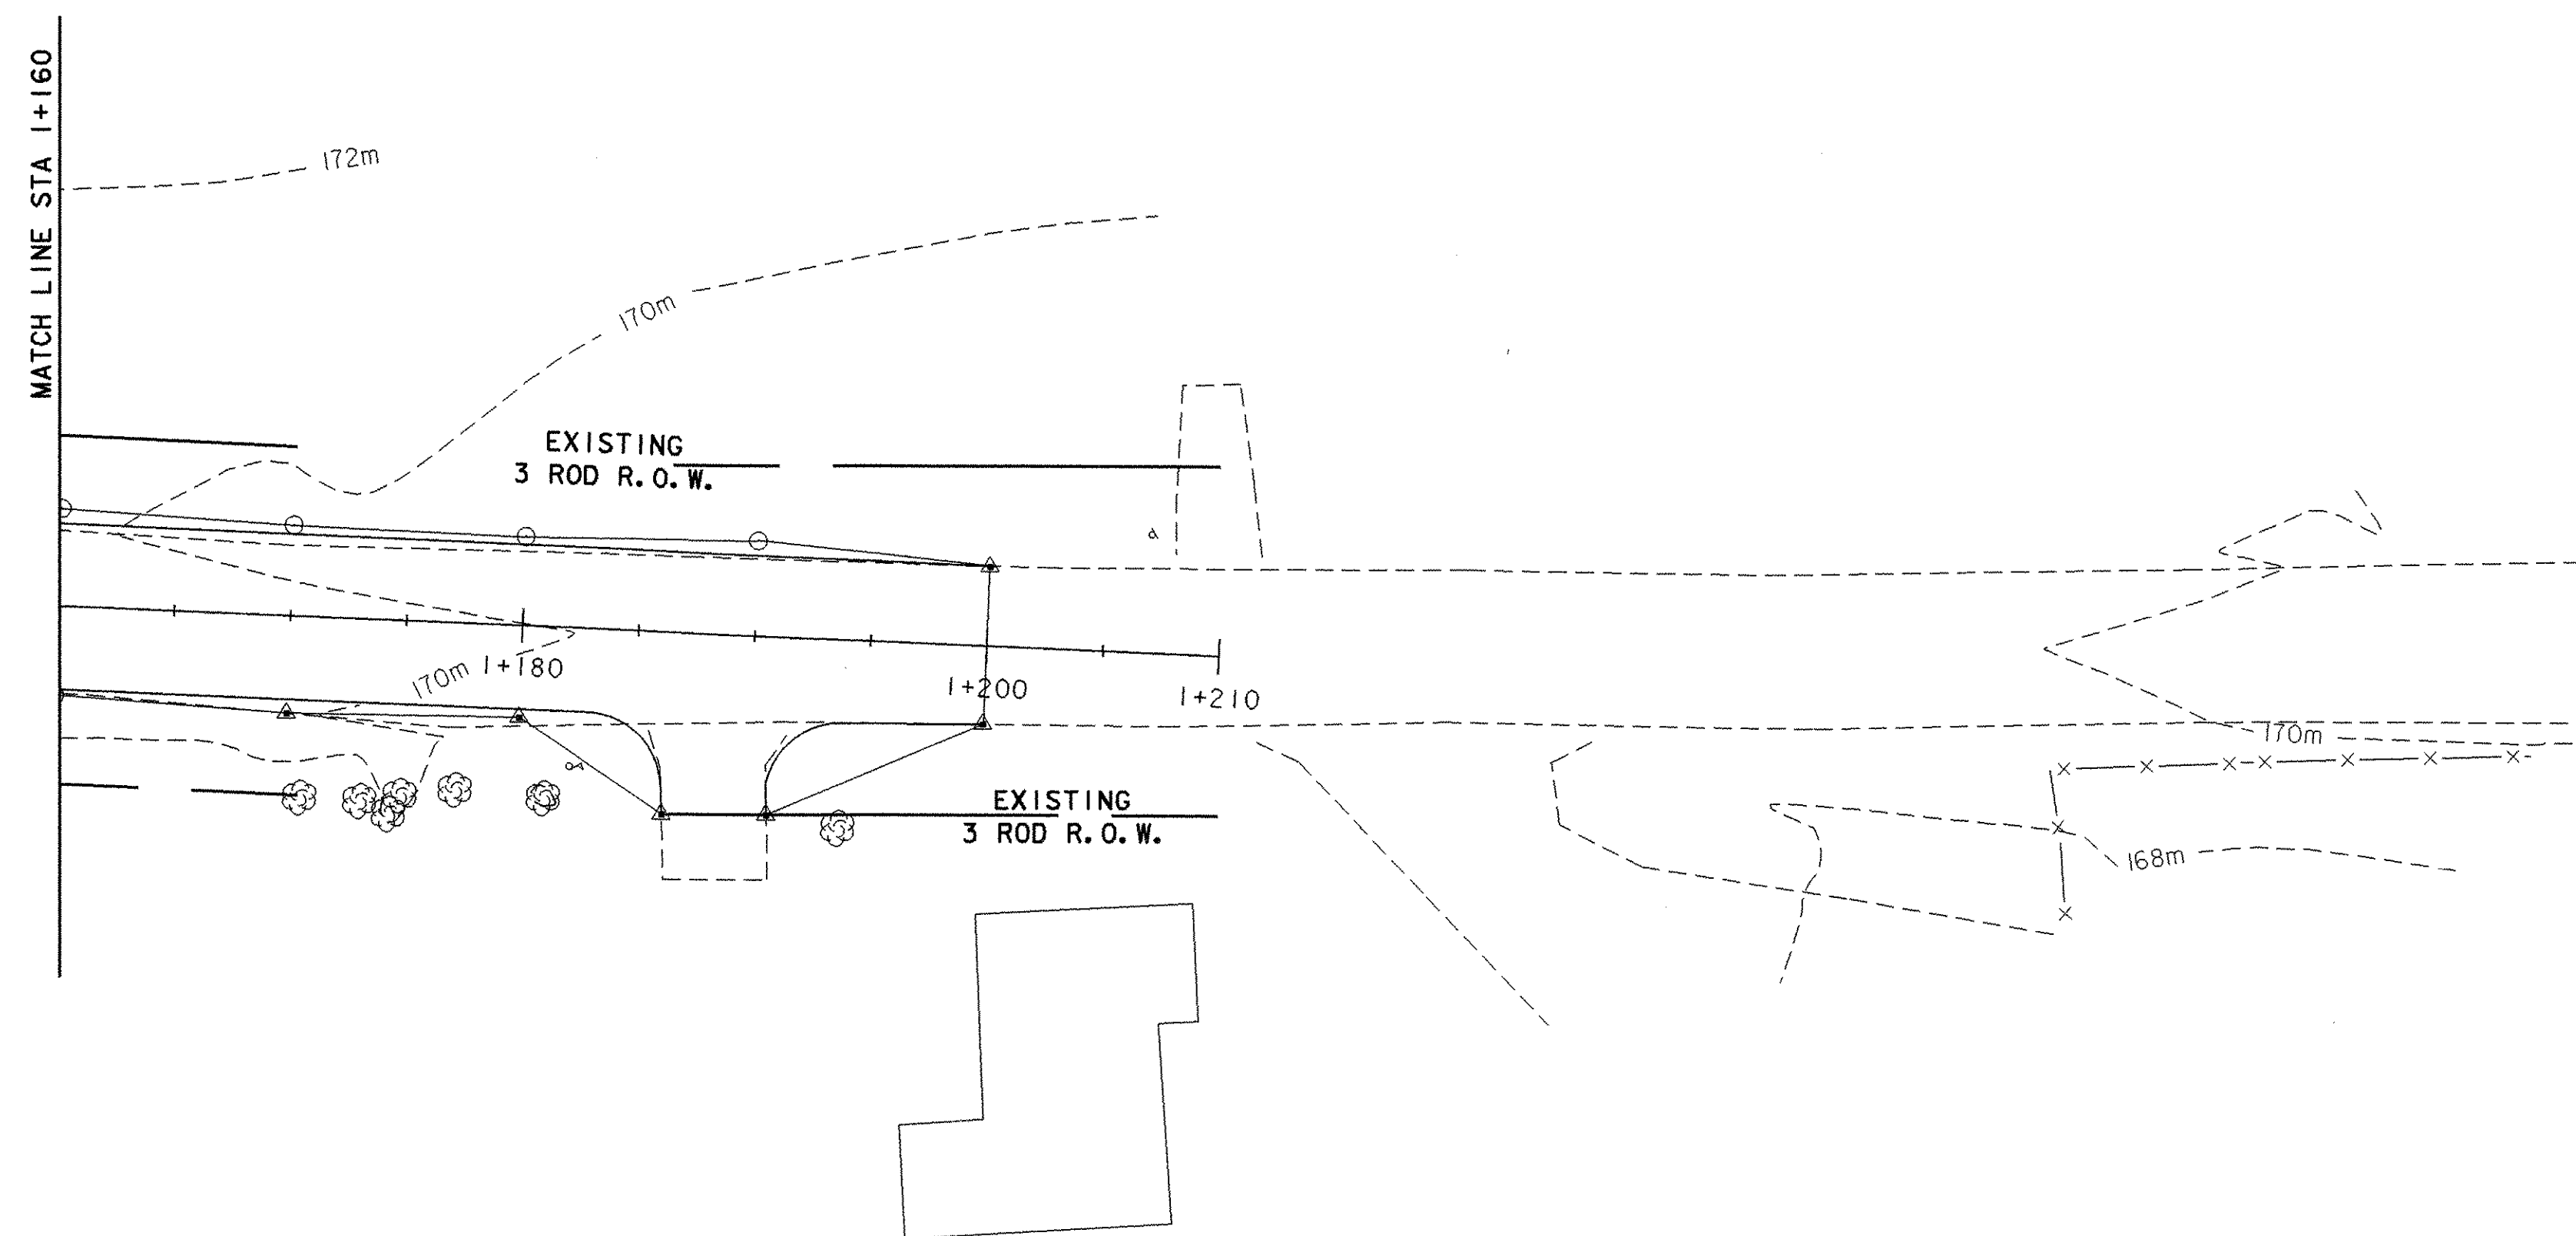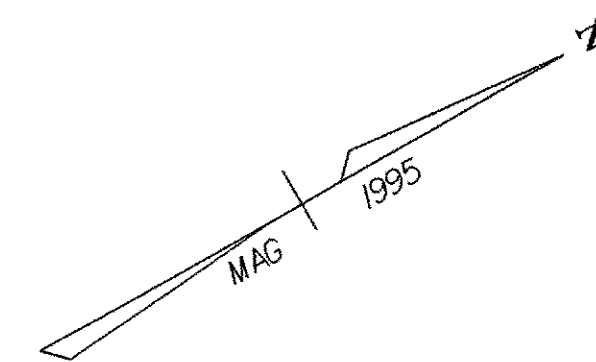

NOTE:
 CONTOURS SHOWN INDICATE THE EXISTING SITE.
 SEE CROSS SECTION AND CHANNEL SECTION SHEETS
 FOR GRADE CHANGES.

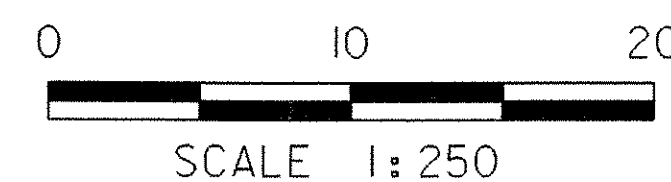

DATUM	
VERTICAL	NAVD 88
HORIZONTAL	NAD 83/92 GPS

SHEET NAME: FINAL CONDITIONS SITE PLAN #2	
PROJECT NAME: WESTFORD	HIGHWAY NO.: TH 4
PROJECT NUMBER: TH2 9436	BRIDGE NO.: 2
	OVER: ROGERS BROOK
FILE NAME: 94J122\Structures\sj122ero.dgn	PLOT DATE: 25-MAR-2005
PROJECT MANAGER: R. R. WHITCOMB	DRAWN BY: STRI
DESIGNED BY: C. CARLSON	IPARM NAME: sj122ero6.1
BRIDGE SHEET NUMBER:	SHEET 26 OF 56

**SEEDING FORMULA
RURAL AREAS**



% WT.	kg/ha	NAME	PUR %	GERM %
37.5	26.0	CREeping RED FESCUE	98	85
37.5	26.0	TALL FESCUE	95	90
5.0	4.0	RED TOP	95	90
15.0	10.0	BIRDSFOOT TREFOIL	98	85
5.0	4.0	ANNUAL RYE GRASS	95	85
100.0	70.0			

GENERAL NOTES

SEED MIXTURE: SHALL NOT HAVE A WEED CONTENT EXCEEDING 0.40% BY WEIGHT AND SHALL BE FREE OF ALL NOXIOUS SEED.

SEED: TO BE APPLIED PER SEEDING FORMULAS OR AS DIRECTED BY THE ENGINEER.


FERTILIZER: FORMULA 10-20-10, TO BE USED WITH SEED, APPLIED AT THE RATE OF 560 kg/ha. (HYDRO SEEDERS MAY USE 19-19-19 FORMULA).

AGRICULTURAL LIMESTONE: TO BE APPLIED AT THE RATE OF 4500 kg/ha, OR AS DIRECTED BY THE ENGINEER.

HAY MULCH: TO BE PLACED ON EARTH SLOPES AT THE RATE OF 4500 kg/ha, OR AS DIRECTED BY THE ENGINEER.


TOPSOIL: TO BE USED WITH SEED AS INDICATED ON THE PLANS, OR AS DIRECTED BY THE ENGINEER.

NOTE: REFER TO LATEST REVISIONS OF THE "VERMONT HANDBOOK FOR SOIL EROSION AND SEDIMENT CONTROL FOR CONSTRUCTION SITES" FOR ADDITIONAL EROSION CONTROL MEASURES.
HAY BALES AND SILT FENCE ARE NOT TO BE USED ACROSS AREAS OF CONCENTRATED FLOW.

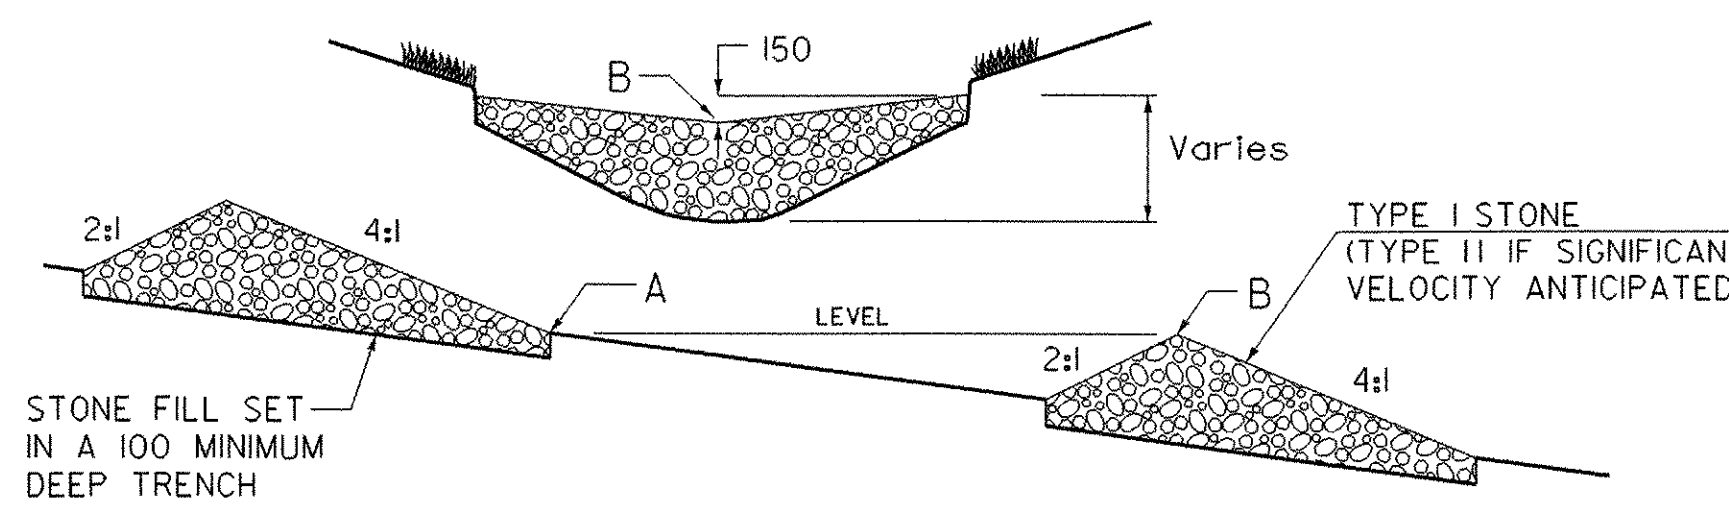


**DETAIL "B"
TEMPORARY STONE CHECK DAM**

- NOTES:
- CHECK DAMS TO BE USED DURING ESTABLISHMENT OF GRASS LINED DRAINAGE DITCHES
 - LOCATE DOWNSTREAM STRUCTURE SUCH THAT POINT "B" IS APPROXIMATELY LEVEL WITH THE LOWEST GROUND ELEVATION "A" OF THE UPSTREAM STRUCTURE.

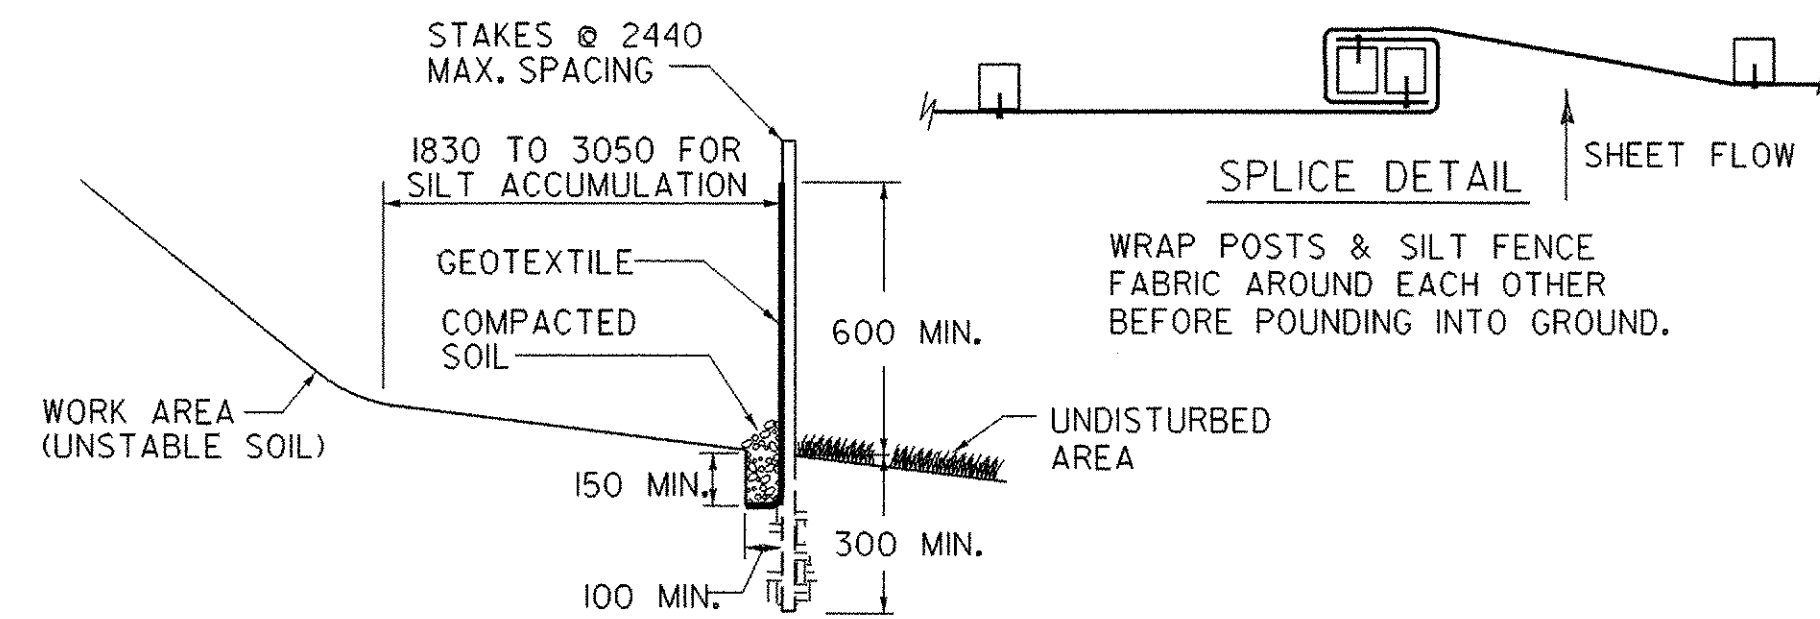

**DETAIL "A"
SILT FENCE**


- NOTES:
- DO NOT USE SILT FENCE IN STREAMS, DRAINAGE DITCHES, OR AREAS OF CONCENTRATED FLOW.
 - BACK WITH STAKED-IN-PLACE HAY BALES OR WIRE FENCE IF ADDITIONAL SUPPORT IS NEEDED.
 - MUST BE REMOVED WHEN SOIL IS STABILIZED.

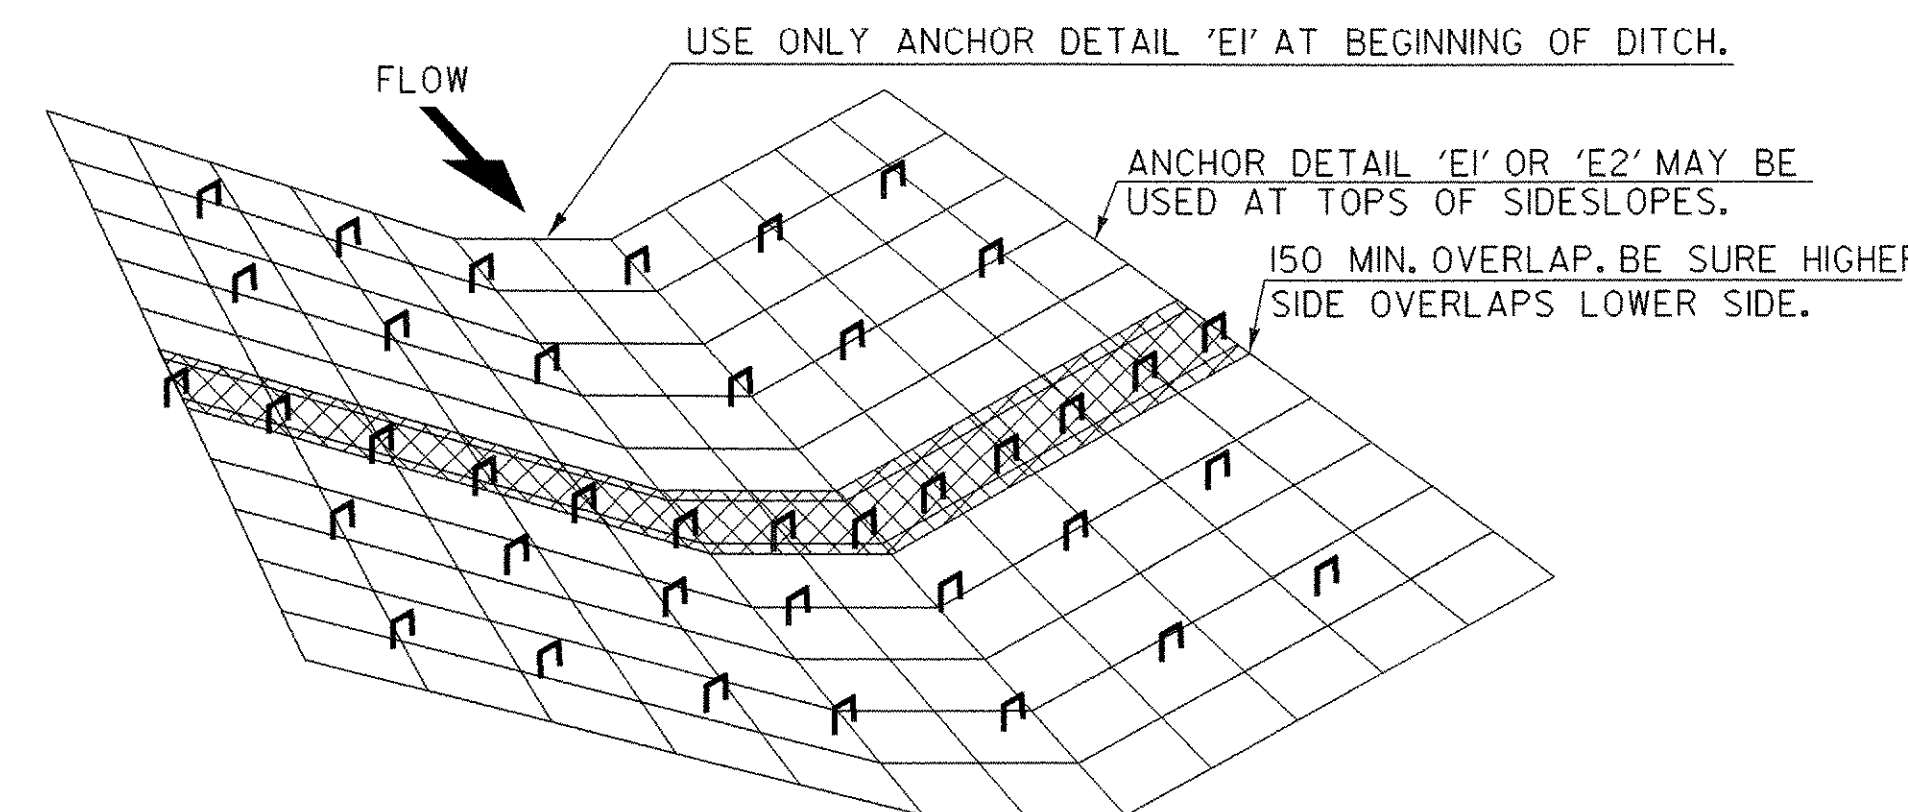

**DETAIL "D"
EROSION MATTING FOR DITCHES**


- NOTES:
- TO BE USED WHERE SLOPE OF DITCHLINE RANGES FROM 1% - 2.5%. SLOPES EXCEEDING 2.5% SHALL BE LINED WITH STONE FILL, TYPE I.
 - OVERLAPS SHALL BE 150 MINIMUM IN THE DIRECTION OF FLOW AND STAPLED EVERY 500 MIN. THROUGH BOTH FABRICS.
 - USE 1000 MAX STAPLE SPACING IN OTHER AREAS.

**DETAIL "C"
EROSION MATTING FOR SLOPES STEEPER THAN 1:3**

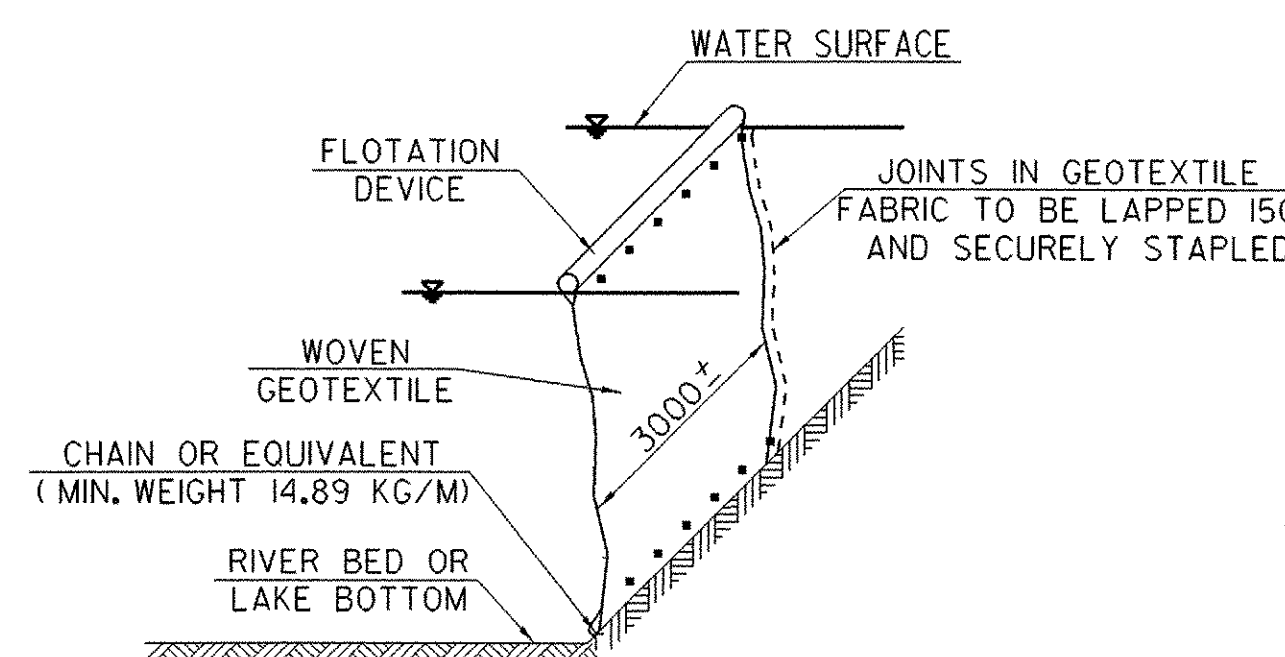


**DETAIL "F"
FILTER CURTAIN**


- NOTES:
- NOT TO BE USED ACROSS THE FLOW OF WATER
 - HEIGHT SHOULD BE SUFFICIENT TO ALLOW FOR VARIATIONS IN THE BOTTOM AND RISING WATER
 - ANCHOR FIRMLY IN PLACE AS NEEDED
 - INSTALL PRIOR TO EARTH DISTURBING ACTIVITIES AND/ OR INSTALLATION OF COFFERDAM WHERE APPLICABLE
 - LEAVE IN PLACE UNTIL UP-SLOPE AREAS ARE STABLE AND COFFERDAM IS REMOVED
 - USE CARE DURING REMOVAL TO PREVENT THE RELEASE OF CAPTURED SEDIMENT AS MUCH AS POSSIBLE

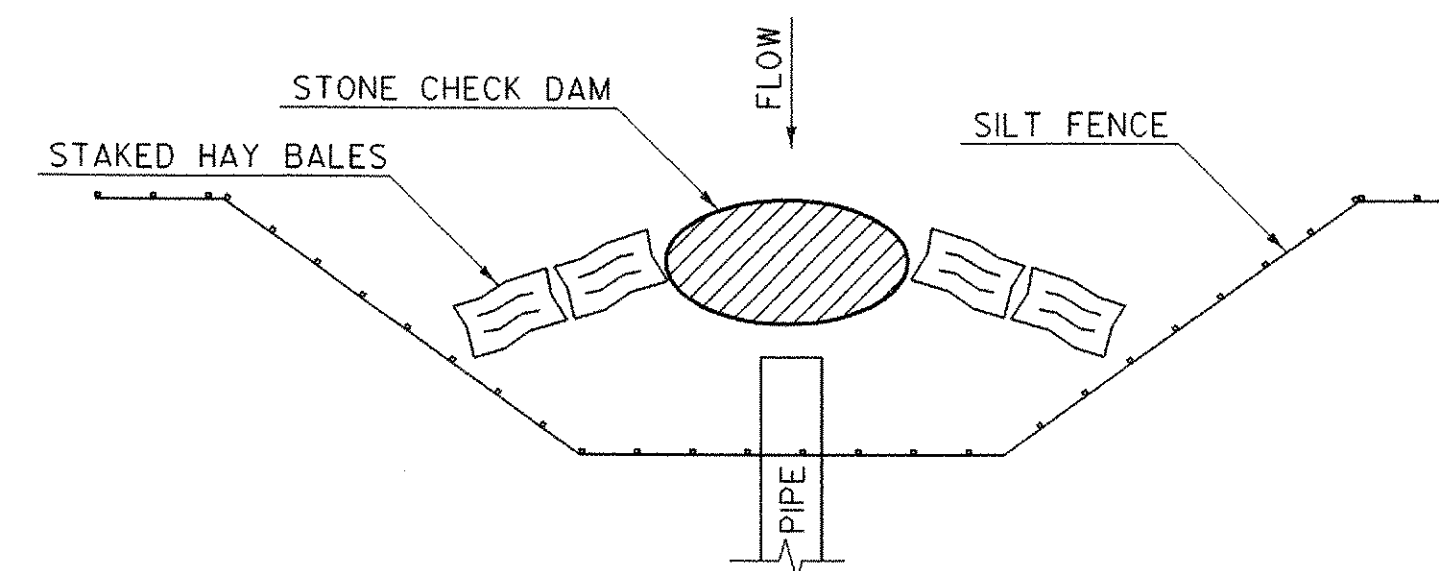

**DETAIL "G"
EXISTING PIPE INLET CONTROL**

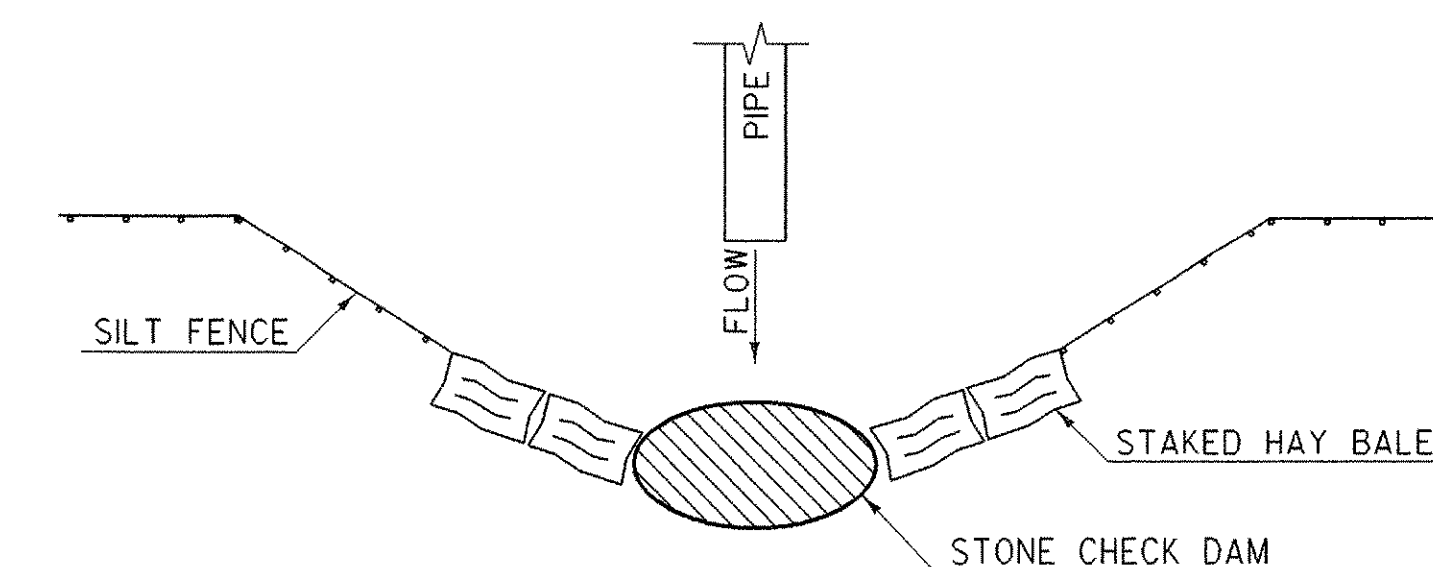

**DETAIL "H"
EXISTING PIPE OUTLET CONTROL**

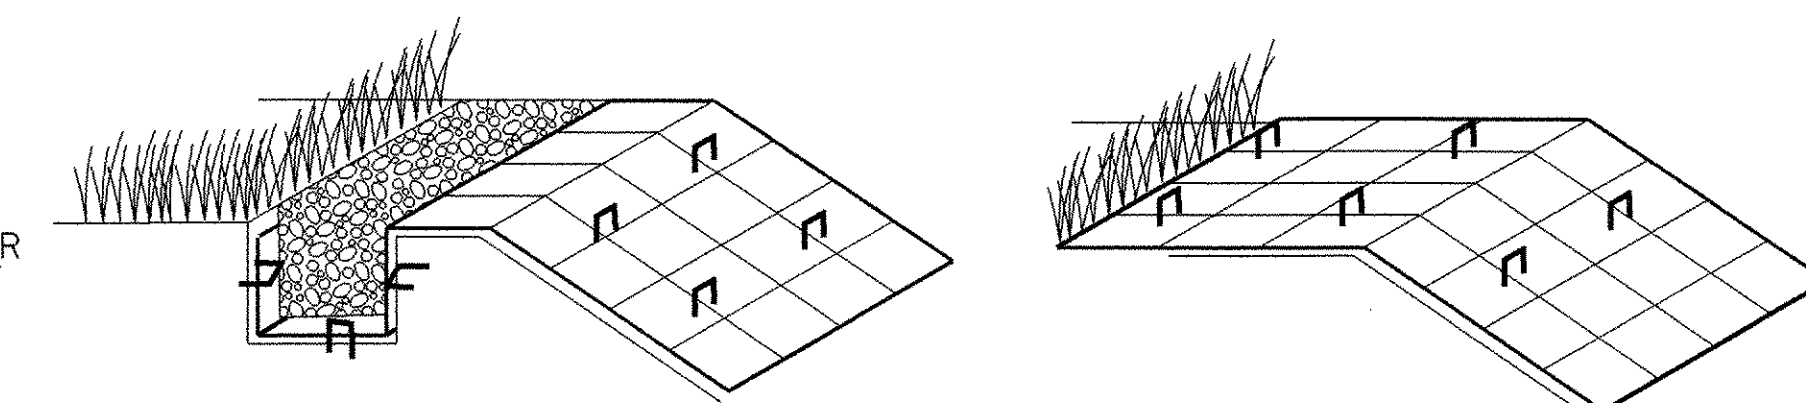


ANCHOR DETAIL "E1"

INSERT & STAPLE FABRIC INTO 150 X 150 TRENCH PRIOR TO BACKFILLING & COMPACTING SOIL. USE 3 STAPLE PATTERN EVERY 500.

ANCHOR DETAIL "E2"


IF THE TOP OF SLOPE IS RELATIVELY FLAT EXTEND MATERIAL APPROXIMATELY 600 AND STAPLE EVERY 500 MINIMUM.

**DETAIL "E"
ANCHOR DETAILS FOR EROSION MATTING**

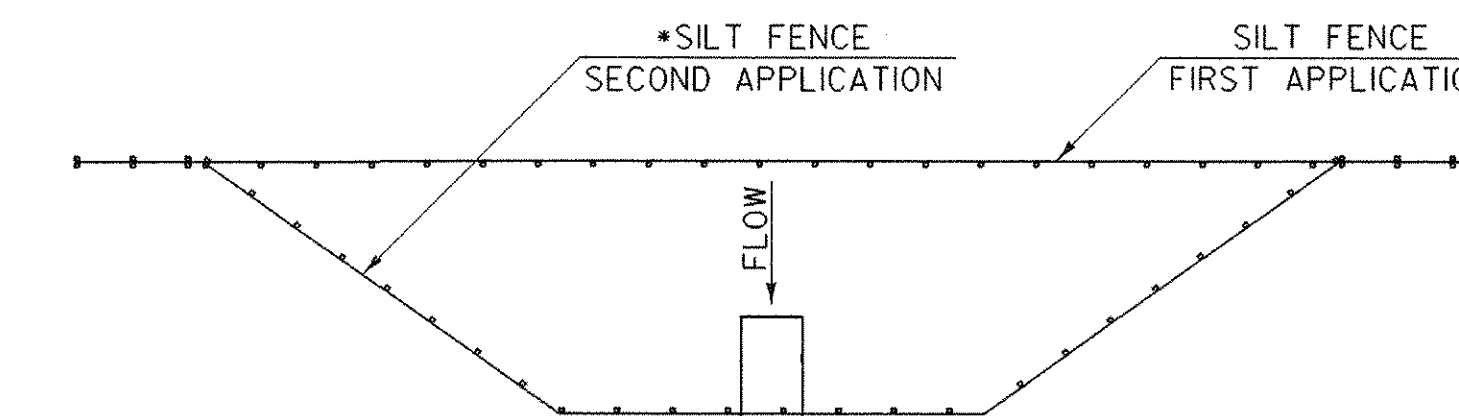

**DETAIL "I"
PROPOSED PIPE INLET CONTROL**

THE SECOND APPLICATION OF SILT FENCE IS TO BE INSTALLED (REMOVE FIRST APPLICATION PRIOR TO DIVERTING FLOW INTO NEW PIPE FOR BOTH PROPOSED INLET AND OUTLET CONTROLS)

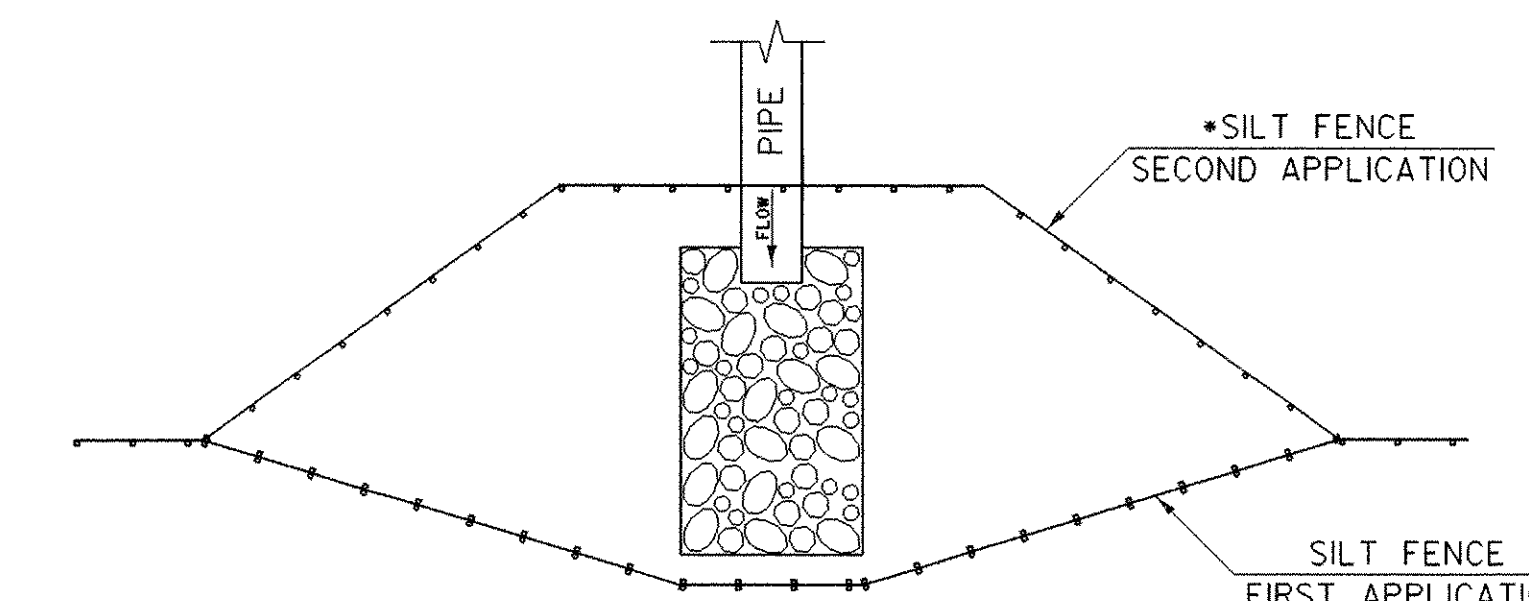

**DETAIL "J"
PROPOSED PIPE OUTLET CONTROL**

NOTE:
DETAILS NOT TO SCALE
METRIC UNITS USED

SHEET NAME: EROSION CONTROL DETAILS	
PROJECT NAME: WESTFORD	HIGHWAY NO.: TH 4
PROJECT NUMBER: TH2 9436	BRIDGE NO.: 2
	OVER: ROGERS BROOK
FILE NAME: 94J122\Structures\sj122ero.dgn	PLOT DATE: 25-MAR-2005
PROJECT MANAGER: R. R. WHITCOMB	DRAWN BY: STRI
DESIGNED BY: C. CARLSON	IPARM NAME: sj122ero7.1
BRIDGE SHEET NUMBER:	SHEET 27 OF 56

1. ALL MATERIALS AND CONSTRUCTION SHALL CONFORM TO THE AGENCY OF TRANSPORTATION'S STANDARD SPECIFICATIONS FOR CONSTRUCTION, DATED 2001, AND ITS LATEST REVISIONS, AND THE AASHTO STANDARD SPECIFICATIONS FOR HIGHWAY BRIDGES, SEVENTEENTH EDITION, AND ITS LATEST REVISIONS.
2. BRIDGE IS DESIGNED FOR MS 22.5 LIVE LOAD WITH FUTURE ALLOWANCE OF 150 mm GRAVEL.
3. IN-STREAM CONSTRUCTION SHALL BE RESTRICTED TO JUNE 1 TO OCTOBER 1, UNLESS THE CONTRACTOR OBTAINS WRITTEN PERMISSION FROM THE AGENCY OF NATURAL RESOURCES TO DO WORK OUTSIDE OF THAT TIME FACTOR.
4. THE CONTRACTOR SHALL TAKE ALL PRECAUTIONS NECESSARY TO PREVENT SILTATION OR POLLUTION, ESPECIALLY THE DISCHARGE OF RAW CONCRETE, INTO ANY BROOK, STREAM OR RIVER.
5. THE CONTRACTOR SHALL NOT REMOVE ANY MORE TREES OR BRUSH THAN IS ABSOLUTELY NECESSARY FOR SATISFACTORY CONSTRUCTION OF THE PROJECT. THE NECESSITY FOR REMOVAL SHALL BE DETERMINED BY THE RESIDENT ENGINEER. ANY TREES REMOVED ON THE KEEFE PROPERTY SHALL REMAIN THE PROPERTY OF THE KEEFE'S. THE TREES SHALL BE CUT AND THE WOOD STACKED AT A LOCATION ON THE KEEFE'S PROPERTY TO BE DETERMINED BY THE RESIDENT ENGINEER AND THE KEEFE'S. THIS WORK SHALL BE INCIDENTAL TO THE ITEM "CLEARING AND GRUBBING (INCL. IND. TREES & STUMPS)".
6. A) THE EXISTING WINGWALLS AND ABUTMENTS AT ABUTMENT NO. 1 & 2 SHALL BE REMOVED UNDER THE ITEMS, "COFFERDAM EXCAVATION, EARTH" AND "COFFERDAM EXCAVATION, ROCK". ANY PORTIONS OF THE EXISTING WINGWALLS/ABUTMENT THAT FALLS OUTSIDE OF THOSE LIMITS SHALL BE REMOVED TO 300 mm BELOW THE FINISHED CHANNEL GRADE OR TO LEDGE AND PAID FOR UNDER THE ITEM "UNCLASSIFIED CHANNEL EXCAVATION".

B) THE CONTRACTOR SHALL USE EXTREME CARE WHEN WORKING NEAR THE LAID UP STONE WALL NEAR WINGWALL NO. 3 THAT FALLS OUTSIDE THE CONSTRUCTION LIMITS. ANY DAMAGE TO THE WALL WILL BE REPAIRED AT THE CONTRACTOR'S EXPENSE.
7. ITEM, 529.20, "PARTIAL REMOVAL OF STRUCTURE" WILL INCLUDE THE REMOVAL OF THE EXISTING SUPERSTRUCTURE AND CURB/RAIL DOWN TO THE EXISTING BRIDGE SEAT ELEVATIONS.
8. ALL DIMENSIONS ARE HORIZONTAL OR VERTICAL AND ARE GIVEN AT 20 DEGREES C UNLESS OTHERWISE NOTED.
9. SPLICE DETAILS FOR THE HANDRAIL ARE ON SHEET 31 OF THE PLANS.
10. TEMPORARY FENCING SHALL BE PLACED BETWEEN STATIONS 1+000 LT - 1+060 RT, STATIONS 1+093 LT - 1+126LT AND STATIONS 1+025 RT - SIDELINE STA 9+045 RT TO RESTRICT ACCESS TO TWO AREAS THAT ARE ARCHAEOLOGICALLY SENSITIVE. THIS WORK WILL BE PAID FOR AS ITEM 620.70, "SNOW FENCE" (MOD. - ARCH).
11. THE EXISTING STONE WALKWAY LOCATED AT STA. 1 + 129.6 RT SHALL BE REMOVED. A NEW WALKWAY WILL BE INSTALLED AT THE SAME LOCATION AND AS DIRECTED BY THE ENGINEER. THIS WORK WILL BE PAID FOR UNDER ITEM 618.10, "PORTLAND CEMENT CONCRETE SIDEWALK 125 mm (MOD.). SEE SHEET 48 FOR ADDITIONAL DETAILS.
12. A) THERE WILL BE 2 - (50 - 75 mm CALIPER) SUGAR MAPLE TREES PLANTED AT APPROXIMATELY STATIONS 1+067.3 LT AND 1+079.5 LT. THE EXACT LOCATIONS SHALL BE DETERMINED BY THE RESIDENT ENGINEER AND THE PROPERTY OWNER. THE APPROXIMATE LOCATIONS OF THESE TREES ARE SHOWN ON SHEET 8. THE TREES WILL BE PAID FOR UNDER THE ITEM 656.30, "DECIDUOUS TREES (SUGAR MAPLE ACER SACCHARUM, B&B, 50 - 75 mm CAL.)".

B) THERE WILL BE 2 - (1.5 - 2.0 M) WHITE SPRUCE TREES PLANTED AT APPROXIMATELY STATIONS 1+113 RT AND 1+107 RT. THE EXACT LOCATIONS SHALL BE DETERMINED BY THE RESIDENT ENGINEER AND THE PROPERTY OWNER. THE APPROXIMATE LOCATIONS OF THESE TREES ARE SHOWN ON SHEET 8. THE TREES WILL BE PAID FOR UNDER THE ITEM 656.20, "EVERGREEN TREES (WHITE SPRUCE, PICEA GLAUCA, B&B, 1.5 - 2.0 M)".

CONCRETE

13. THE HEIGHT OF FILL BEHIND ABUTMENTS WILL BE LIMITED TO THE BRIDGE SEAT ELEVATION UNTIL THE DECK HAS BEEN POURED AND THE CURING PERIOD IS UP.
14. THE KEY IN CONCRETE CONSTRUCTION JOINTS SHALL BE MONOLITHIC AND CONTINUOUS FOR THE FULL LENGTH OF THE JOINT, ANY UPWARD KEY SHALL BE PLACED INTEGRALLY WITH THE CONCRETE BELOW THE JOINT.
15. ALL EXPOSED EDGES OF CONCRETE SHALL BE CHAMFERED 25 mm BY 25 mm.
16. JOINTS AND SCORE MARKS IN CONCRETE SHALL BE CONSTRUCTED AS INDICATED ON THE PLANS OR AS DIRECTED BY THE ENGINEER.
17. ALL REINFORCING STEEL SHALL BE DETAILED AND FABRICATED USING PROCEDURES AND TOLERANCES IN ACCORDANCE WITH APPLICABLE PUBLICATIONS OF THE CONCRETE REINFORCING STEEL INSTITUTE (CRSI).
18. REINFORCING PLACEMENT TOLERANCES SHALL BE:
SPACING +/- 25 mm
CLEARANCE +/- 5 mm

19. MINIMUM COVER FOR REINFORCING STEEL SHALL BE 50 mm ALONG THE BACK FACES OF WALLS AGAINST EARTH AND ALONG THE BOTTOM SURFACE OF THE DECK AND 80 mm ELSEWHERE, UNLESS OTHERWISE NOTED.
20. WATER REPELLENT (MOD-SILANE) SHALL BE APPLIED TO ALL EXPOSED CONCRETE SURFACES EXCEPT THE UNDERSIDE OF THE DECK BETWEEN THE DRIP BEADS.
21. THE CONCRETE SLAB AND SUBSTRUCTURE CONCRETE SHALL BE HIGH PERFORMANCE CONCRETE, CLASS B. THE CONCRETE CURBS SHALL BE HIGH PERFORMANCE CONCRETE, CLASS B (MOD.).

LEDGE

22. FOOTINGS SHALL BE PLACED ON SOUND, CLEAN LEDGE, ALL OVER BREAKAGE BELOW INDICATED BOTTOM OF FOOTING SHALL BE REPLACED WITH "HIGH PERFORMANCE CONCRETE, CLASS B." A MAXIMUM OF 150 mm AVERAGE DEPTH SHALL BE PAID FOR AS "HIGH PERFORMANCE CONCRETE, CLASS B.". ANY ADDITIONAL CONCRETE REQUIRED SHALL BE PLACED AT THE CONTRACTOR'S EXPENSE. THE QUANTITIES SHOWN FOR "HIGH PERFORMANCE CONCRETE, CLASS B" AND "COFFERDAM EXCAVATION, ROCK" INCLUDES THE ADDITIONAL VOLUMES THAT MAY BE INCURRED DUE TO THE OVER BREAKAGE.
23. WHEN SOUND LEDGE IS ENCOUNTERED, PROFILES OF THE LEDGE SHALL BE SUBMITTED TO THE STRUCTURES SECTION TO DETERMINE WHETHER THE FOOTINGS FOR THE ABUTMENTS NEED TO BE ADJUSTED. NO FURTHER WORK SHALL BE DONE ON THE FOOTINGS UNTIL A REPLY IS RECEIVED FROM THE STRUCTURES SECTION.

TEMPORARY DETOUR

24. THE WOODS HOLLOW BRIDGE ROAD (TH 4) SHALL BE CLOSED TO THROUGH TRAFFIC DURING CONSTRUCTION.
25. THE CONTRACTOR SHALL NOTIFY THE TOWN CLERK OF WESTFORD AT (802) 878-4597 A MINIMUM OF TWO(2) WEEKS PRIOR TO CLOSING THE ROADS.
26. A) THE CONTRACTOR WILL BE RESPONSIBLE FOR INSTALLING AND MAINTAINING THE DETOUR SIGNS FOR THE CLOSURE OF THE BRIDGE. THE DETOUR SIGN PACKAGE IS SHOWN ON SHEETS 14-15. ALL SIGNS MUST BE INSTALLED PRIOR TO CLOSURE OF THE BRIDGE. THIS WORK WILL BE PAID FOR UNDER THE ITEMS 675.20, "TRAFFIC SIGNS, TYPE A (MOD) AND 675.301, "FLANGED CHANNEL SIGN POST (MOD)".



B) THE INSTALLATION OF THE DETOUR SIGNS AND ANY ADDITIONAL SIGNS NOT INCLUDED IN THE DETOUR PLAN BUT DEEMED NECESSARY BY THE RESIDENT ENGINEER SHALL BE PAID FOR AS ITEMS, 675.20, "TRAFFIC SIGNS, TYPE A (MOD)" AND 675.301, "FLANGED CHANNEL SIGN POST (MOD)."

C) ALL DETOUR SIGNS AND POSTS SHALL BE REMOVED BY THE CONTRACTOR AT THE END OF THE PROJECT OR AS DIRECTED BY THE ENGINEER. THE SIGNS AND POSTS WILL BECOME THE PROPERTY OF THE CONTRACTOR. THIS WORK WILL BE INCIDENTAL TO ITEMS 675.20, "TRAFFIC SIGNS, TYPE A (MOD)" AND 675.301, "FLANGED CHANNEL SIGN POST (MOD)".
27. IF THE CONTRACTOR HAS TO REMOVE AND RESET DETOUR SIGNS DUE TO INCORRECT PLACEMENT OR SIGHT DISTANCE PROBLEMS AS DEEMED BY THE ENGINEER, THE WORK NECESSARY TO COMPLETE THIS TASK WILL BE INCIDENTAL TO THE ITEM 641.10, "TRAFFIC CONTROL".
28. THE REMOVAL, COVERING AND/OR RESETTING OF EXISTING TRAFFIC SIGNS, AS DEEMED NECESSARY BY THE RESIDENT ENGINEER, WILL BE CONSIDERED INCIDENTAL TO ITEM 641.10, "TRAFFIC CONTROL".
29. THE COST OF ALL ON-PROJECT CONSTRUCTION SIGNING AND BARRICADES SHALL BE INCIDENTAL TO ITEM 641.10, "TRAFFIC CONTROL".
30. ACCESS TO DRIVES SHALL BE MAINTAINED. WHEN THE CONTRACTOR MUST TEMPORARILY RESTRICT ACCESS TO THE DRIVES, THE CONTRACTOR SHALL NOTIFY THE PROPERTY OWNERS IN ADVANCE. THIS WORK WILL BE PAID FOR UNDER THE ITEM 641.10, "TRAFFIC CONTROL".

MISCELLANEOUS


31. EXISTING TRAFFIC SIGNS (MARKED FOR REMOVAL) AND SIGN POSTS (AS SHOWN ON SHEETS 40 AND 41) SHALL BE REMOVED AND STOCKPILED ON THE PROJECT. THEY WILL REMAIN THE PROPERTY OF THE TOWN. THE CONTRACTOR SHALL BE PREPARED TO LOAD THE SIGNS ON TRUCKS FURNISHED AT THE SITE BY THE TOWN FOR REMOVAL FROM THE SITE BY THE TOWN. NOTIFICATION MUST BE GIVEN ONE WEEK IN ADVANCE TO THE TOWN INDICATING WHEN THE MATERIAL WILL BE AVAILABLE. CONTACT GARY ESTUS, ROAD FOREMAN AT (802) 879-4306. THIS WORK WILL BE PAID FOR UNDER THE ITEM 675.50, "REMOVING SIGNS".

PROJECT NAME:	WESTFORD		
PROJECT NUMBER:	TH2 9436		
FILE NAME:	194j122Structures1j122gen.xls	PLOT DATE:	3/23/2005
PROJECT MANAGER:	R. R. WHITCOMB	DRAWN BY:	J. GILMORE
DESIGNED BY:	C. CARLSON	CHECKED BY:	C. CARLSON
GENERAL NOTES SHEET			SHEET 29 OF 56

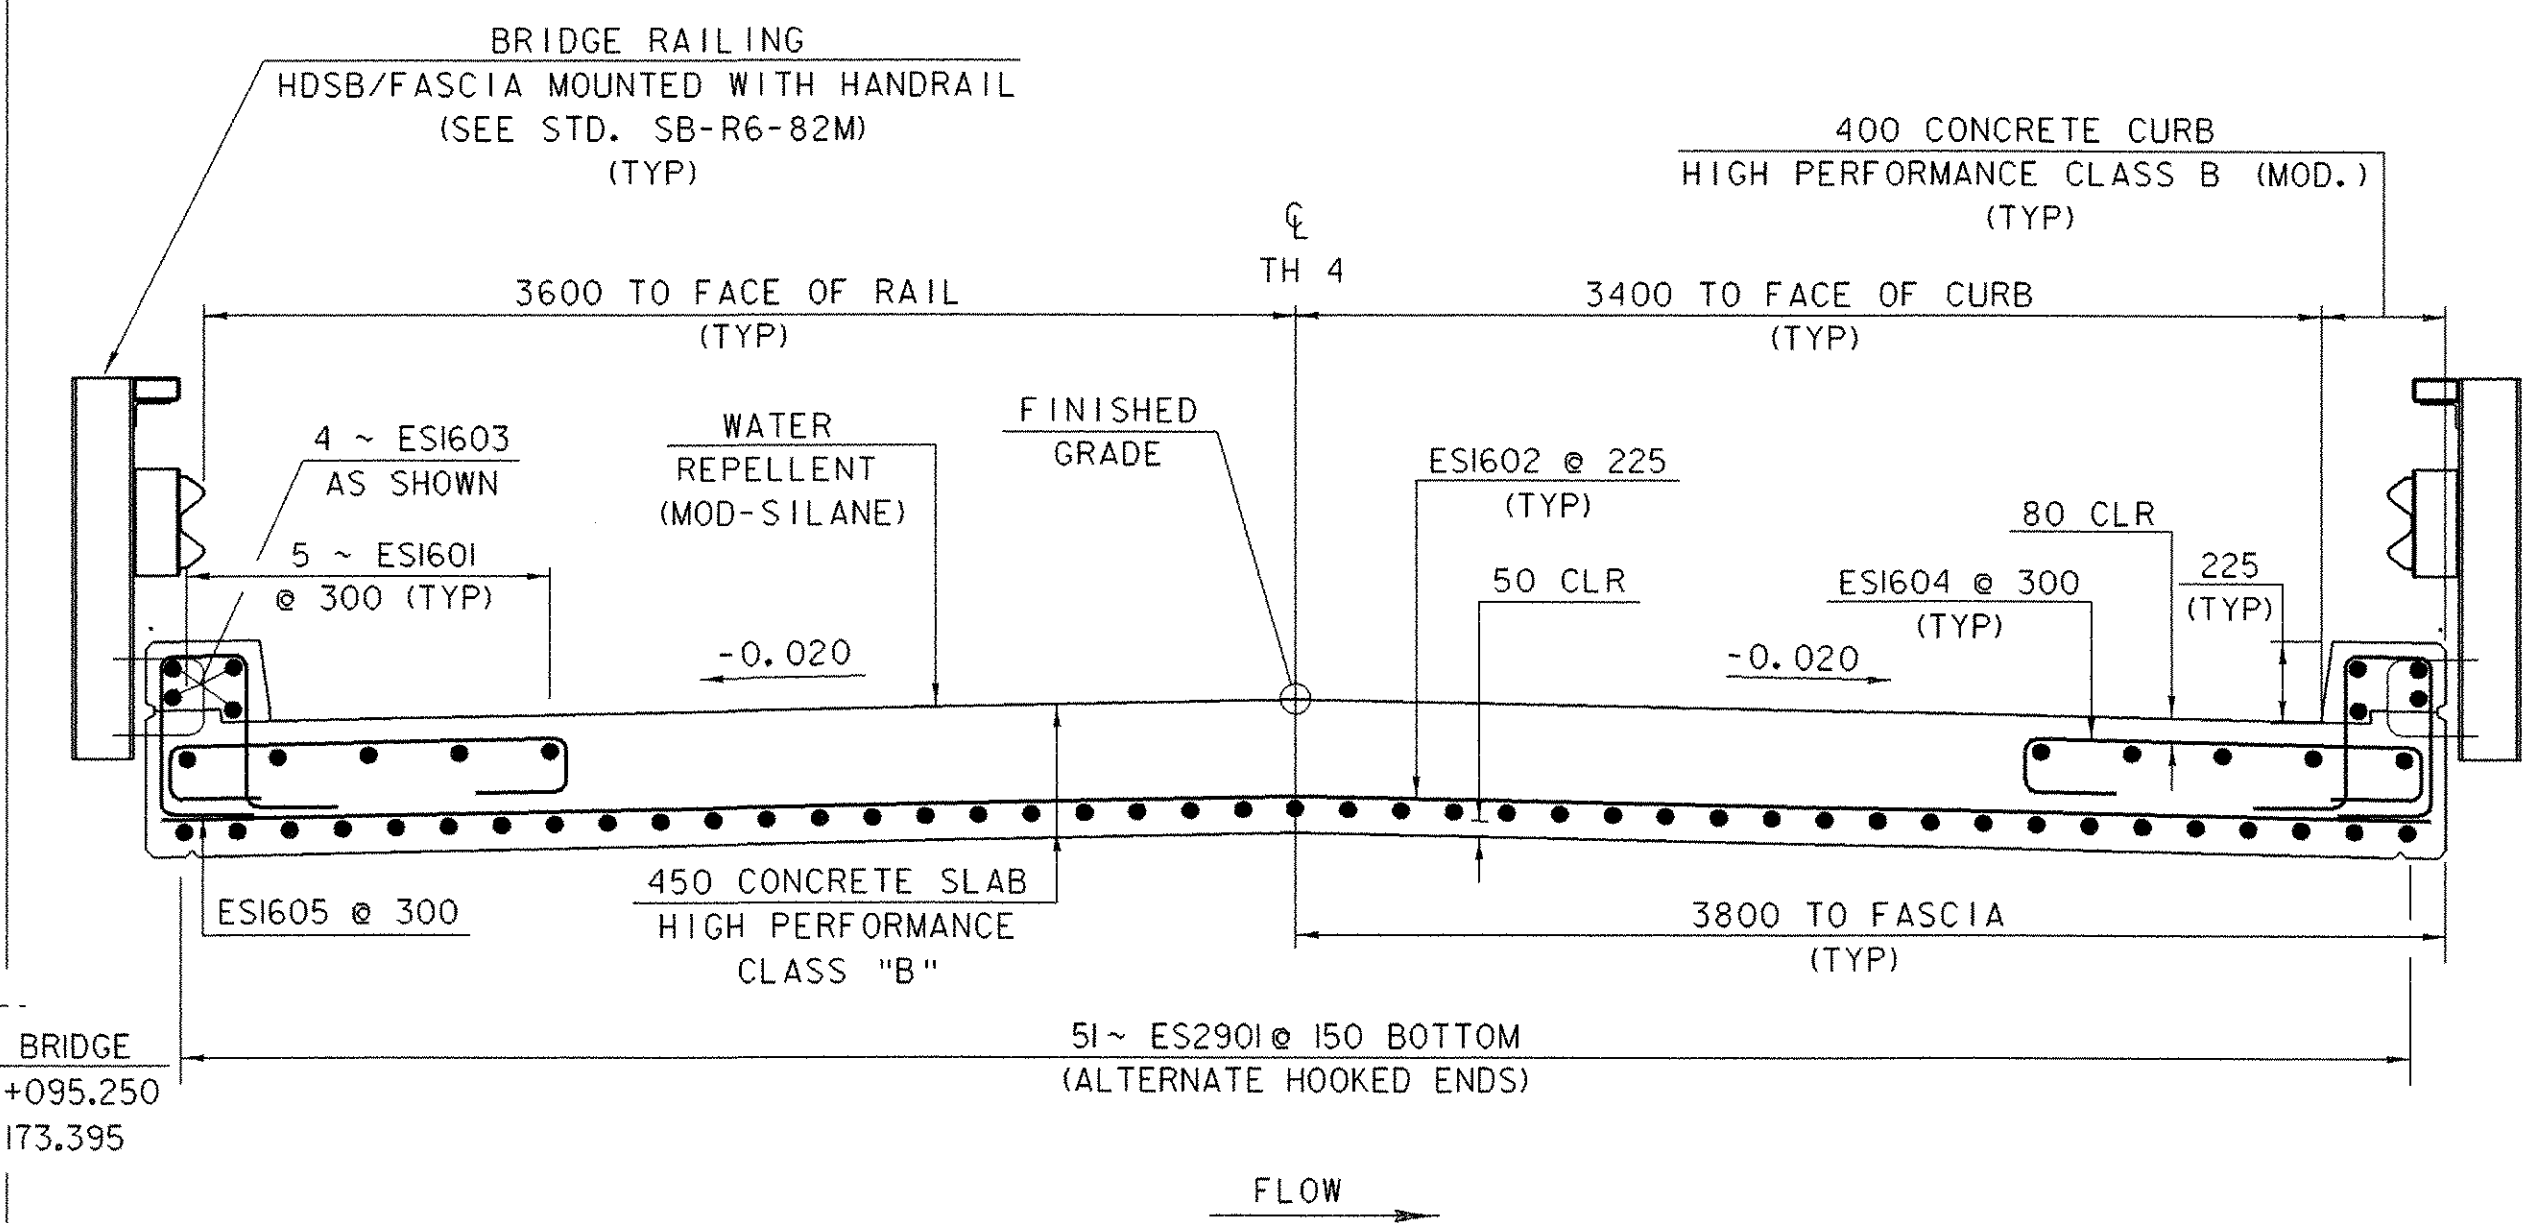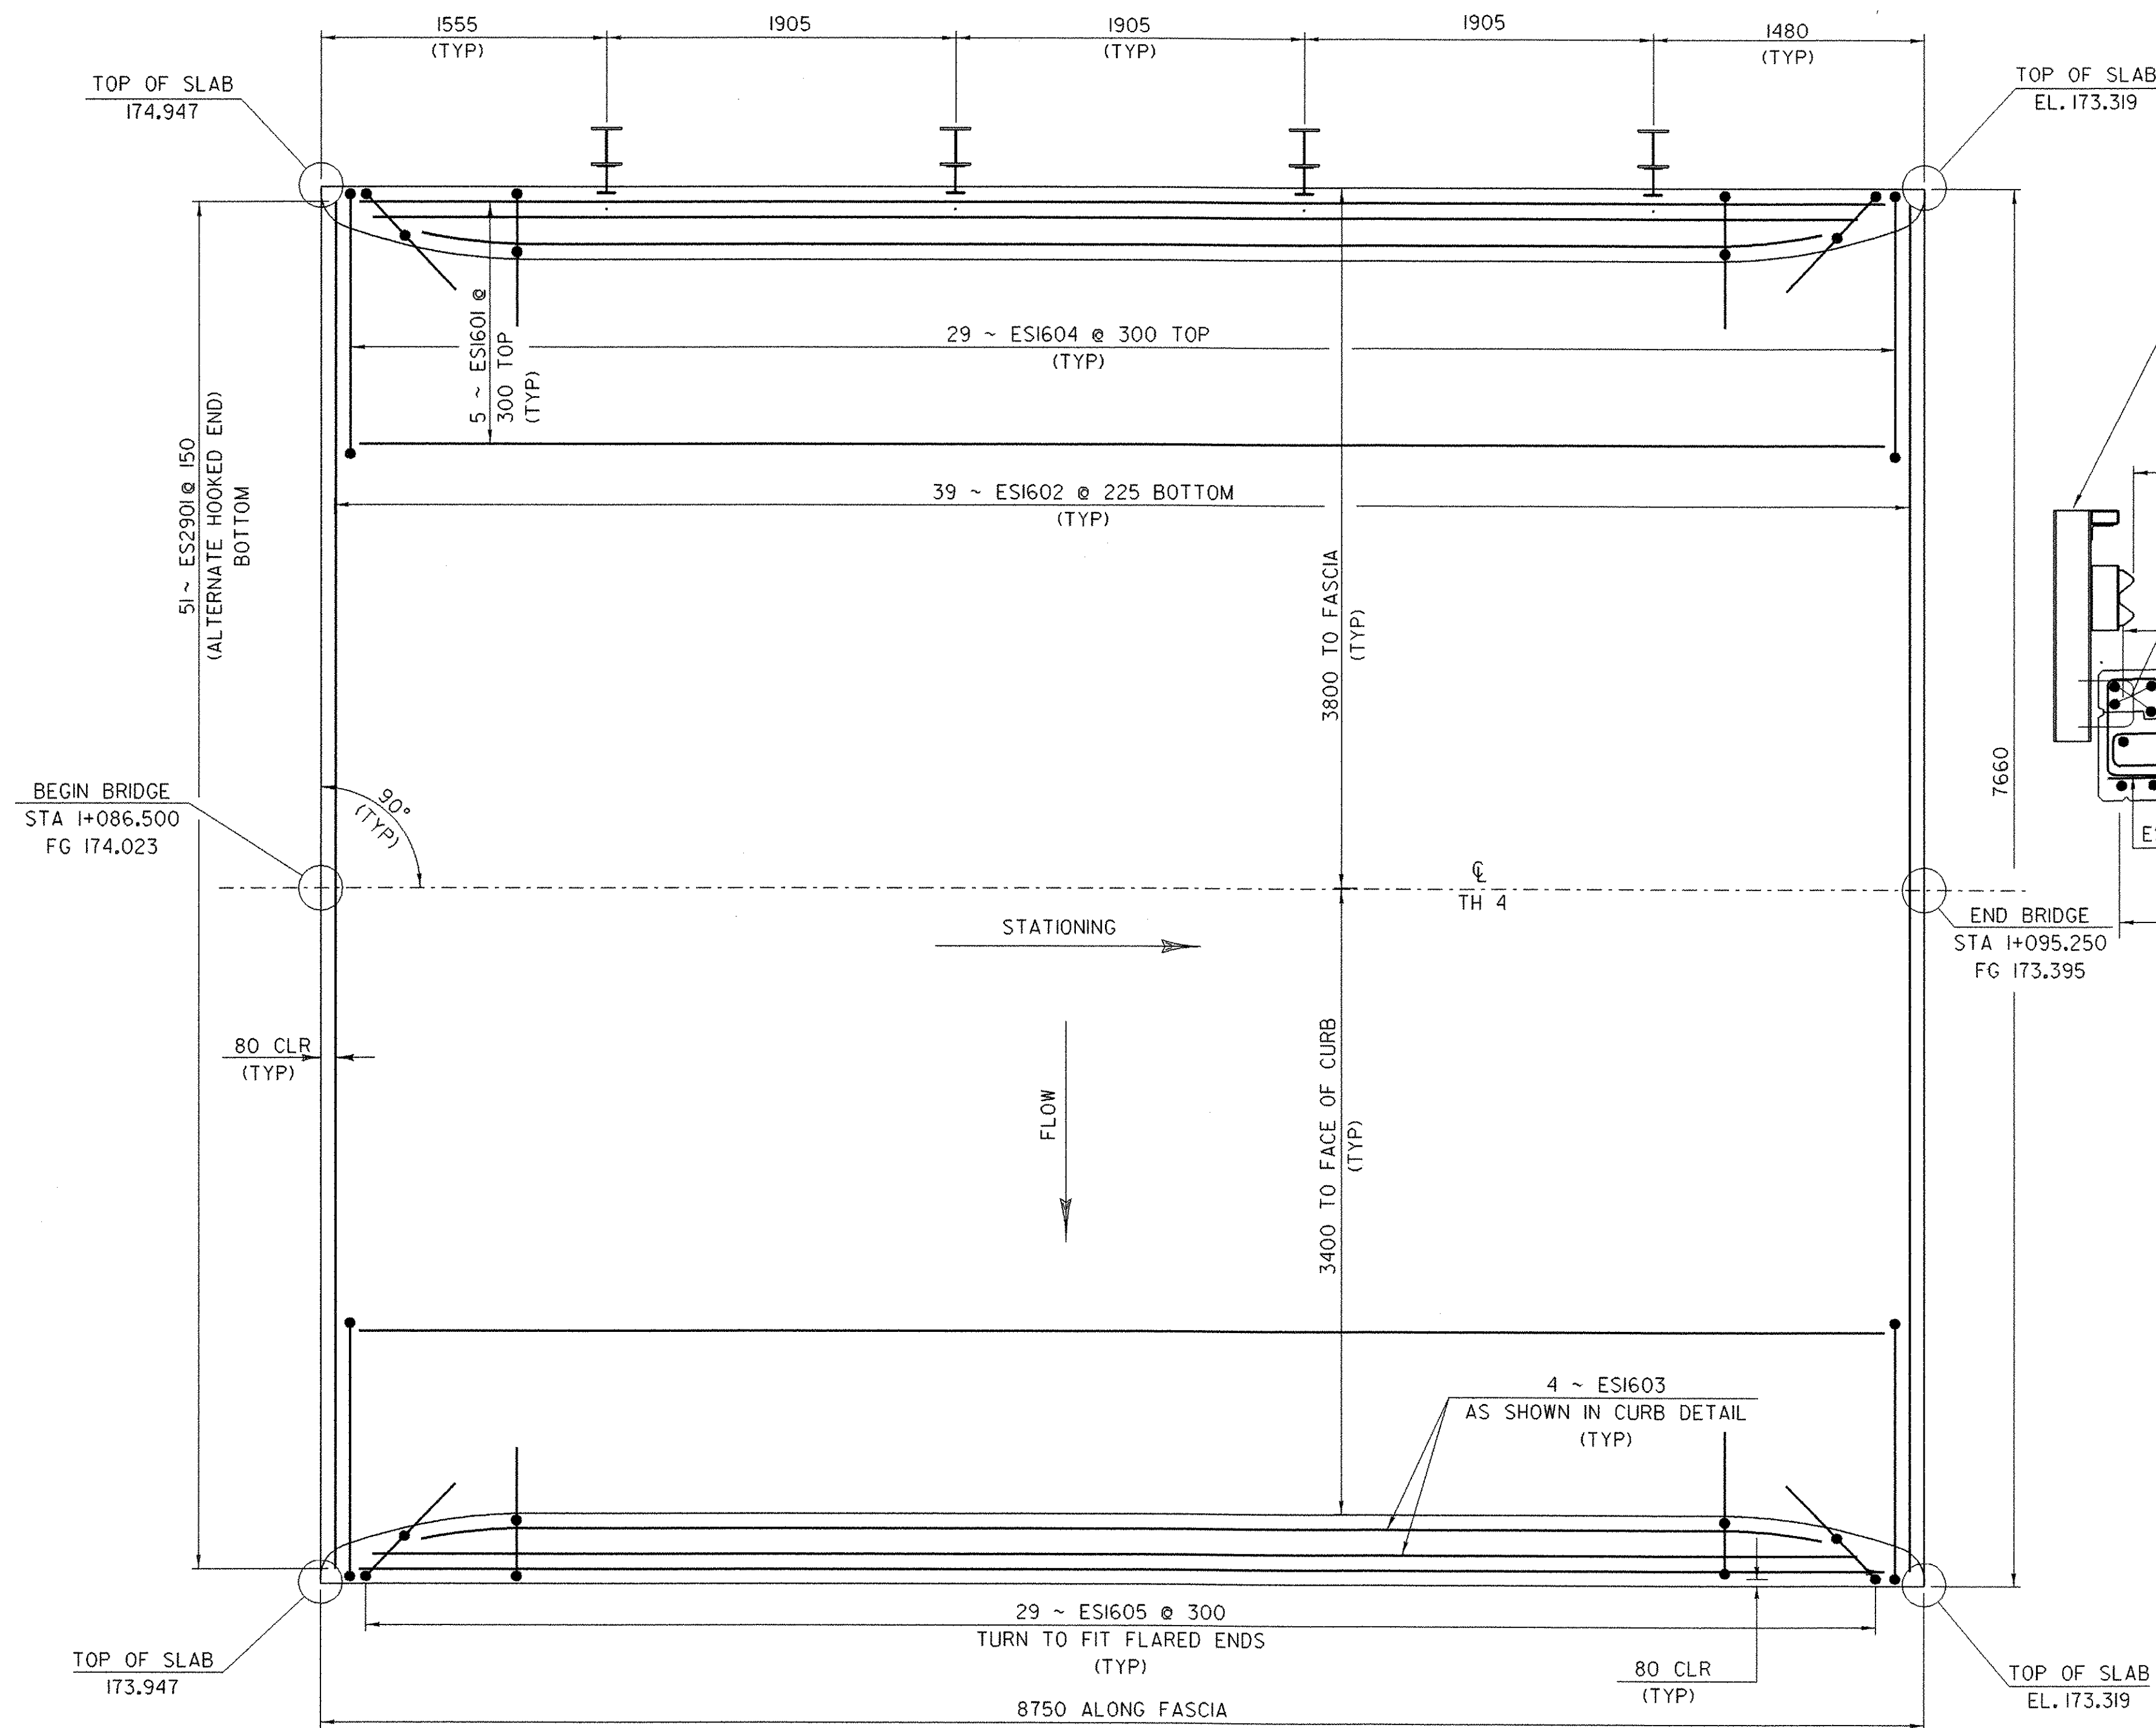


NOTES:

1. THE SLAB SHALL BE CAMBERED A TOTAL OF 41mm AT MIDSPAN. THIS CAMBER SHALL APPROXIMATE A CIRCULAR CURVE.
2. THE CONCRETE DECK SHALL BE BROOM FINISHED NORMAL TO CENTERLINE.
3. THE COST OF THE TAR PAPER AND PIPE INSULATION AND THEIR APPLICATIONS SHALL BE INCIDENTAL TO THE ITEM 501.34 "CONCRETE, HIGH PERFORMANCE CLASS B."
4. ▲ DENOTES CUT TO FIT IN FIELD.
5. THE "E" AND "AE" PREFIX DENOTES EPOXY COATED REINFORCING STEEL.

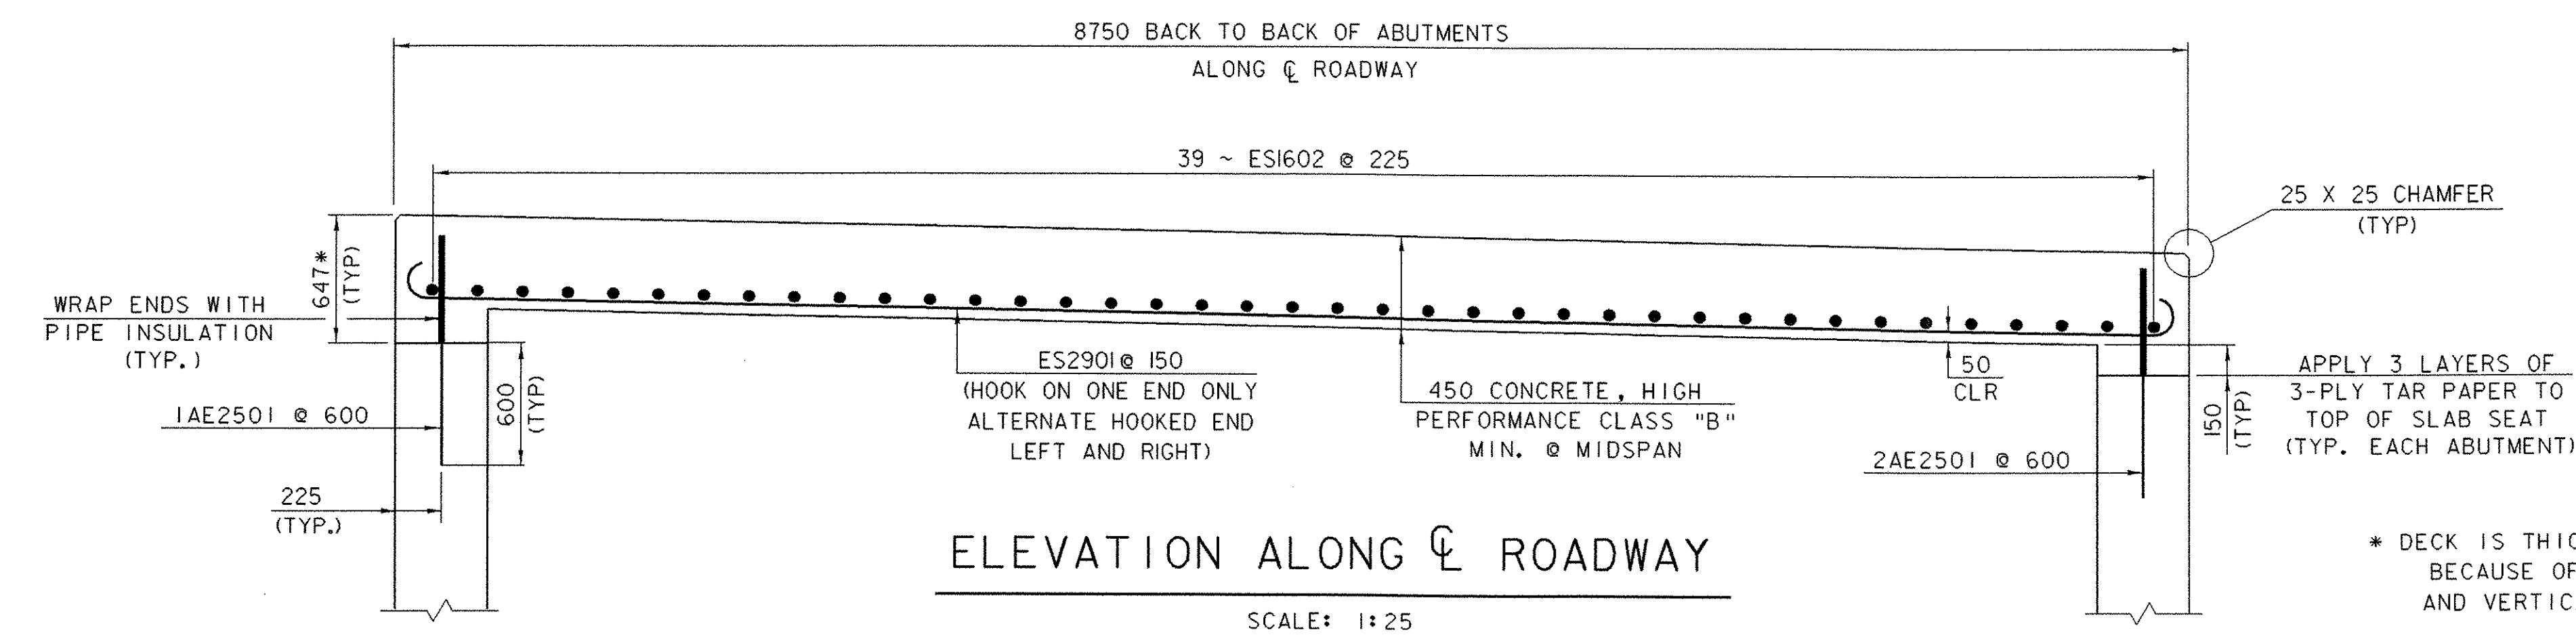


SCALE = 1:25

SHEET NAME: SLAB DETAILS		
PROJECT NAME: WESTFORD	HIGHWAY NO.: TH 4	
PROJECT NUMBER: TH2 9436	BRIDGE NO.: 2	
	OVER: ROGERS BROOK	
FILE NAME: 94J22\Structures\sj22sup.dgn	PLOT DATE: 25-MAR-2005	
PROJECT MANAGER: R. R. WHITCOMB	DRAWN BY: T. FILLBACH	
DESIGNED BY: T. FILLBACH	IPARM NAME: sj22sb.1	
BRIDGE SHEET NUMBER:	SHEET 30 OF 56	

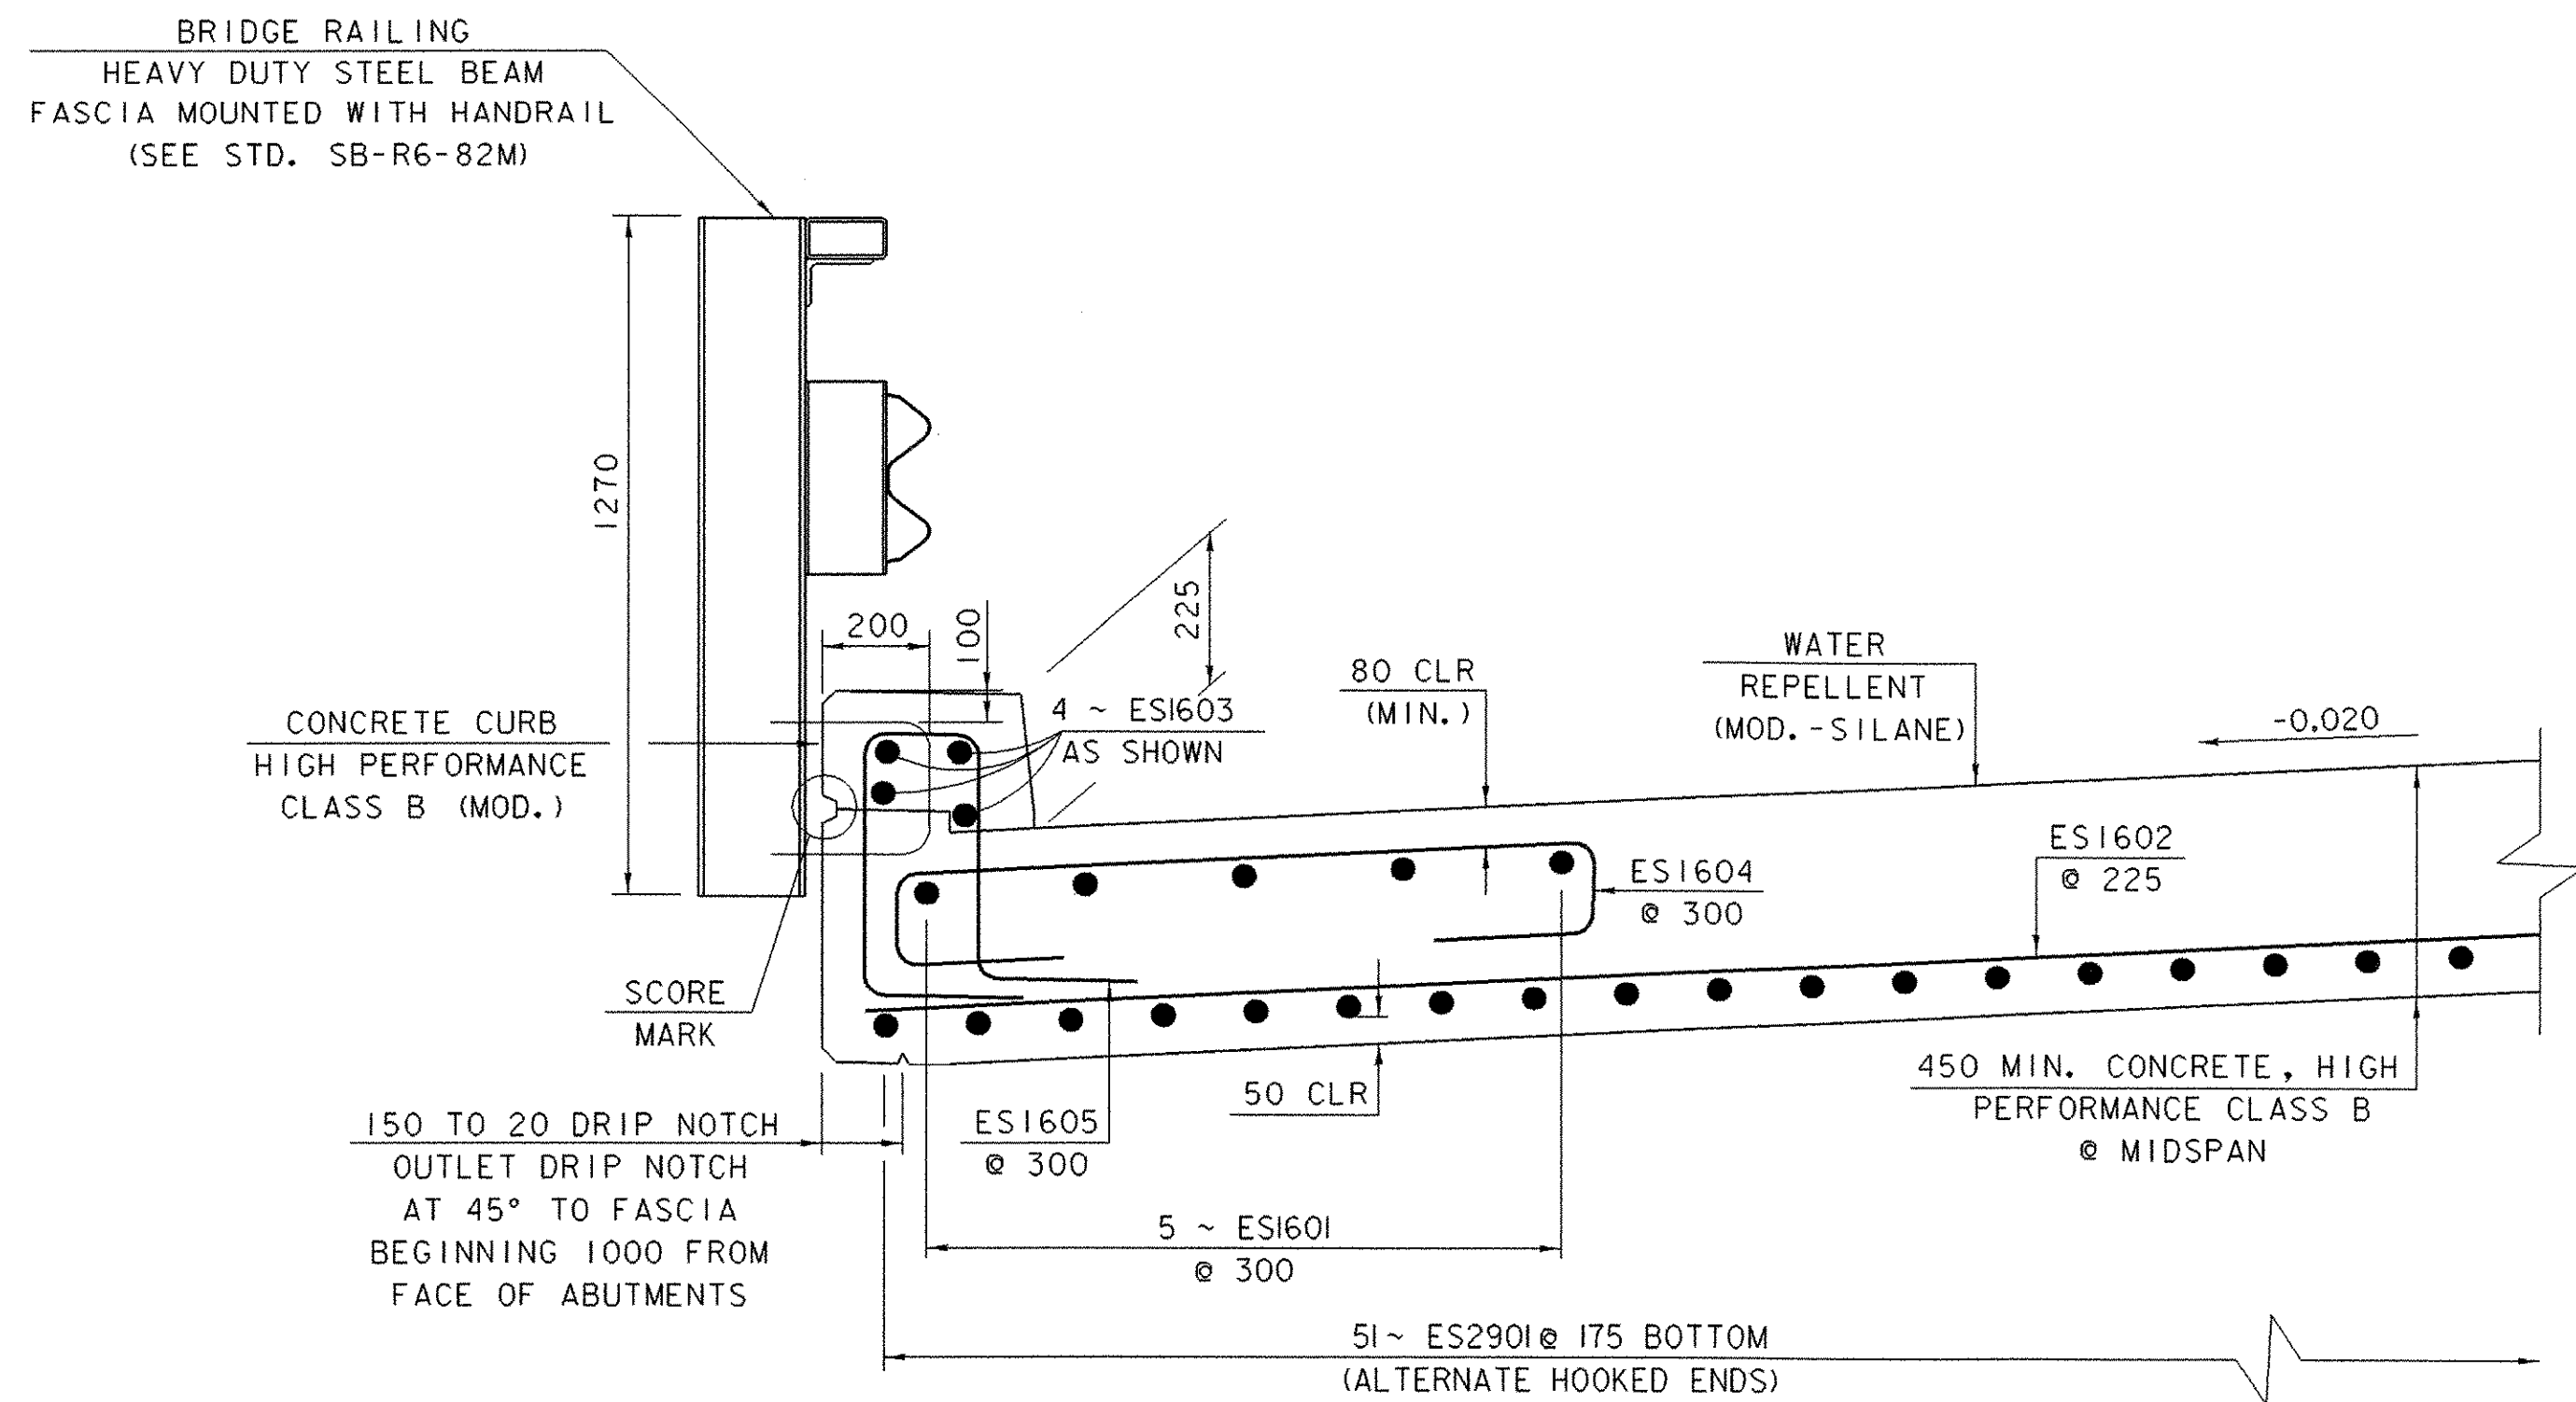


CURB AND RAIL DETAIL
NOT TO SCALE

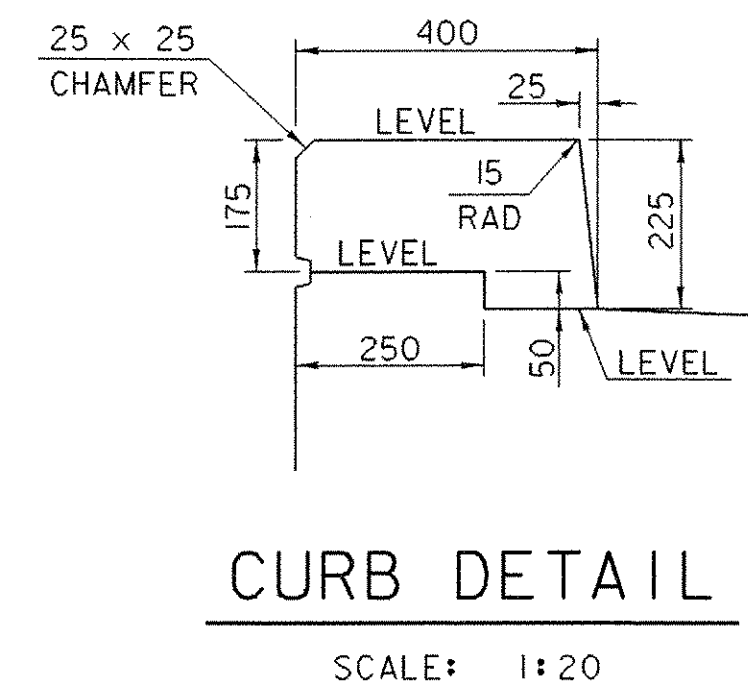


CURB DETAIL
SCALE: 1:20

- NOTES**
1. THERE WILL NOT BE ANY CONSTRUCTION JOINTS IN THE CURBS.
 2. CURB REINFORCING STIRRUP BARS SHALL BE TURNED AS REQUIRED TO FIT TAPERED ENDS.

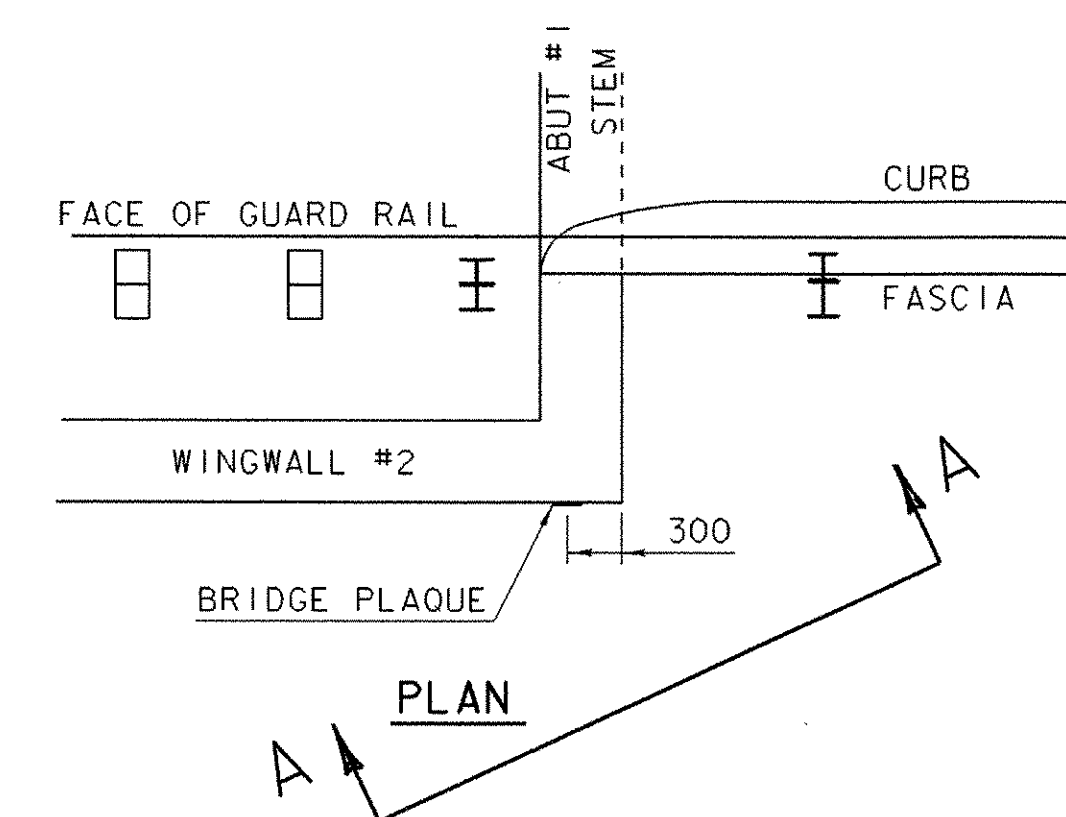


VIEW "A - A"
LOCATE BRIDGE PLAQUE


THE BRIDGE PLAQUE WILL BE SUPPLIED BY THE AGENCY OF TRANSPORTATION AND SHALL BE INSTALLED BY THE CONTRACTOR AT ABUTMENT #1 ON THE RIGHT SIDE AS SHOWN OR AS DIRECTED BY THE ENGINEER.

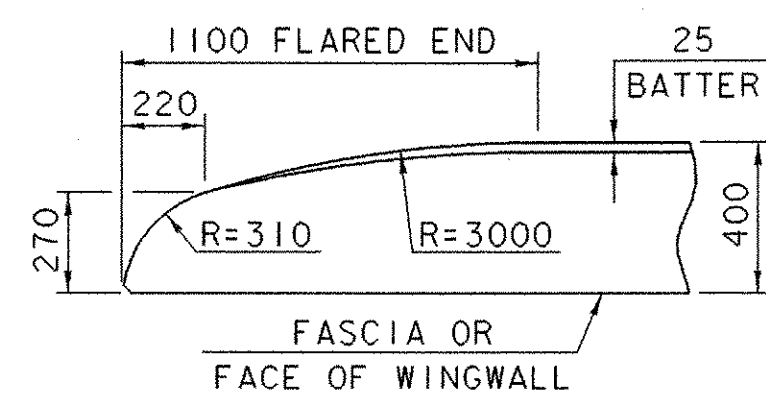


FLARED END FOR 400 CURB
BARS SHALL BE TURNED AS REQUIRED TO FIT FLARED ENDS

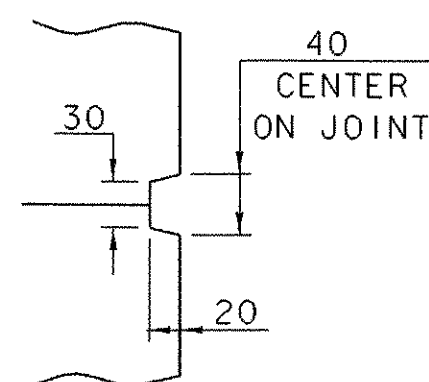


SCORE MARK DETAIL

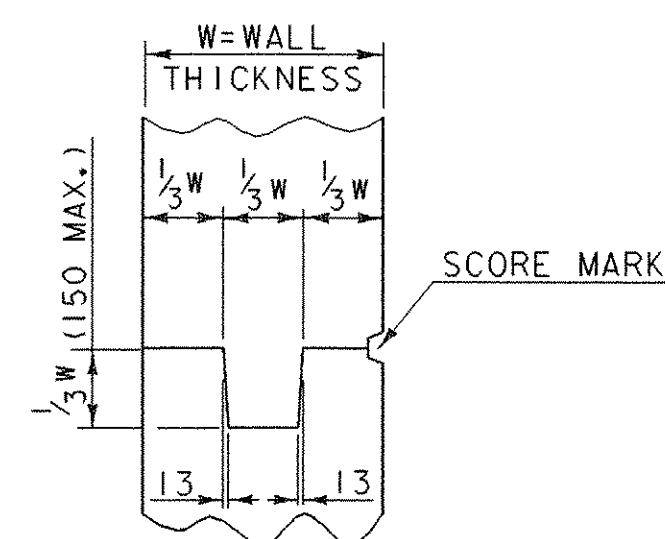

TYPICAL CONCRETE CONSTRUCTION JOINT

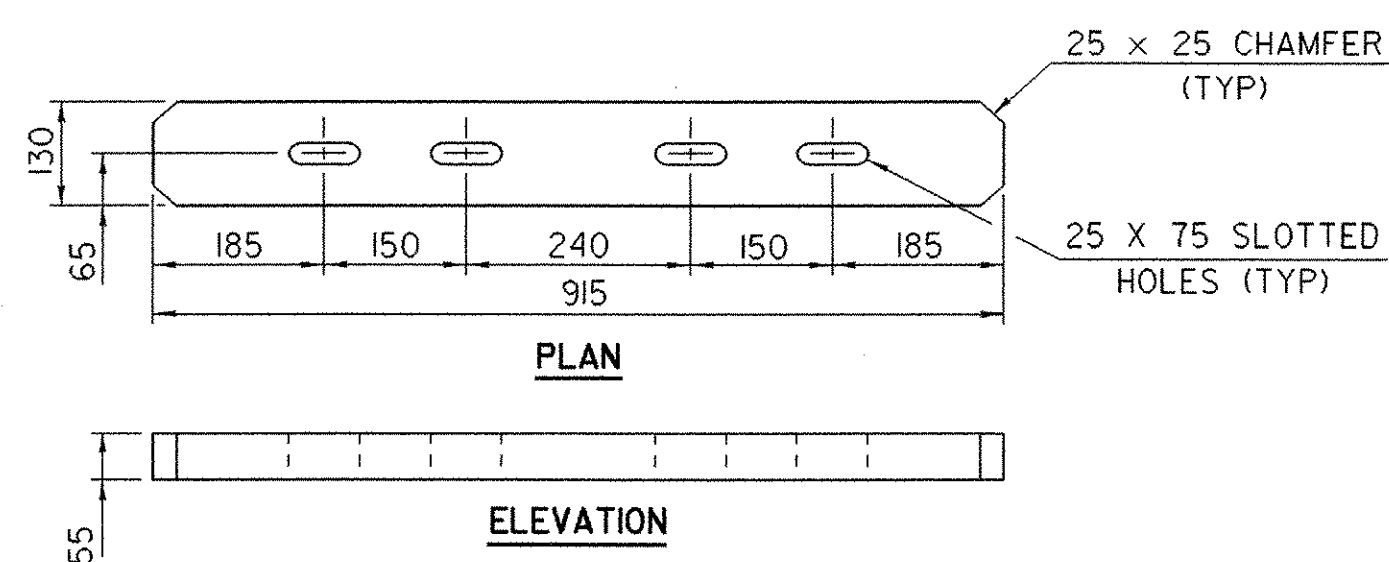


HANDRAIL SPLICE BAR (OPTION 'A')

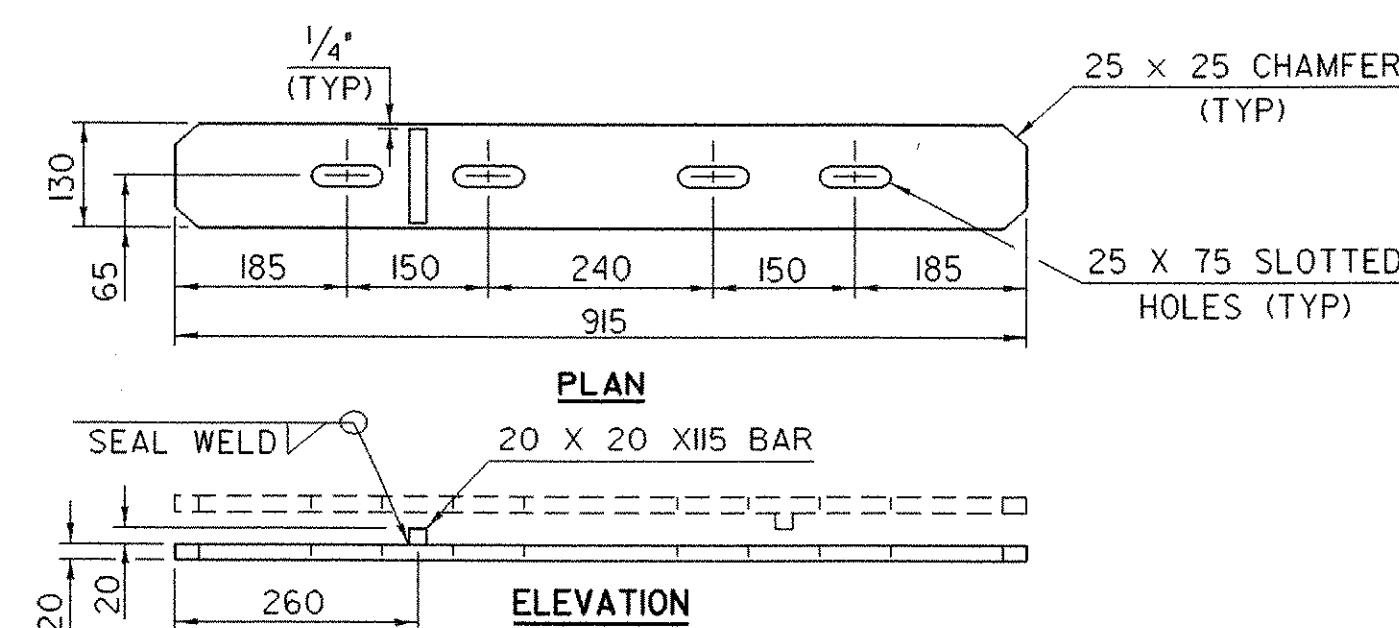


HANDRAIL SPLICE BAR (OPTION 'B')
NOT TO SCALE

SHEET NAME: CURB DETAILS	
PROJECT NAME: WESTFORD	HIGHWAY NO.: TH 4
PROJECT NUMBER: TH2 9436	BRIDGE NO.: 2
	OVER: ROGERS BROOK
FILE NAME: 94J122\Structures\sj122sup.dgn	PLOT DATE: 25-MAR-2005
PROJECT MANAGER: R. R. WHITCOMB	DRAWN BY: T. FILLBACH
DESIGNED BY: T. FILLBACH	IPARM NAME: sj122sb2.1
BRIDGE SHEET NUMBER:	SHEET 31 OF 56

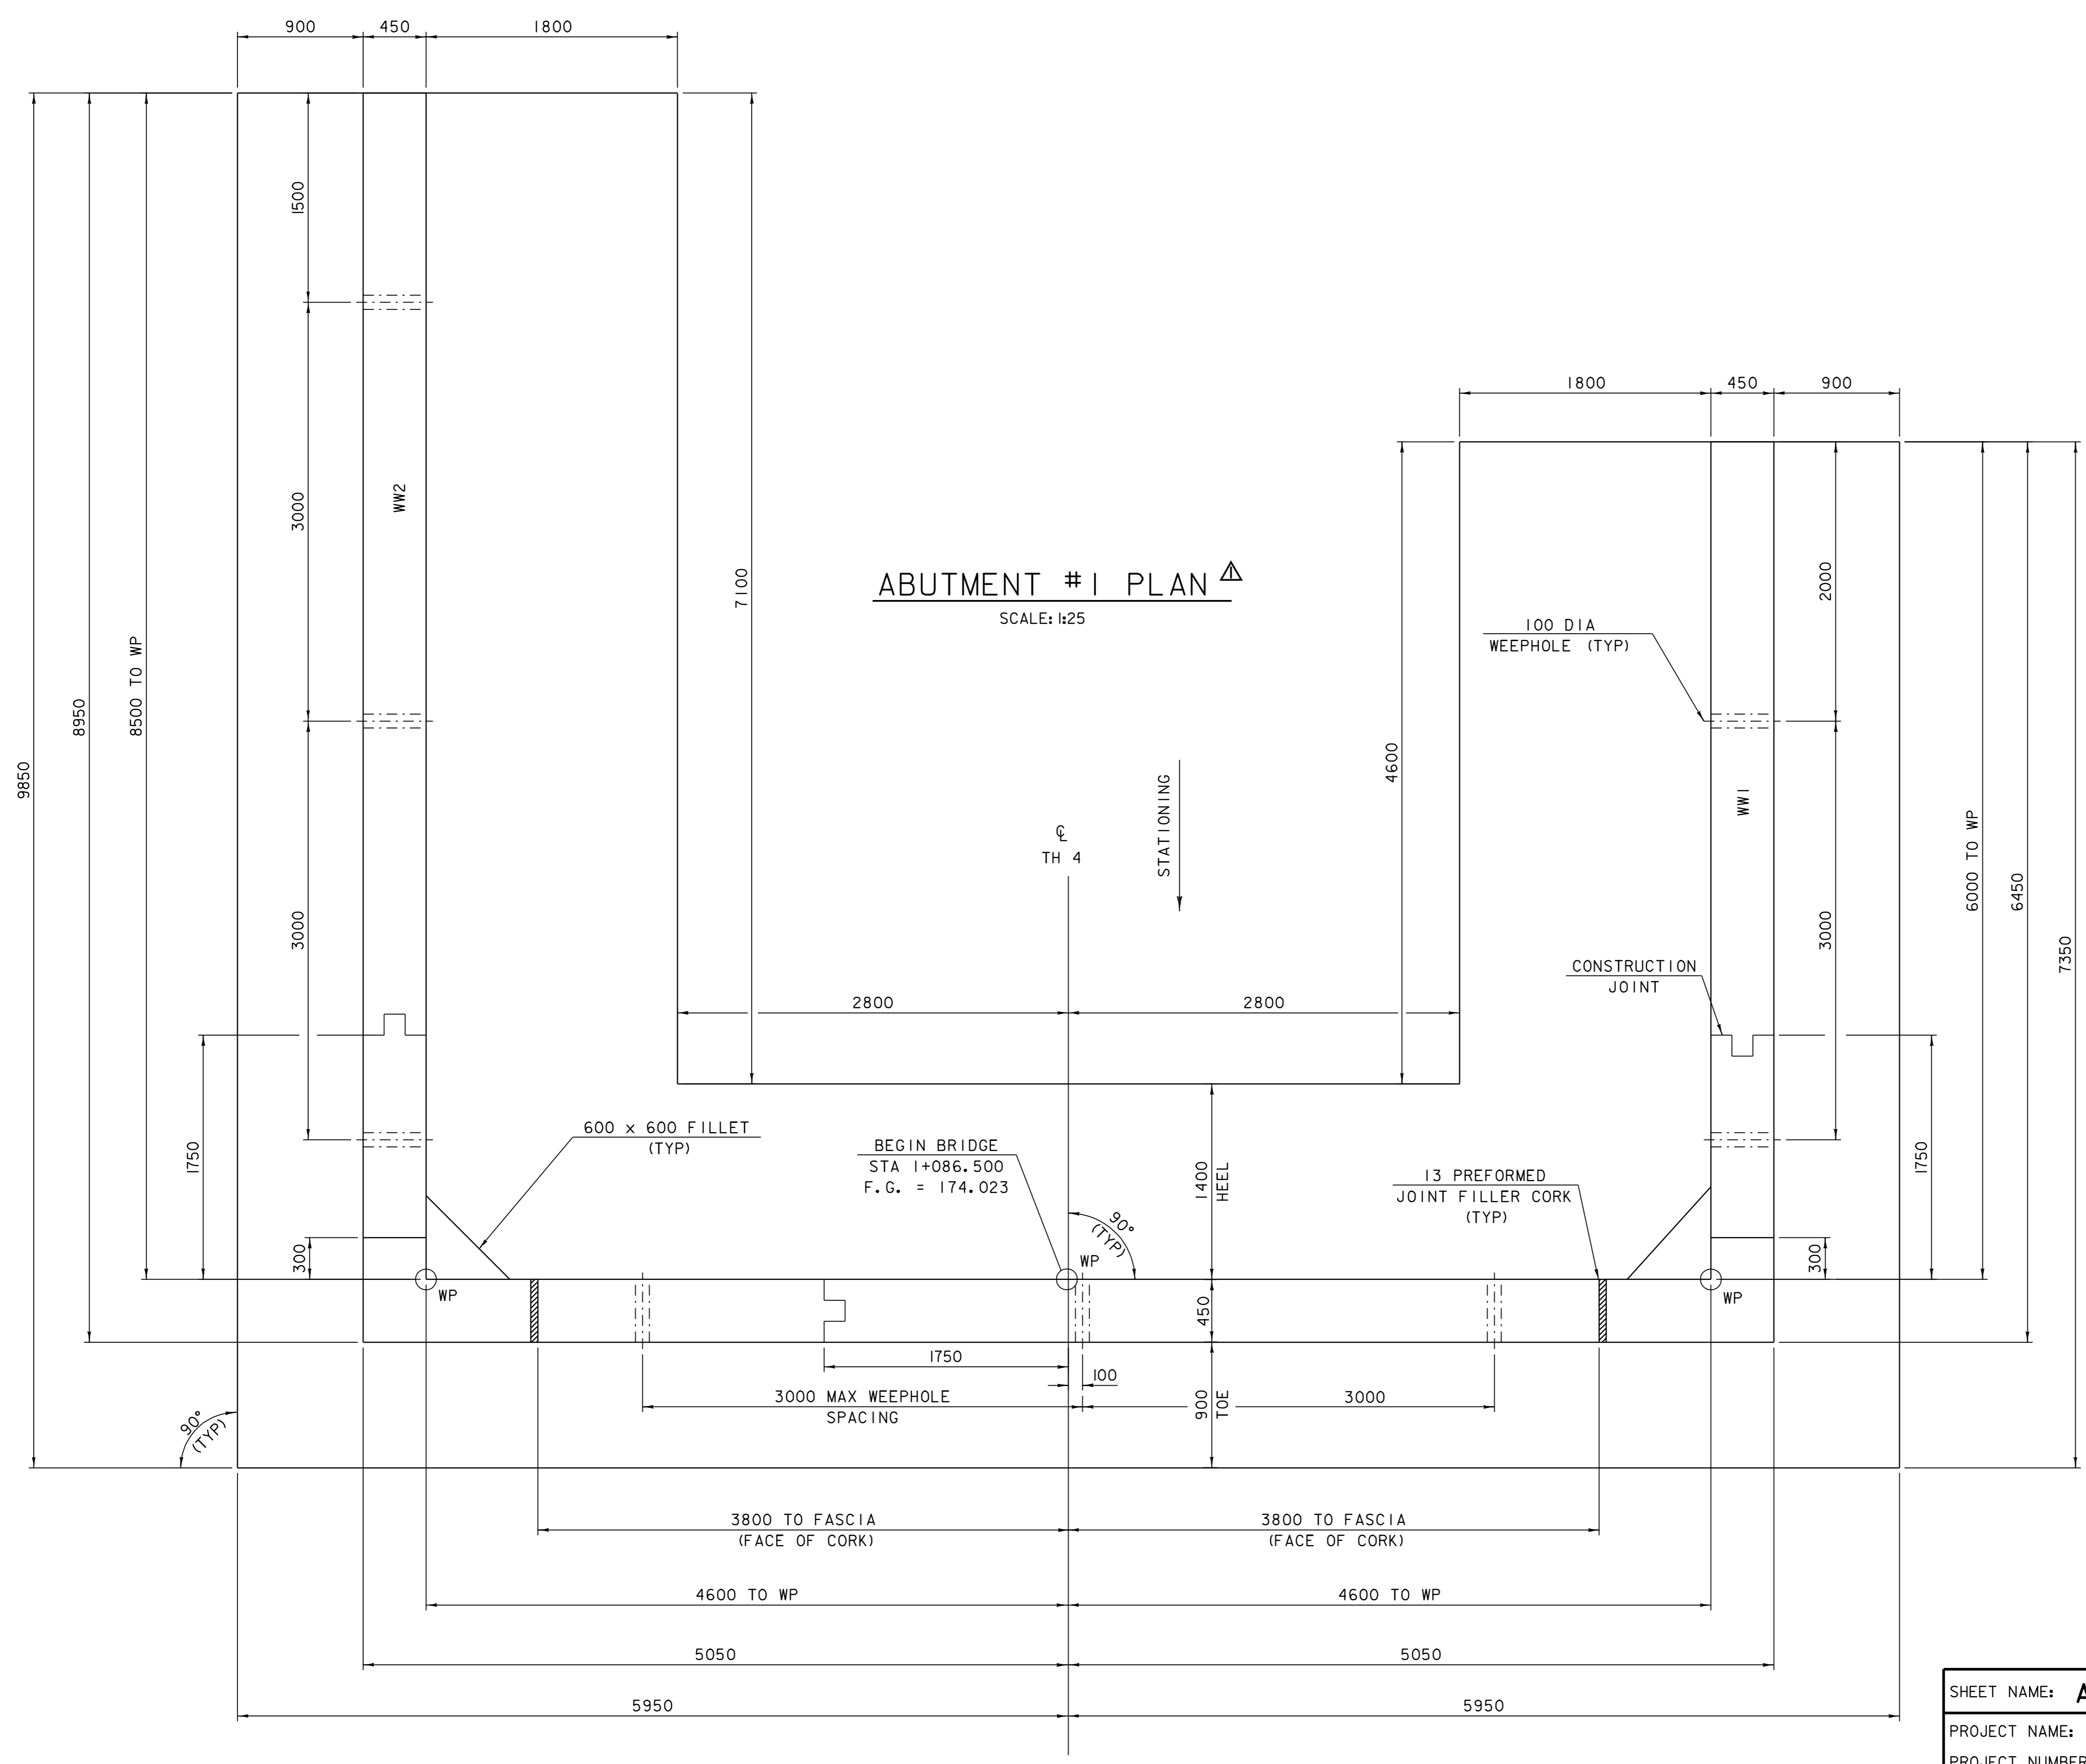


ABUTMENT #1 PLAN
SCALE: 1:25

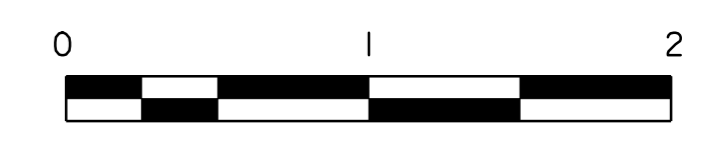

SCALE = 1:25

SHEET NAME: ABUTMENT #1 PLAN	
PROJECT NAME: WESTFORD	HIGHWAY NO.: TH 4
PROJECT NUMBER: TH2 9436	BRIDGE NO.: 2
	OVER: ROGERS BROOK
FILE NAME: 94J122\Structures\sj122sup.dgn	PLOT DATE: 22-DEC-2006
PROJECT MANAGER: R. R. WHITCOMB	DRAWN BY: T. FILLBACH
DESIGNED BY: T. FILLBACH	IPARM NAME: sj122abl.i
BRIDGE SHEET NUMBER:	SHEET 32 OF 56

REVISION	DATE	BY	CHK'D	DESCRIPTION
△	06/27/2005	GFR	CWC	ABUTMENTS MODIFIED DUE TO UPDATED LEDGE INFORMATION.

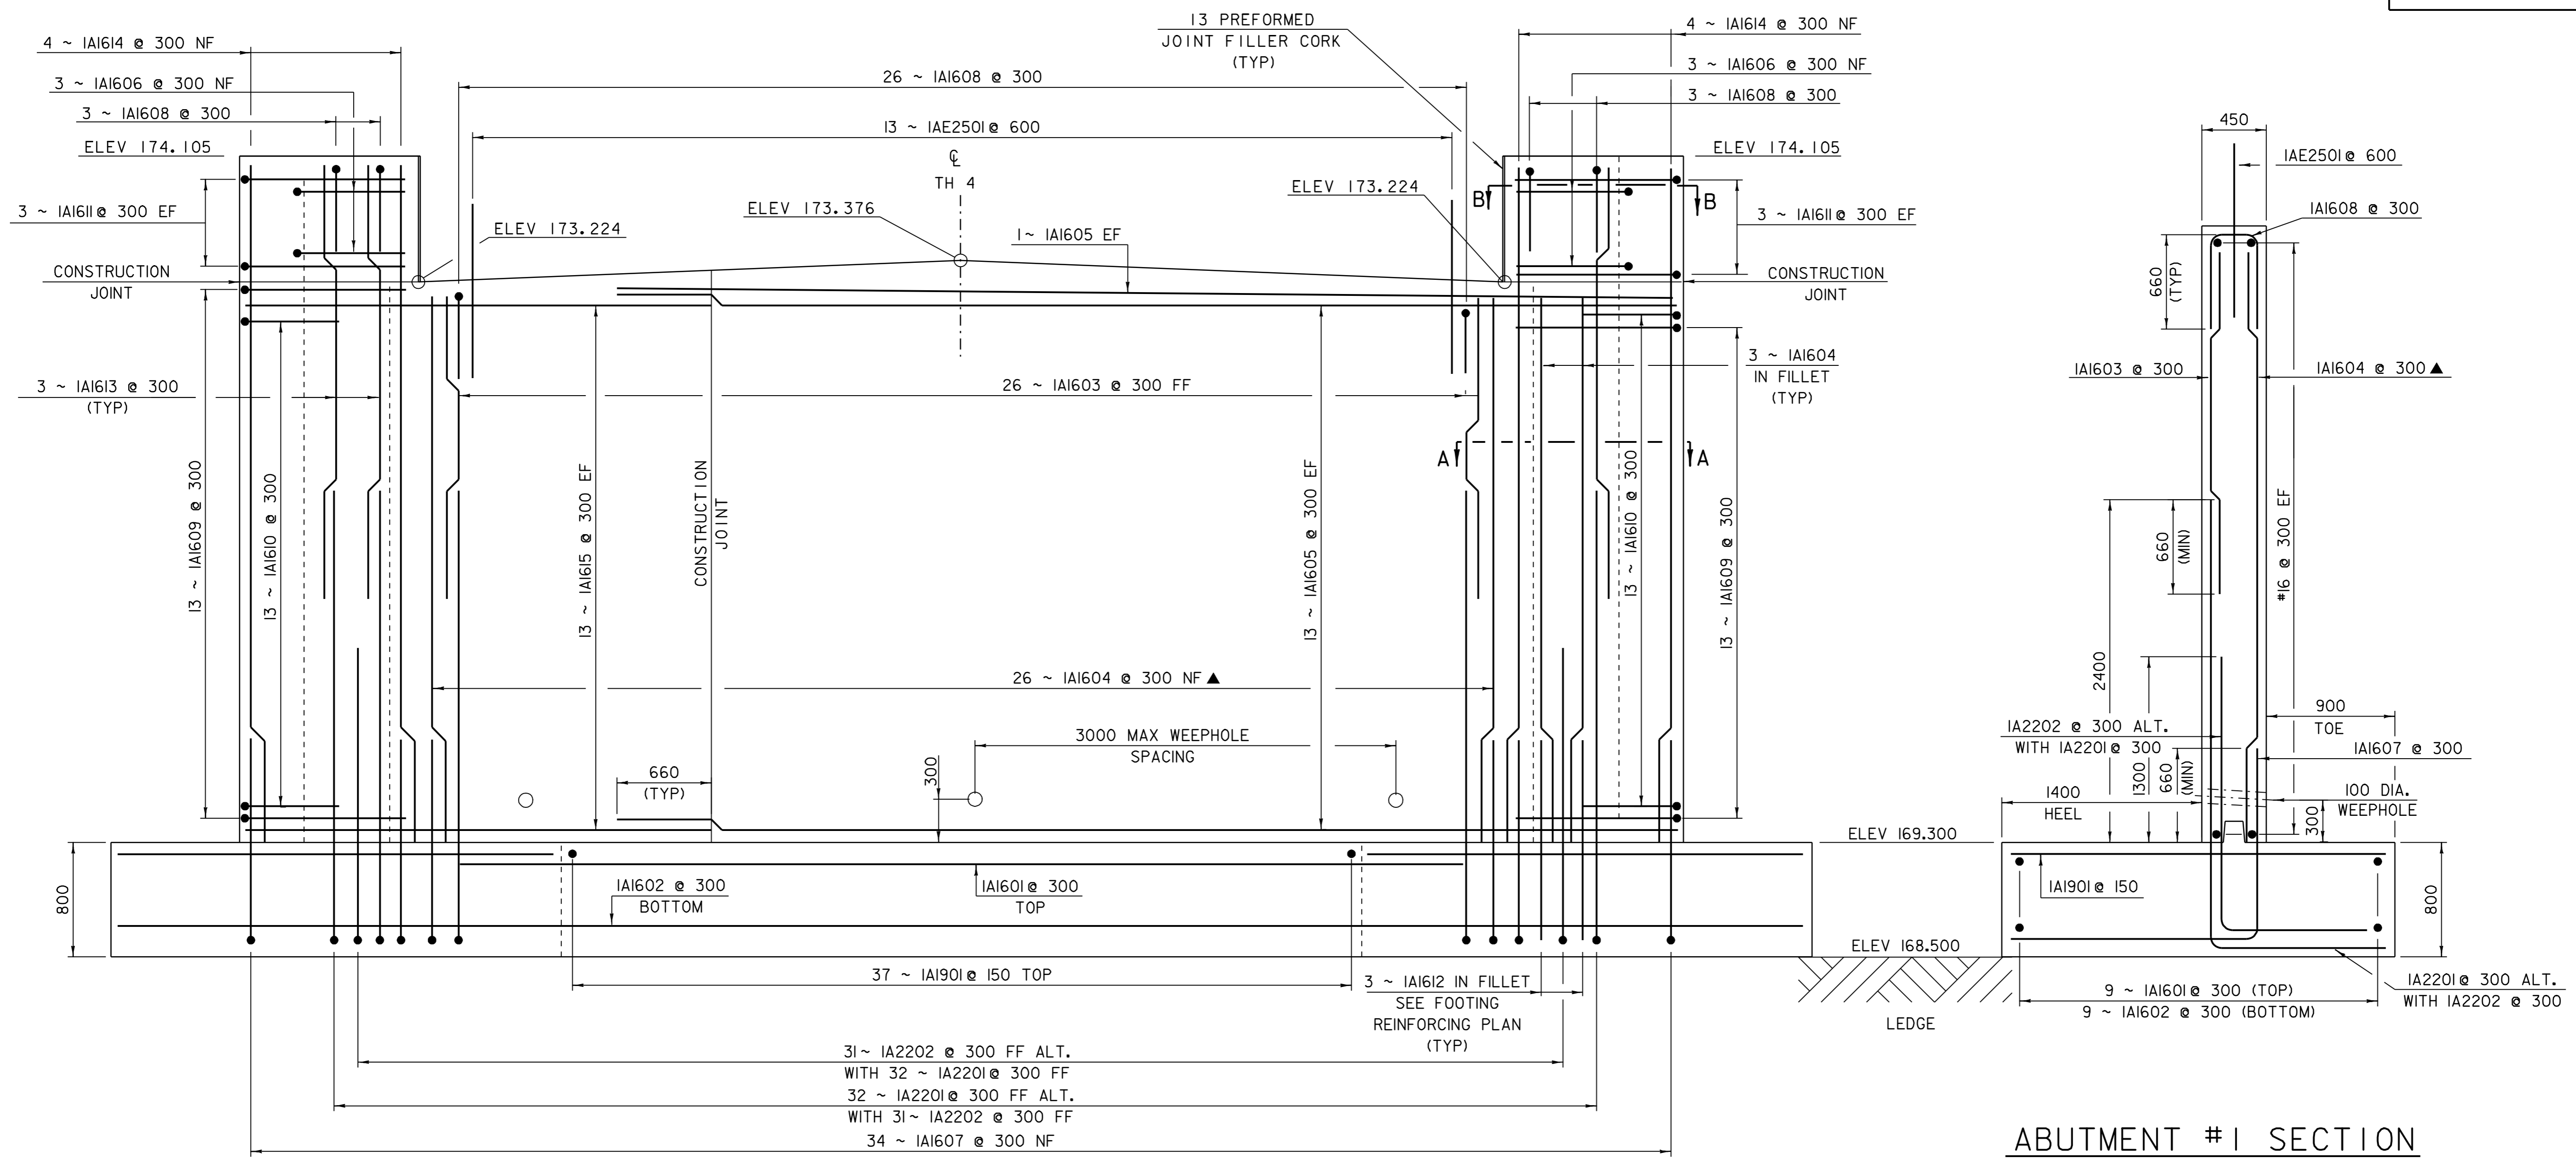


ABUTMENT #1 SECTION

SCALE: 1:25

ABUTMENT #1 ELEVATION


SCALE: 1:25

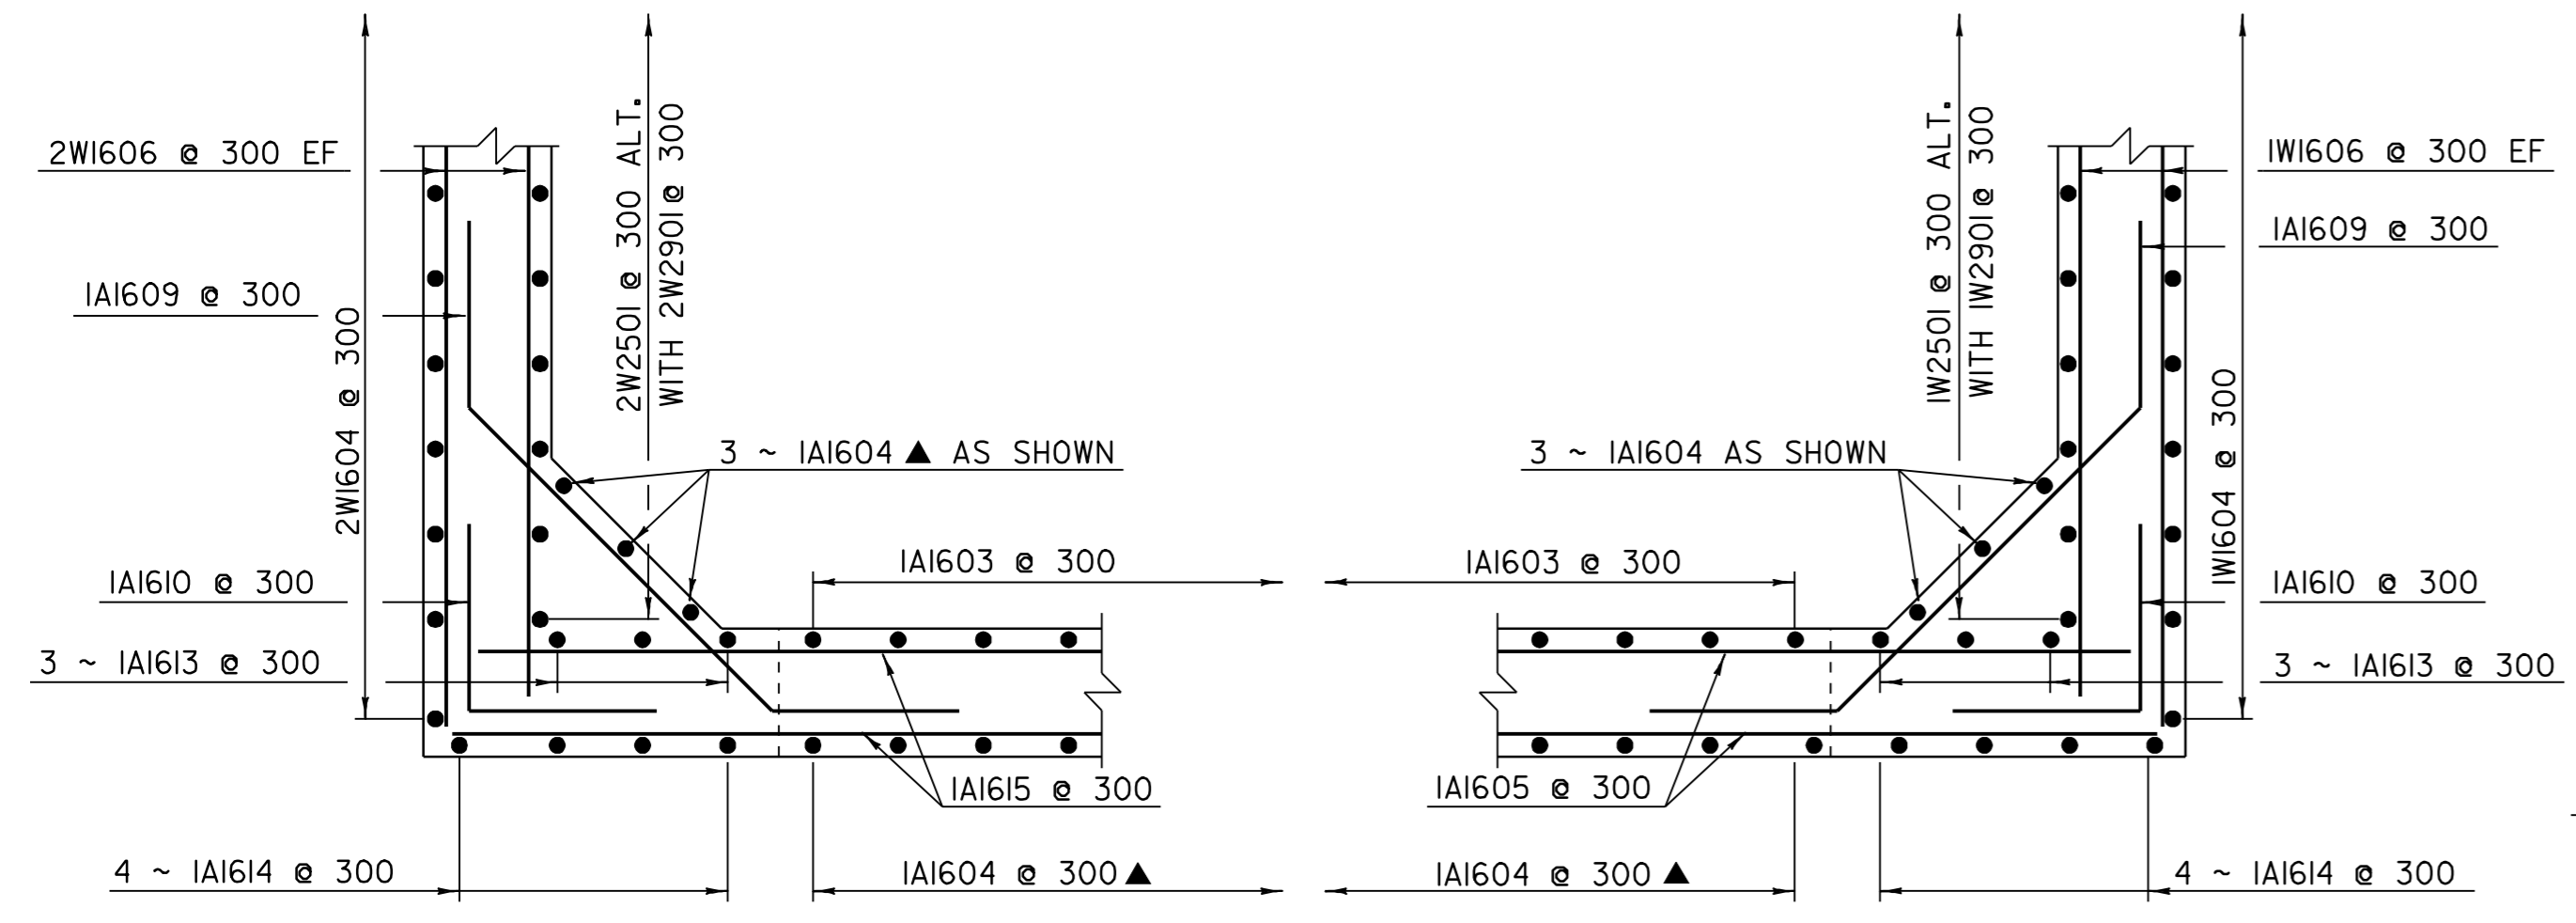

CORNER DETAILS BELOW BRIDGE SEAT

SCALE: 1:25


SECTION A-A

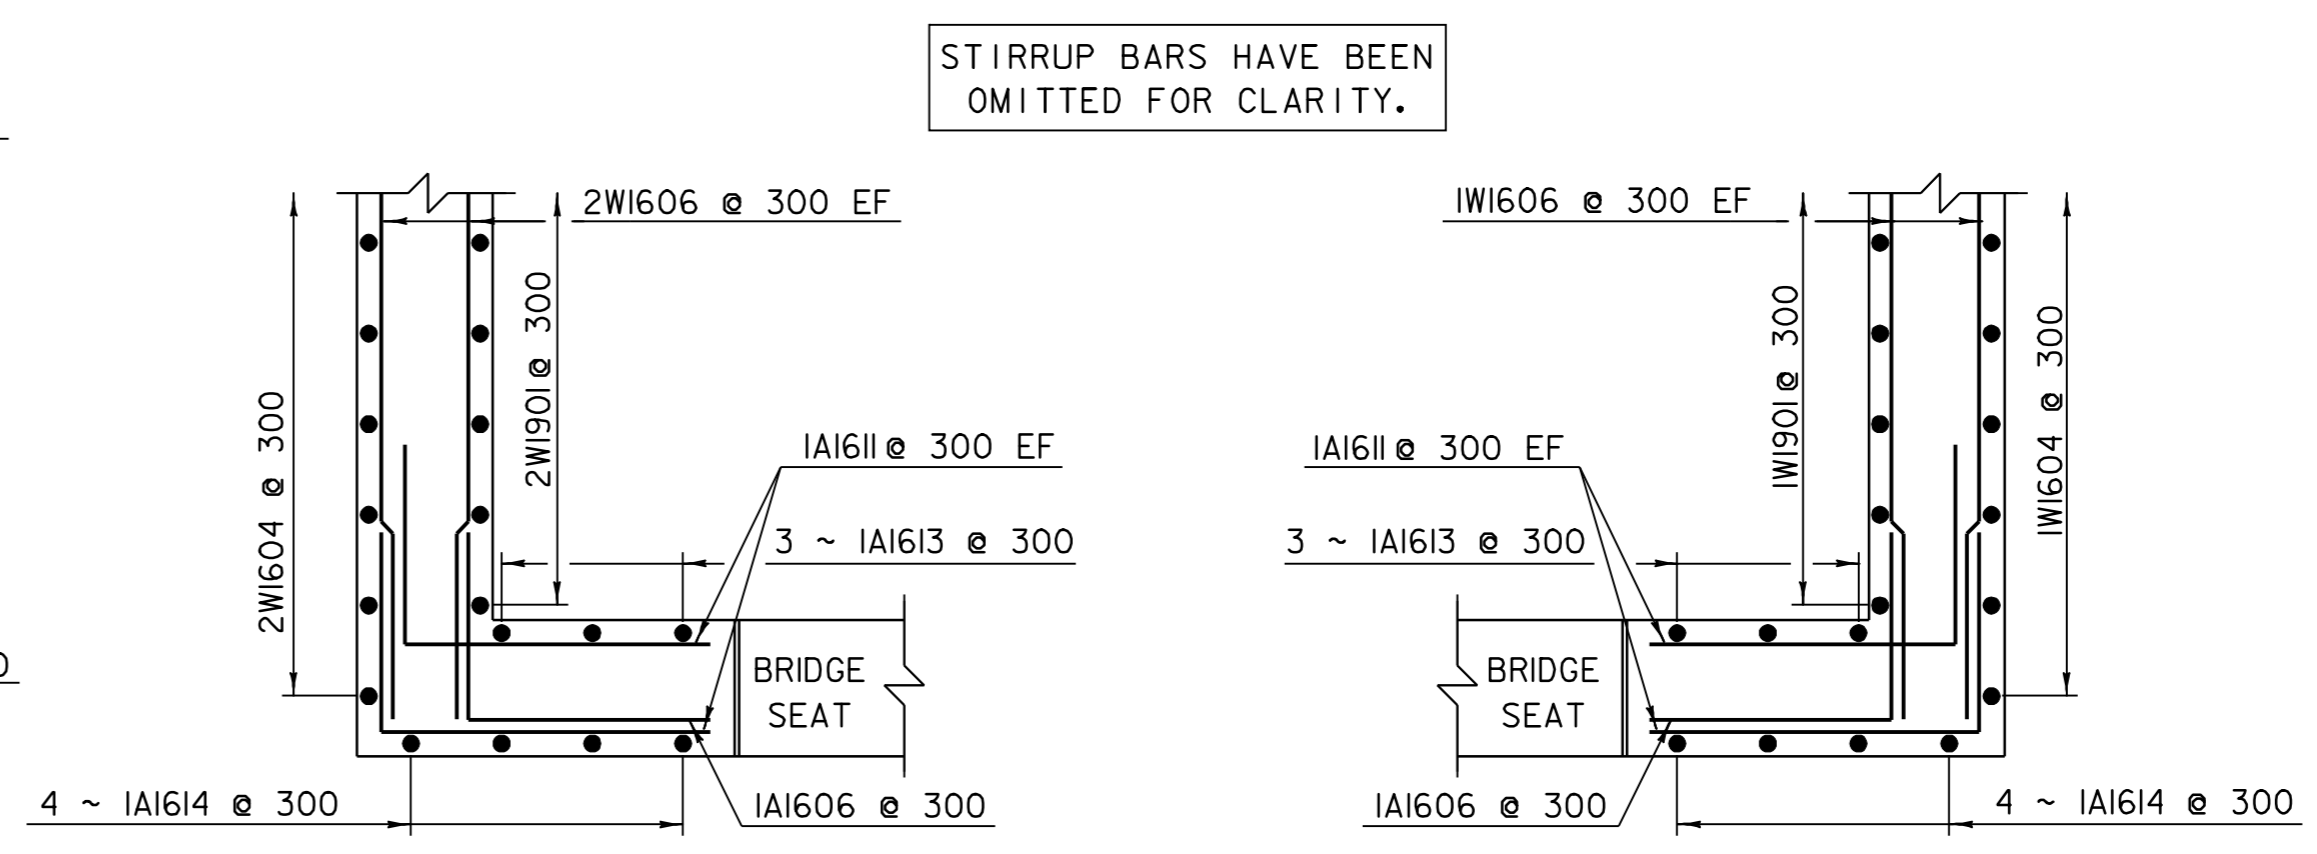

CORNER DETAILS ABOVE BRIDGE SEAT

SCALE: 1:25

SECTION B-B

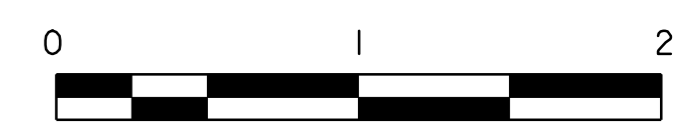

SCALE = 1:25

NOTES


1. NF = NEAR FACE
2. FF = FAR FACE
3. EF = EACH FACE
4. ▲ = CUT TO FIT IN FIELD
5. 80 CLEAR UNLESS OTHERWISE SPECIFIED ON THE PLANS
6. ALL LAPS NOT DETAILED SHALL BE 660 (MIN)
7. 3000 MAX. WEEPHOLE SPACING
8. SEE SHEET 35 FOR FOOTING REINFORCING PLAN.

SHEET NAME: **ABUTMENT #1 ELEVATION**


PROJECT NAME: WESTFORD
 PROJECT NUMBER: TH2 9436
 HIGHWAY NO.: TH 4
 BRIDGE NO.: 2
 OVER: ROGERS BROOK

FILE NAME: 94J122\Structures\sj122sup.dgn
 PROJECT MANAGER: R. R. WHITCOMB
 DESIGNED BY: T. FILLBACH
 BRIDGE SHEET NUMBER:
 PLOT DATE: 22-DEC-2006
 DRAWN BY: T. FILLBACH
 IPARM NAME: sj122ev1.i
 SHEET 33 OF 56


REVISION	DATE	BY	CHK'D	DESCRIPTION
△	06/27/2005	GFR	CWC	ABUTMENTS MODIFIED DUE TO UPDATED LEDGE INFORMATION.

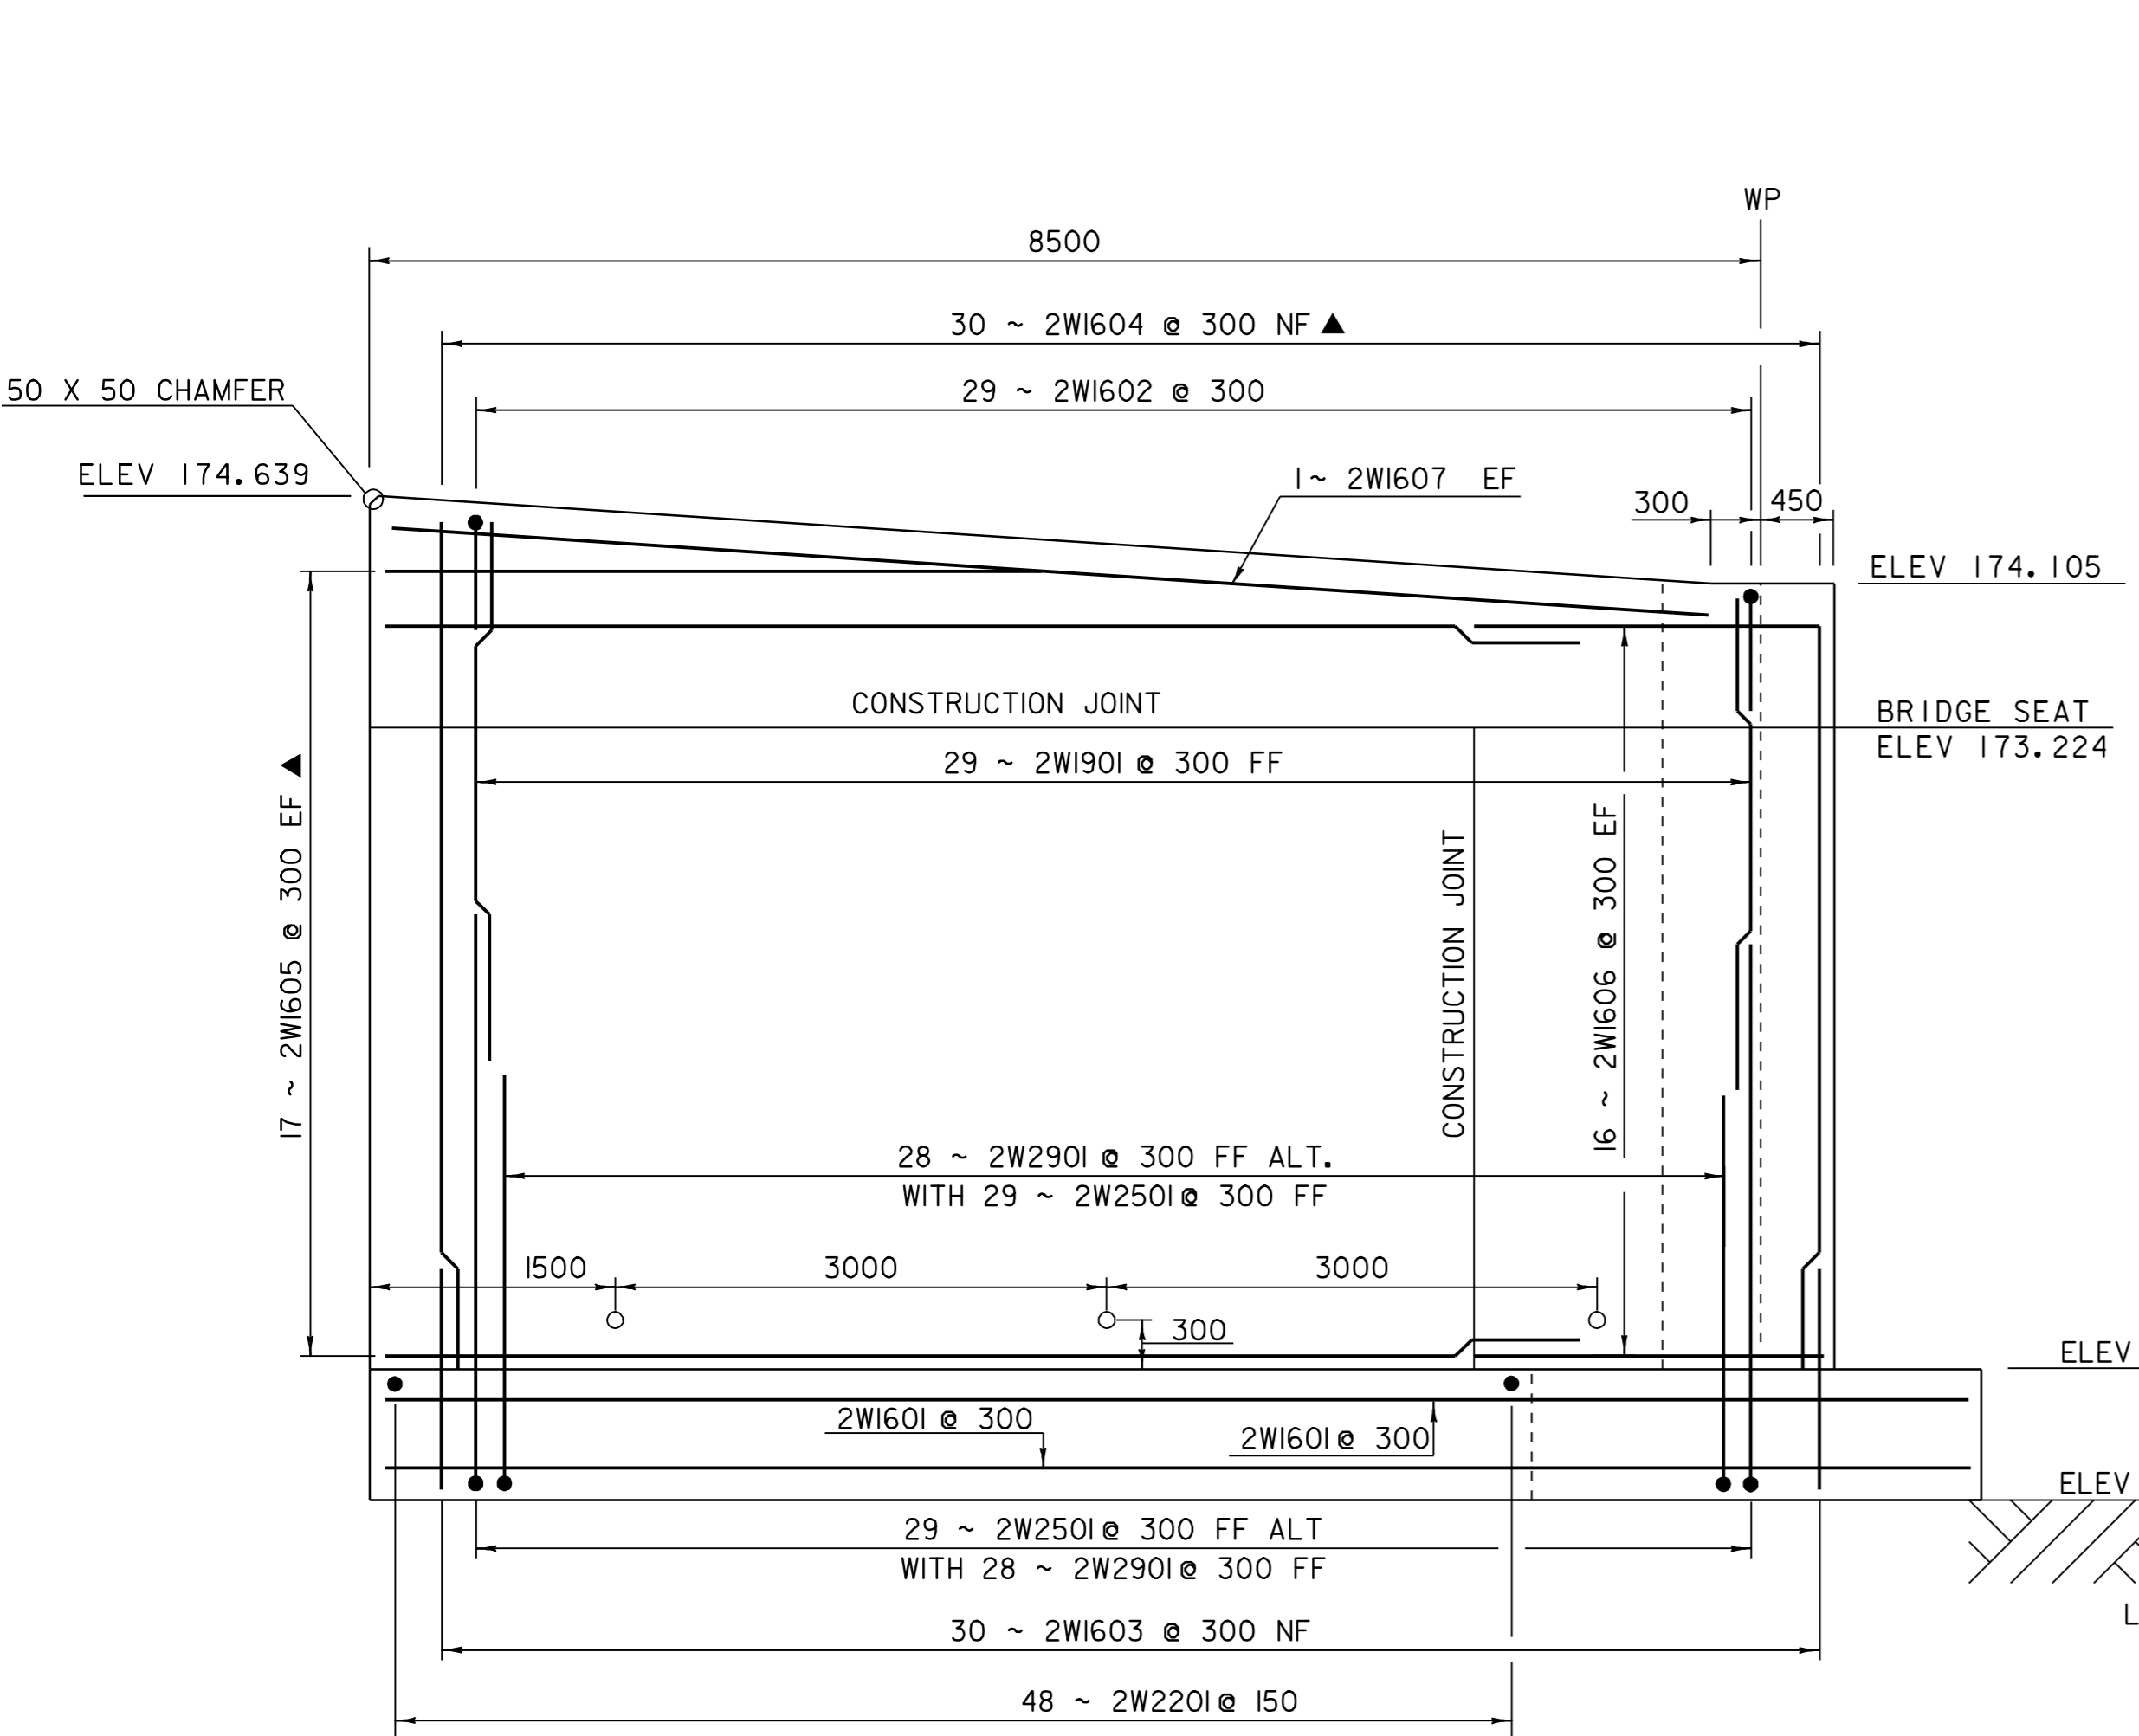

WINGWALL #2 ELEVATION
 0 1 2 3 4
 SCALE = 1:40

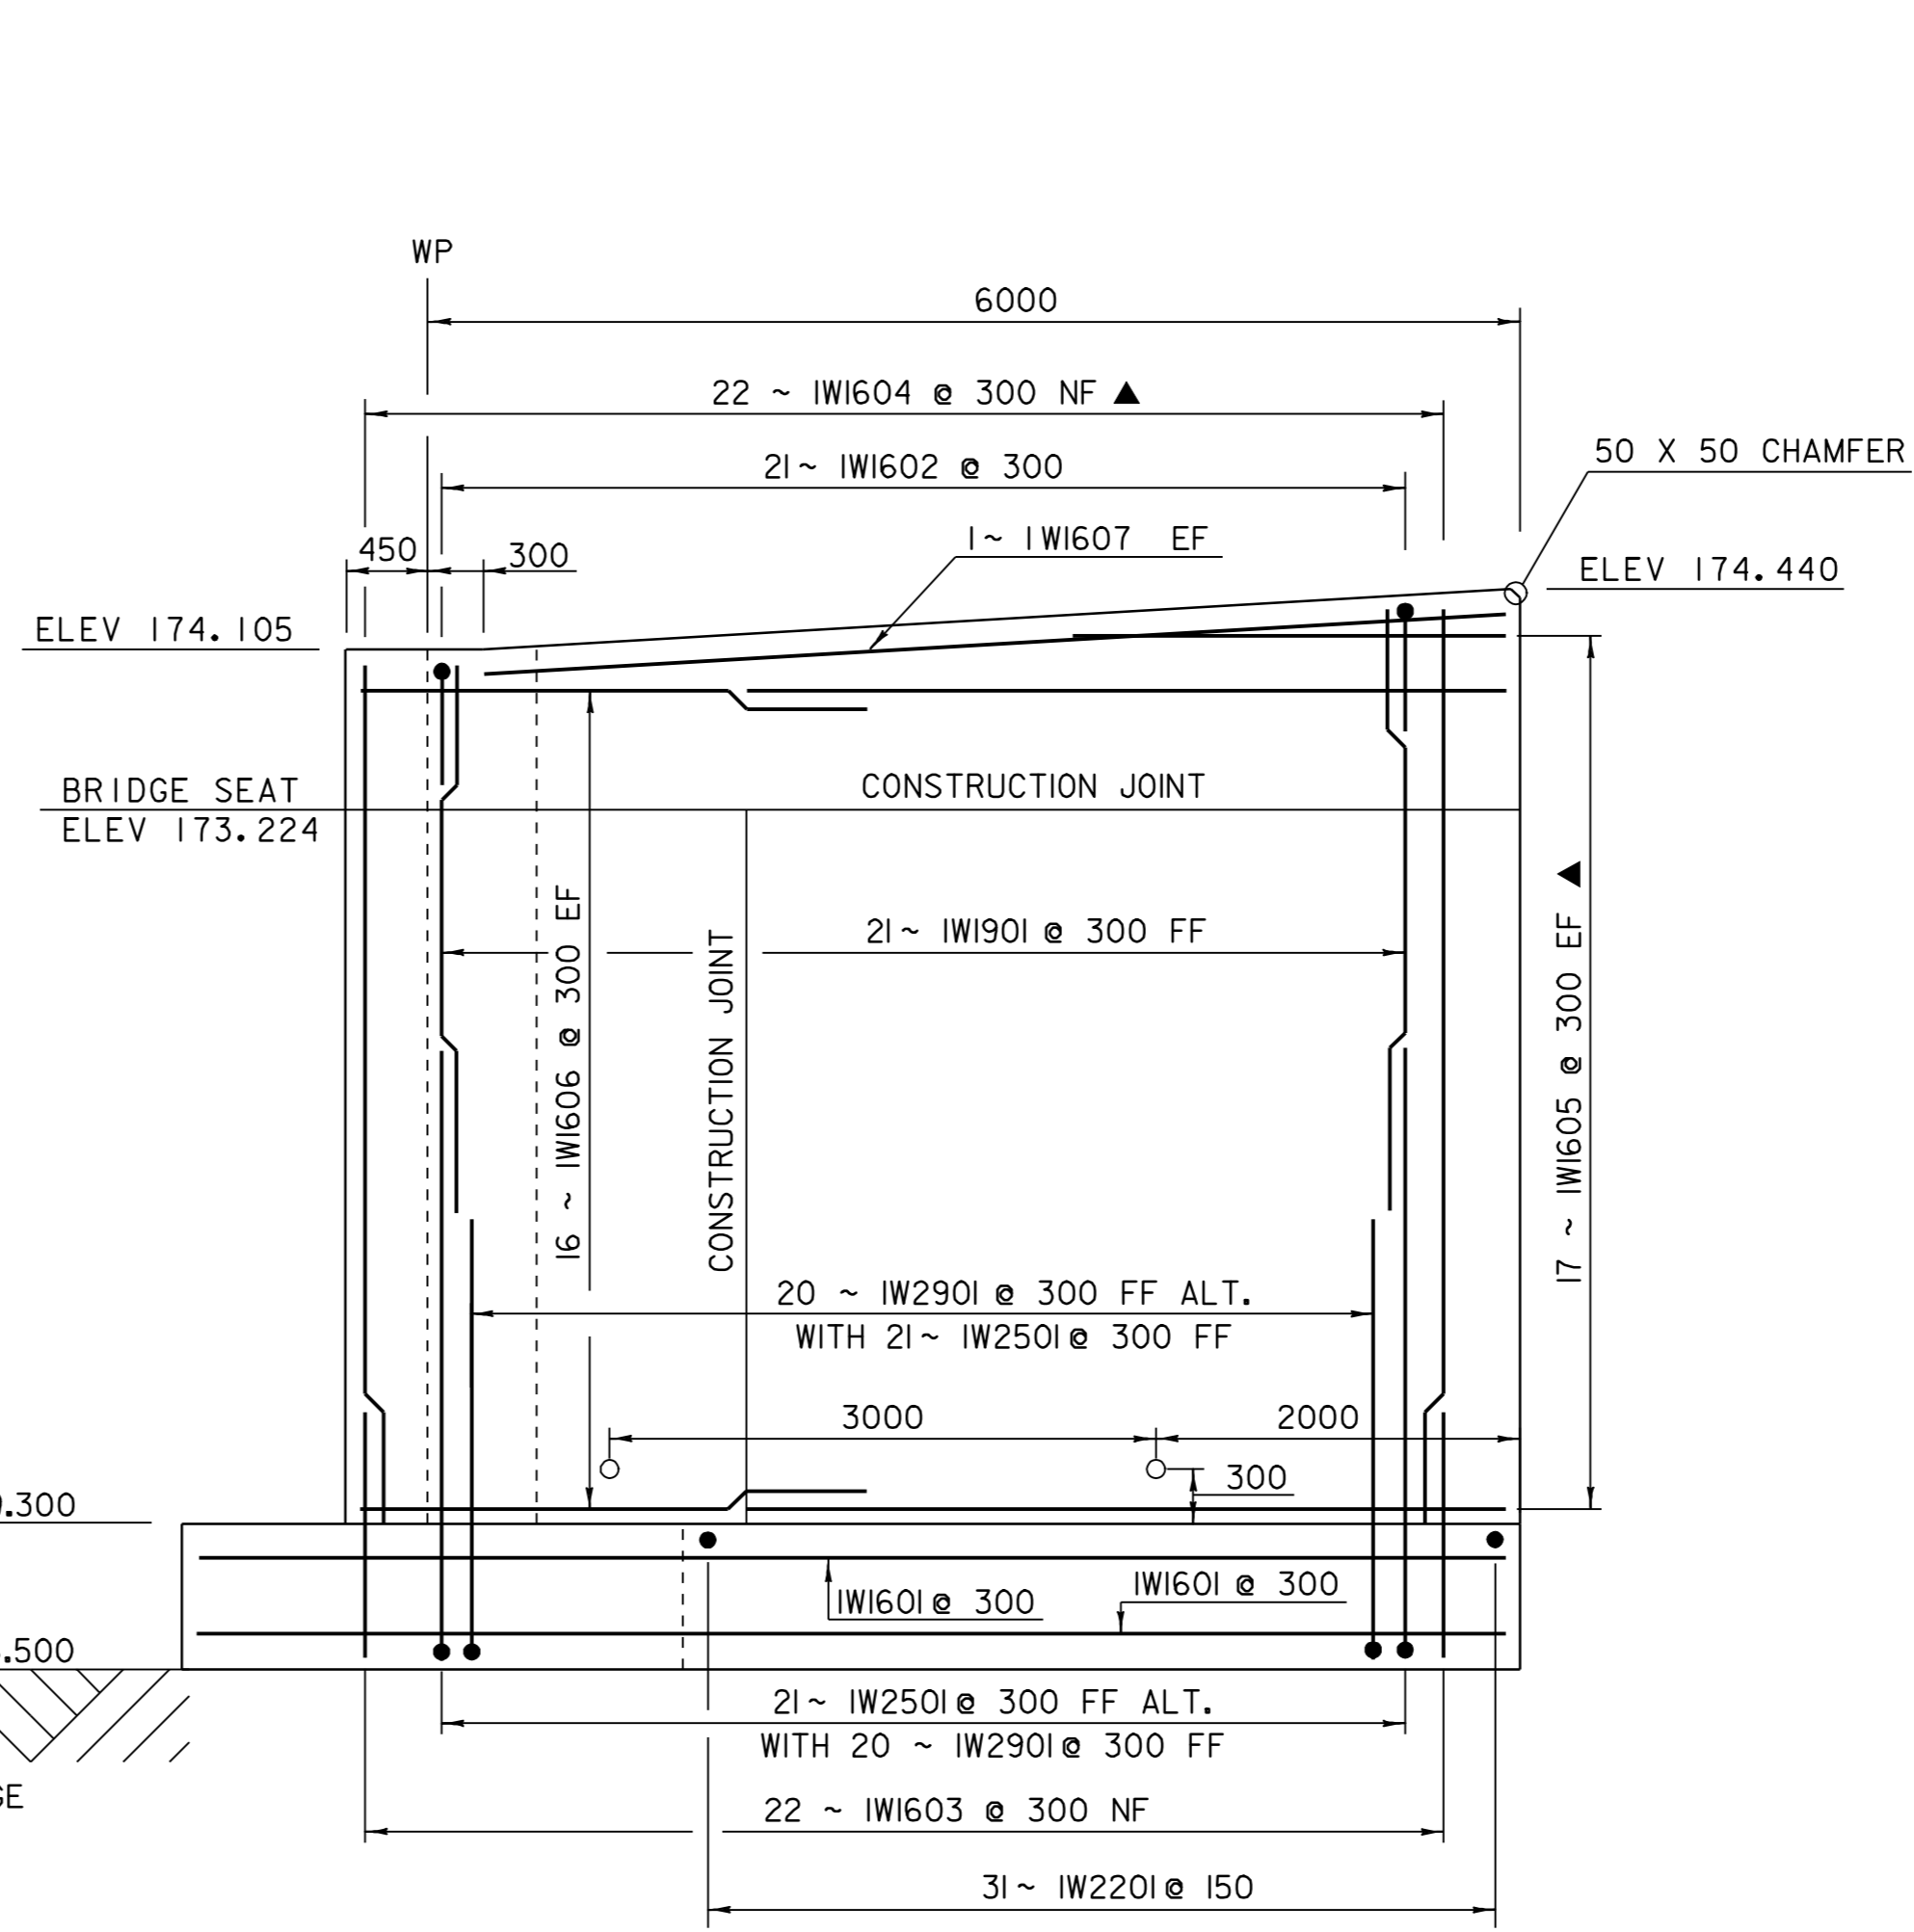

WINGWALL #1 ELEVATION
 0 1 2 3 4
 SCALE = 1:40

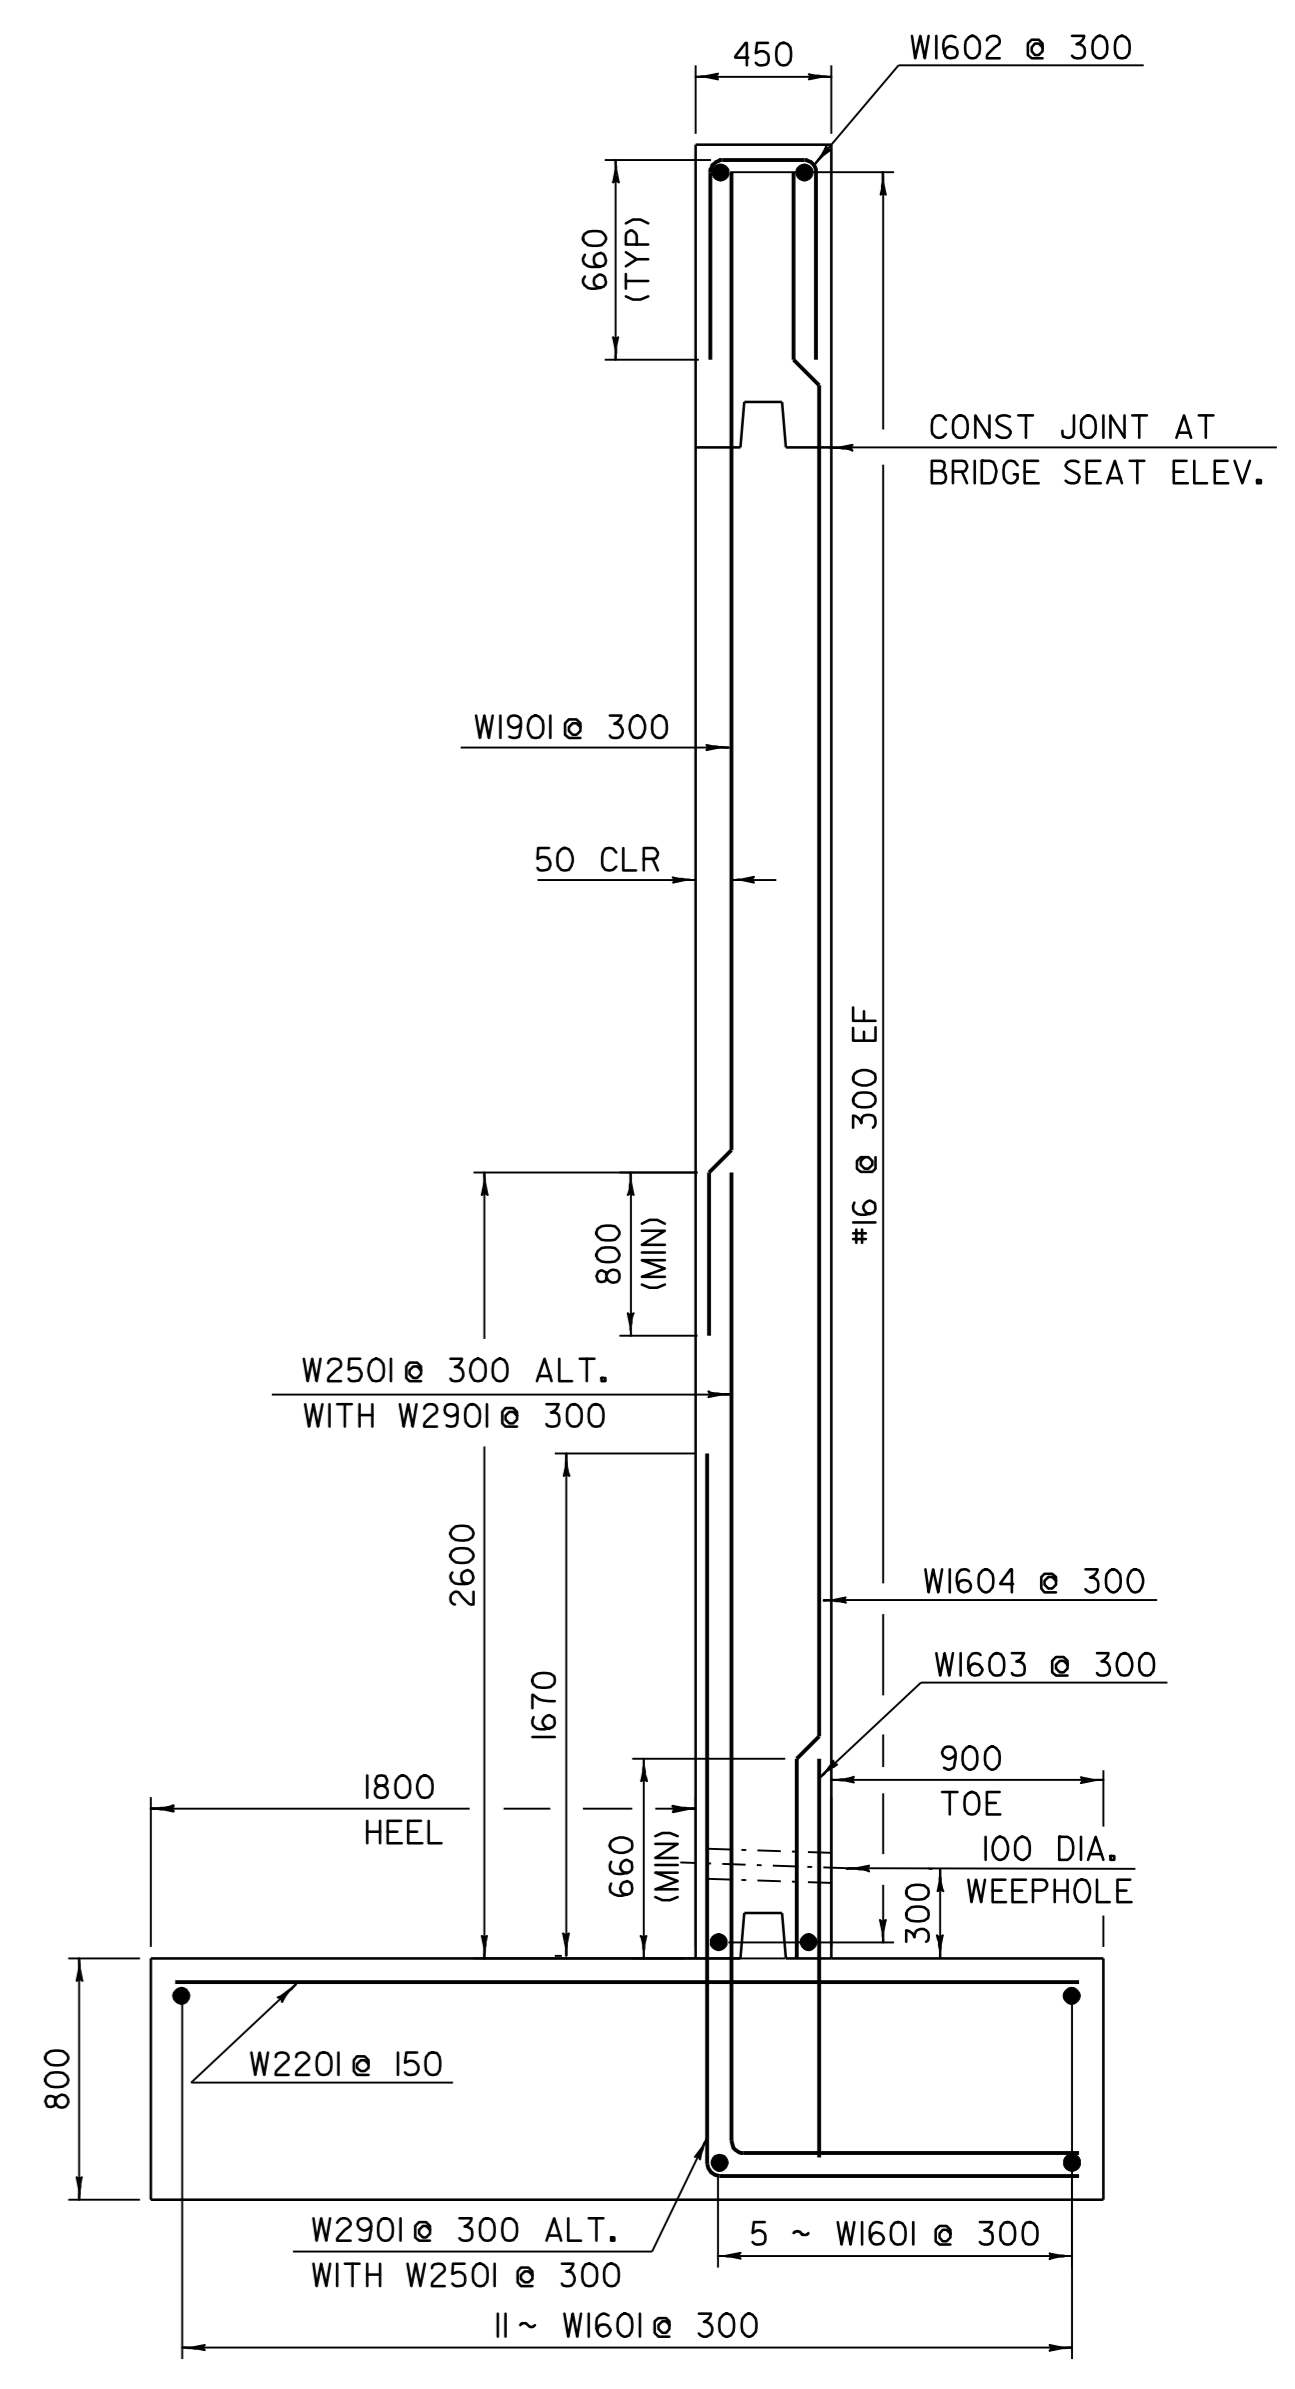


WINGWALL TYPICAL SECTION
 (WINGWALL #1 AND #2 ARE SIMILAR)
 0 1 2
 SCALE = 1:25

NOTES


1. NF = NEAR FACE
2. FF = FAR FACE
3. EF = EACH FACE
4. ▲ = CUT TO FIT IN FIELD
5. 80 CLEAR UNLESS OTHERWISE SPECIFIED ON THE PLANS
6. 3000 MAX. WEEPHOLE SPACING
7. ALL LAPS NOT DETAILED SHALL BE 660 (MIN)
8. SEE SHEET 33 FOR CORNER DETAILS.

REVISION	DATE	BY	CHK'D	DESCRIPTION
Δ	06/27/2005	GFR	CWC	ABUTMENTS MODIFIED DUE TO UPDATED LEDGE INFORMATION.

SHEET NAME: WW 1 & WW 2 ELEVATIONS	
PROJECT NAME: WESTFORD	HIGHWAY NO.: TH 4
PROJECT NUMBER: TH2 9436	BRIDGE NO.: 2
	OVER: ROGERS BROOK
FILE NAME: 94J122\Structures\sj122sup.dgn	PLOT DATE: 22-DEC-2006
PROJECT MANAGER: R. R. WHITCOMB	DRAWN BY: T. FILLBACH
DESIGNED BY: T. FILLBACH	IPARM NAME: sj122wwl.1
BRIDGE SHEET NUMBER:	SHEET 34 OF 56

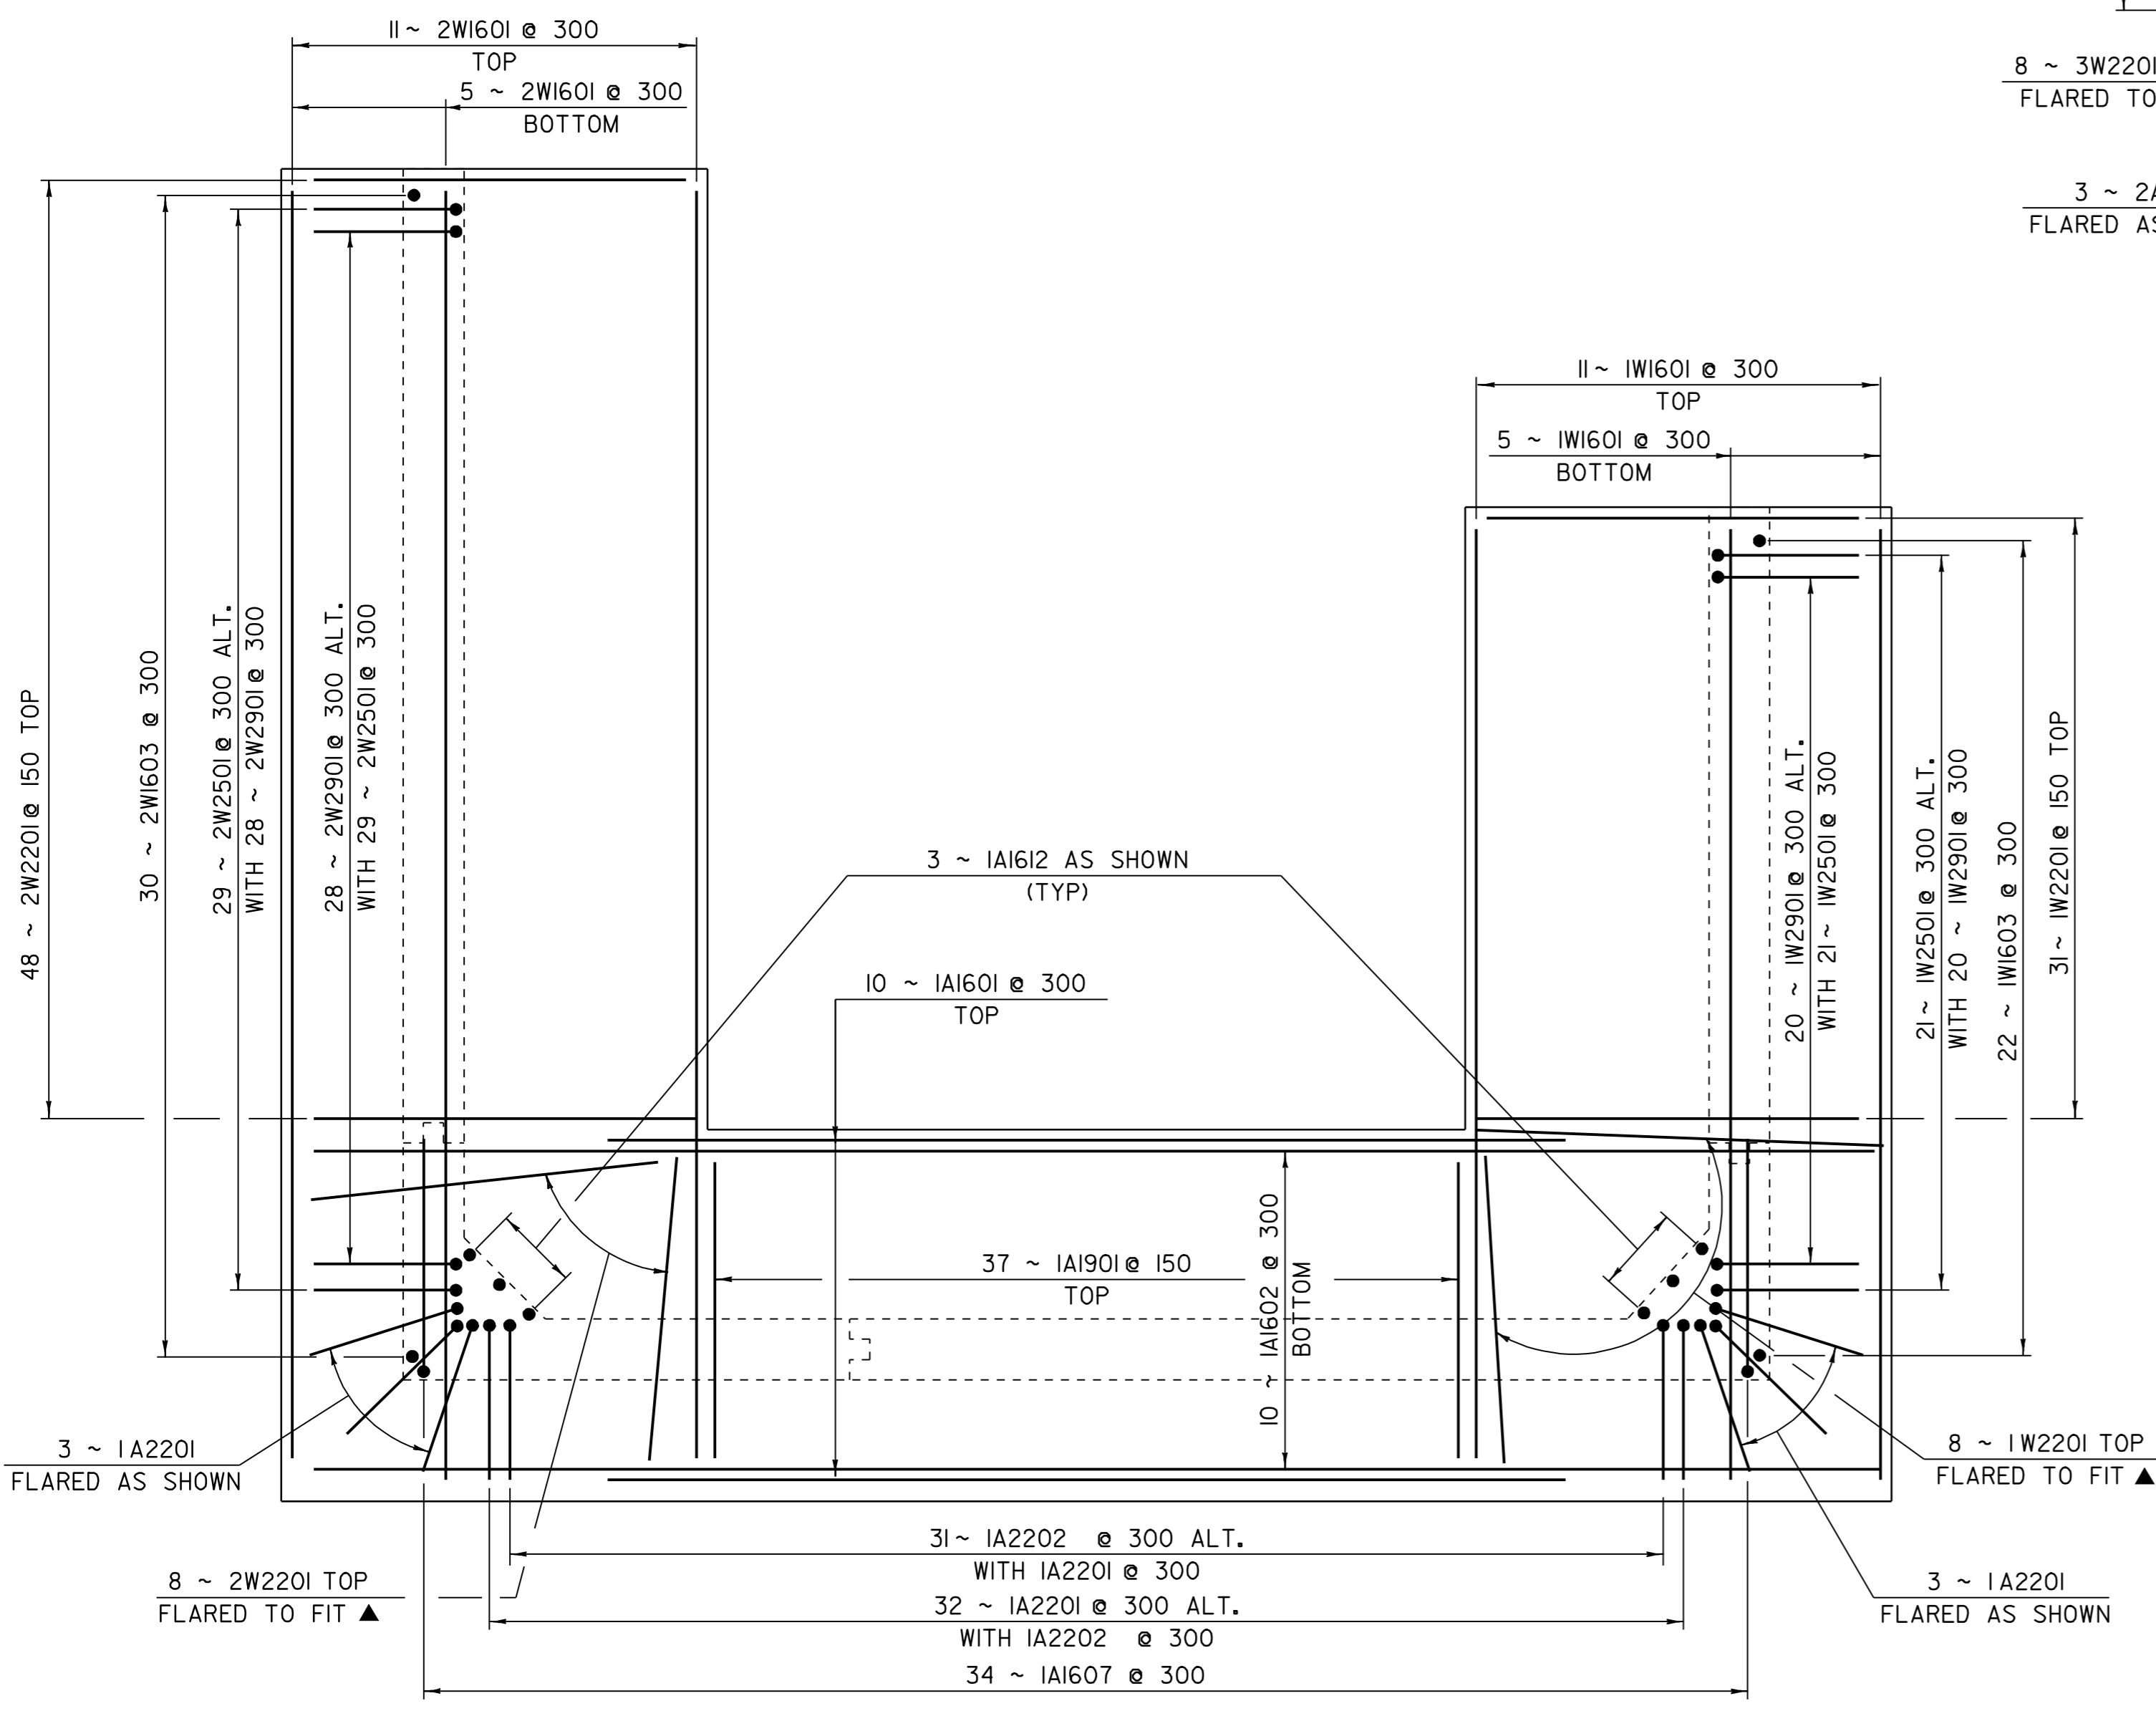

ABUTMENT #1 REINFORCING PLAN Δ
SCALE: 1:40

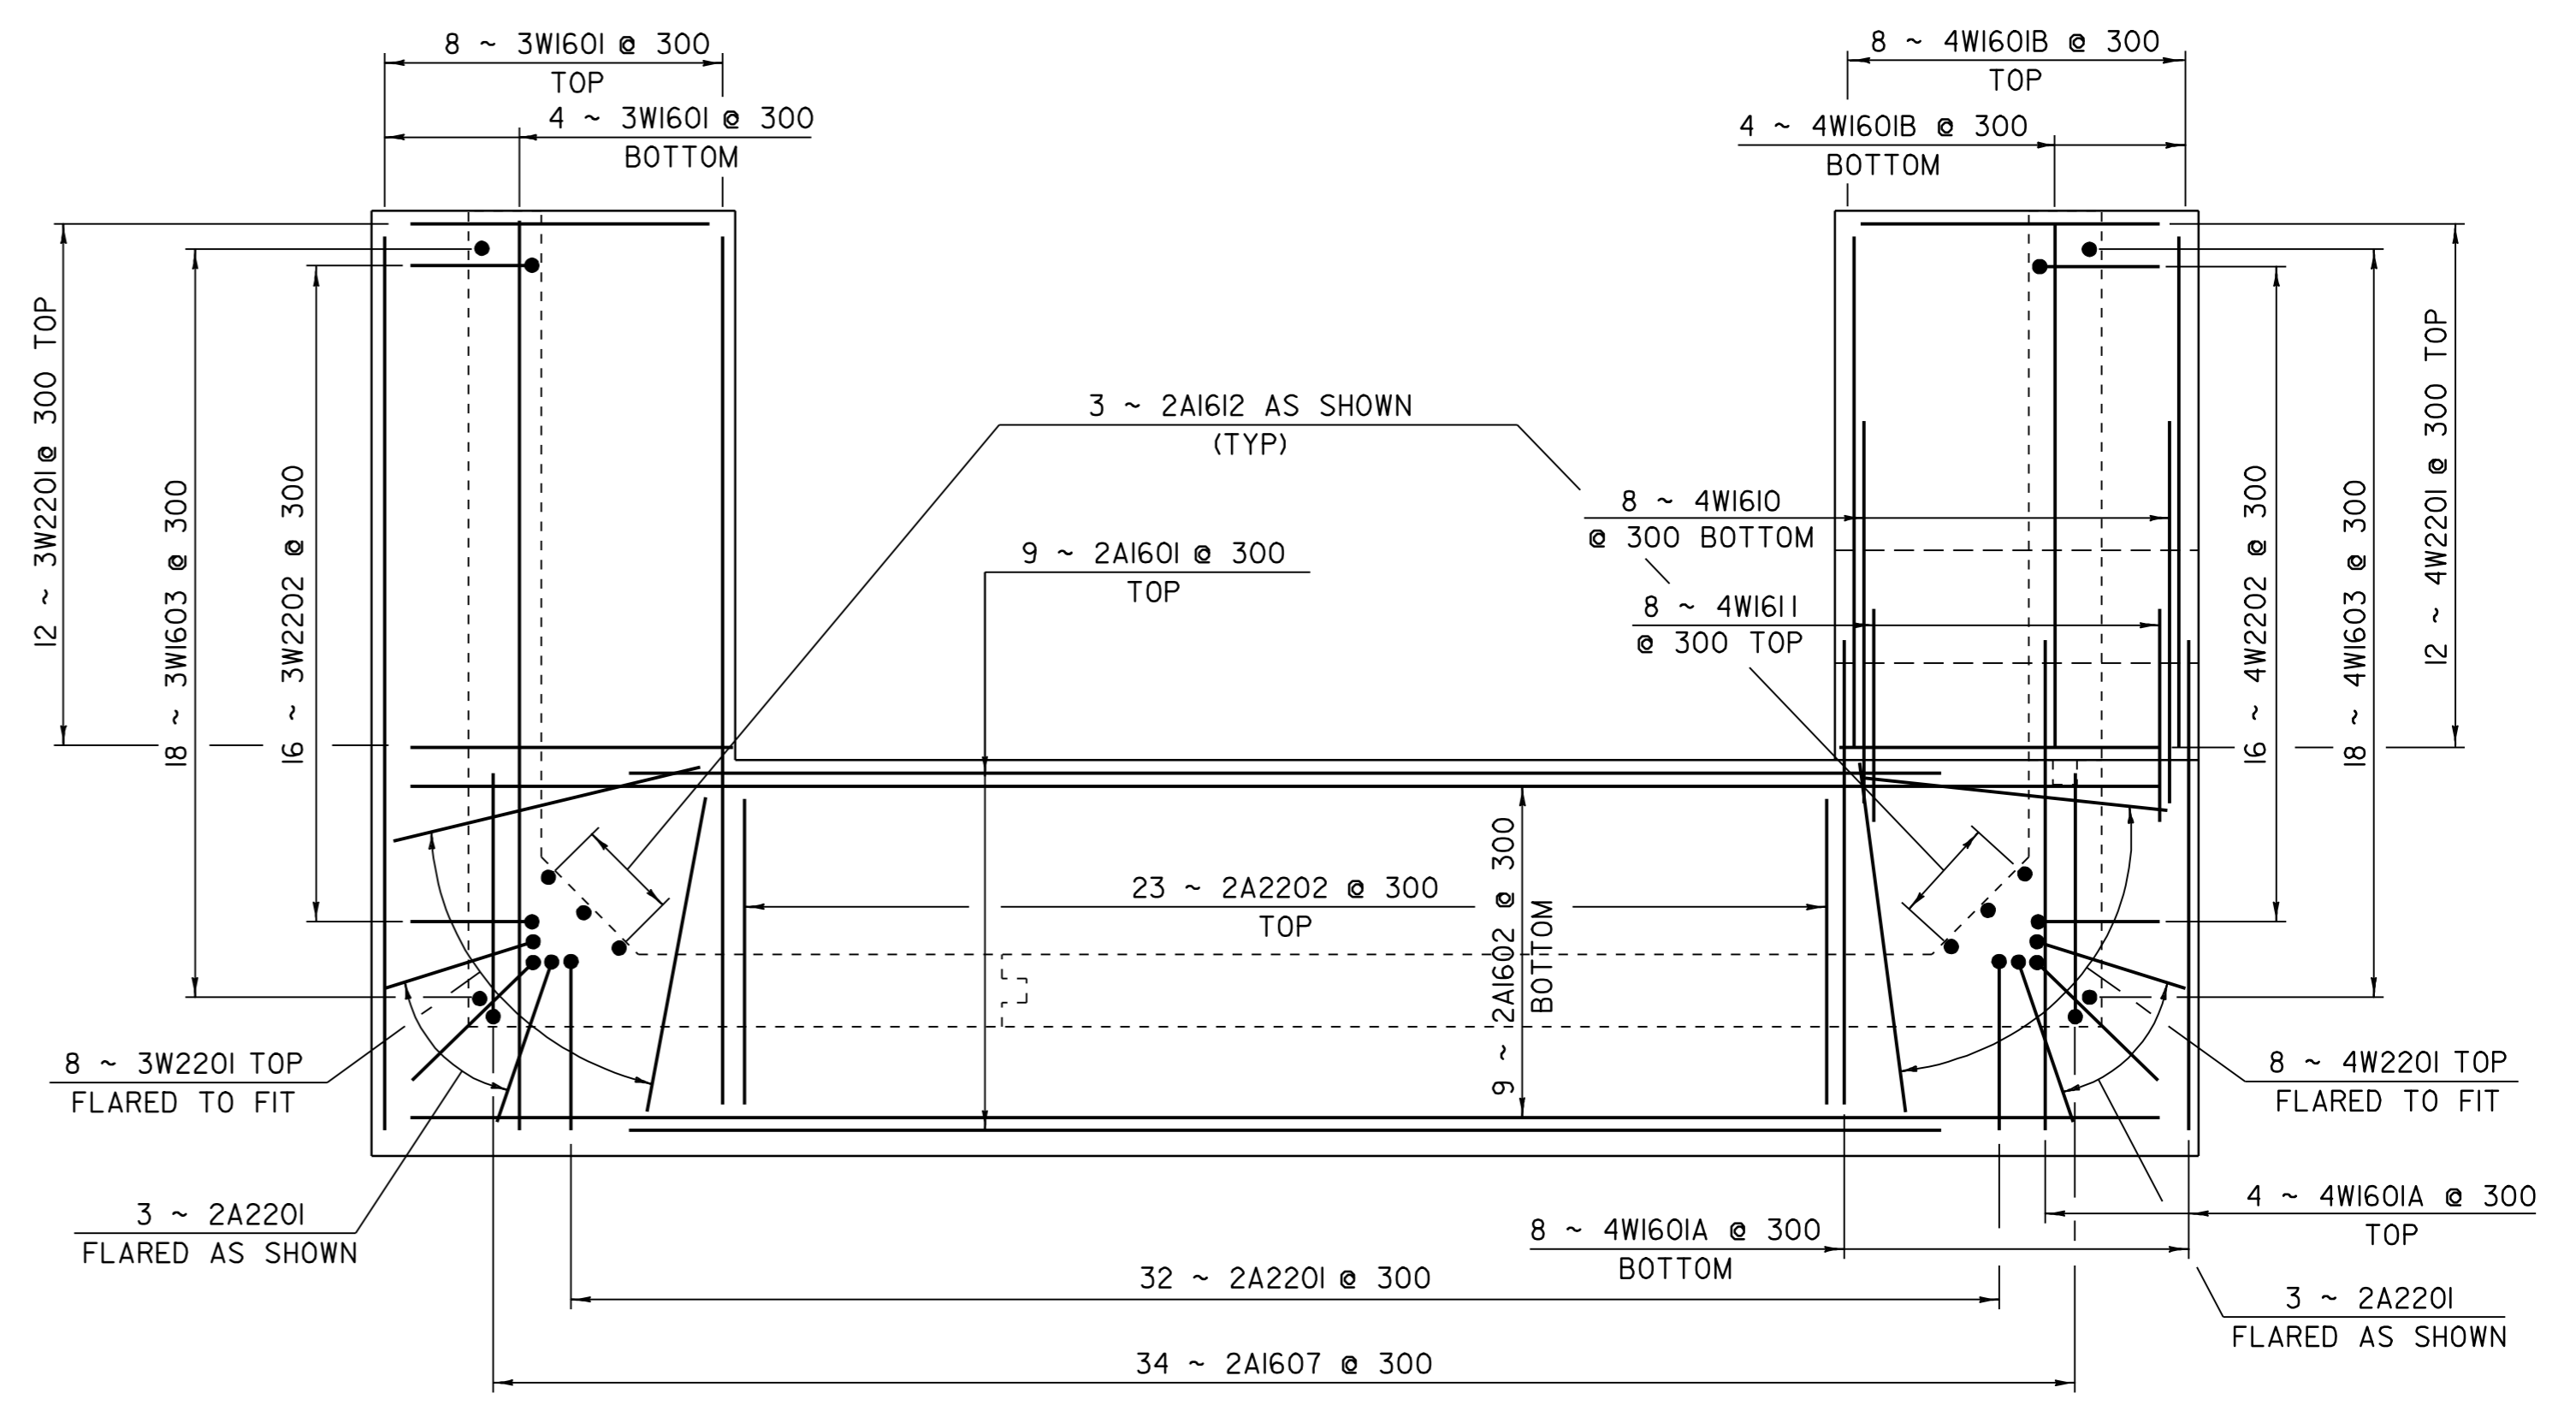

ABUTMENT #2 REINFORCING PLAN Δ
SCALE: 1:40


NOTES

1. NF = NEAR FACE
2. FF = FAR FACE
3. EF = EACH FACE
4. Δ = CUT TO FIT IN FIELD
5. 80 CLEAR UNLESS OTHERWISE SPECIFIED ON THE PLANS
6. ALL LAPS NOT DETAILED SHALL BE 660



SHEET NAME: FOOTING REINFORCING	
PROJECT NAME: WESTFORD	HIGHWAY NO.: TH 4
PROJECT NUMBER: TH2 9436	BRIDGE NO.: 2
	OVER: ROGERS BROOK
FILE NAME: 94J122\Structures\sj122sup.dgn	PLOT DATE: 22-DEC-2006
PROJECT MANAGER: R. R. WHITCOMB	DRAWN BY: T. FILLBACH
DESIGNED BY: T. FILLBACH	IPARM NAME: sj122ftg.1
BRIDGE SHEET NUMBER:	SHEET 35 OF 56

REVISION	DATE	BY	CHK'D	DESCRIPTION
Δ	06/27/2005	GFR	CWC	ABUTMENTS MODIFIED DUE TO UPDATED LEDGE INFORMATION.

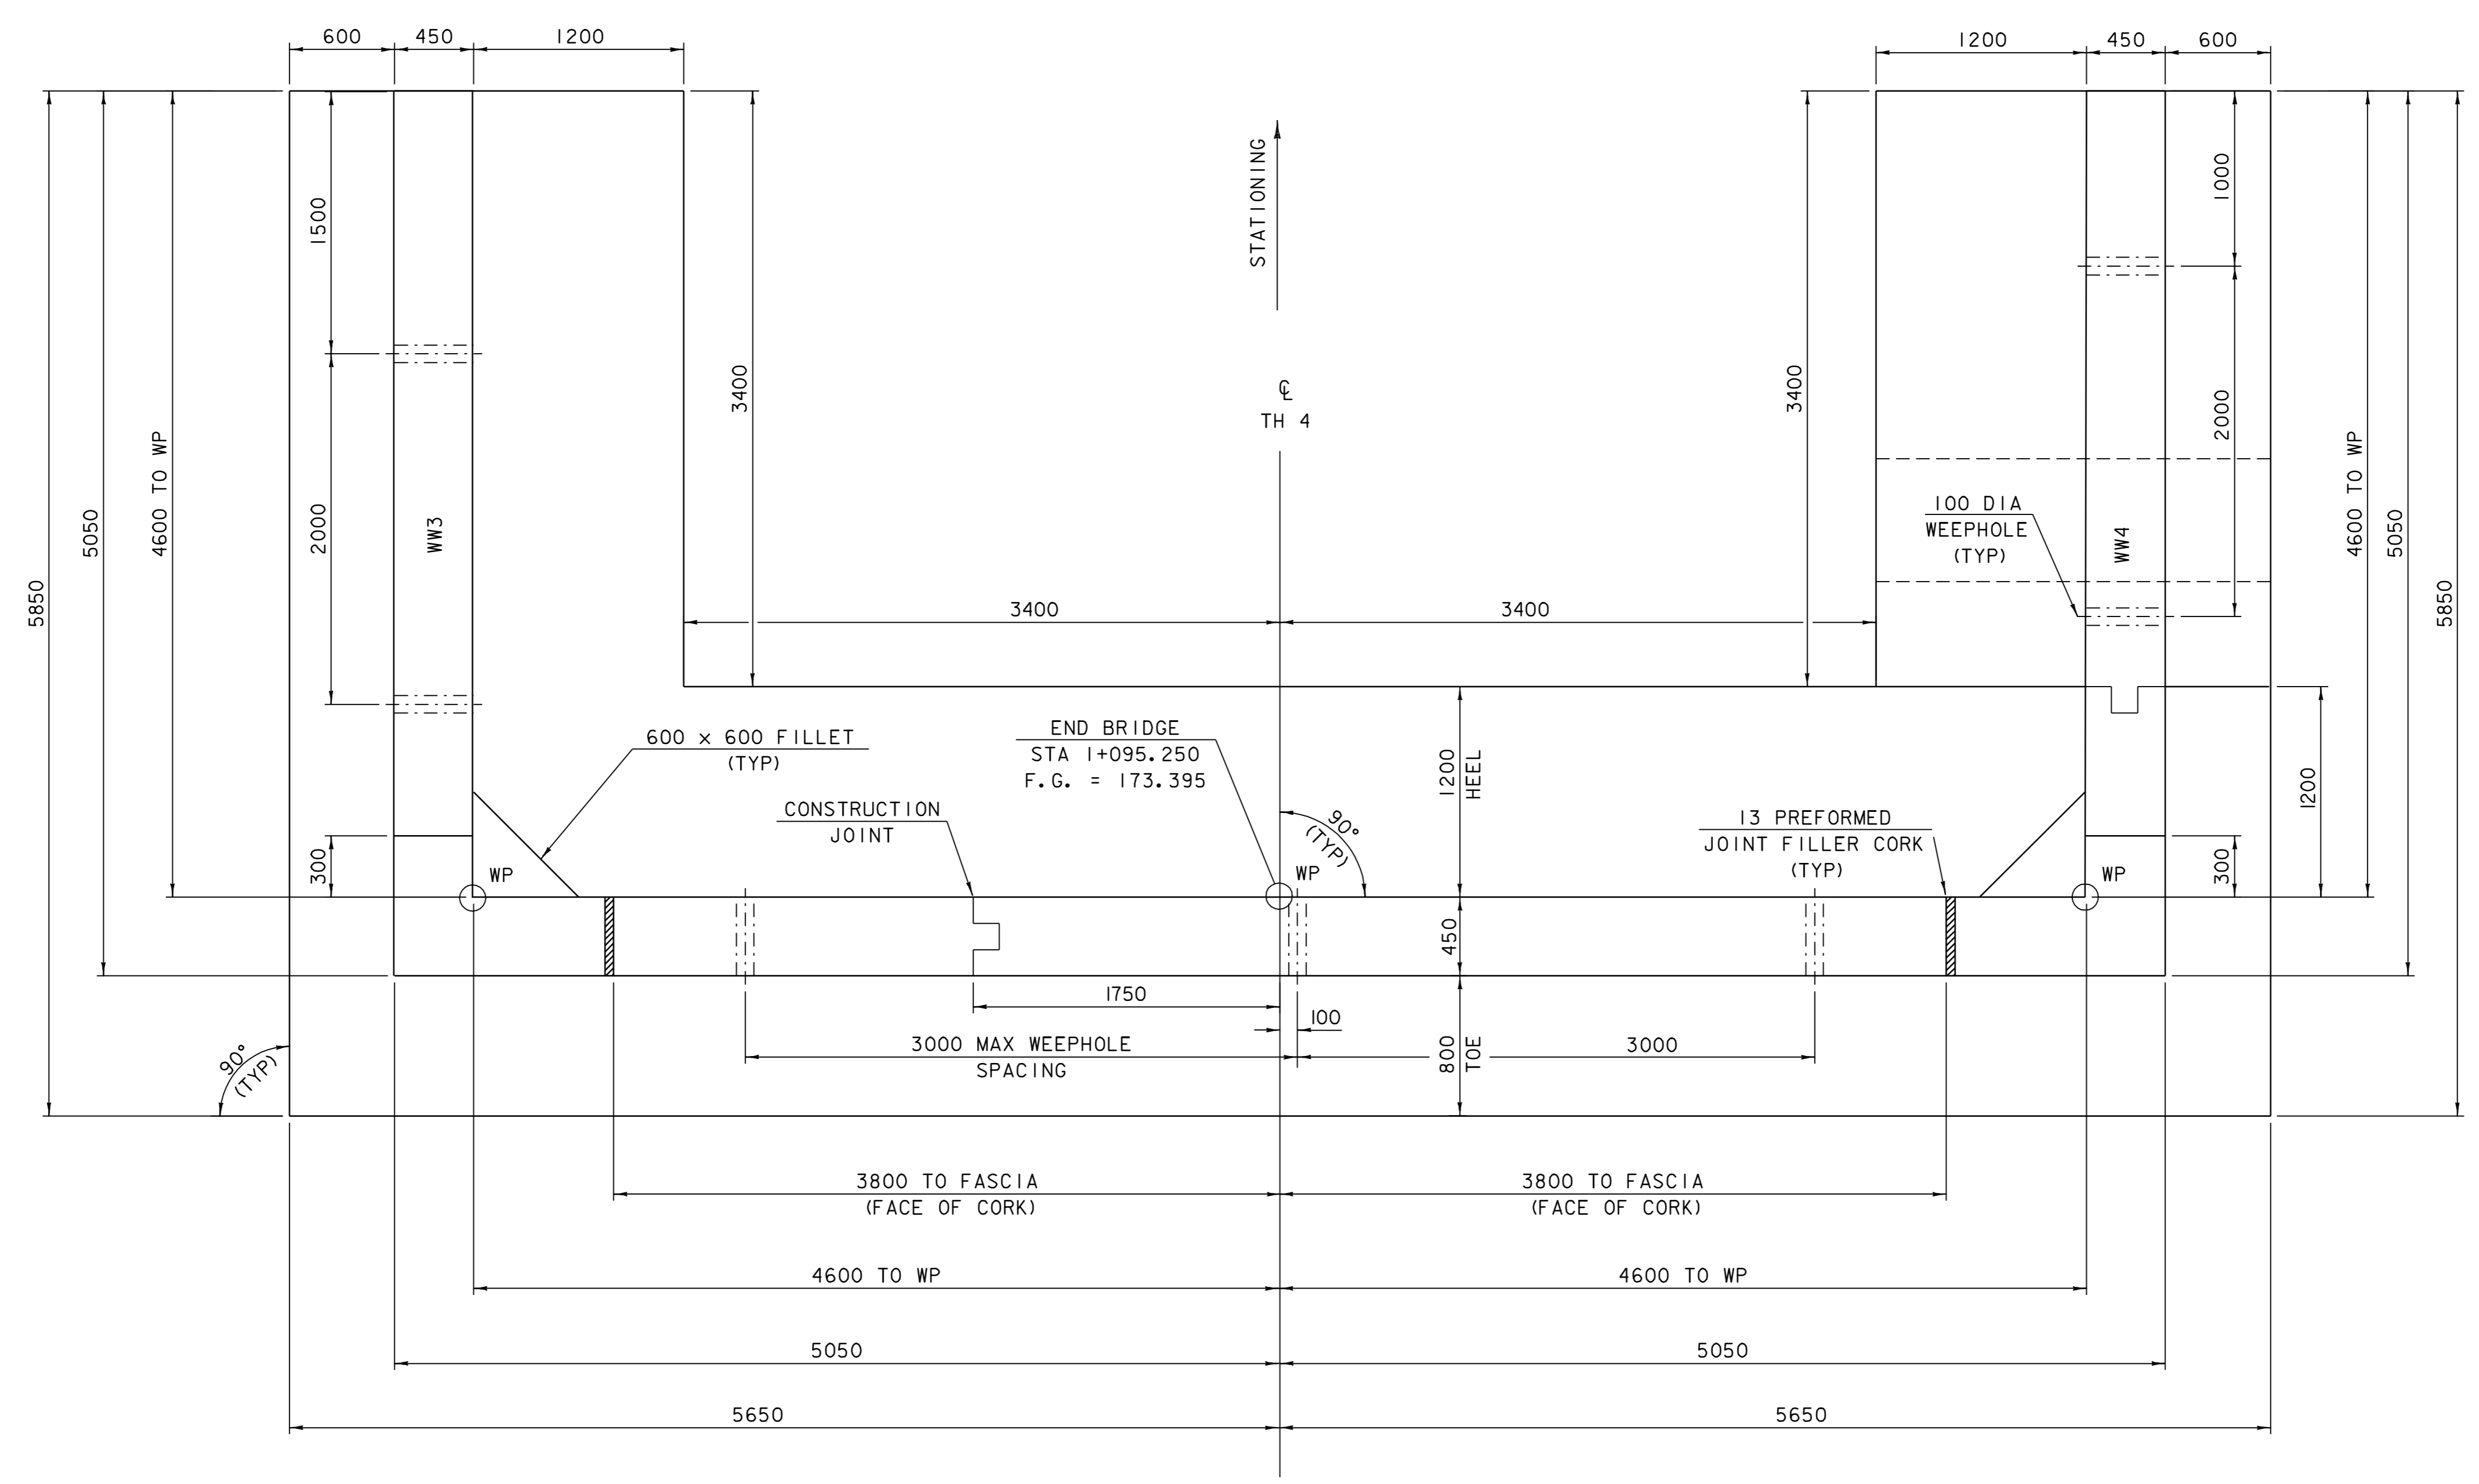

ABUTMENT #2 PLAN Δ



SCALE = 1:25


FLOW \rightarrow

SHEET NAME: **ABUTMENT #2 PLAN**

PROJECT NAME: WESTFORD
 PROJECT NUMBER: TH2 9436
 HIGHWAY NO.: TH 4
 BRIDGE NO.: 2
 OVER: ROGERS BROOK



FILE NAME: 94J122\Structures\sj122sup.dgn
 PROJECT MANAGER: R. R. WHITCOMB
 DESIGNED BY: T. FILLBACH
 BRIDGE SHEET NUMBER:
 PLOT DATE: 22-DEC-2006
 DRAWN BY: T. FILLBACH
 IPARM NAME: sj122ab2.1
 SHEET 36 OF 56

REVISION	DATE	BY	CHK'D	DESCRIPTION
Δ	06/27/2005	GFR	CWC	ABUTMENTS MODIFIED DUE TO UPDATED LEDGE INFORMATION.

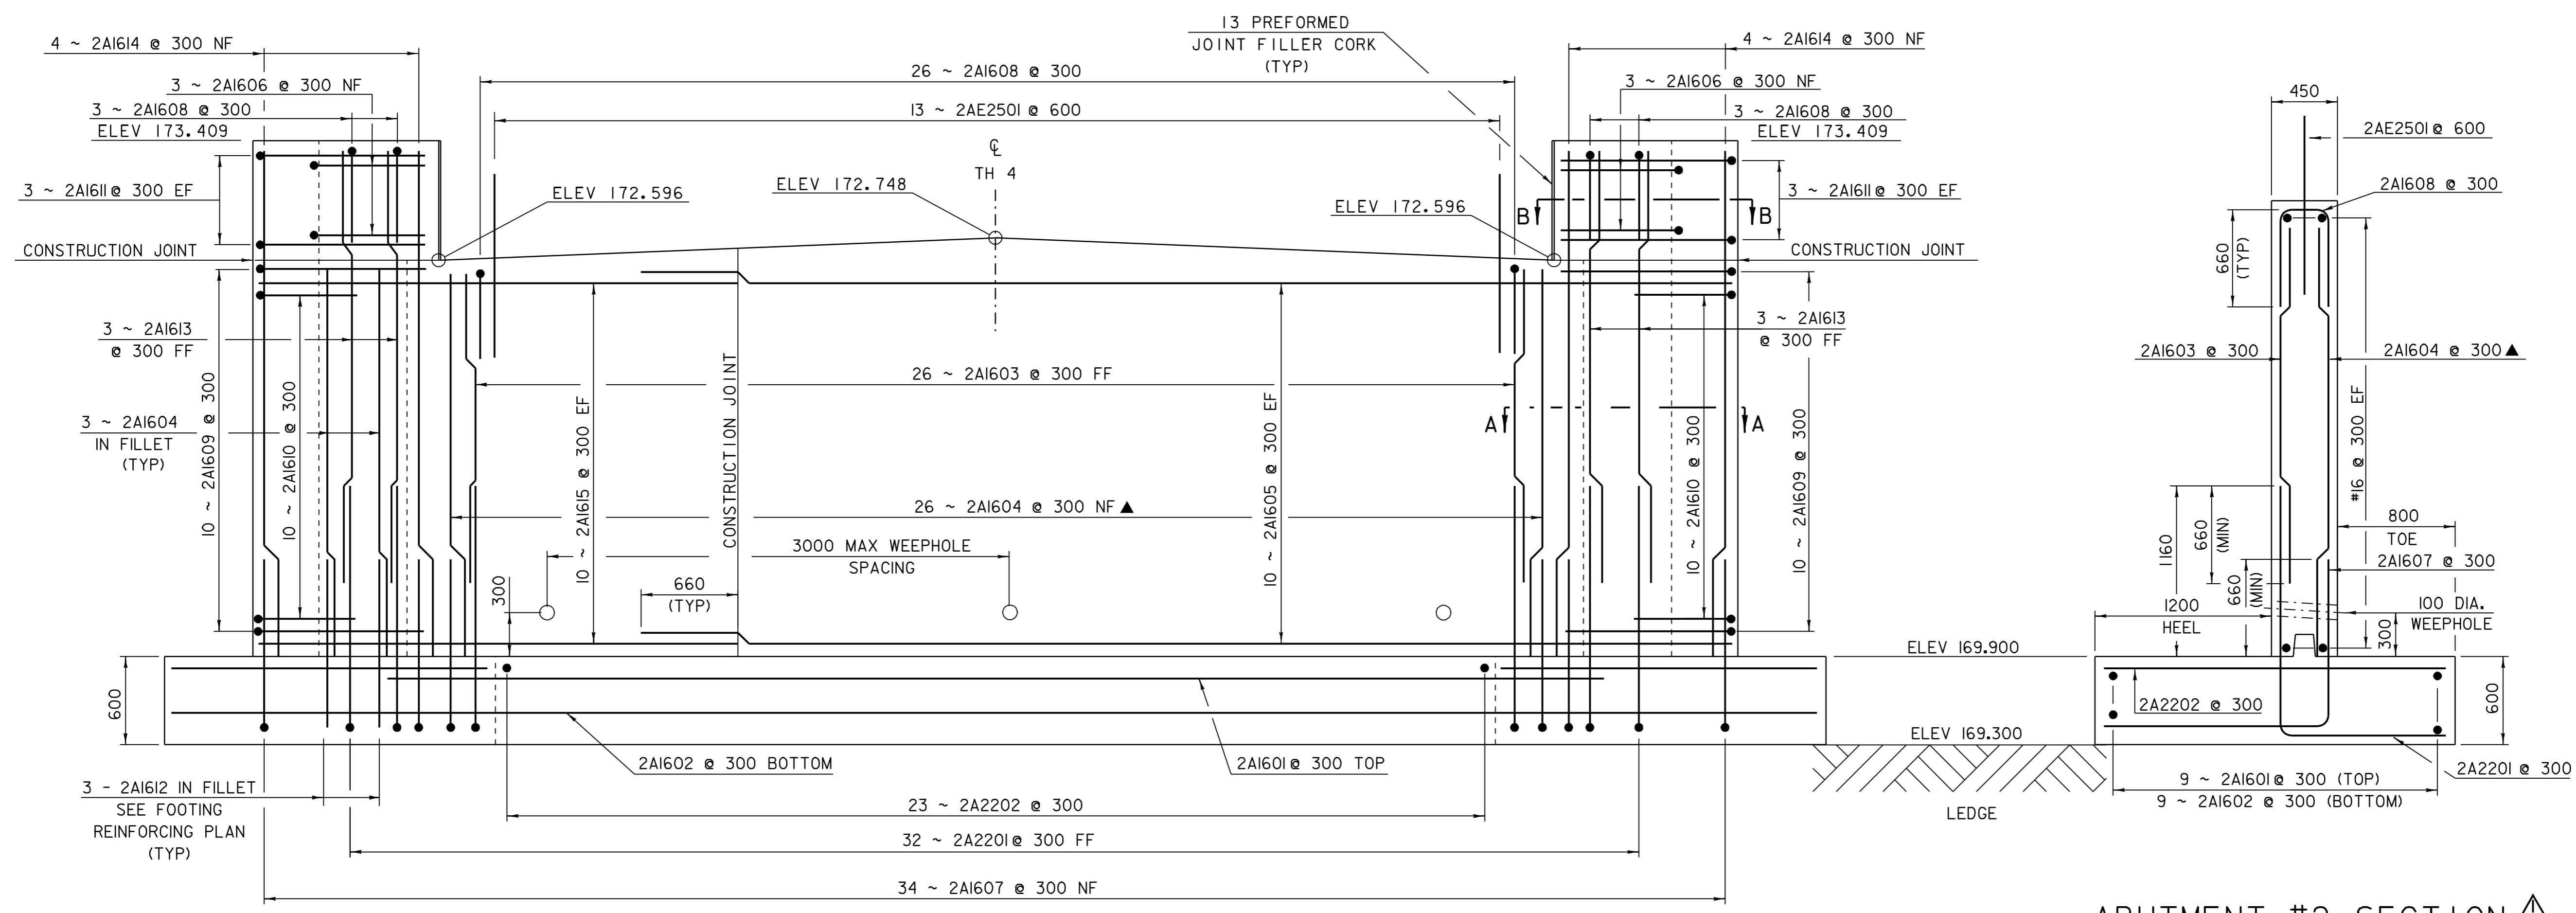


ABUTMENT #2 SECTION A
SCALE: 1:25

ABUTMENT #2 ELEVATION A
SCALE: 1:25

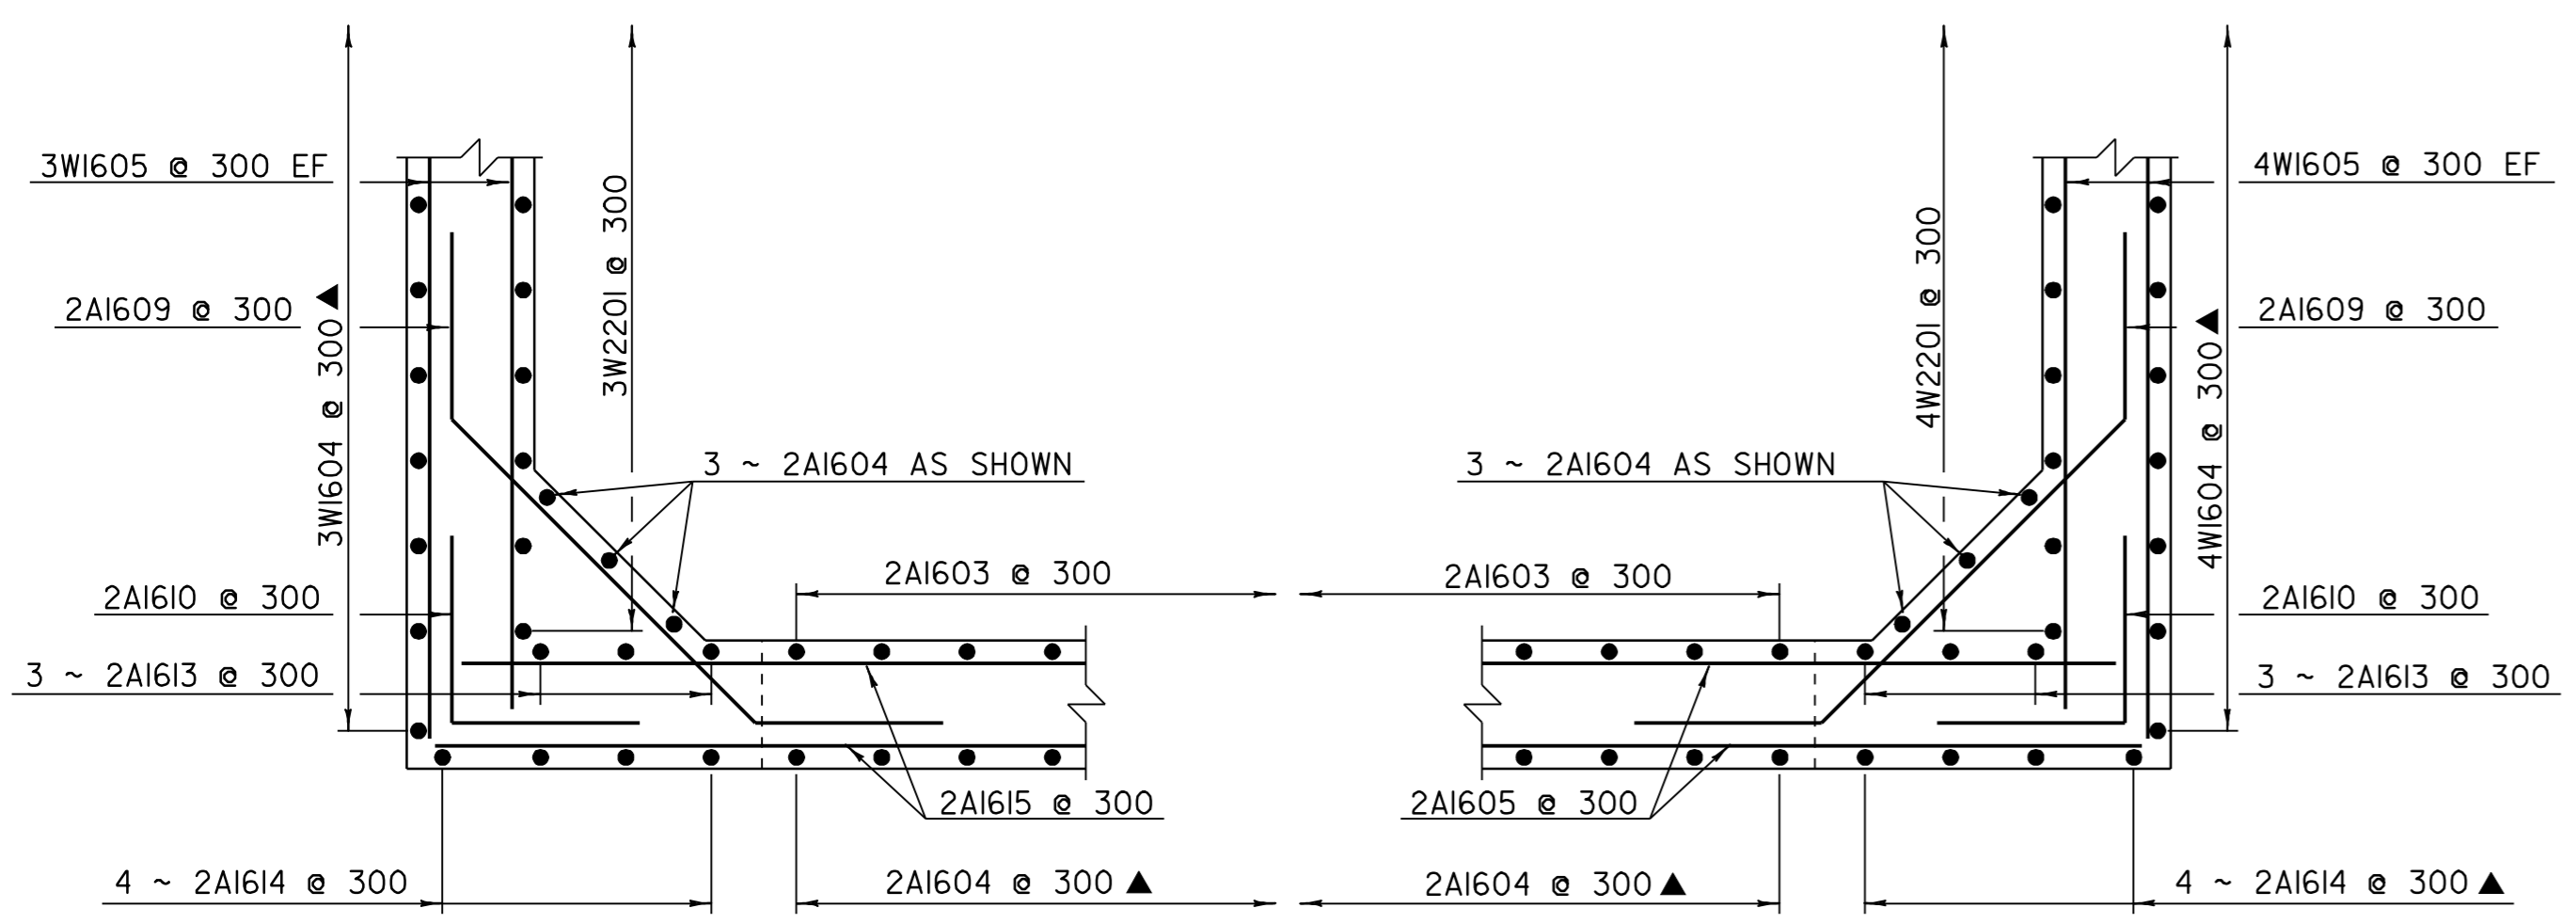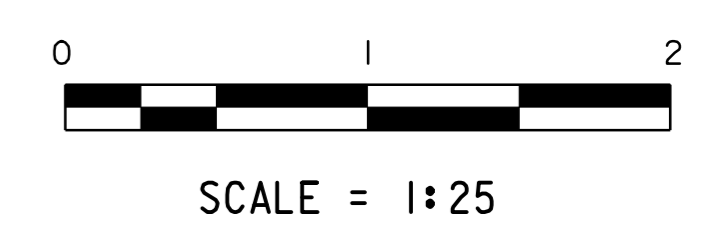

CORNER DETAILS BELOW BRIDGE SEAT
SCALE: 1:25

SECTION A-A

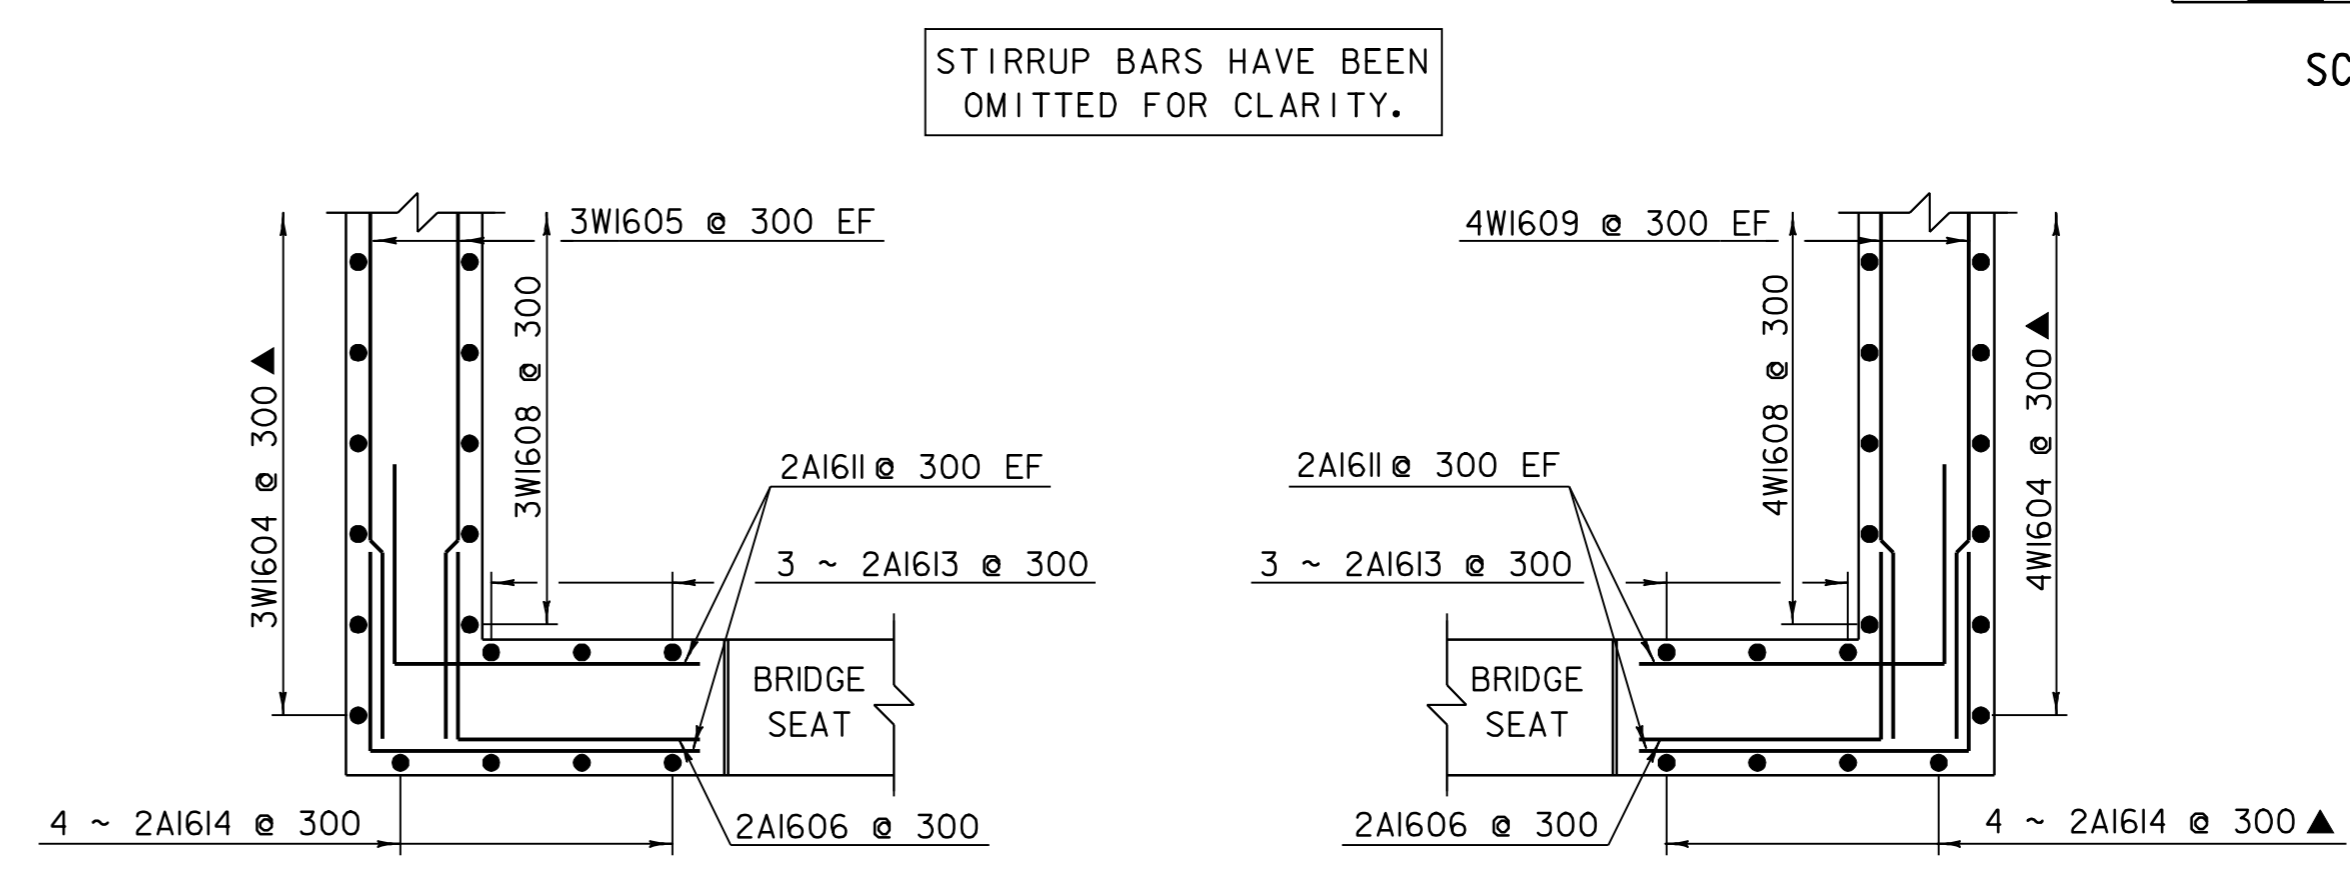


CORNER DETAILS ABOVE BRIDGE SEAT
SCALE: 1:25
SECTION B-B


- NOTES**
1. NF = NEAR FACE
 2. FF = FAR FACE
 3. EF = EACH FACE
 4. ▲ = CUT TO FIT IN FIELD
 5. 80 CLEAR UNLESS OTHERWISE SPECIFIED ON THE PLANS
 6. ALL LAPS NOT DETAILED SHALL BE 660 (MIN)
 7. 3000 MAX. WEEPHOLE SPACING
 8. SEE SHEET 35 FOR FOOTING REINFORCING PLAN.

SHEET NAME: ABUTMENT #2 ELEVATION	
PROJECT NAME: WESTFORD	HIGHWAY NO.: TH 4
PROJECT NUMBER: TH2 9436	BRIDGE NO.: 2
	OVER: ROGERS BROOK
FILE NAME: 94J122\Structures\sj122sup.dgn	PLOT DATE: 22-DEC-2006
PROJECT MANAGER: G.S. ROGERS	DRAWN BY: T. FILLBACH
DESIGNED BY: T. FILLBACH	IPARM NAME: sj122ev2.1
BRIDGE SHEET NUMBER:	SHEET 37 OF 56


REVISION	DATE	BY	CHK'D	DESCRIPTION
A	06/27/2005	GFR	CWC	ABUTMENTS MODIFIED DUE TO UPDATED LEDGE INFORMATION.

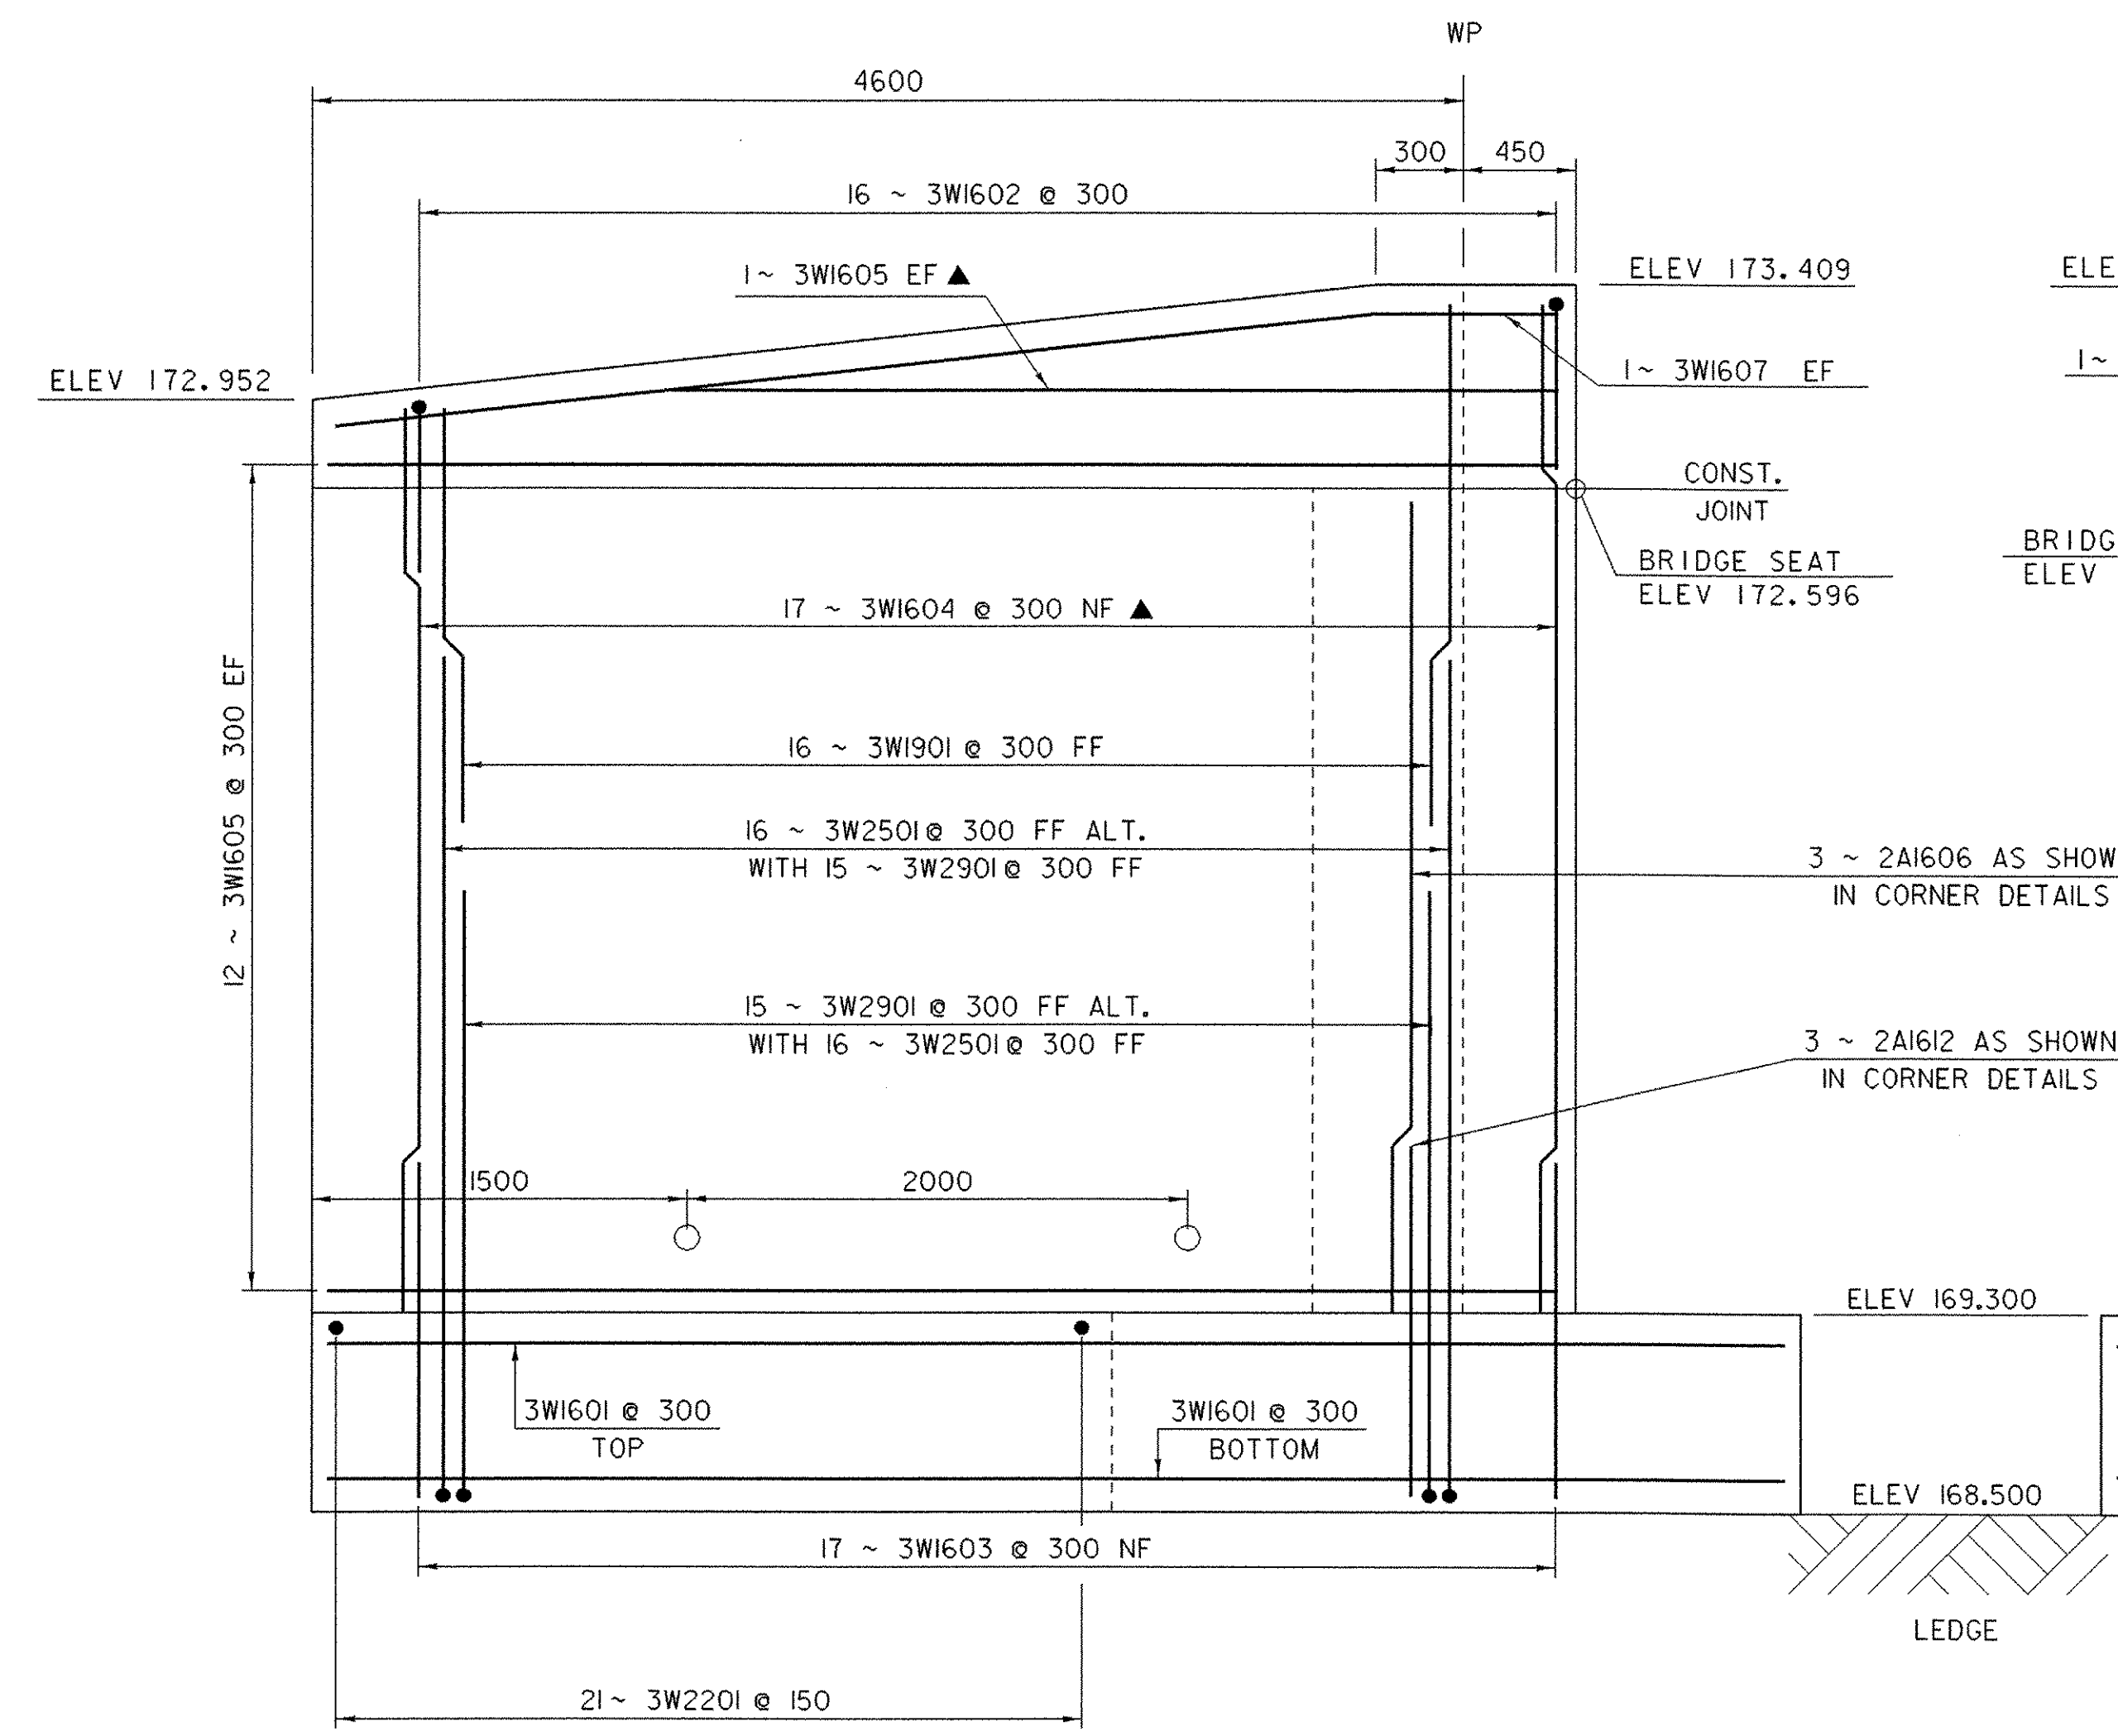

WINGWALL #3 ELEVATION
SCALE: 1:25

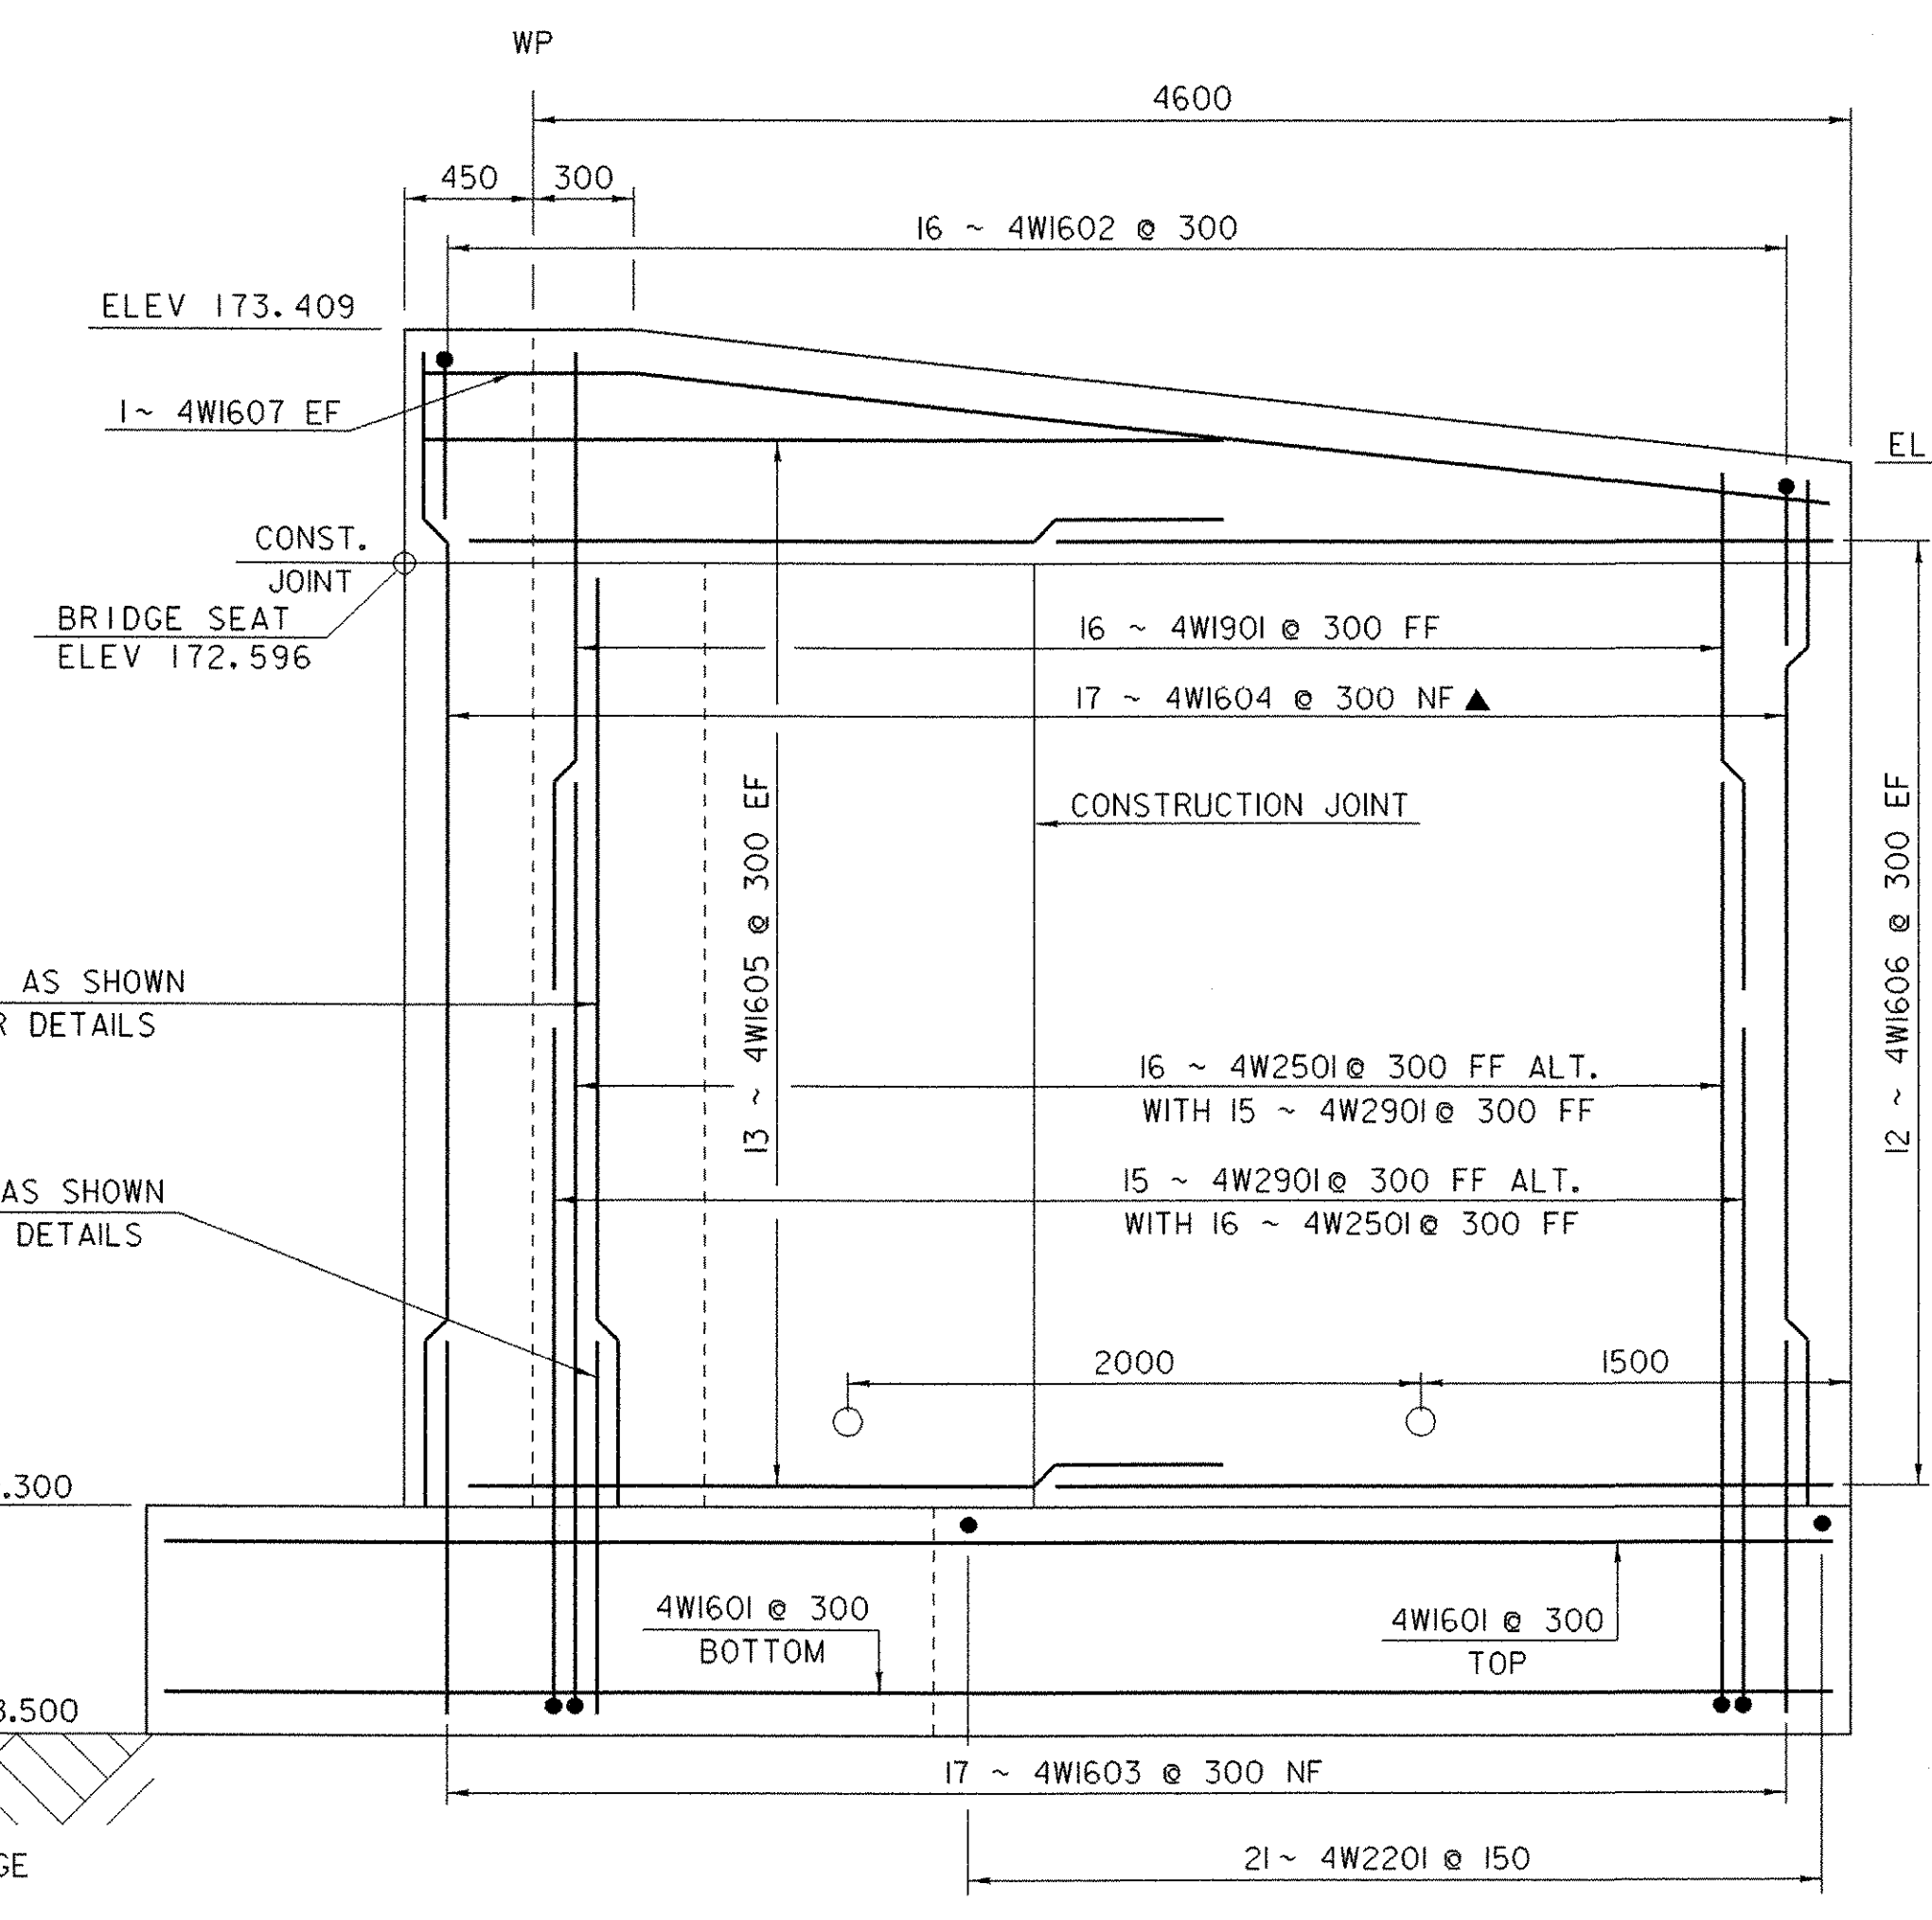

WINGWALL #4 ELEVATION
SCALE: 1:25

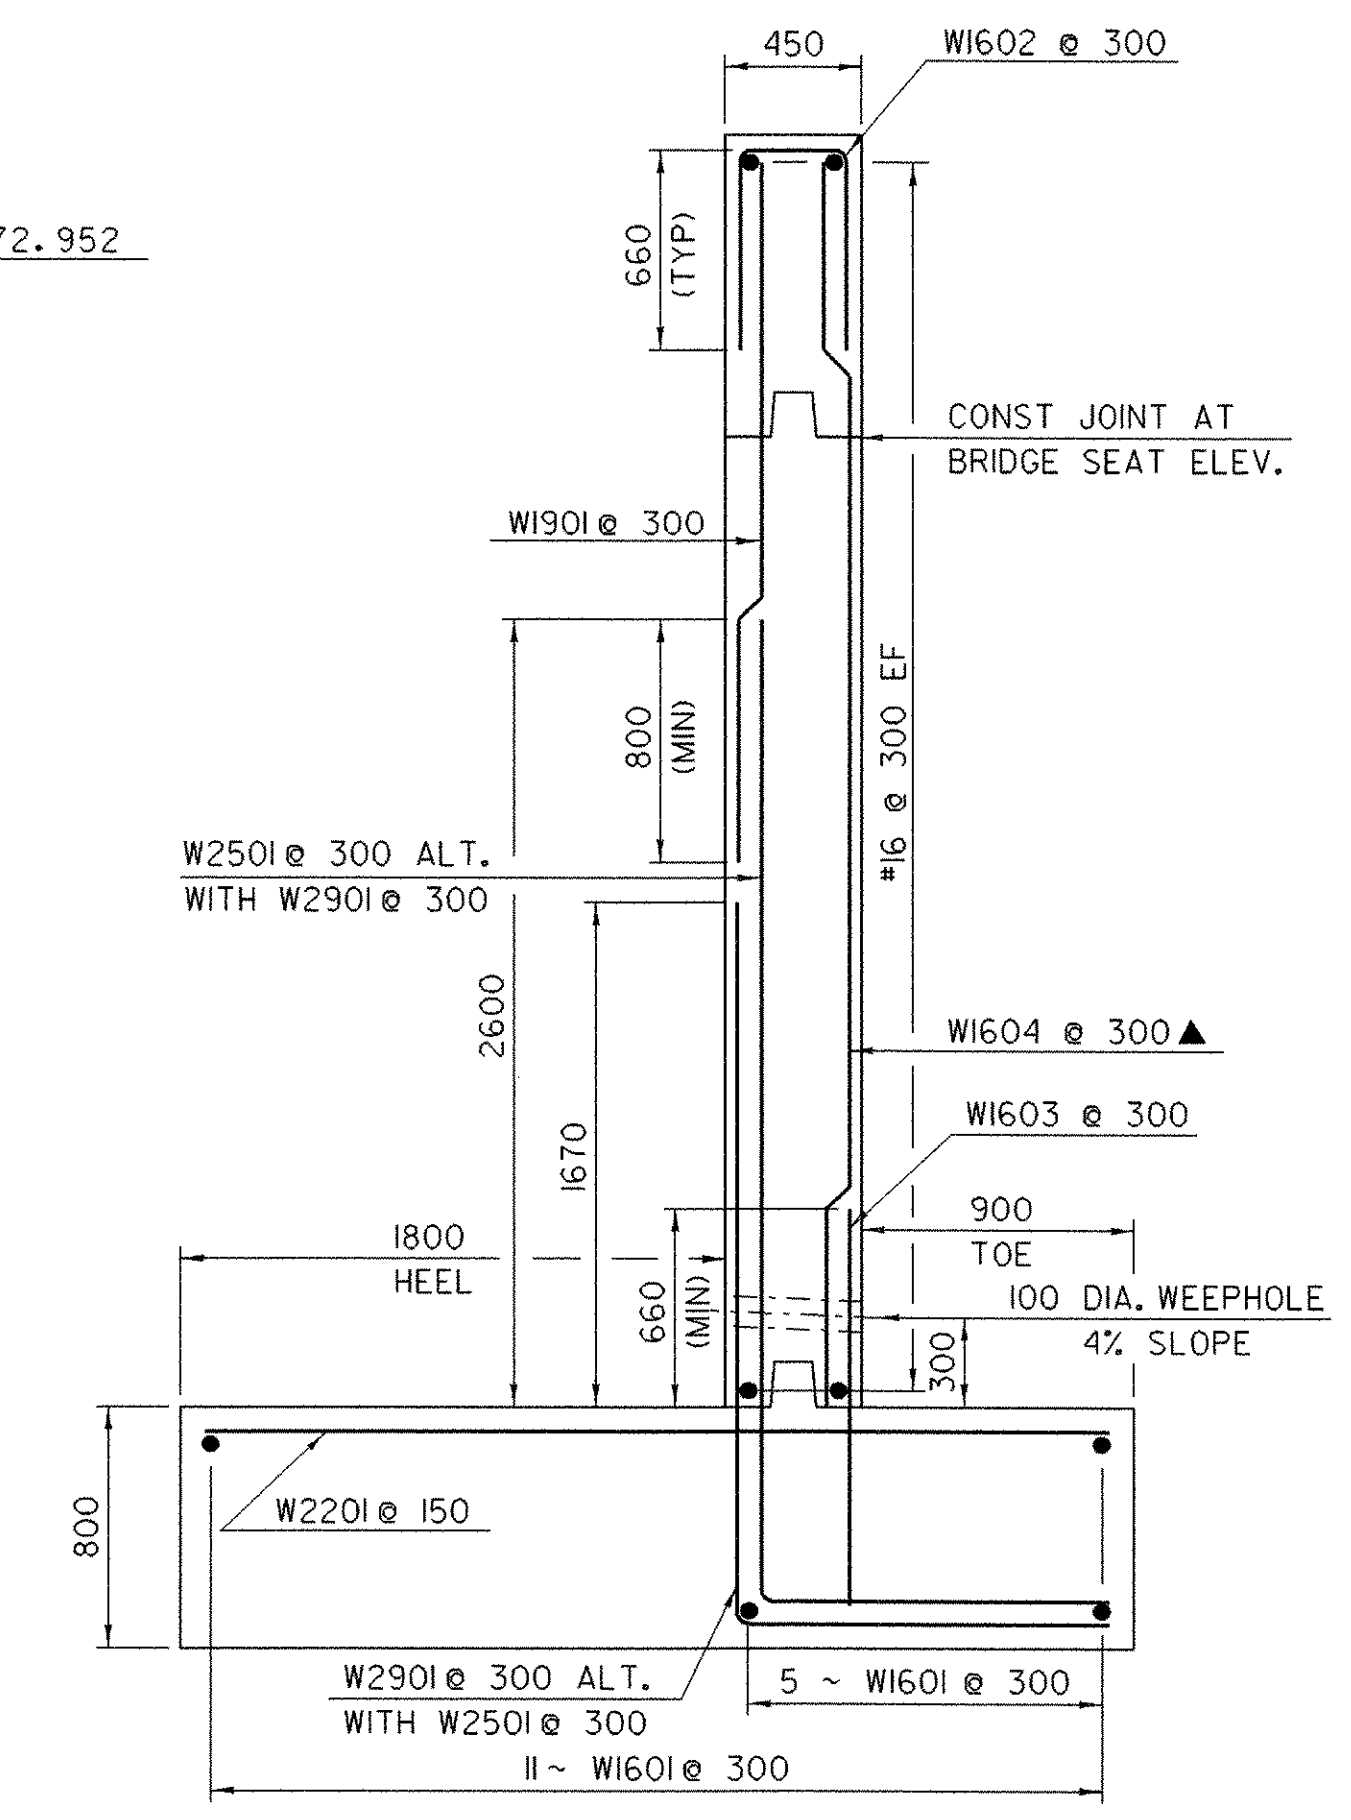

WINGWALL TYPICAL SECTION
(WINGWALL #3 AND #4 ARE SIMILAR)
SCALE: 1:25




SCALE = 1:25

NOTES

1. NF = NEAR FACE
2. FF = FAR FACE
3. EF = EACH FACE
4. ▲ = CUT TO FIT IN FIELD
5. 80 CLEAR UNLESS OTHERWISE SPECIFIED ON THE PLANS
6. 3000 MAX. WEEPHOLE SPACING
7. ALL LAPS NOT DETAILED SHALL BE 660 (MIN)
8. SEE SHEET 37 FOR CORNER DETAILS.

SHEET NAME: WW #3 & WW #4 ELEVATIONS	
PROJECT NAME: WESTFORD	HIGHWAY NO.: TH 4
PROJECT NUMBER: TH2 9436	BRIDGE NO.: 2
	OVER: ROGERS BROOK
FILE NAME: 94J122\Structures\sj122sup.dgn	PLOT DATE: 25-MAR-2005
PROJECT MANAGER: R. R. WHITCOMB	DRAWN BY: T. FILLBACH
DESIGNED BY: T. FILLBACH	IPARM NAME: sj122ww2.1
BRIDGE SHEET NUMBER:	SHEET 38 OF 56

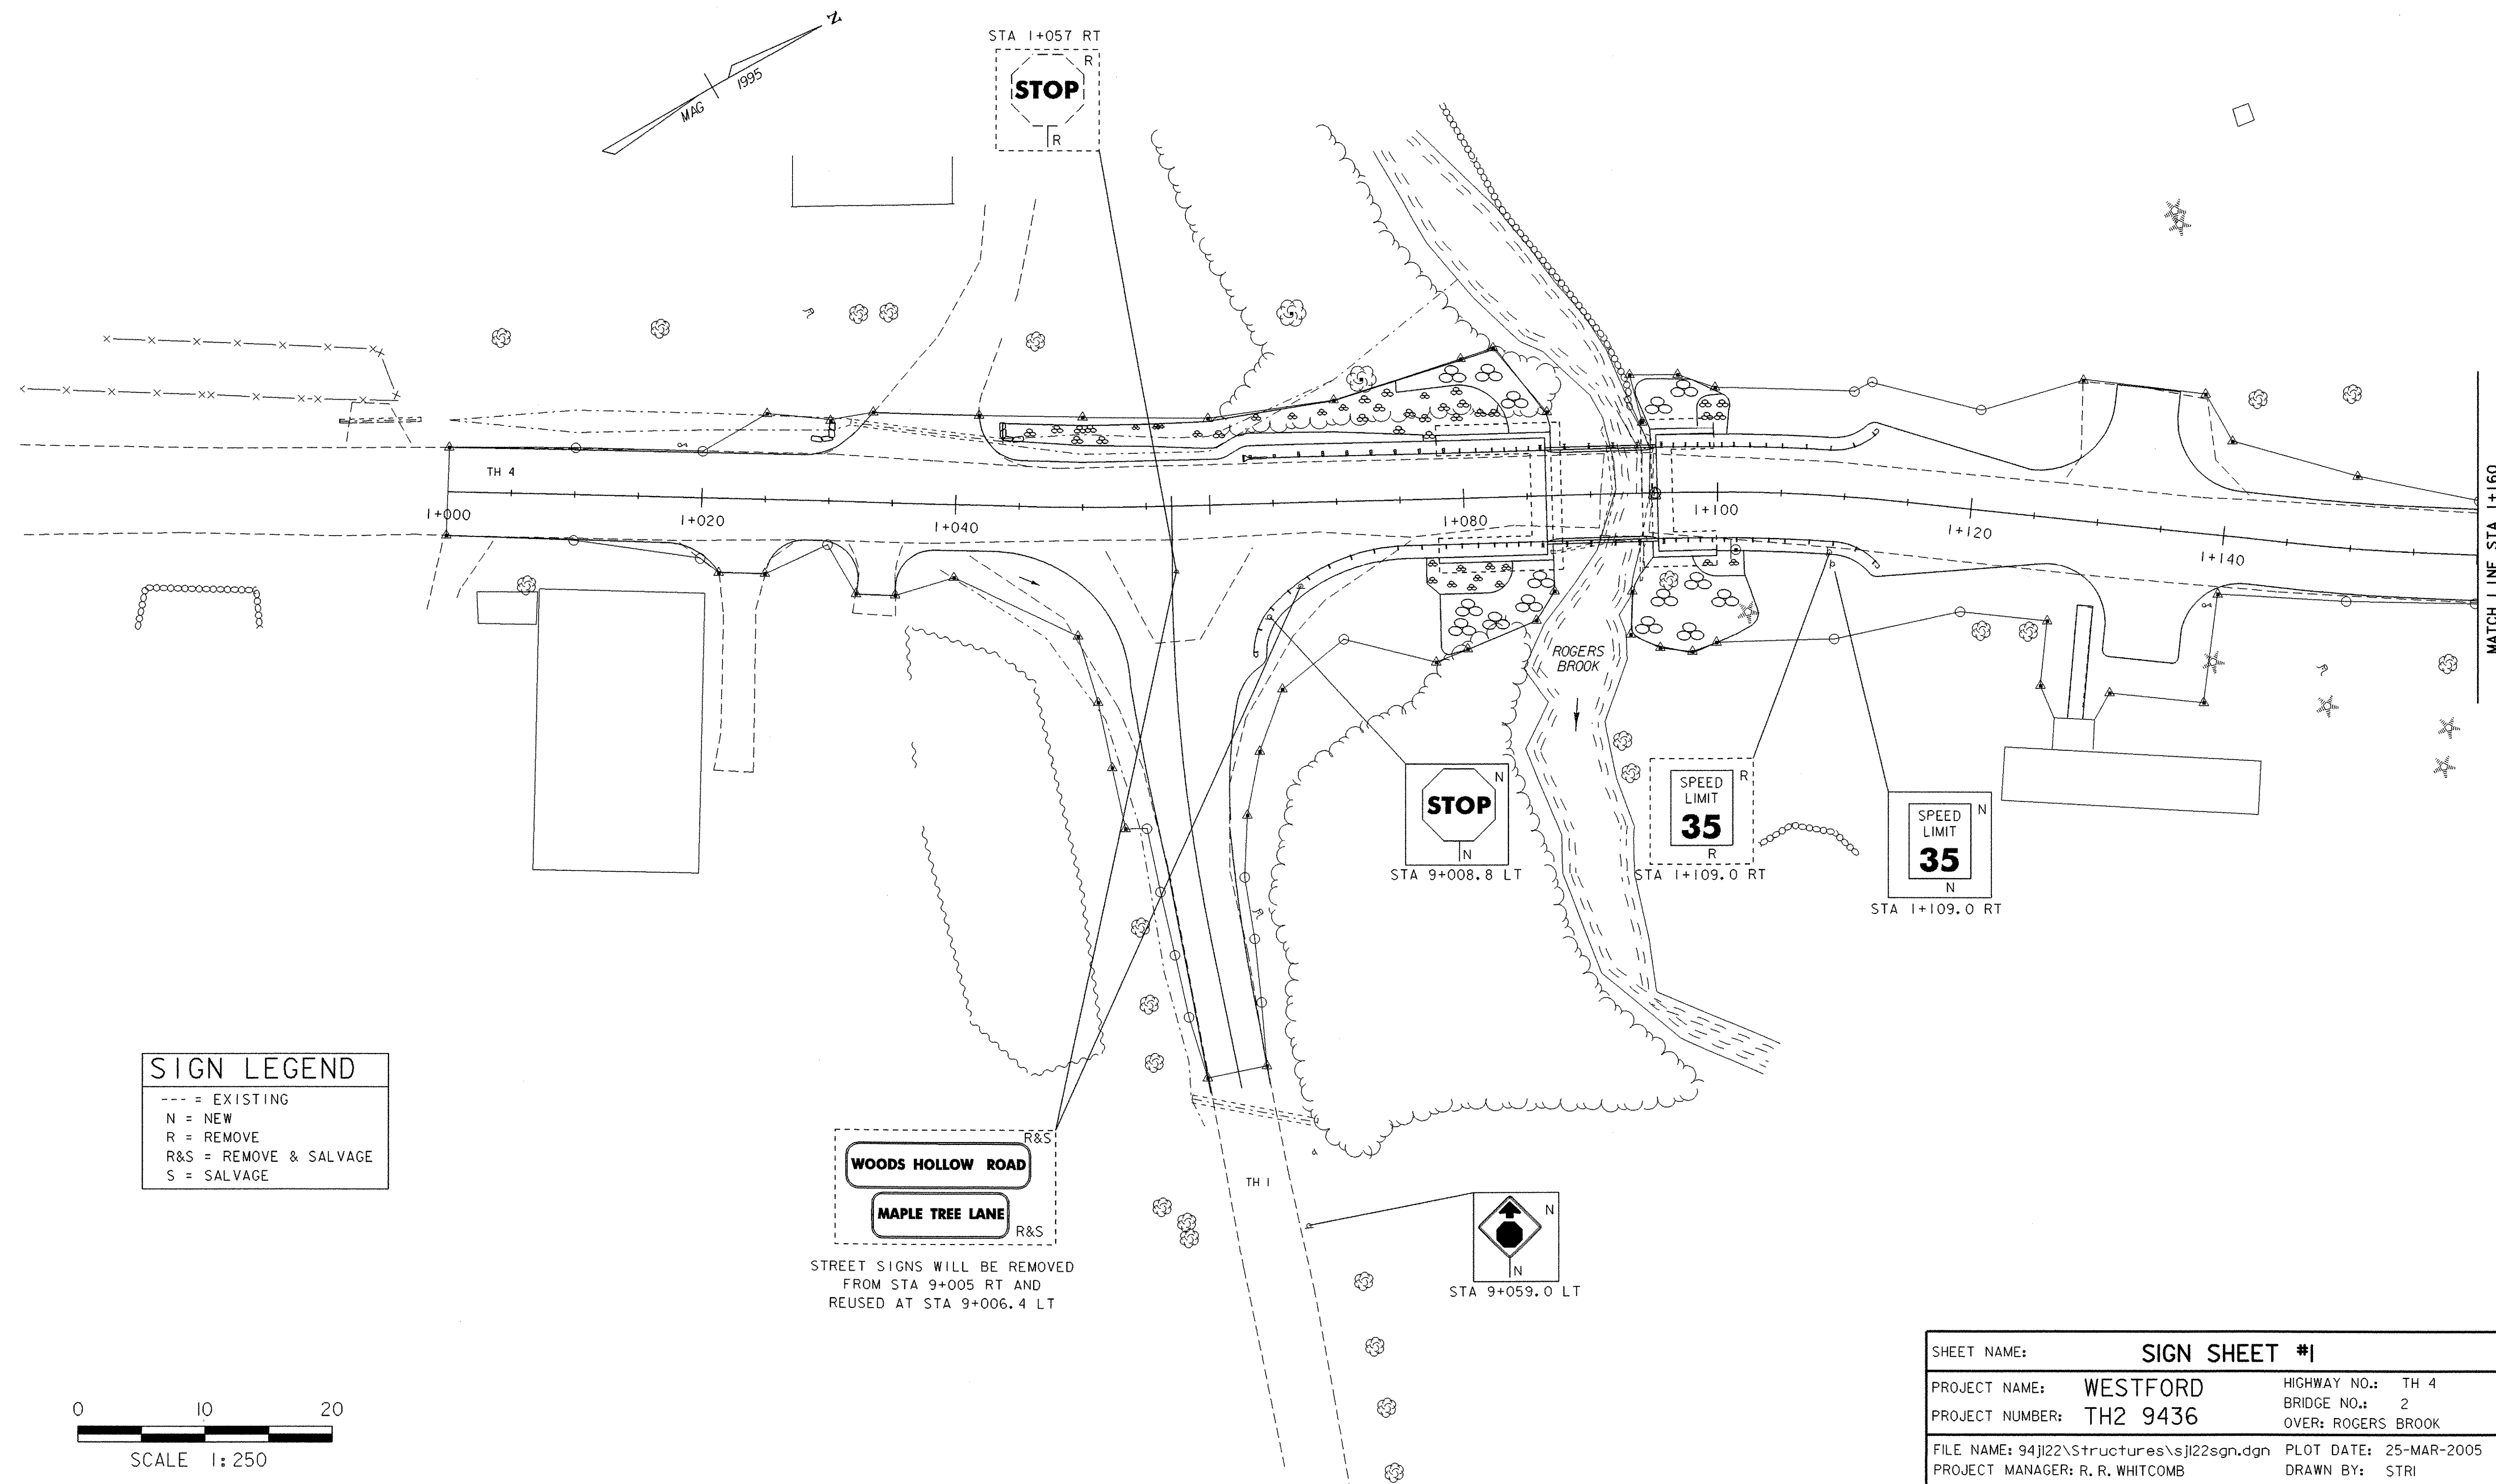


SIGN LEGEND
 --- = EXISTING
 N = NEW
 R = REMOVE
 R&S = REMOVE & SALVAGE
 S = SALVAGE

WOODS HOLLOW ROAD R&S
MAPLE TREE LANE R&S

STREET SIGNS WILL BE REMOVED FROM STA 9+005 RT AND REUSED AT STA 9+006.4 LT


0 10 20
 SCALE 1:250

SHEET NAME: SIGN SHEET #1	
PROJECT NAME: WESTFORD	HIGHWAY NO.: TH 4
PROJECT NUMBER: TH2 9436	BRIDGE NO.: 2
	OVER: ROGERS BROOK
FILE NAME: 94J122\Structures\sj122sgn.dgn	PLOT DATE: 25-MAR-2005
PROJECT MANAGER: R. R. WHITCOMB	DRAWN BY: STRI
DESIGNED BY: C. CARLSON	IPARM NAME: sj122sg3.1
BRIDGE SHEET NUMBER:	SHEET 40 OF 56

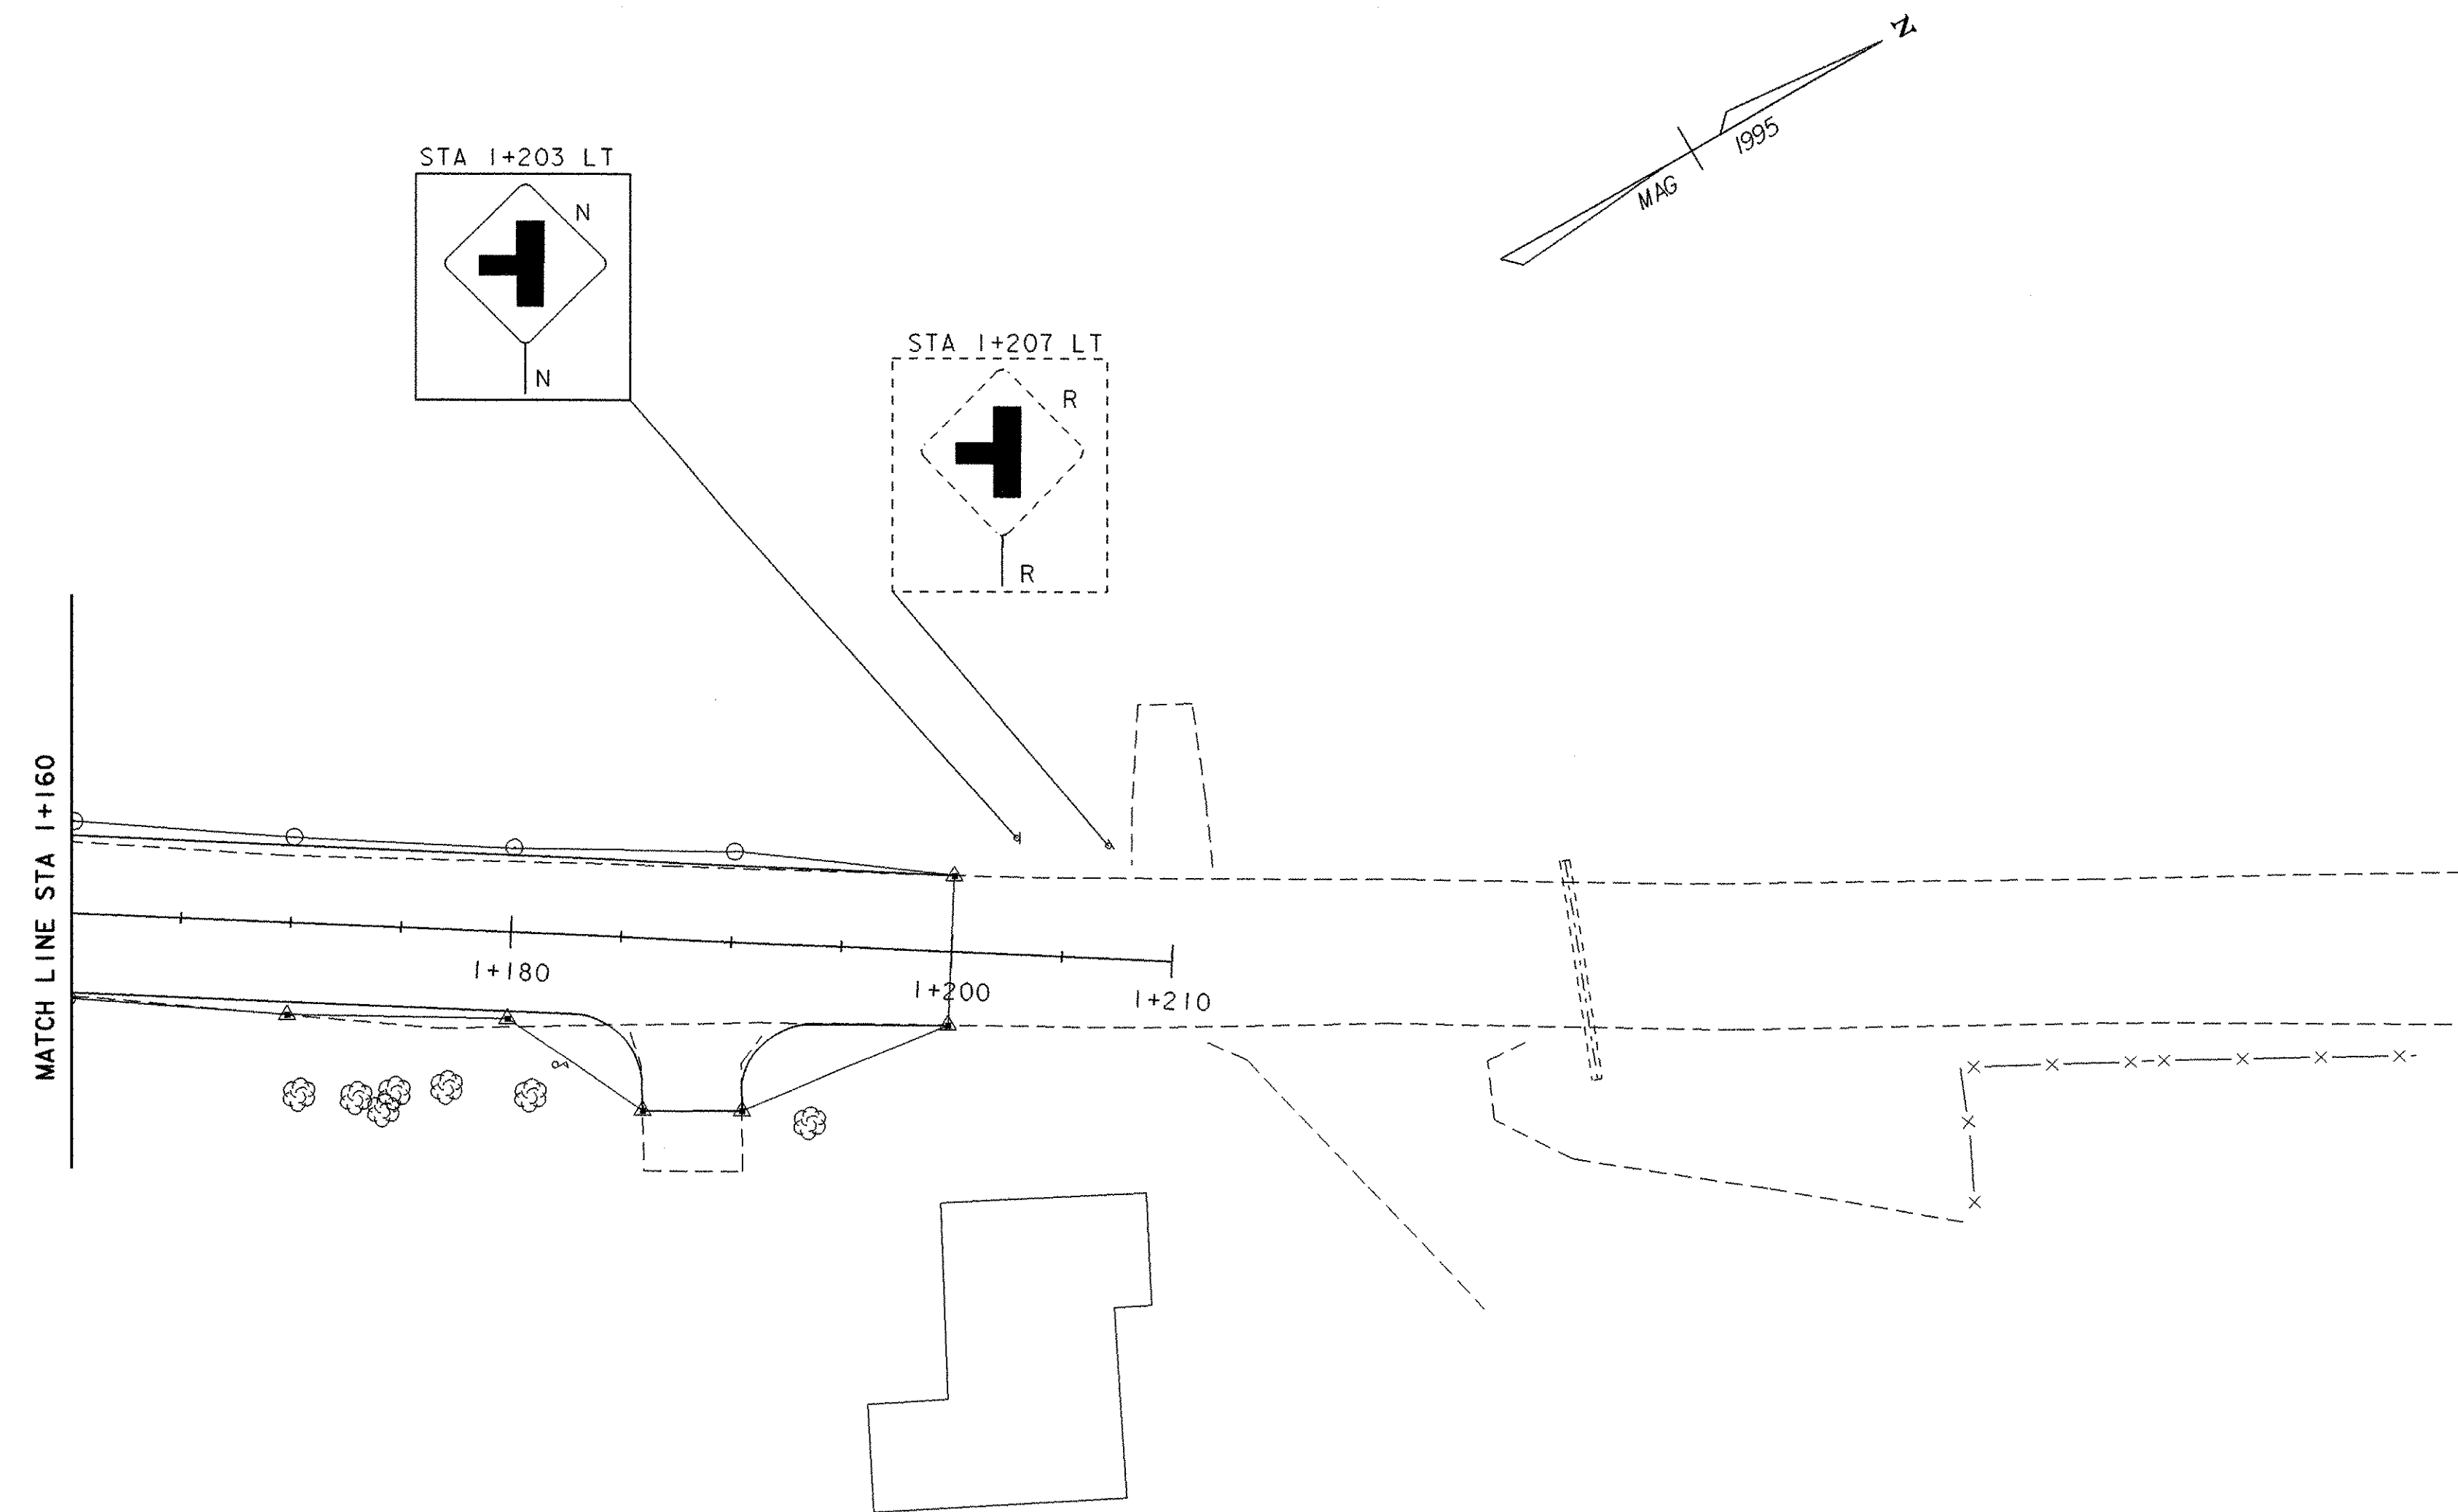


SIGN LEGEND

- = EXISTING
- N = NEW
- R = REMOVE
- R&S = REMOVE & SALVAGE
- S = SALVAGE

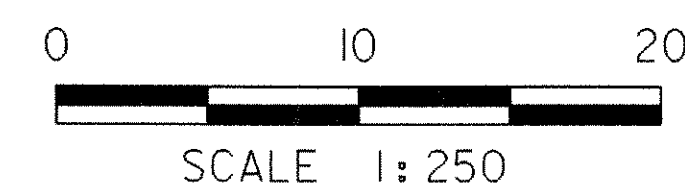


SHEET NAME: SIGN SHEET #2	
PROJECT NAME: WESTFORD	HIGHWAY NO.: TH 4
PROJECT NUMBER: TH2 9436	BRIDGE NO.: 2
	OVER: ROGERS BROOK
FILE NAME: 94J122\Structures\sj122sgn.dgn	PLOT DATE: 25-MAR-2005
PROJECT MANAGER: R. R. WHITCOMB	DRAWN BY: STRI
DESIGNED BY: C. CARLSON	IPARM NAME: sj122sg4.l
BRIDGE SHEET NUMBER:	SHEET 41 OF 56

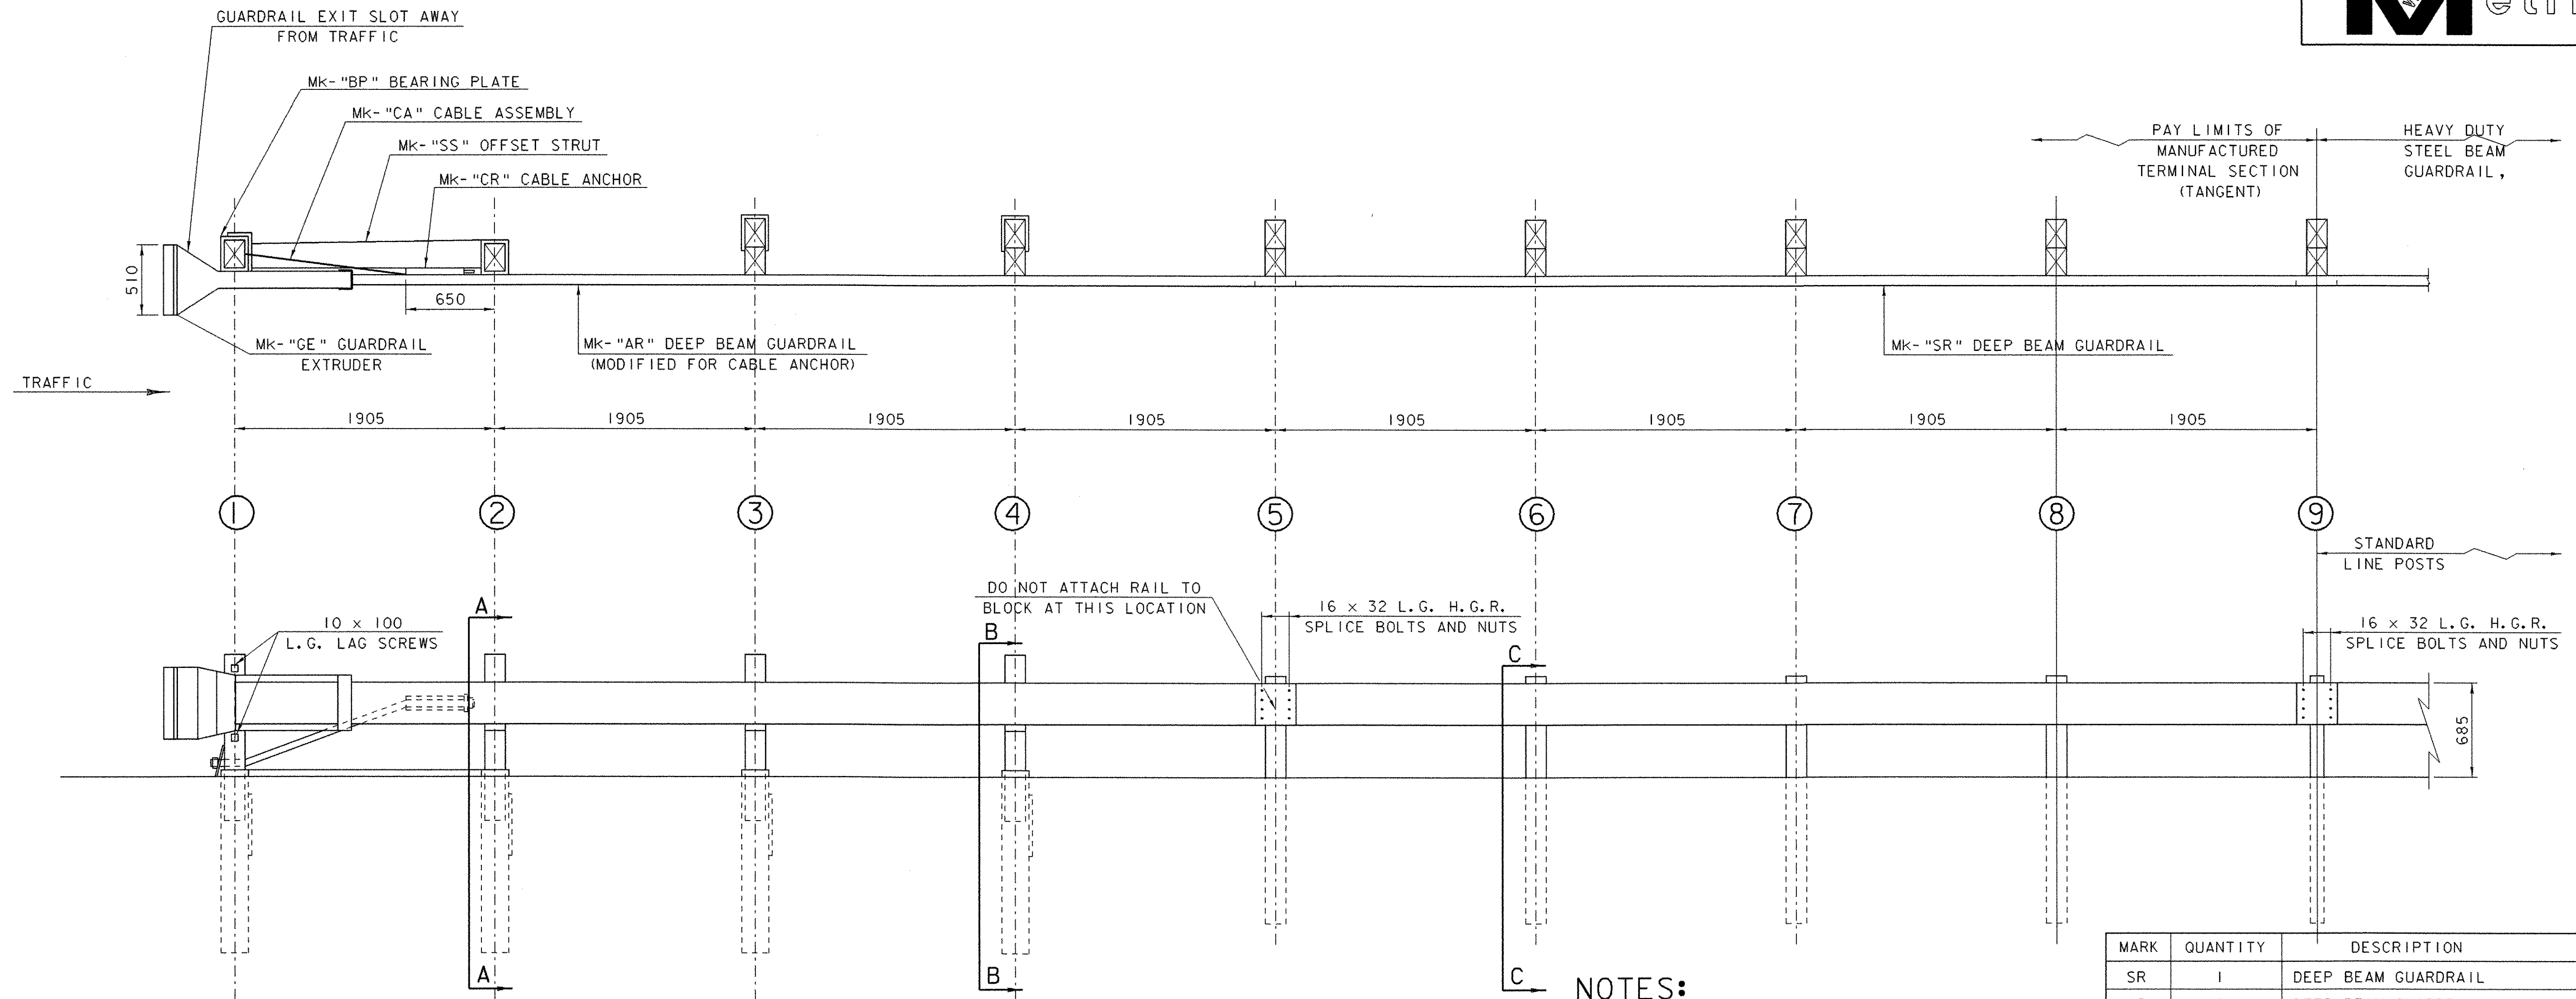

NOTES:

1. THE 16 DIA FLAT WASHER IS USED WITH THE NUT, BEHIND THE POST ONLY. NO WASHER IS USED AT THE RAIL.
2. THE BREAKAWAY POSTS AT LOCATIONS #5, 6, 7 AND 8 MAY BE AS SHOWN, OR FOUNDATION TUBES MAY BE USED AS SHOWN AT POST LOCATIONS #1, 2, 3, AND 4.
3. REFLECTORIZATION OF THE TERMINAL SHALL BE PROVIDED. ALL COSTS SHALL BE INCLUDED IN ITEM 621.505, "MANUFACTURED TERMINAL SECTION, (TANGENT)."

MARK	QUANTITY	DESCRIPTION
SR	1	DEEP BEAM GUARDRAIL
AR	1	DEEP BEAM GUARDRAIL
PS	1	PIPE SLEEVE
SP	4	SOIL PLATE
K	6	L.G. WOOD BLOCK
PG	4	WOOD POST
PA	4	WOOD POST
ST	4	L.G. STEEL TUBE
BP	1	BEARING PLATE
CR	1	CABLE ANCHOR BRACKET
CA	1	CABLE ASSEMBLY
SS	1	STRUT
GE	1	GUARDRAIL EXTRUDER
PE	1	WOOD POST
HARDWARE		
	4	16 x 250 HEX H.D. BOLT
	35	16 HEX NUT
	11	16 DIA. WASHER
	6	16 x 455 H.G.R. POST BOLT
	1	16 x 255 H.G.R. POST BOLT
	16	16 x 32 H.G.R. SPLICE BOLT
	8	16 x 190 HEX H.D. BOLT
	2	10 x 100 LAG SCREW
	2	25 HEX NUT
	2	25 WASHER

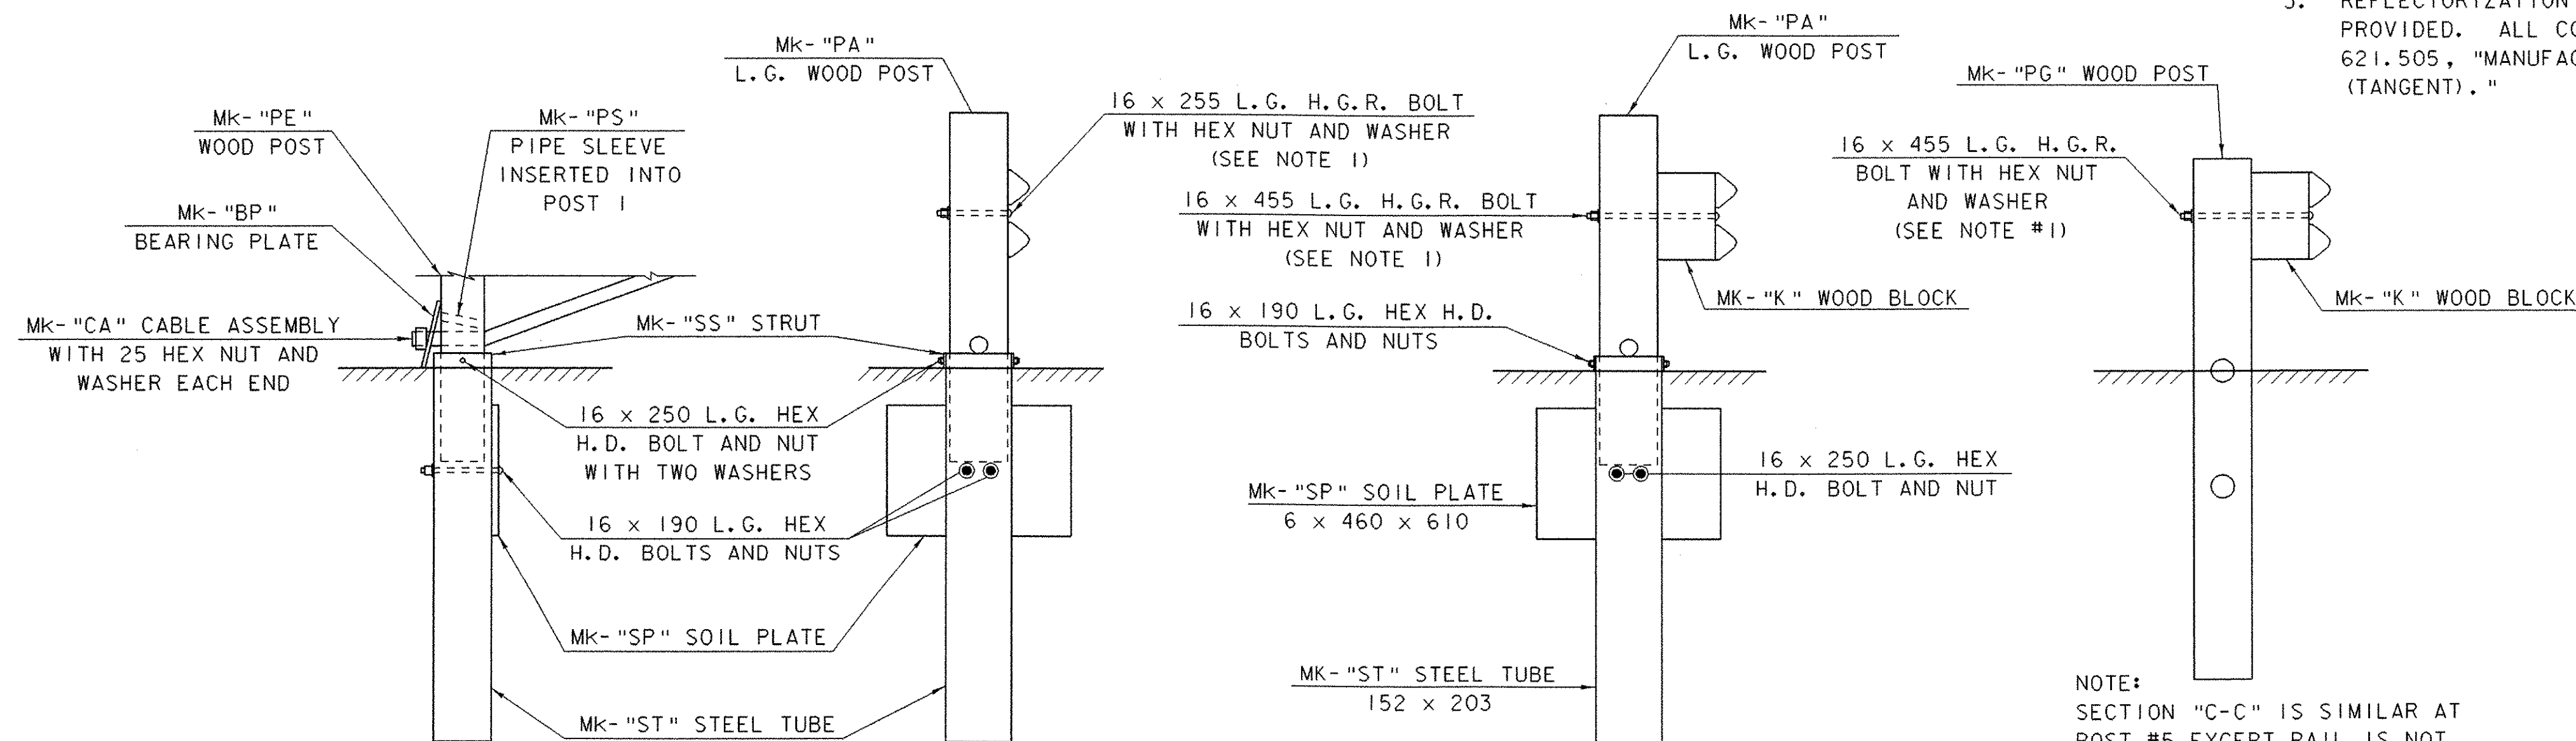

NOTE:
SECTION "C-C" IS SIMILAR AT POST #5 EXCEPT RAIL IS NOT ATTACHED.

PARTIAL VIEW
AT POST #1

SECTION "A-A"
(POST #2)


SECTION "B-B"
(POST #3 AND #4)

SECTION "C-C"
(POST #6, #7 AND #8)

SHEET NAME: **MANUFACTURED END TERMINAL**



PROJECT NAME: **WESTFORD** HIGHWAY NO.: TH 4
PROJECT NUMBER: **TH2 9436** BRIDGE NO.: 2
OVER: **ROGERS BROOK**

FILE NAME: 94j122\Structures\sj122sup.dgn PLOT DATE: 25-MAR-2005
PROJECT MANAGER: R. R. WHITCOMB DRAWN BY: J. GILMORE
DESIGNED BY: C. CARLSON IPARM NAME: sj122me+1
BRIDGE SHEET NUMBER: SHEET 43 OF 56


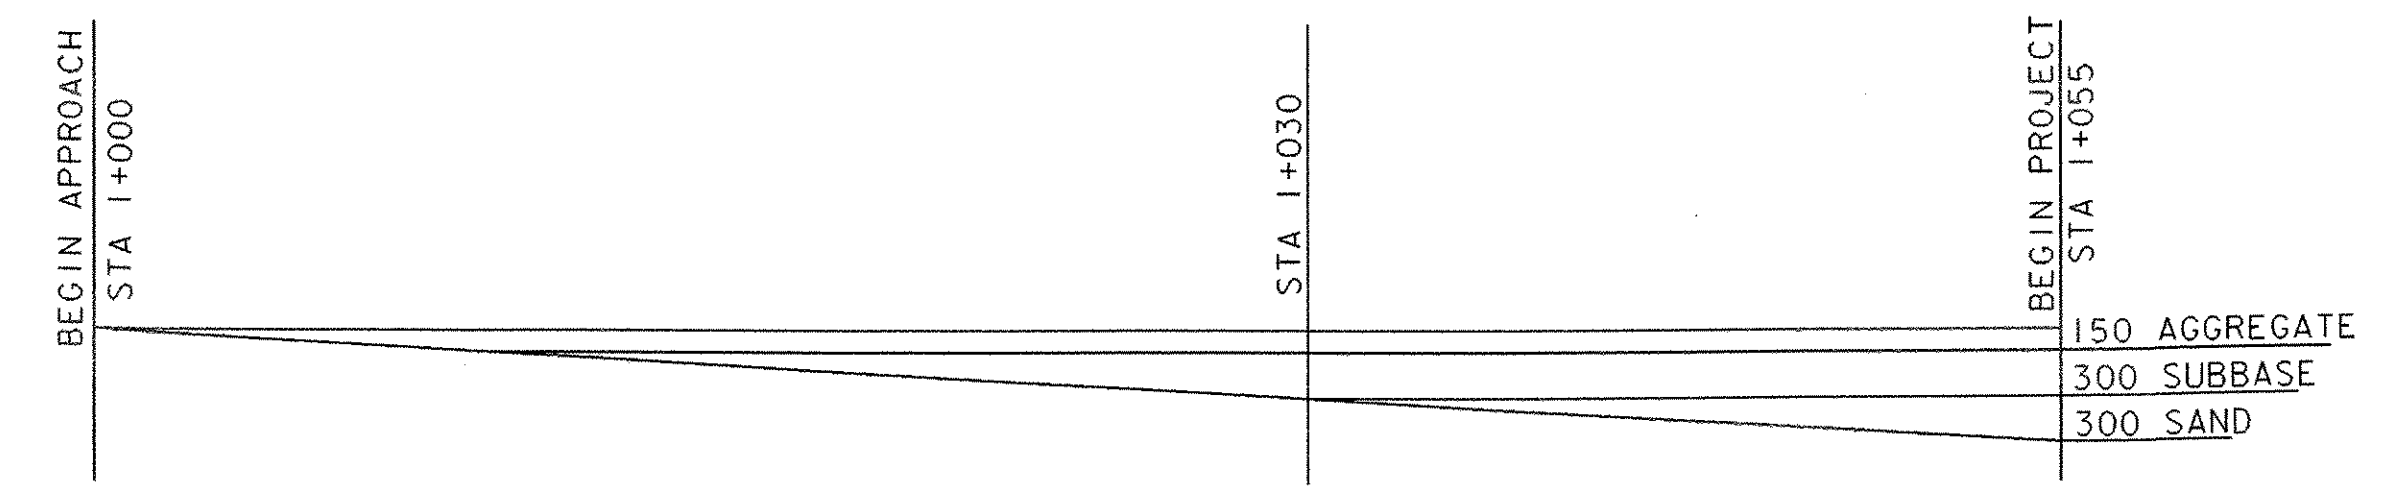


MATERIAL TRANSITION DETAIL

NTS

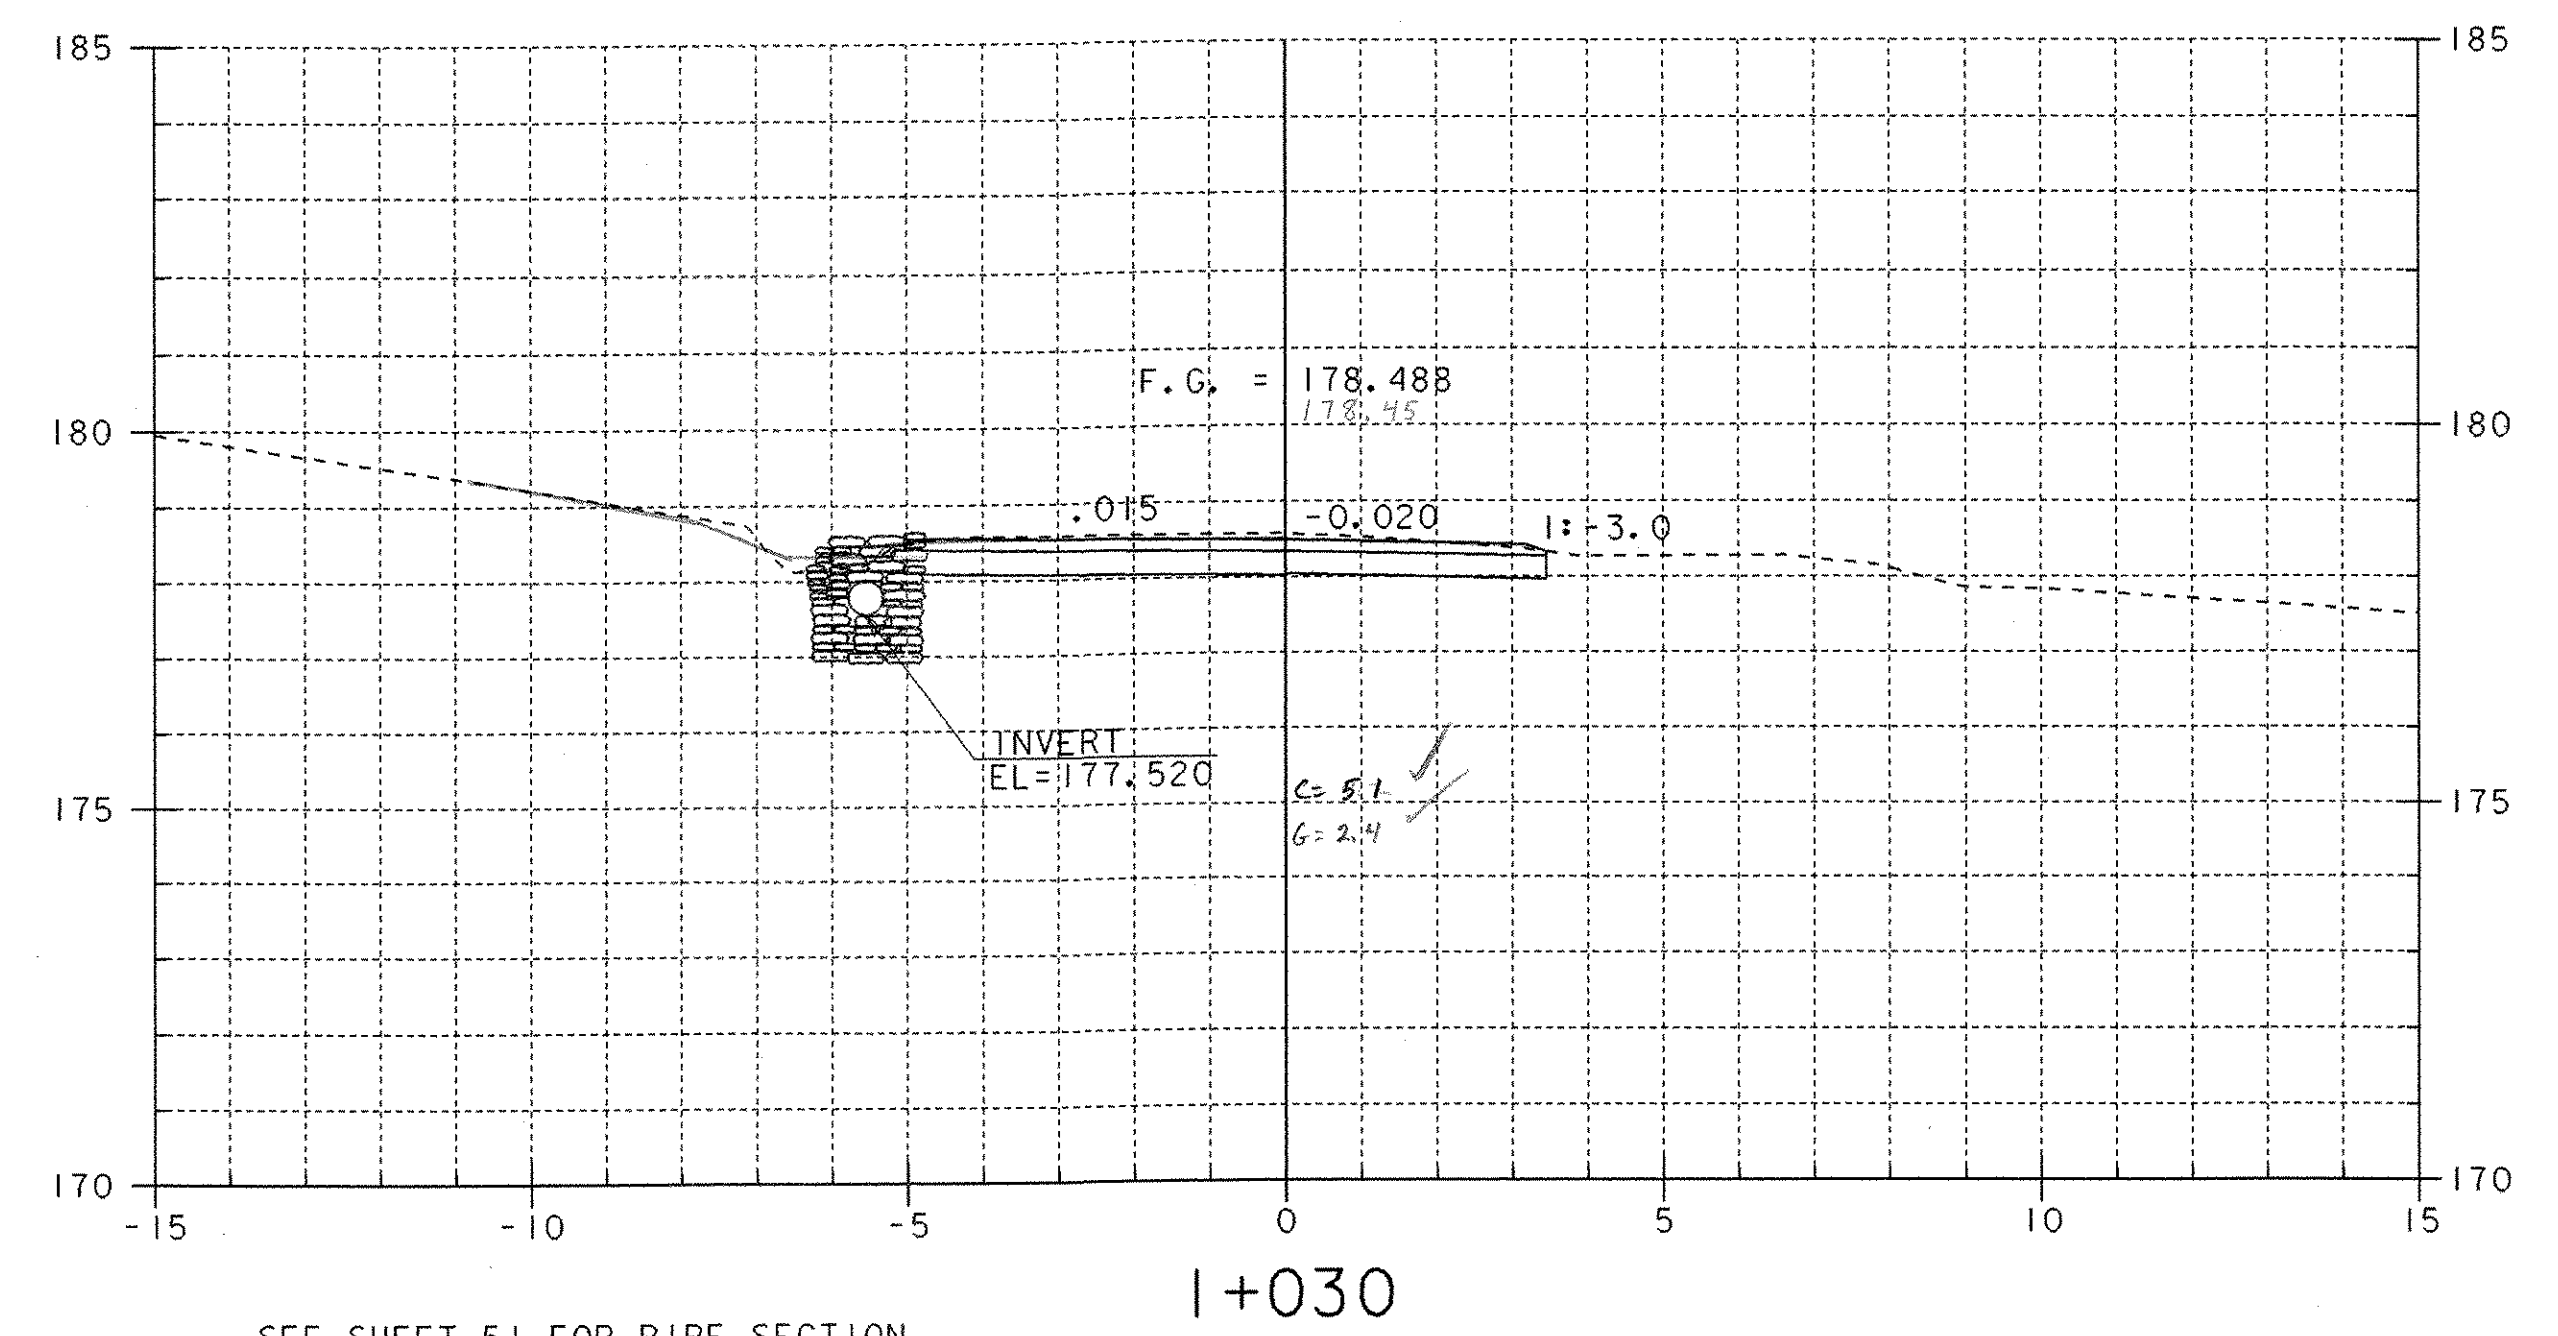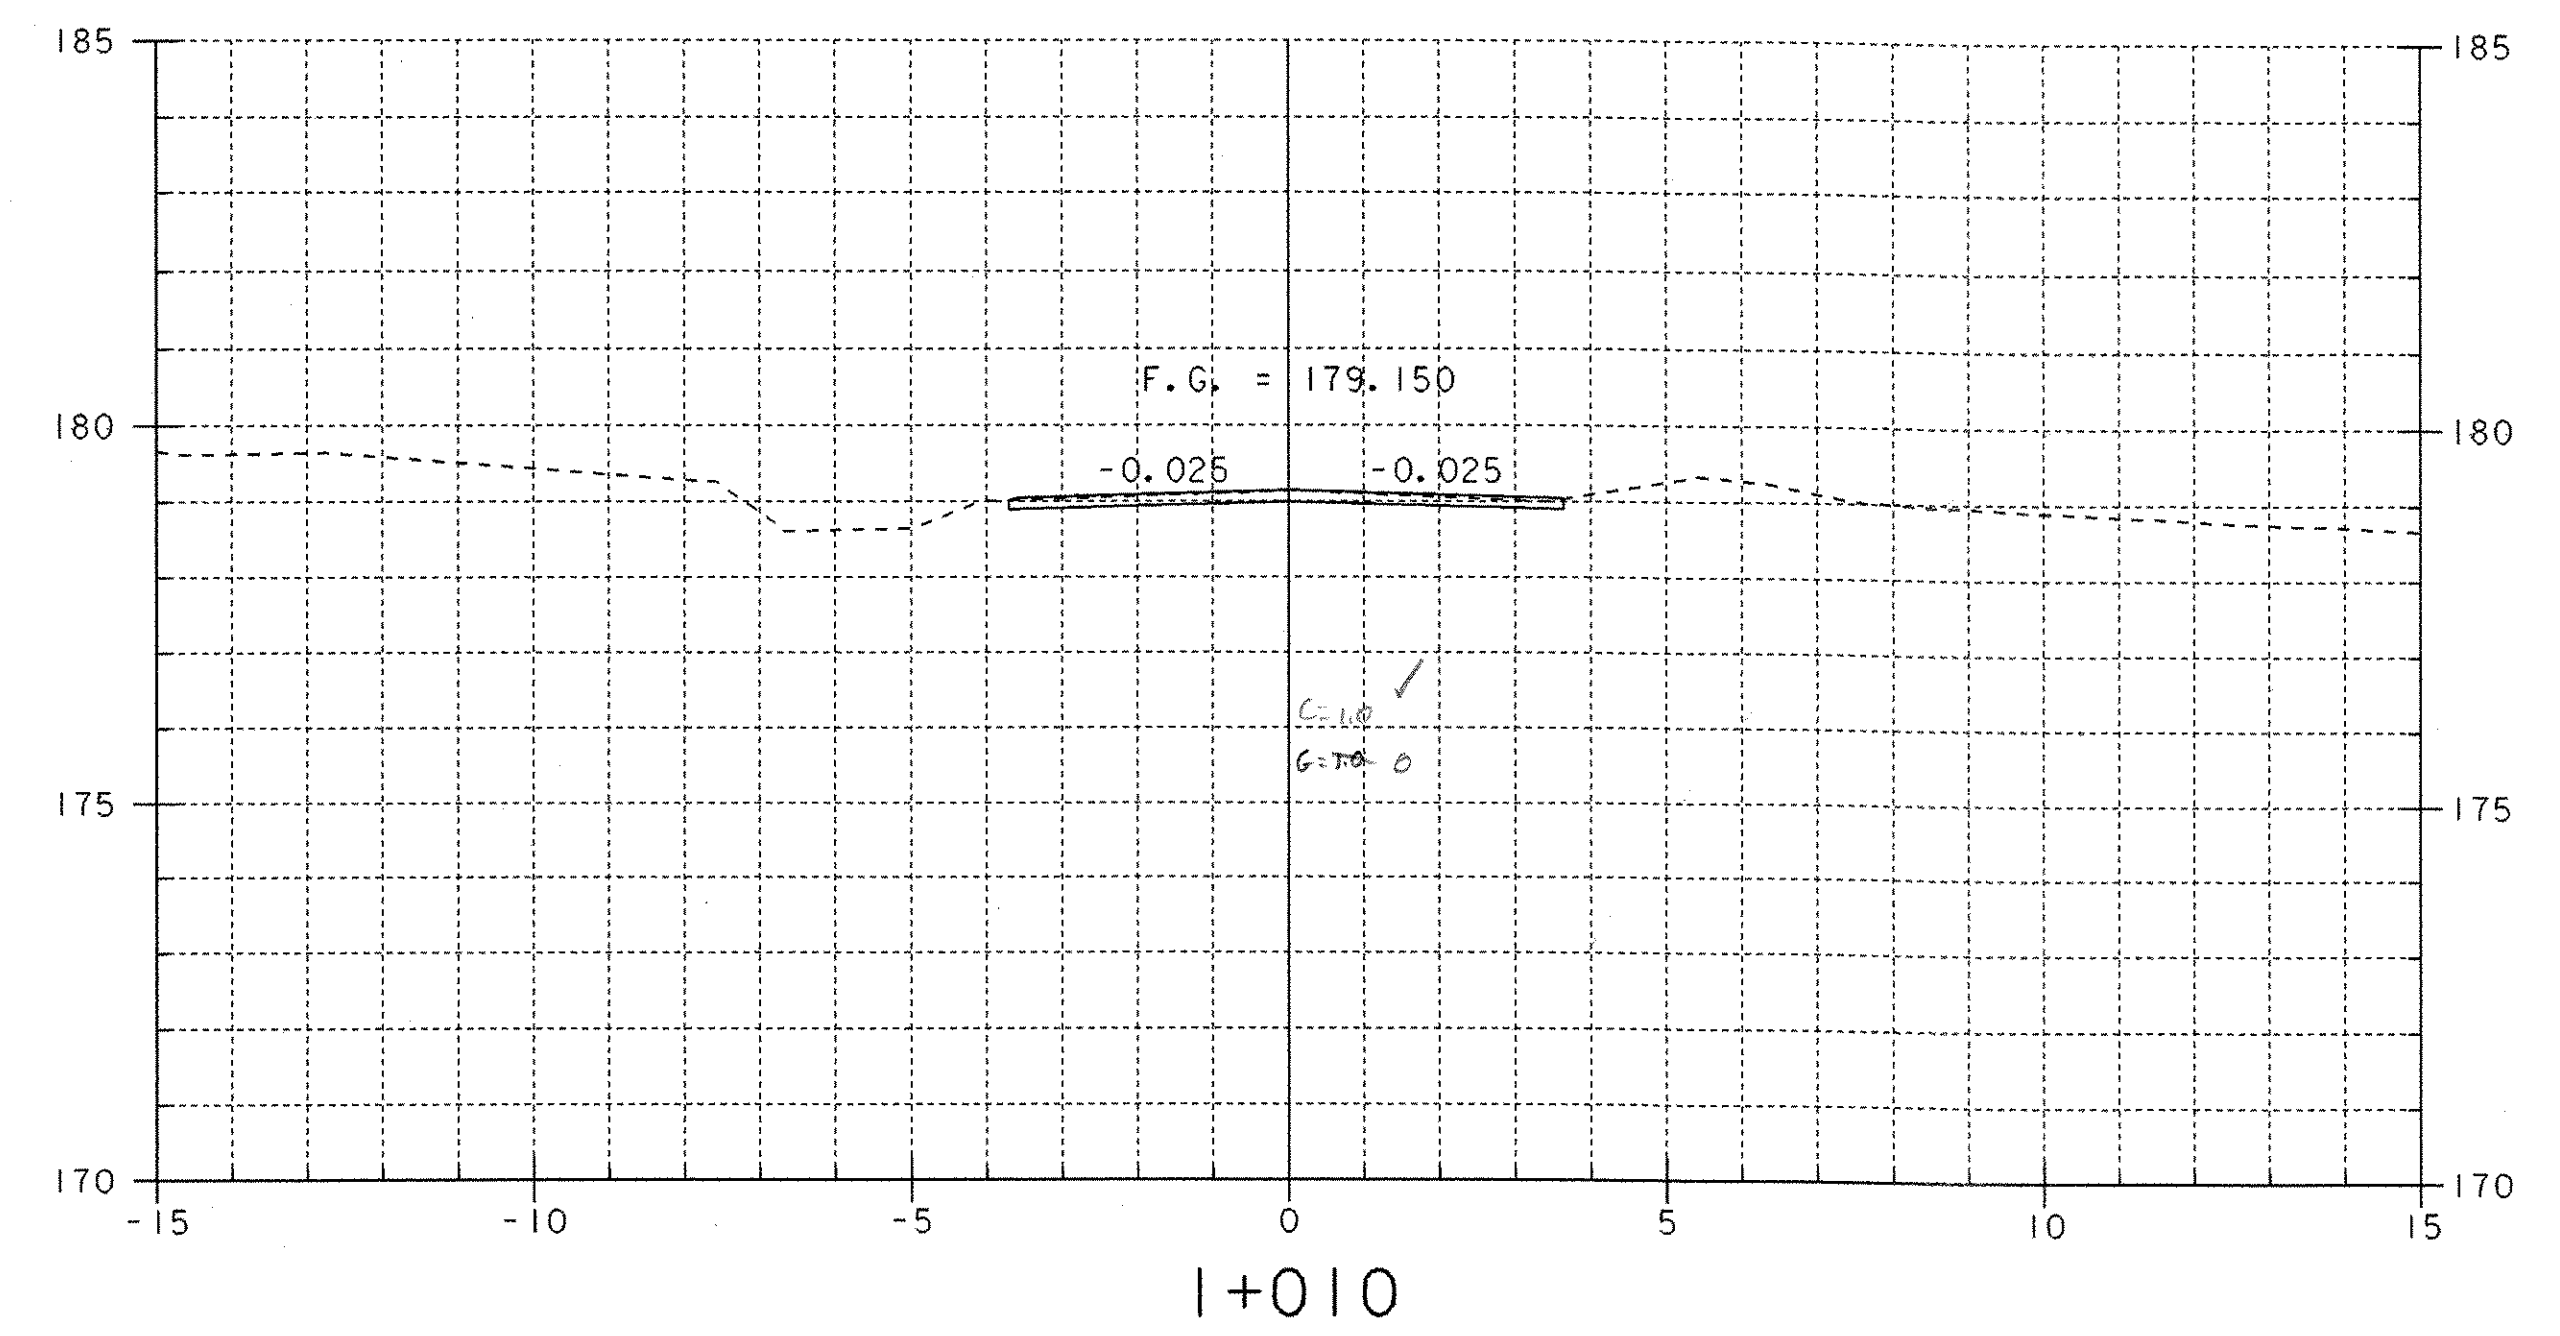


SEE SHEET 51 FOR PIPE SECTION AND STD D-2M FOR HEADWALL DETAILS AT STA 1+037.000 LEFT

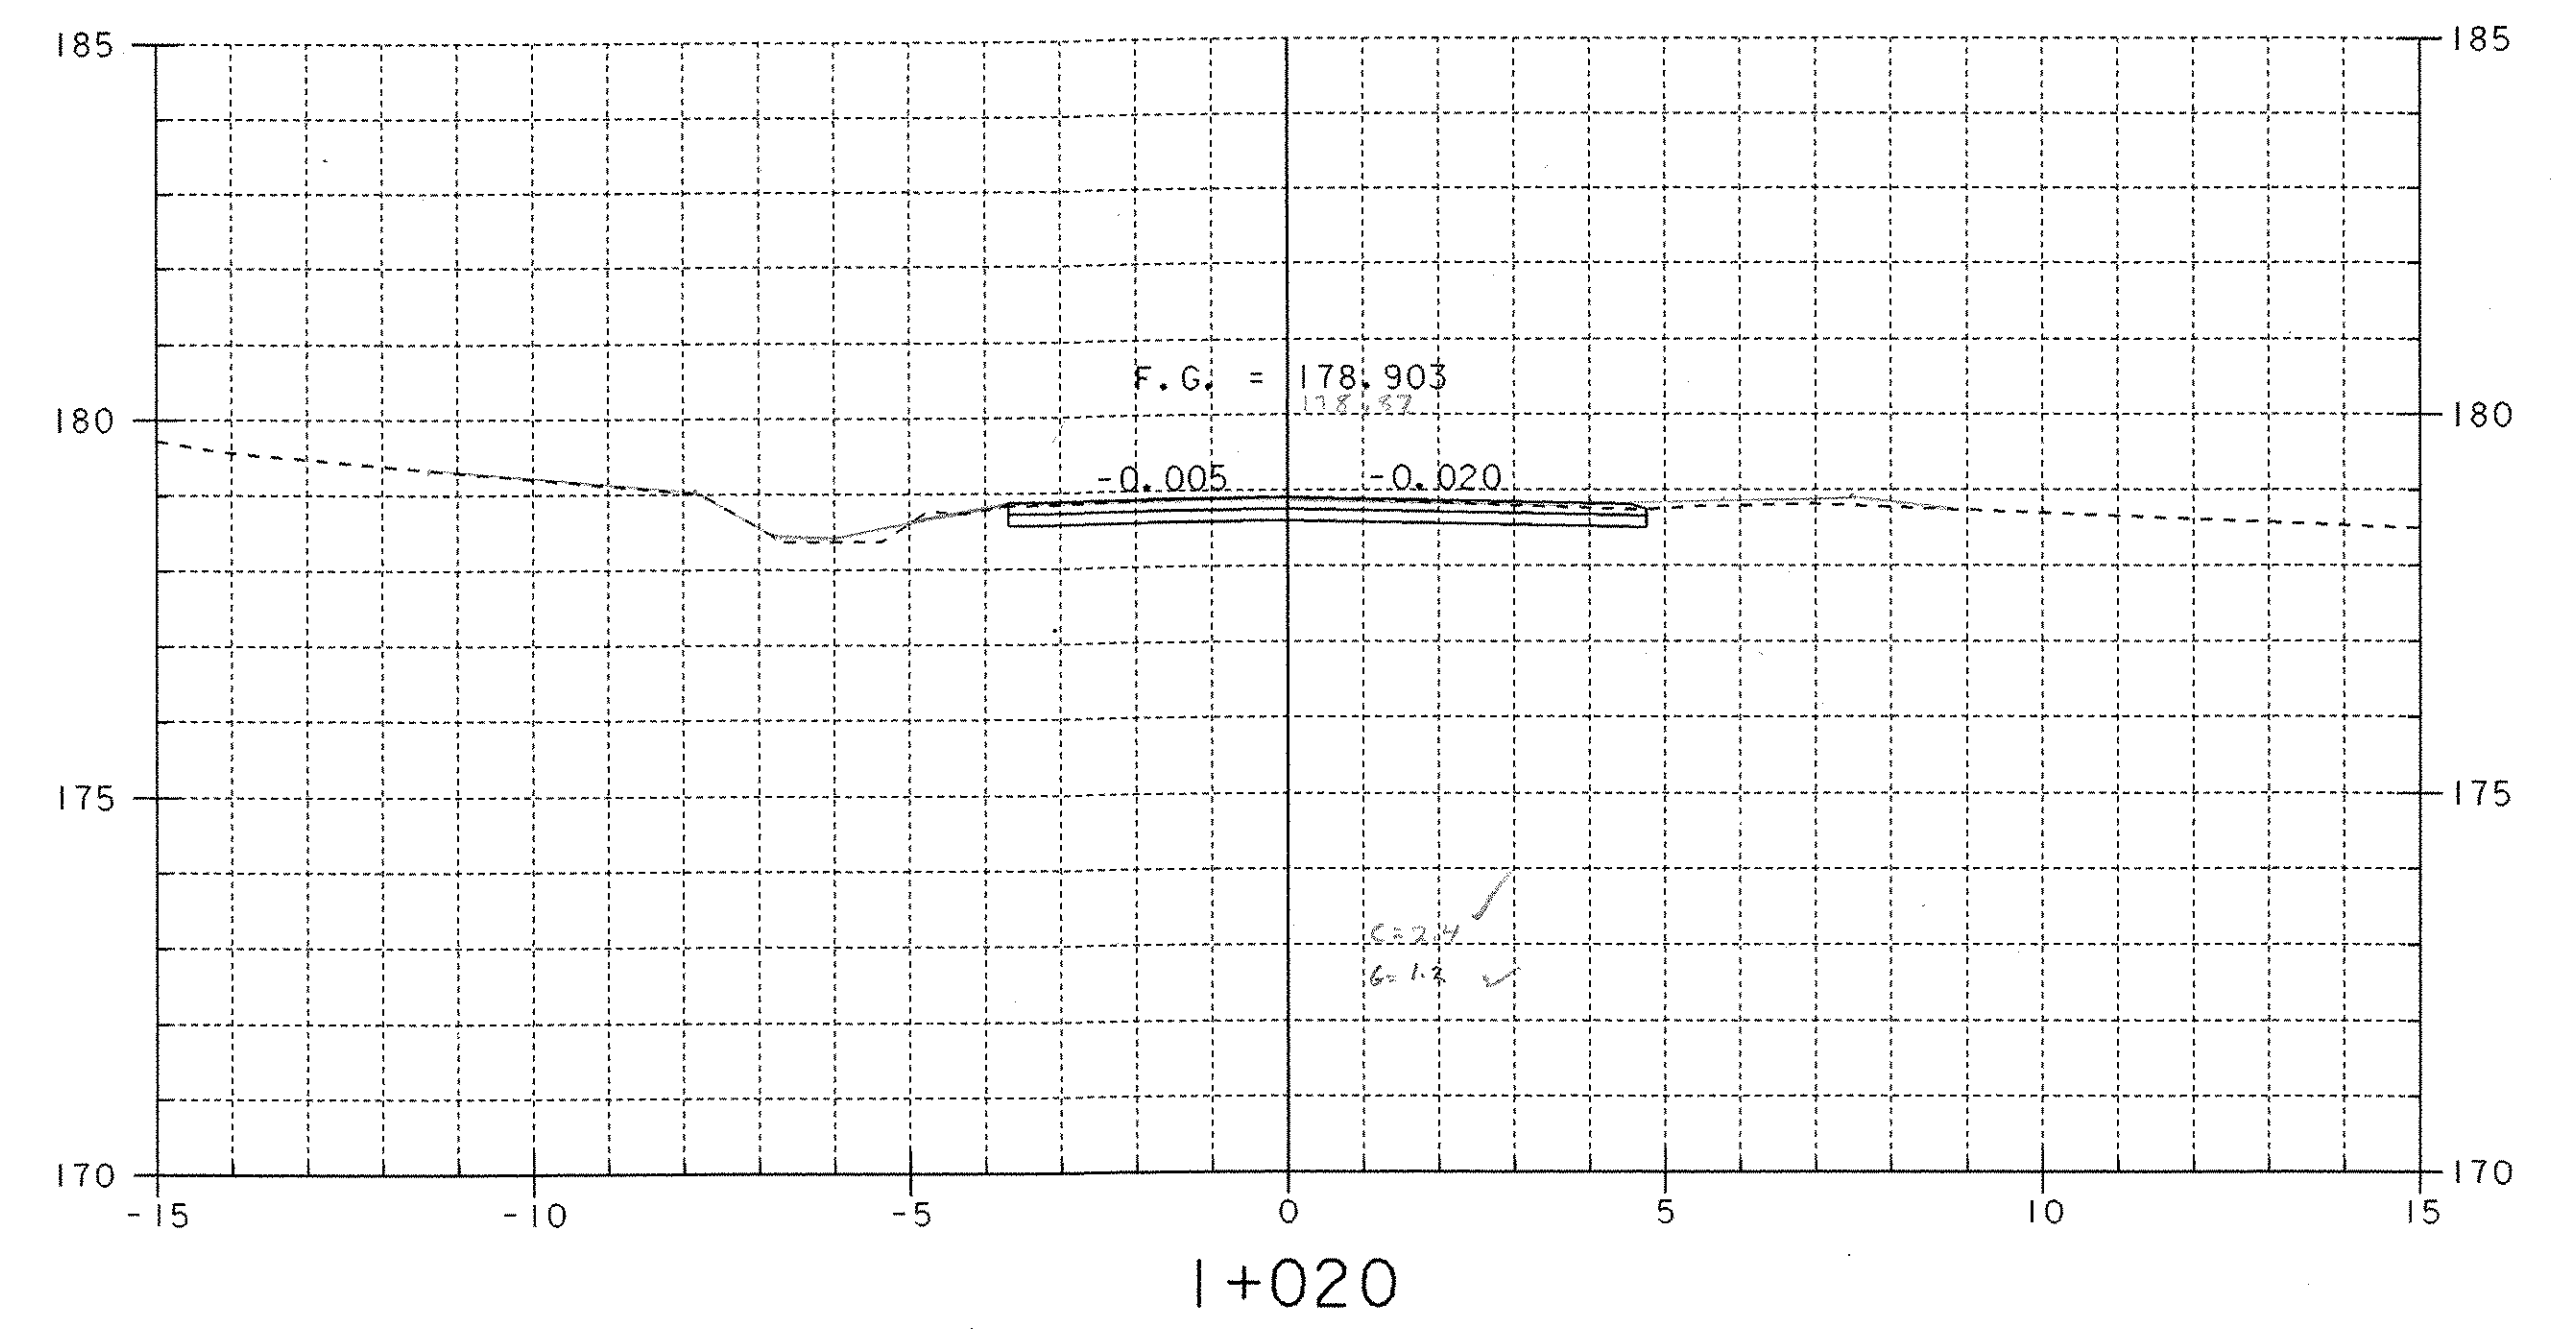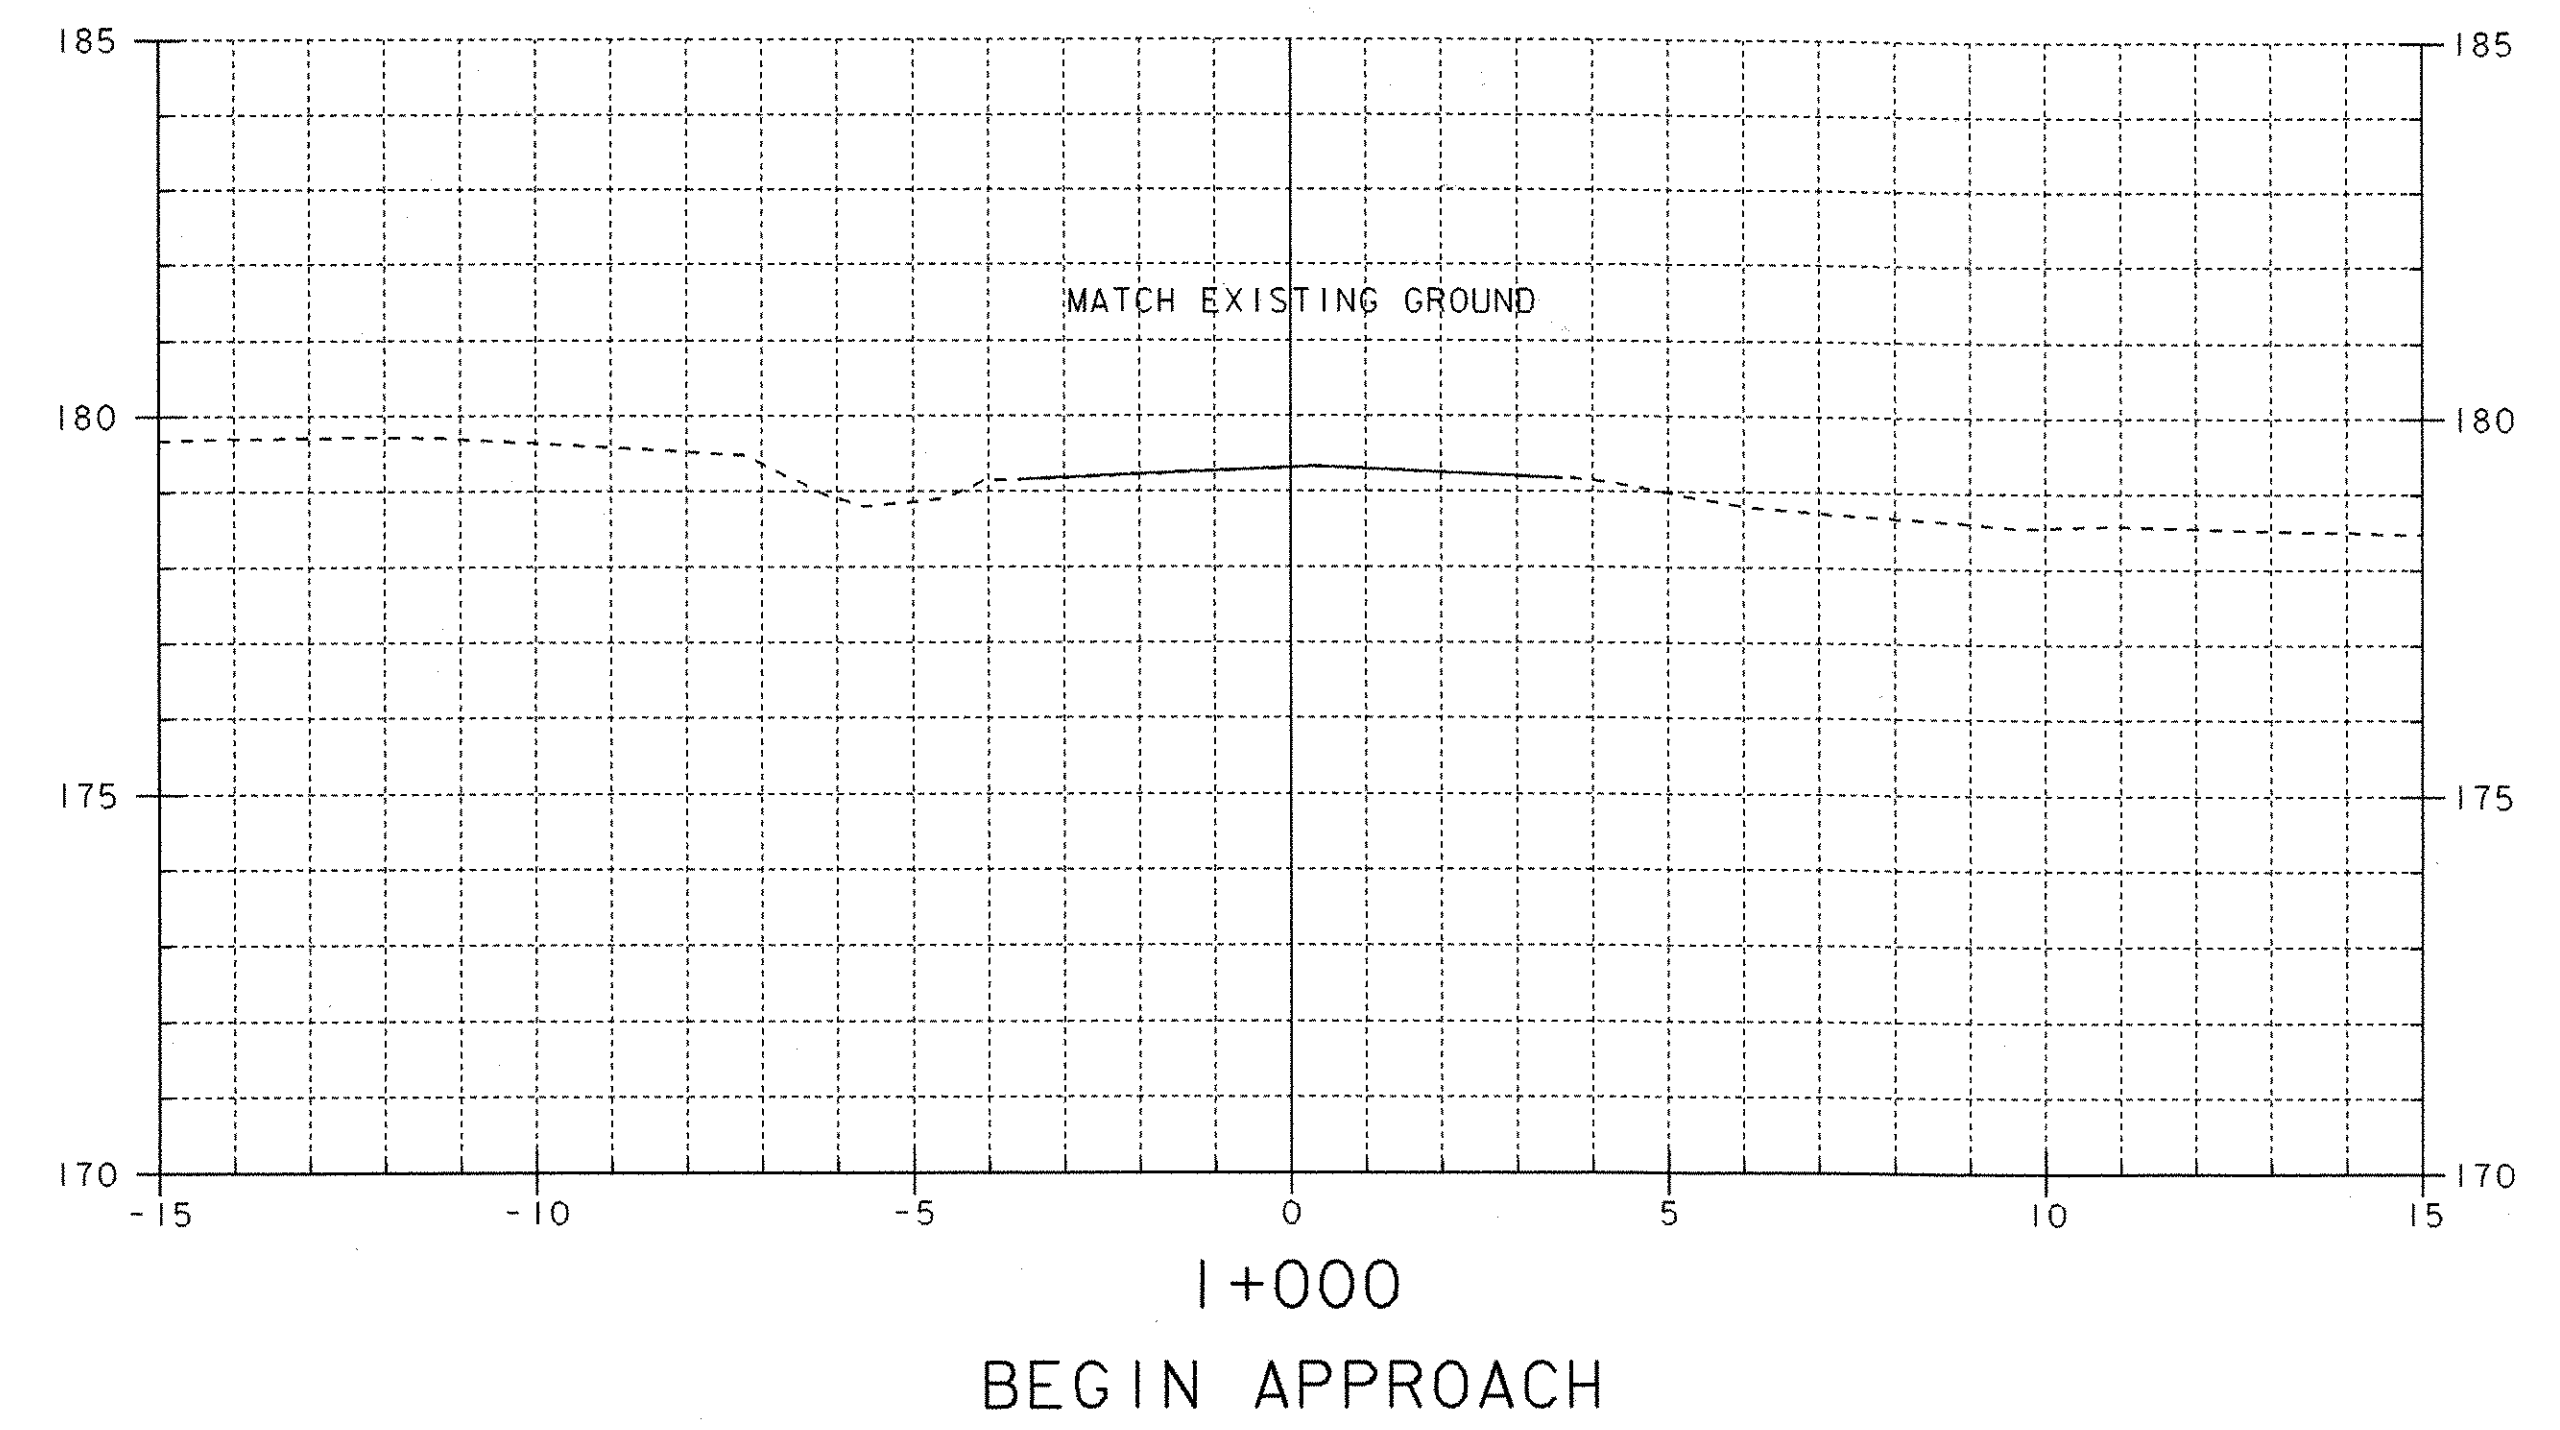


* SEE SHEET 12 FOR BANKING DIAGRAM


SHEET NAME: MAINLINE CROSS SECTIONS	
PROJECT NAME: WESTFORD	HIGHWAY NO.: TH 4
PROJECT NUMBER: TH2 9436	BRIDGE NO.: 2
	OVER: ROGERS BROOK
FILE NAME: /PW/94j122/sj122xs2.dgn	PLOT DATE: 25-MAR-2005
PROJECT MANAGER: R. R. WHITCOMB	DRAWN BY: STRI
DESIGNED BY: C. CARLSON	IPARM NAME: sj122mx1.1
BRIDGE SHEET NUMBER:	SHEET 44 OF 56

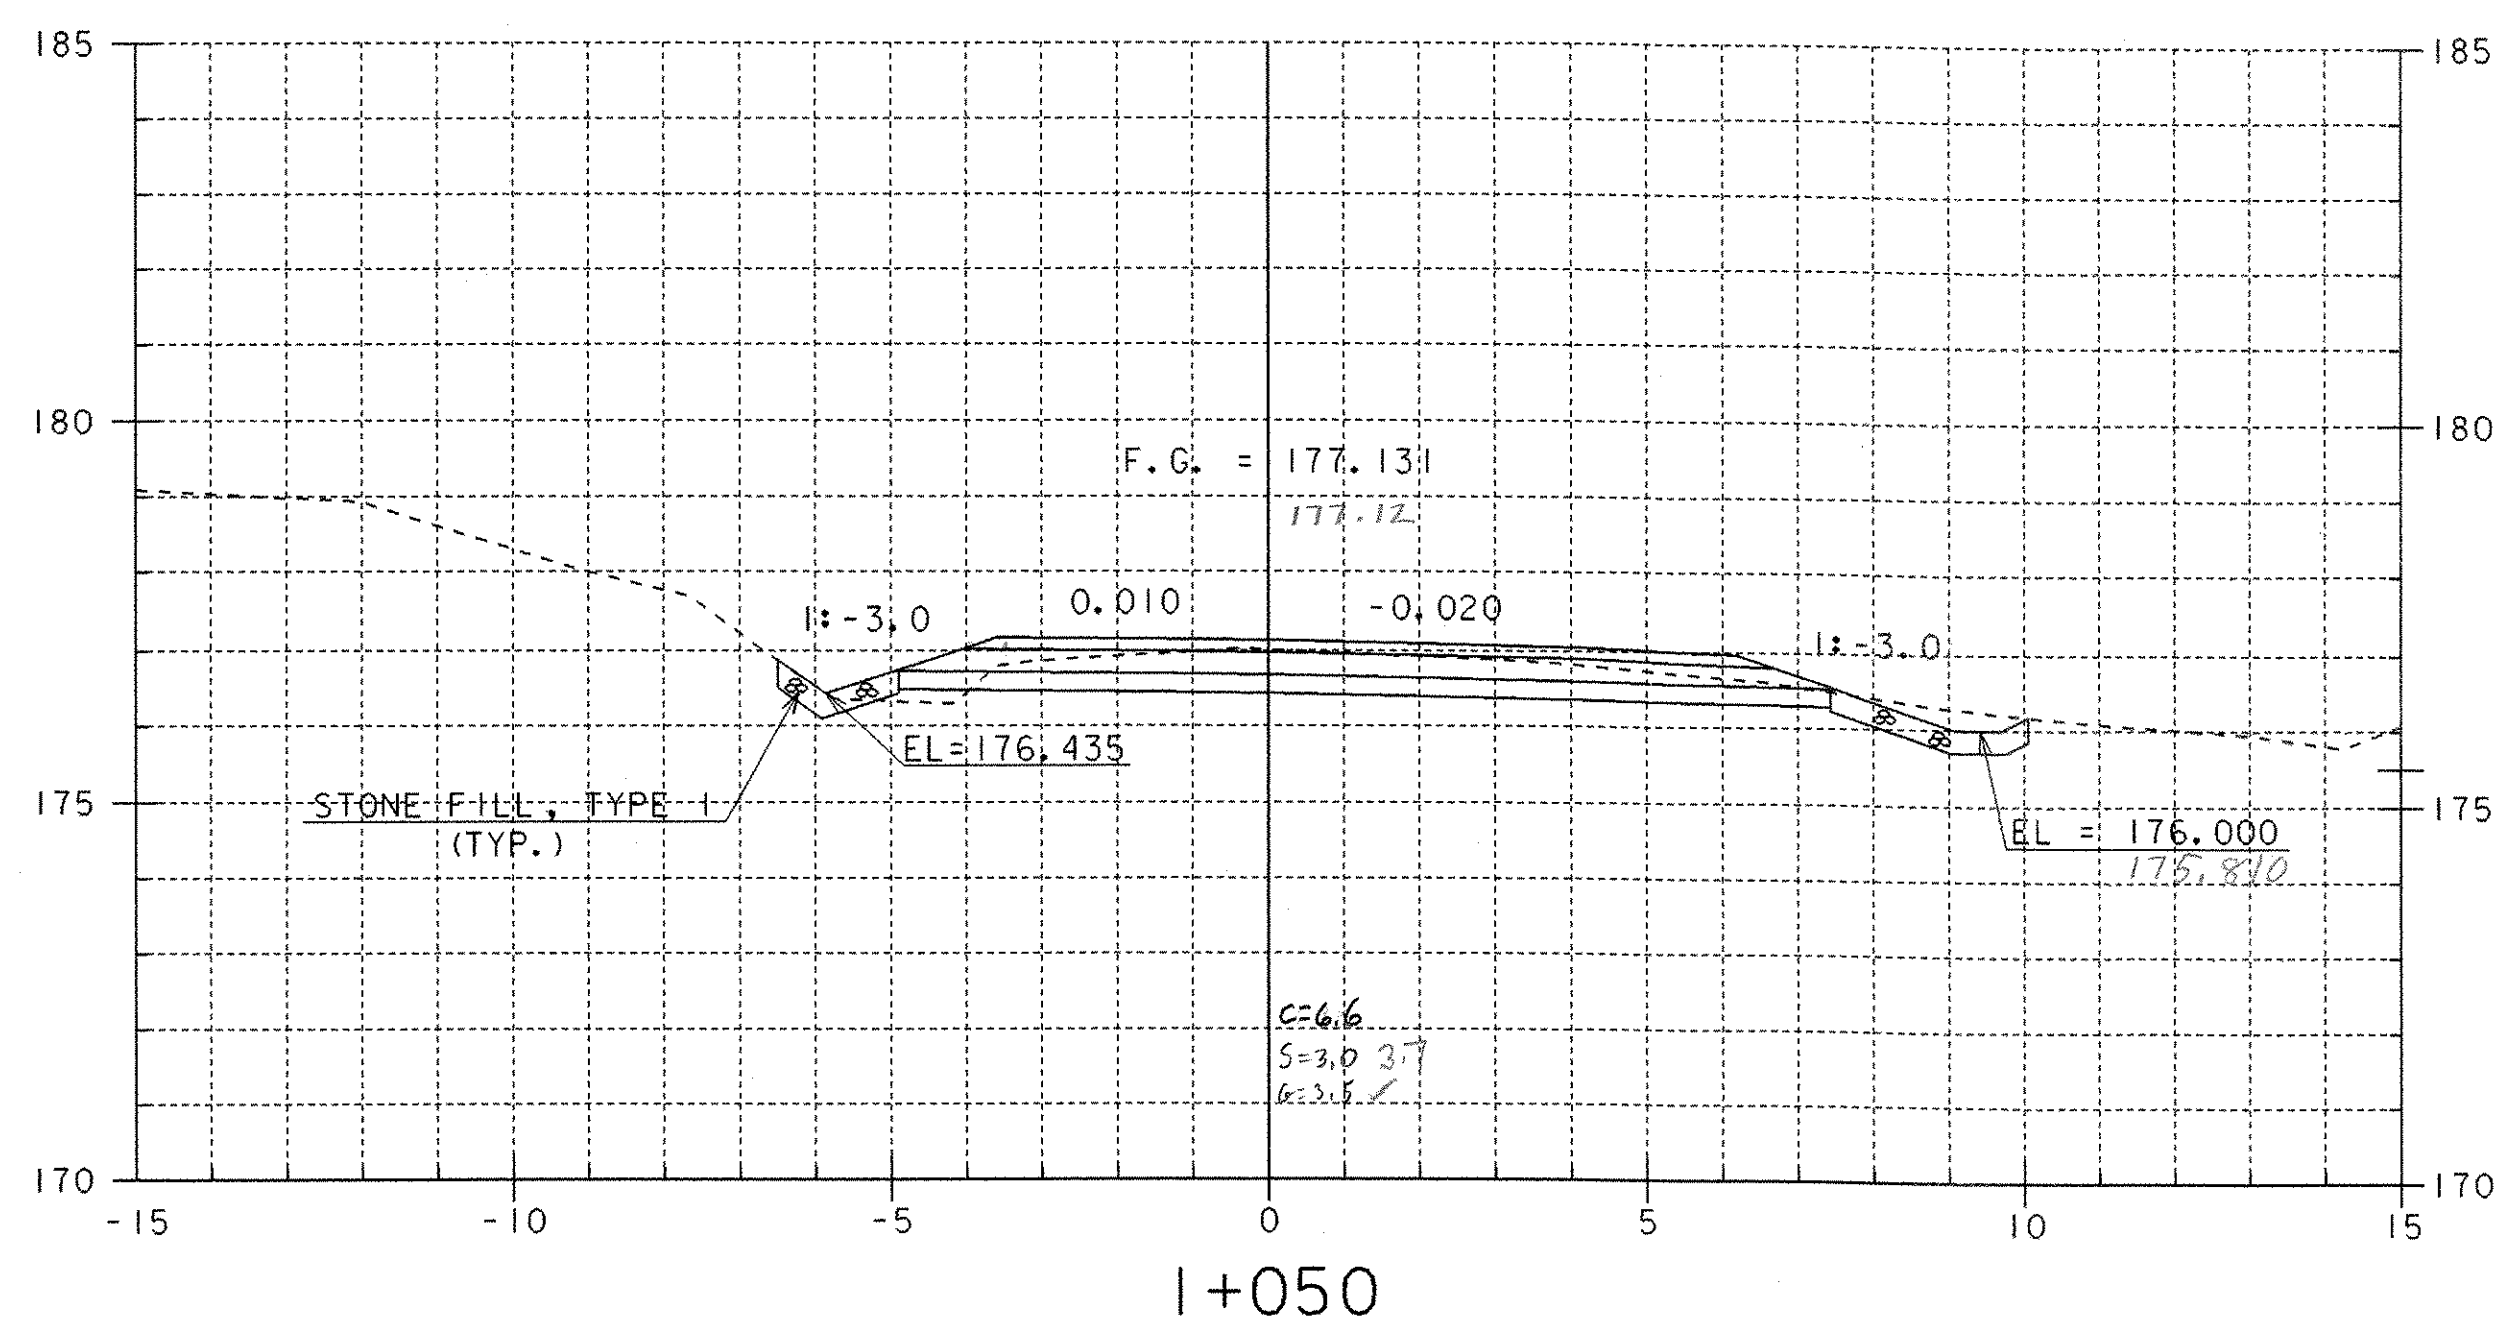


STA 1+044 RIGHT
 BEGIN STONE FILL, TYPE I
 STONE LINED DITCH ALONG SIDELINE

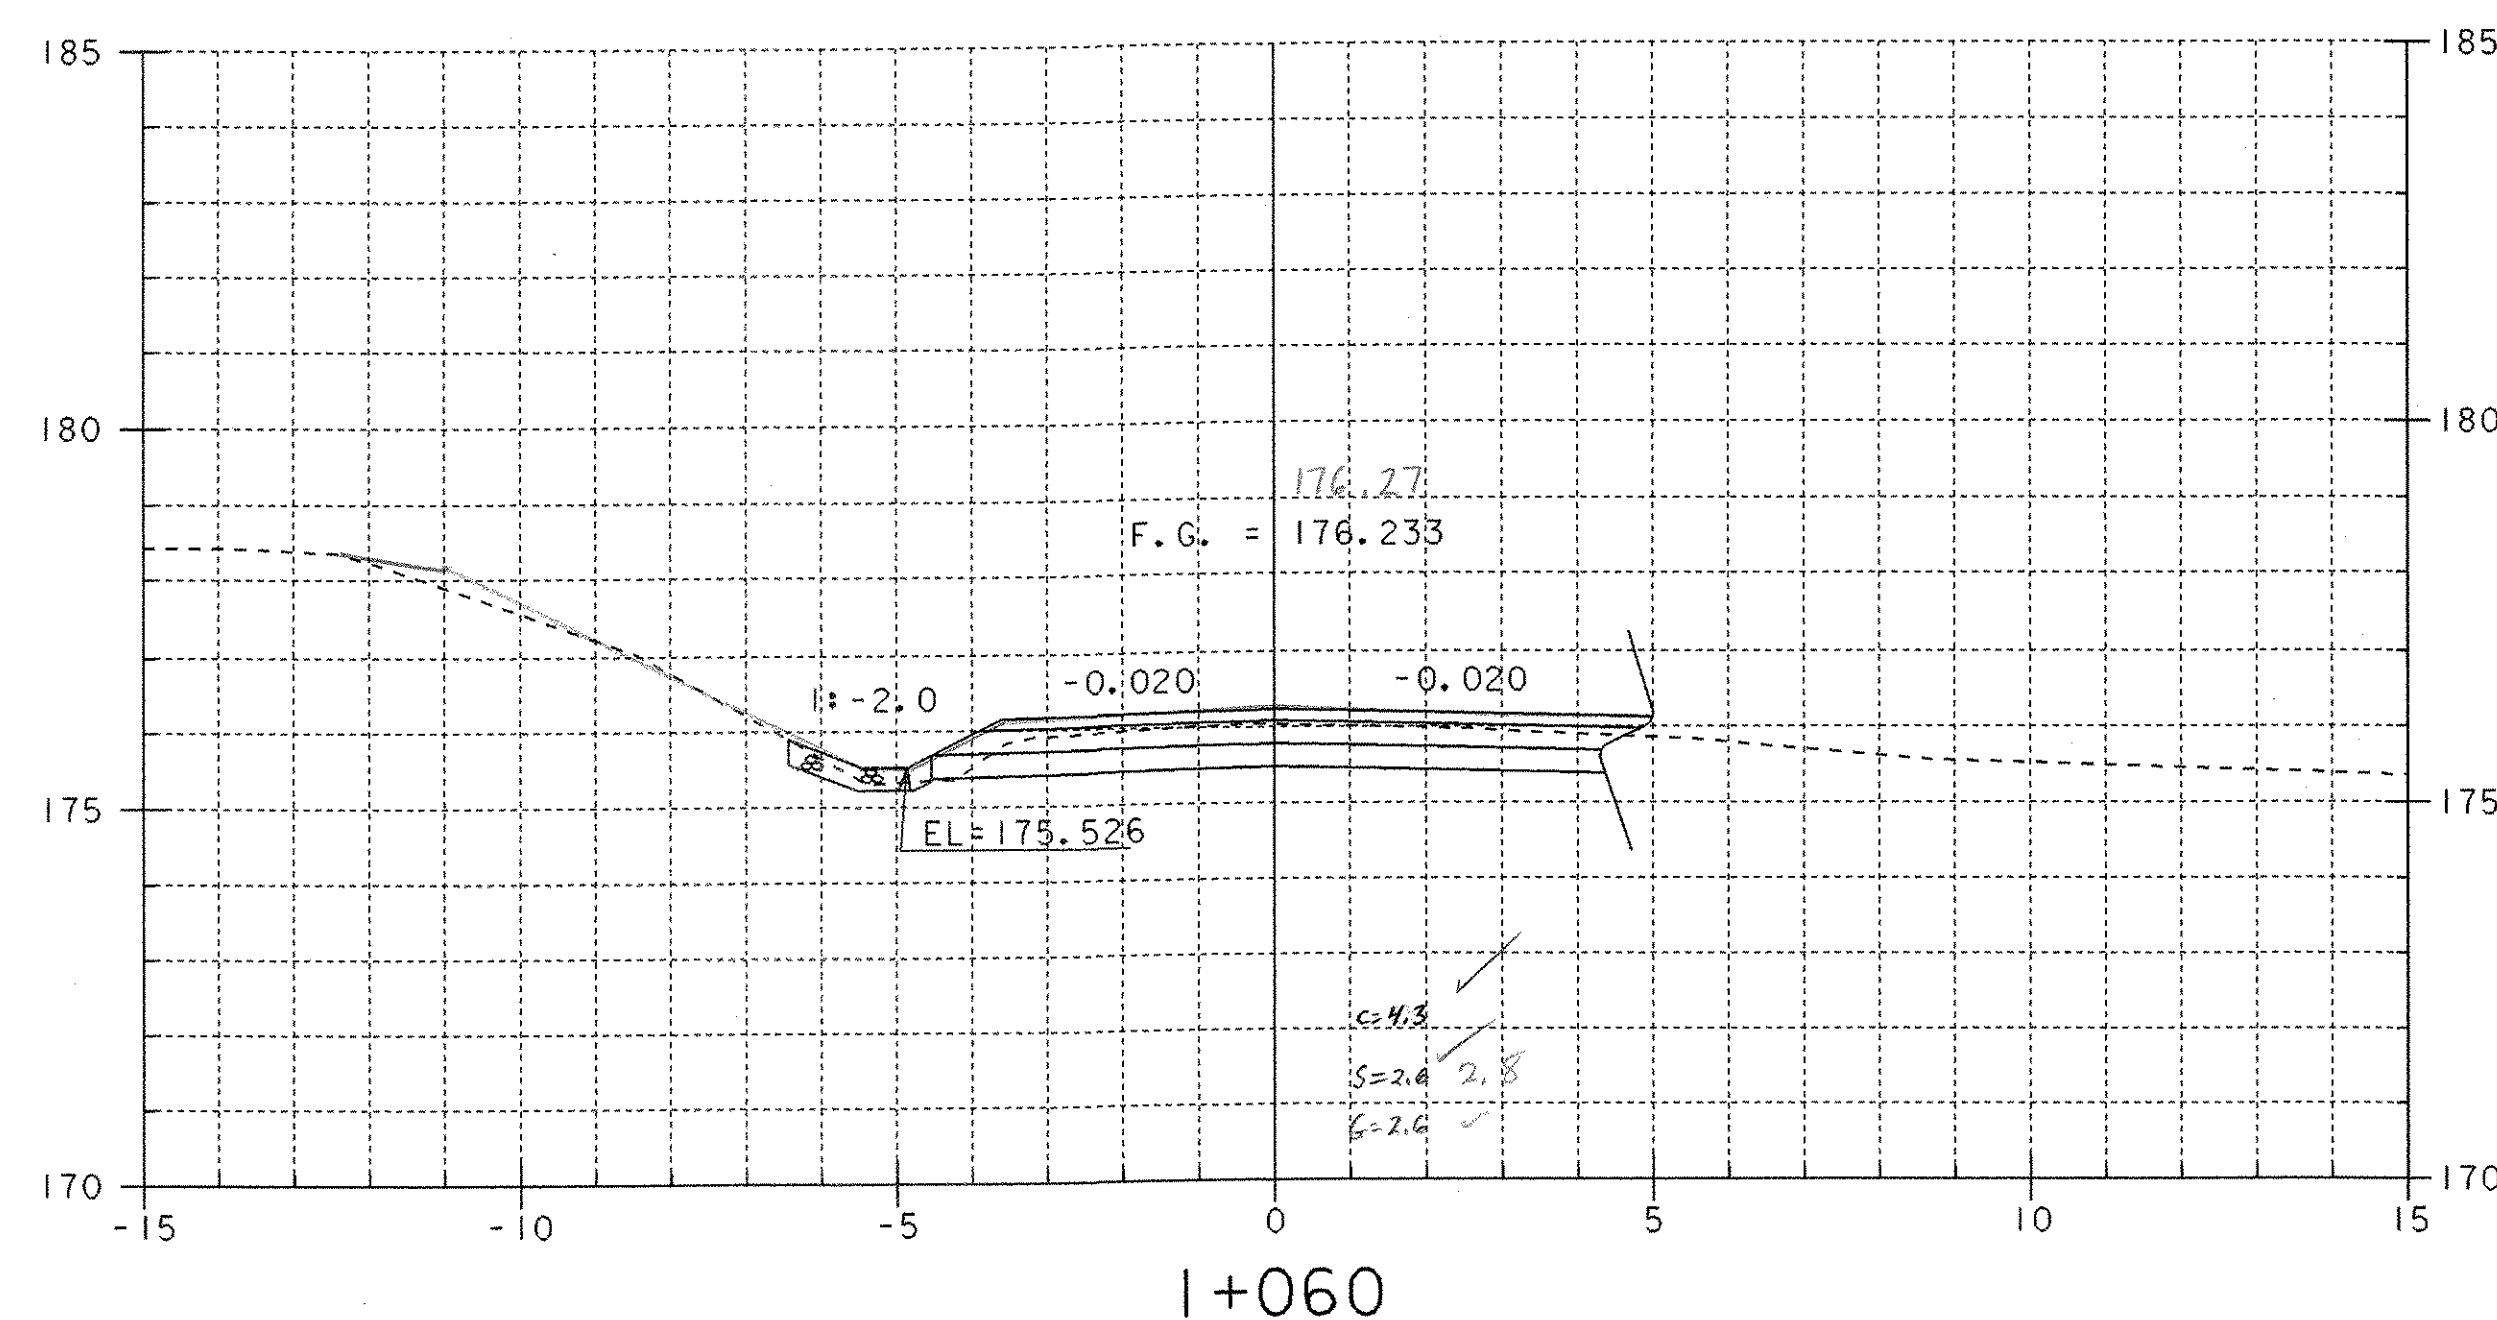


END APPROACH/BEGIN PROJECT
 1+055

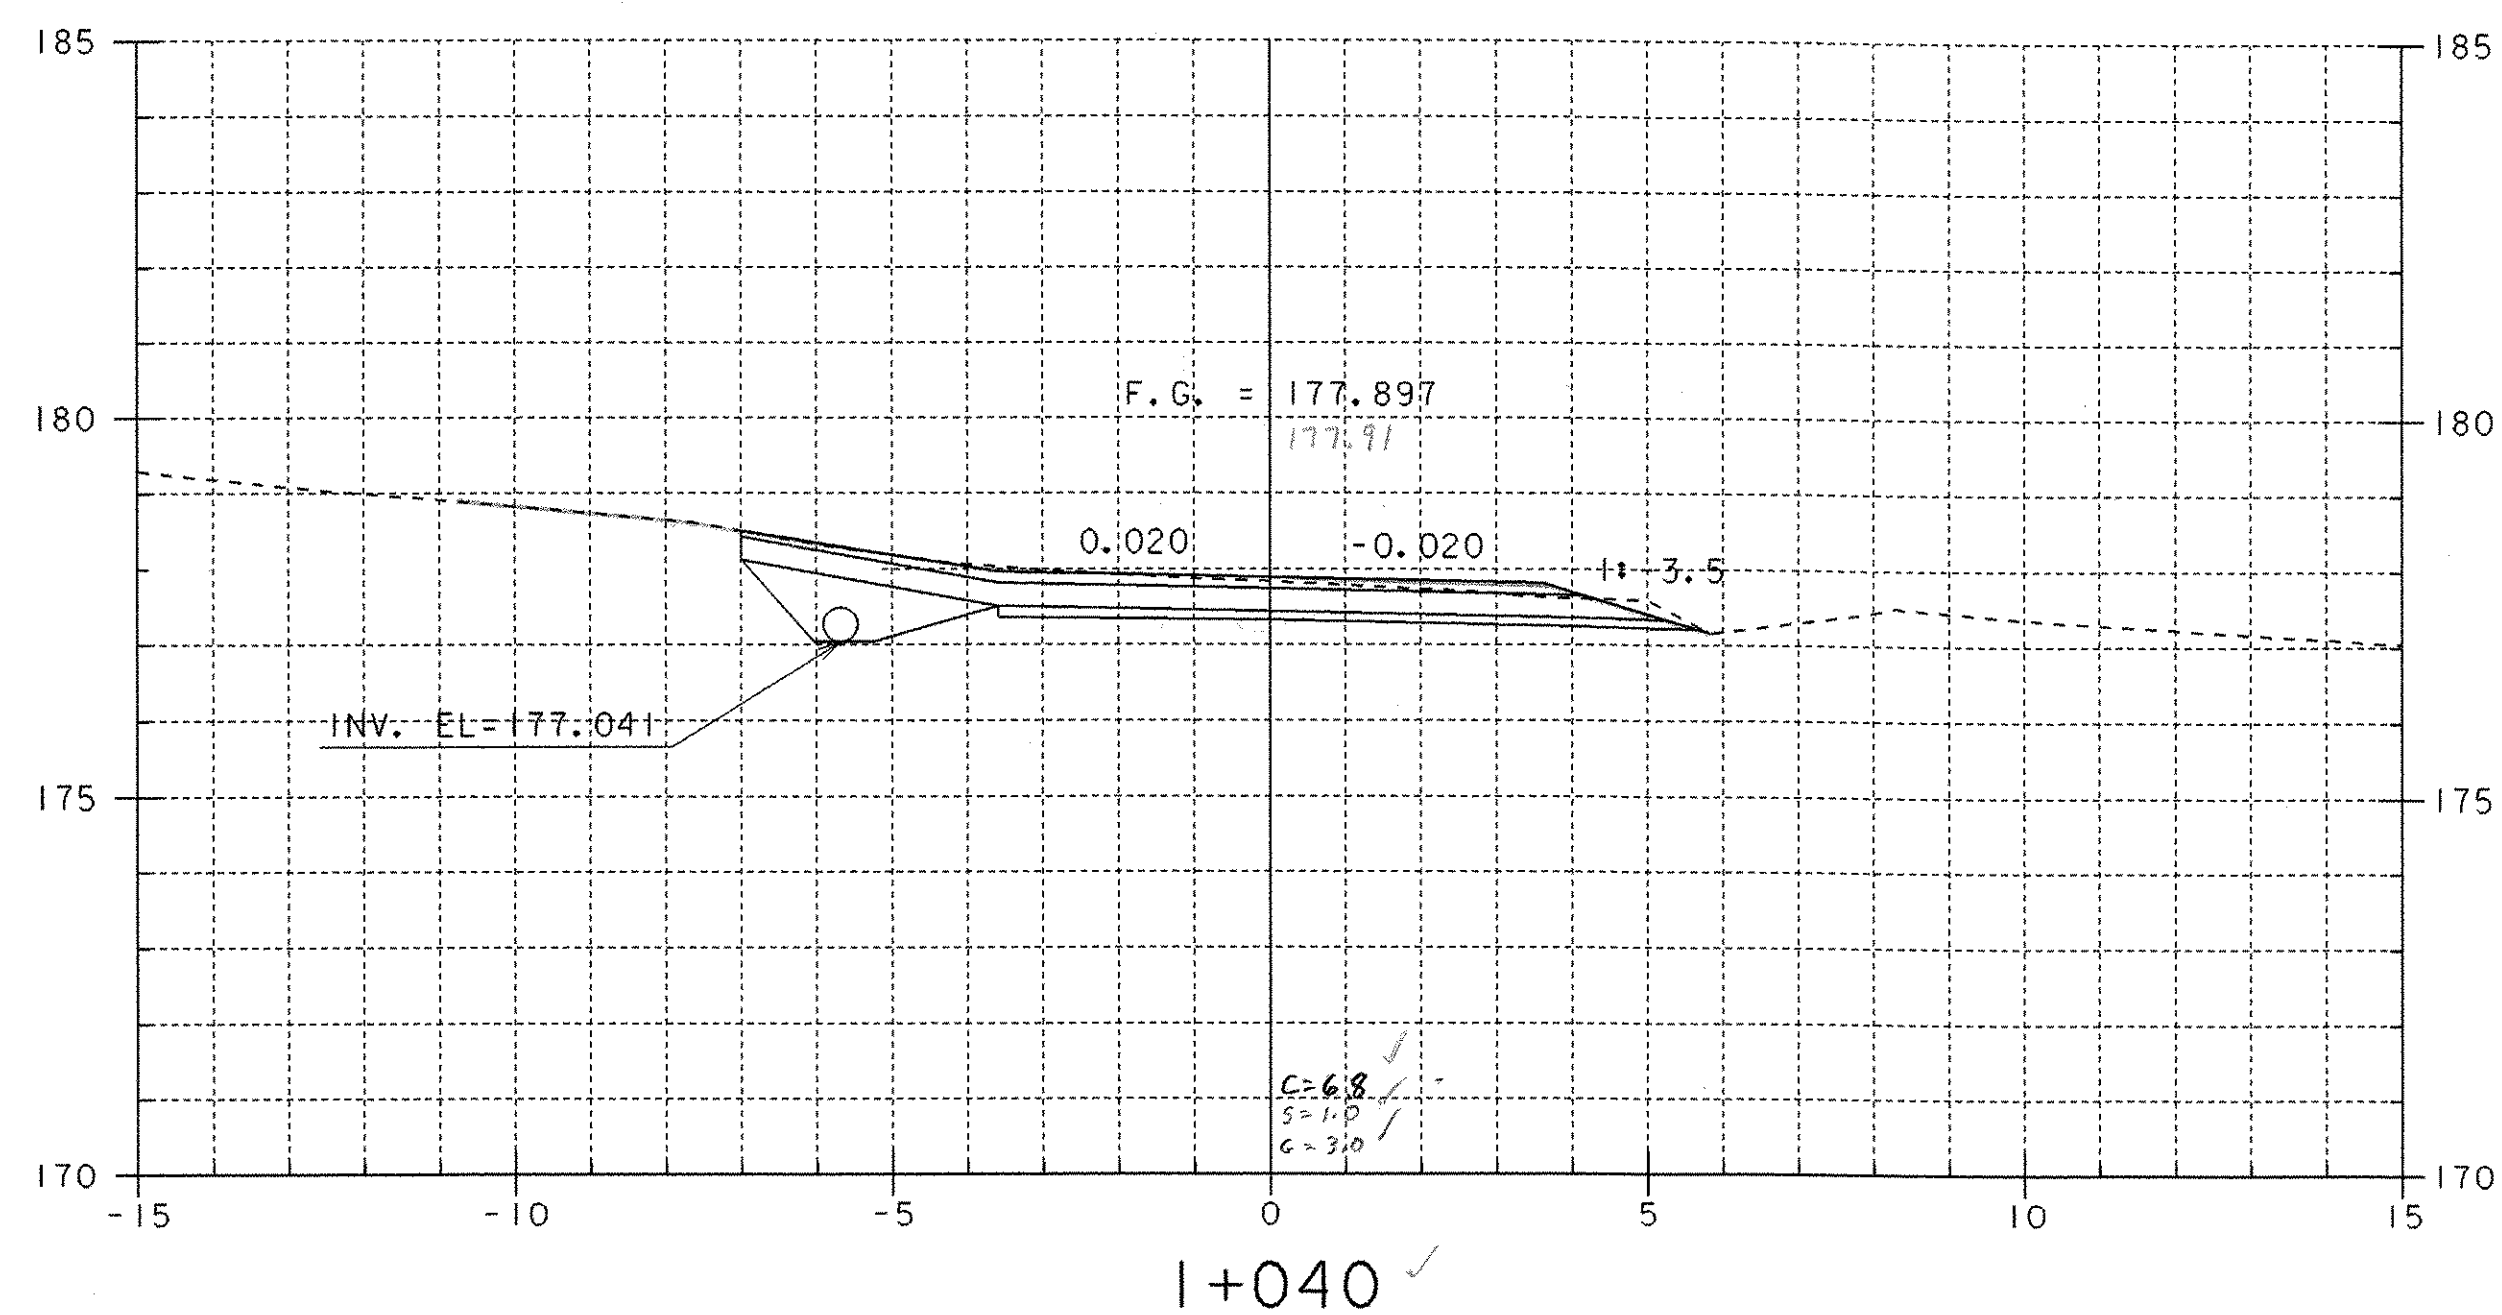


STA 1+037 LT
 CONSTRUCT DRIVE
 (SEE SHT. 50 FOR DETAILS)

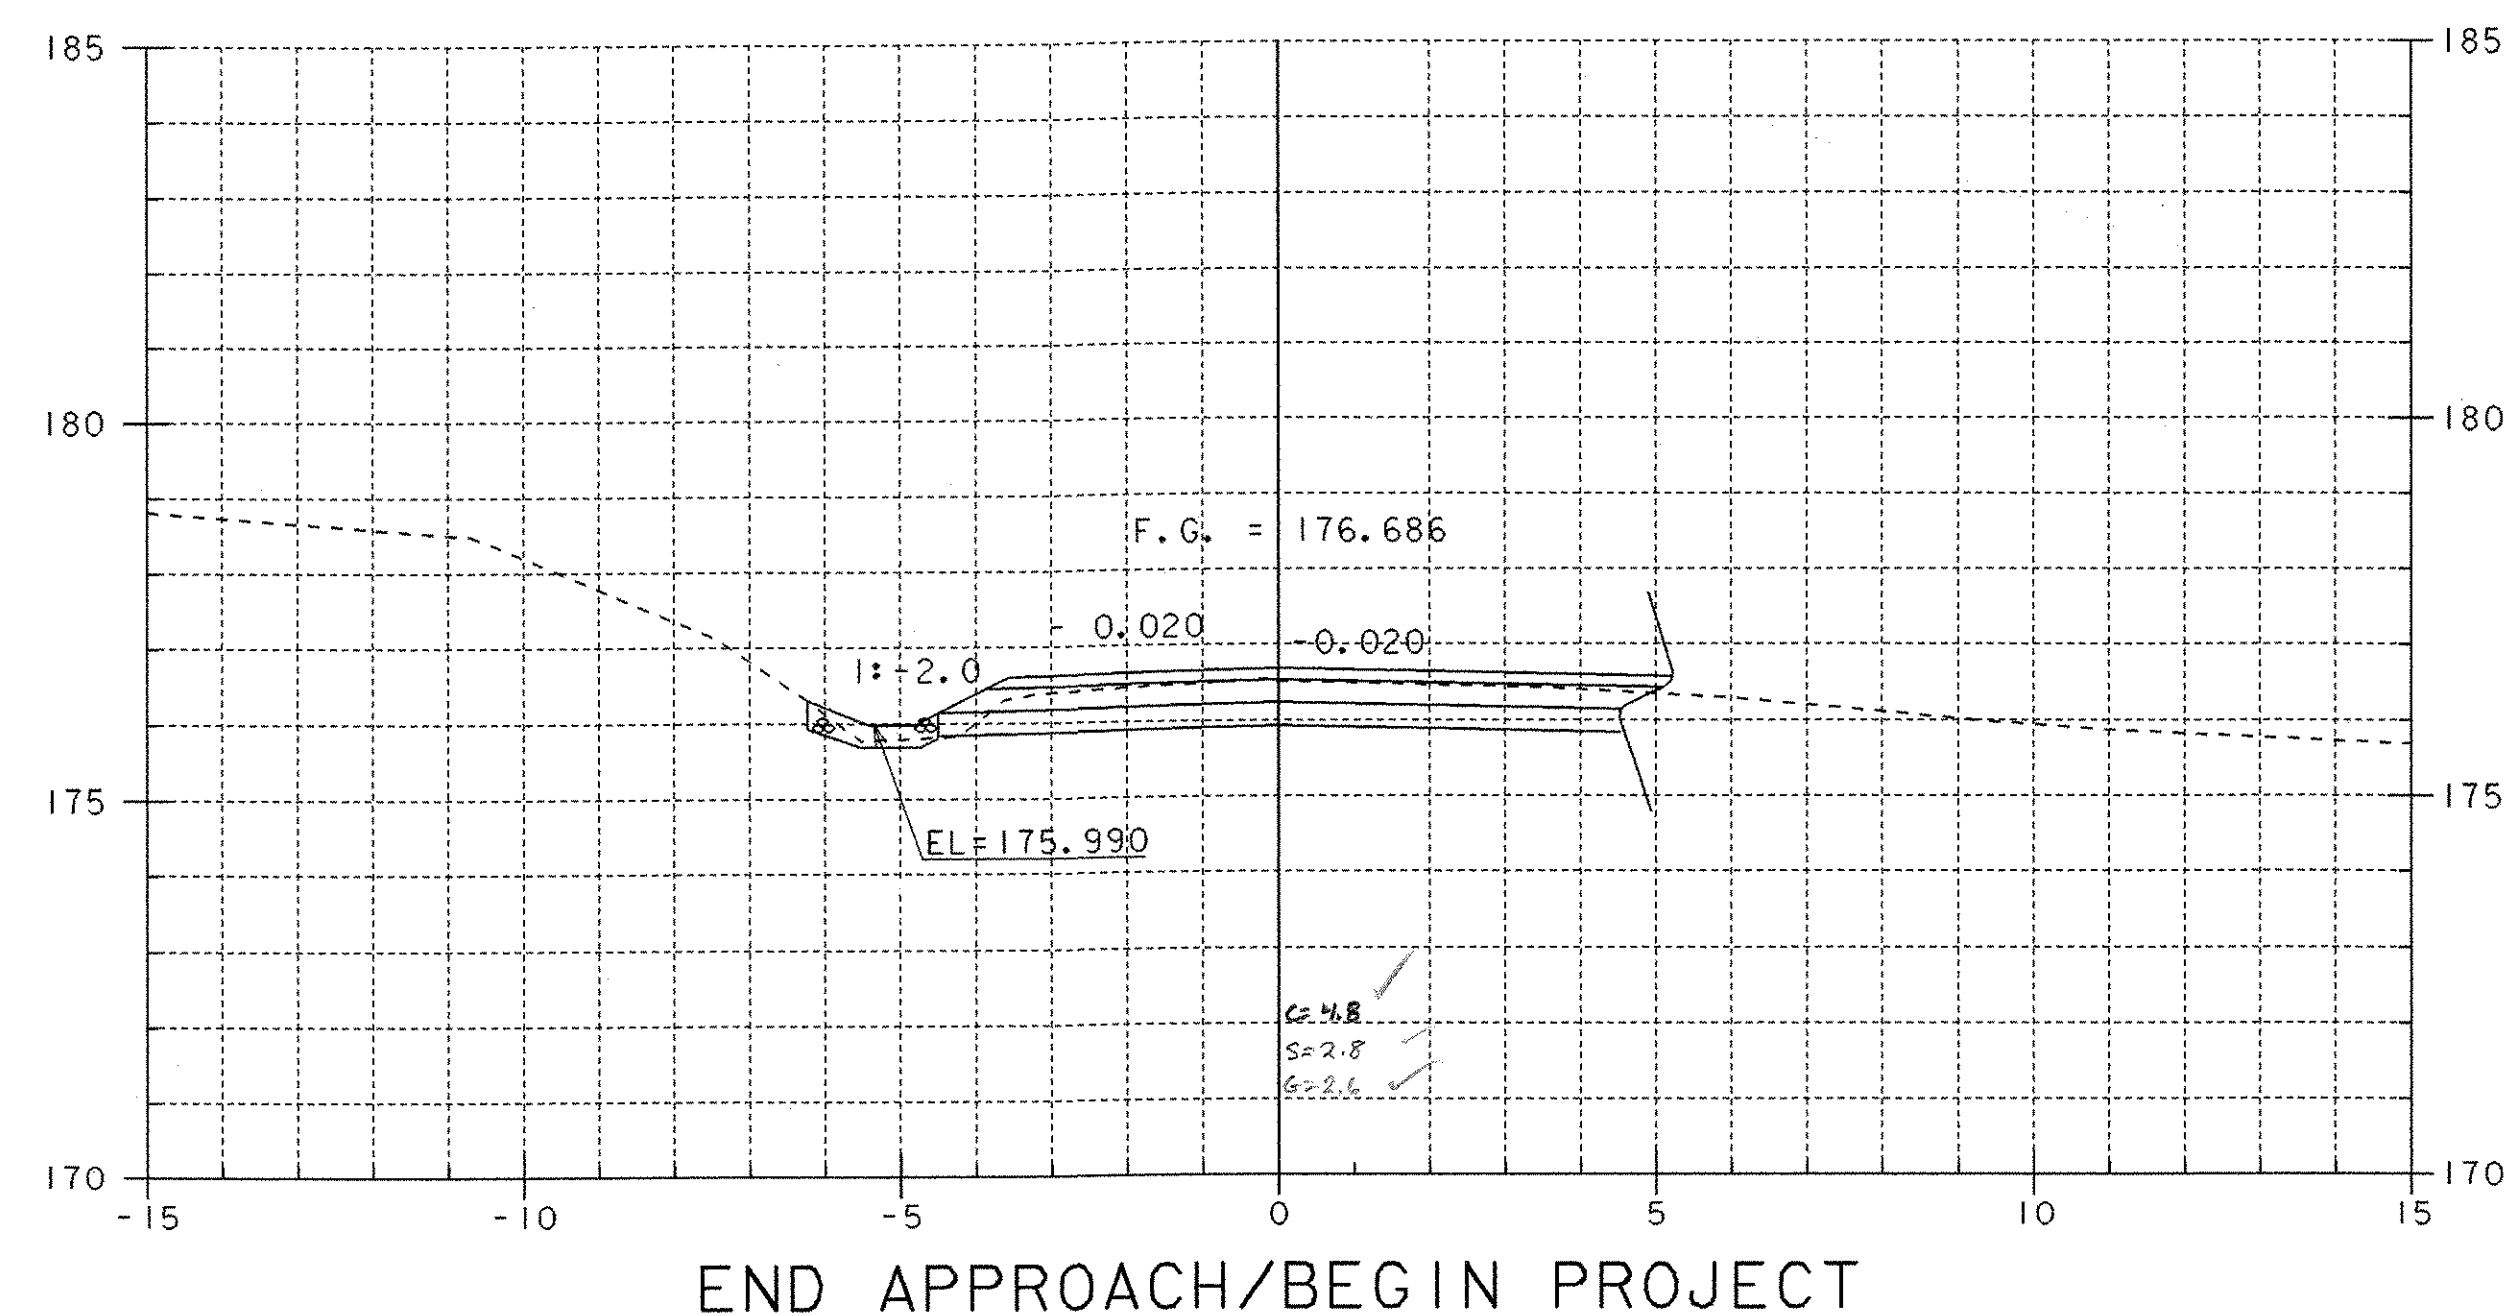


SHEET NAME: MAINLINE CROSS SECTIONS	
PROJECT NAME: WESTFORD	HIGHWAY NO.: TH 4
PROJECT NUMBER: TH2 9436	BRIDGE NO.: 2
	OVER: ROGERS BROOK
FILE NAME: /PW/94J122/sj122xs2.dgn	PLOT DATE: 25-MAR-2005
PROJECT MANAGER: R. R. WHITCOMB	DRAWN BY: STRI
DESIGNED BY: C. CARLSON	IPARM NAME: sj122mx2.1
BRIDGE SHEET NUMBER:	SHEET 45 OF 56

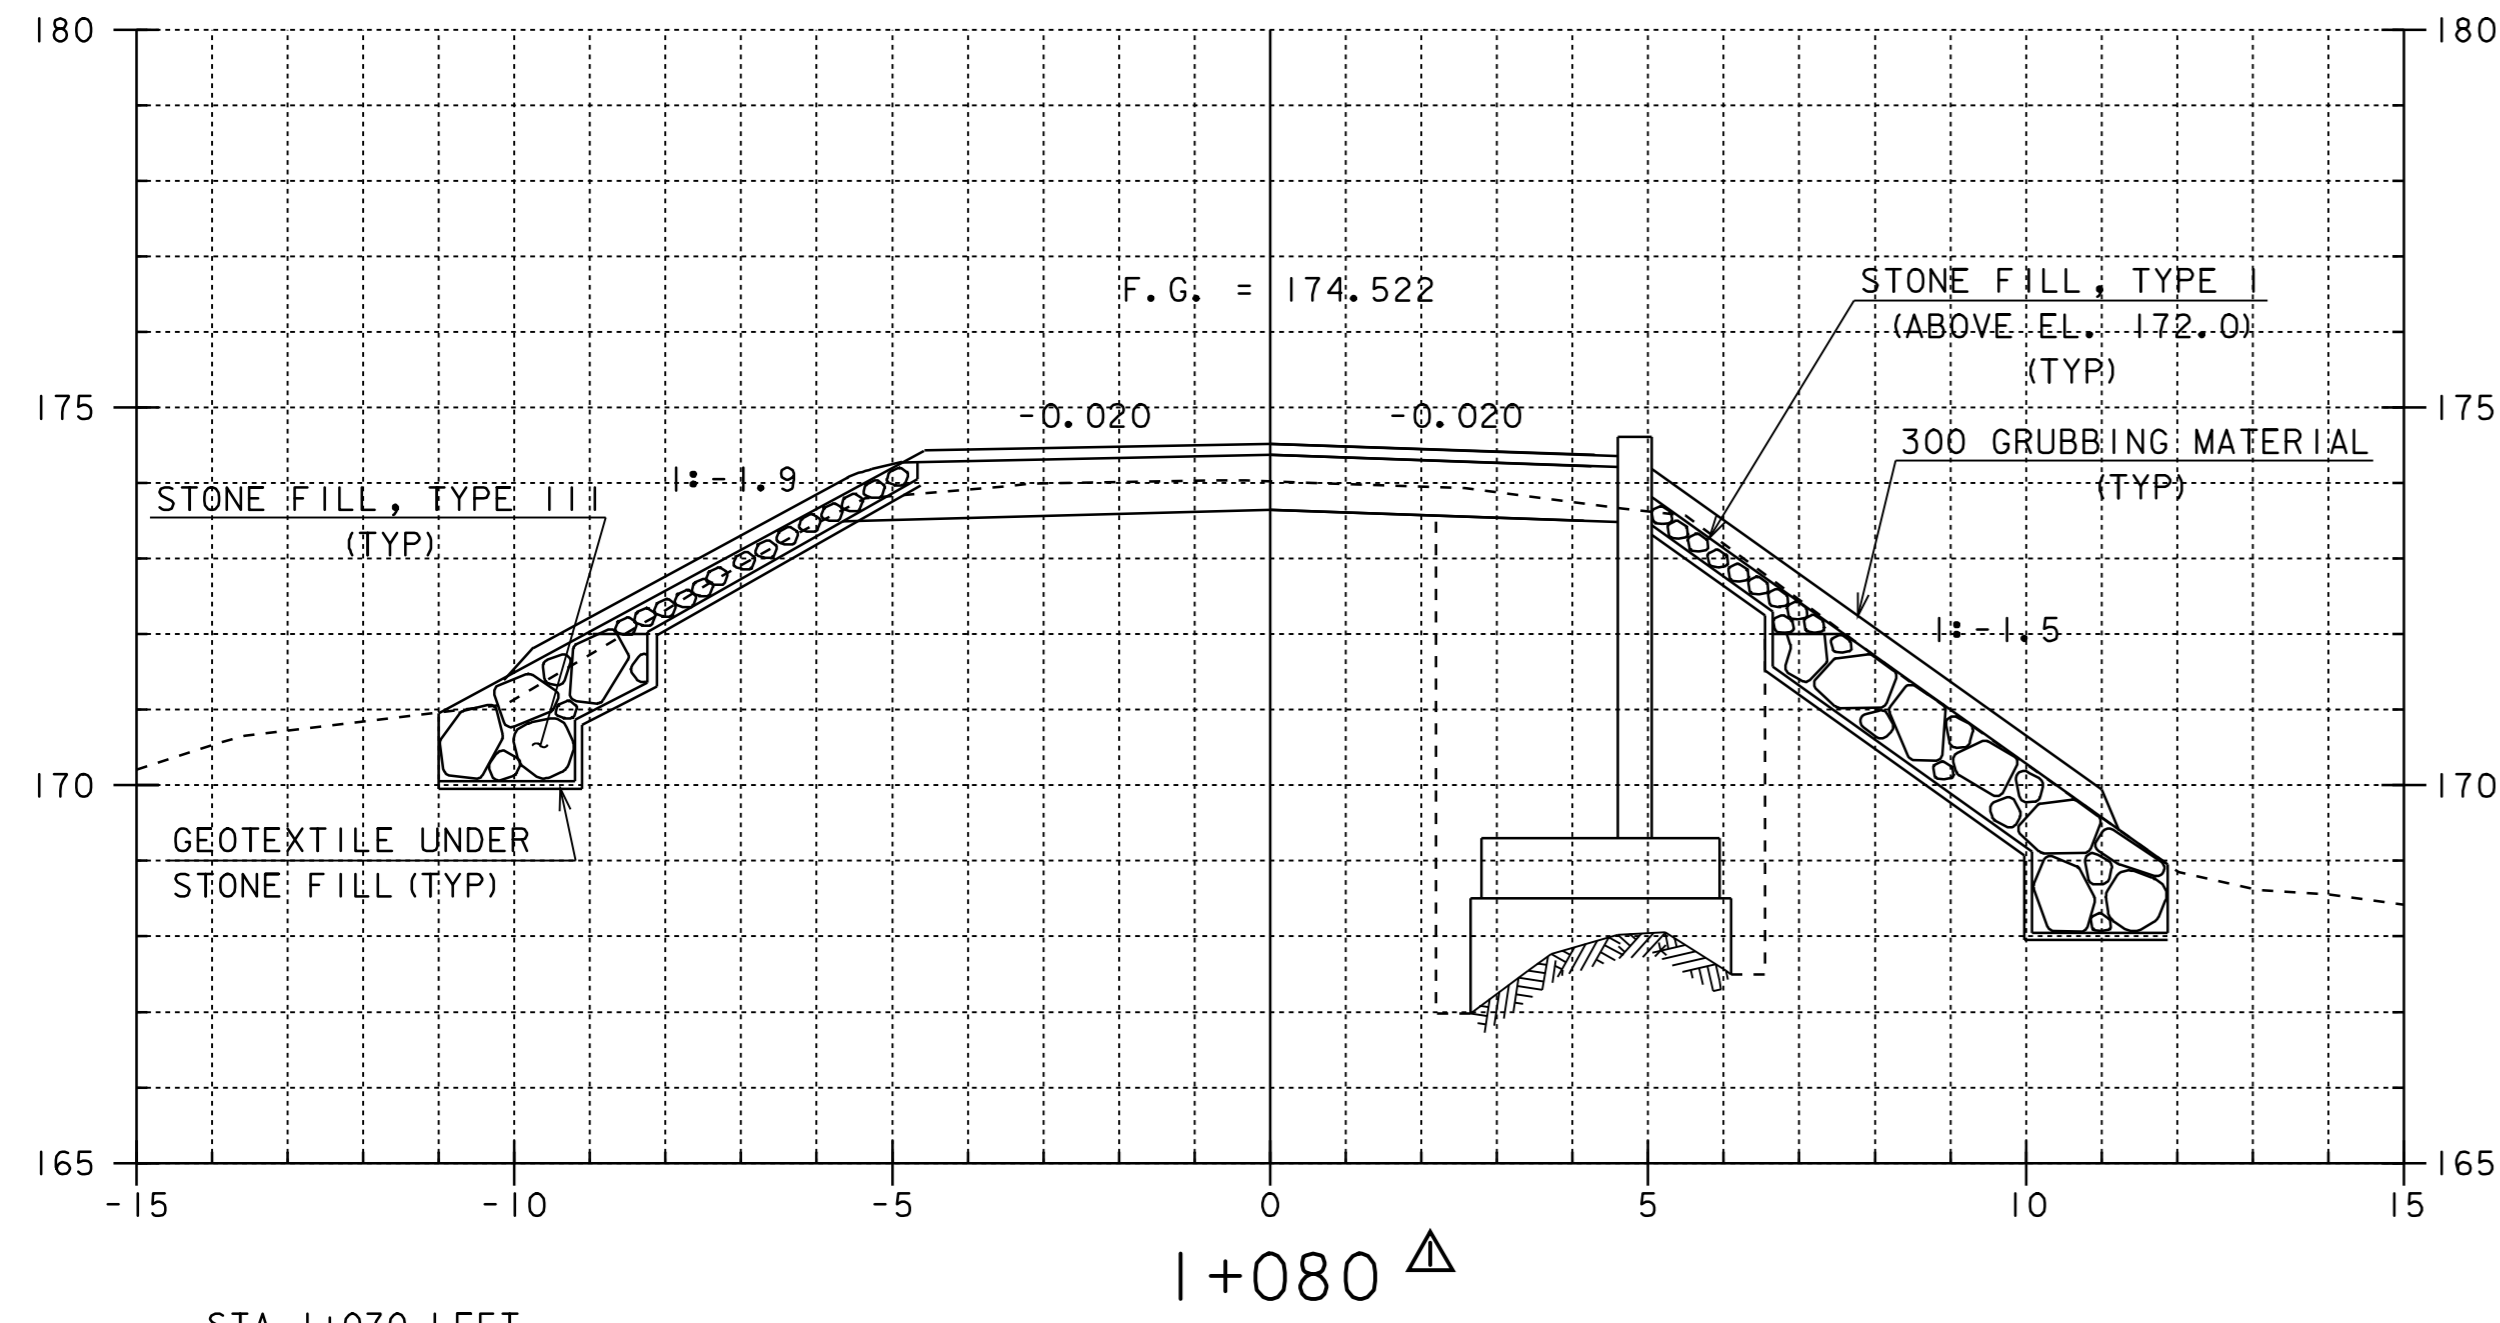


STA 1+070 LEFT
END STONE FILL, TYPE I

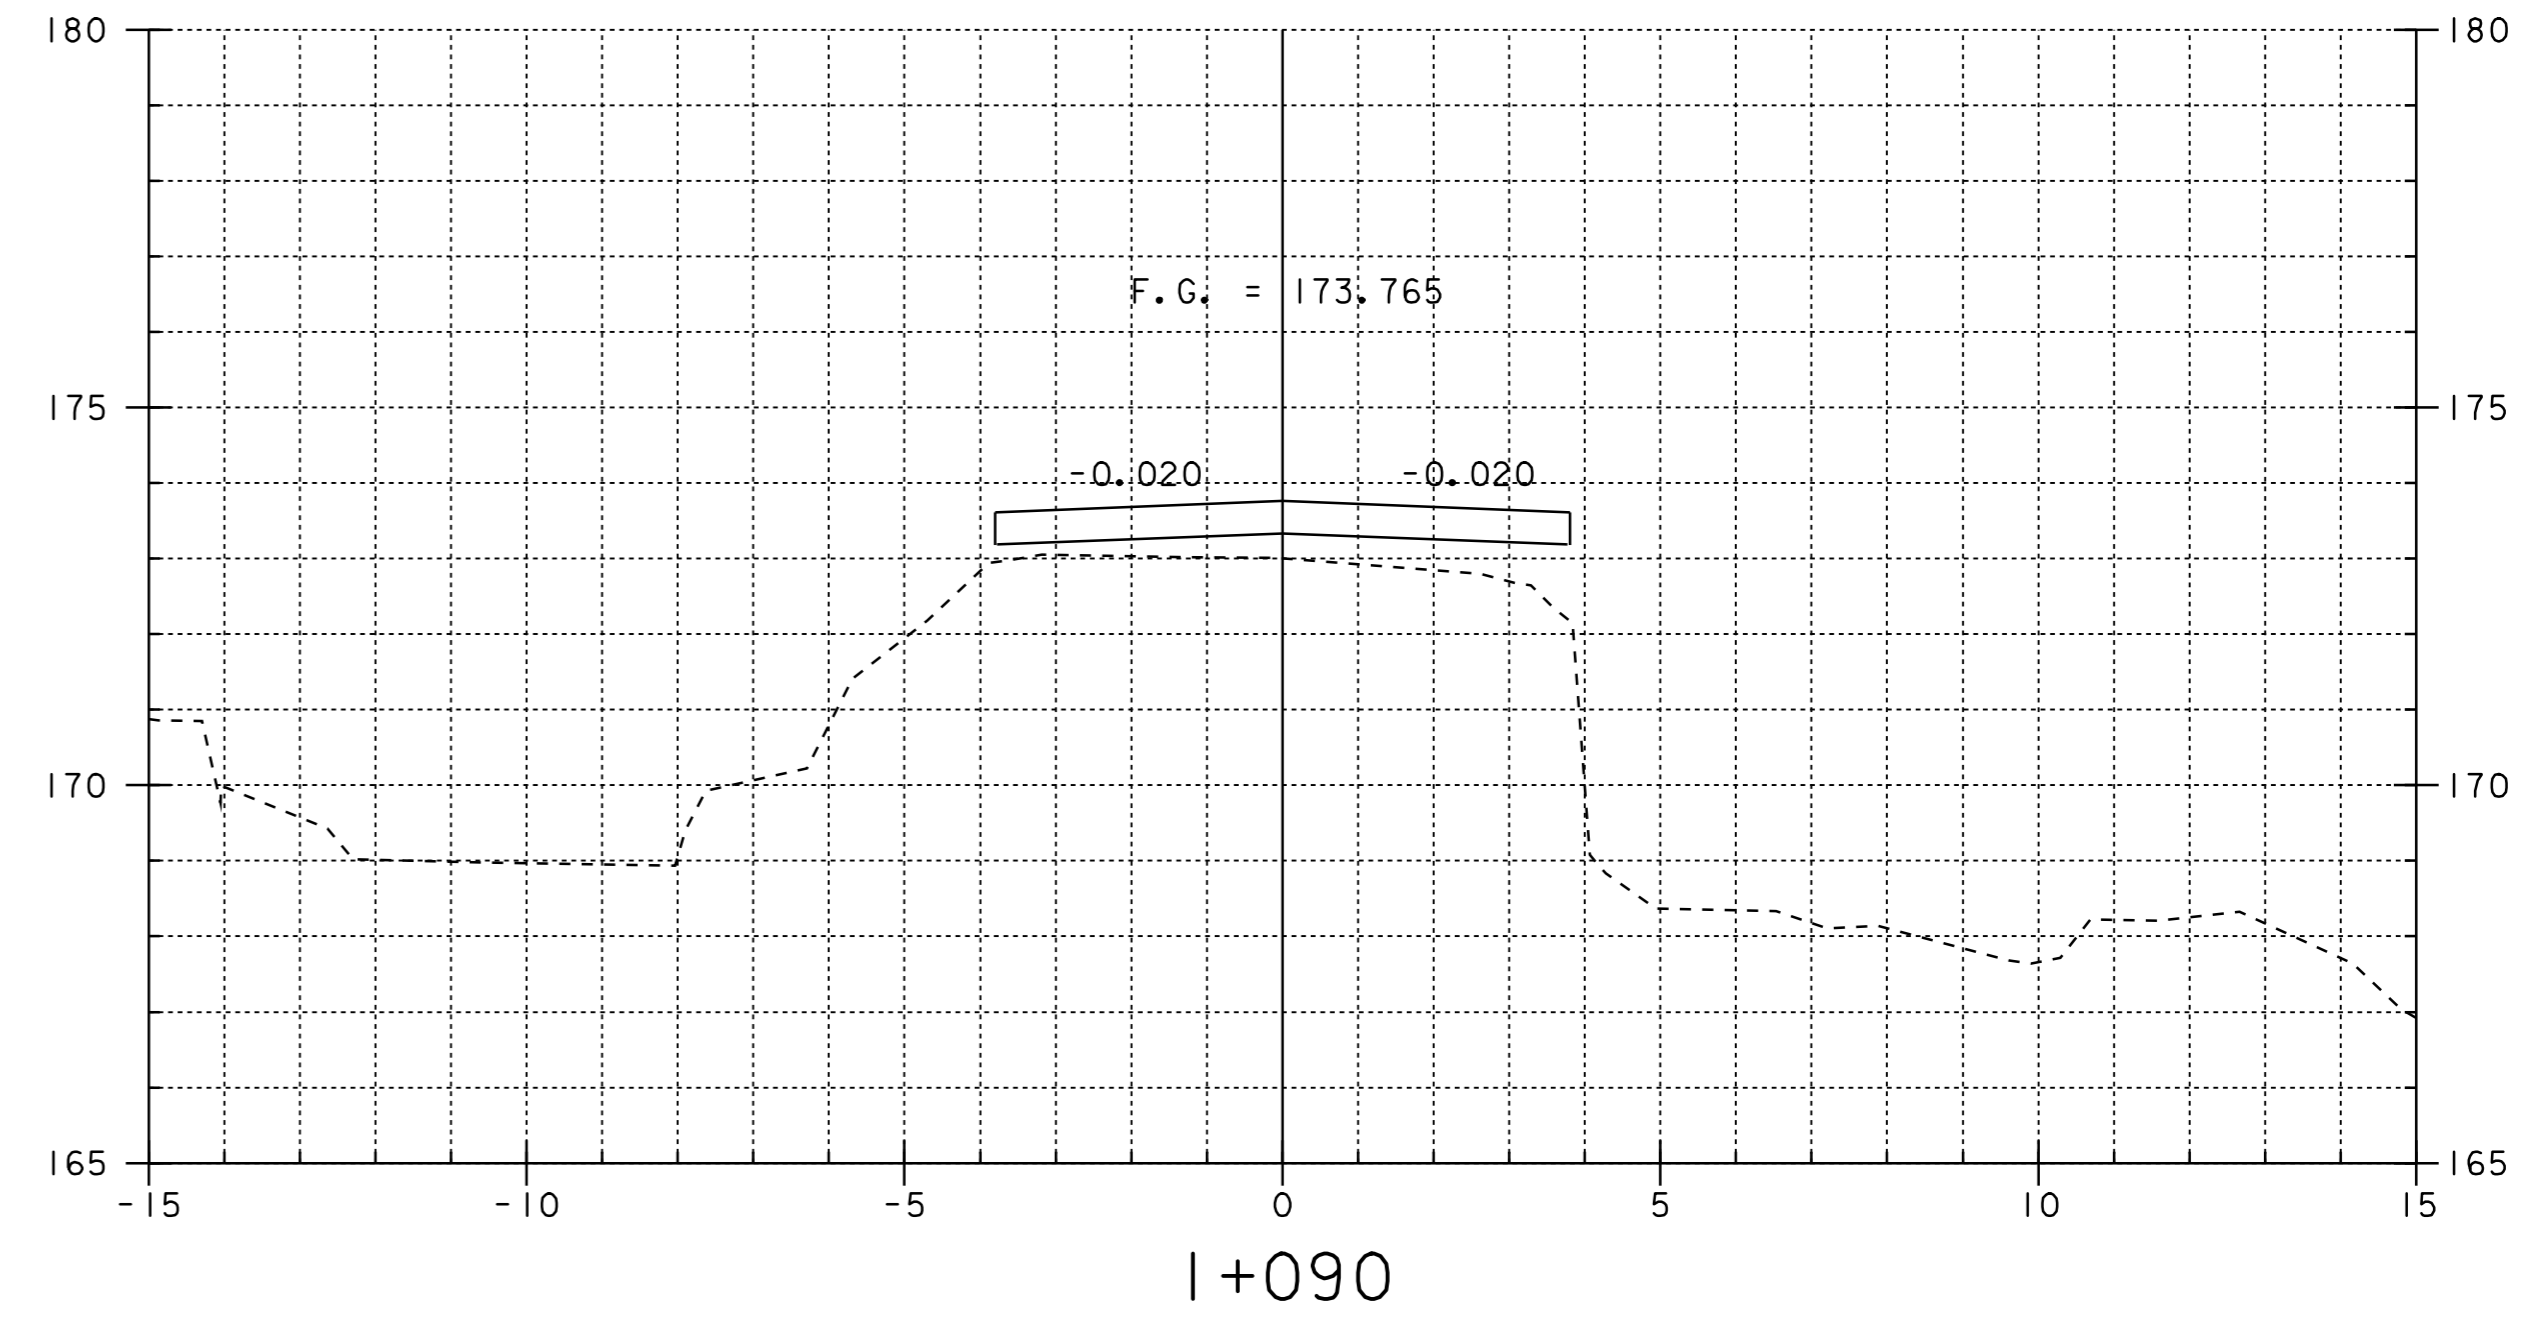

1+090

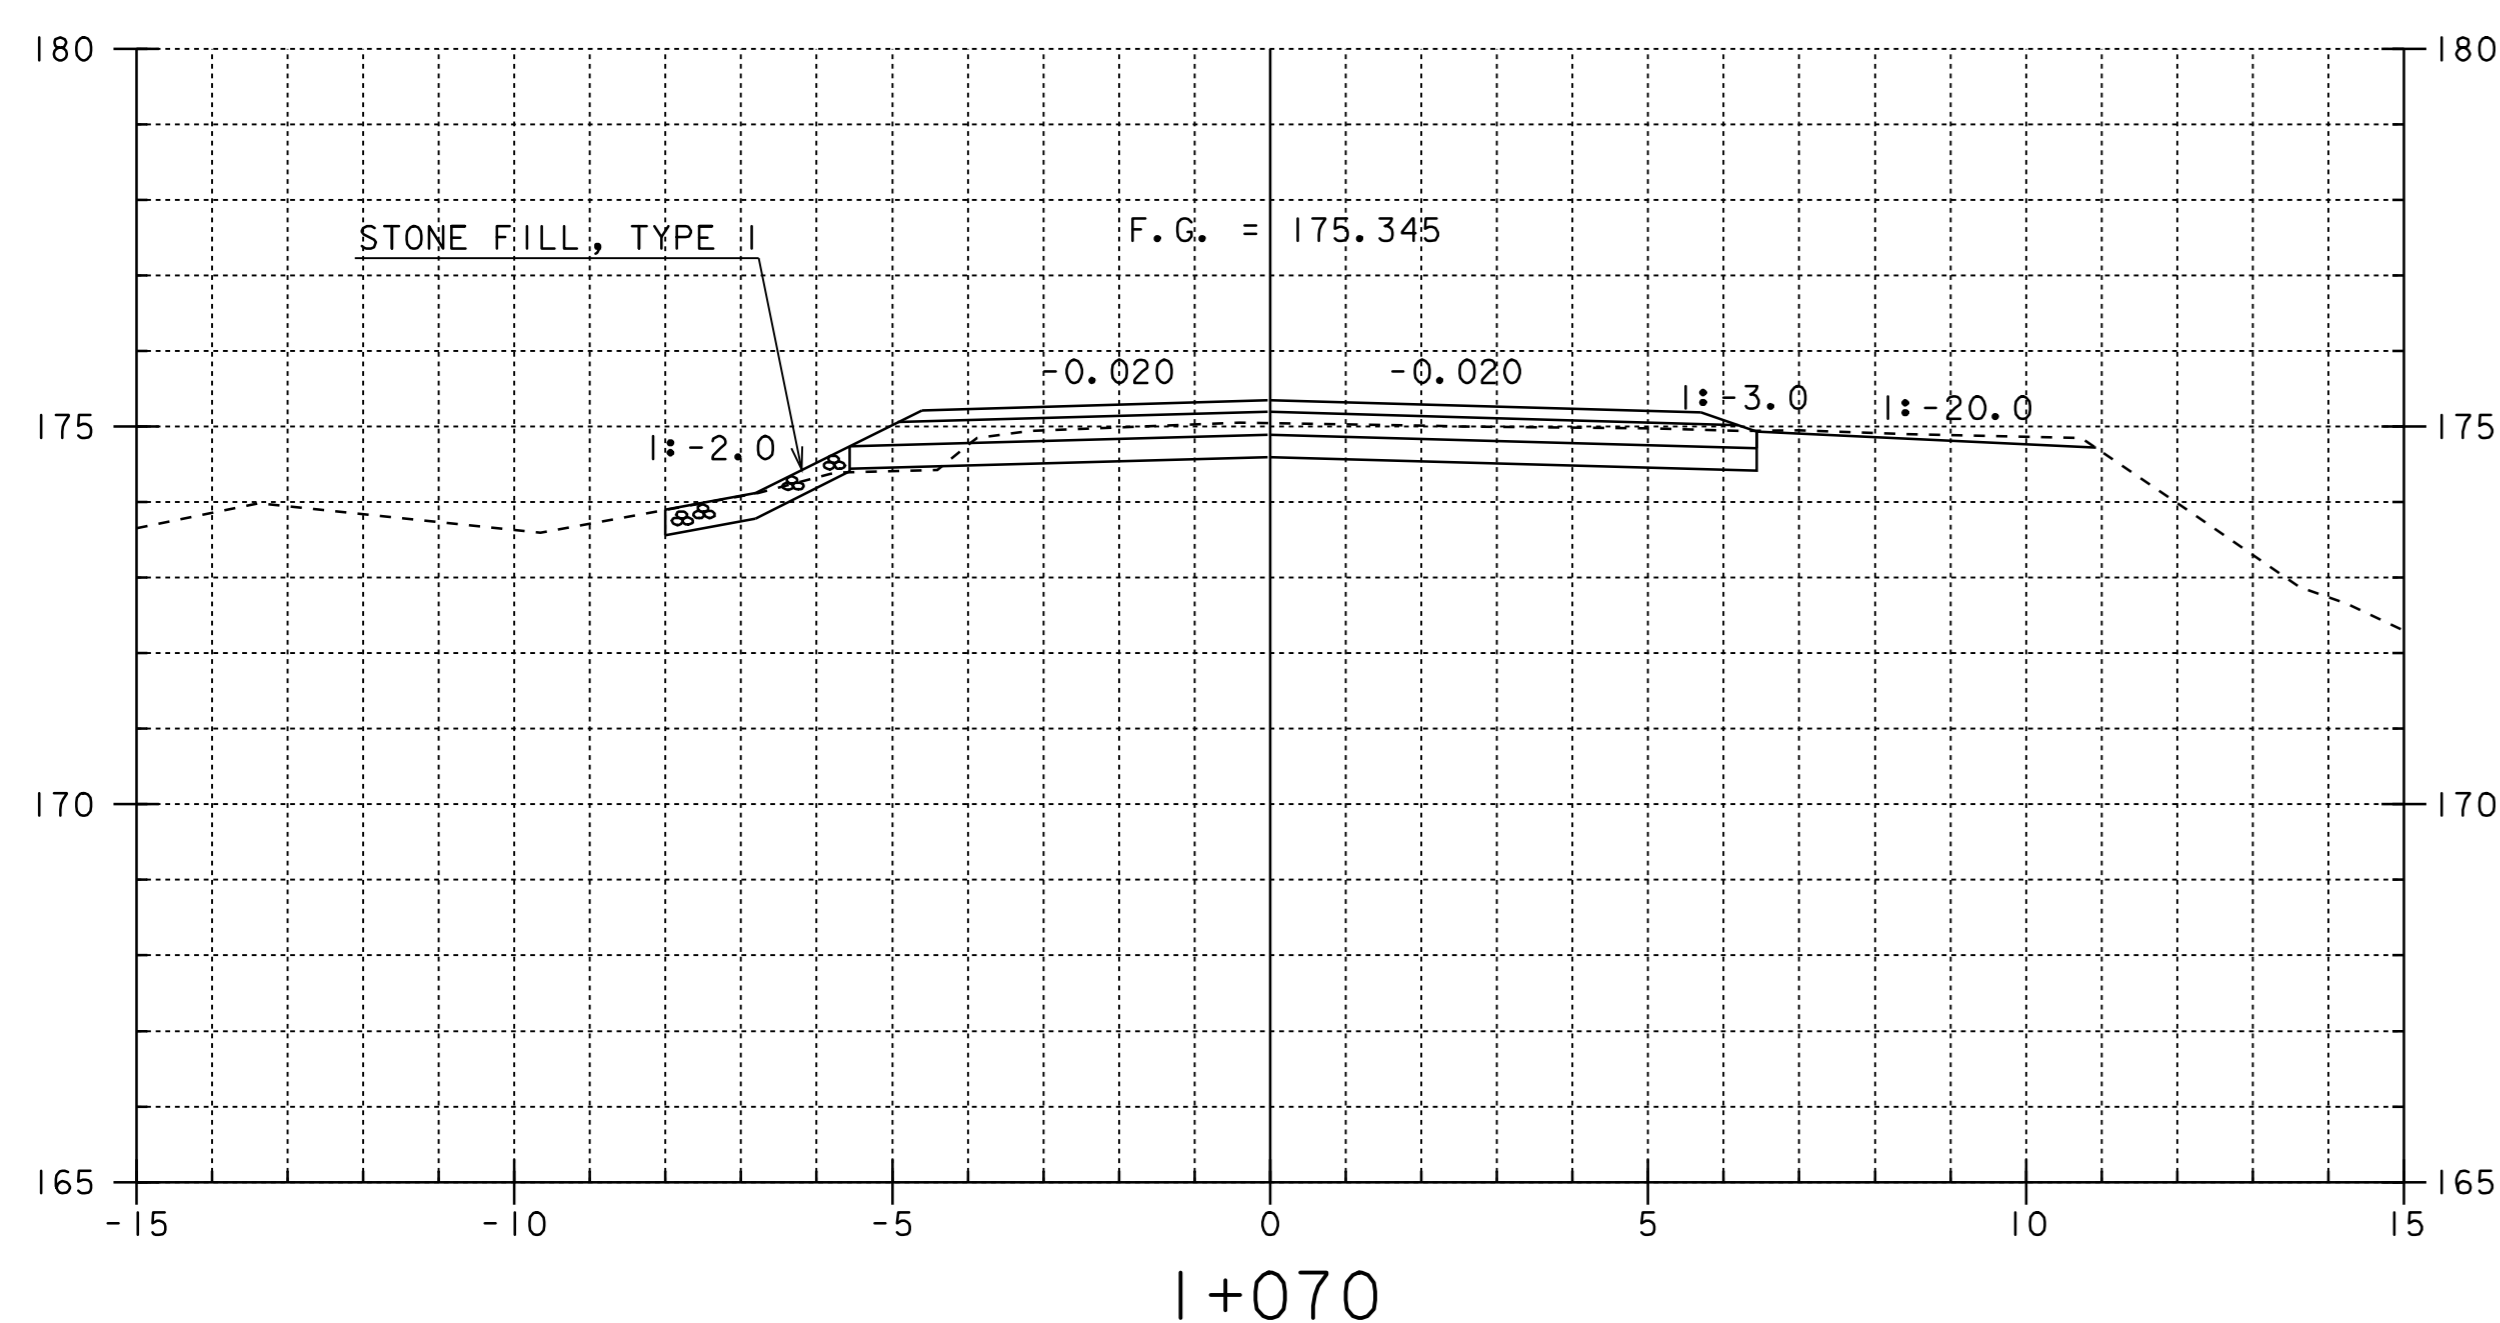





1+070

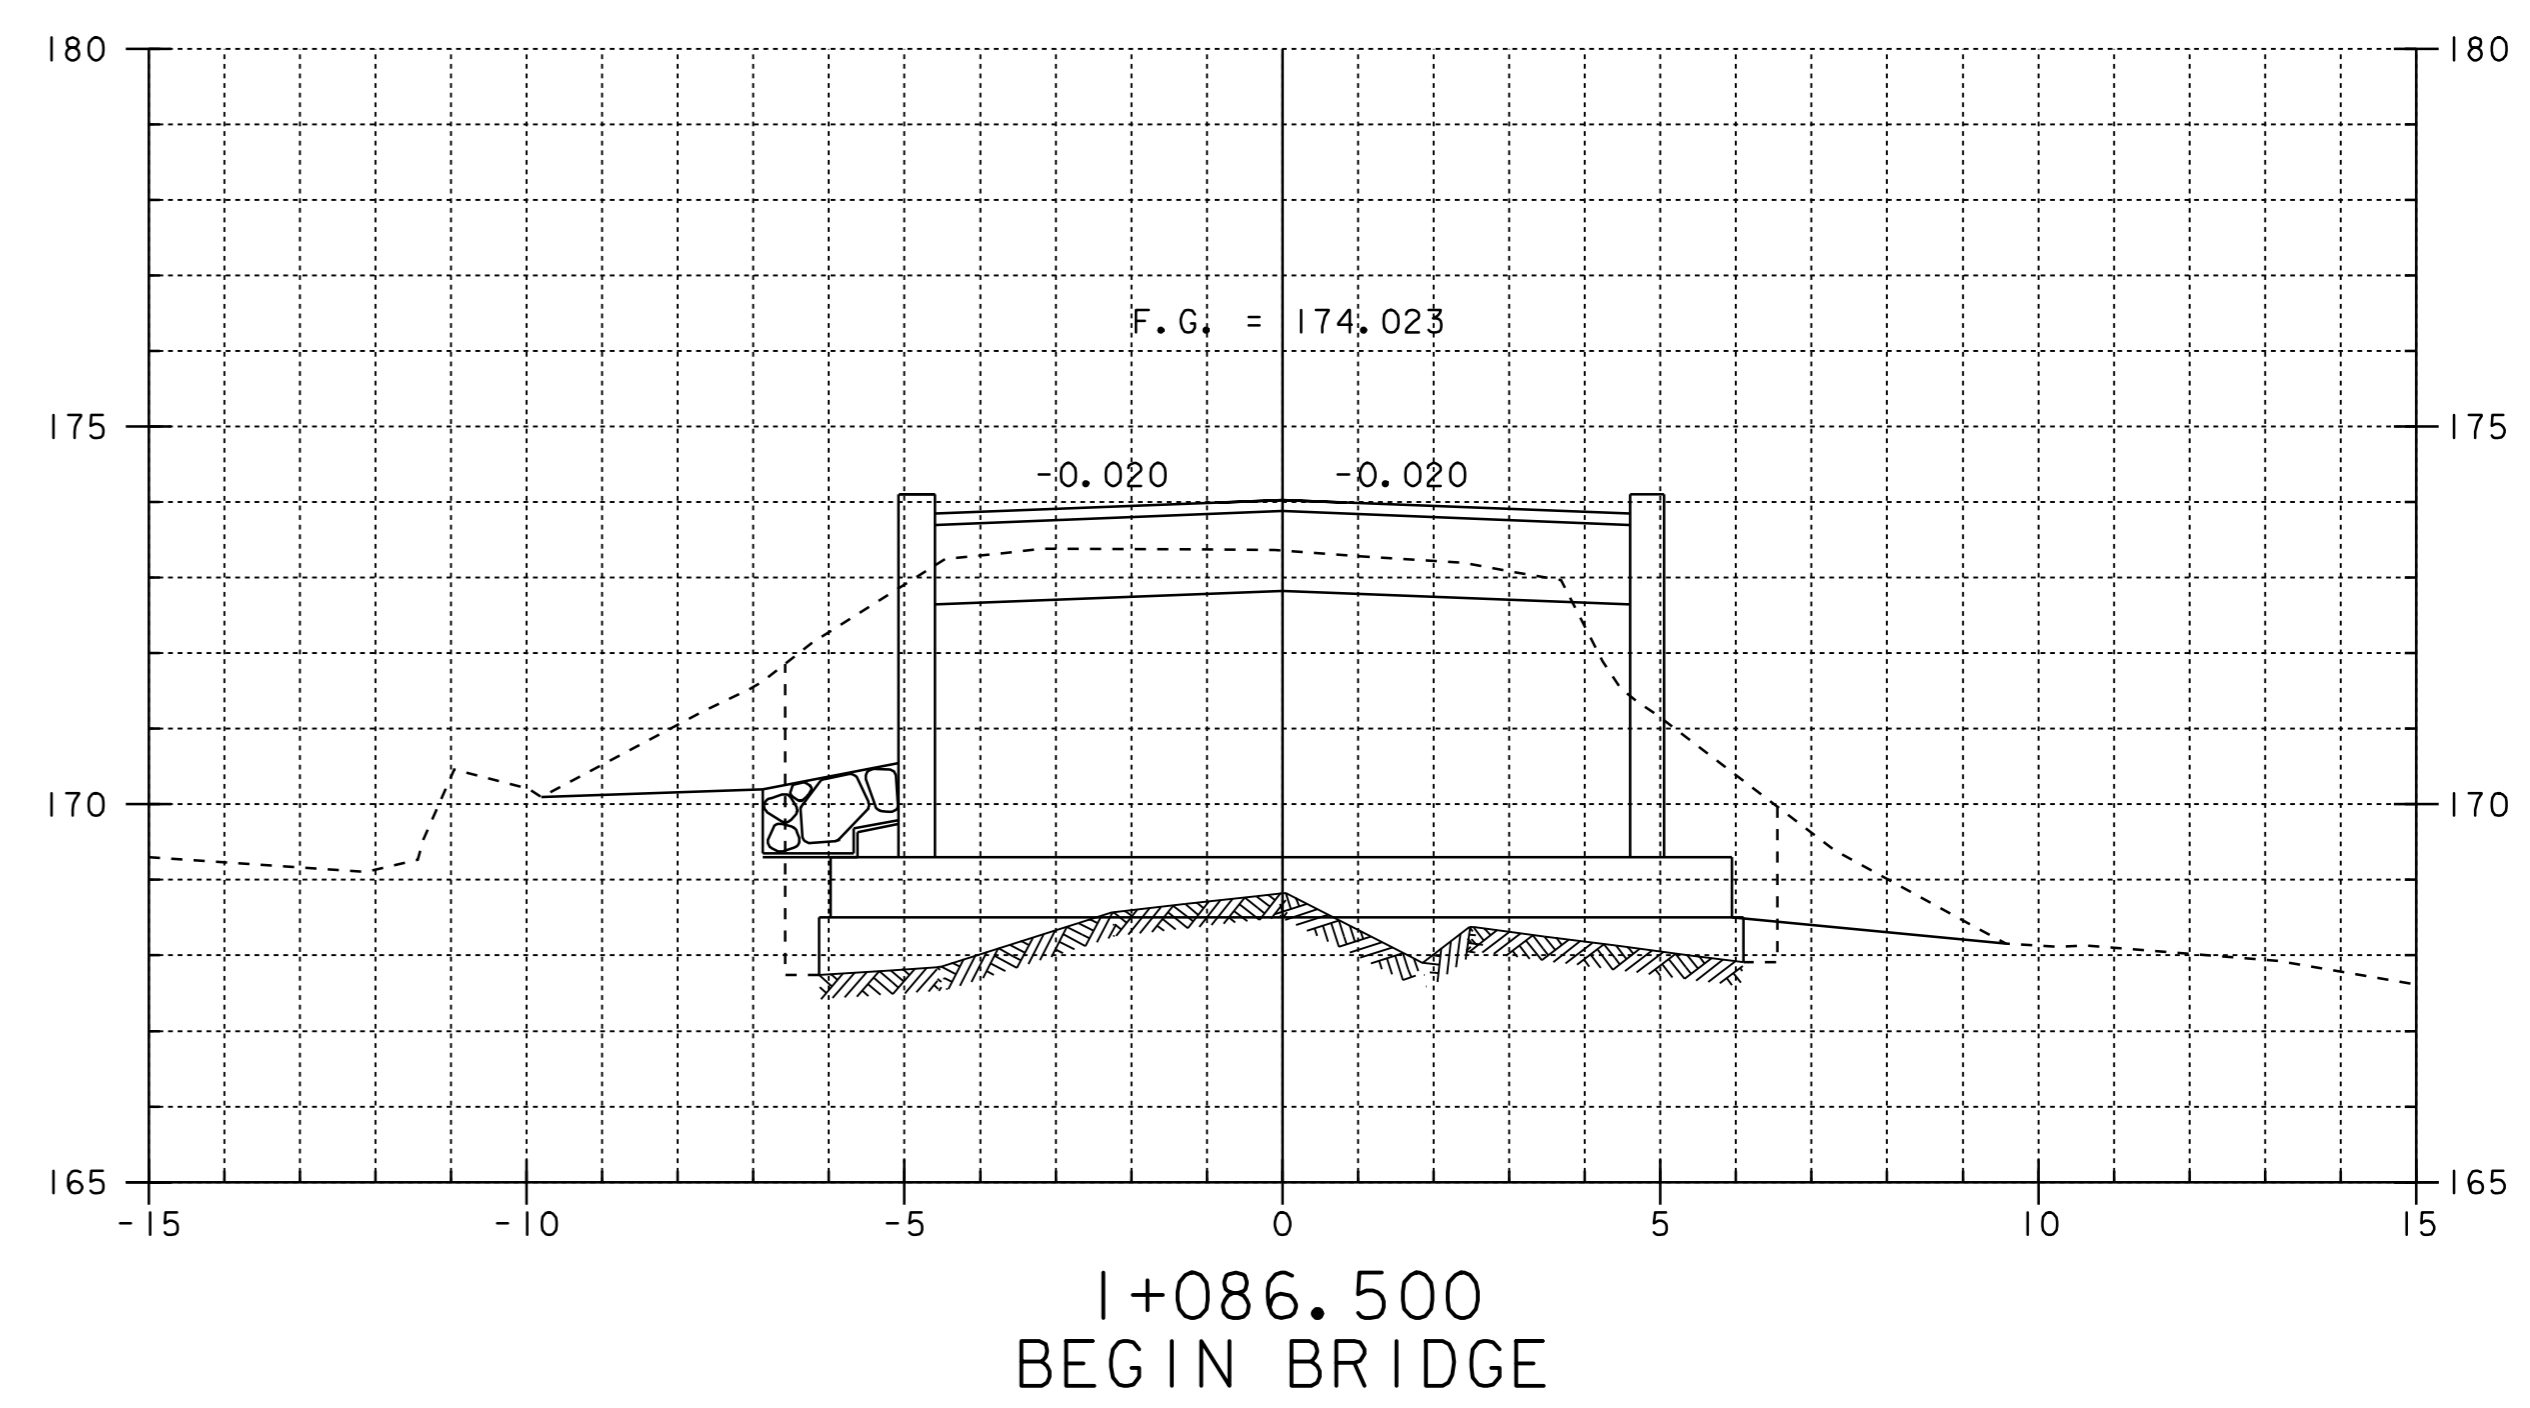

1+086.500
BEGIN BRIDGE

SHEET NAME: <u>MAINLINE CROSS SECTIONS</u>	
PROJECT NAME: <u>WESTFORD</u>	HIGHWAY NO.: <u>IH 4</u>
PROJECT NUMBER: <u>IH2_9436</u>	BRIDGE NO.: <u>2</u>
	OVER: <u>ROGERS BROOK</u>
FILE NAME: <u>ZPW\941122\sj122xs2.dgn</u>	PLOT DATE: <u>22-DEC-2006</u>
PROJECT MANAGER: <u>B. B. WHITCOMB</u>	DRAWN BY: <u>SIRI</u>
DESIGNED BY: <u>C. CARLSON</u>	IPARM NAME: <u>sj122mx3.1</u>
BRIDGE SHEET NUMBER: <u> </u>	SHEET <u>46</u> OF <u>56</u>

REVISION	DATE	BY	CHK'D	DESCRIPTION
△	06/27/2005	GFR	CWC	ABUTMENTS MODIFIED DUE TO UPDATED LEDGE INFORMATION.

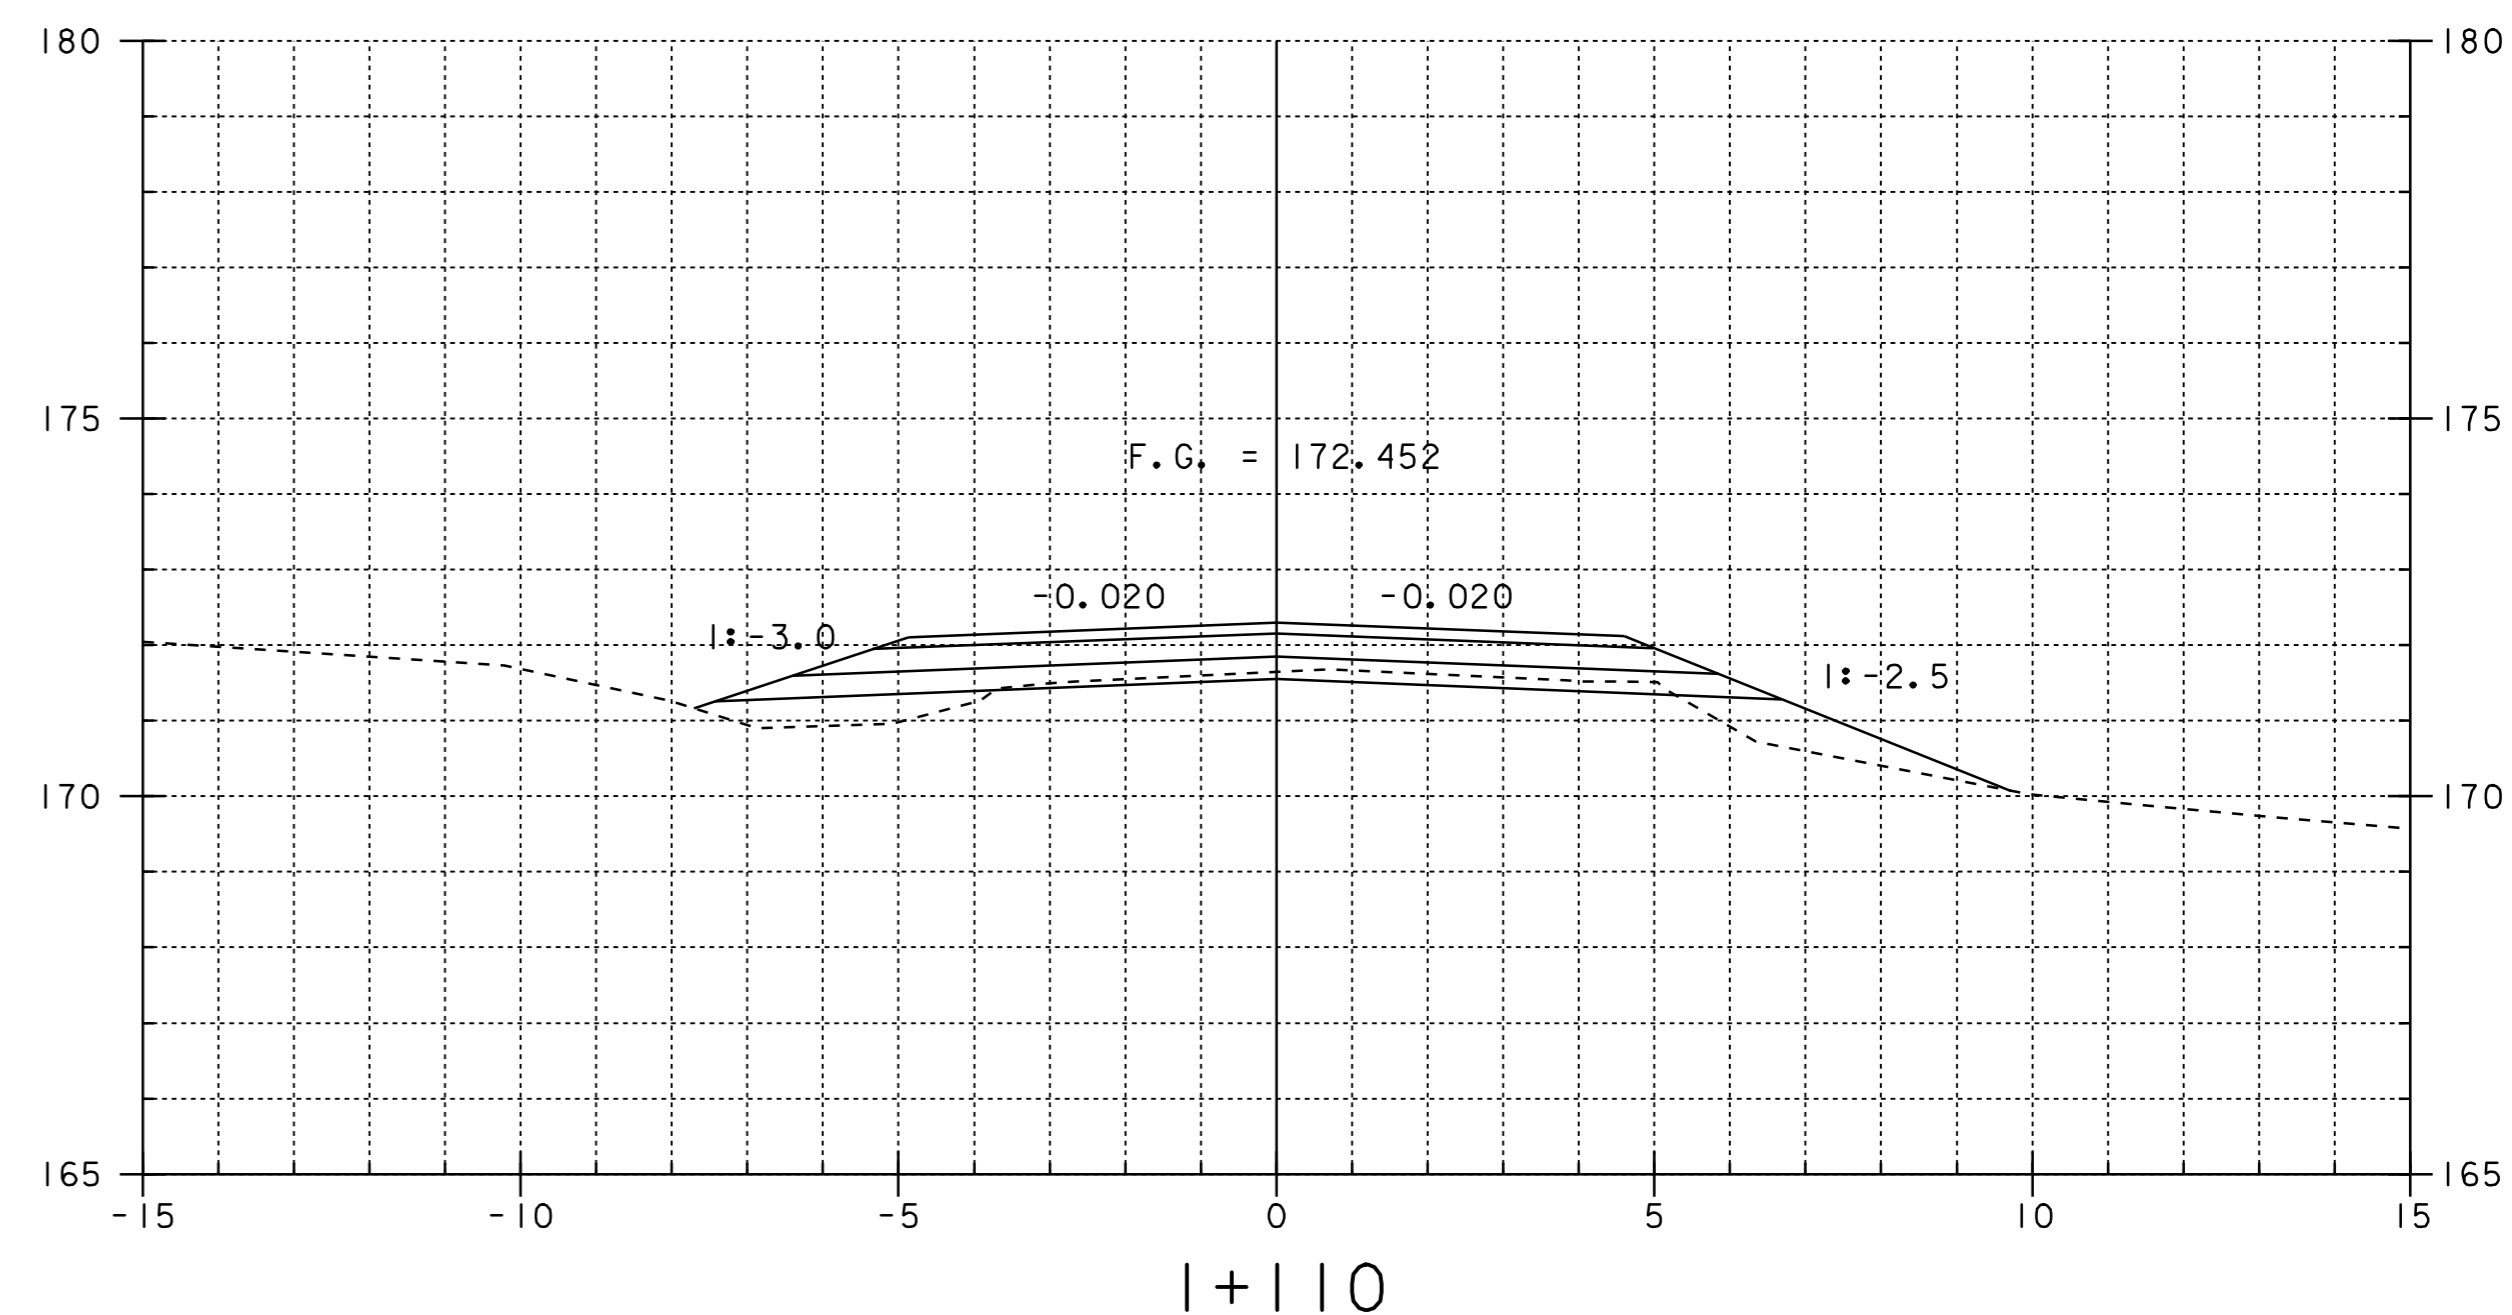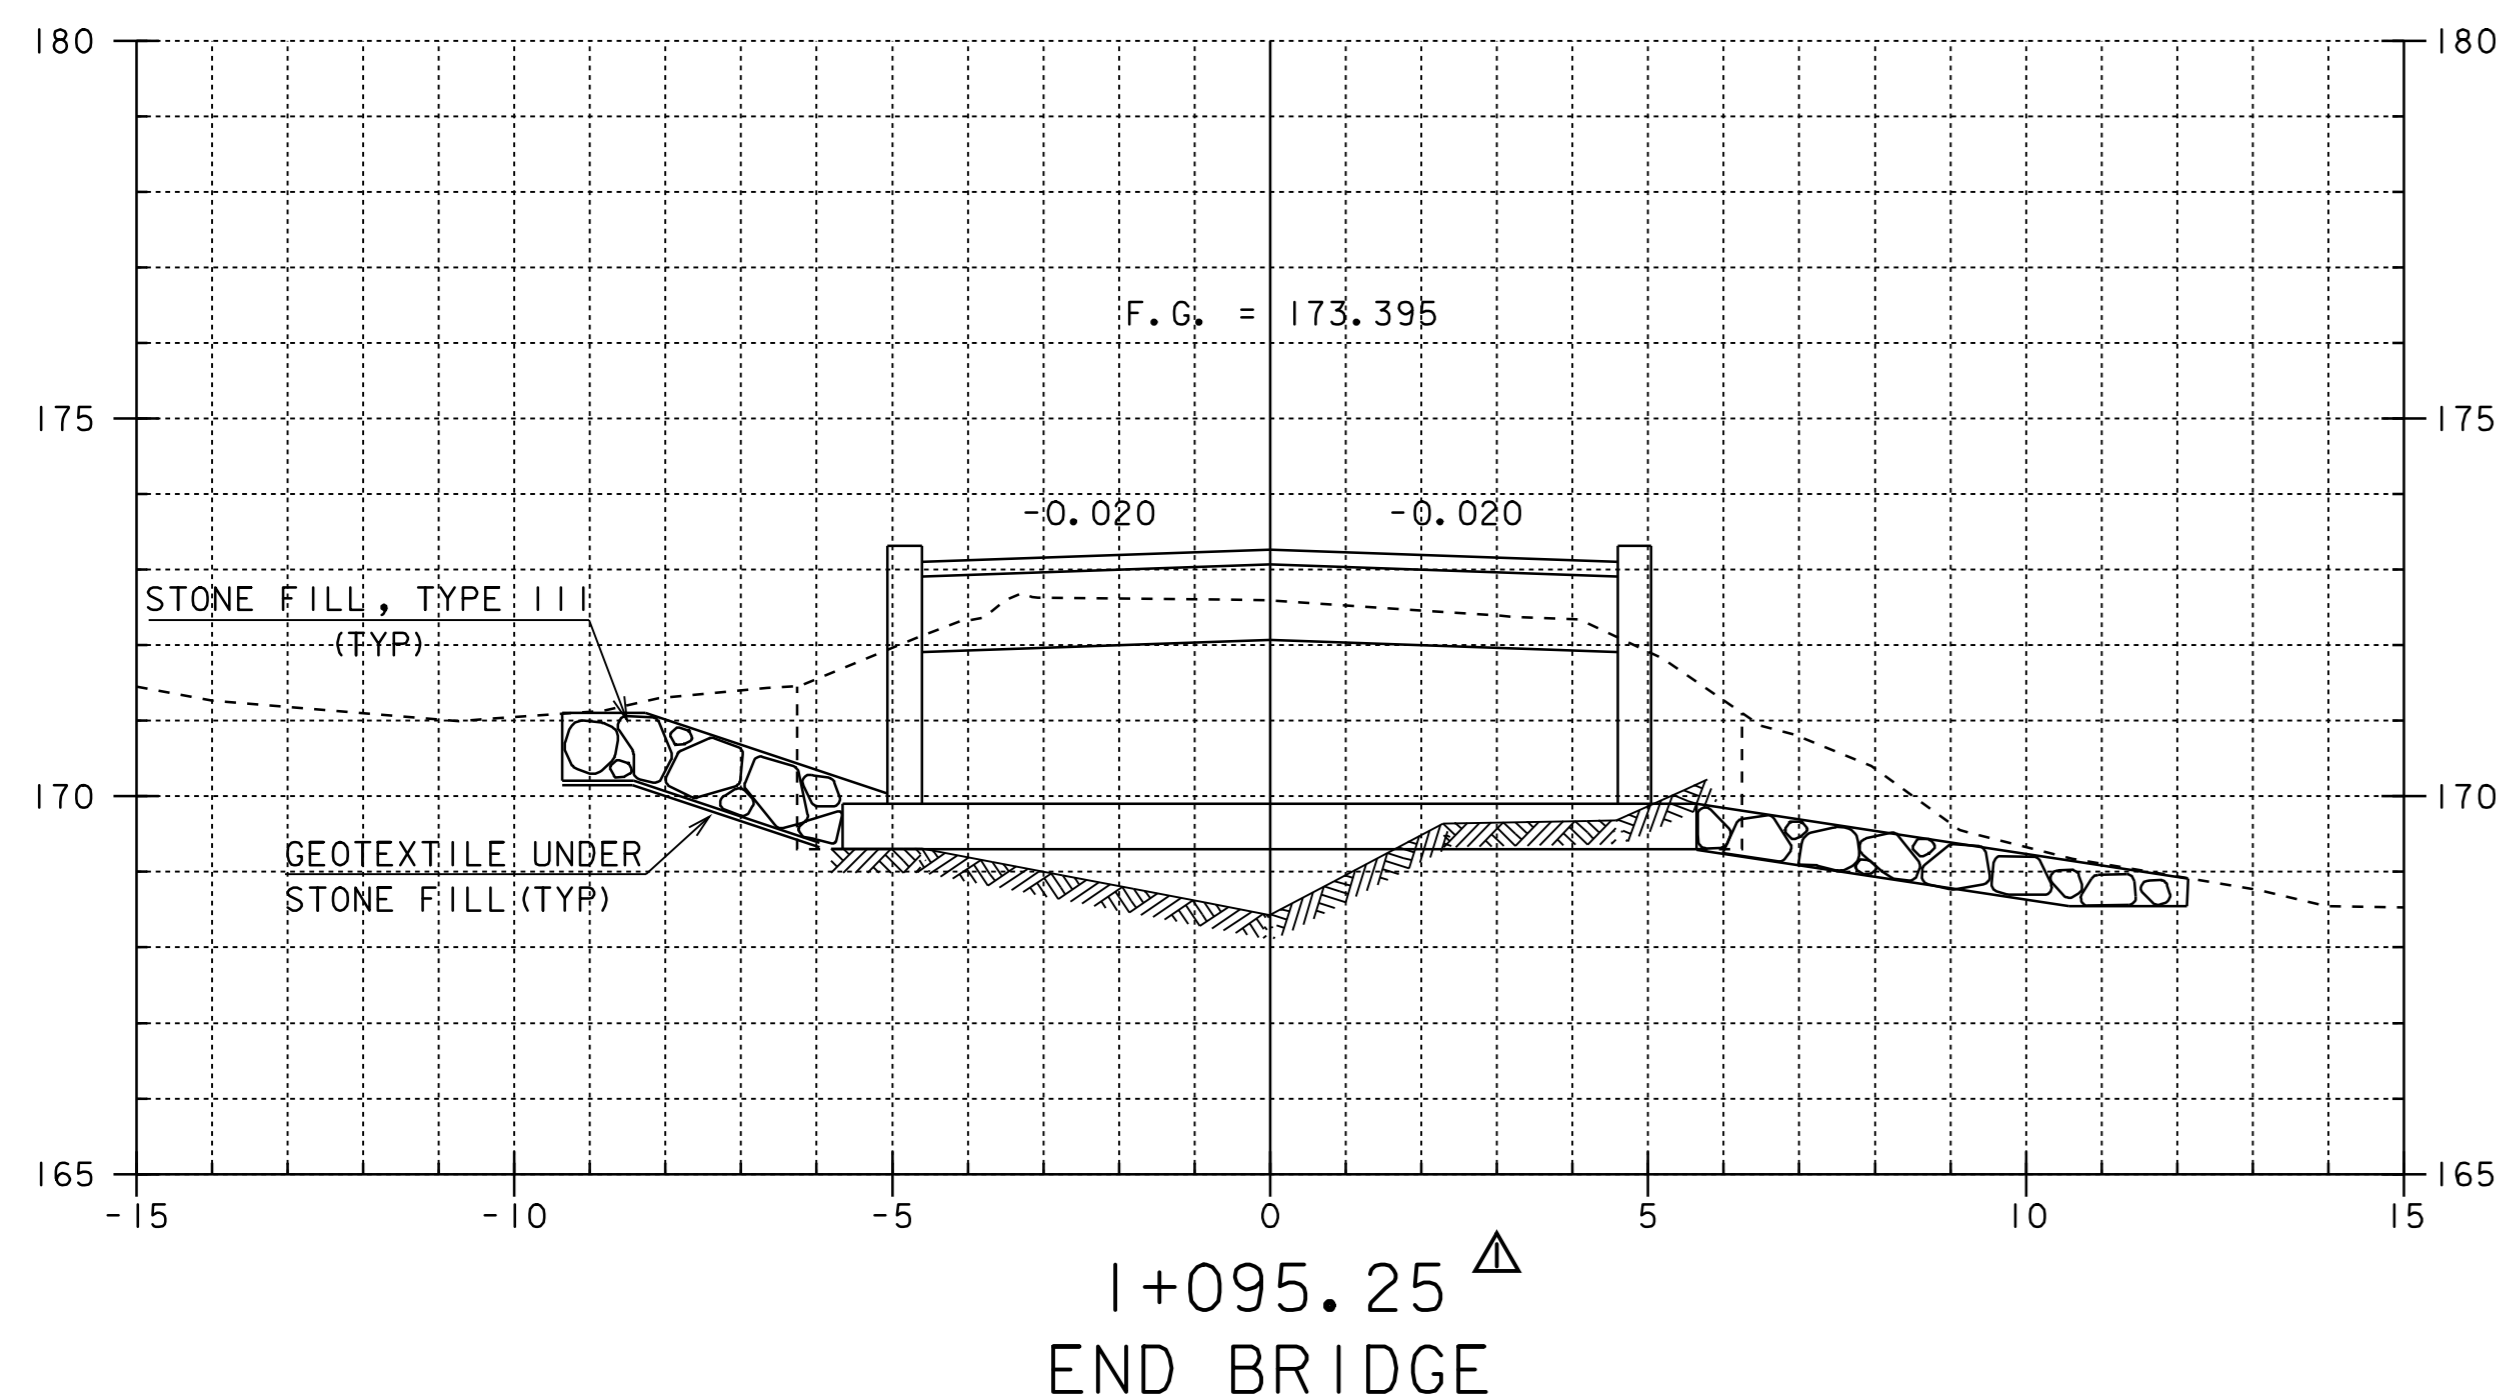
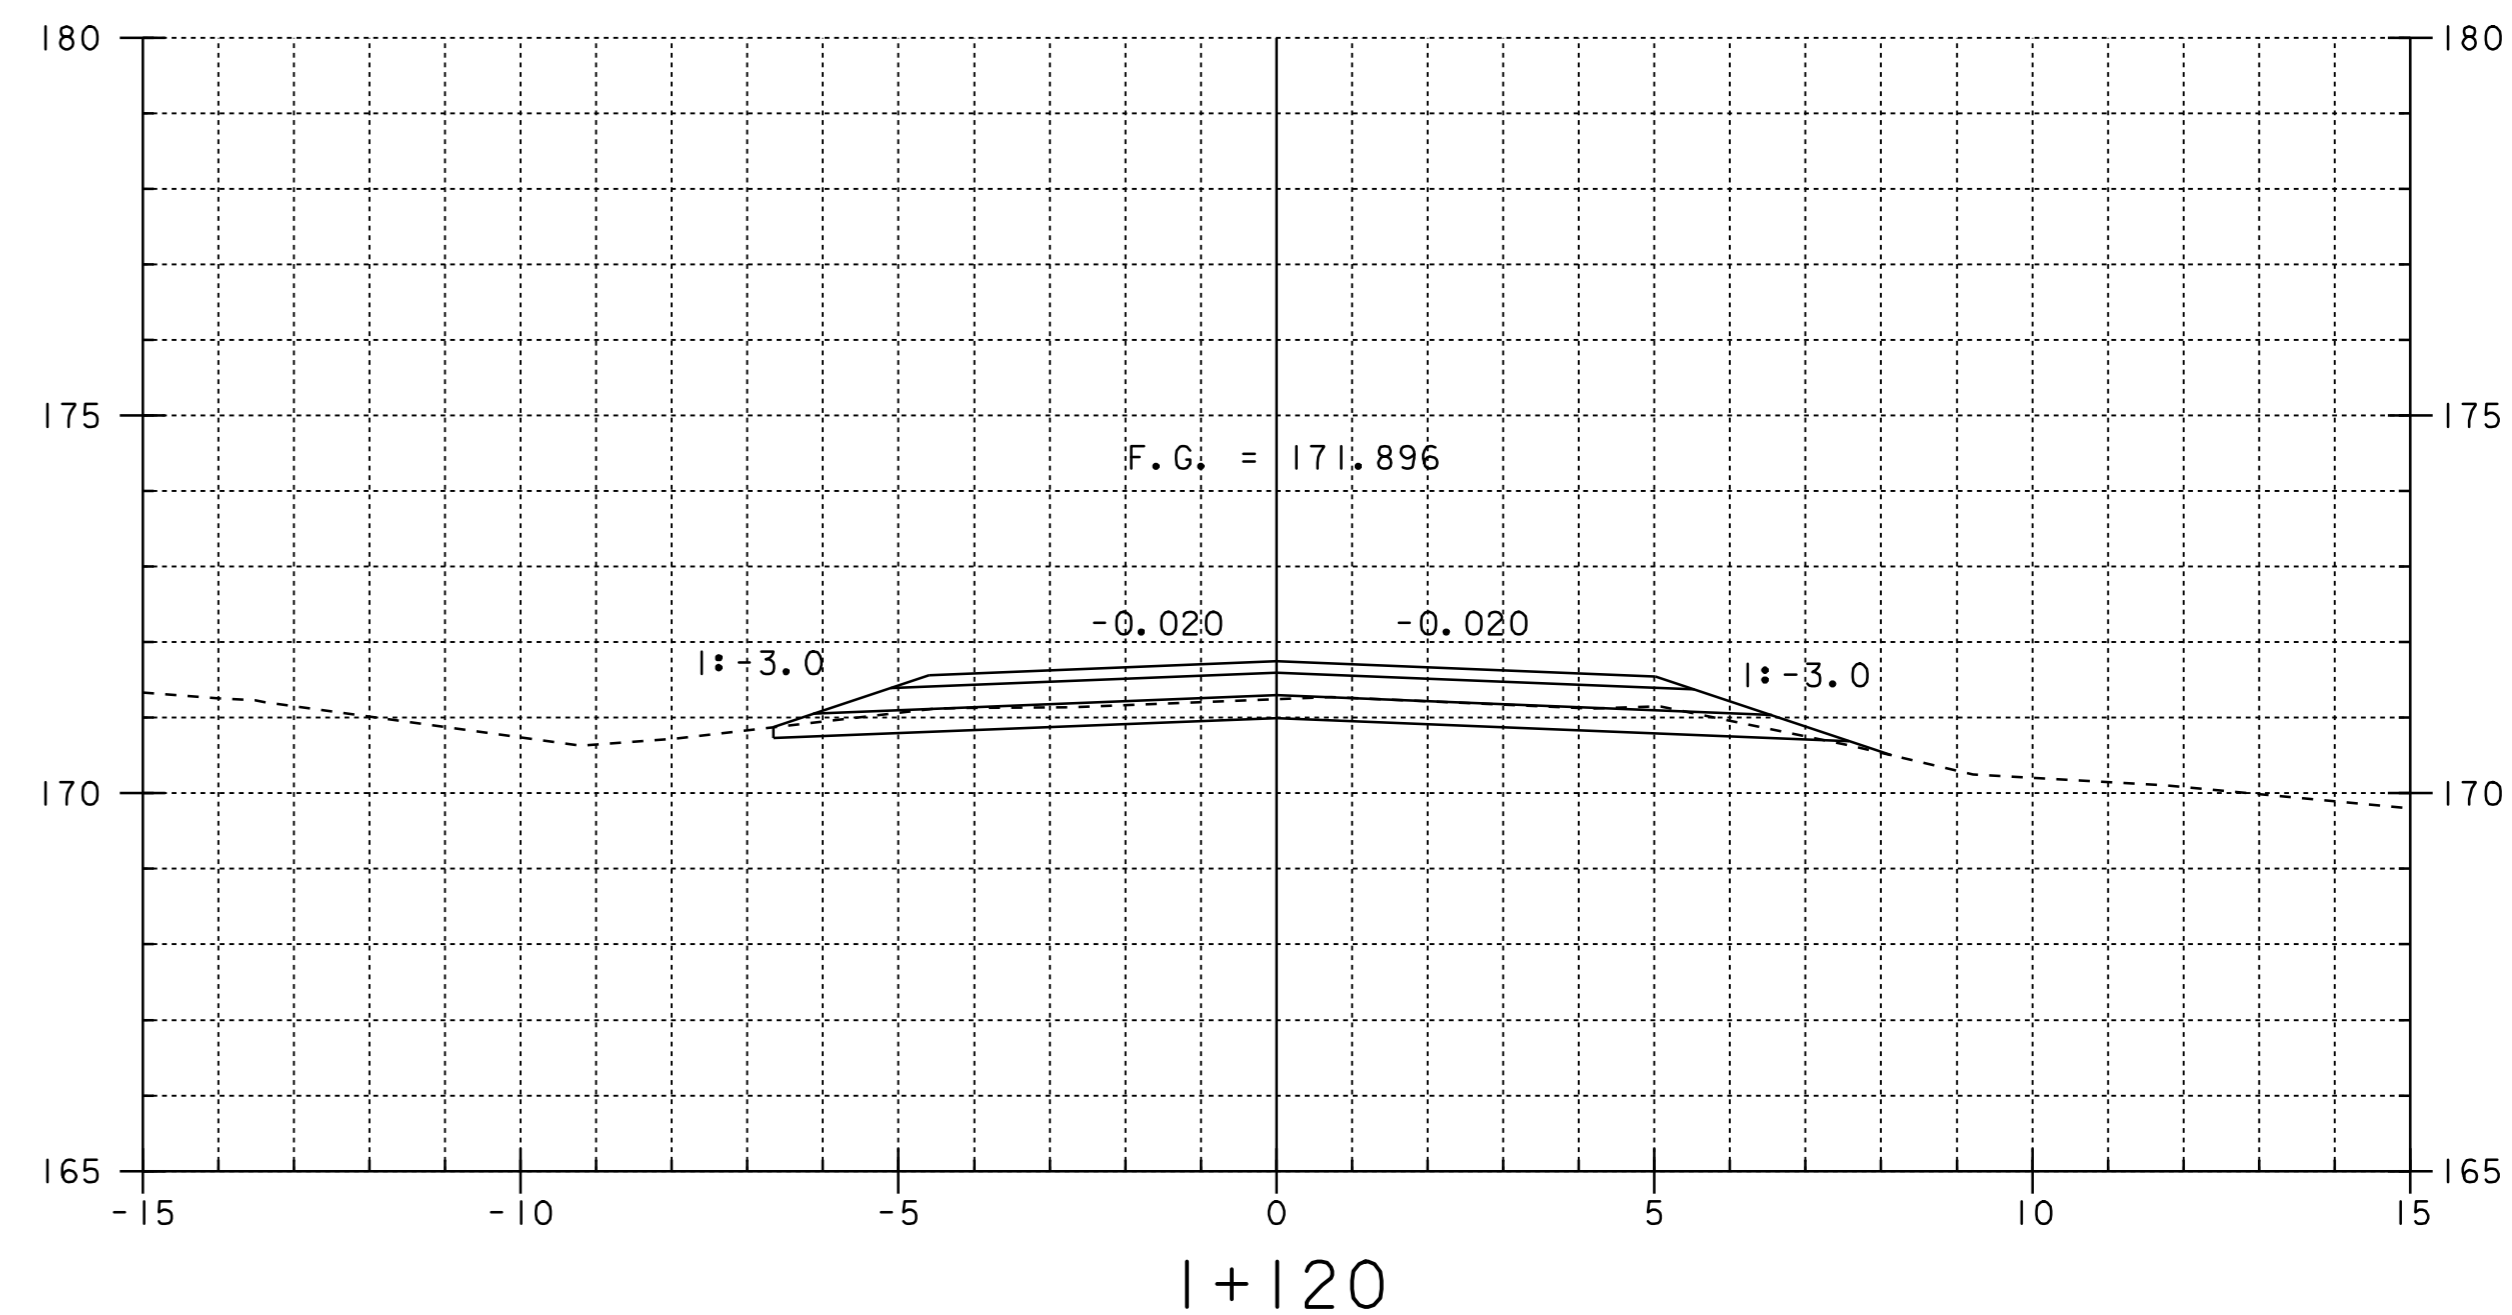
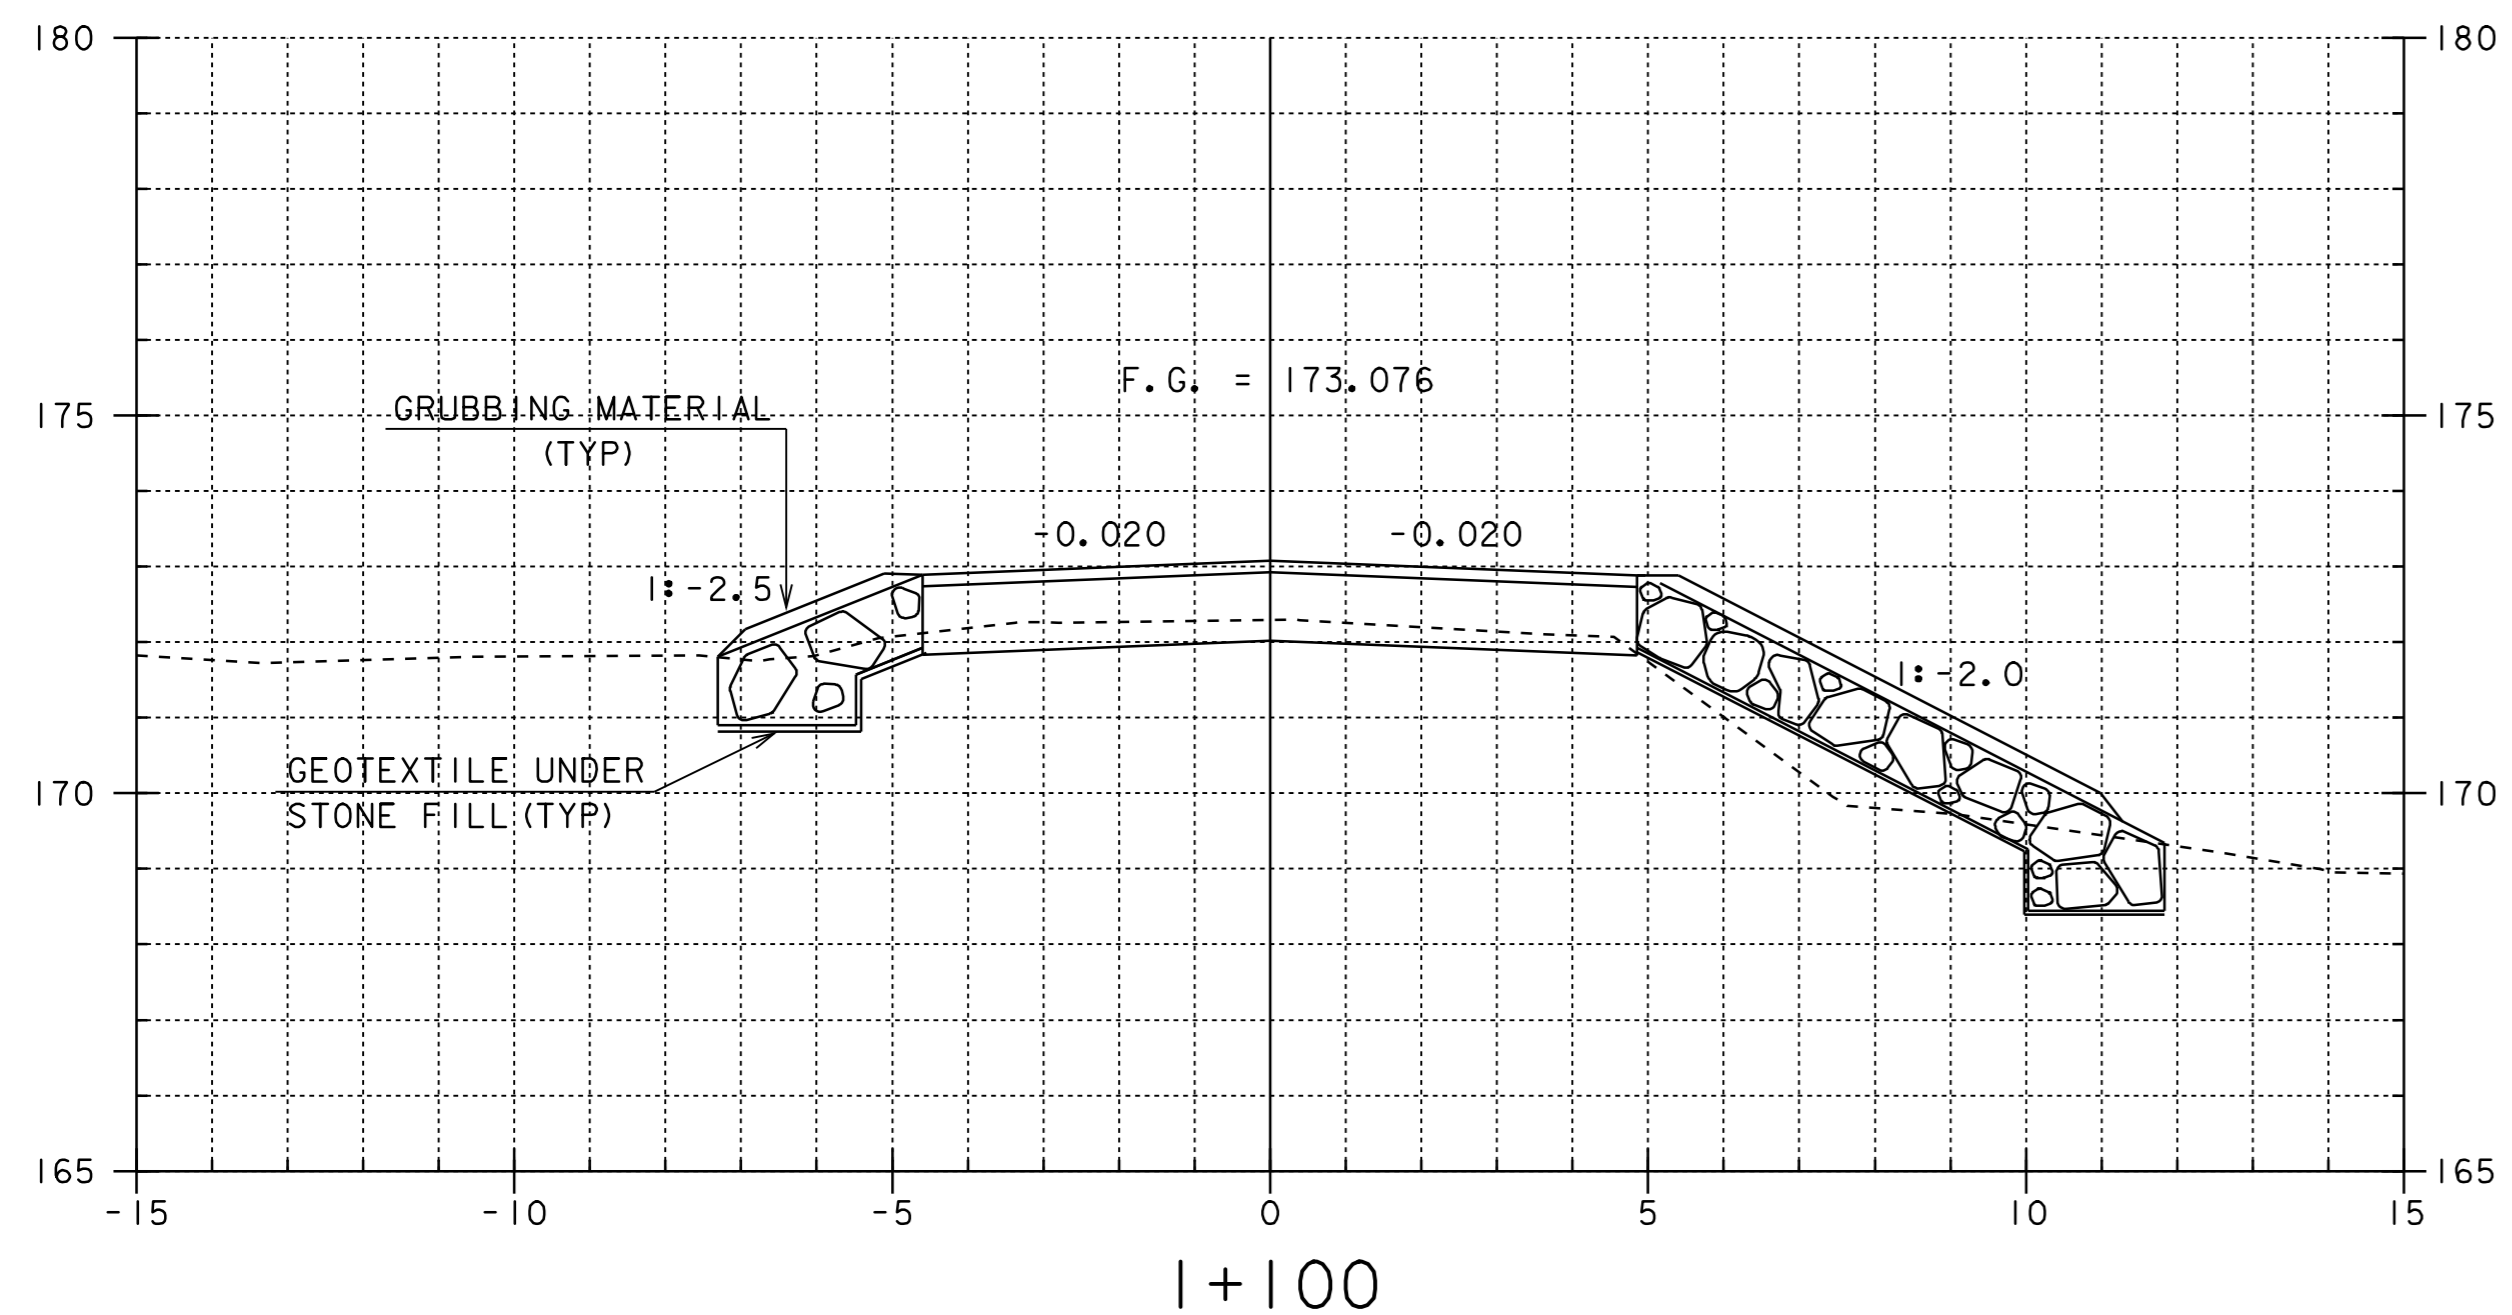


SHEET NAME: MAINLINE CROSS SECTIONS

PROJECT NAME: WESTFORD HIGHWAY NO.: IH 4
 PROJECT NUMBER: IH2_9436 BRIDGE NO.: 2
 OVER: ROGERS BROOK

FILE NAME: ZPW\941\22\sj122xs2.dgn PLOT DATE: 22-DEC-2006
 PROJECT MANAGER: B.B. WHITCOMB DRAWN BY: SIRI
 DESIGNED BY: C. CARLSON IPARM NAME: sj122mx4.1
 BRIDGE SHEET NUMBER: --- SHEET 47 OF 56



REVISION	DATE	BY	CHK'D	DESCRIPTION
△	06/27/2005	GFR	CWC	ABUTMENTS MODIFIED DUE TO UPDATED LEDGE INFORMATION.

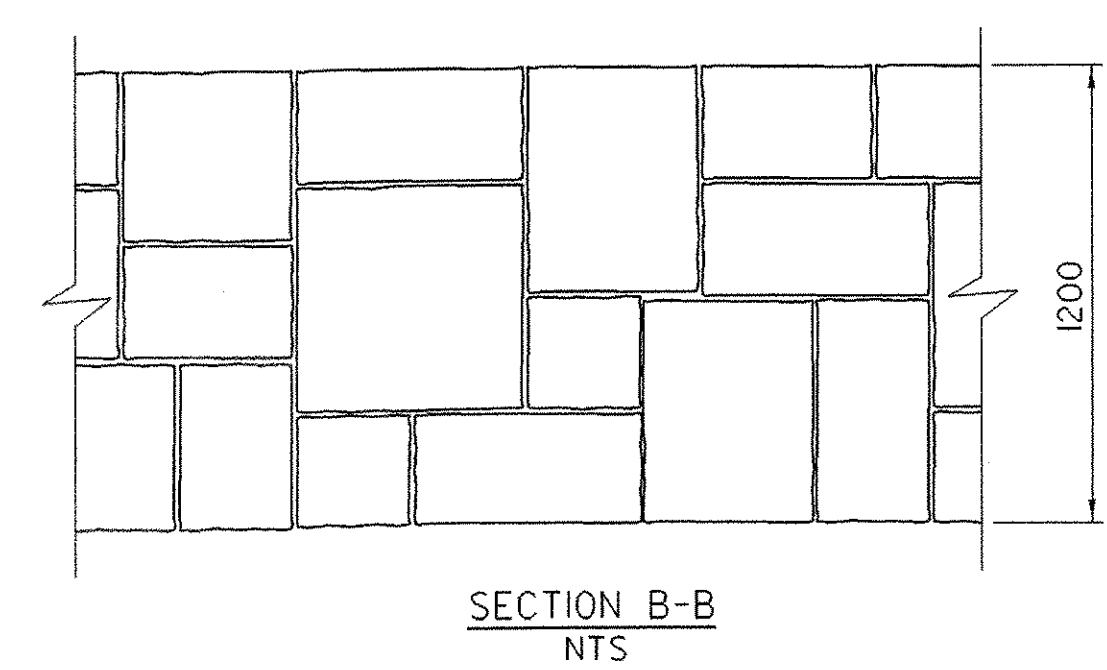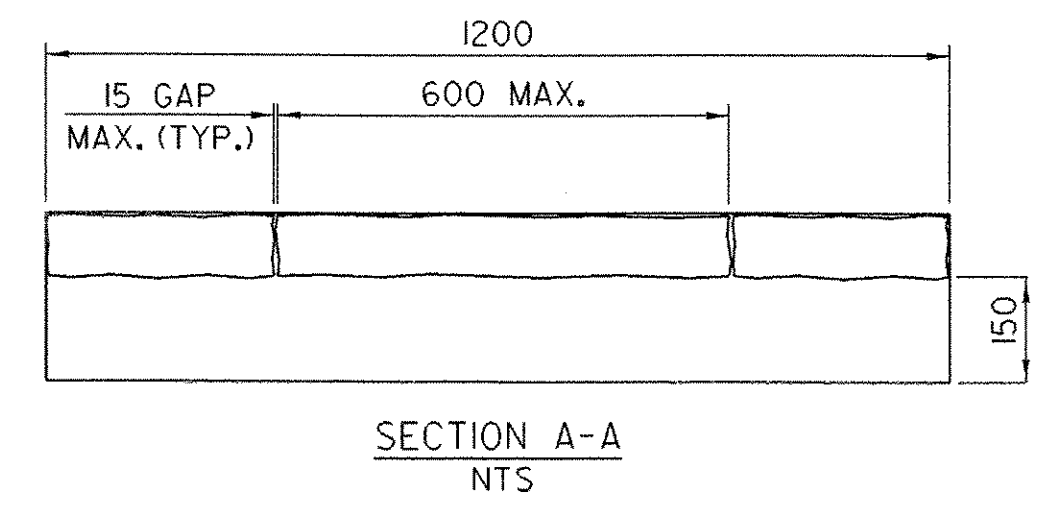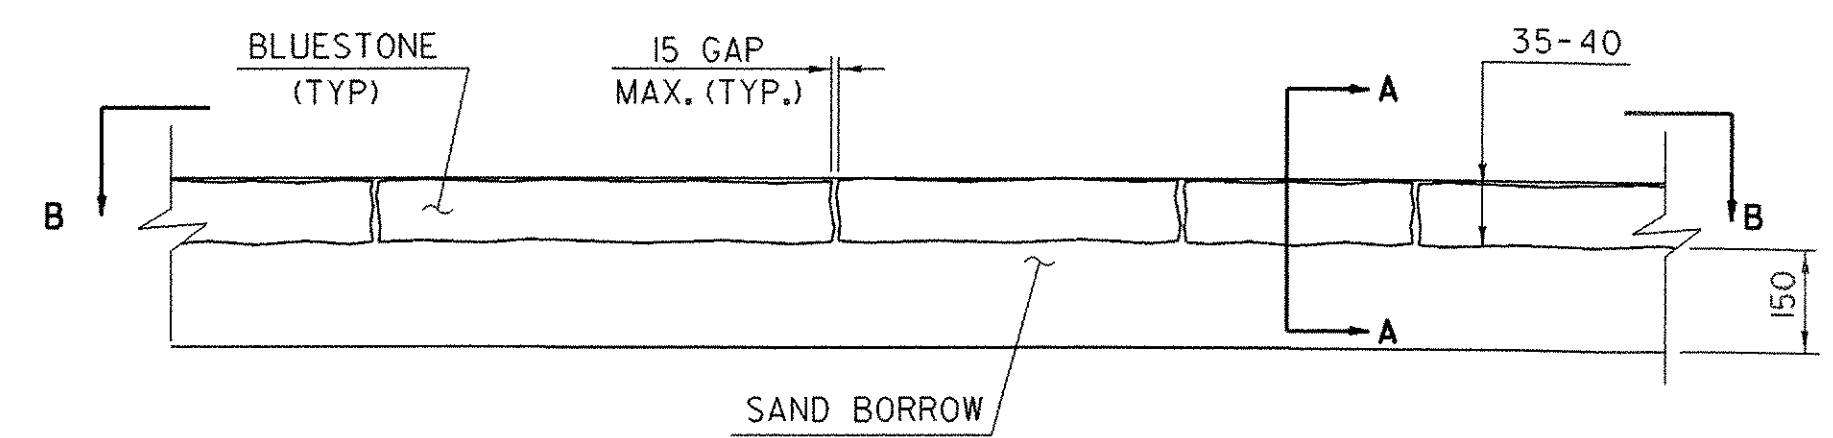


GAPS BETWEEN BLUESTONES TO BE FILLED IN WITH STONE DUST FILLER.

SPECIAL WALKWAY @ STA. I+129.6 RT. DETAIL
NTS


LABOR AND MATERIALS FOR SPECIAL WALKWAY SHALL BE PAID FOR UNDER ITEM 618.10, "PORTLAND CEMENT SIDEWALK, 125 mm (MOD.)"

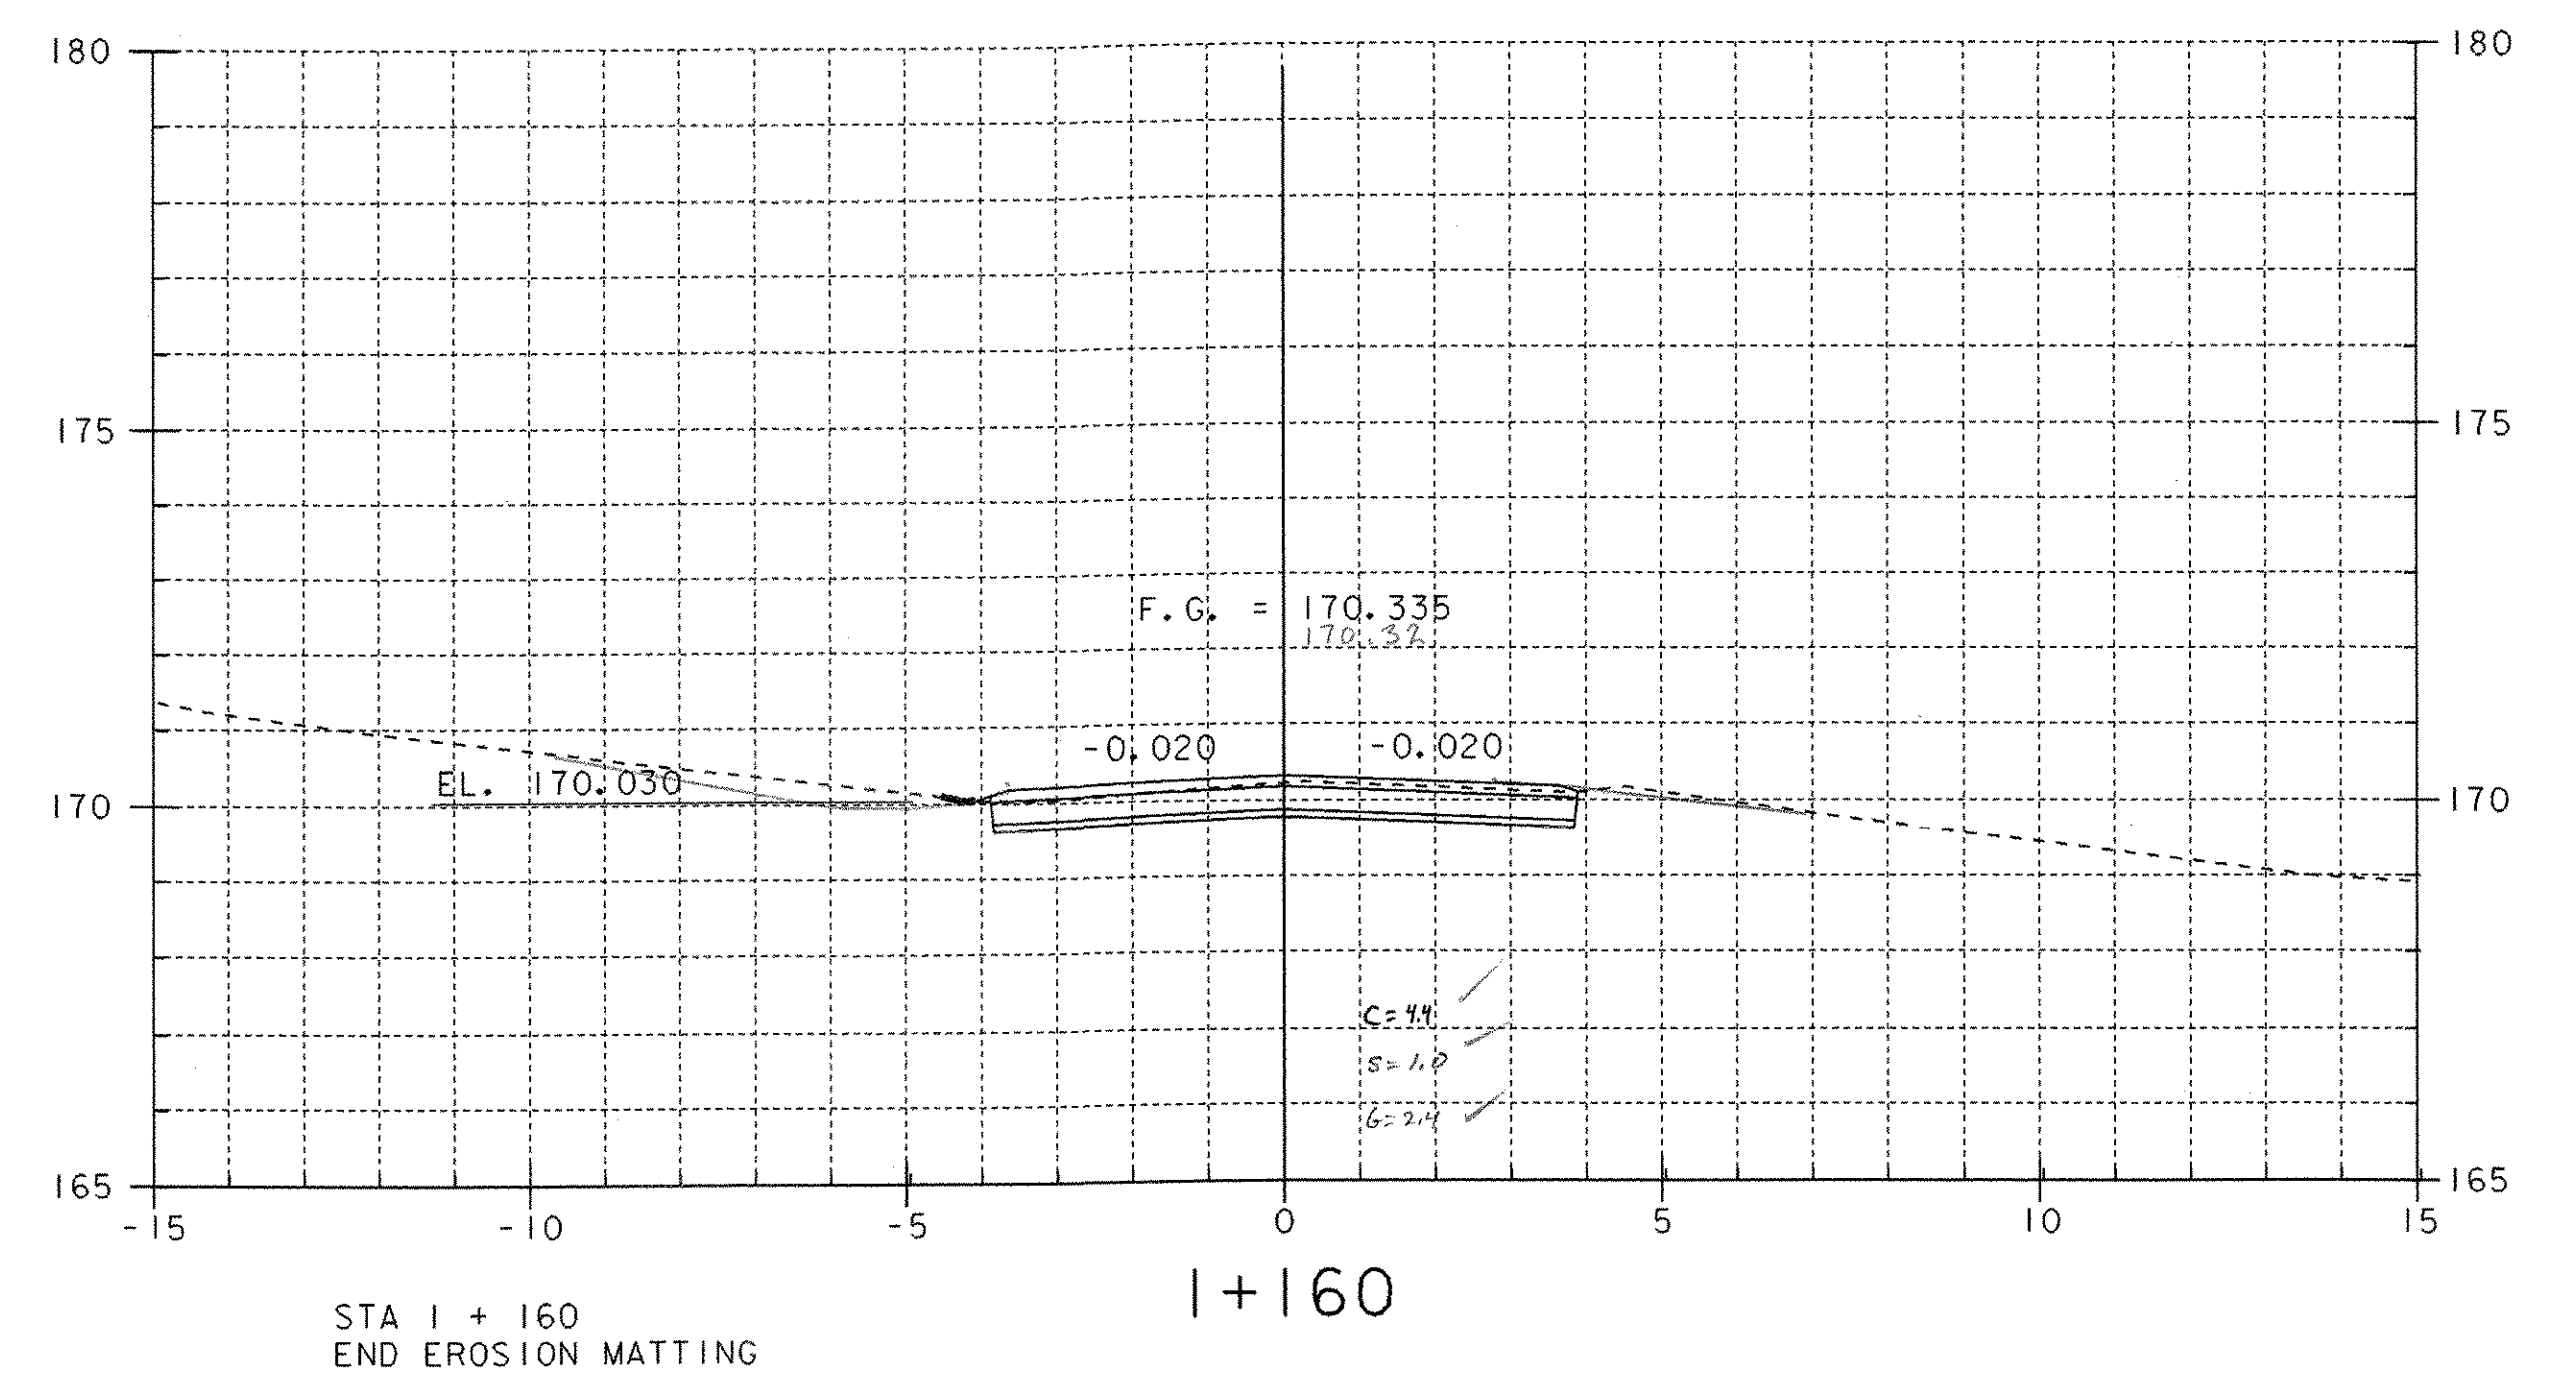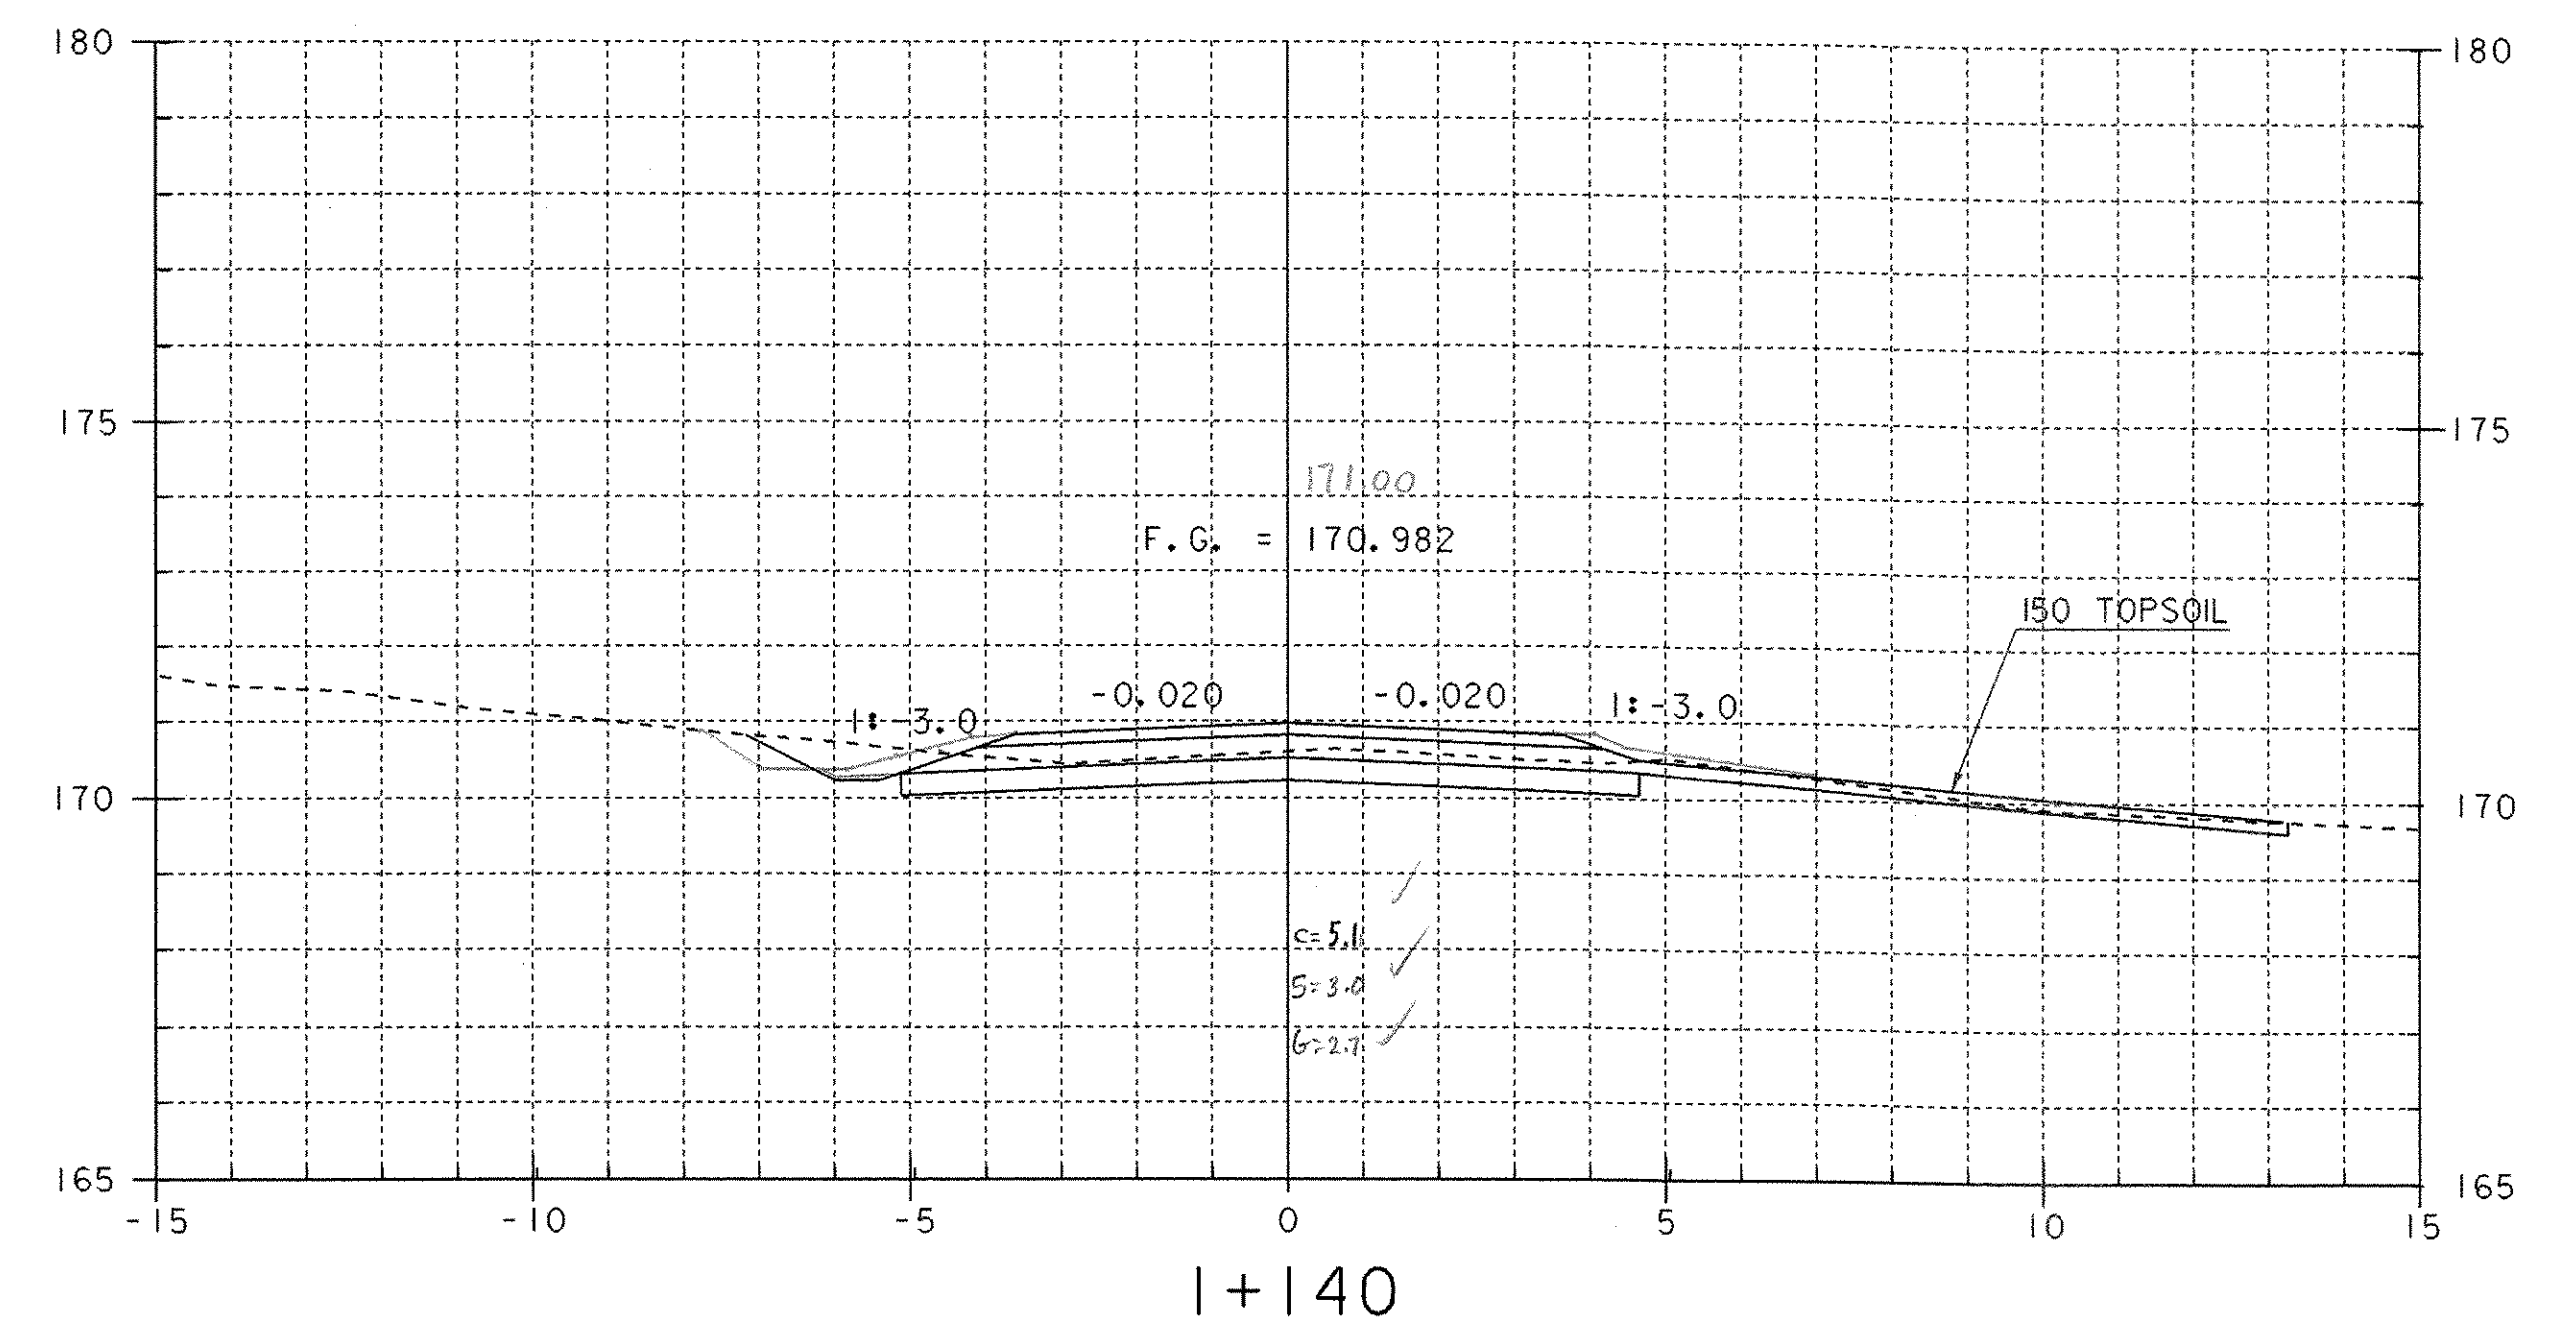

STA I + 133.0 LT & STA I + 134.0 RT
CONSTRUCT DRIVES
SEE SHEET 32 & 33 FOR MORE INFORMATION

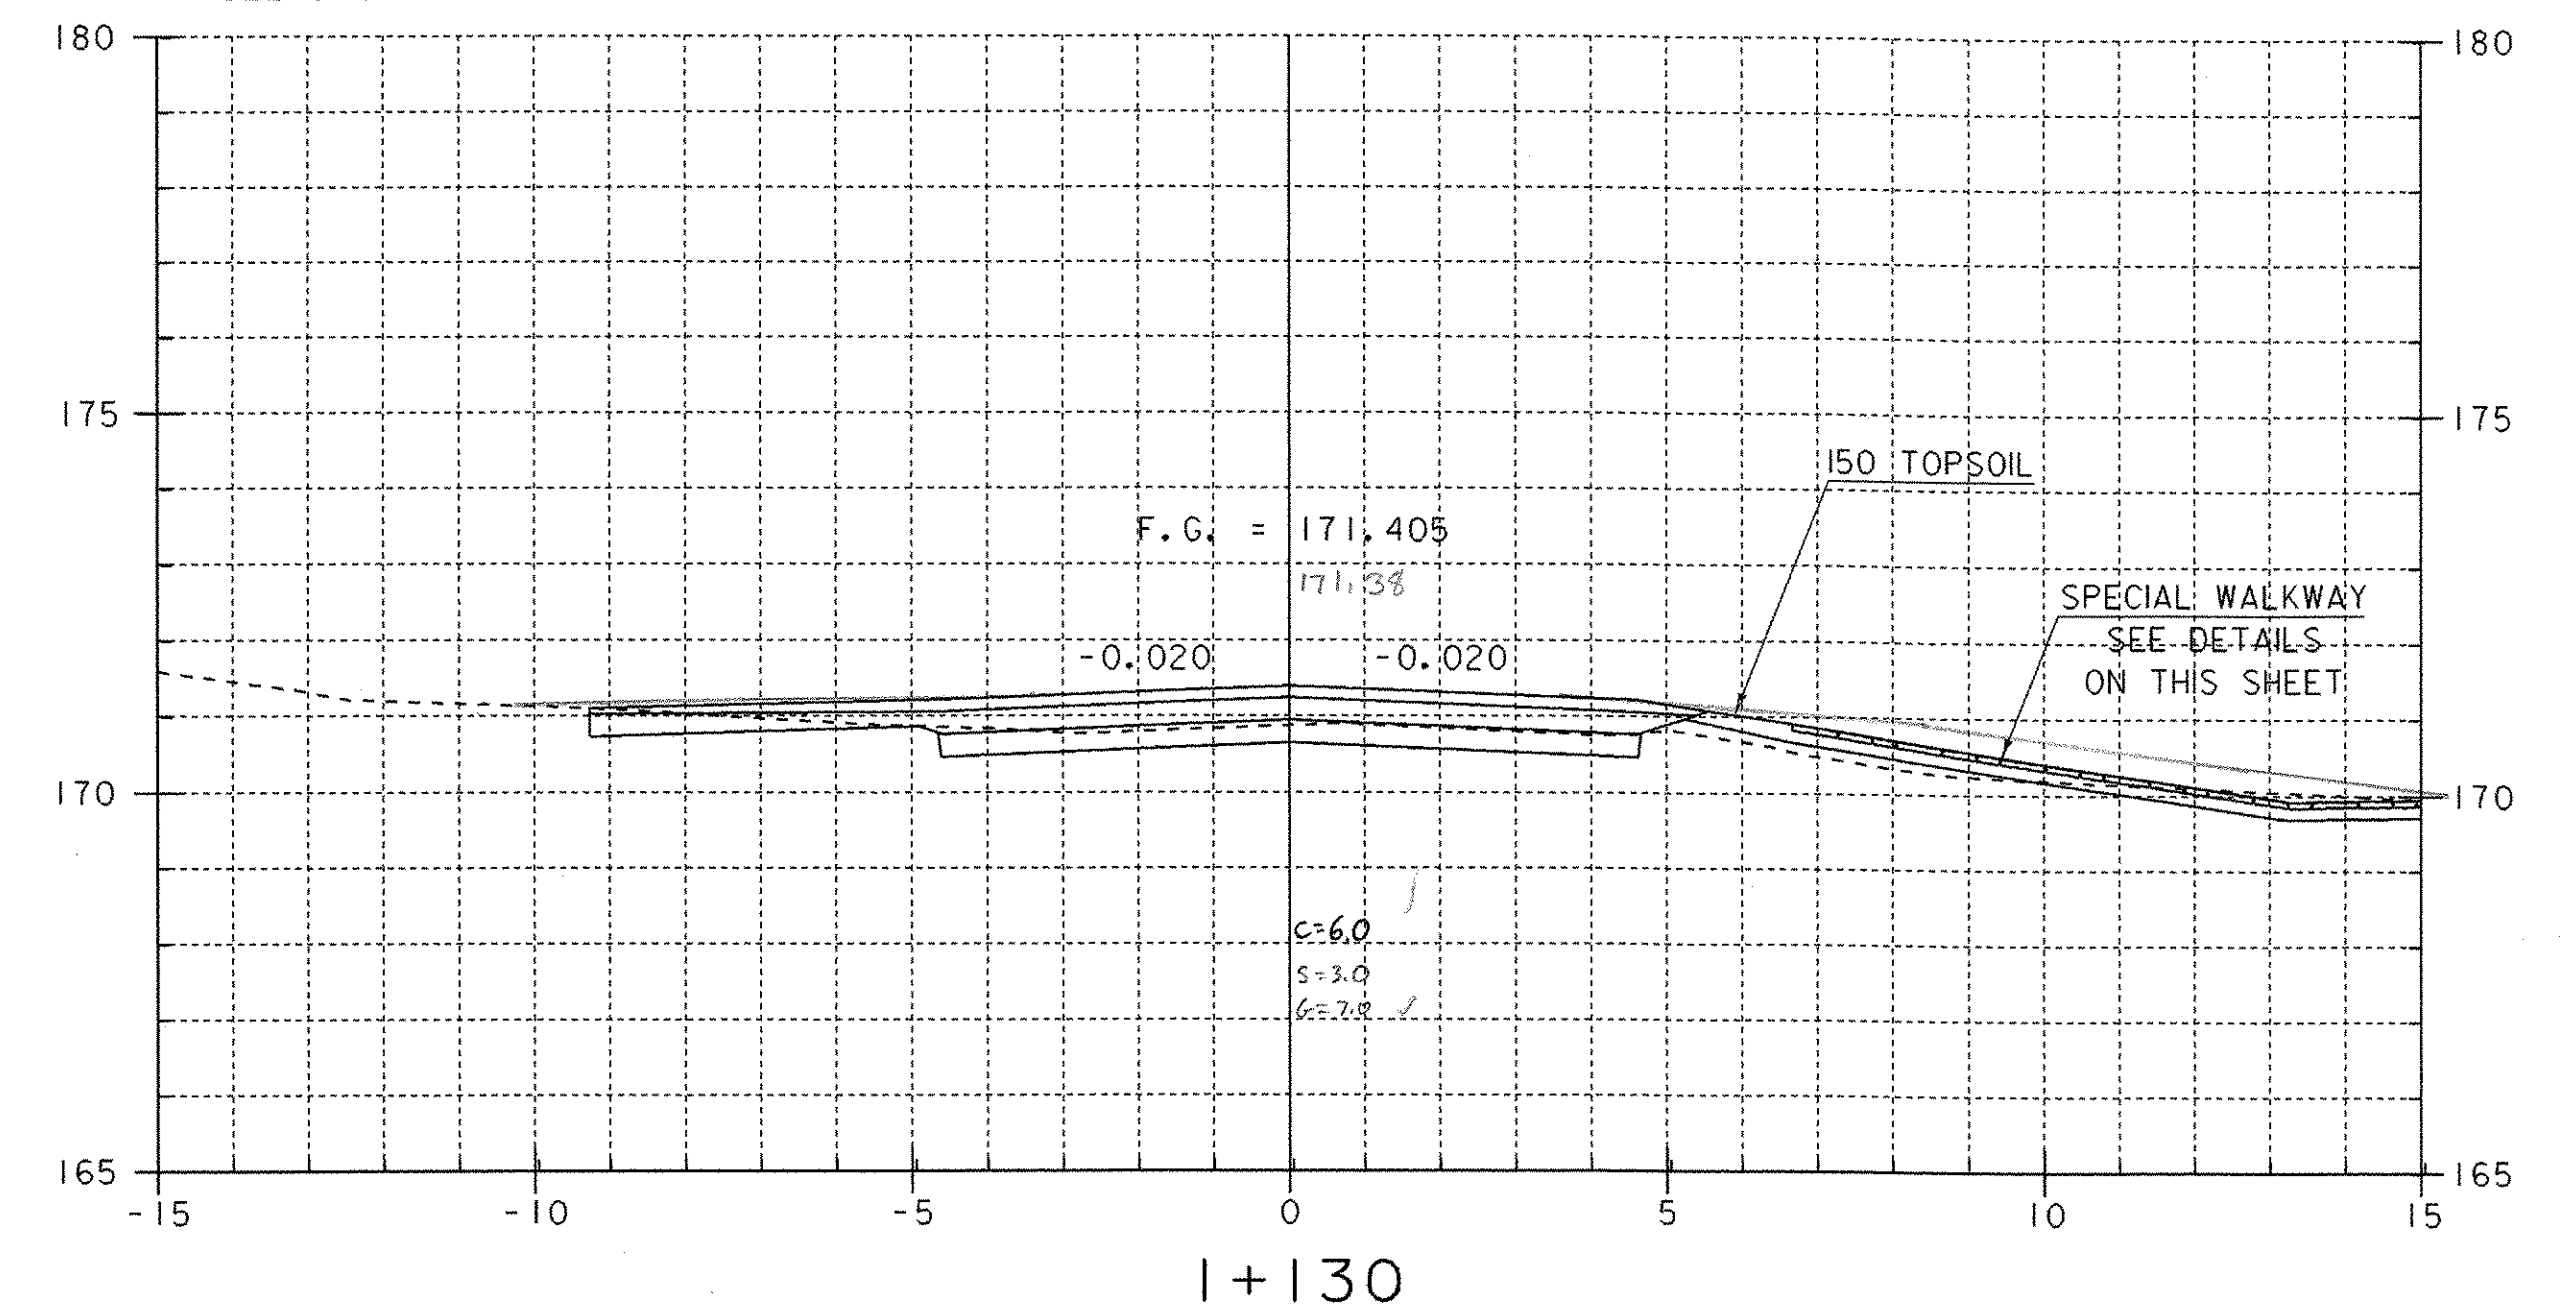


STA I + 129.600 RT
CONSTRUCT SPECIAL WALKWAY

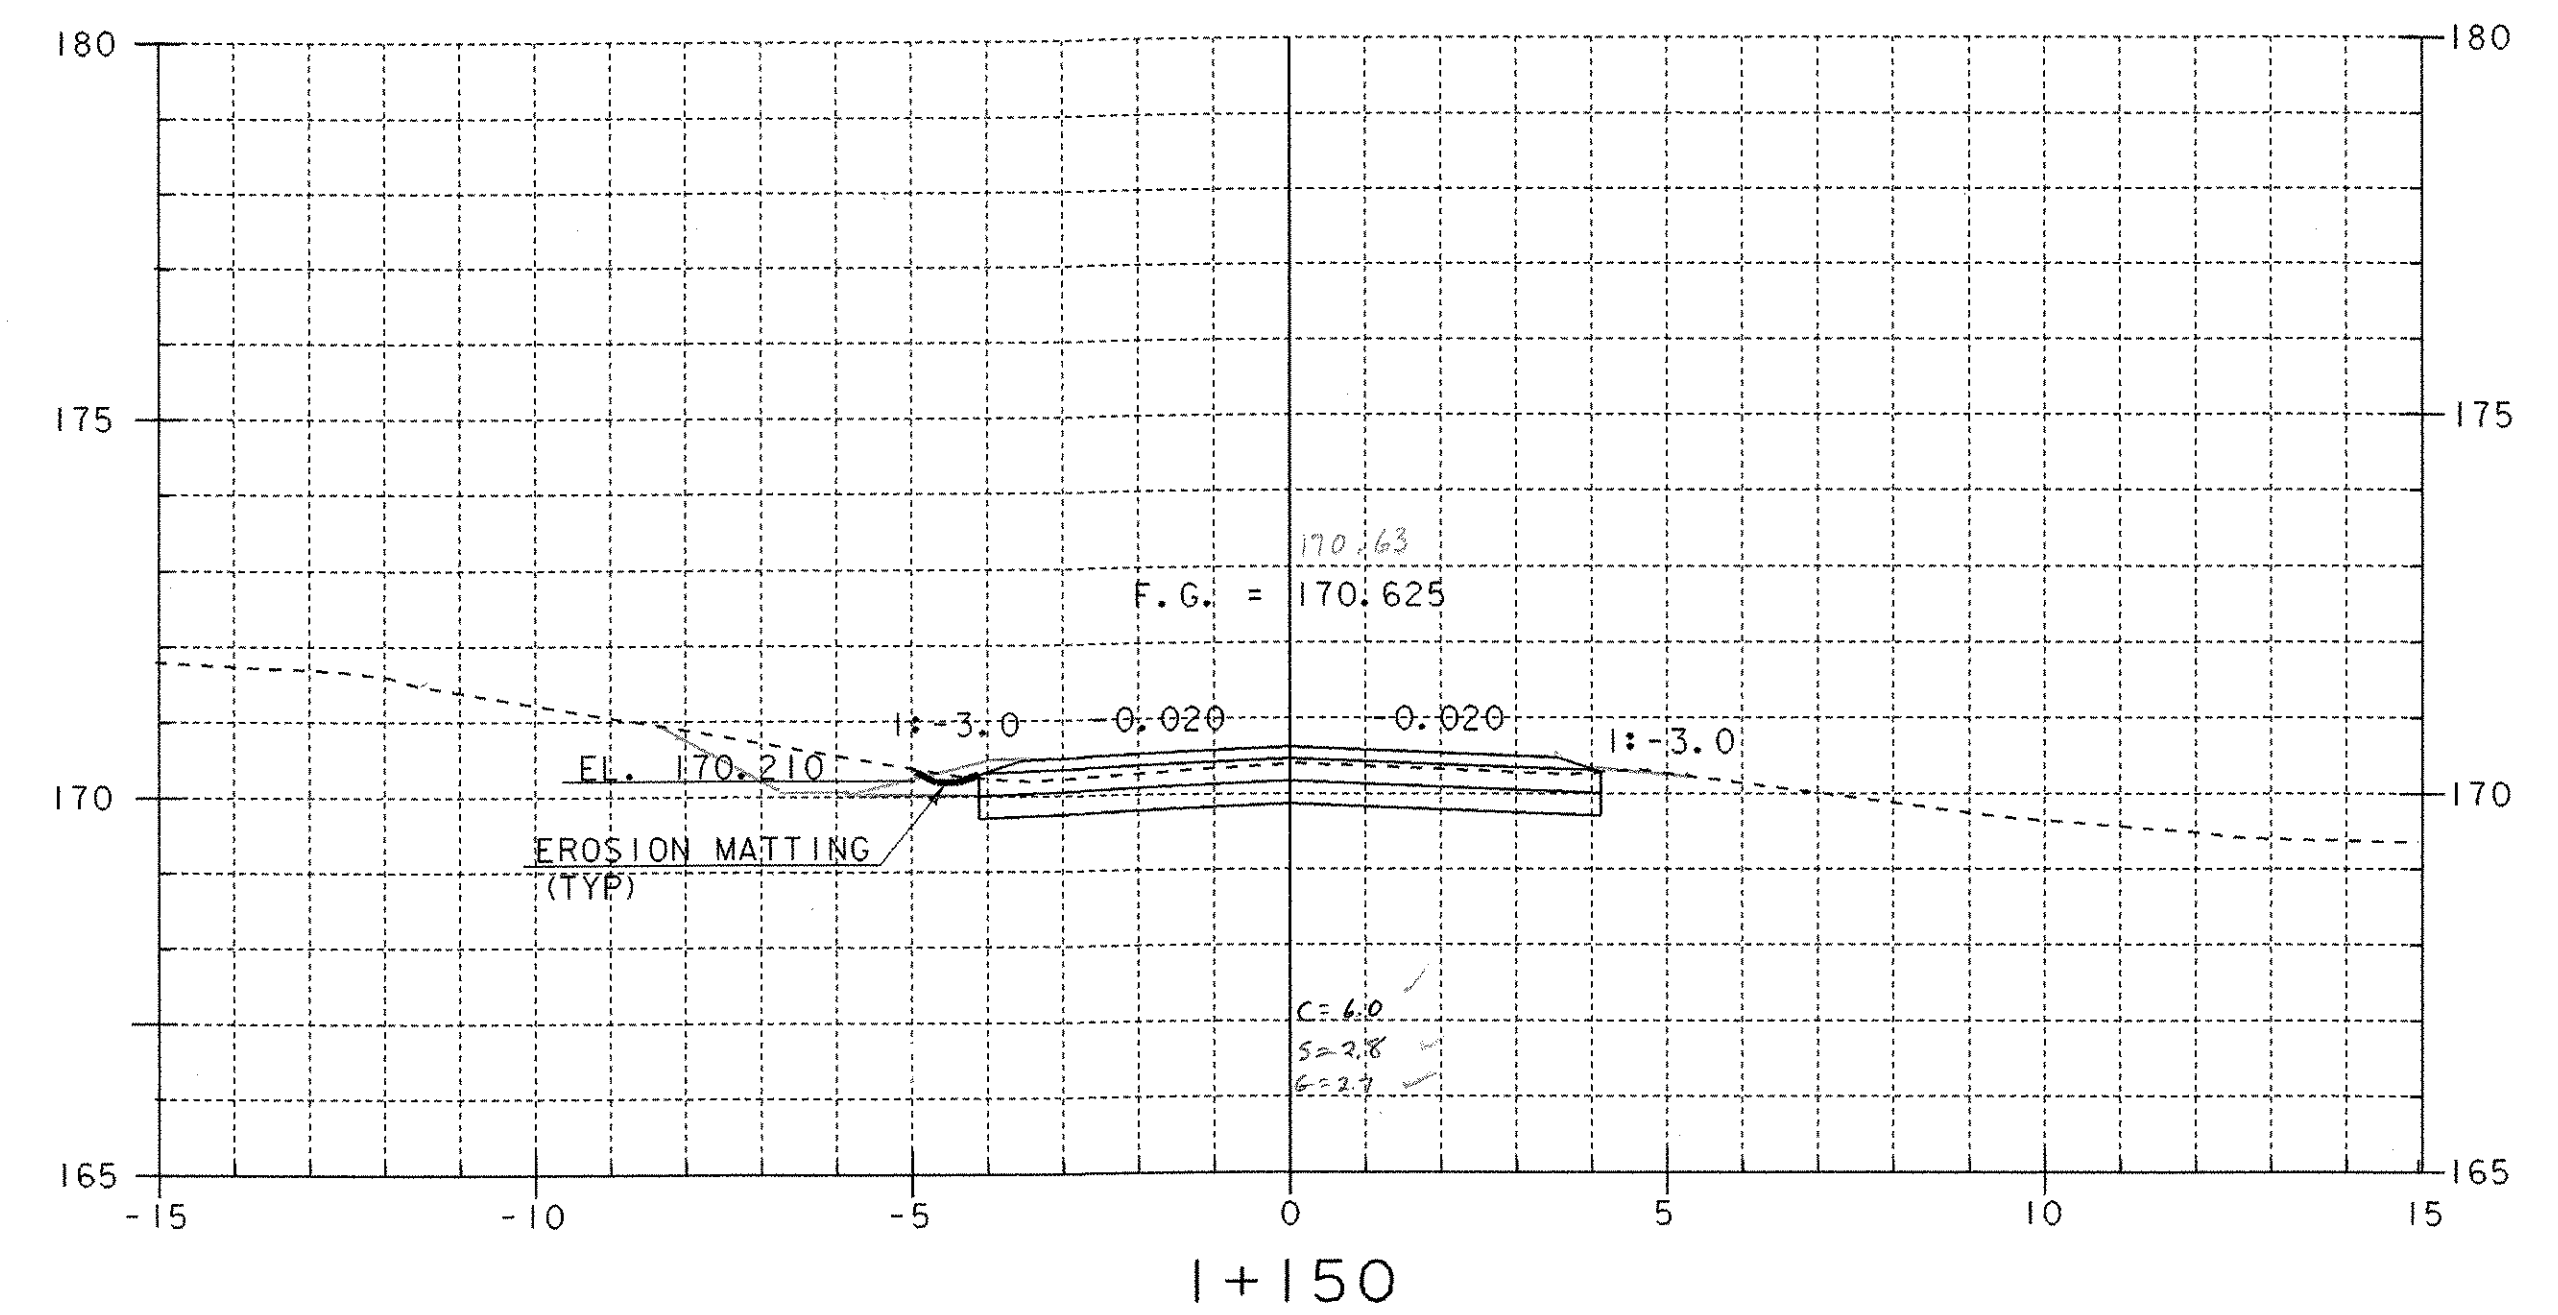





END PROJECT/BEGIN APPROACH

STA I + 140.75
BEGIN EROSION MATTING


SHEET NAME: MAINLINE CROSS SECTIONS	
PROJECT NAME: WESTFORD	TH 4
PROJECT NUMBER: TH2 9436	2
	OVER: ROGERS BROOK
FILE NAME: /PW/941122/sj122xs2.dgn	PLOT DATE: 25-MAR-2005
PROJECT MANAGER: R. R. WHITCOMB	DRAWN BY: STRI
DESIGNED BY: C. CARLSON	IPARM NAME: sj122m5.1
BRIDGE SHEET NUMBER:	SHEET 48 OF 56

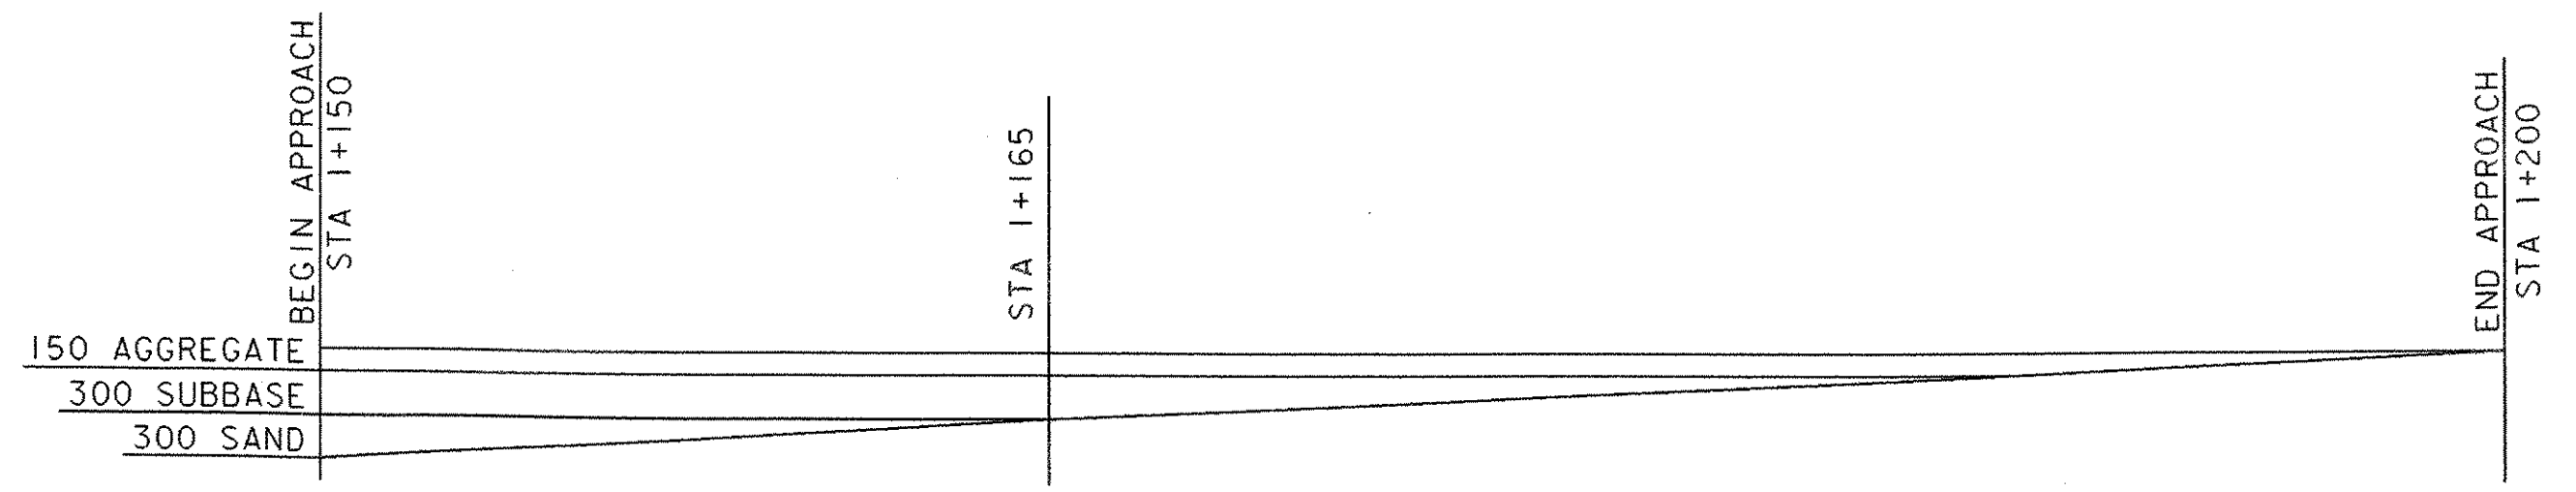


MATERIAL TRANSITION DETAIL
NTS

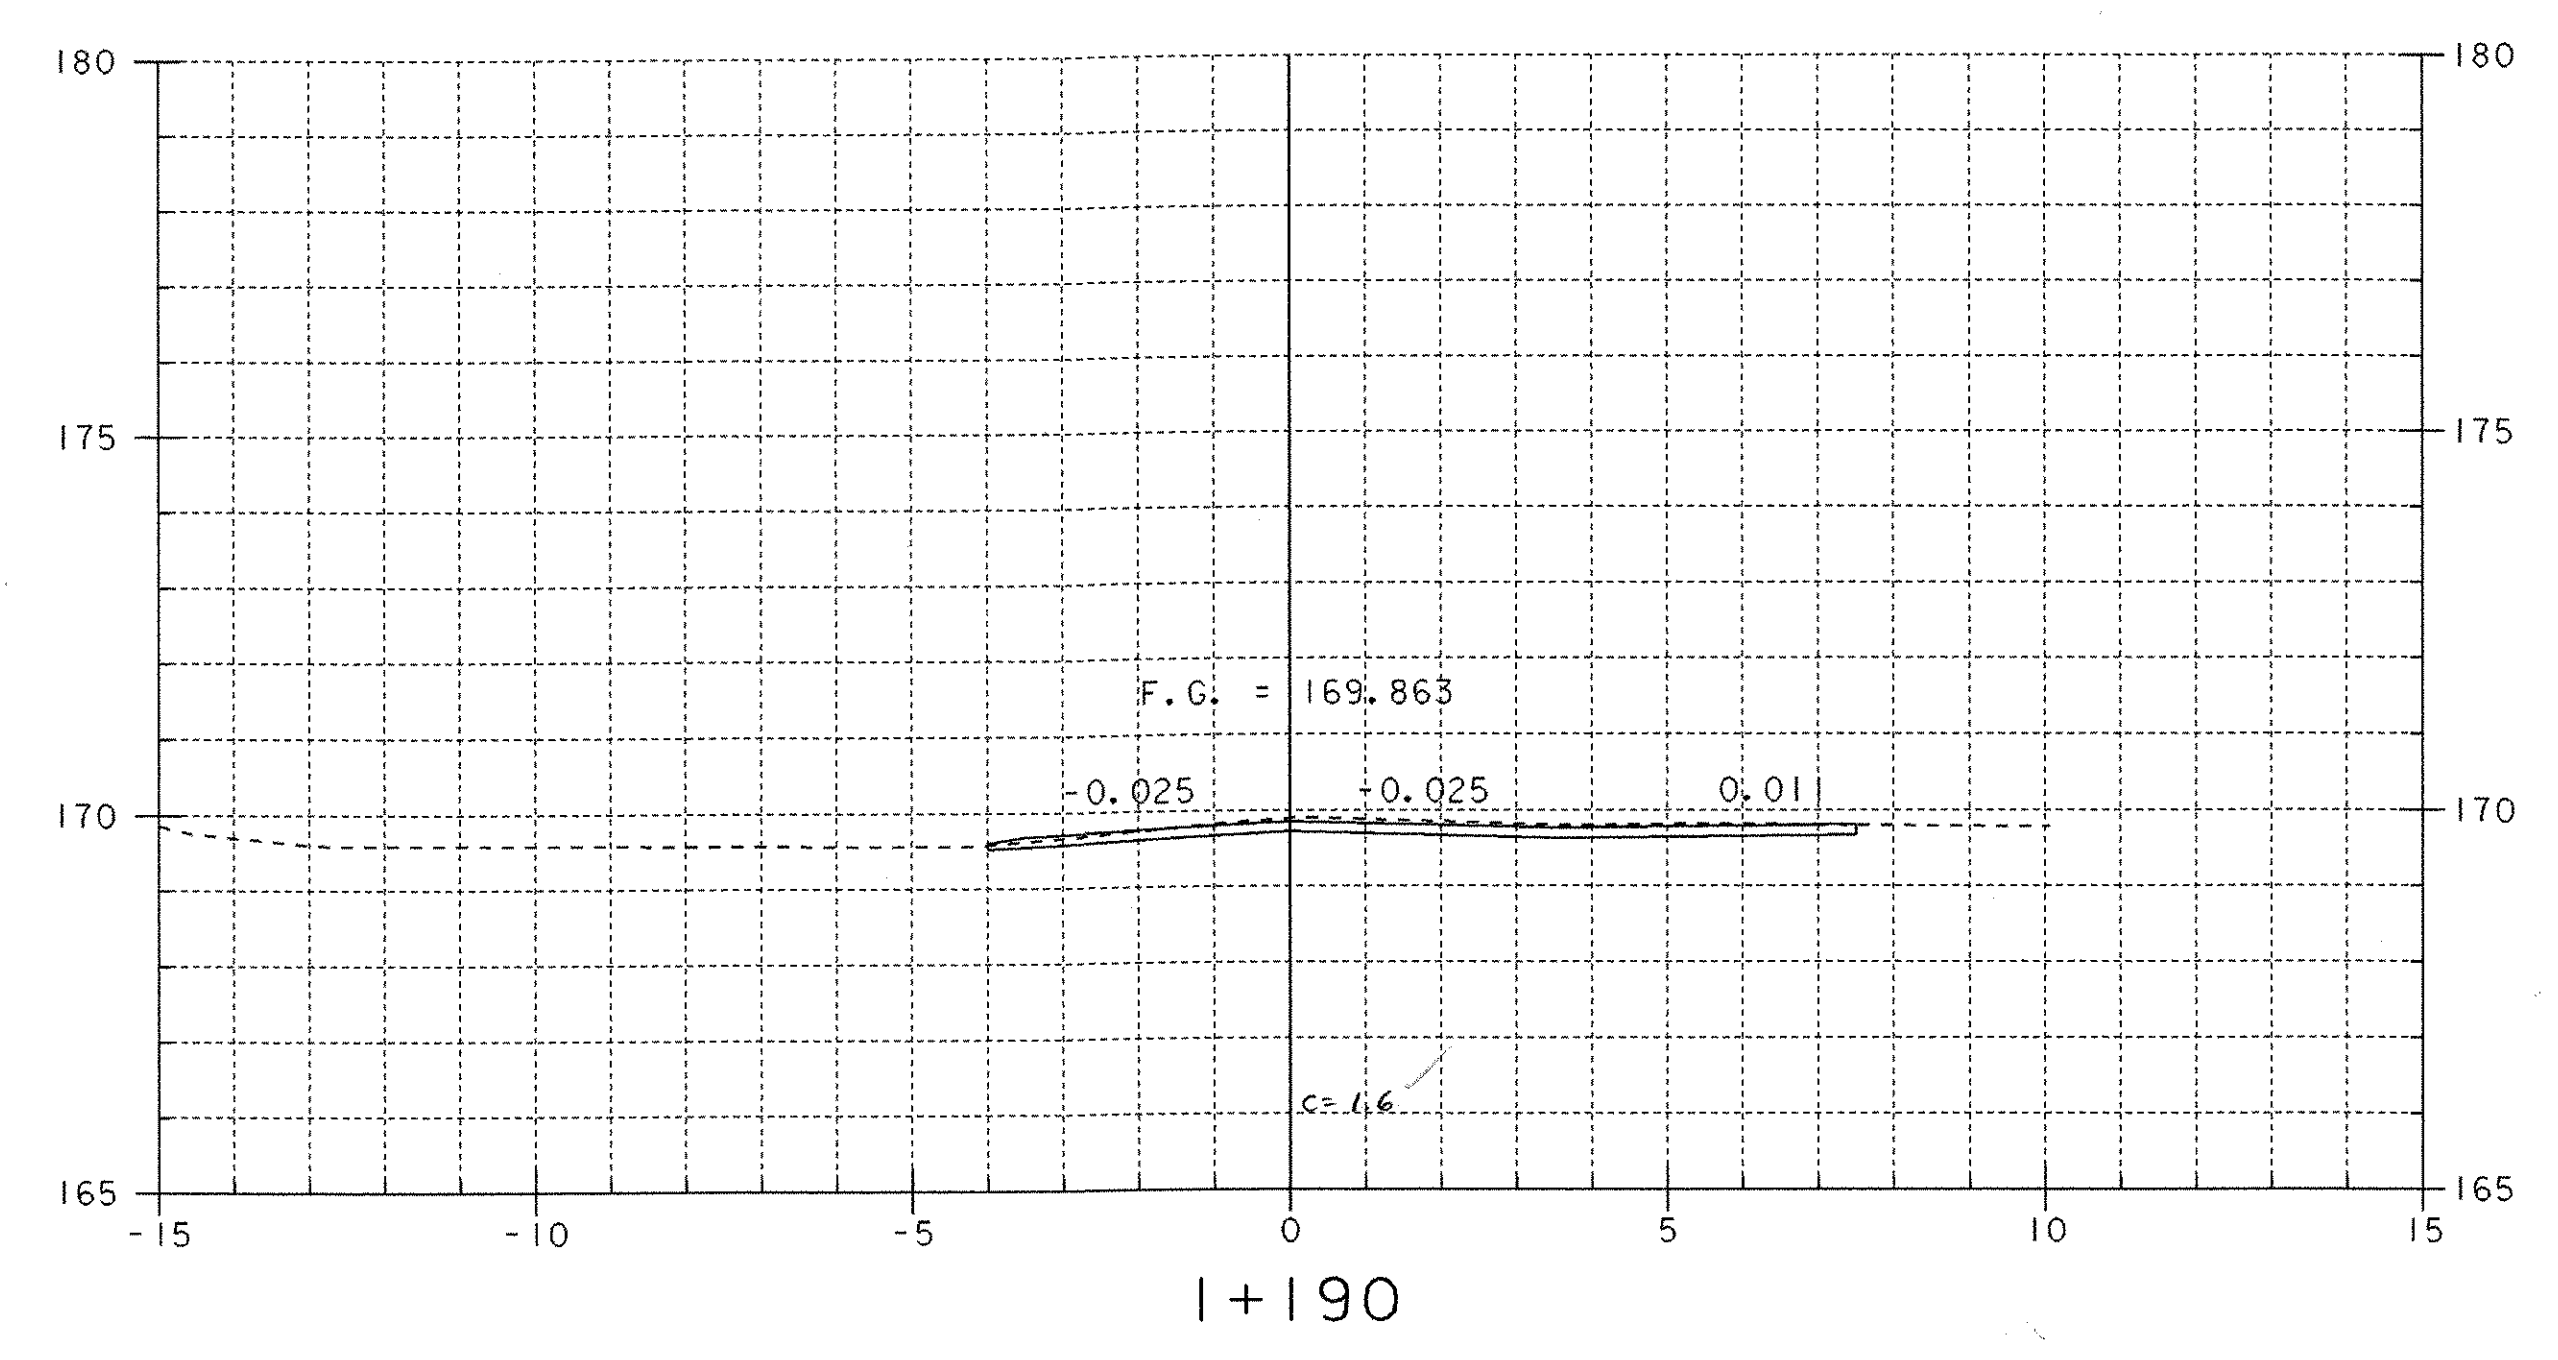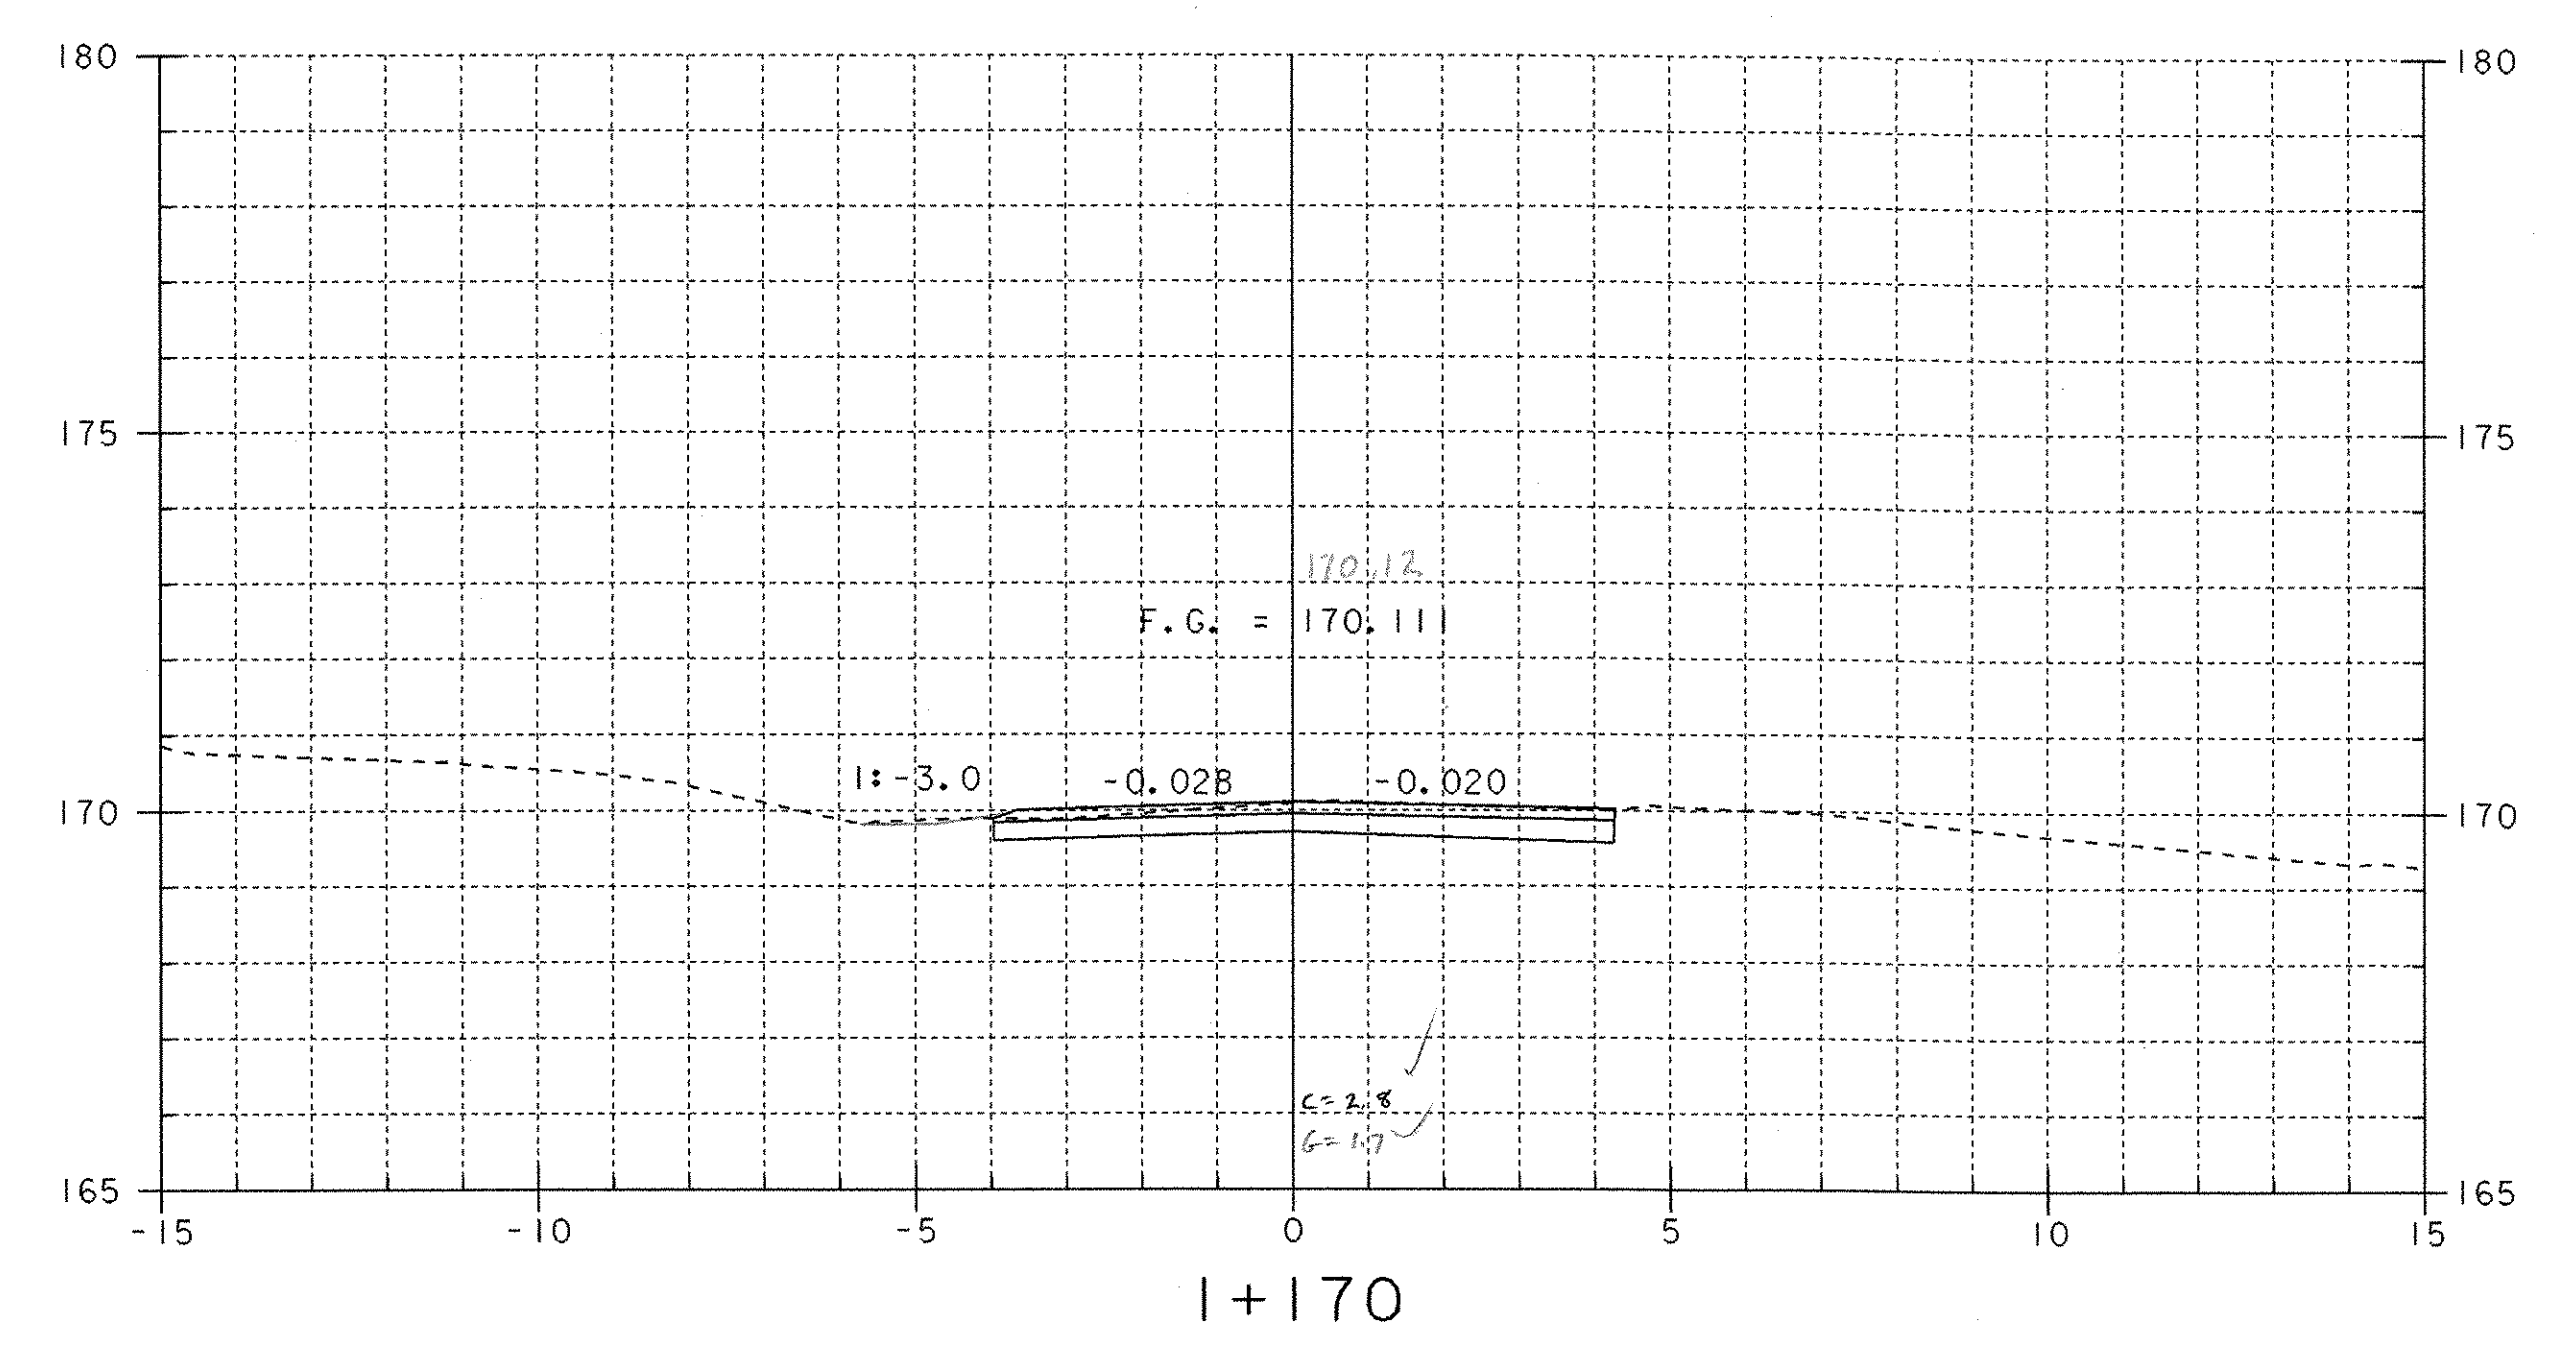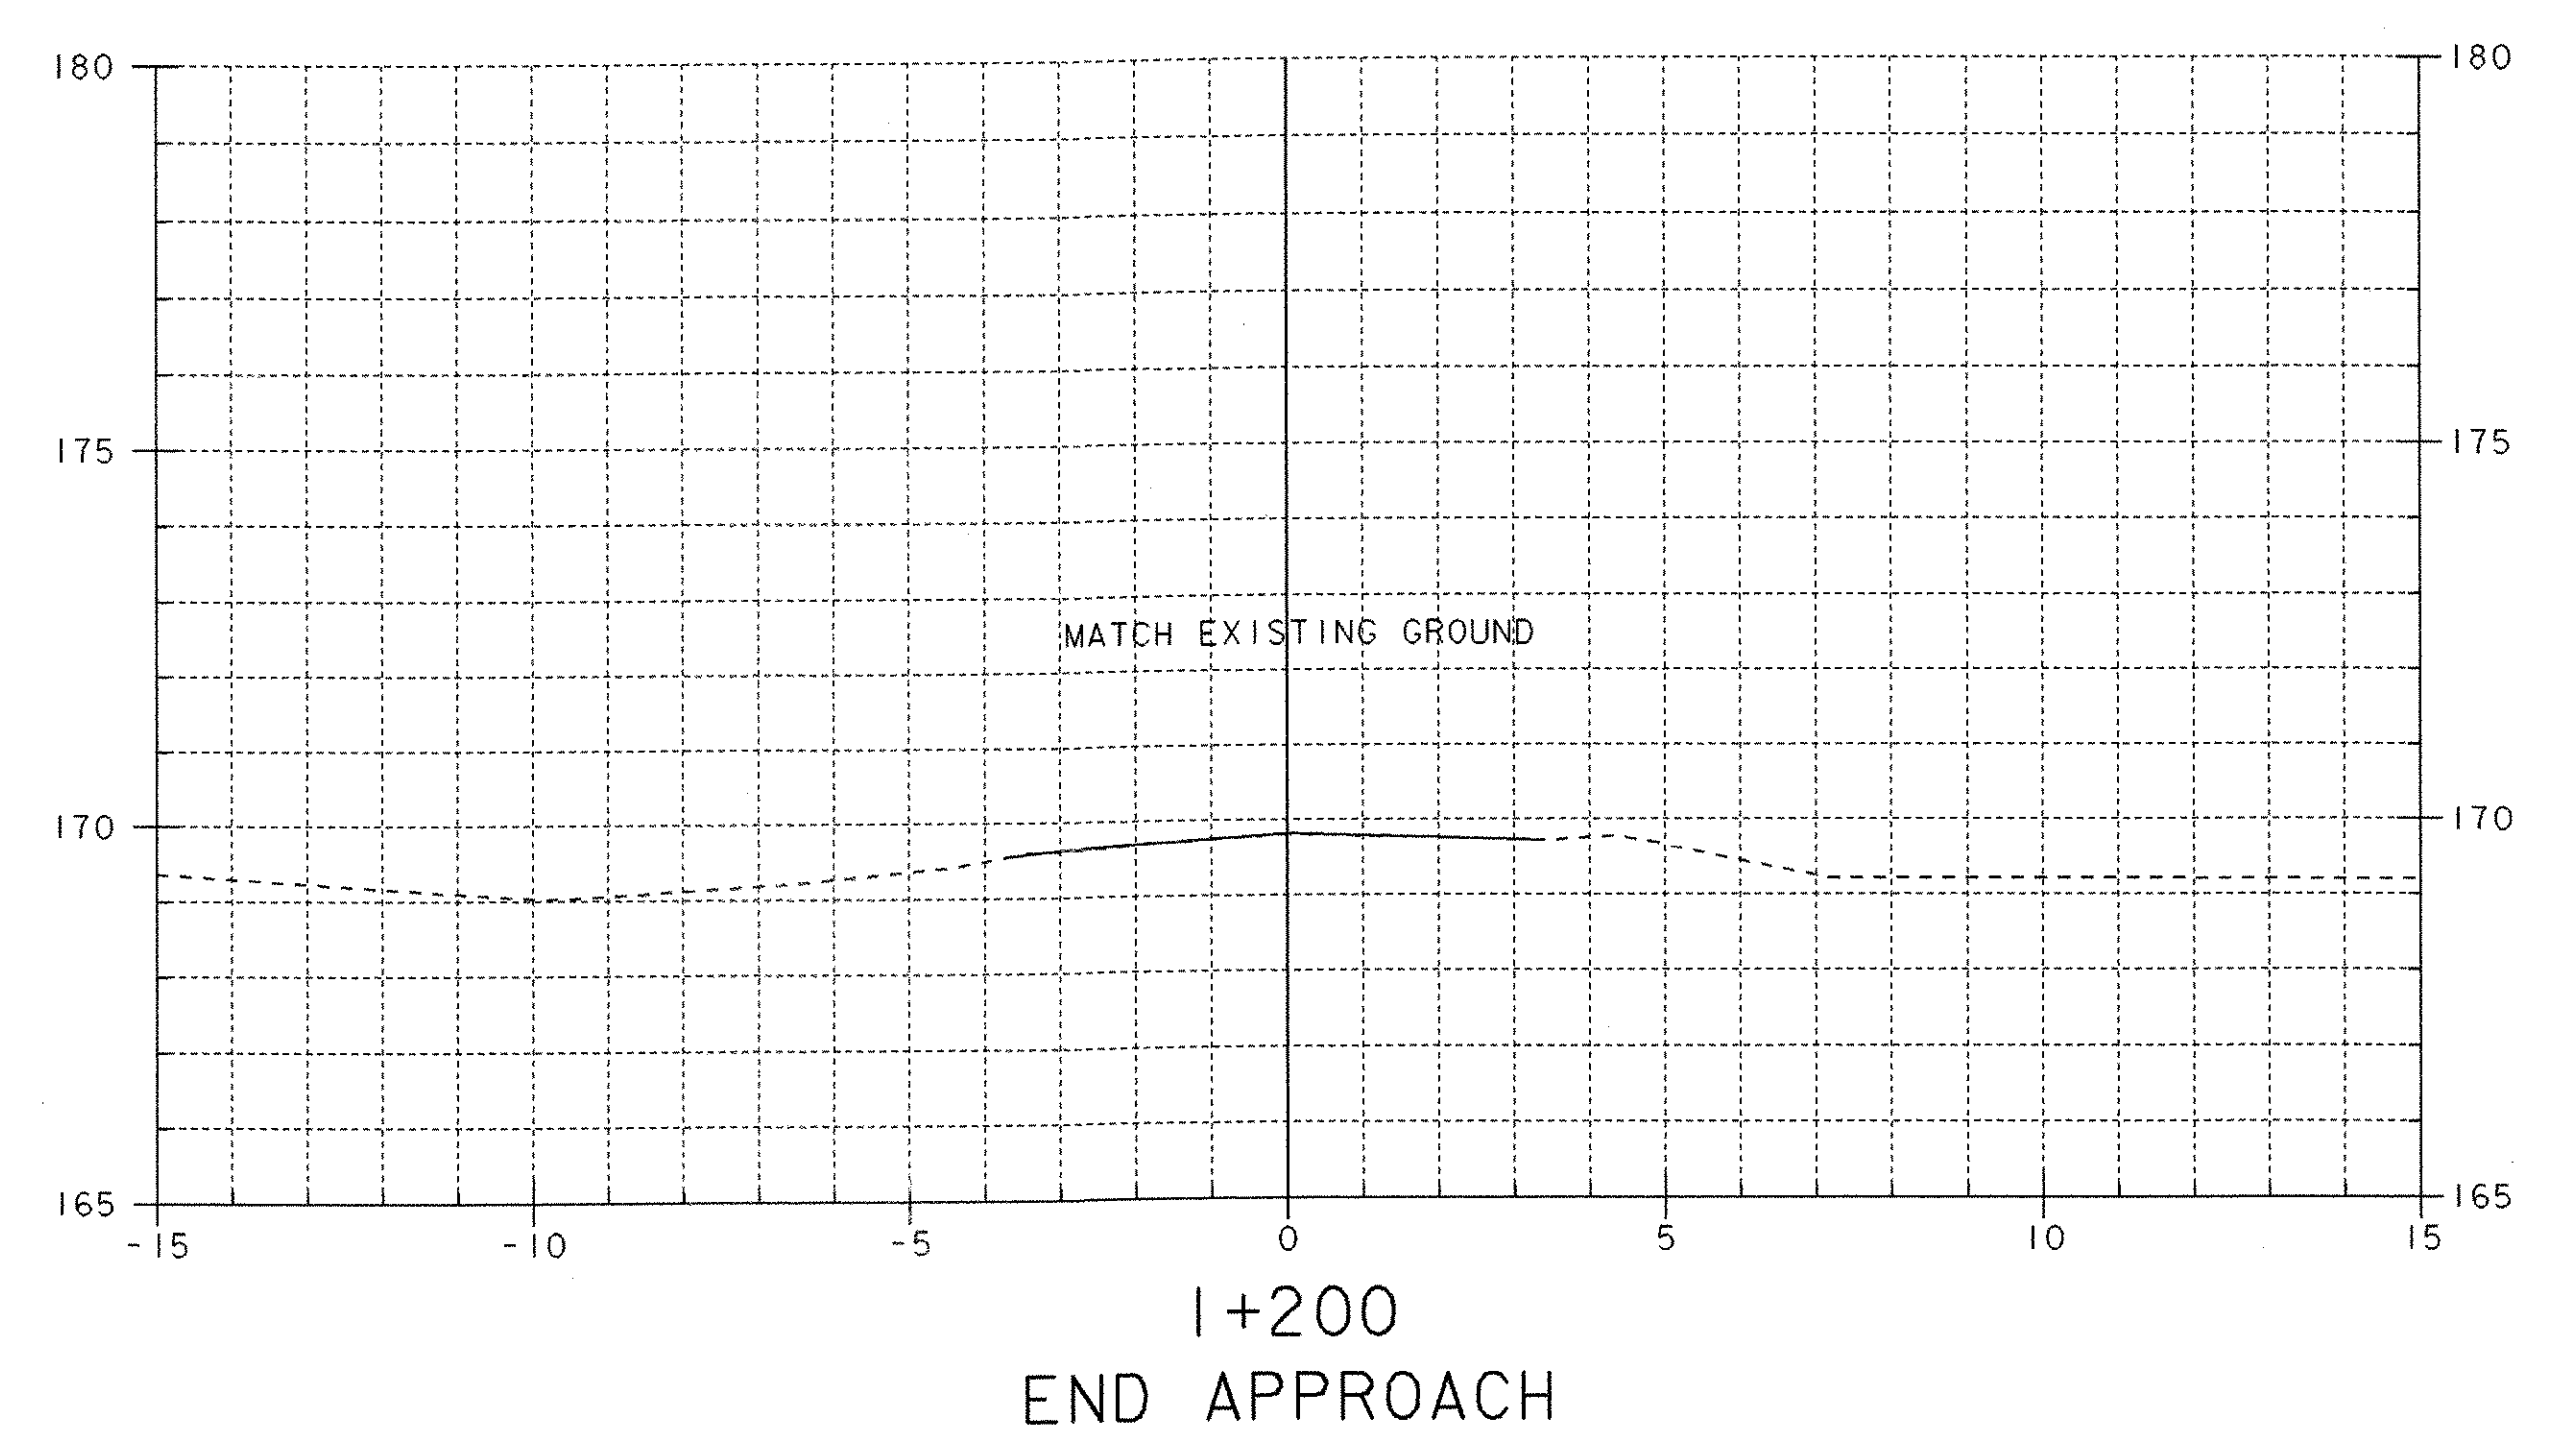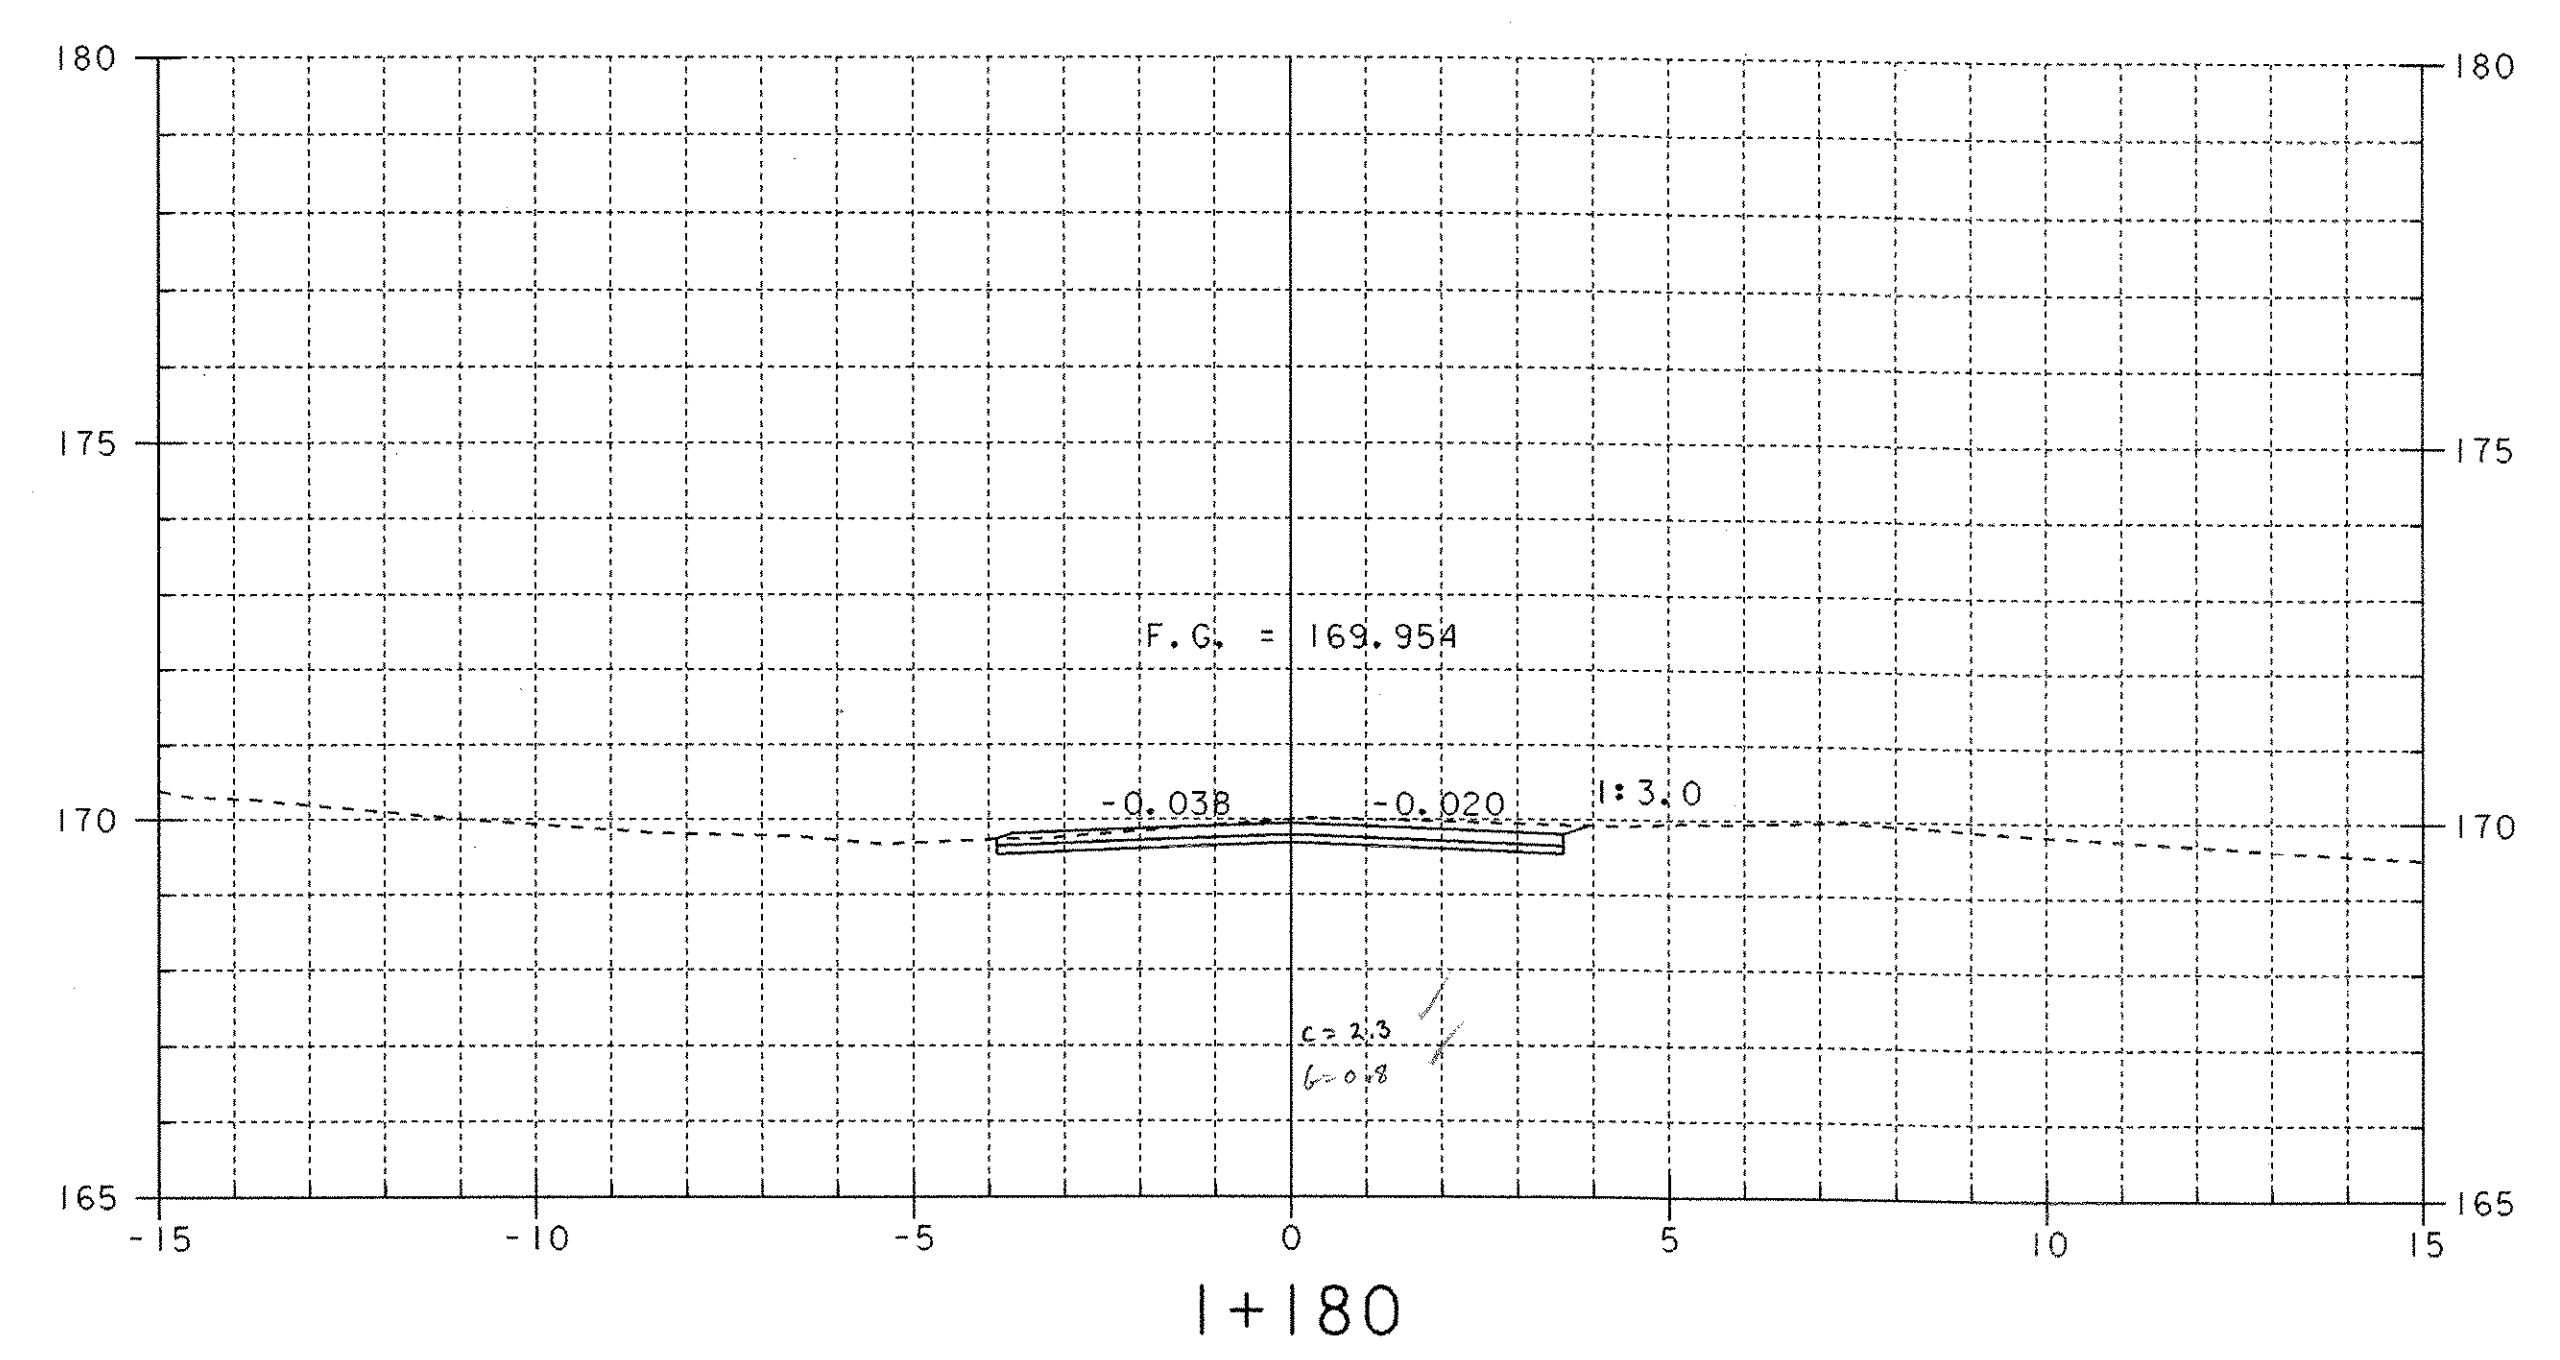


SHEET NAME: MAINLINE CROSS SECTIONS	
PROJECT NAME: WESTFORD	HIGHWAY NO.: TH 4
PROJECT NUMBER: TH2 9436	BRIDGE NO.: 2
	OVER: ROGERS BROOK
FILE NAME: /PW/941122/sj122xs2.dgn	PLOT DATE: 25-MAR-2005
PROJECT MANAGER: R. R. WHITCOMB	DRAWN BY: STRI
DESIGNED BY: C. CARLSON	IPARM NAME: sj122m6.i
BRIDGE SHEET NUMBER:	SHEET 49 OF 56

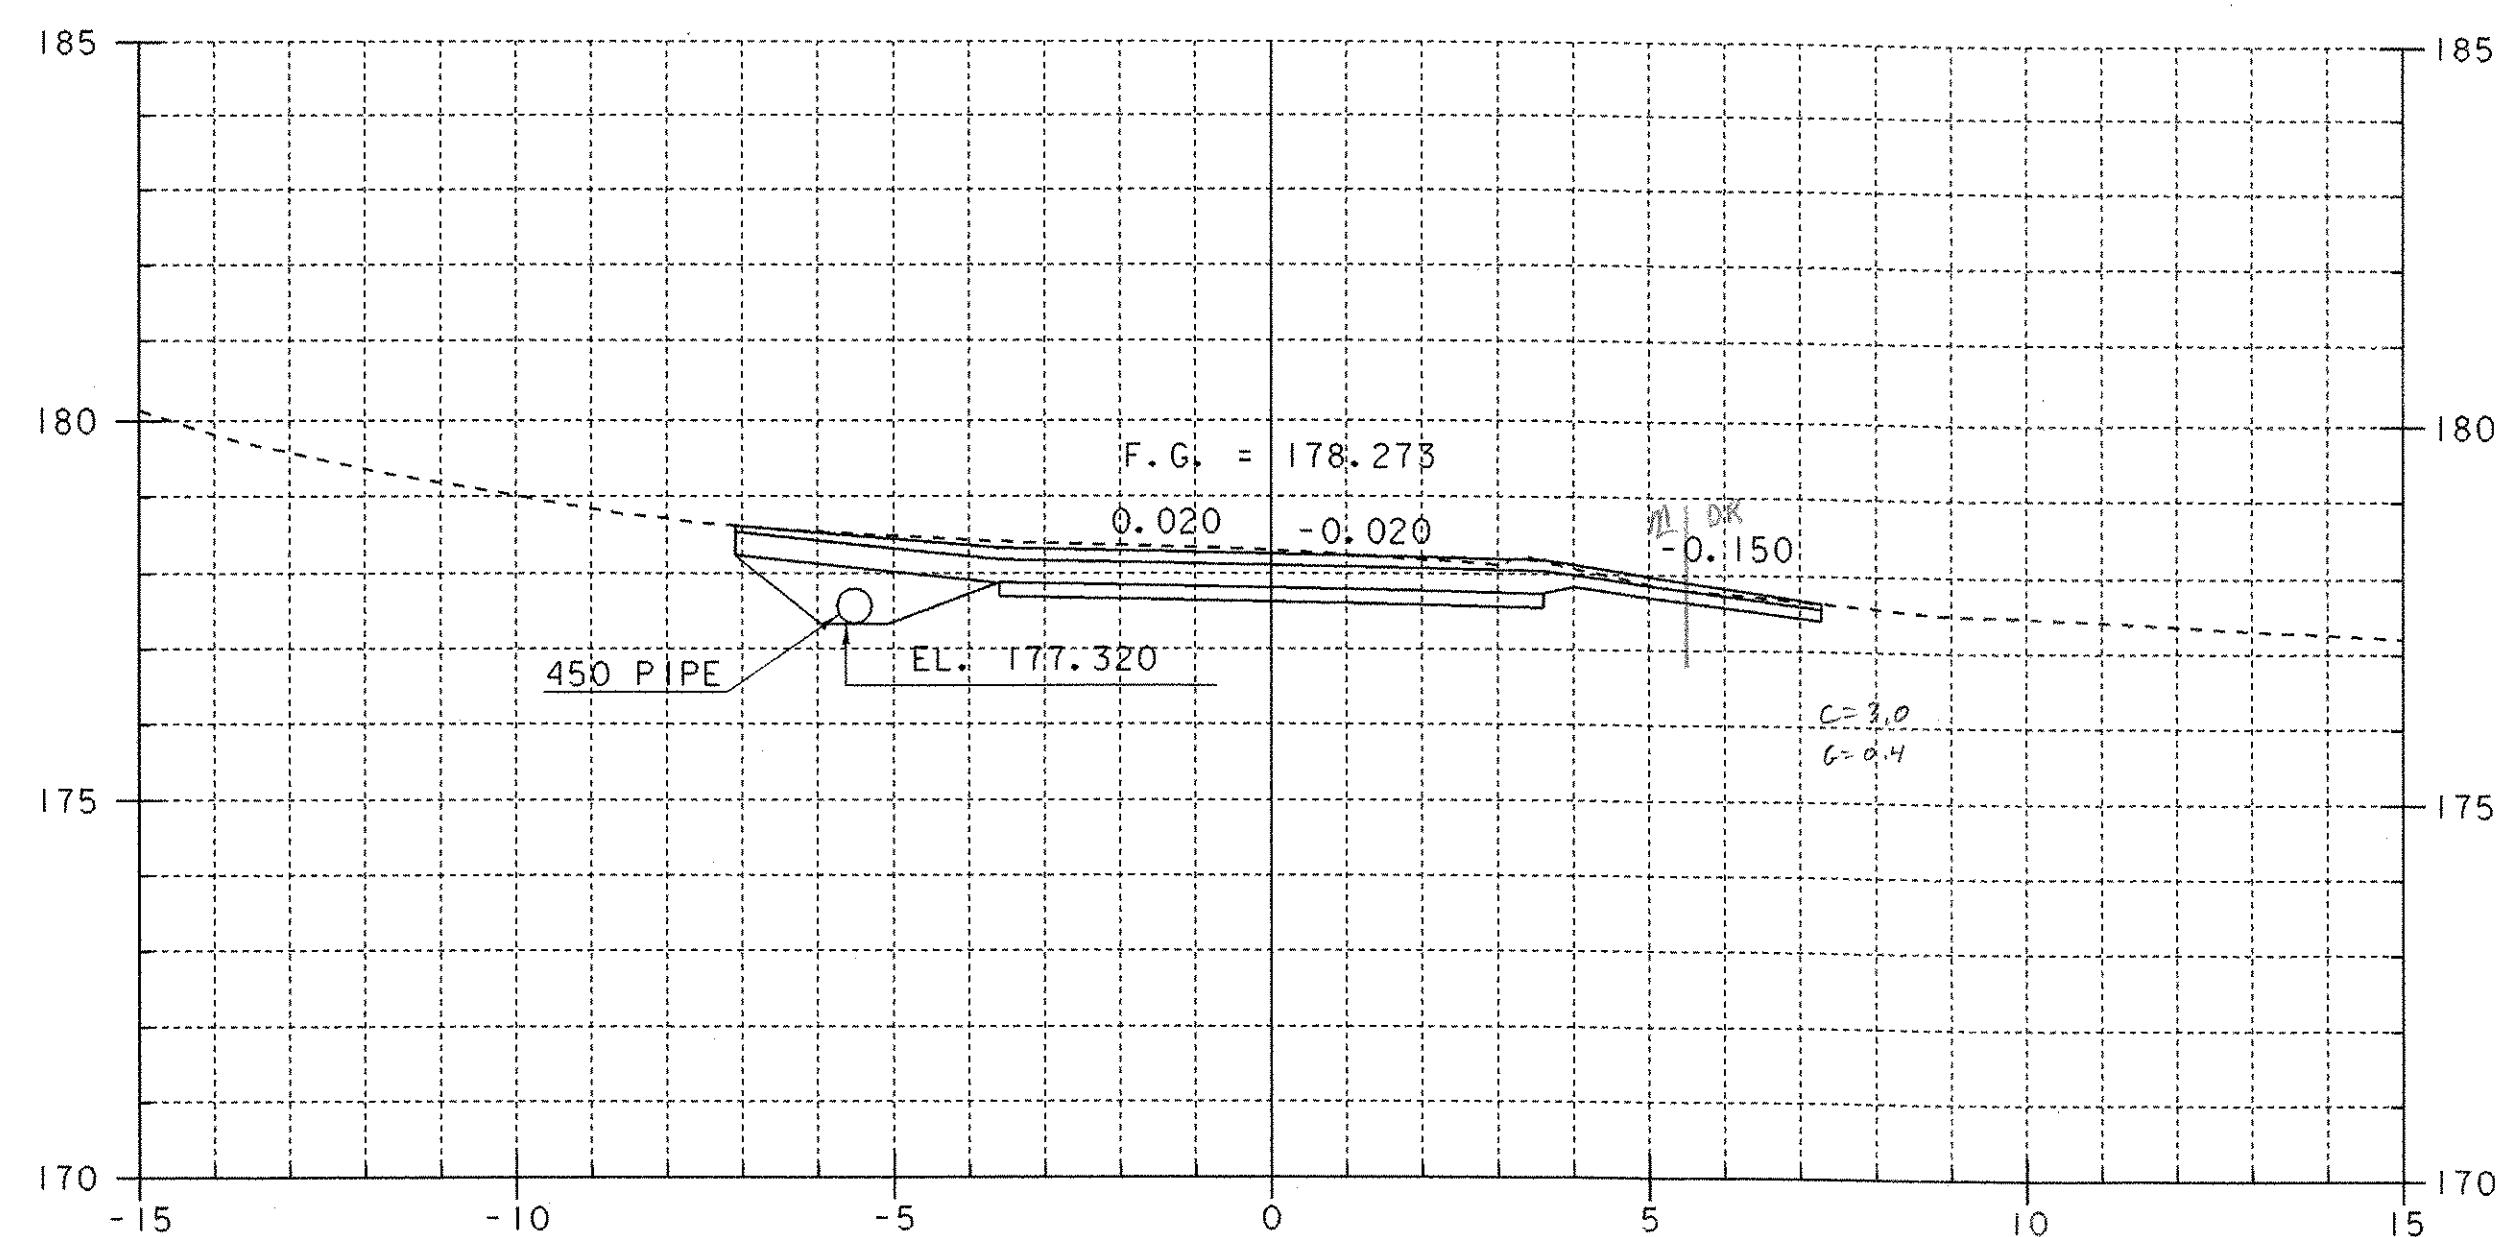


I+034
DRIVE RIGHT

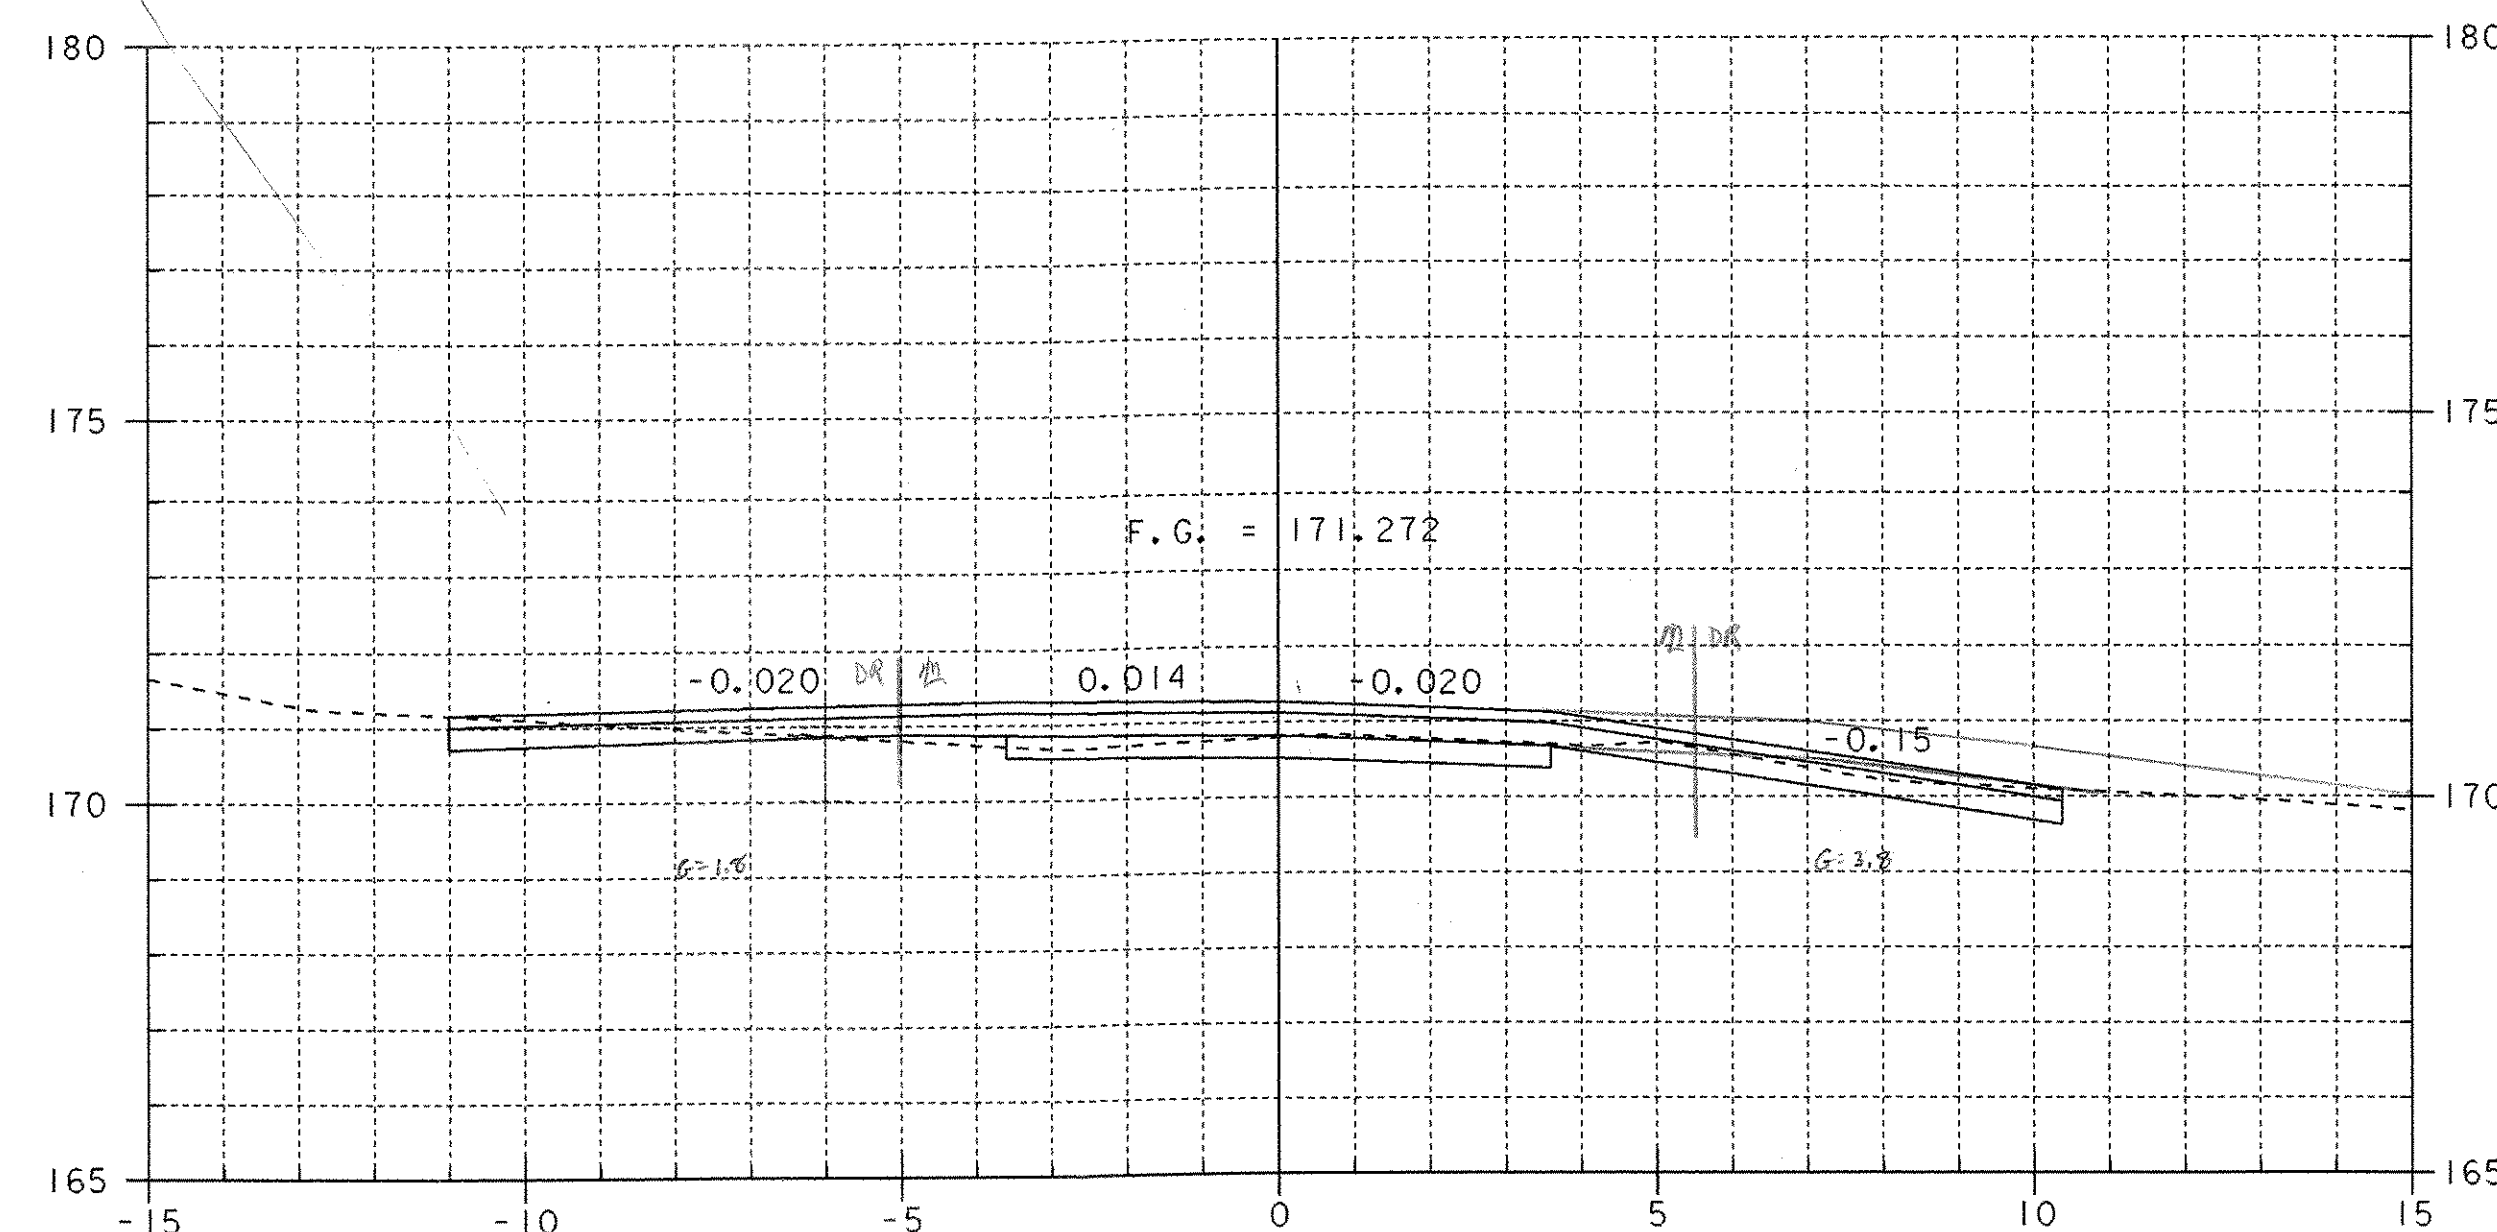

I+133
DRIVE LEFT *RT*

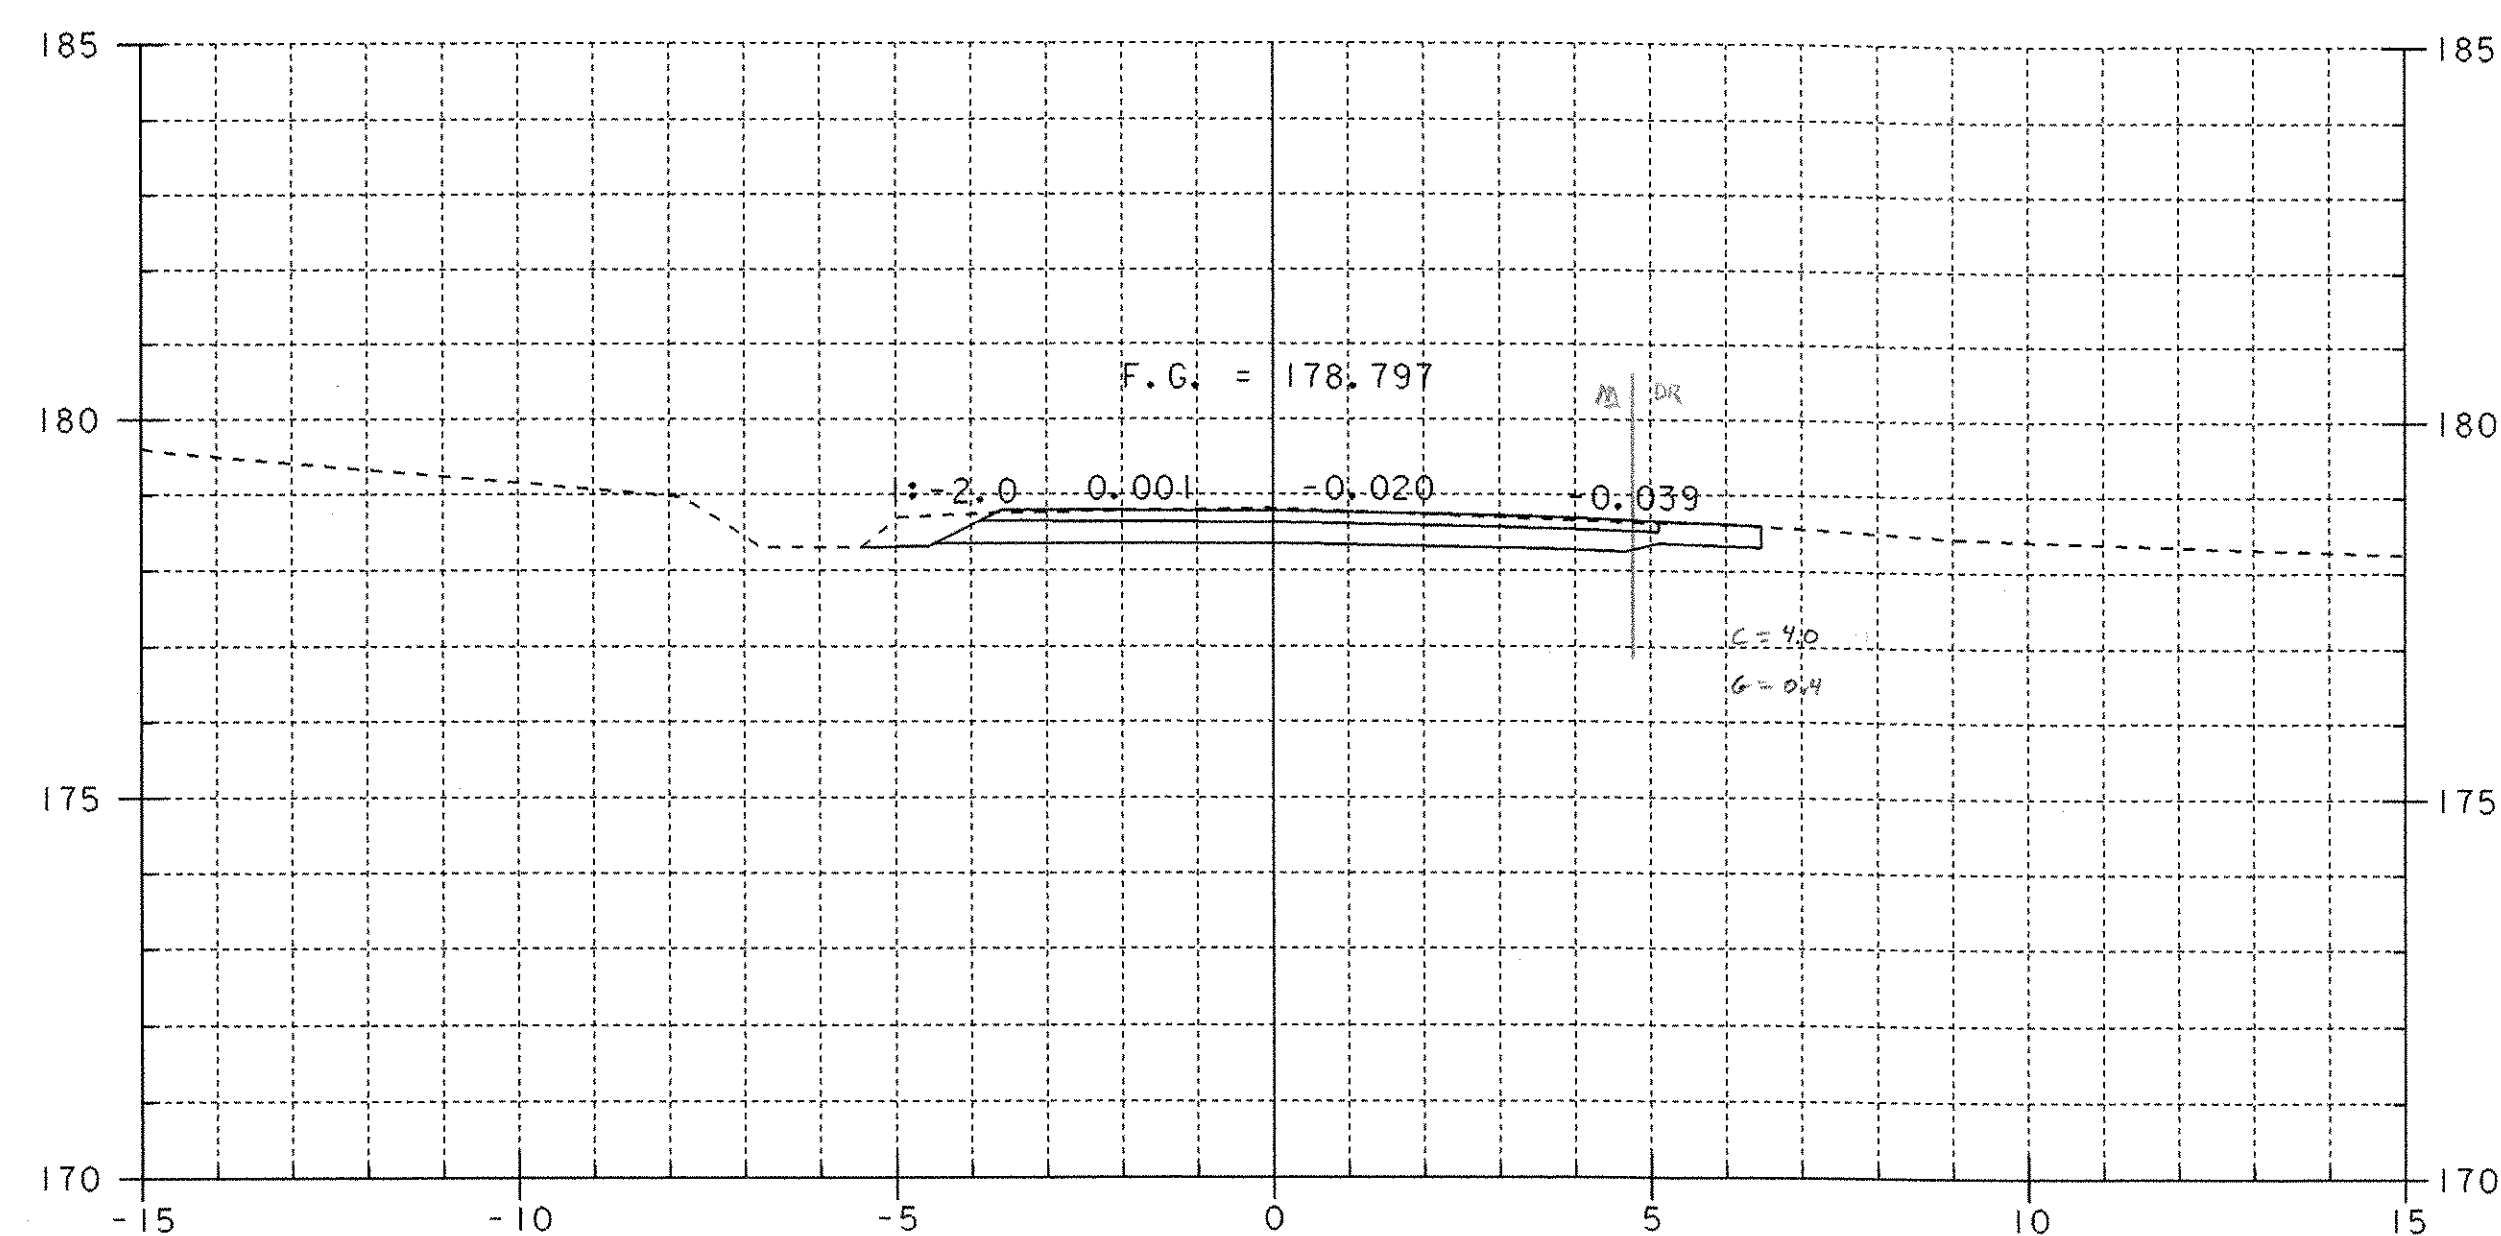


I+023
DRIVE RIGHT

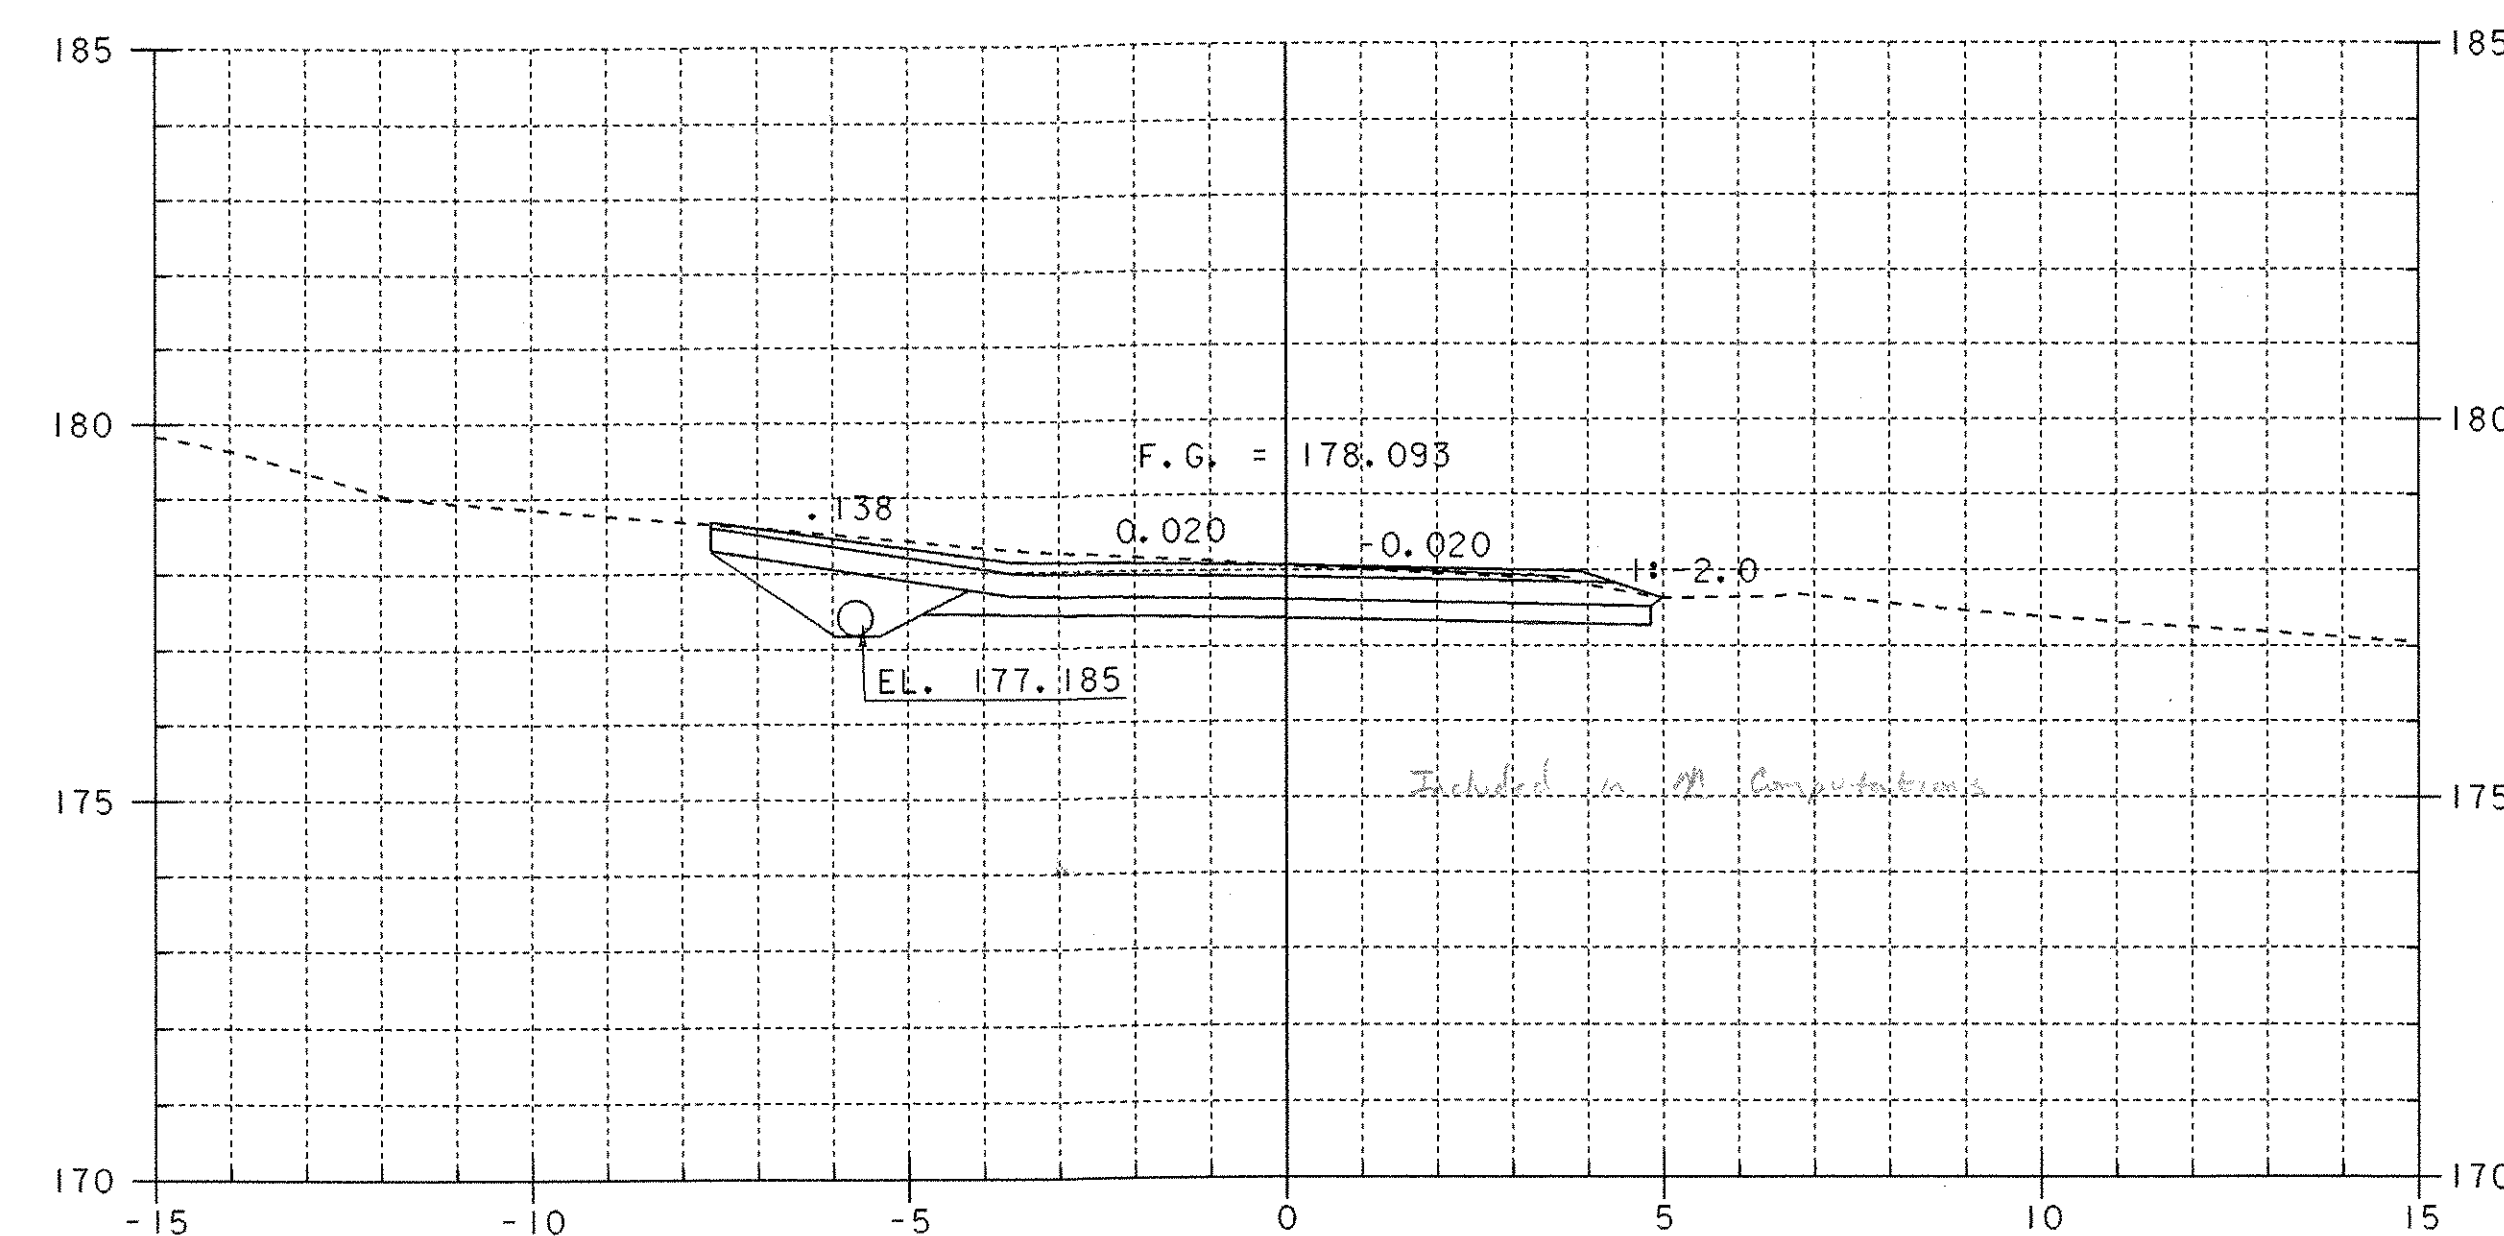


I+037
DRIVE LEFT


SHEET NAME: DRIVE CROSS SECTIONS	
PROJECT NAME: WESTFORD	HIGHWAY NO.: TH 4
PROJECT NUMBER: TH2 9436	BRIDGE NO.: 2
	OVER: ROGERS BROOK
FILE NAME: /PW/941122/sj122xs2.dgn	PLOT DATE: 25-MAR-2005
PROJECT MANAGER: R. R. WHITCOMB	DRAWN BY: STRI
DESIGNED BY: C. CARLSON	IPARM NAME: sj122dx1.1
BRIDGE SHEET NUMBER:	SHEET 50 OF 56

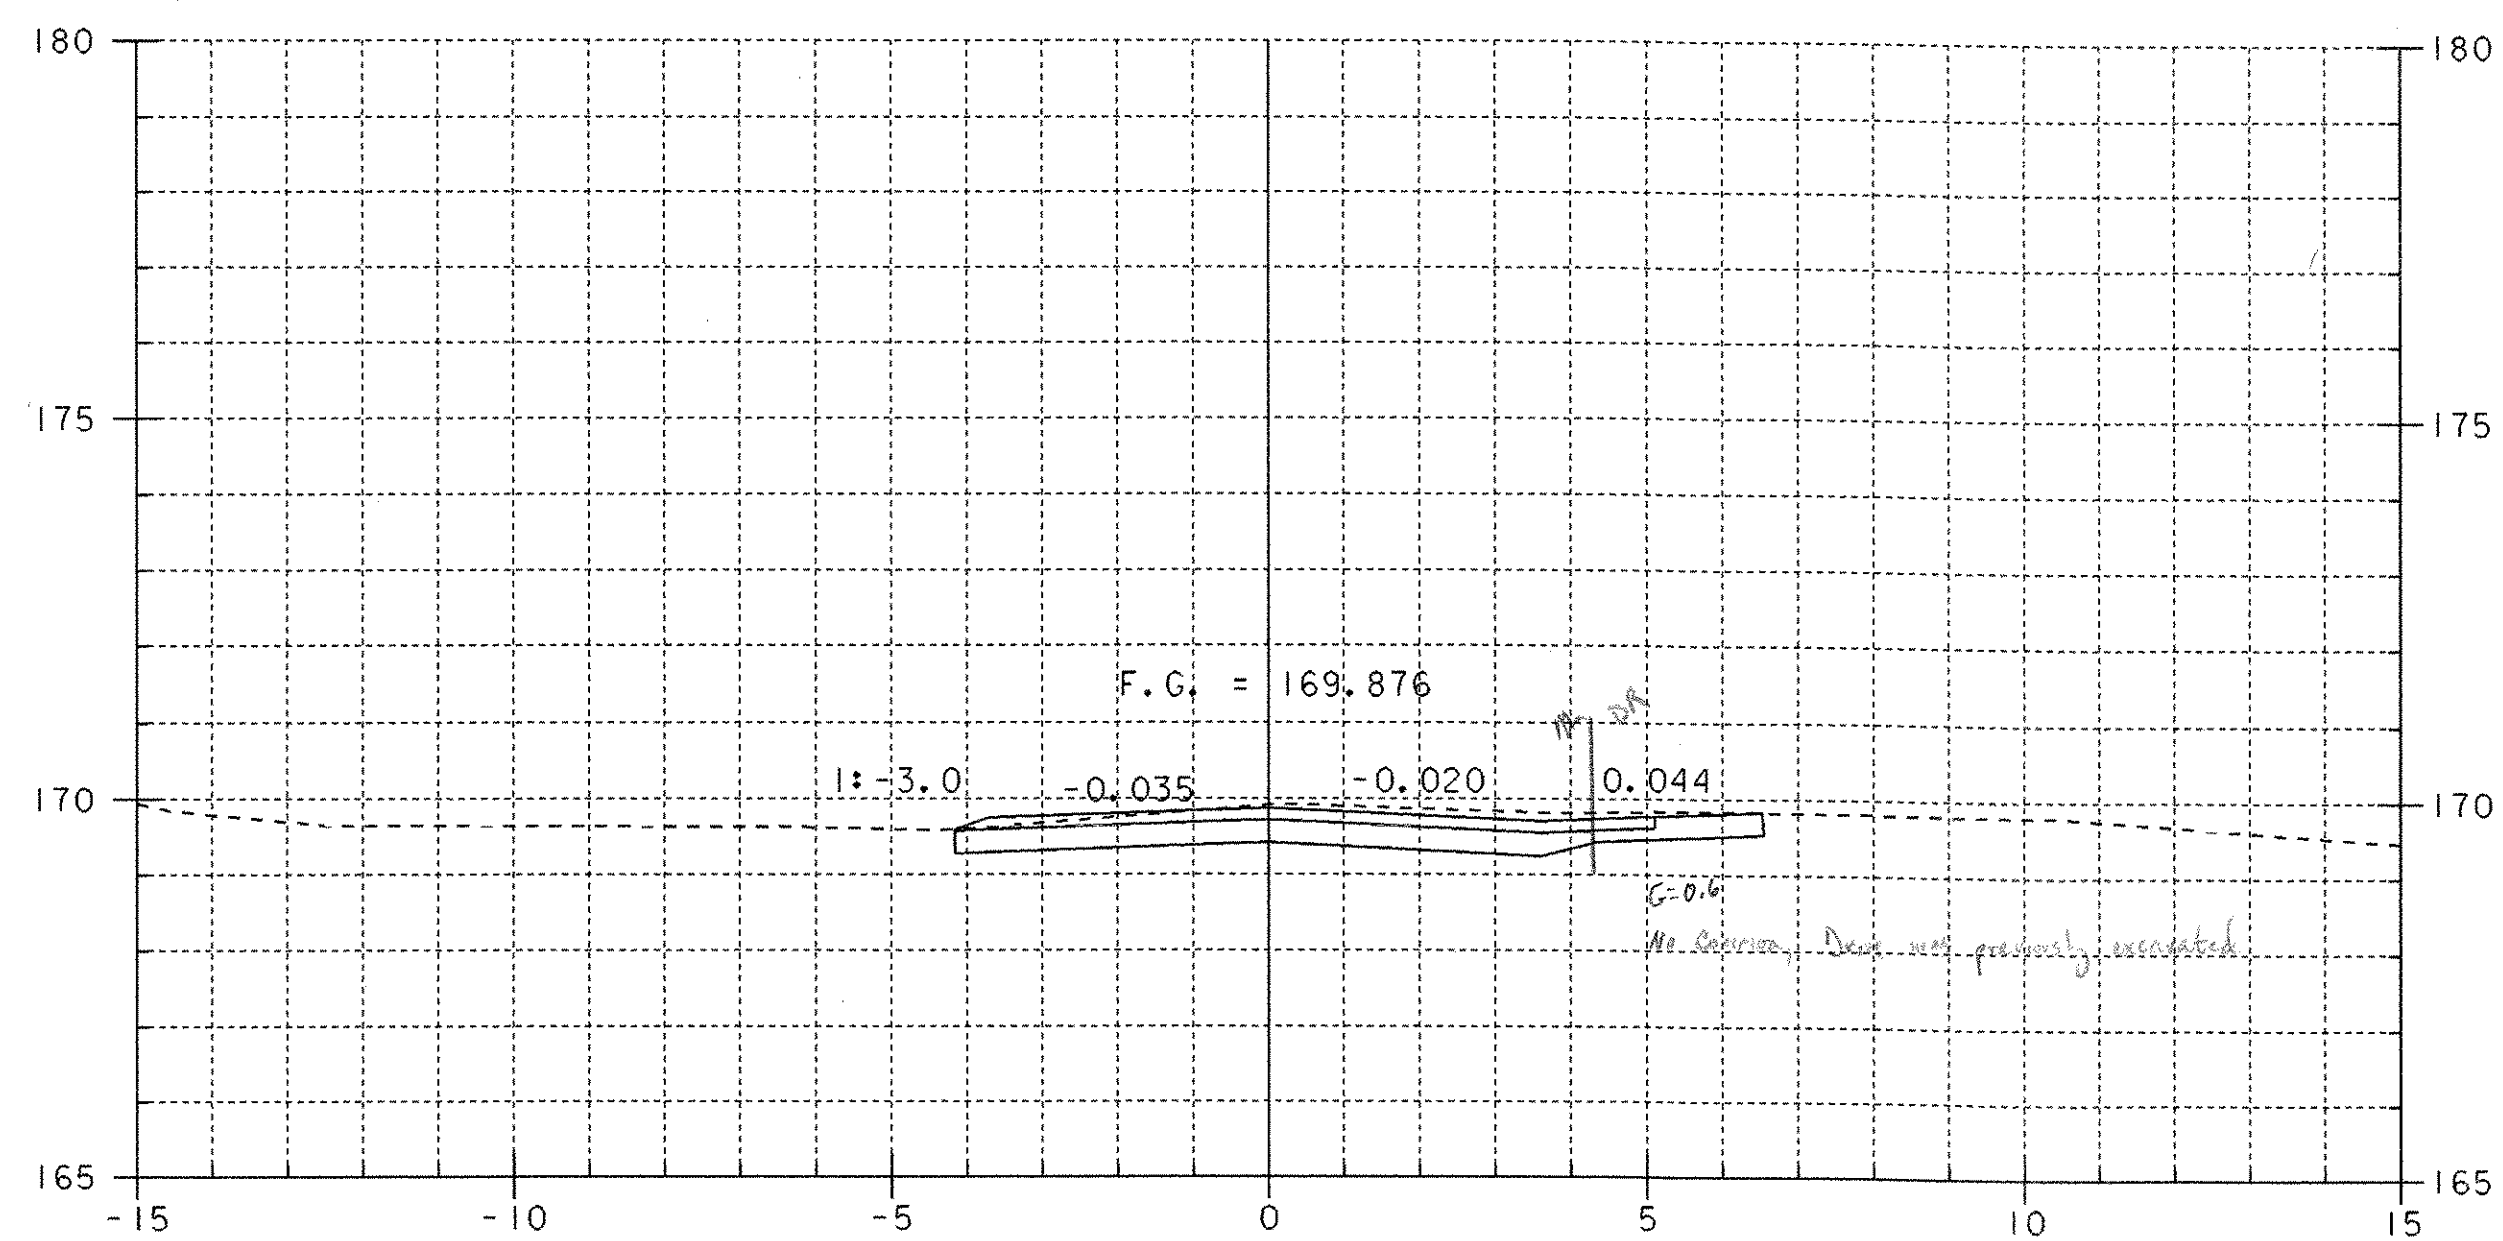

I+188
DRIVE RIGHT

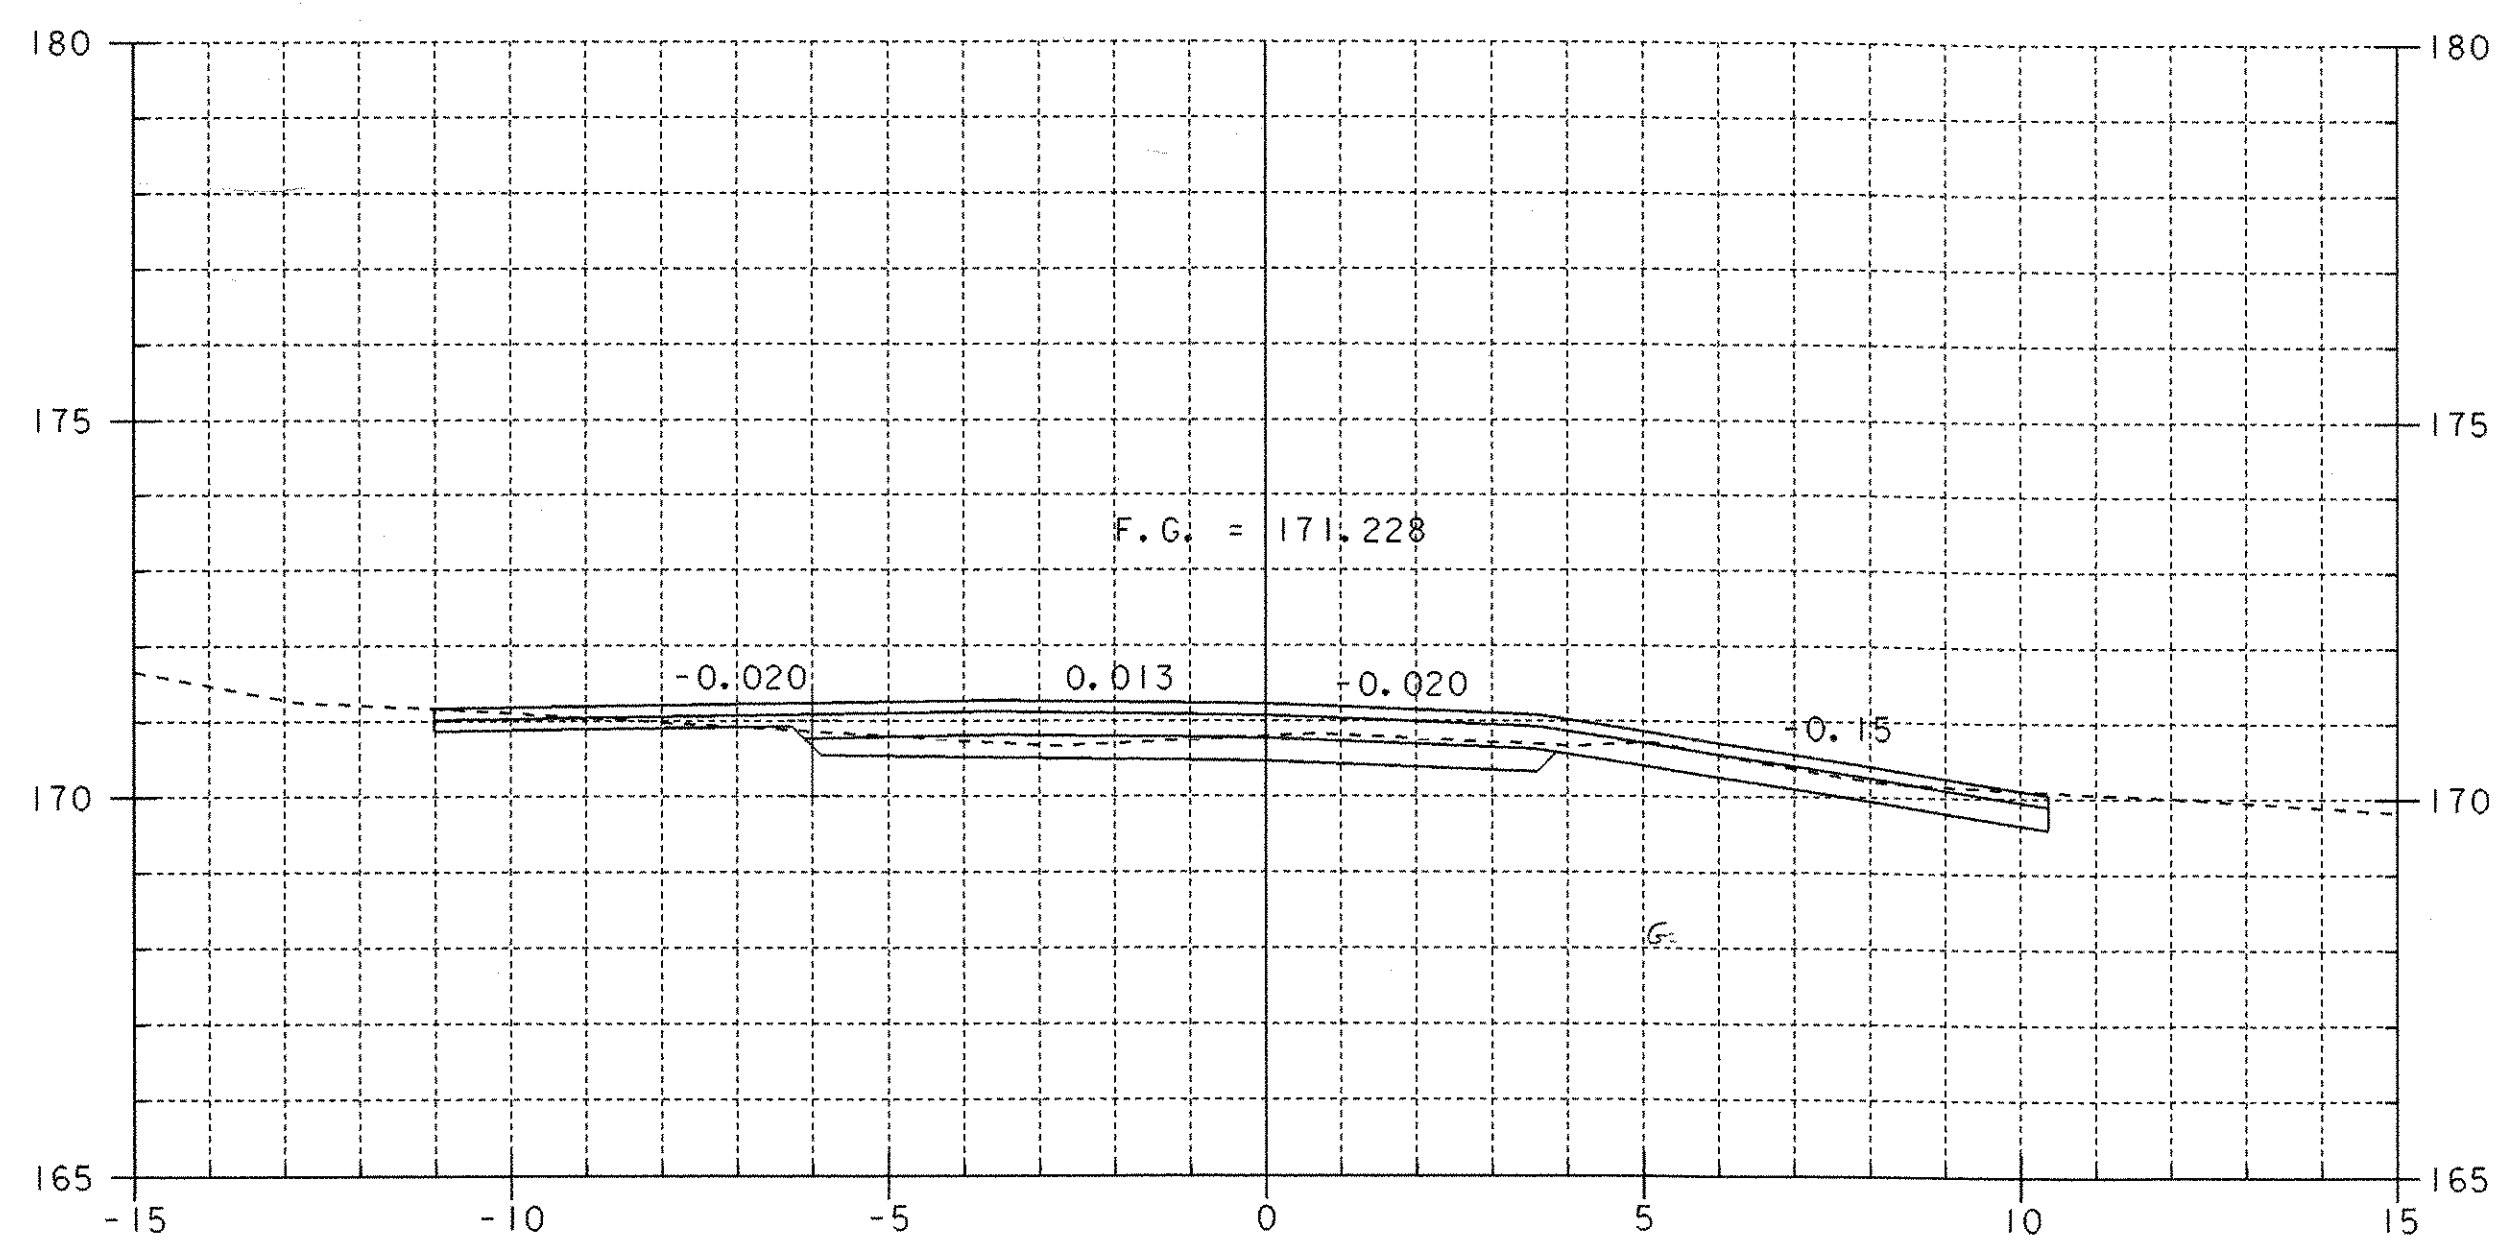


I+134
DRIVE RIGHT



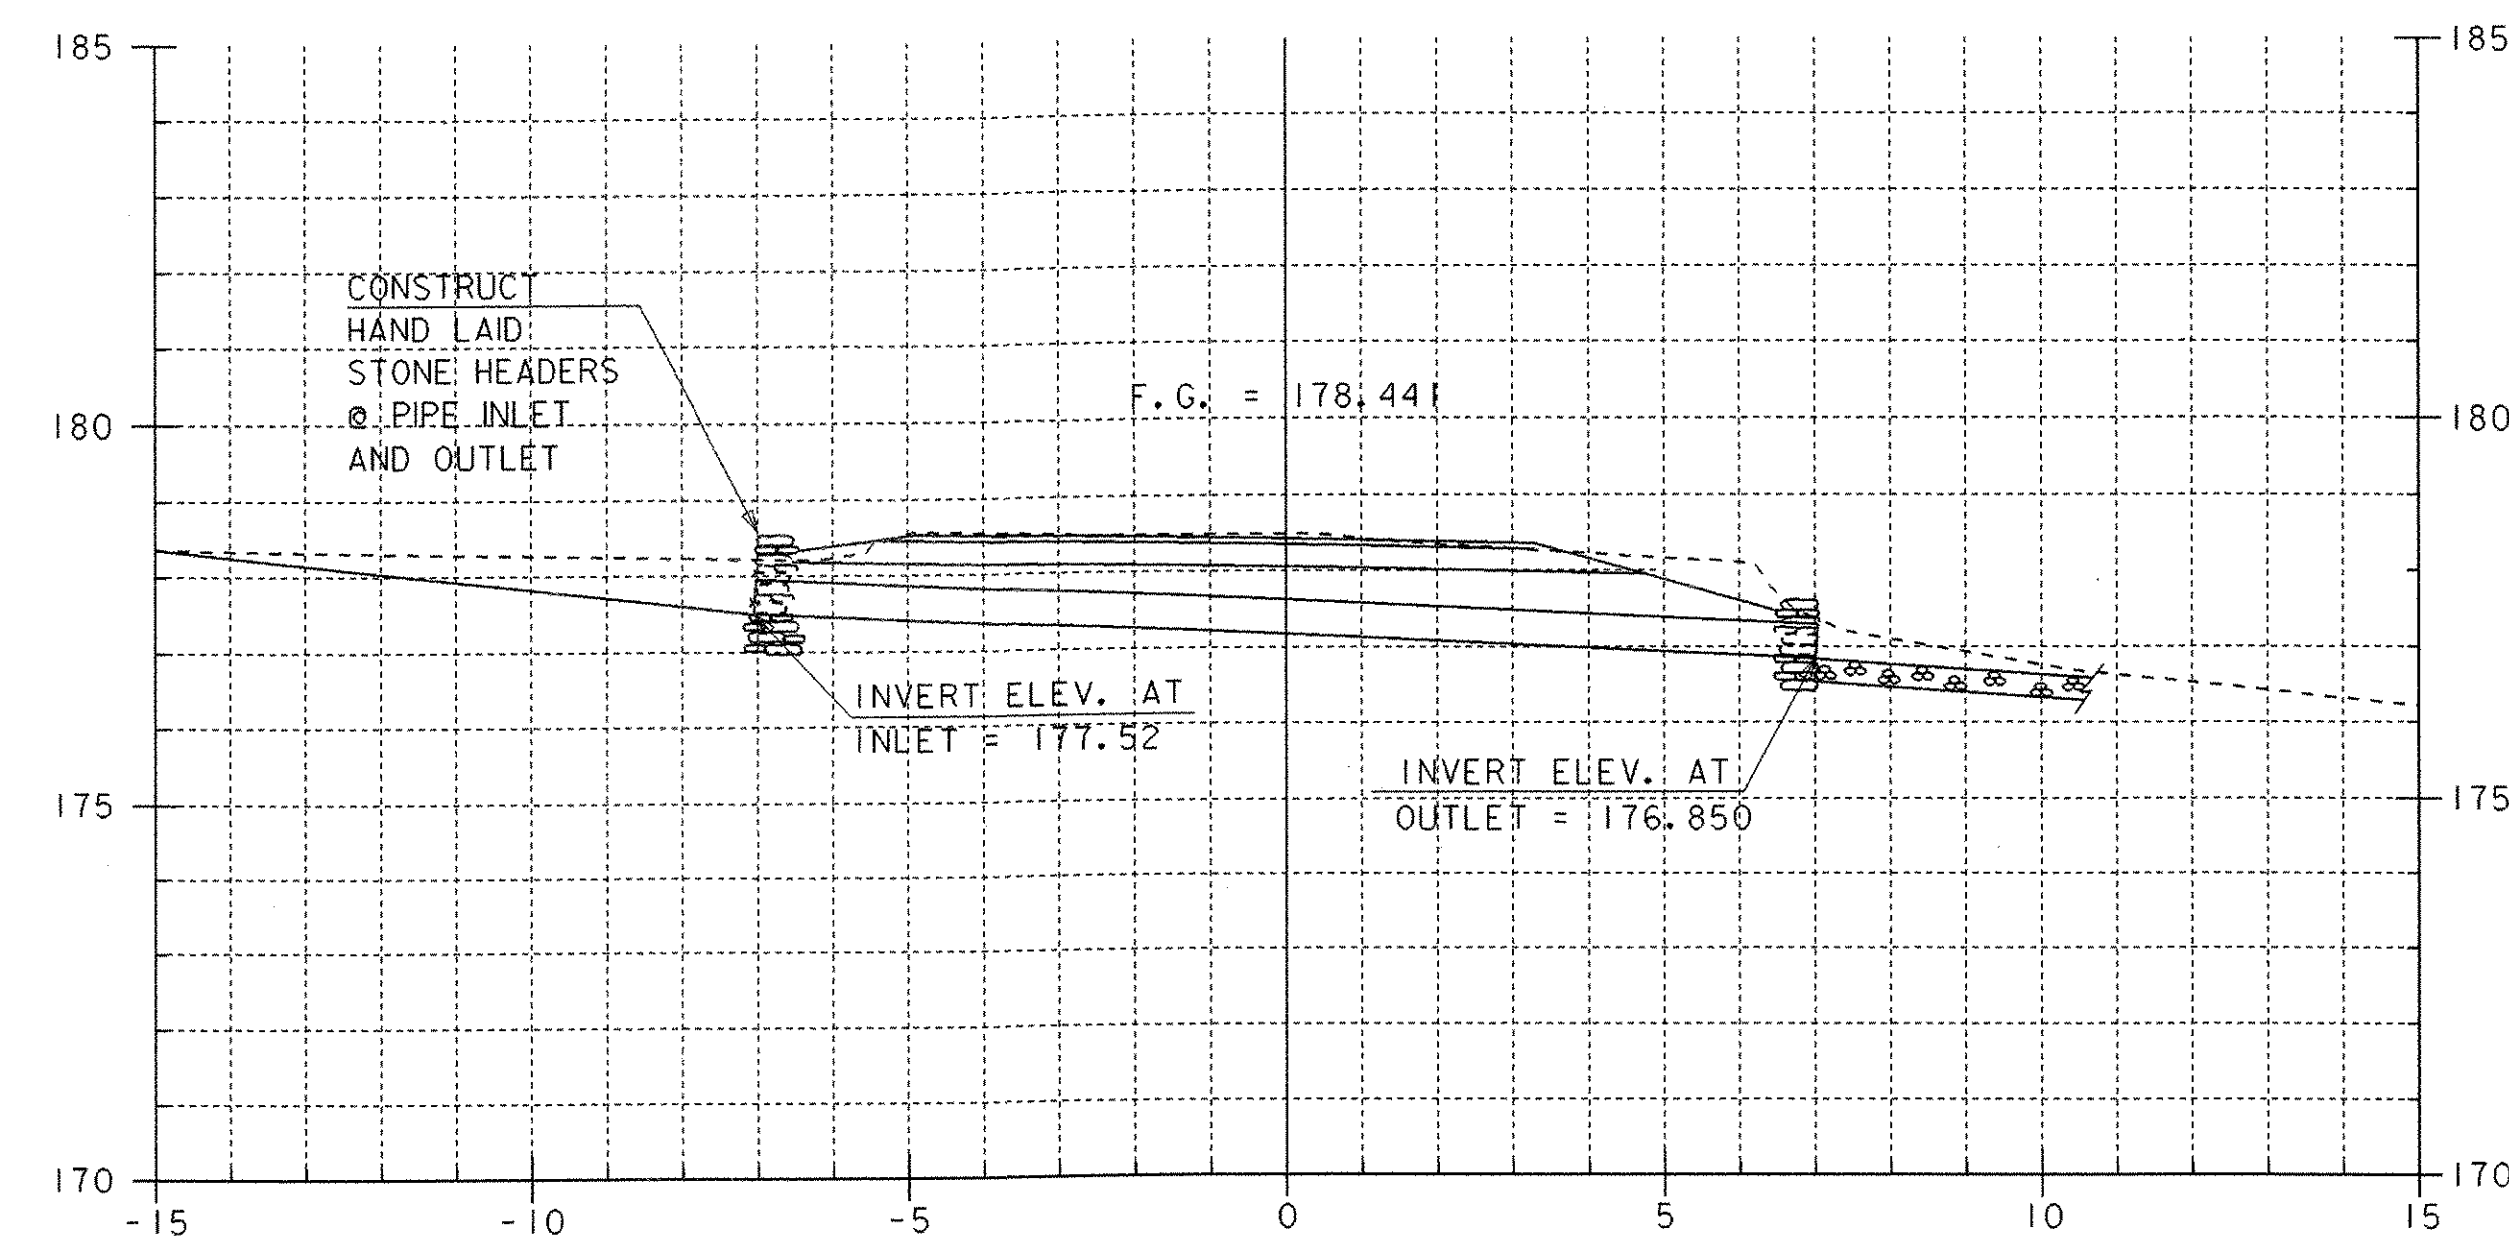


OPTION PIPE UNDER DRIVE
STA I+037 LEFT


SHEET NAME: DRIVE CROSS SECTIONS	
PROJECT NAME: WESTFORD	HIGHWAY NO.: TH 4
PROJECT NUMBER: TH2 9436	BRIDGE NO.: 2
	OVER: ROGERS BROOK
FILE NAME: /PW/941122/sj122xs2.dgn	PLOT DATE: 25-MAR-2005
PROJECT MANAGER: R. R. WHITCOMB	DRAWN BY: STRI
DESIGNED BY: C. CARLSON	IPARM NAME: sj122d2.1
BRIDGE SHEET NUMBER:	SHEET 51 OF 56

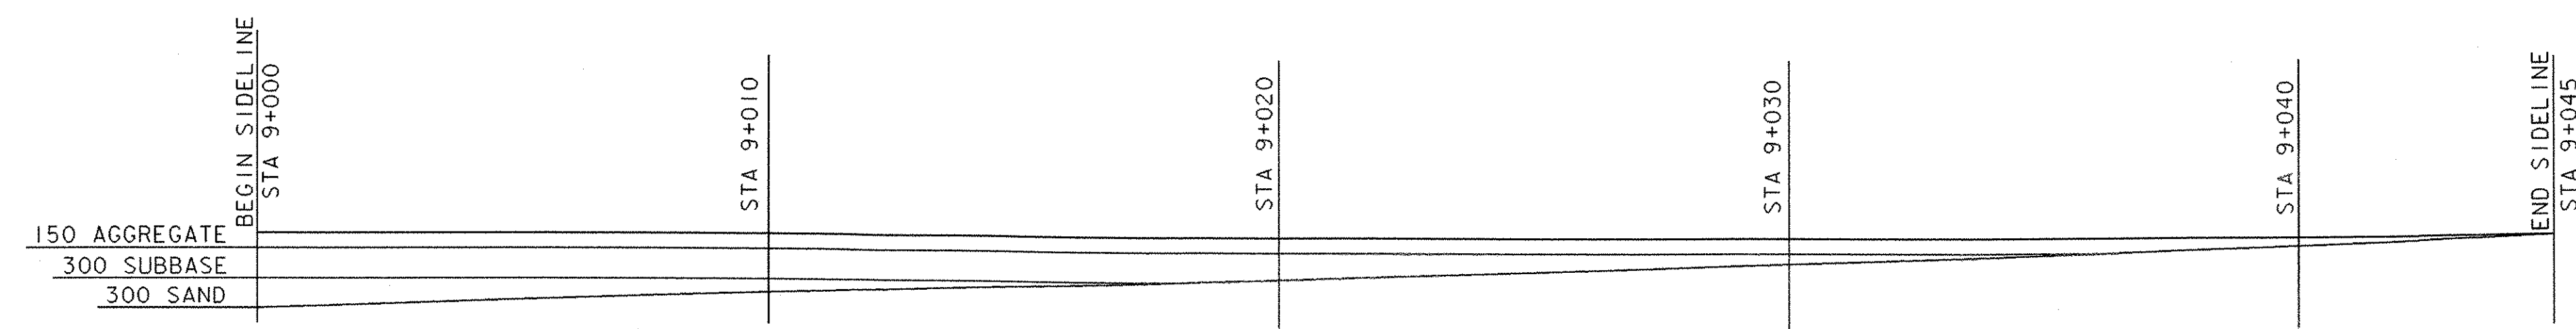





MATERIAL TRANSITION DETAIL

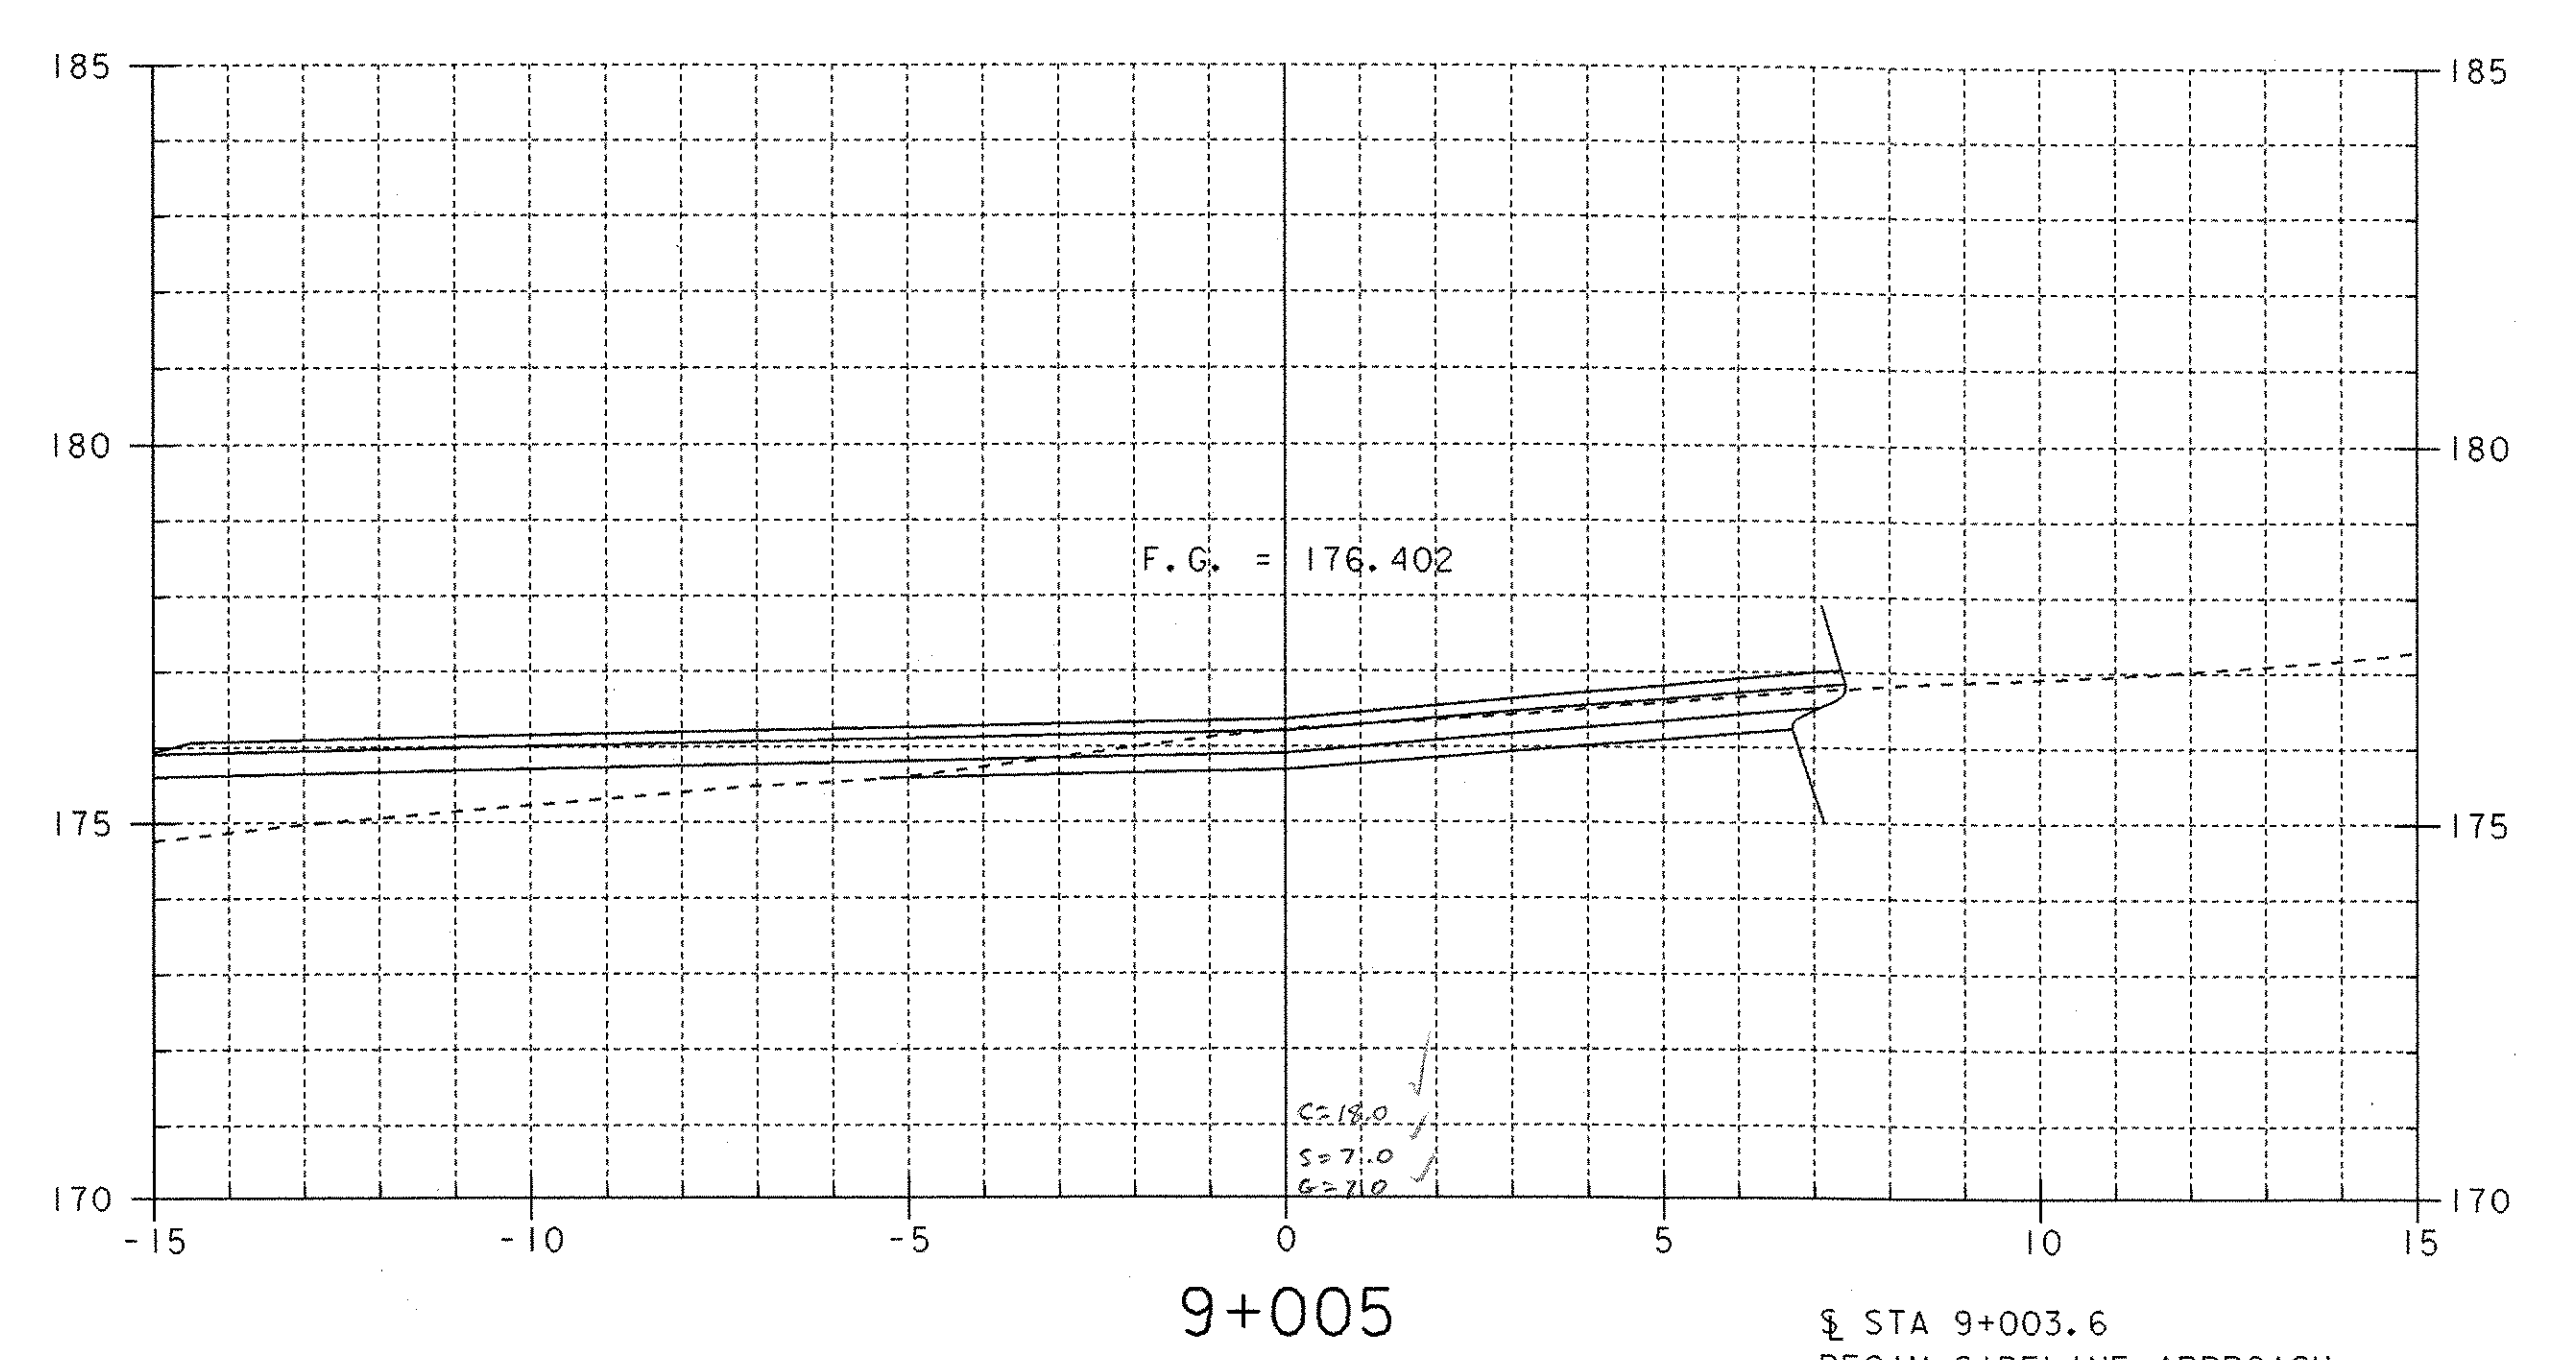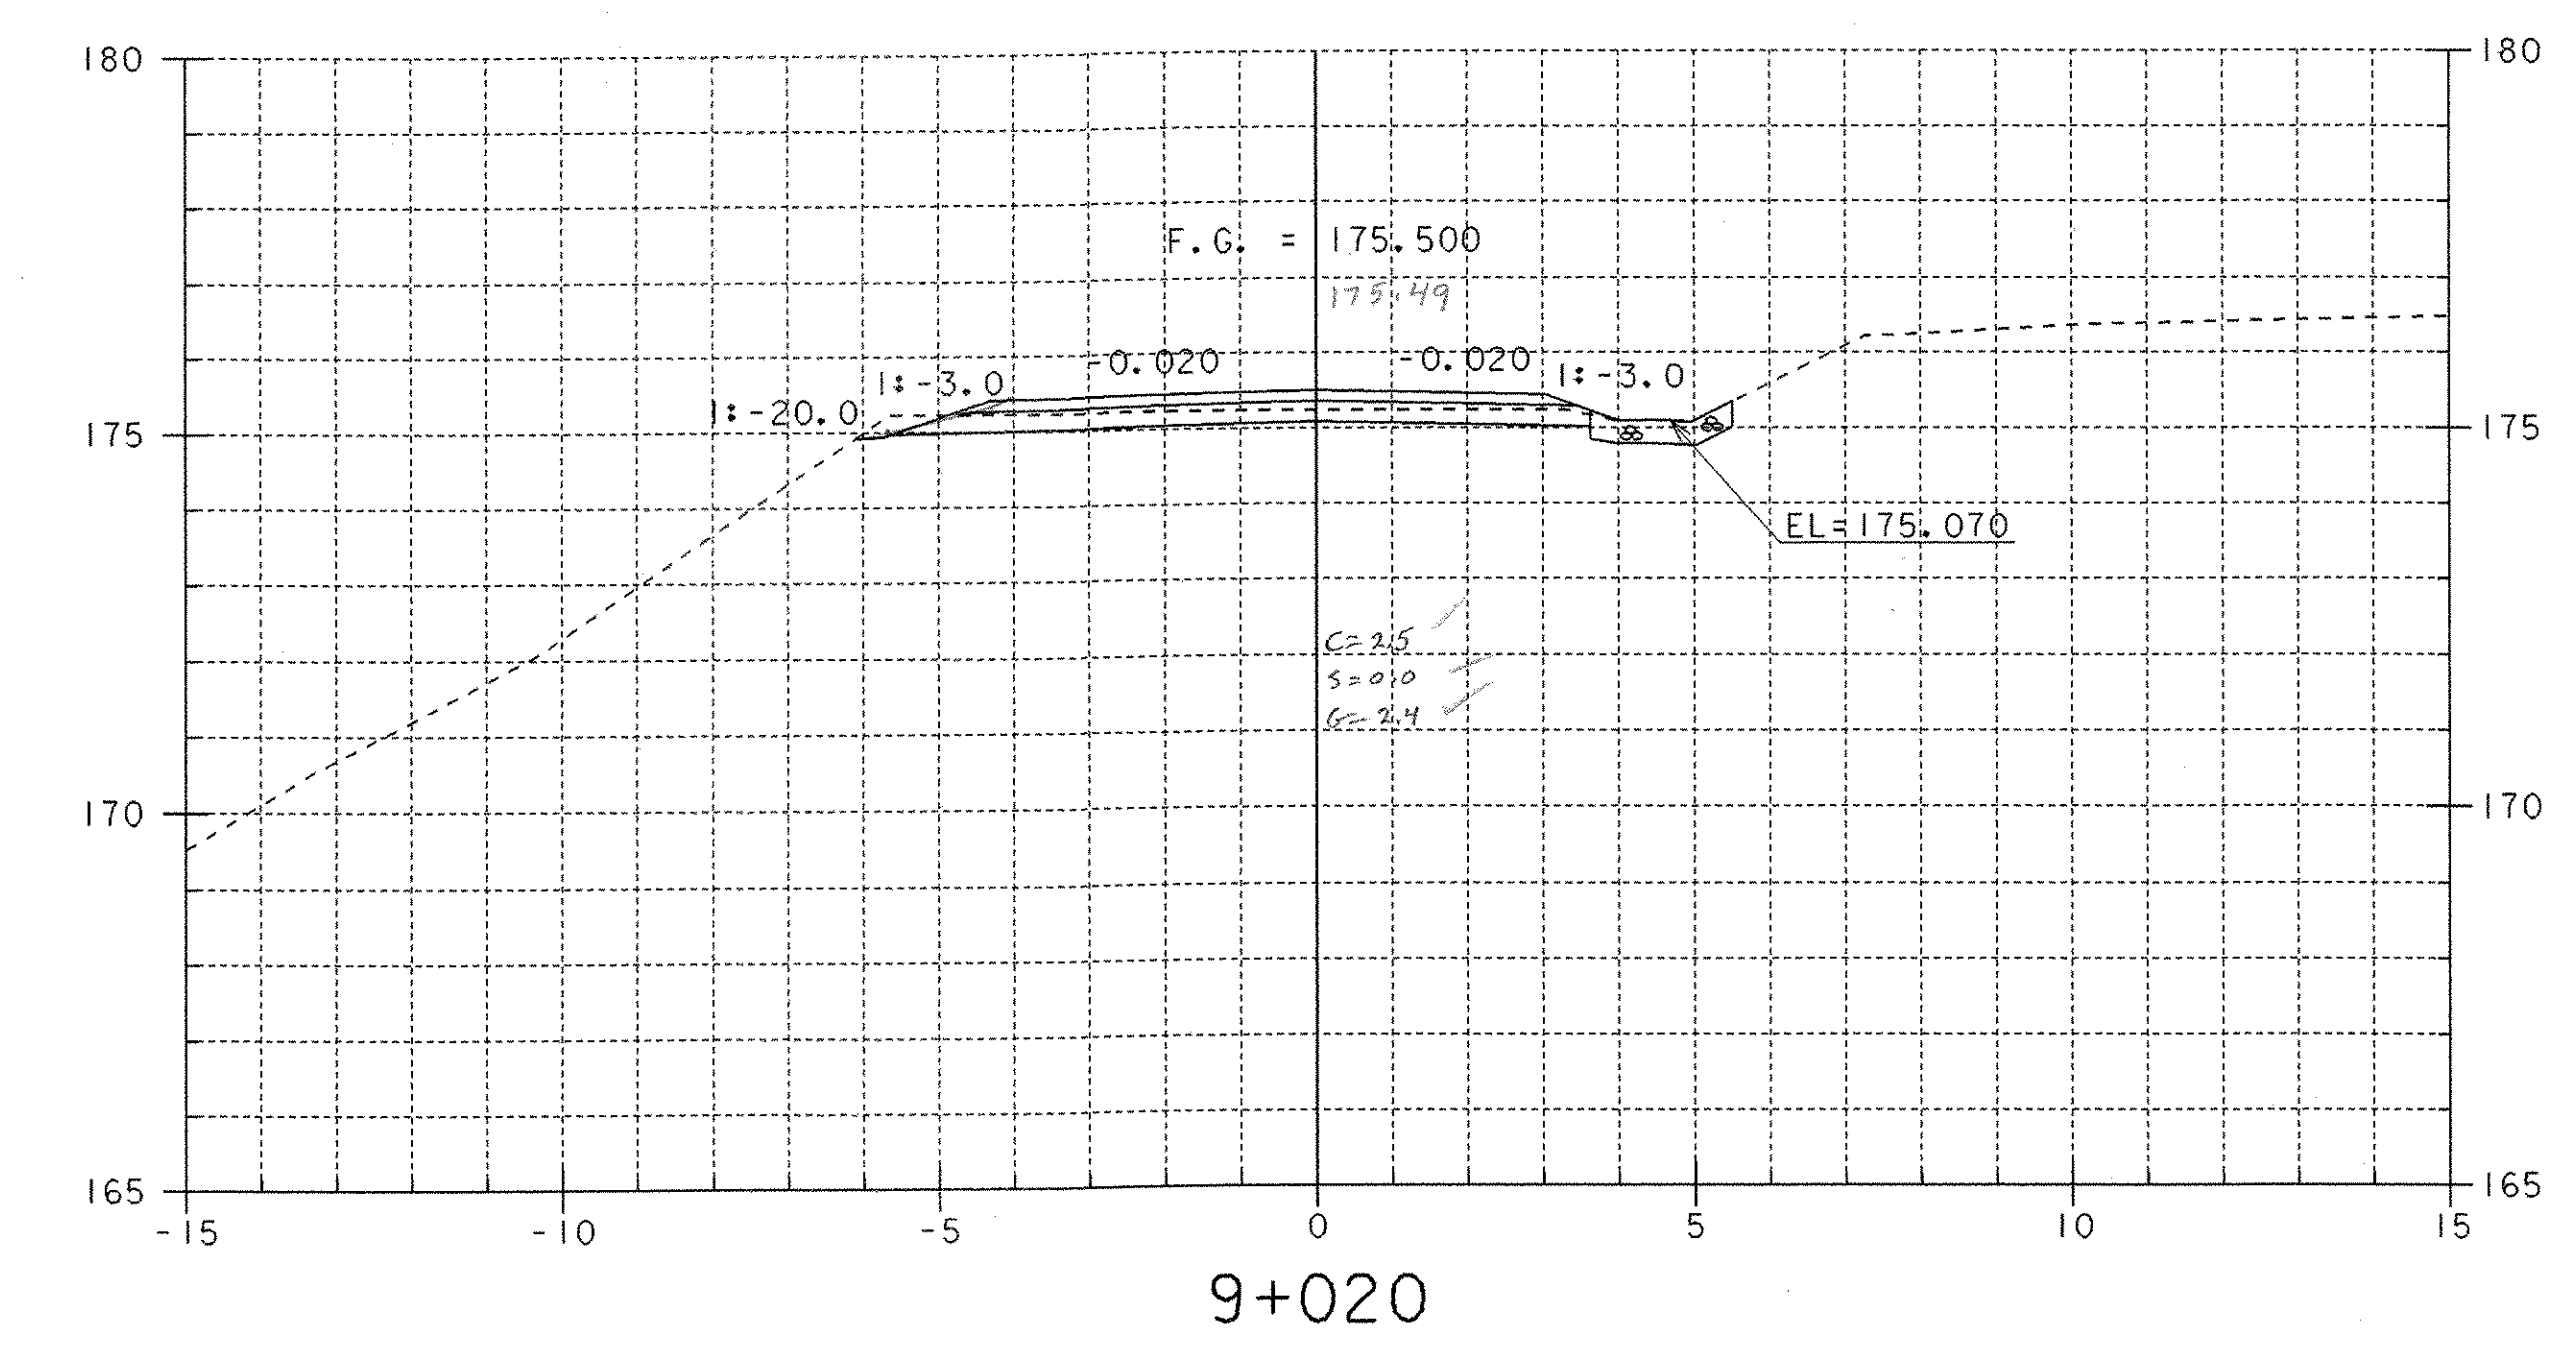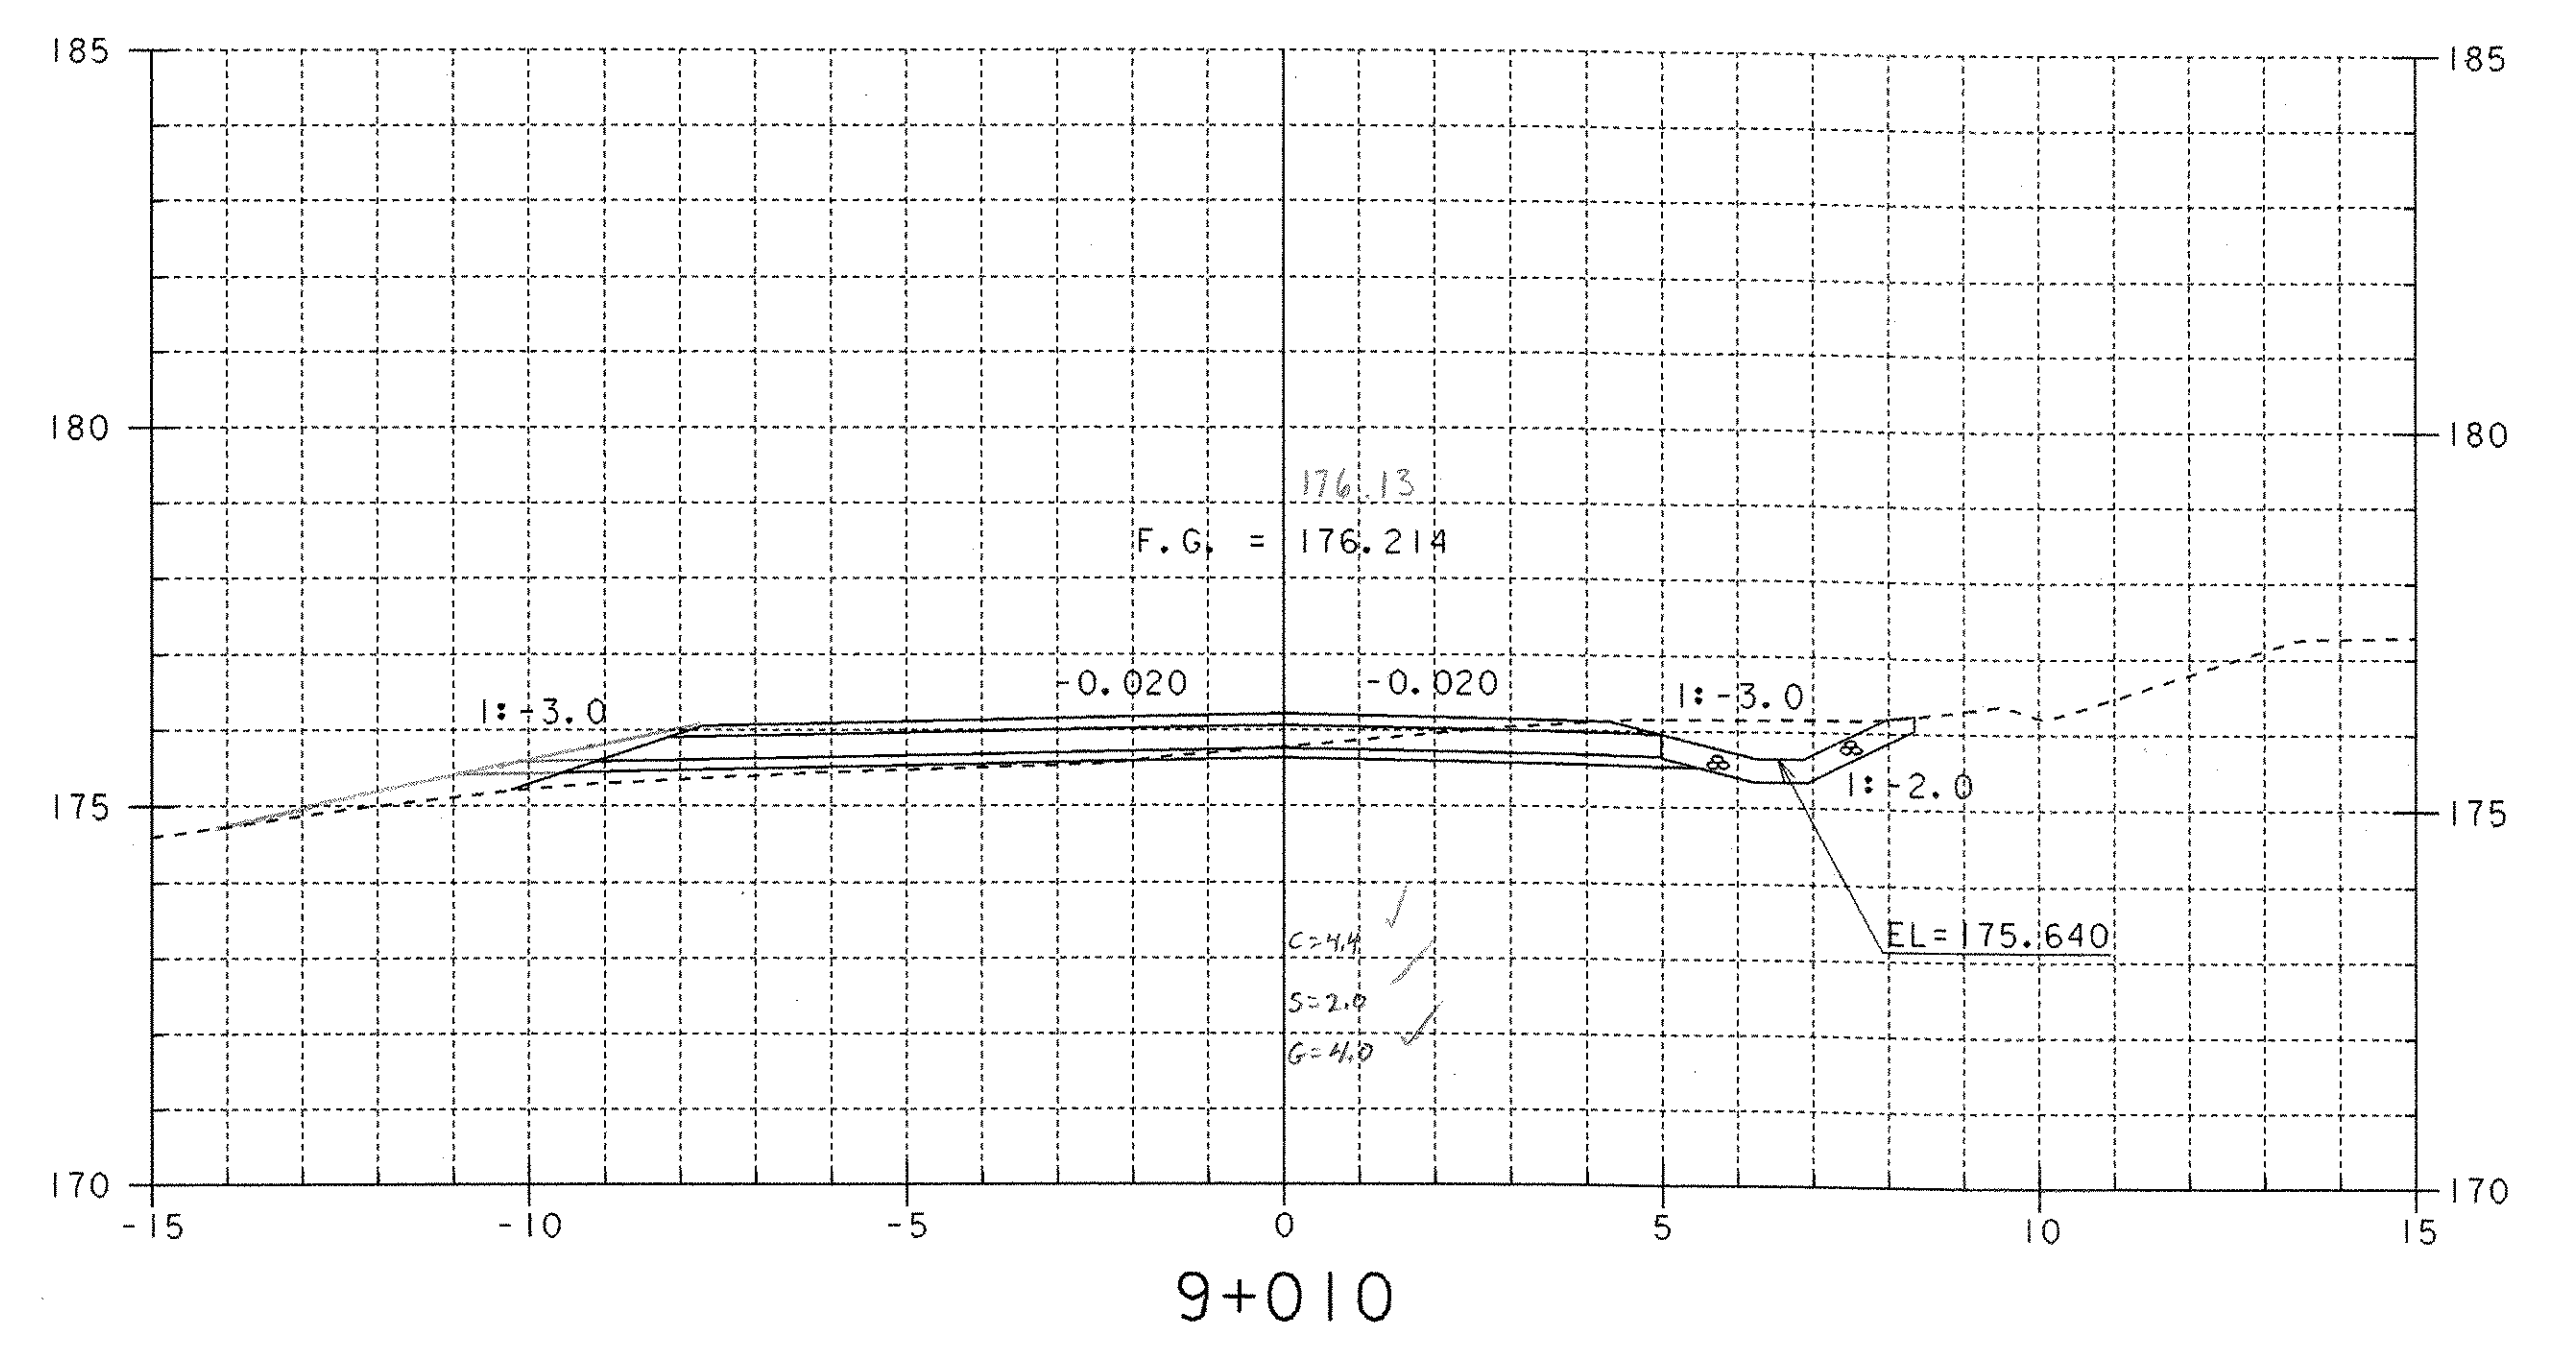


§ STA 9+003.6
 BEGIN SIDELINE APPROACH
 § STA 9+004.6
 BEGIN DITCH

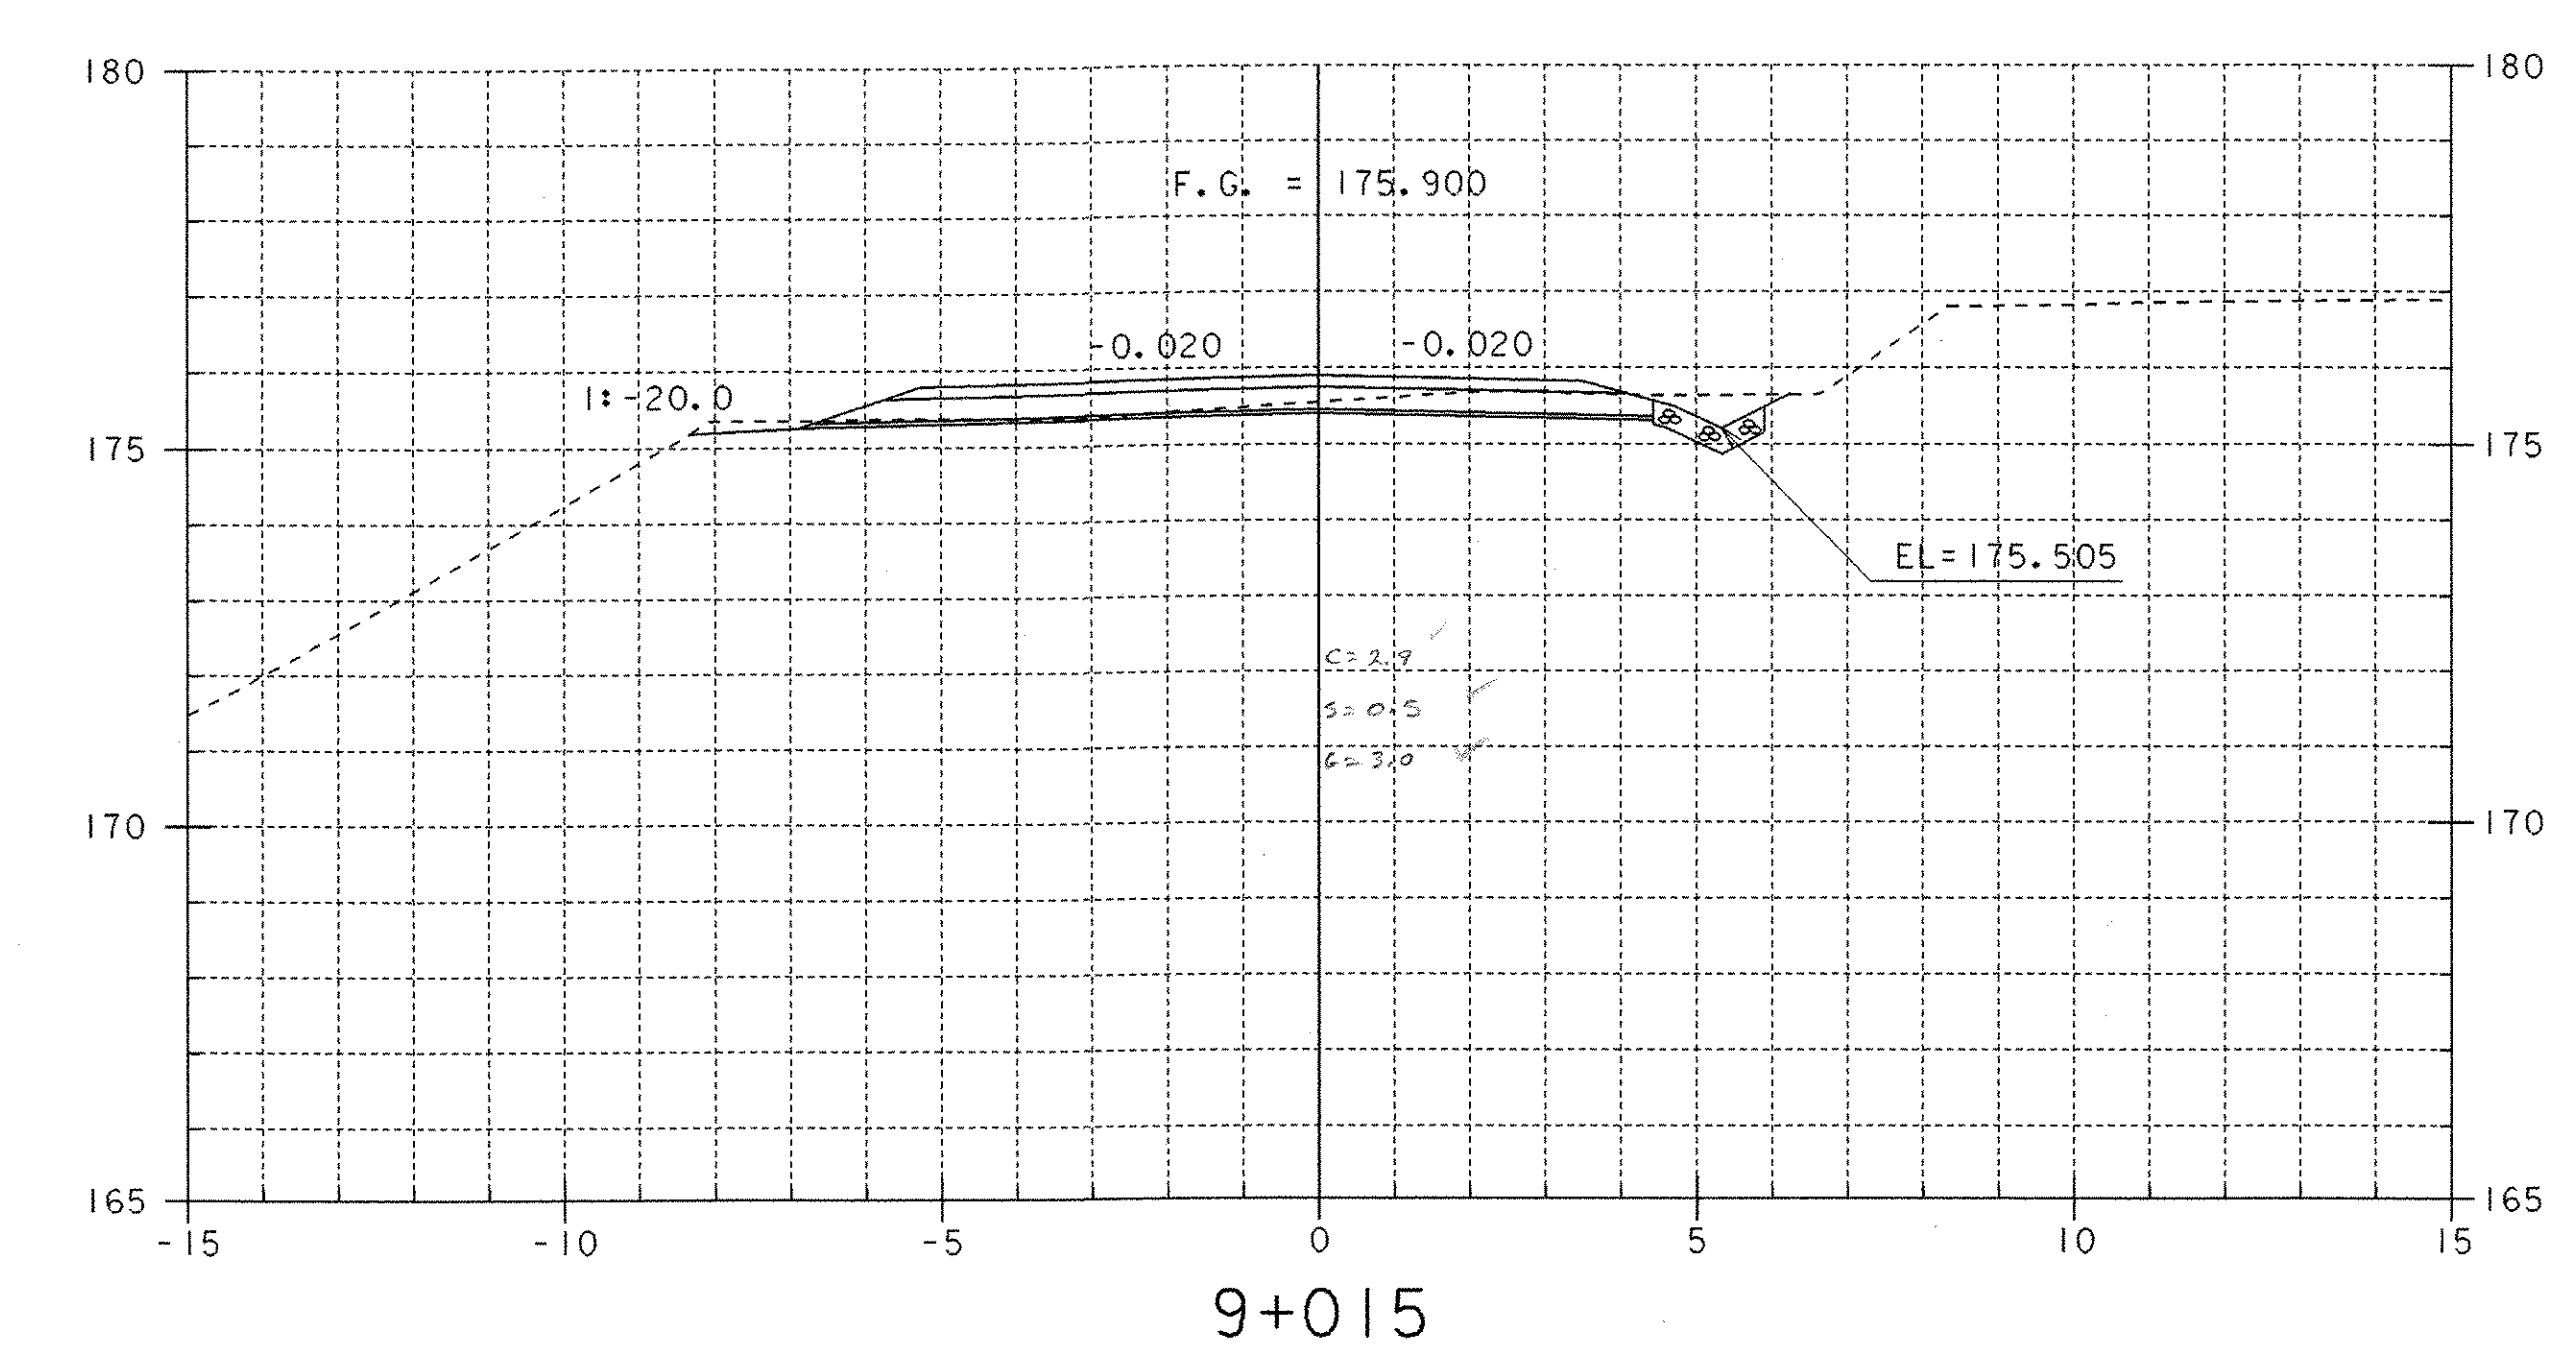

SHEET NAME: SIDELINE CROSS SECTIONS	
PROJECT NAME: WESTFORD	HIGHWAY NO.: TH 4
PROJECT NUMBER: TH2 9436	BRIDGE NO.: 2
	OVER: ROGERS BROOK
FILE NAME: /PW/94J122/sj122xs2.dgn	PLOT DATE: 25-MAR-2005
PROJECT MANAGER: R. R. WHITCOMB	DRAWN BY: STR1
DESIGNED BY: C. CARLSON	IPARM NAME: sj122sxl1
BRIDGE SHEET NUMBER:	SHEET 52 OF 56

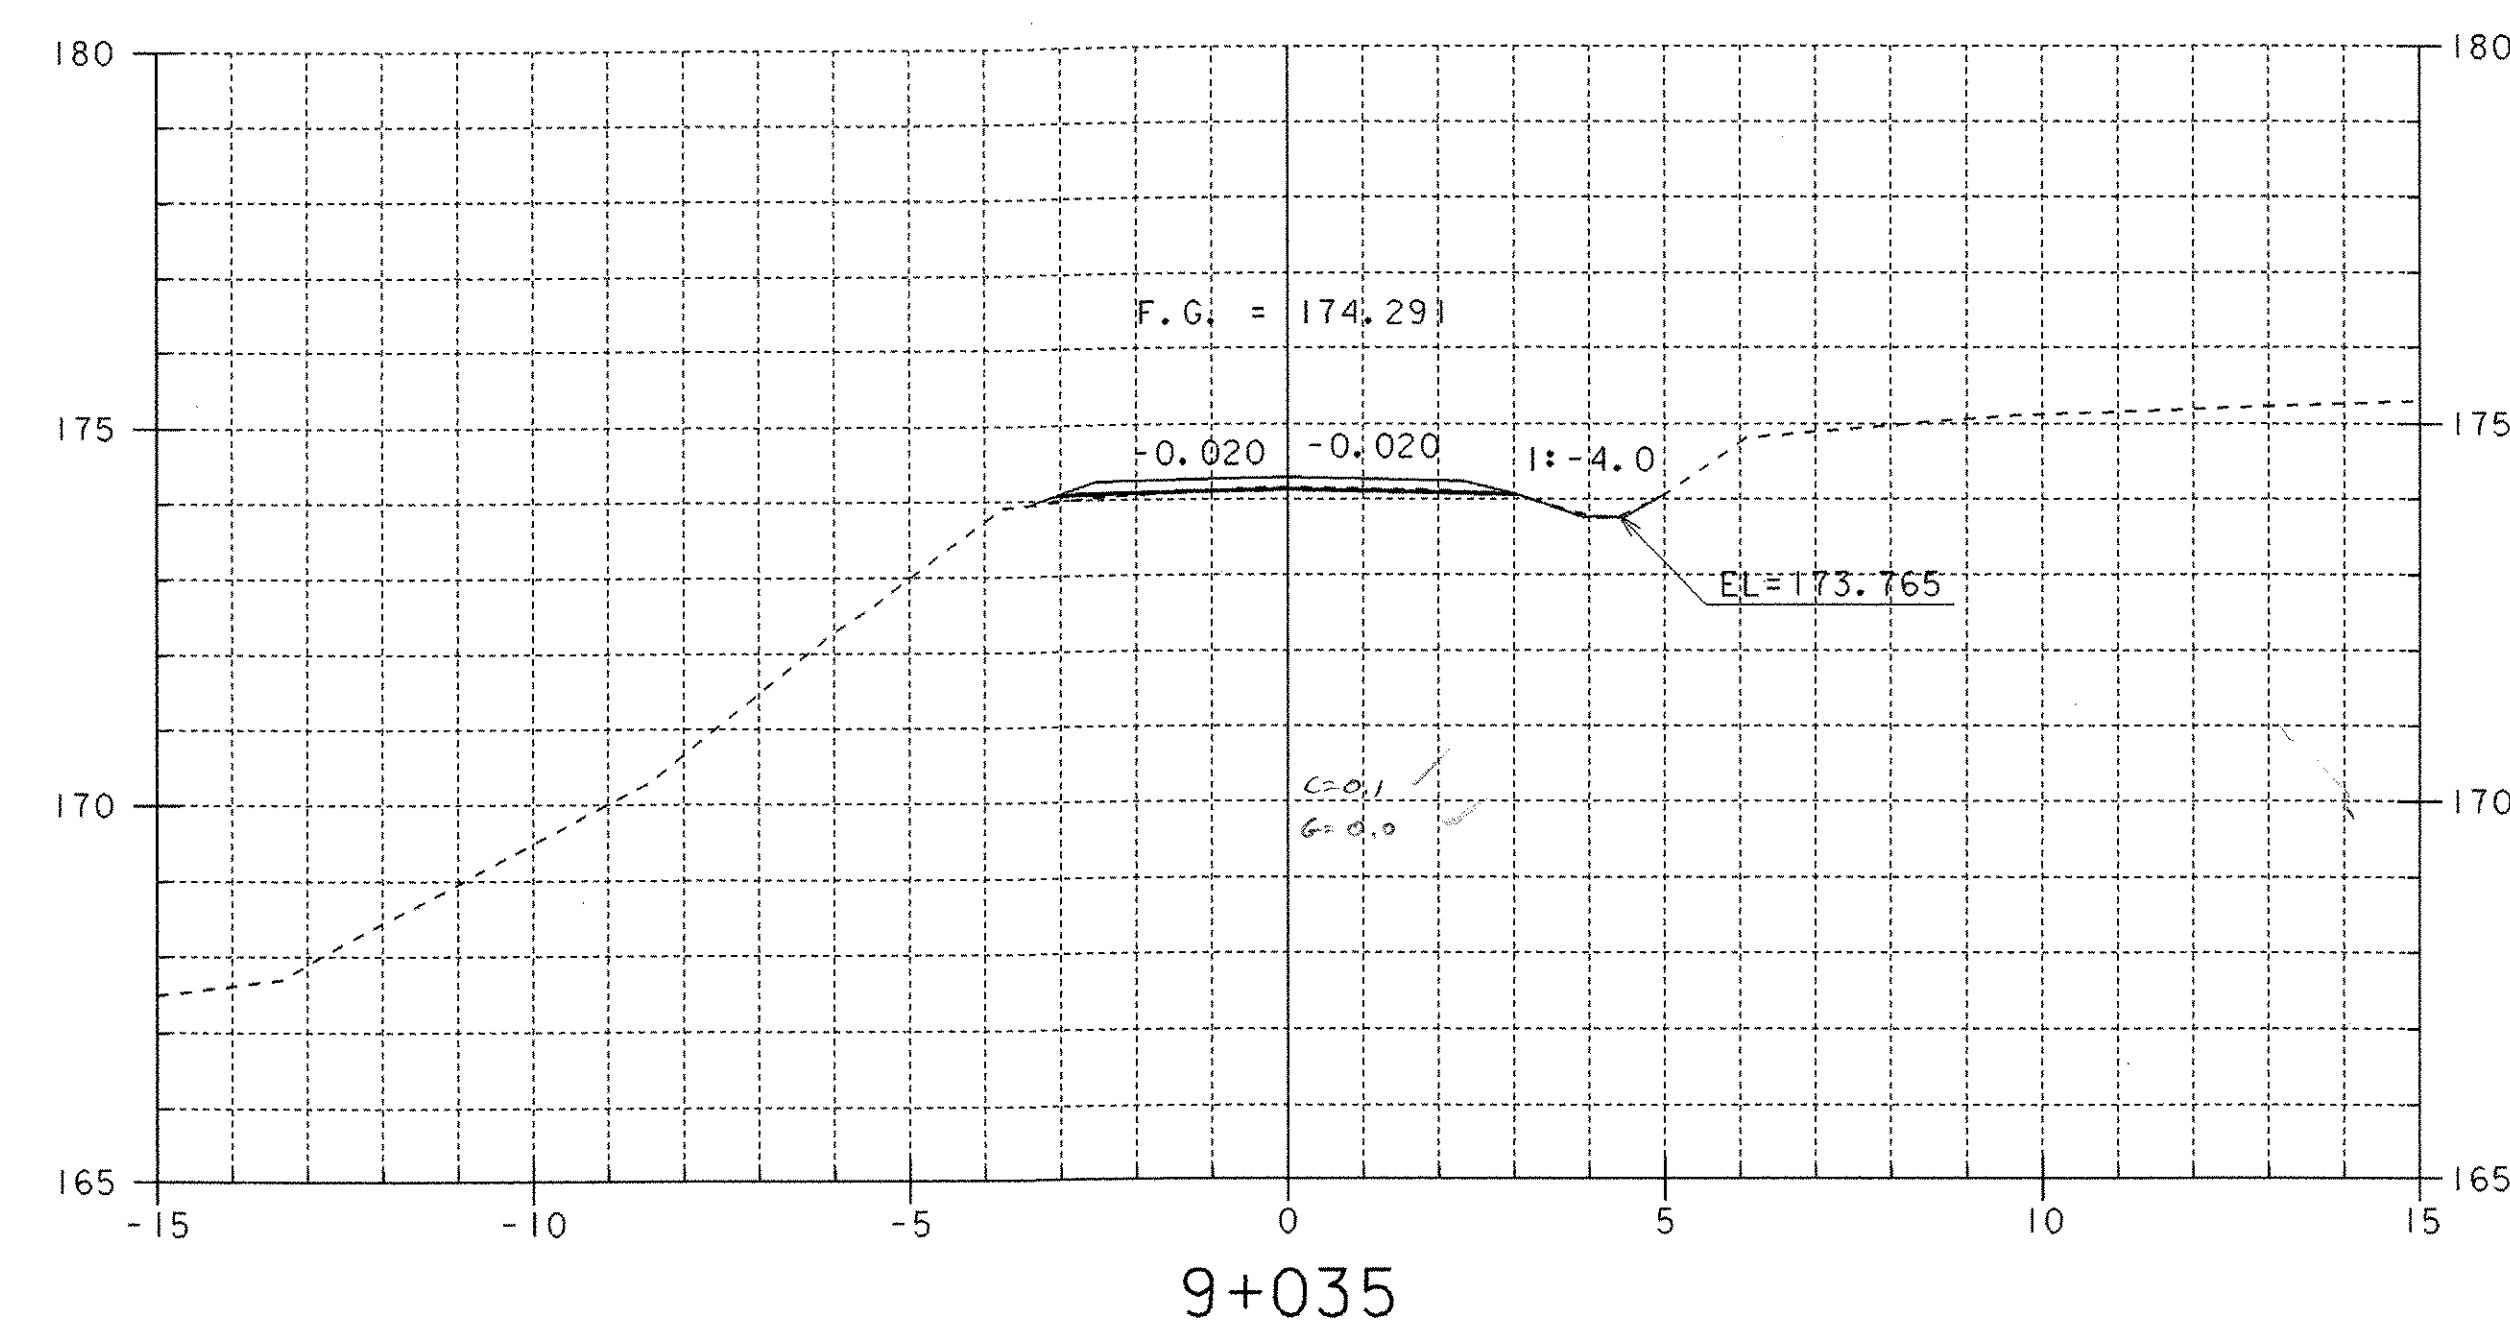
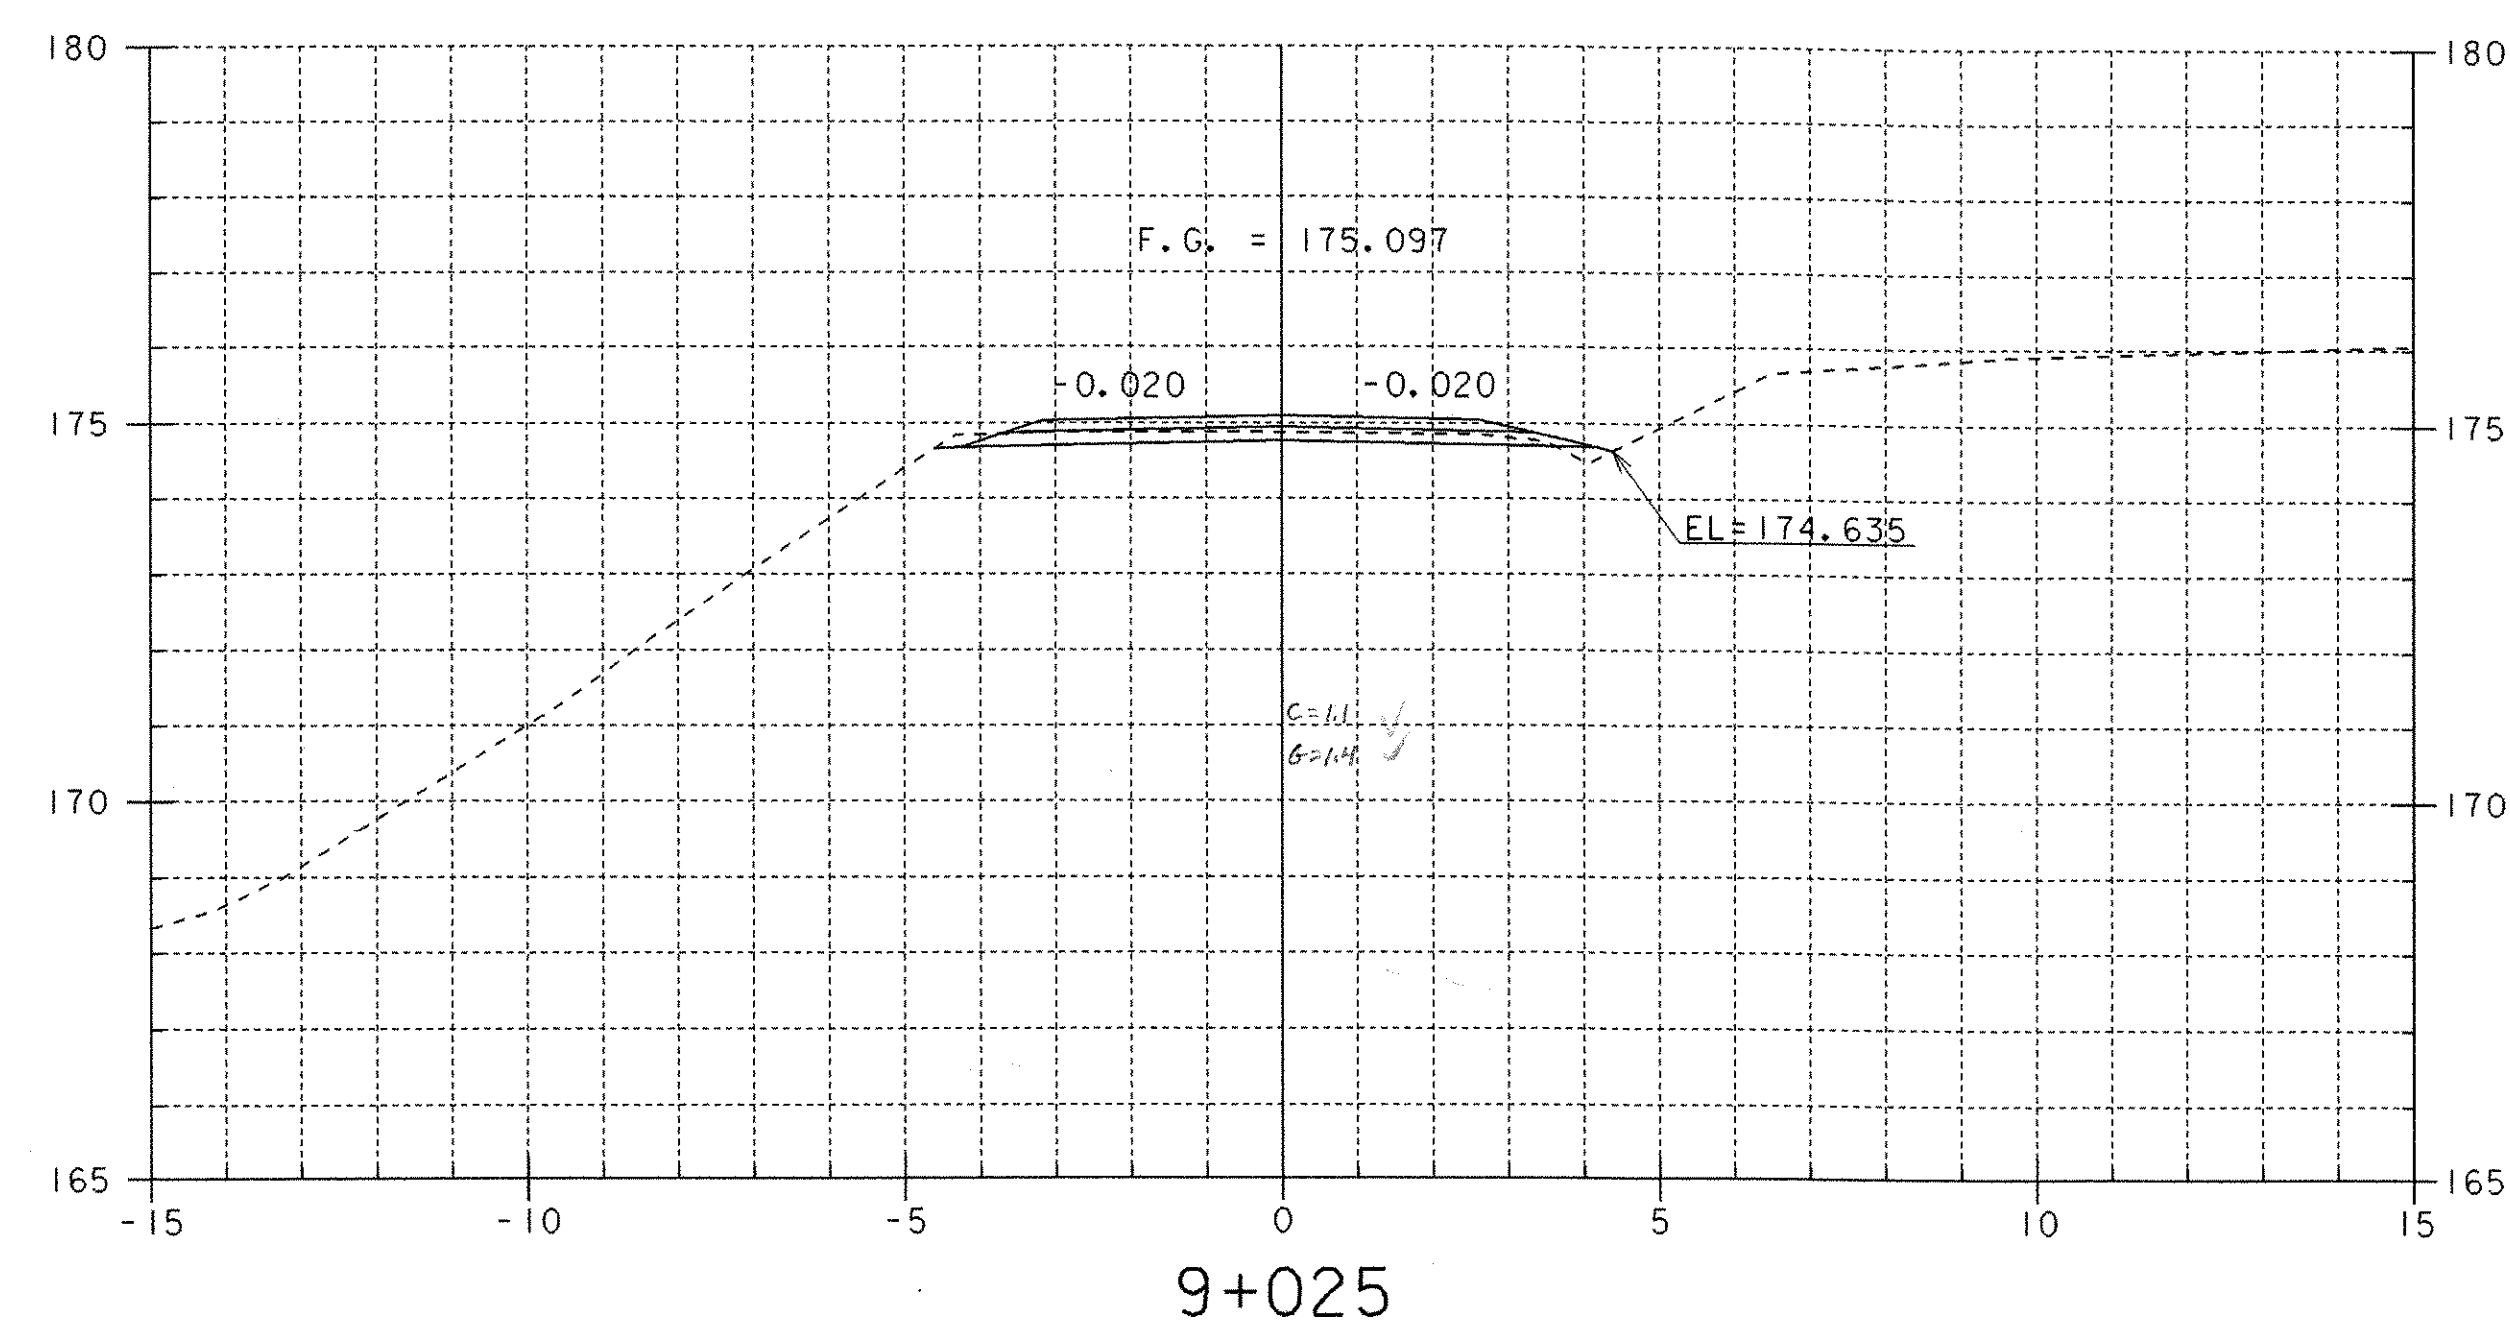
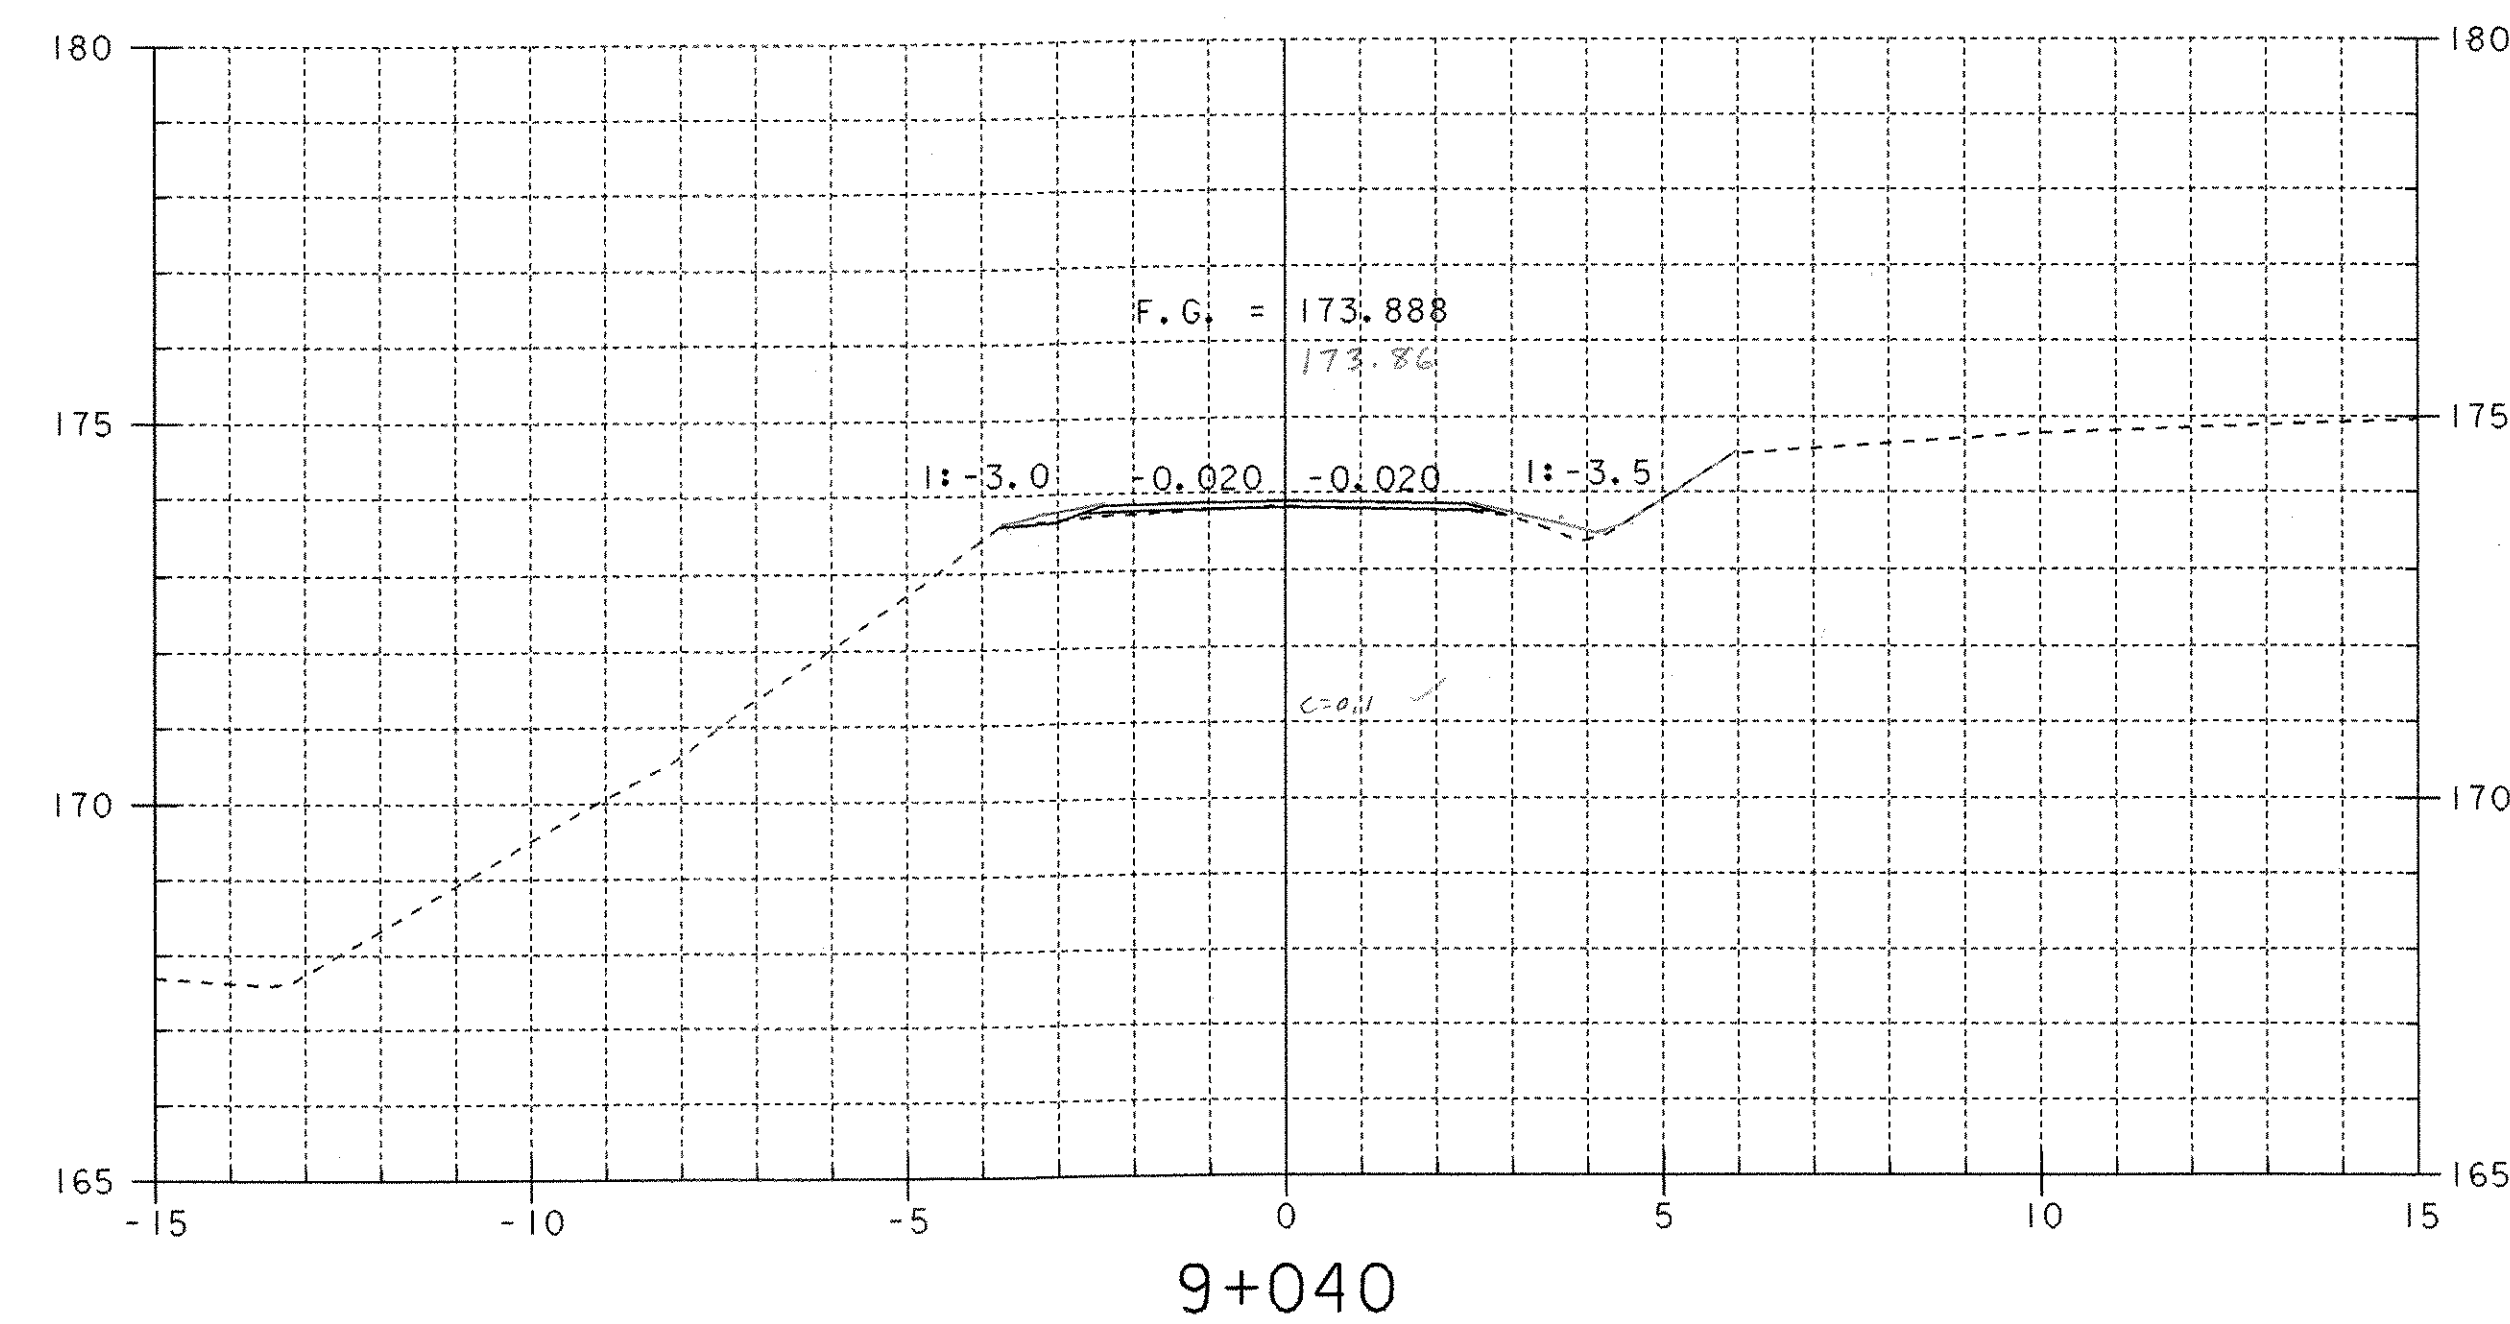
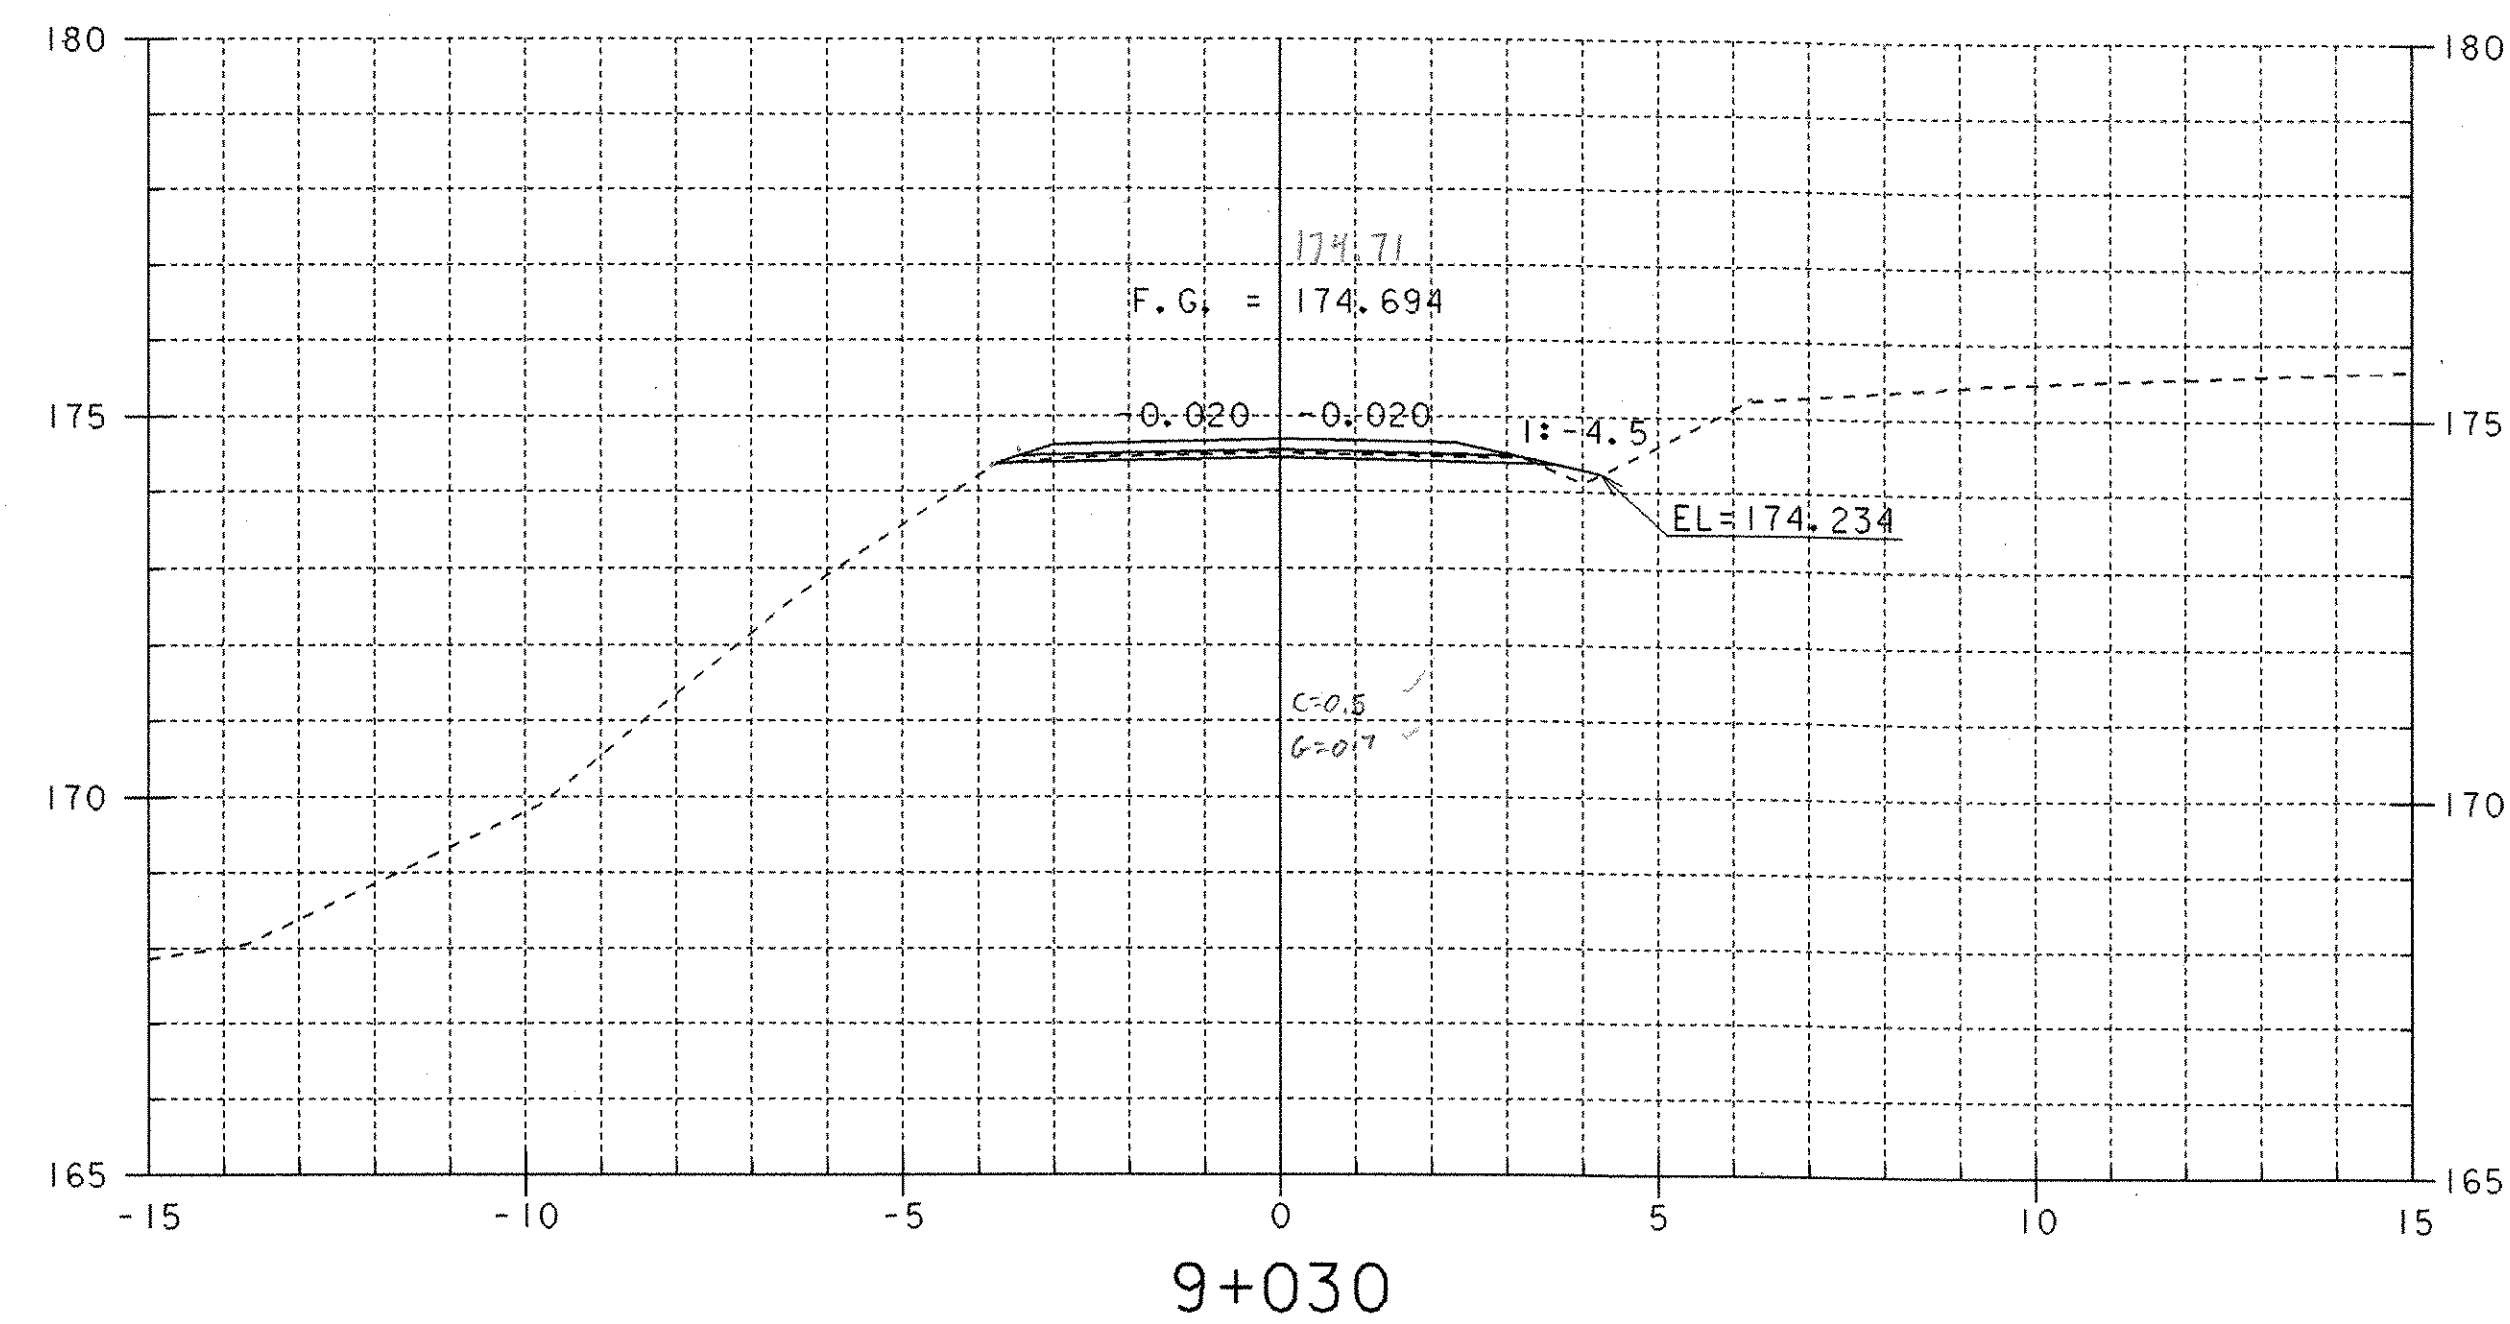


SHEET NAME: SIDELINE CROSS SECTIONS	
PROJECT NAME: WESTFORD	HIGHWAY NO.: TH 4
PROJECT NUMBER: TH2 9436	BRIDGE NO.: 2
	OVER: ROGERS BROOK
FILE NAME: /PW/94J122/sj122xs2.dgn	PLOT DATE: 25-MAR-2005
PROJECT MANAGER: R. R. WHITCOMB	DRAWN BY: STRI
DESIGNED BY: C. CARLSON	IPARM NAME: sj122sxs2.1
BRIDGE SHEET NUMBER:	SHEET 53 OF 56

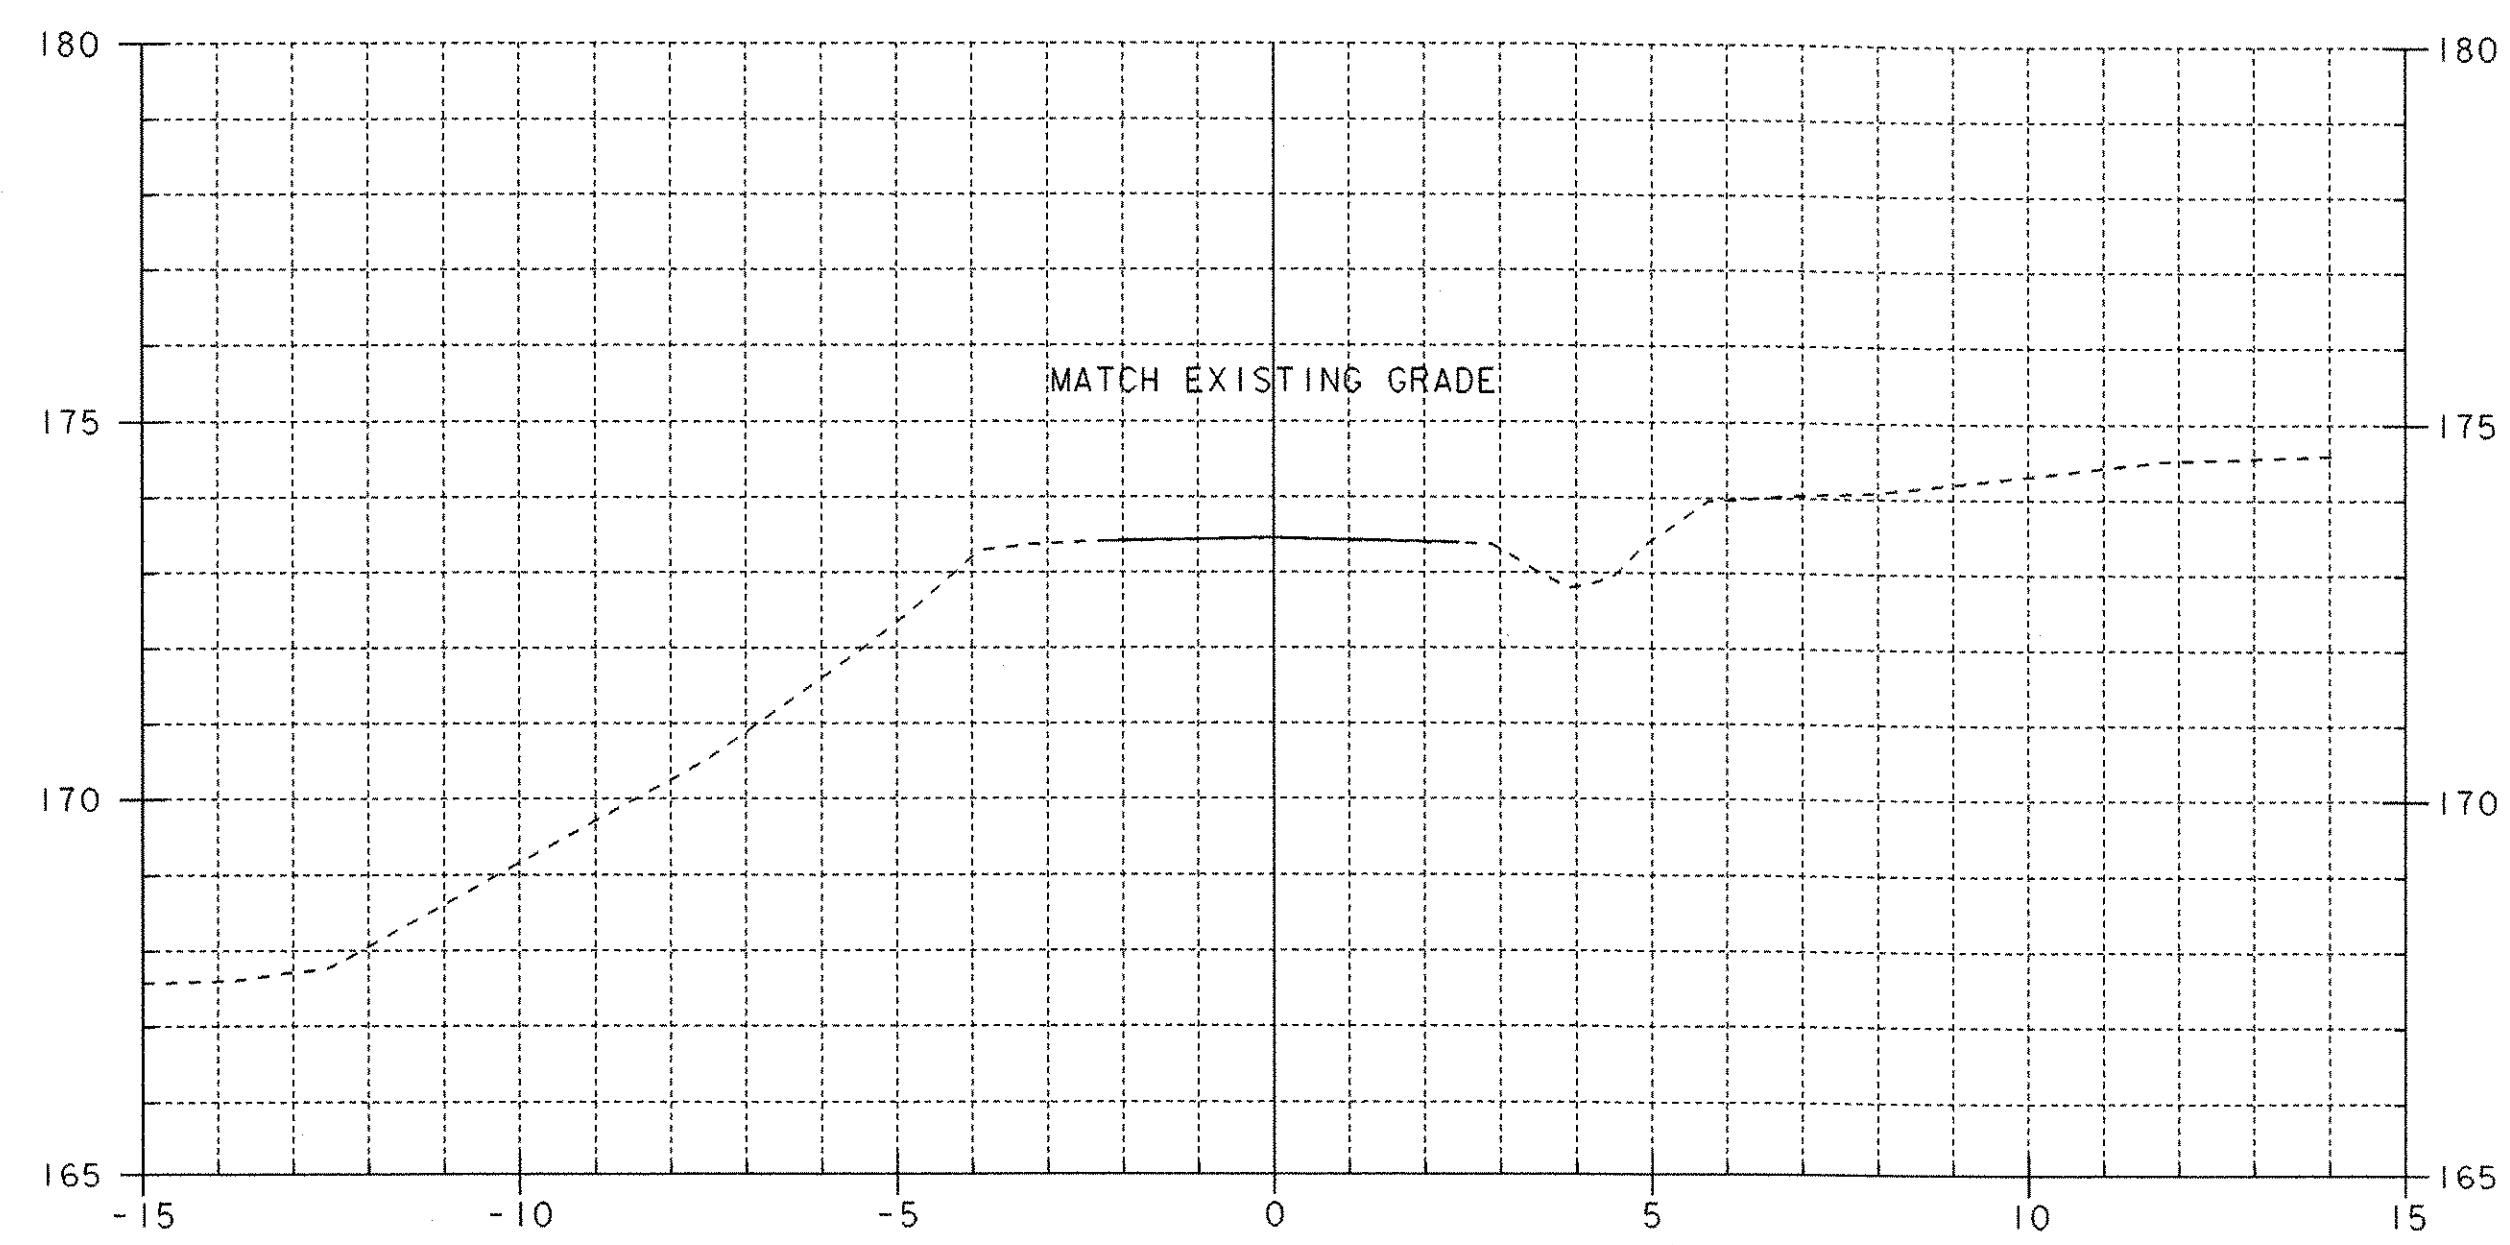

§ 9+045
END SIDELINE APPROACH

SHEET NAME: SIDELINE CROSS SECTIONS	
PROJECT NAME: WESTFORD	HIGHWAY NO.: TH 4
PROJECT NUMBER: TH2 9436	BRIDGE NO.: 2
	OVER: ROGERS BROOK
FILE NAME: /PW/94J122/sj122xs2.dgn	PLOT DATE: 25-MAR-2005
PROJECT MANAGER: R. R. WHITCOMB	DRAWN BY: STRI
DESIGNED BY: C. CARLSON	IPARM NAME: sj122sx3.1
BRIDGE SHEET NUMBER:	SHEET 54 OF 56

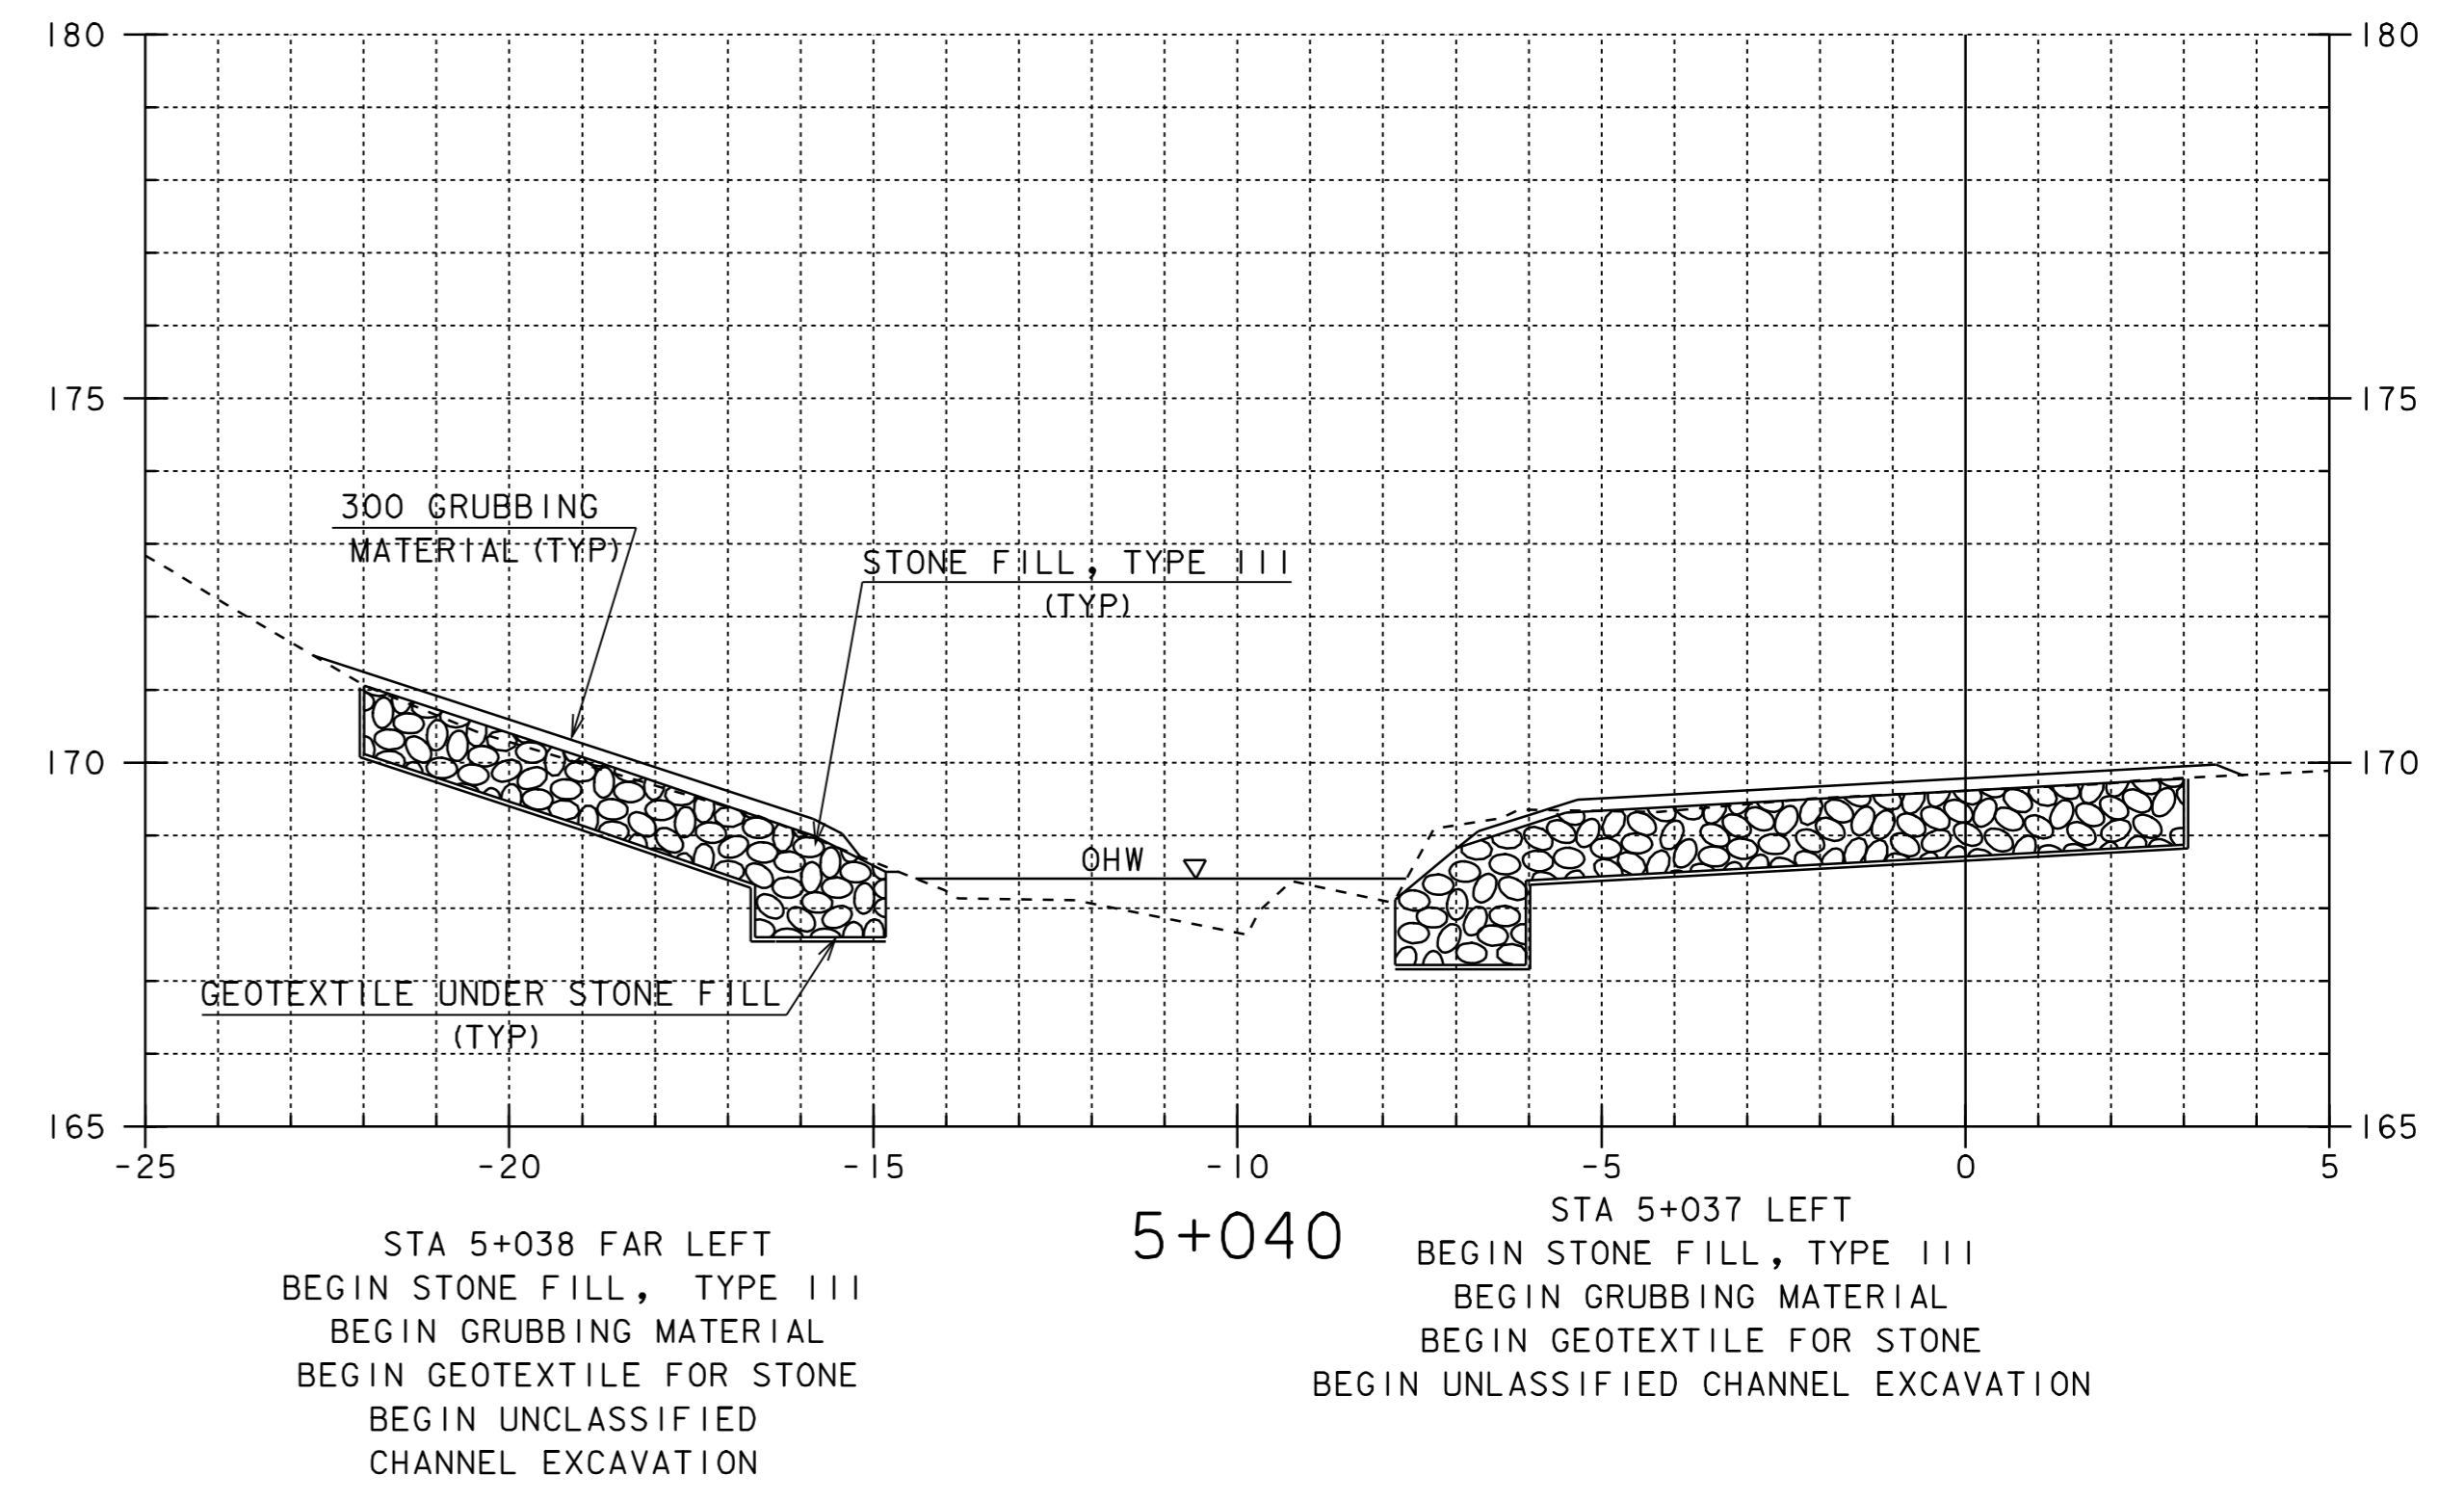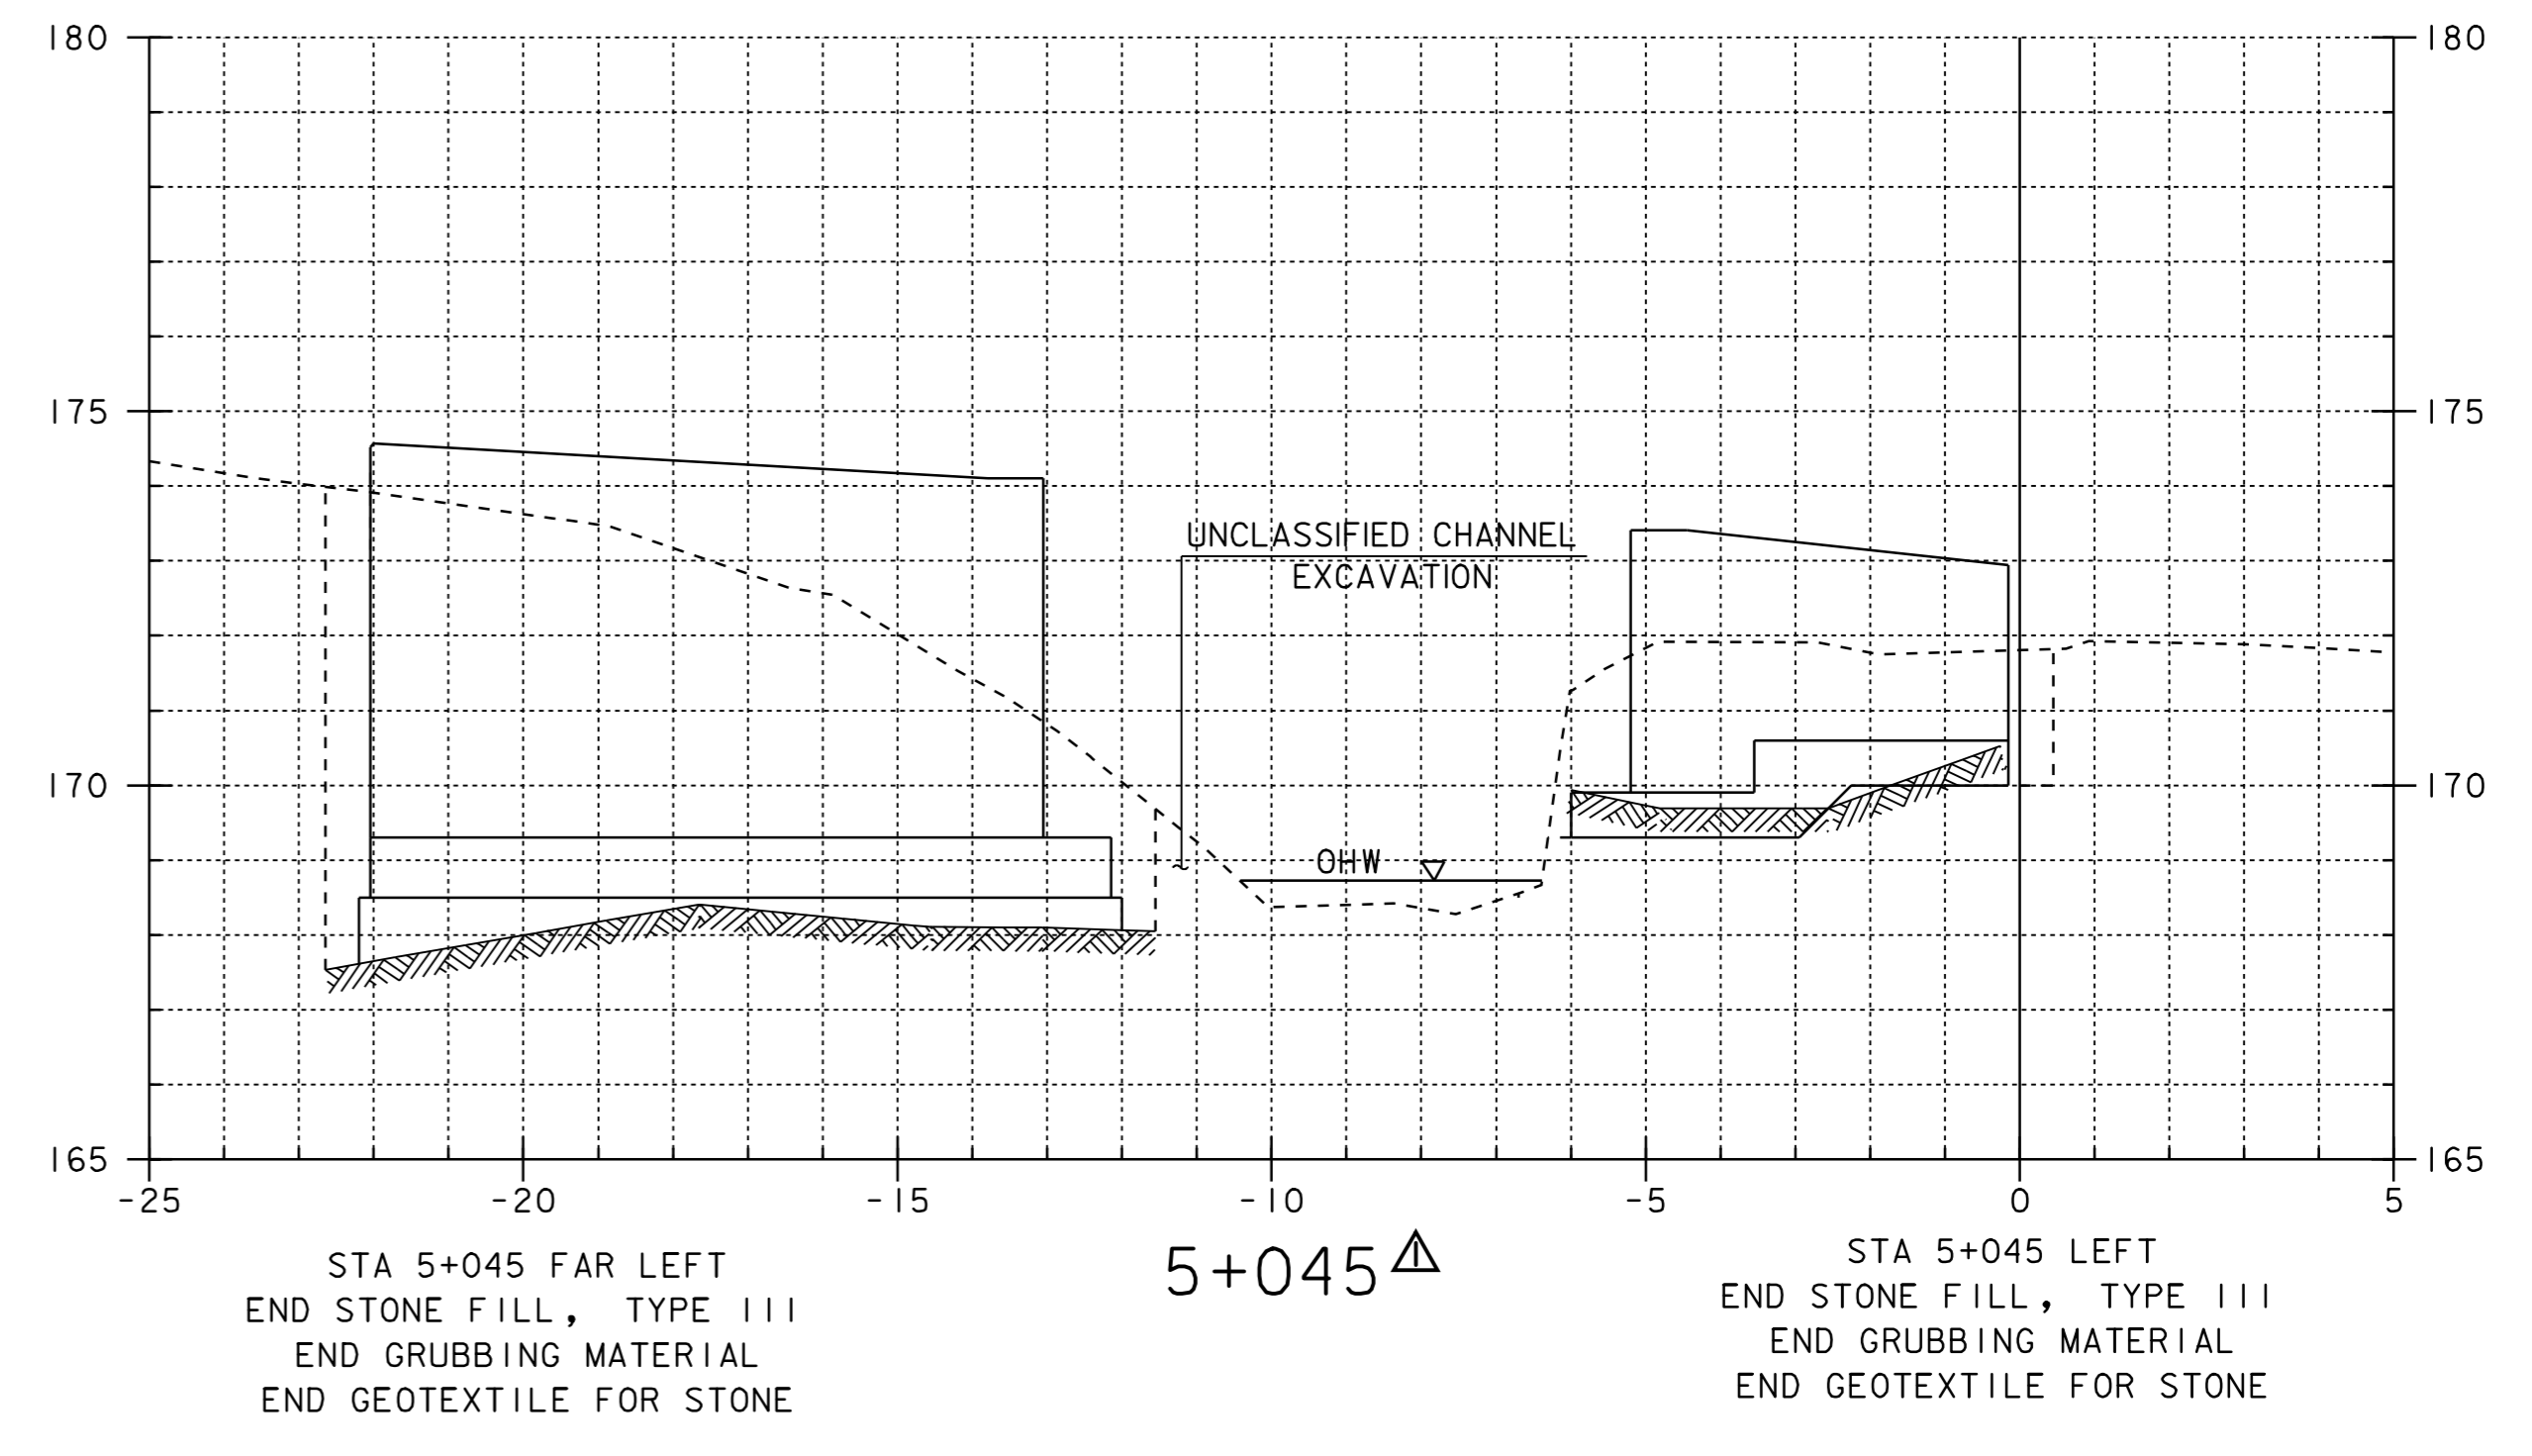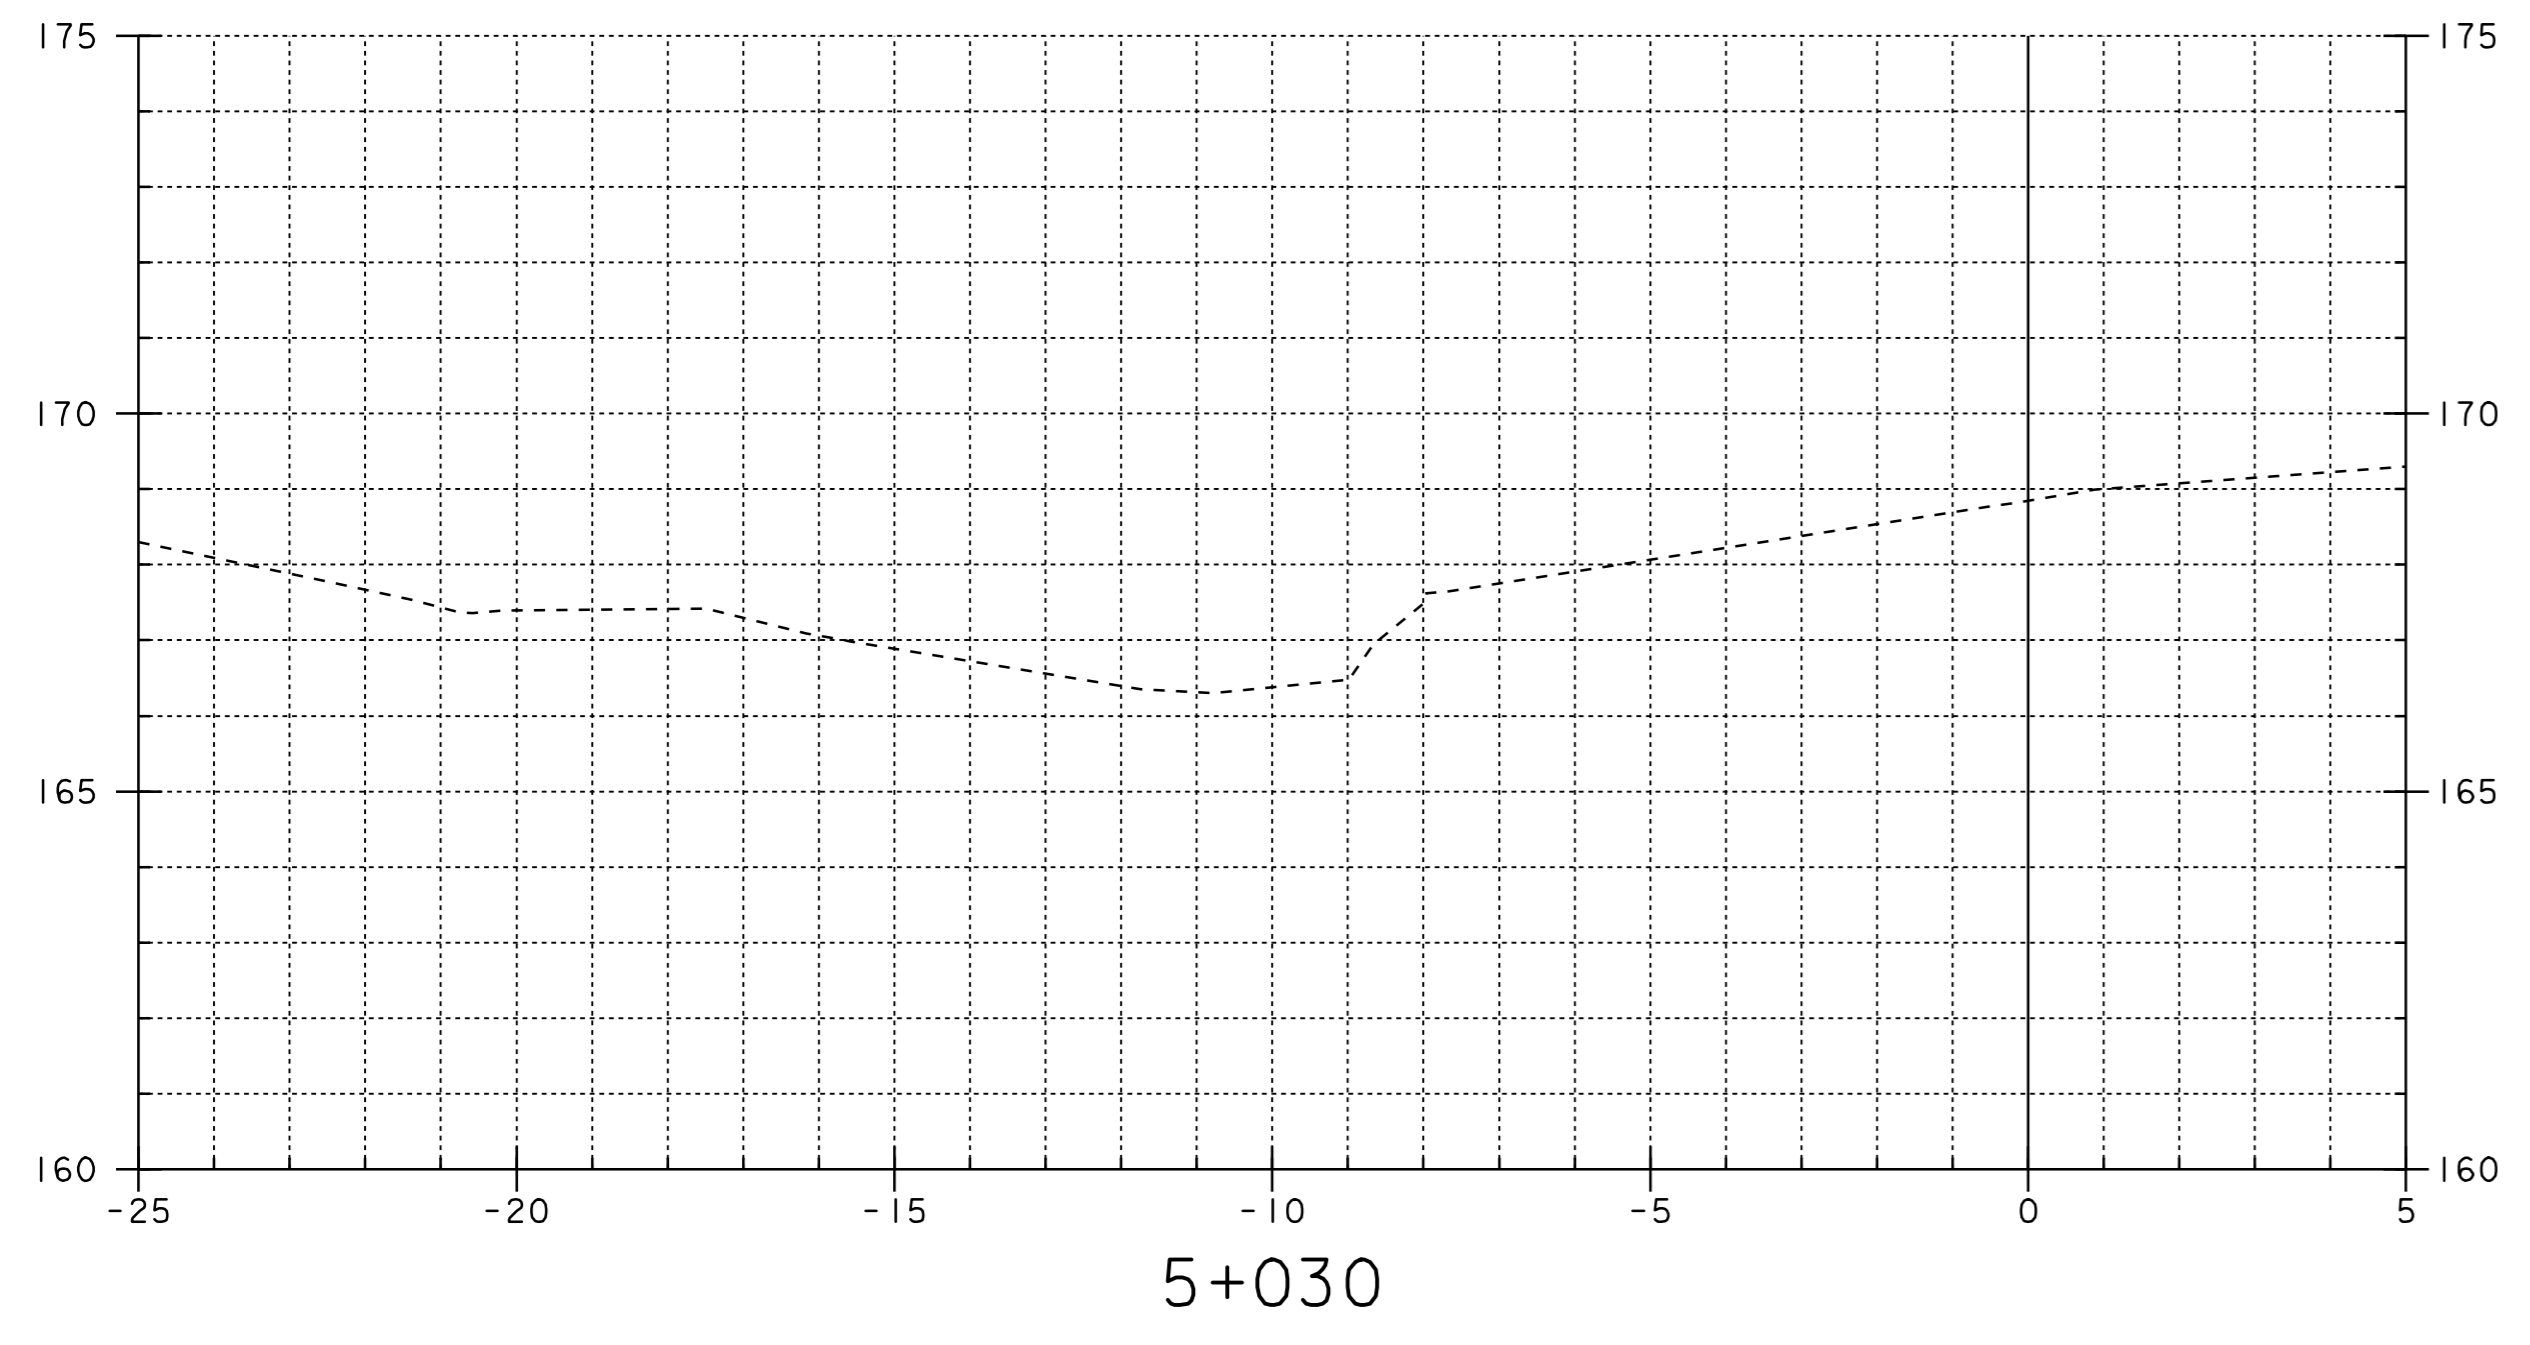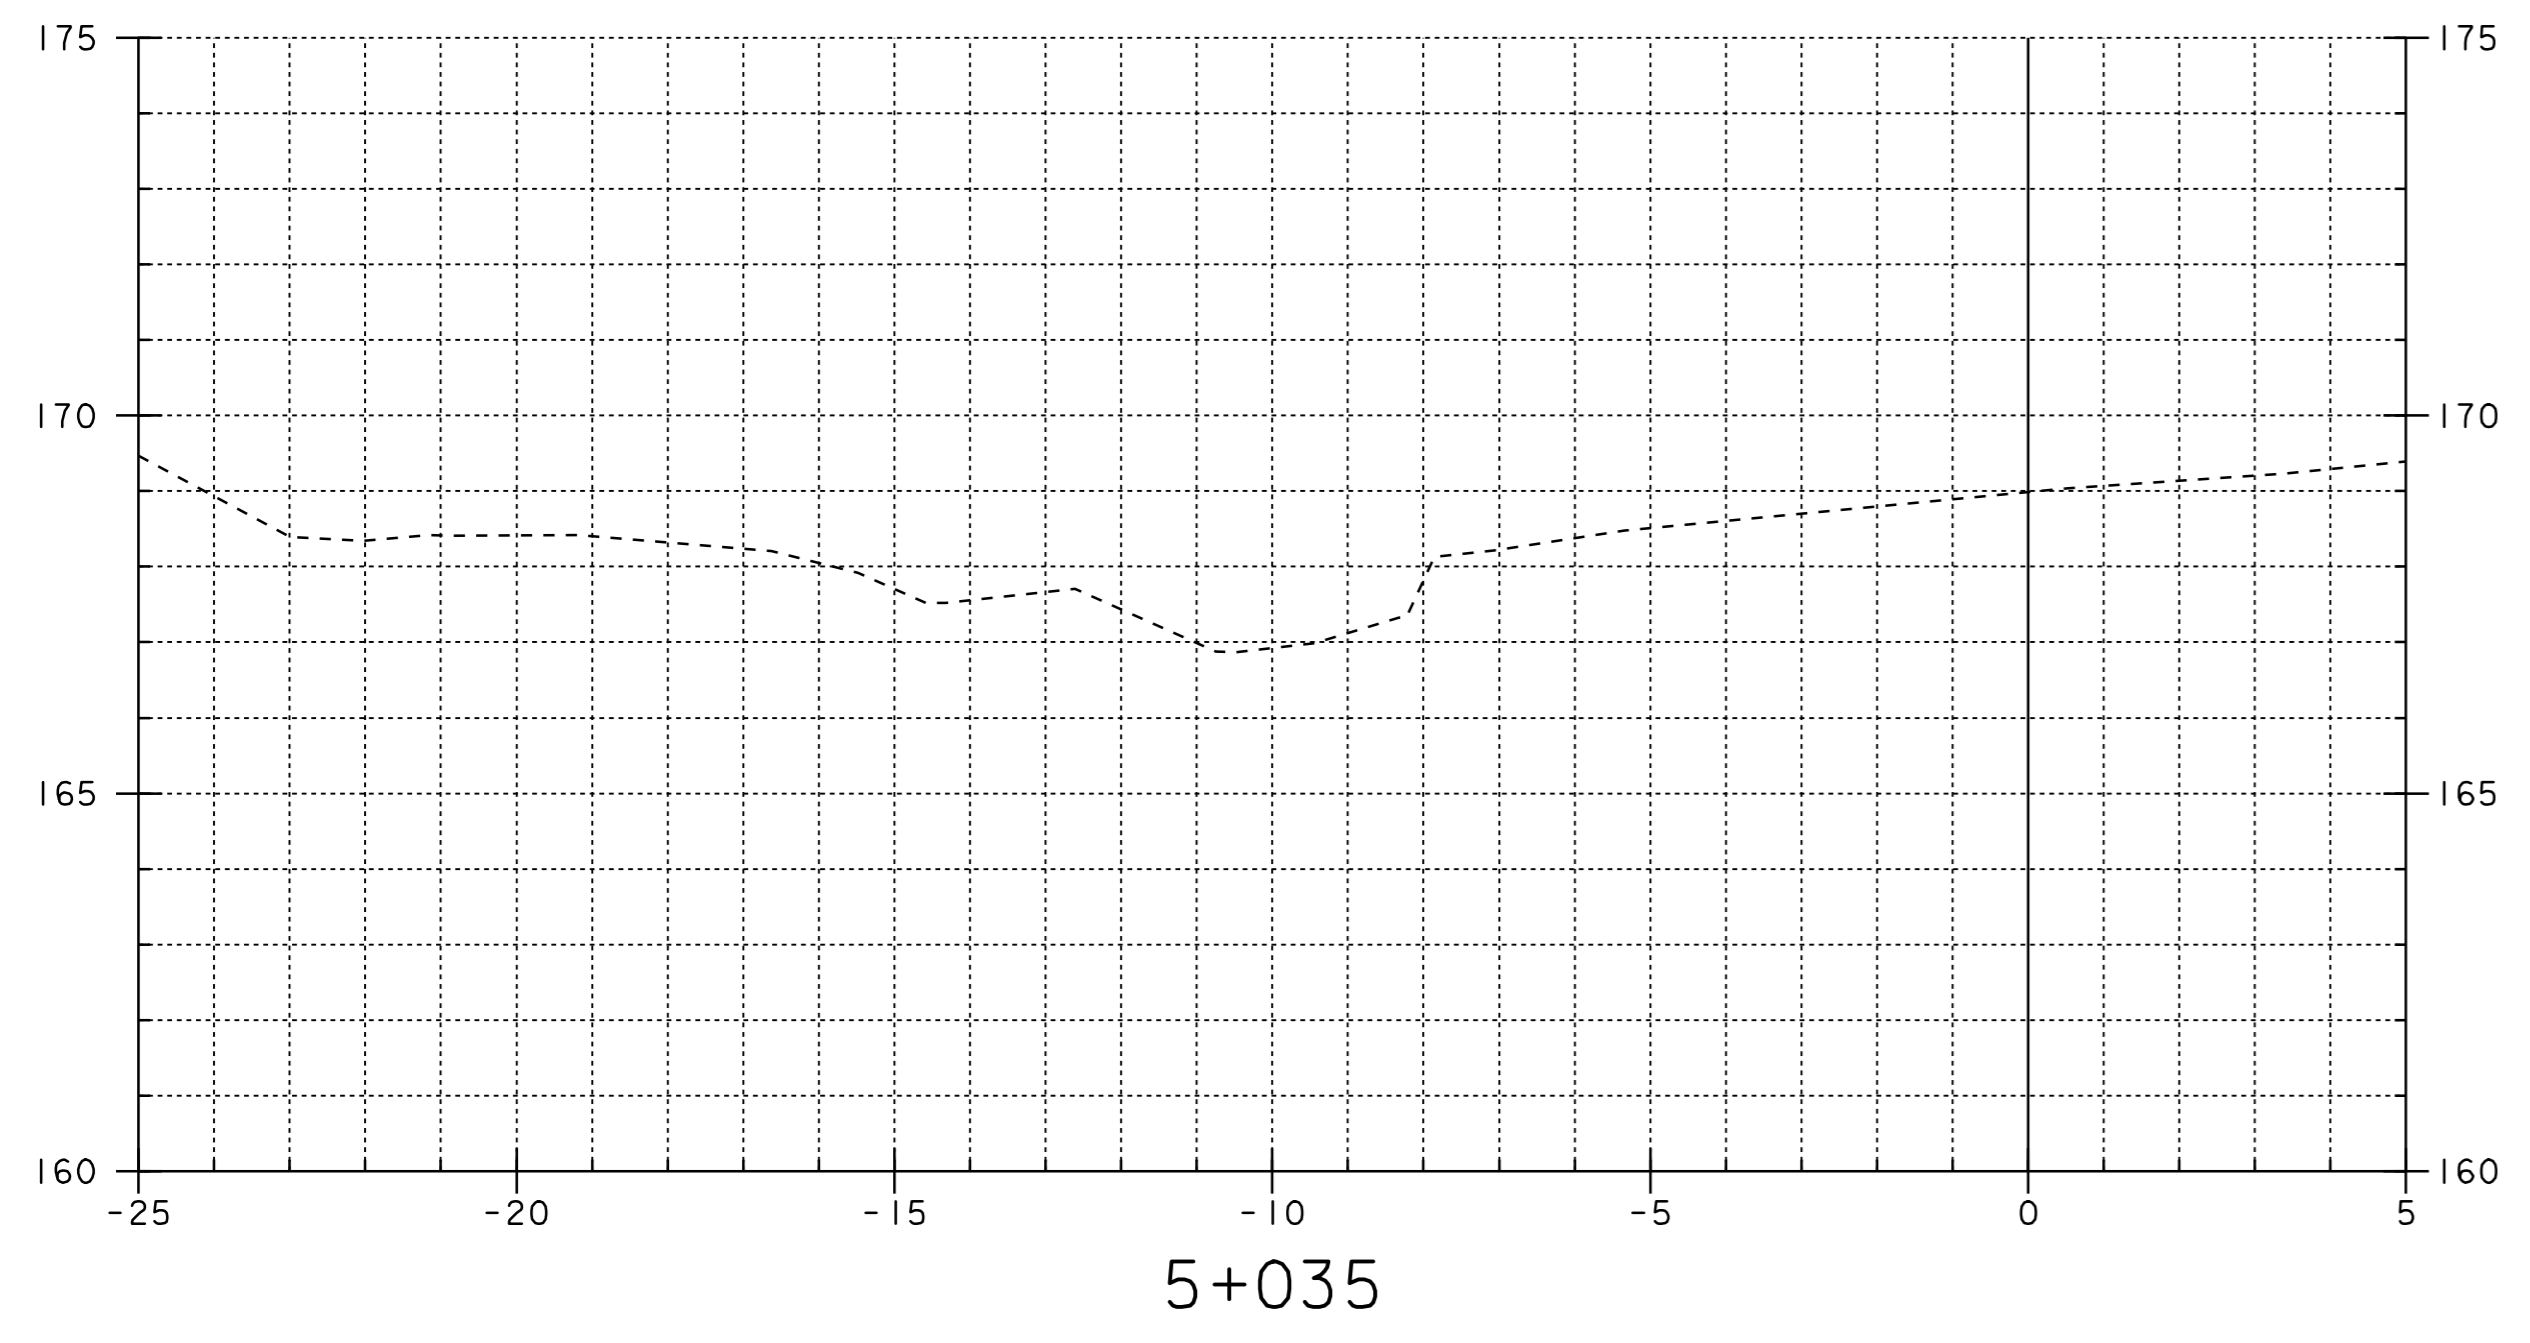



SHEET NAME: CHANNEL CROSS SECTIONS

PROJECT NAME: WESTFORD HIGHWAY NO.: IH 4
 PROJECT NUMBER: IH2_9436 BRIDGE NO.: 2
 OVER: ROGERS BROOK


FILE NAME: ZPW\941\22\sj122xs2.dgn PLOT DATE: 22-DEC-2006
 PROJECT MANAGER: B. B. WHITCOMB DRAWN BY: SIRI
 DESIGNED BY: C. CARLSON IPARM NAME: sj122cxl1
 BRIDGE SHEET NUMBER: SHEET 55 OF 56

REVISION	DATE	BY	CHK'D	DESCRIPTION
Δ	06/27/2005	GFR	CWC	ABUTMENTS MODIFIED DUE TO UPDATED LEDGE INFORMATION.

STA 5+062 FAR LEFT
 END STONE FILL, TYPE III
 END GRUBBING MATERIAL
 END GEOTEXTILE FOR STONE
 END UNCLASSIFIED CHANNEL EXCAVATION

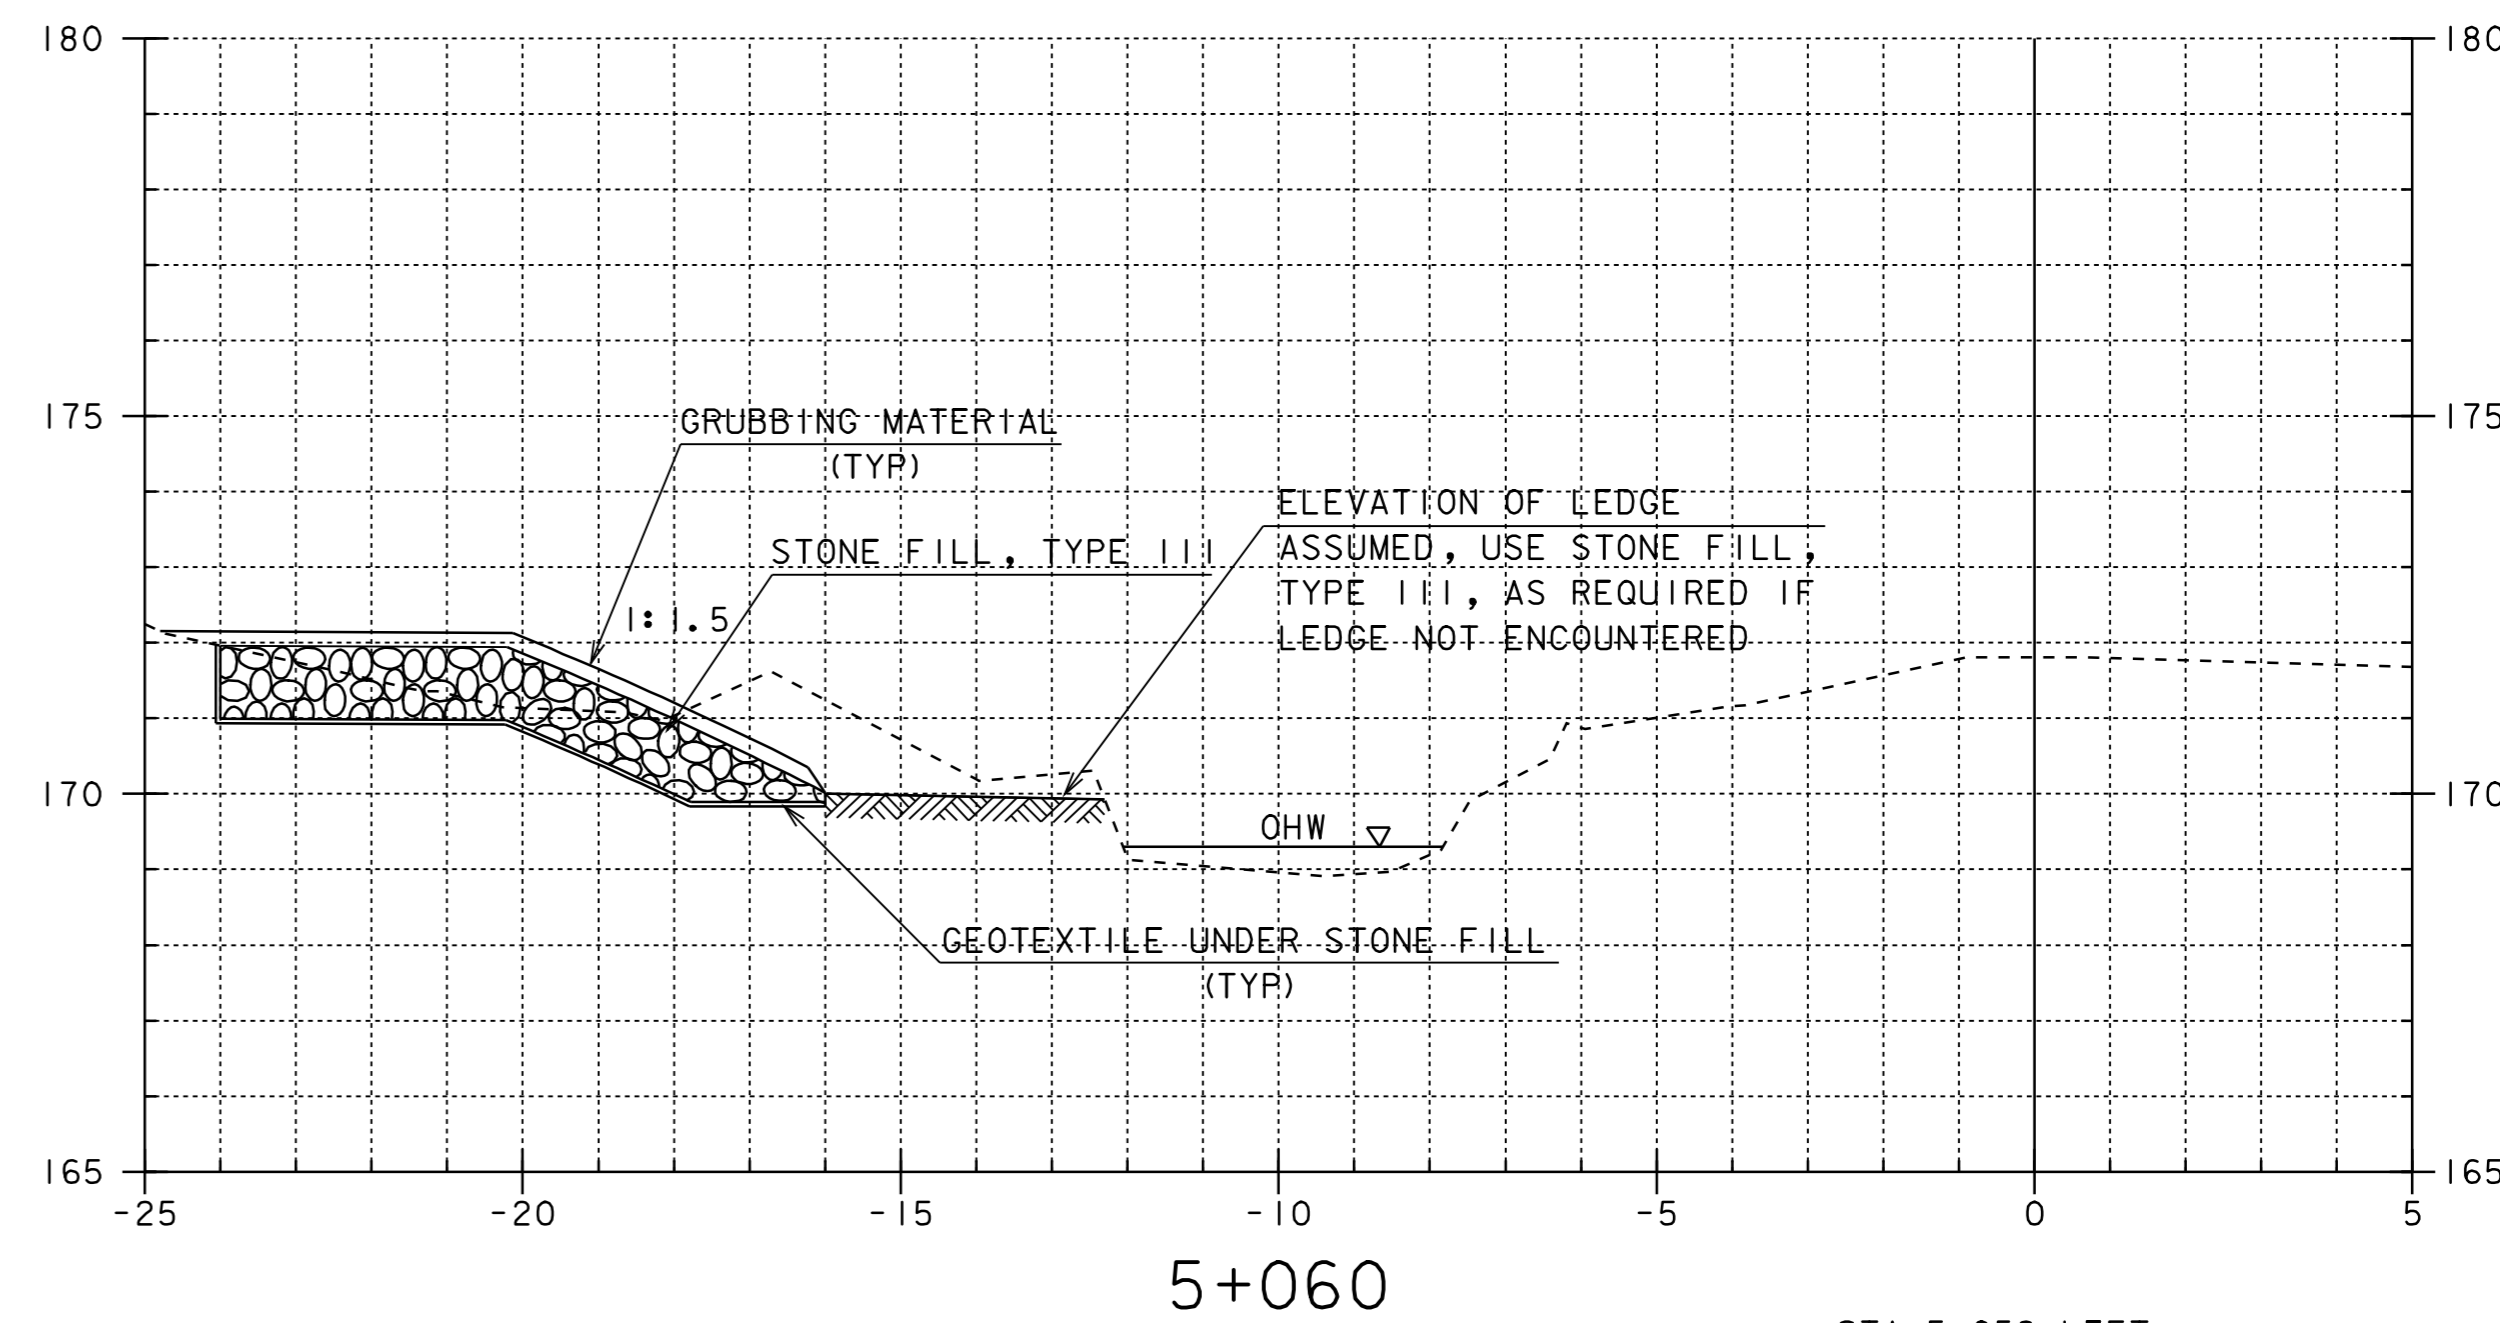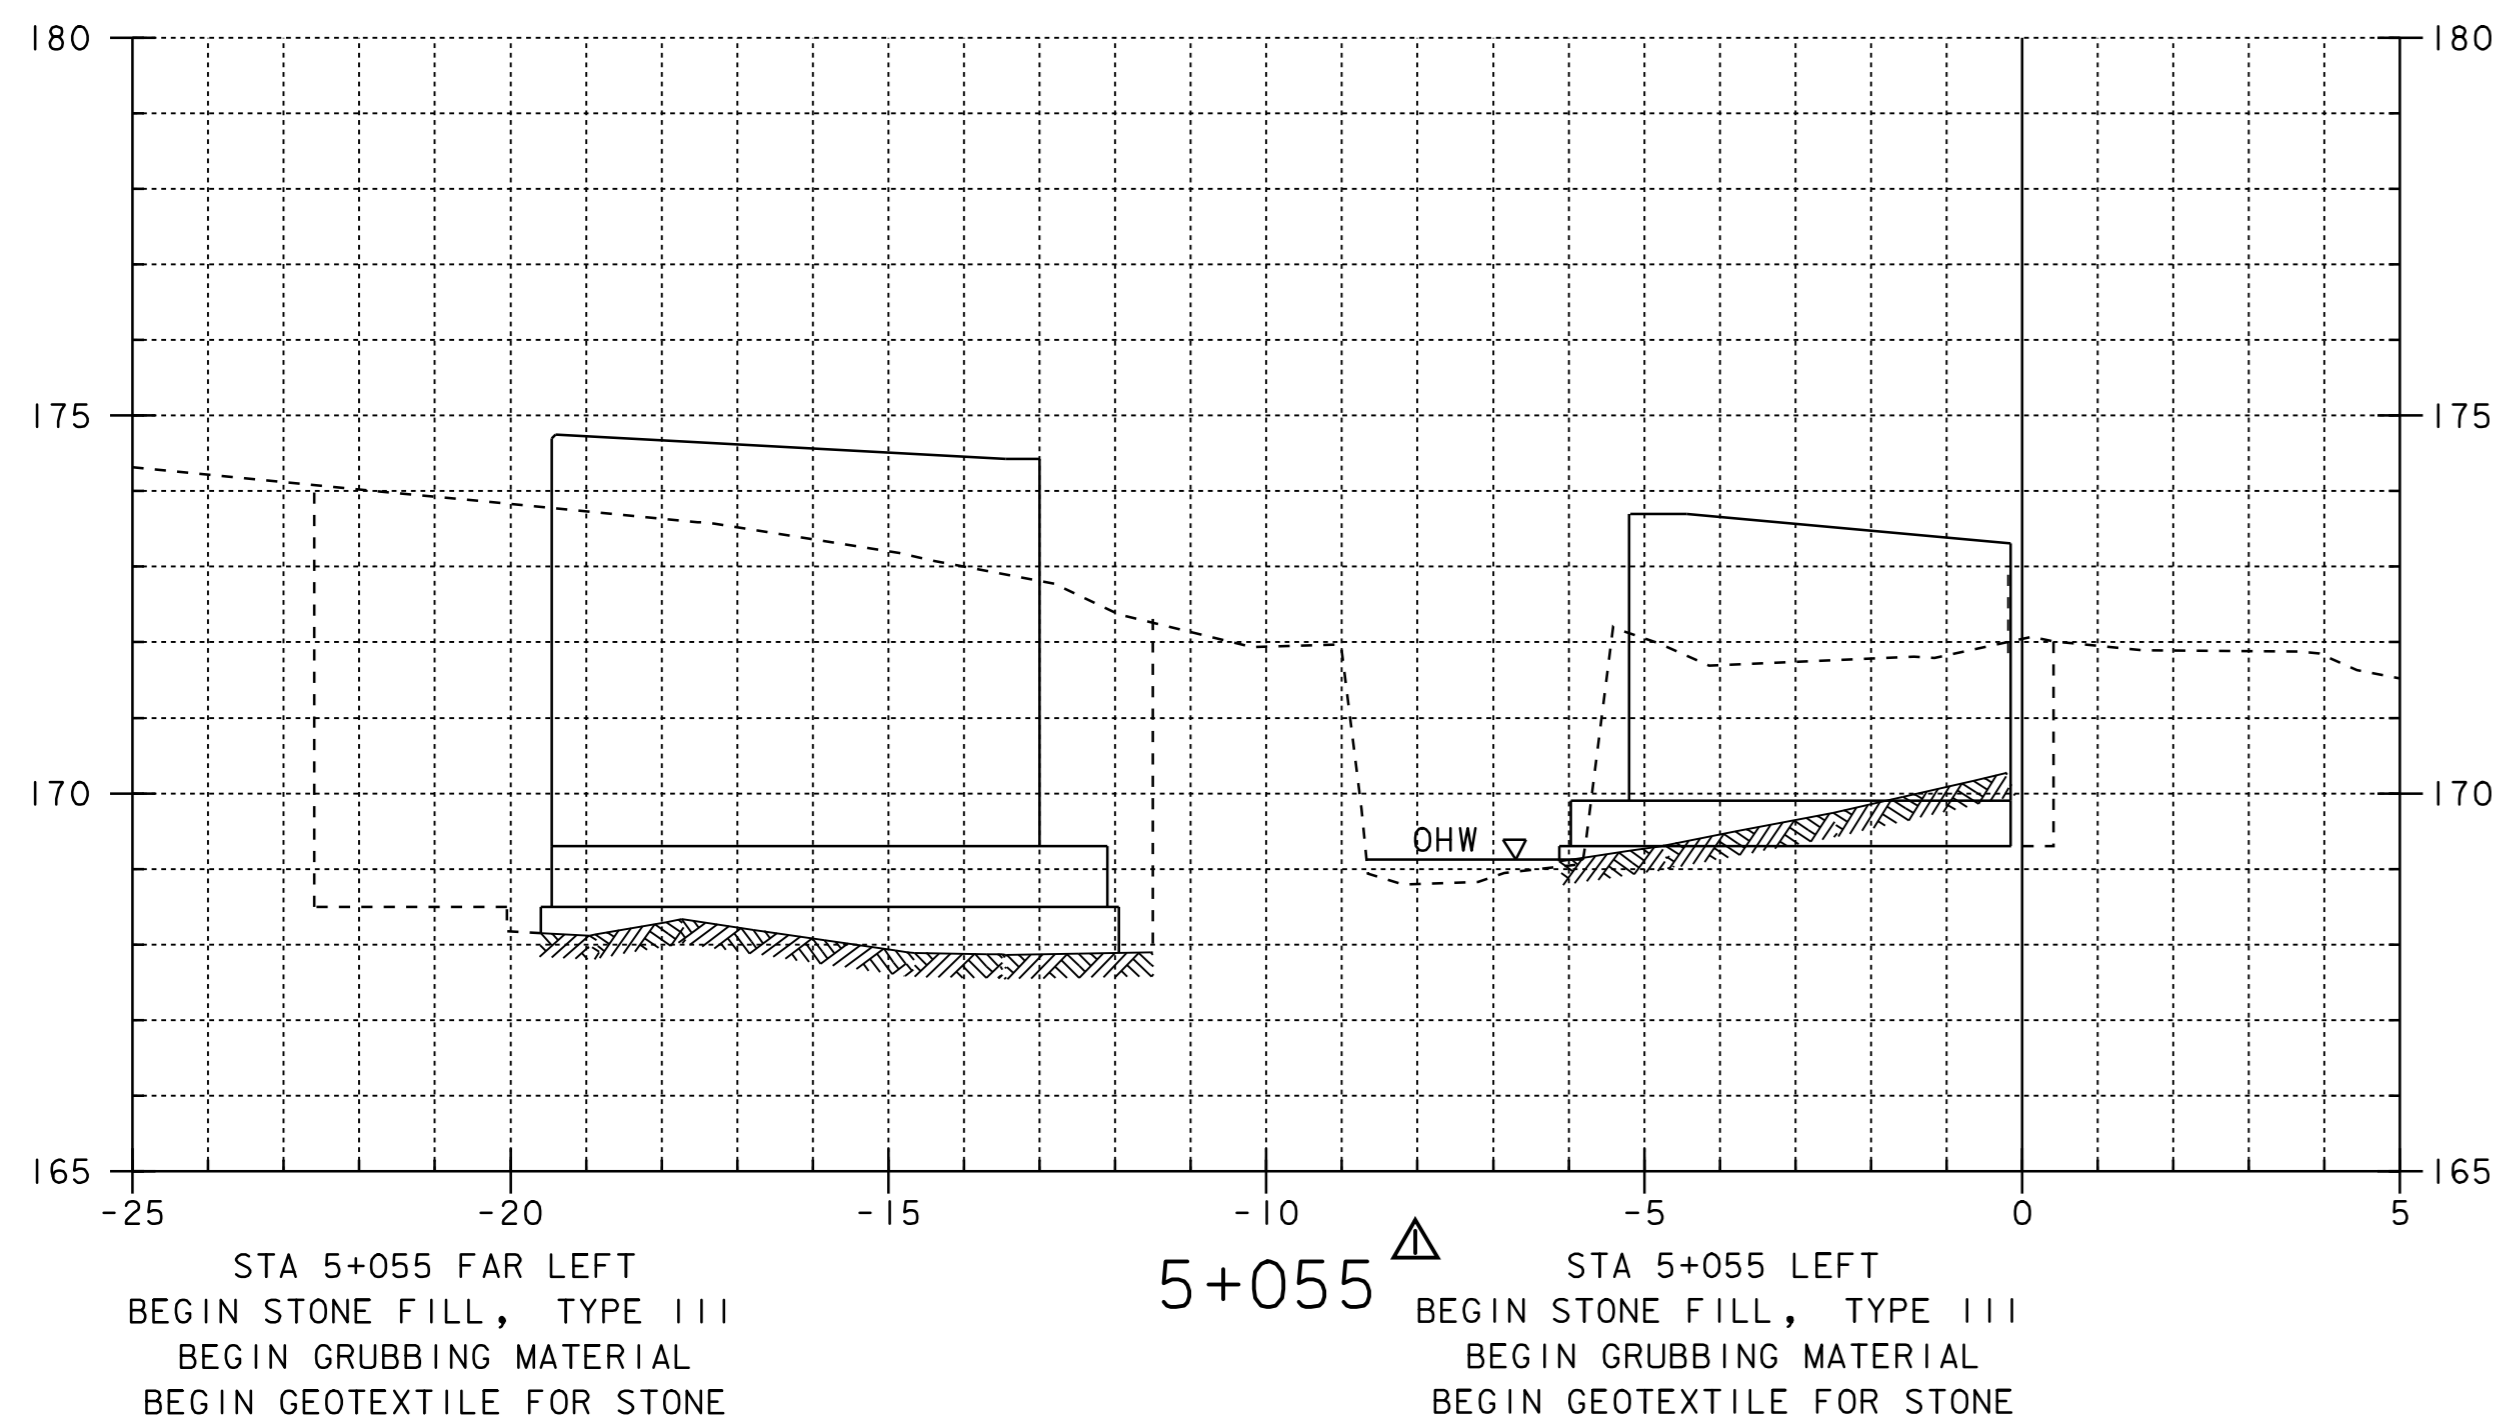

STA 5+058 LEFT
 END UNCLASSIFIED CHANNEL EXCAVATION
 END STONE FILL, TYPE III
 END GRUBBING MATERIAL
 END GEOTEXTILE FOR STONE

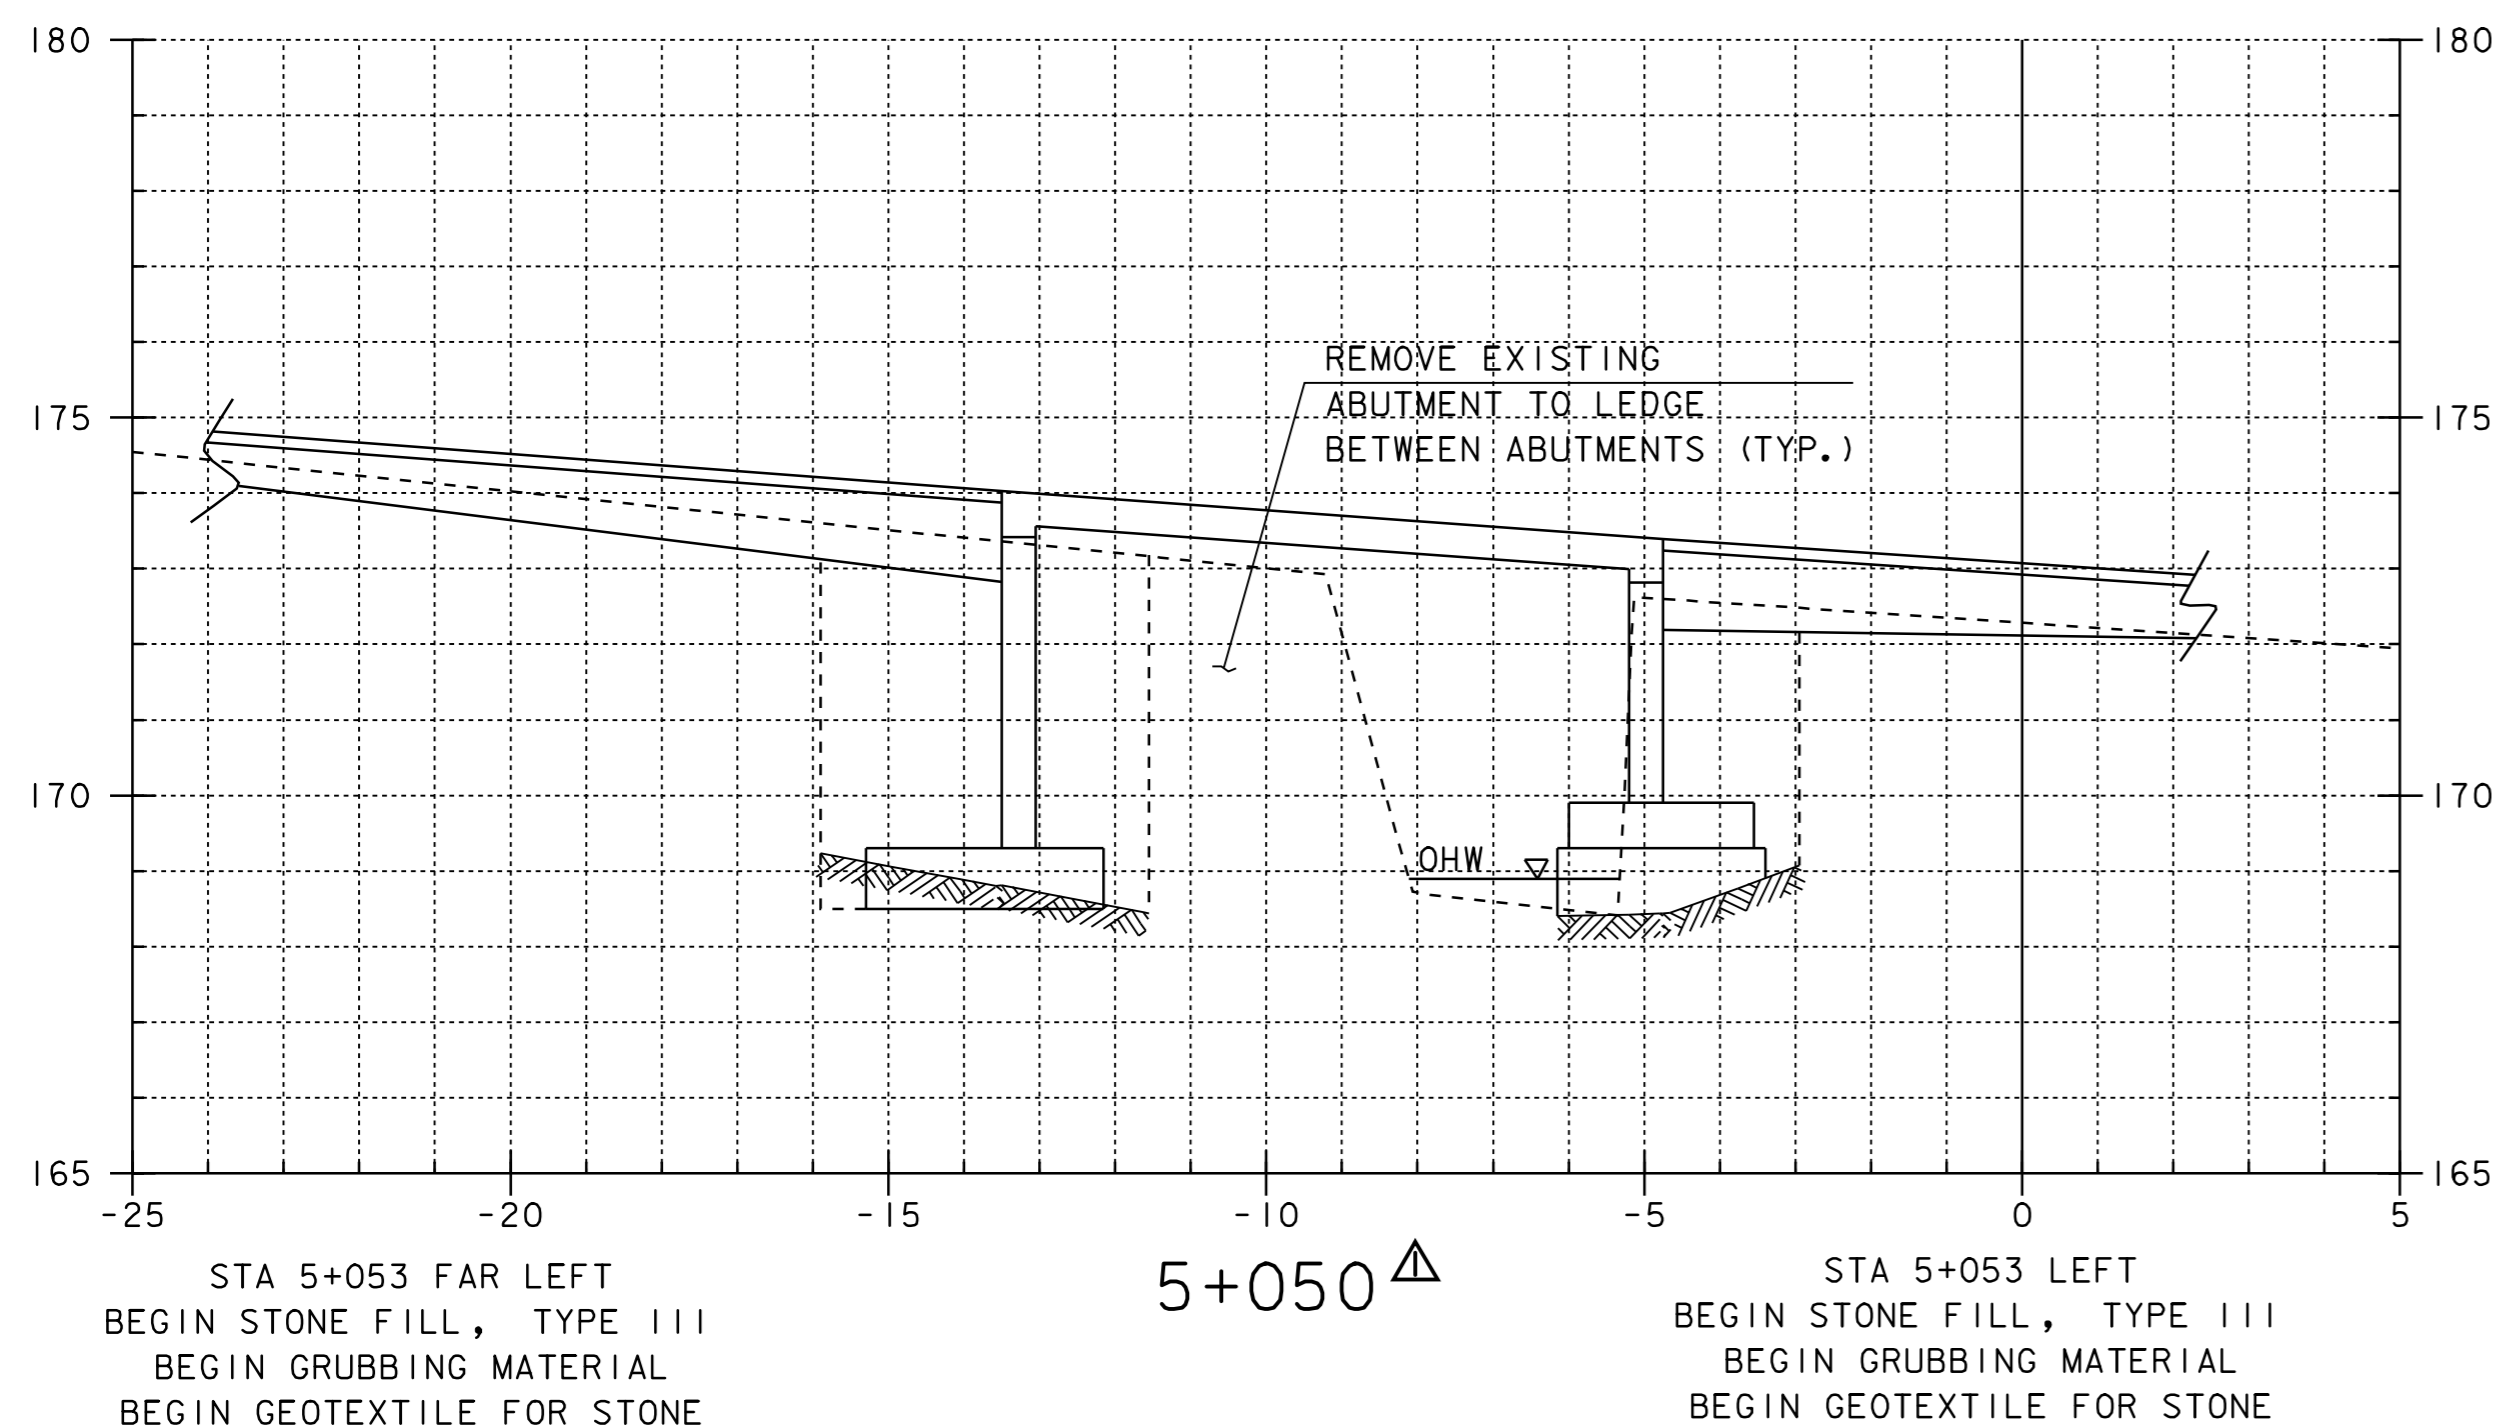

SHEET NAME: <u>CHANNEL CROSS SECTIONS</u>	
PROJECT NAME: <u>WESTFORD</u>	HIGHWAY NO.: <u>IH 4</u>
PROJECT NUMBER: <u>IH2_9436</u>	BRIDGE NO.: <u>2</u>
FILE NAME: <u>ZPW\941122\sj122xs2.dgn</u>	OVER: <u>ROGERS BROOK</u>
PROJECT MANAGER: <u>B. B. WHICOMB</u>	PLOT DATE: <u>22-DEC-2006</u>
DESIGNED BY: <u>C. CARLSON</u>	DRAWN BY: <u>SIRI</u>
BRIDGE SHEET NUMBER: <u>---</u>	IPARM NAME: <u>sj122cx2.1</u>
	SHEET <u>56</u> OF <u>56</u>

REVISION	DATE	BY	CHK'D	DESCRIPTION
△	06/27/2005	GFR	CWC	ABUTMENTS MODIFIED DUE TO UPDATED LEDGE INFORMATION.