
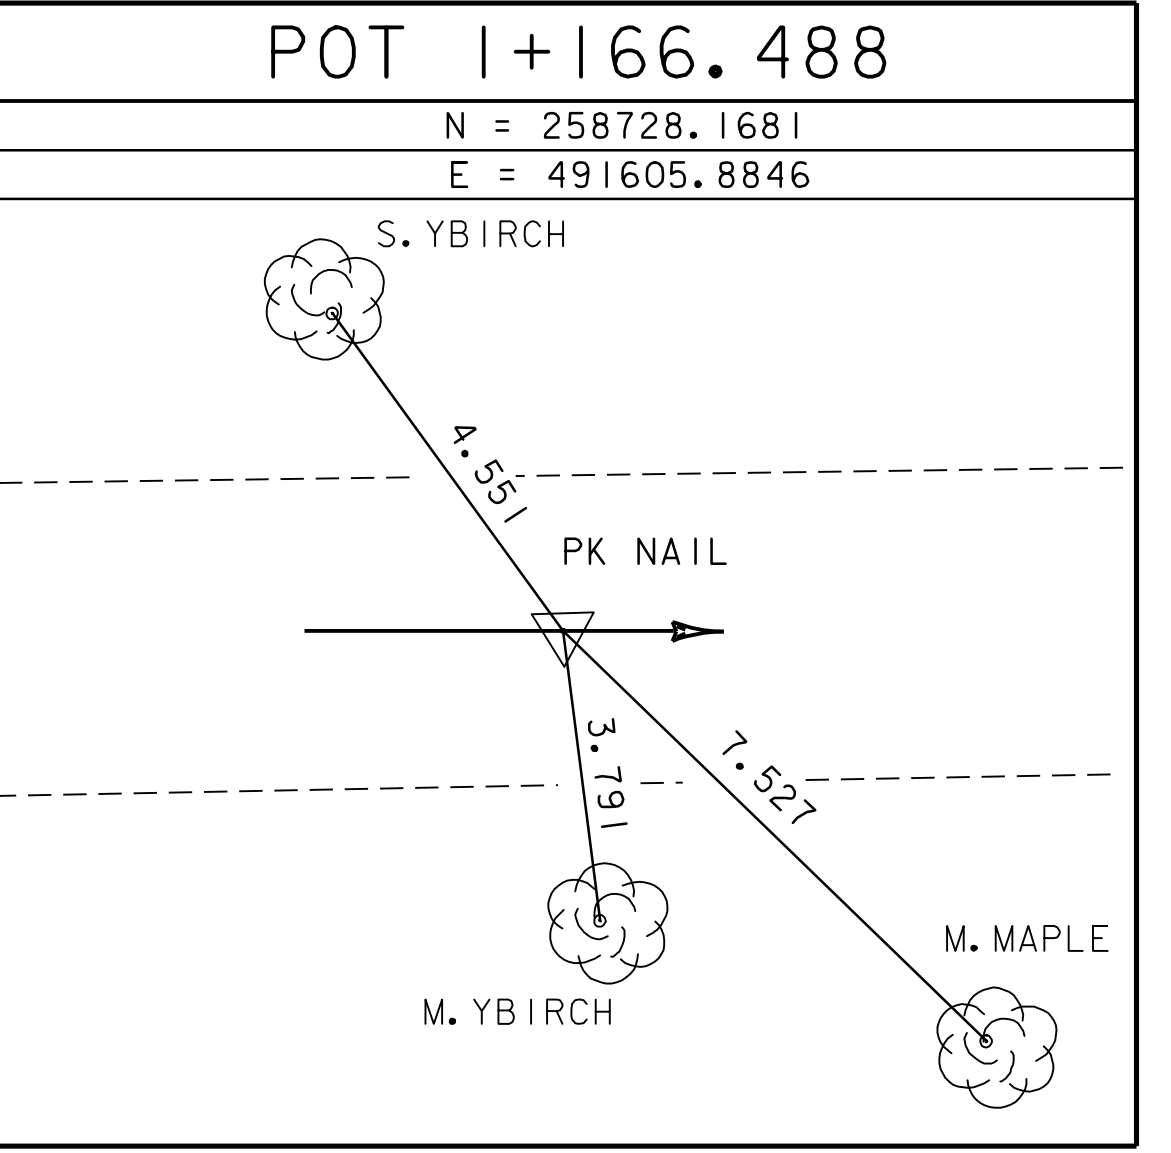
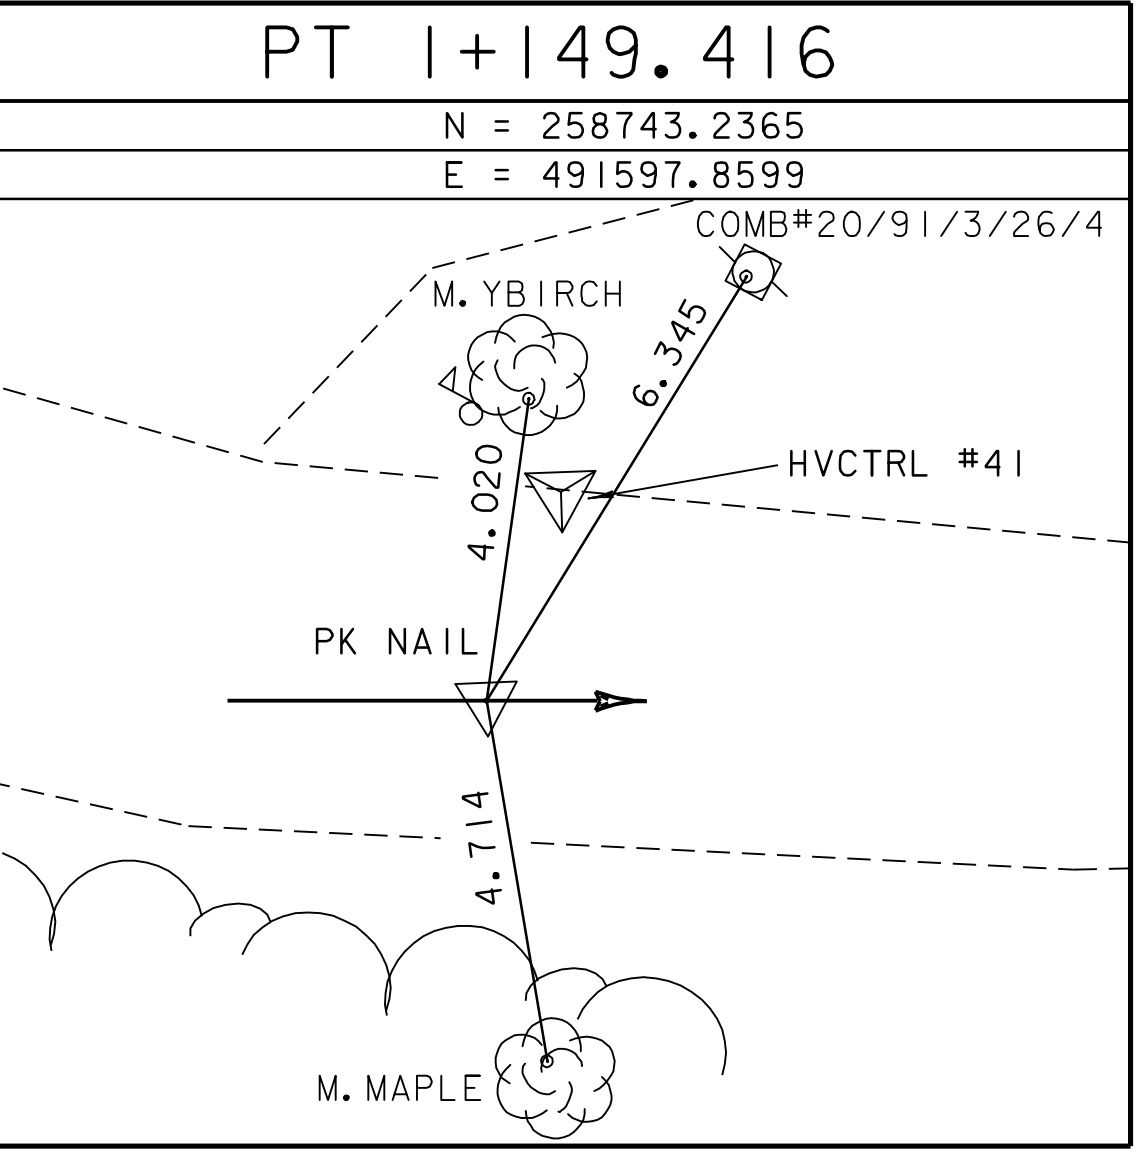
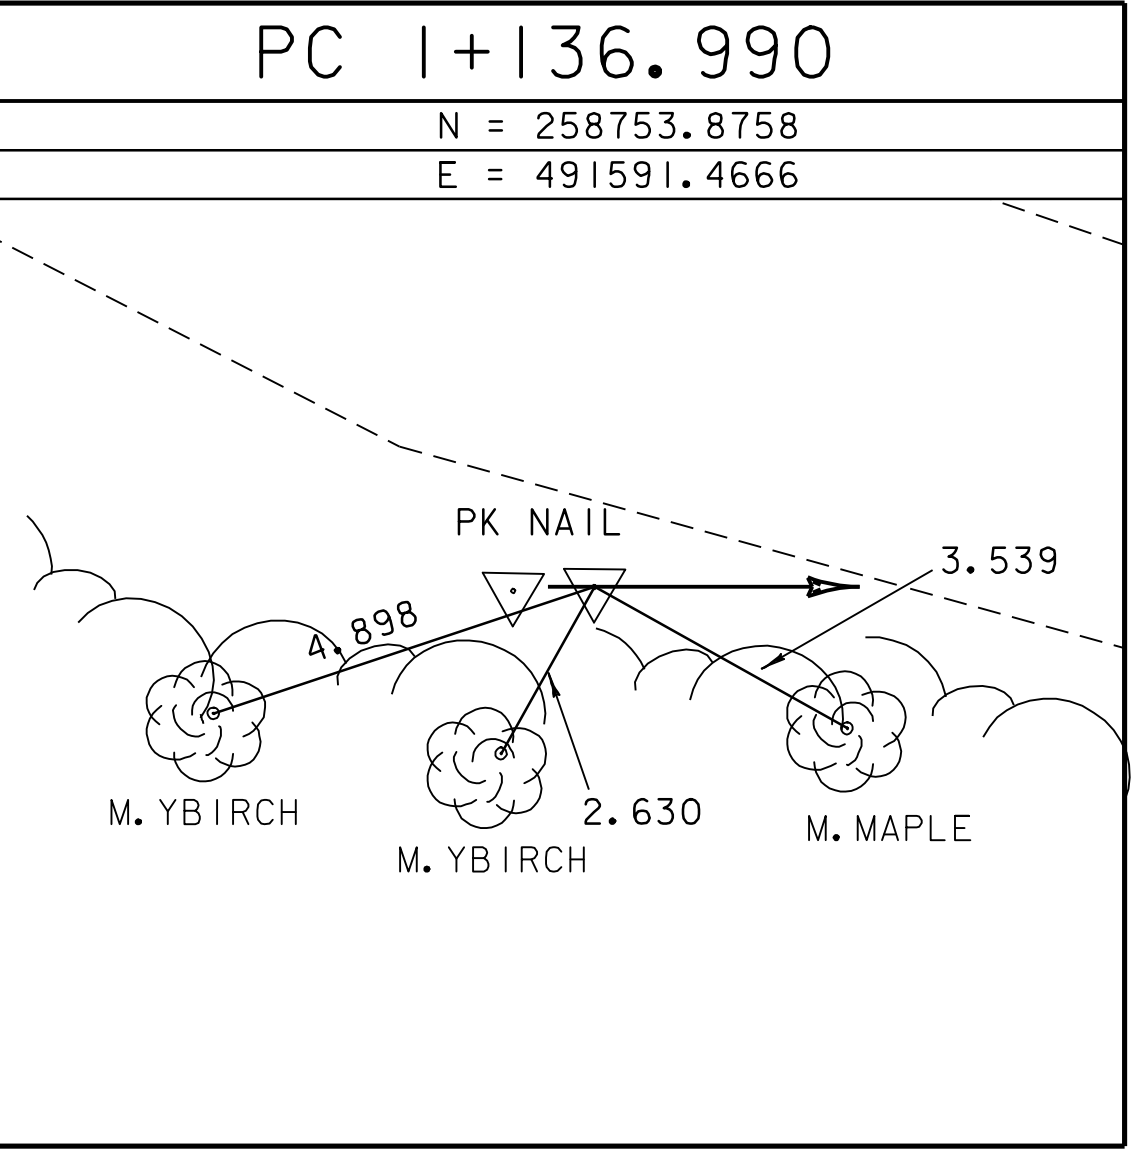
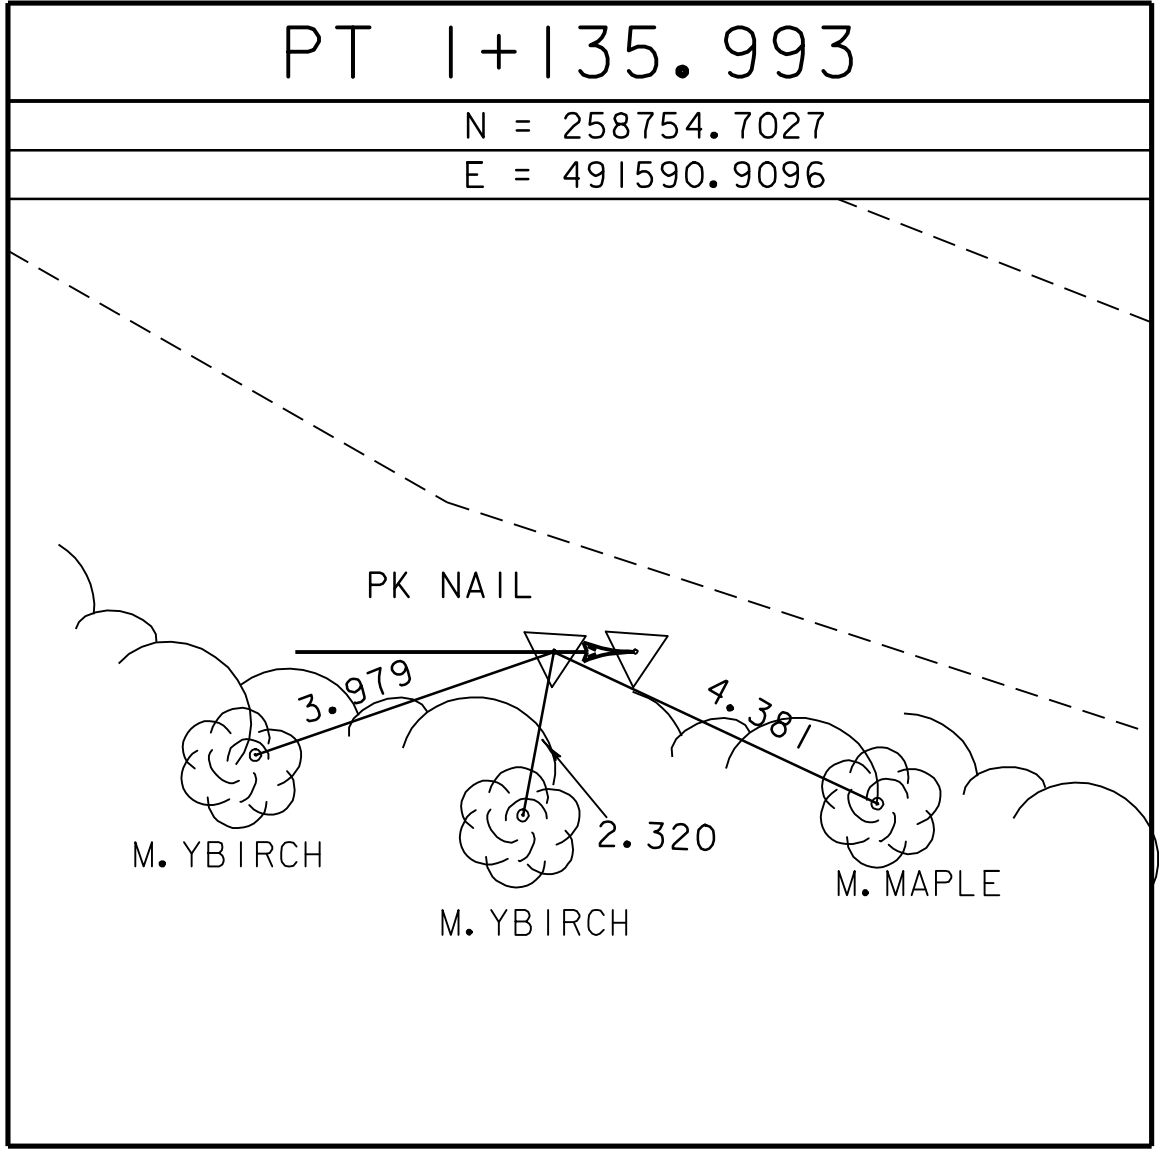


GPS CONTROL POINTS

TRAVERSE TIES

ALIGNMENT TIES

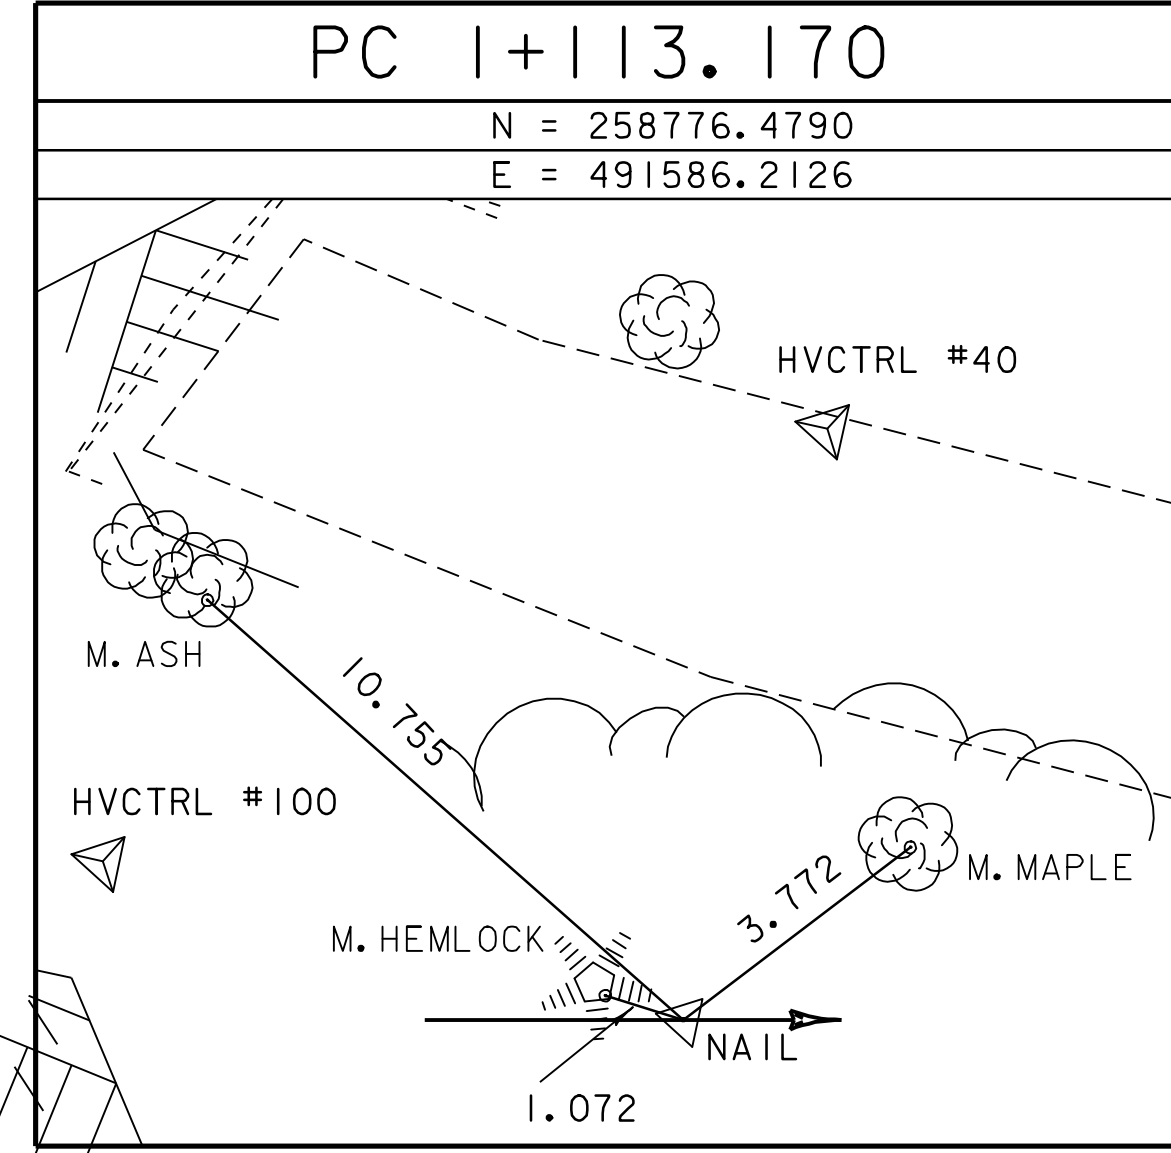

* ALIGNMENT STAKED ON JANUARY 20, 2002 BY R.GILMAN & P.WINTERS

DATUM	
VERTICAL	NAVD 88
HORIZONTAL	NAD 83 (92)

PROJECT NAME:	MONTGOMERY
PROJECT NUMBER:	BRO 1448 (20)
FILE NAME:	94J124\xj124t1.dgn
DESIGNED BY:	
PLOT DATE:	08-JAN-2009 12:00
DRAWN BY:	J.HULETT
CHECKED BY:	P.HODGE
SHEET	OF