

HVCTRL #1

STANDARD DISC STAMPED

NUTTING AZ

N = 259357.2390

E = 491398.8680

ELEV. = 242.100

DESCRIBED BY VERMONT AGENCY OF TRANSPORTATION 1994 (CHR)
 GENERAL LOCATION, MONTGOMERY, VT., IN THE SMALL SETTLEMENT OF
 HECTORVILLE, ABOUT 12.5 MI (20.1 KM) SOUTH OF THE U.S./CANADA BORDER,
 ABOUT 20.5 MI (33.0 KM) WEST OF NEWPORT, AND ABOUT 23.5 MI (37.8 KM)
 EAST OF ST ALBANS. OWNERSHIP, ARNOLD MERCY, RD 1 BOX 330, MONTGOMERY
 CENTER, VT. 05471. PHONE 802-326-4200. TO REACH FROM THE
 INTERSECTION OF VT ROUTES 118 AND 242 IN MONTGOMERY CENTER GO SOUTH
 ALONG VT ROUTE 118 FOR 3.1 MI (5.0 KM) TO THE MARK ON THE RIGHT, ABOUT
 0.1 MI (0.2 KM) NORTH OF A LOG HOME. THE MARK IS 11.5 M (37.7 FT)
 WEST OF AND ABOUT LEVEL WITH THE CENTERLINE OF VT ROUTE 118, 2.6 M
 (8.5 FT) SOUTH OF UNDERGROUND TELEPHONE CABLE BOX NO. 2/29, 4.3 M
 (14.1 FT) SOUTHWEST OF MILE MARKER 1180/0610/0260 AND A GUY ANCHOR,
 AND 3.4 M (11.2 FT) SOUTH OF A FIBERGLASS WITNESS POST AND POLE NO.
 MT/168. IT IS SET FLUSH WITH THE GROUND IN THE TOP OF A 1 M (3.3 FT)
 X 0.5 M (1.6 FT) ROCK OUTCROP.

HVCTRL #2

STANDARD DISC STAMPED

NUTTING



N = 258972.7470

E = 491386.9480






ELEV. = 243.000

DESCRIBED BY VERMONT AGENCY OF TRANSPORTATION 1994 (CHR)
 GENERAL LOCATION, MONTGOMERY, VT., IN THE SMALL SETTLEMENT OF
 HECTORVILLE, ABOUT 13 MI (20.9 KM) SOUTH OF THE U.S./CANADA BORDER,
 ABOUT 20.5 MI (33.0 KM) WEST OF NEWPORT, AND ABOUT 23.5 MI (37.8 KM)
 EAST OF ST ALBANS. TO REACH FROM THE INTERSECTION OF VT ROUTES 118
 AND 242 IN MONTGOMERY CENTER GO SOUTH ALONG VT ROUTE 118 FOR 3.3 MI
 (5.3 KM) TO THE MARK ON THE RIGHT, ABOUT 25 M (82.0 FT) SOUTH OF THE
 INTERSECTION OF NUTTING ROAD. THE MARK IS 8.7 M (28.5 FT) WEST OF AND
 ABOUT LEVEL WITH THE CENTERLINE OF VT ROUTE 118, 35.4 M (116.1 FT)
 SOUTHWEST OF POLE NO. VE COOP MT/164, 17.4 M (57.1 FT) EAST OF A
 40-CM MAPLE (MOST NORTHERLY OF 2), 34.7 M (113.8 FT) NORTH-NORTHEAST
 OF POLE NO. 20/91A/1/2/29-2, AND 0.3 M (1.0 FT) EAST OF A FIBERGLASS
 WITNESS POST. IT IS SET FLUSH WITH THE GROUND IN THE TOP OF A 30-CM
 DIAMETER CONCRETE MONUMENT POURED TO A DEPTH OF 1.3 M.

* DESCRIPTION PROVIDED BY VERMONT AGENCY OF TRANSPORTATION GEODETIC SURVEY UNIT

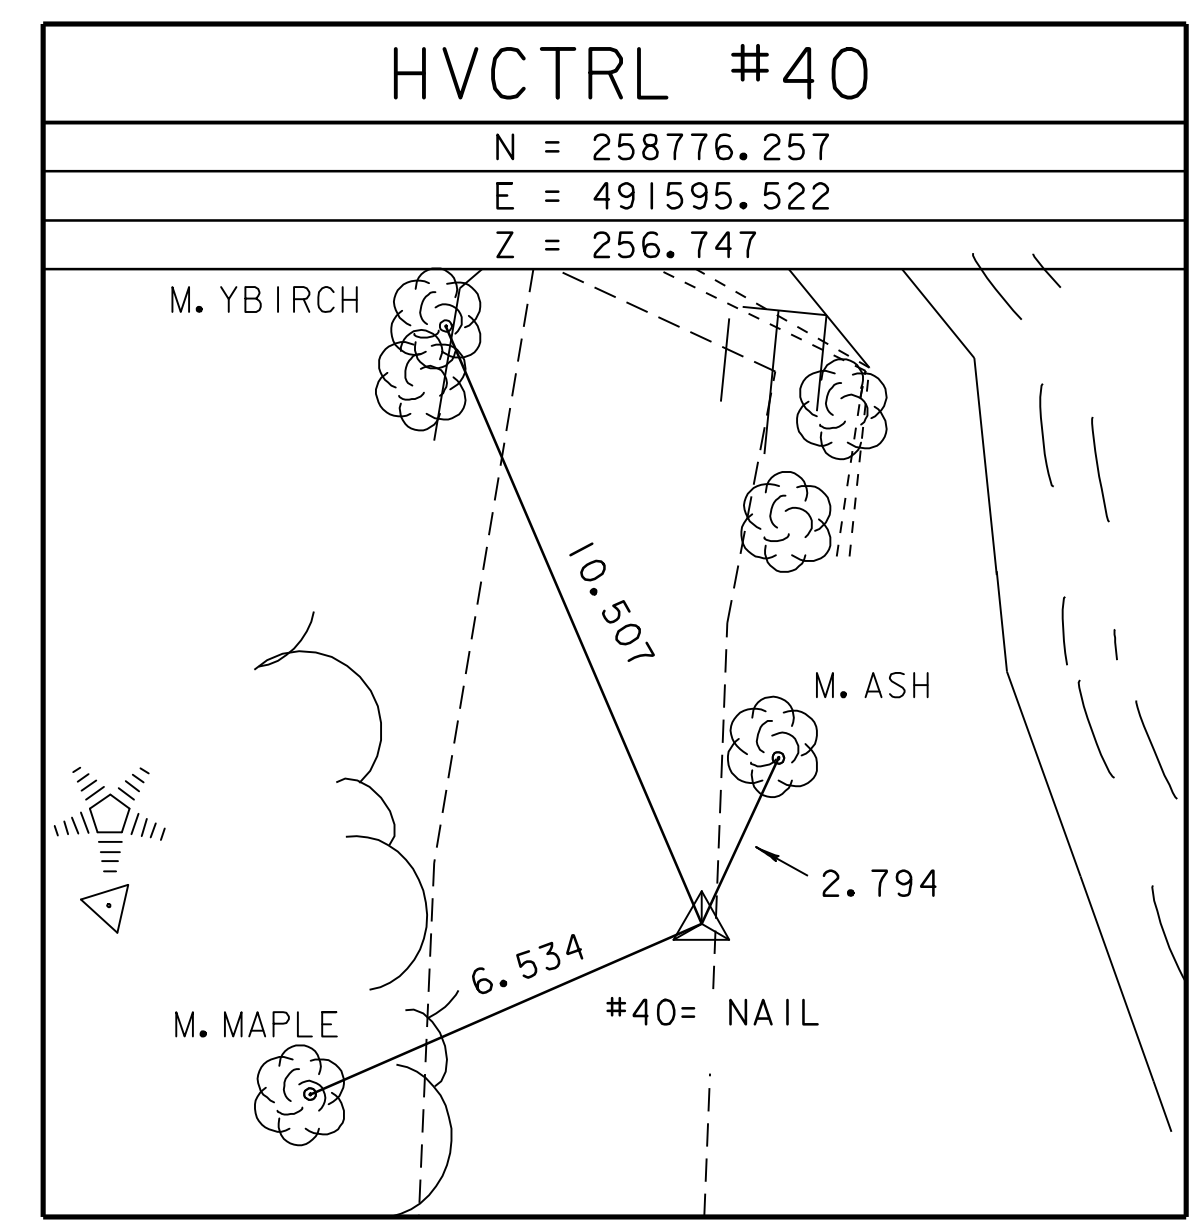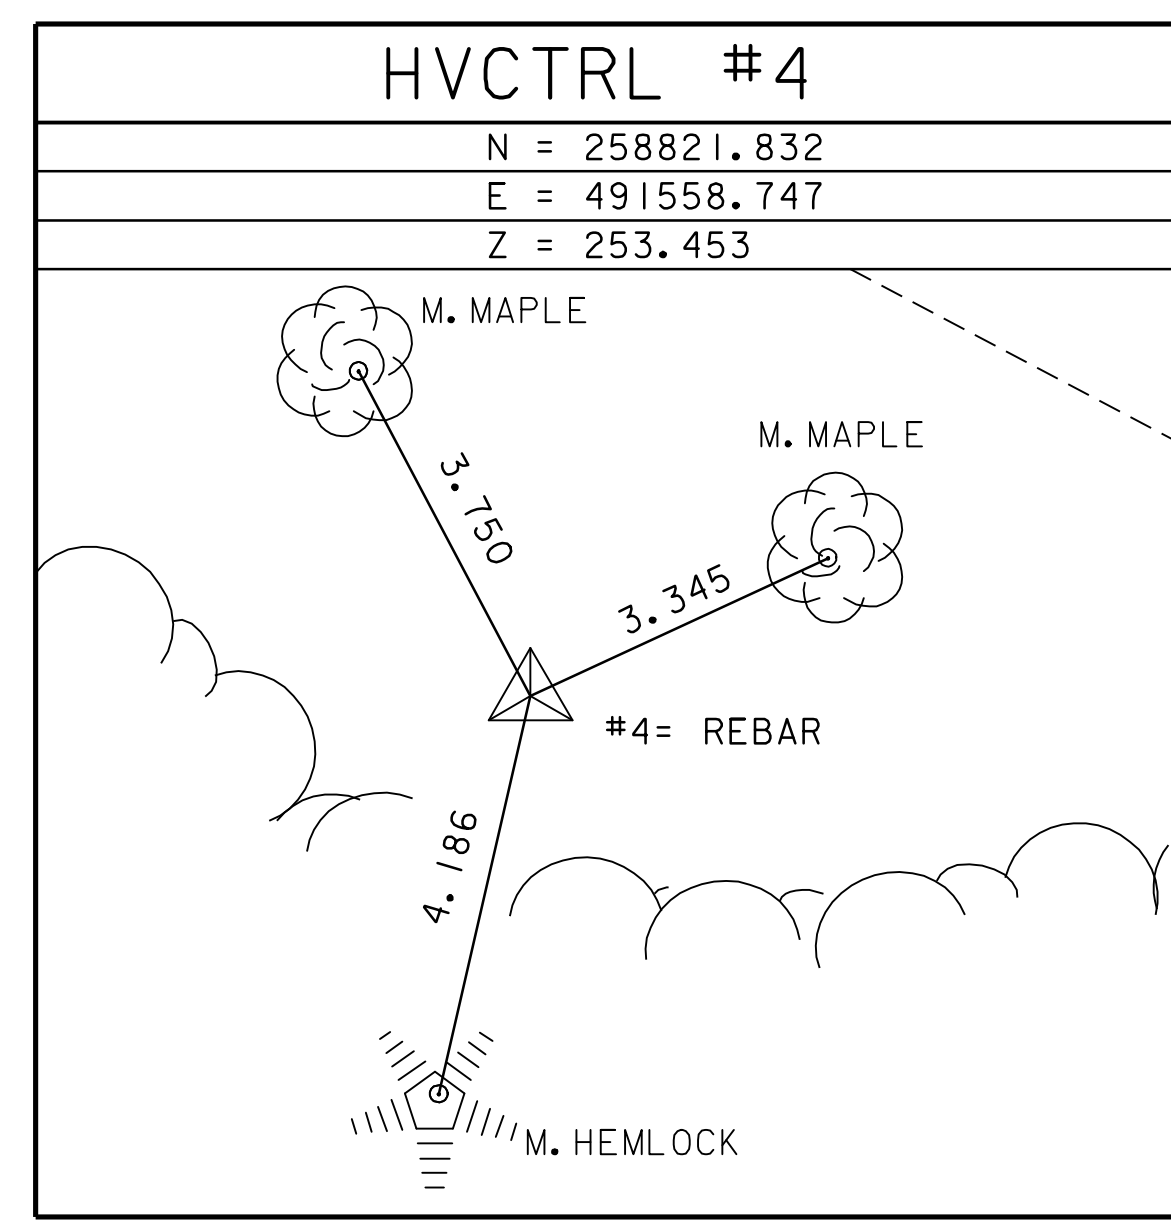

* MAIN TRAVERSE COMPLETED: FEBRUARY 21, 1995 BY R. MOREAU, A. MYERS & T. CHASE

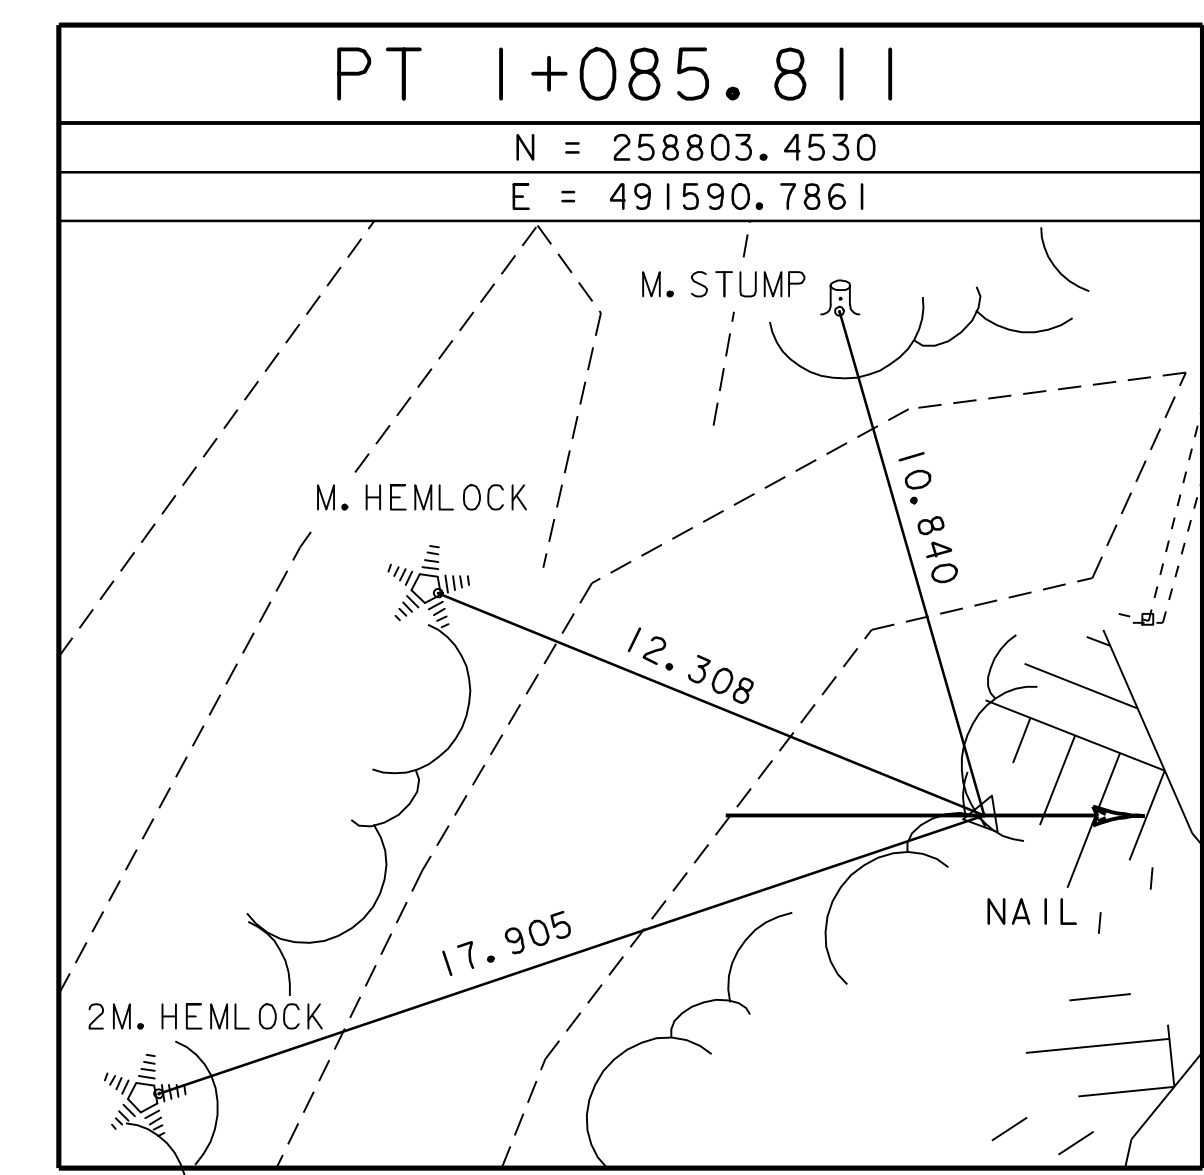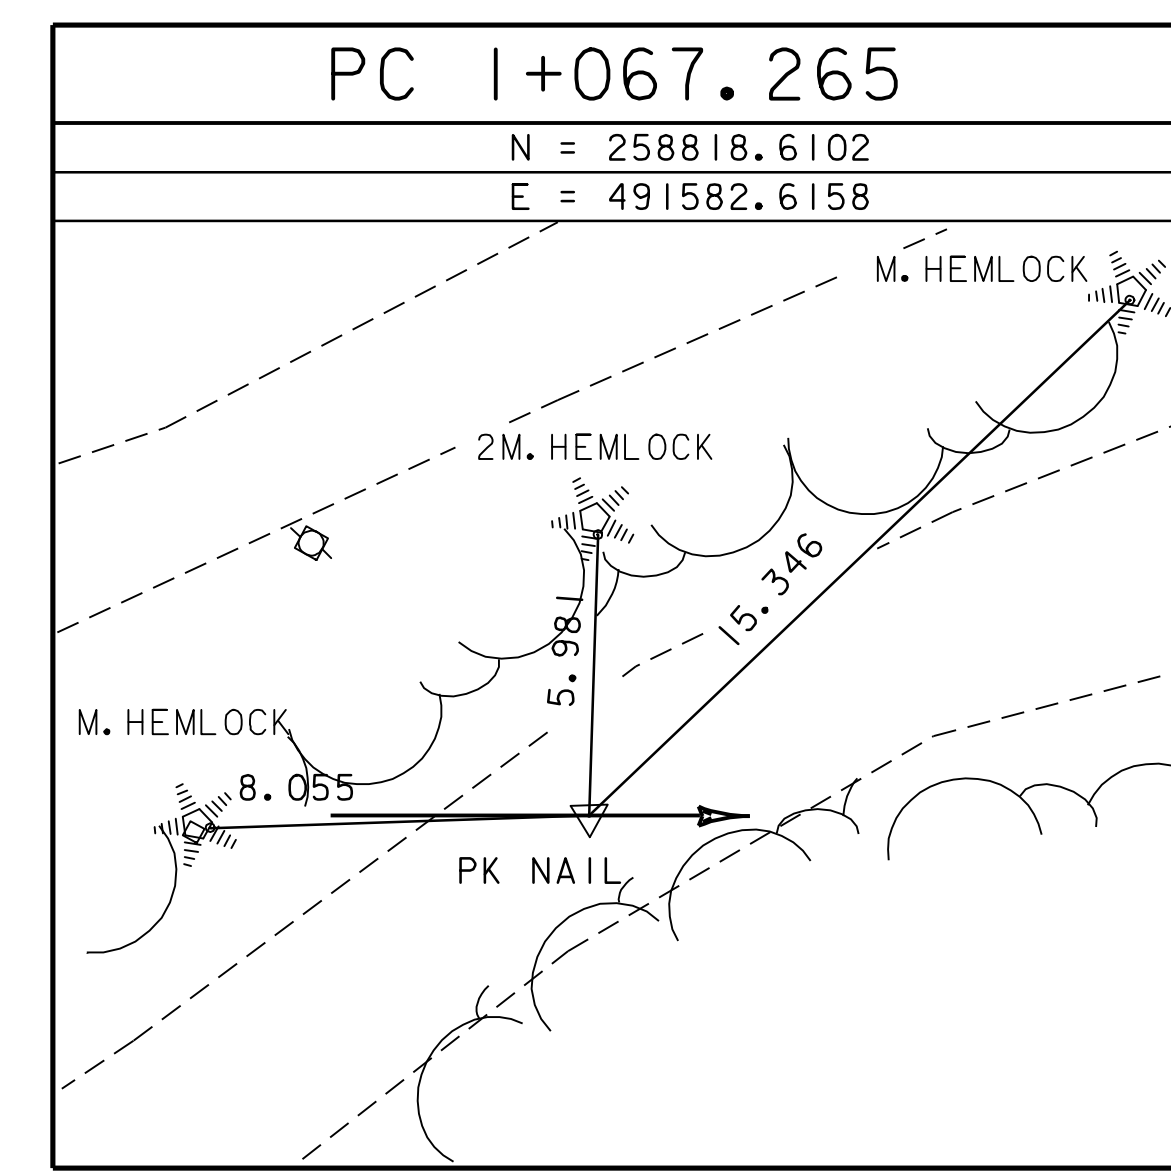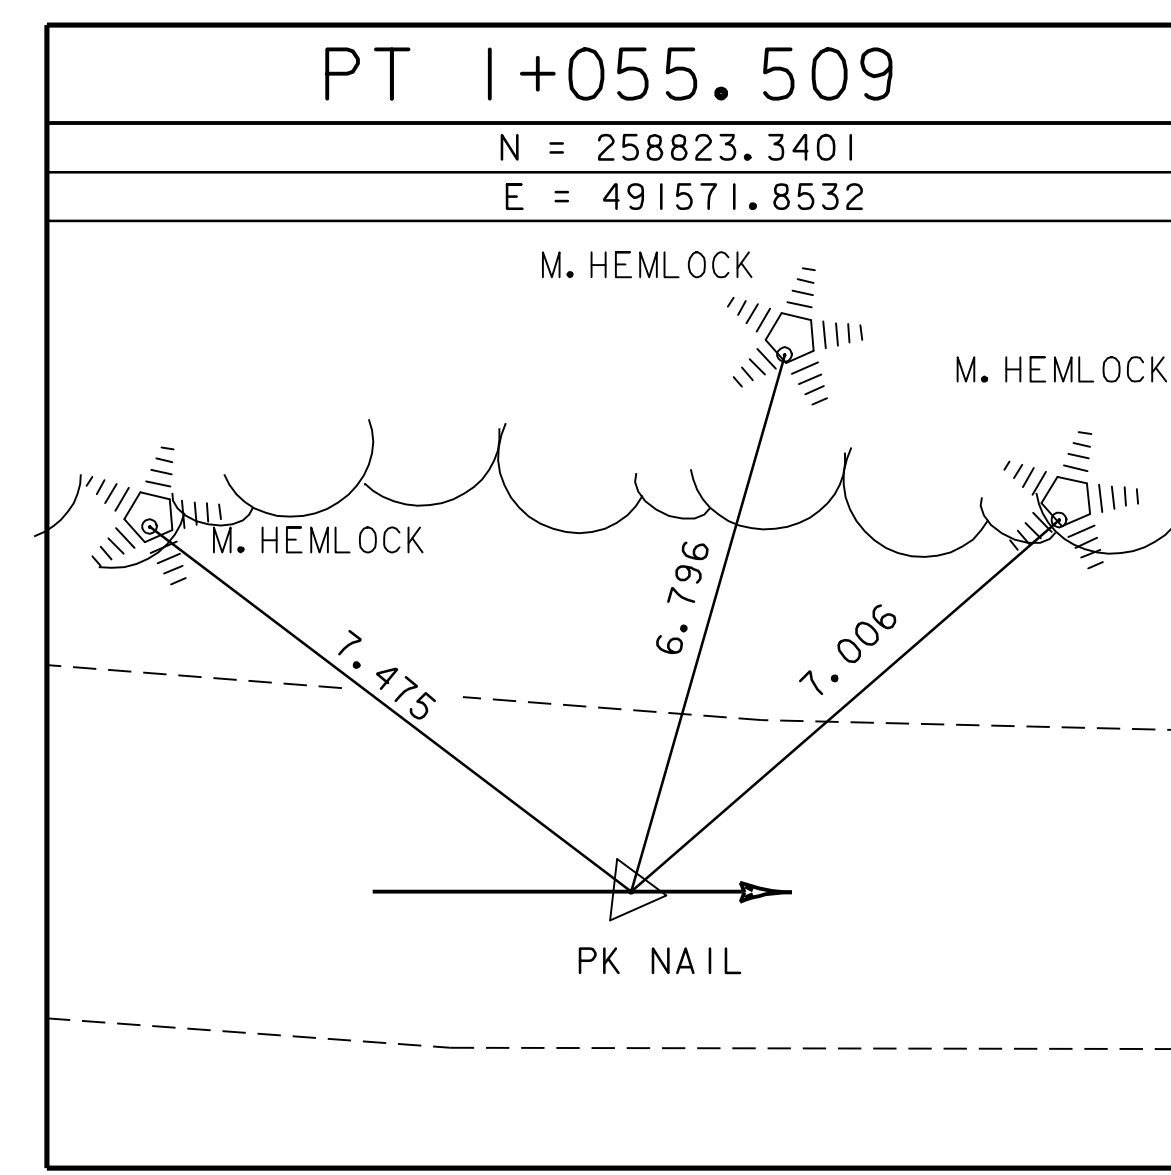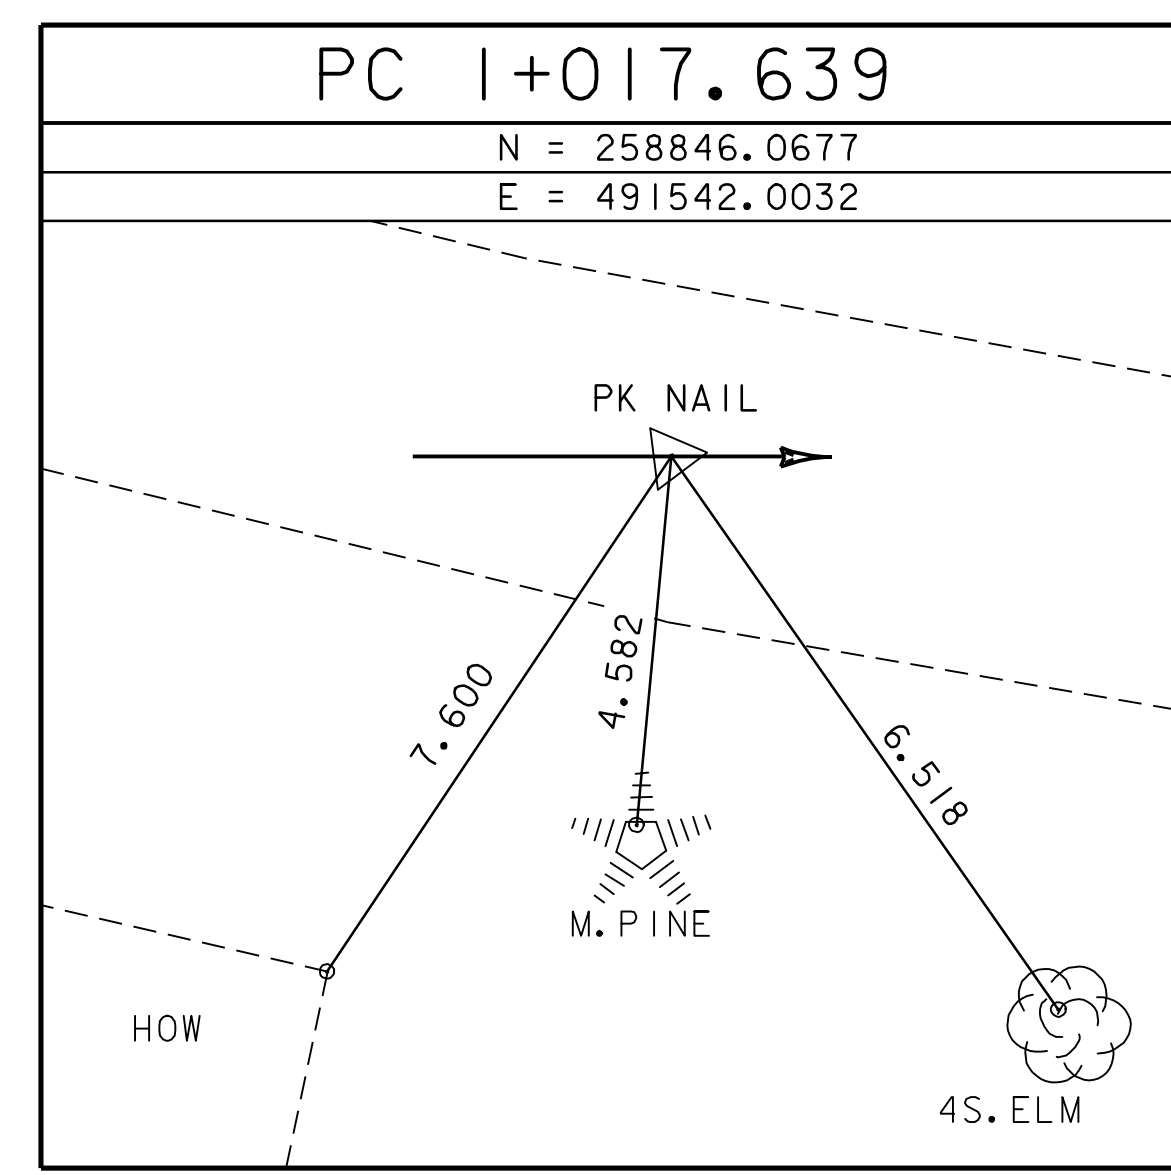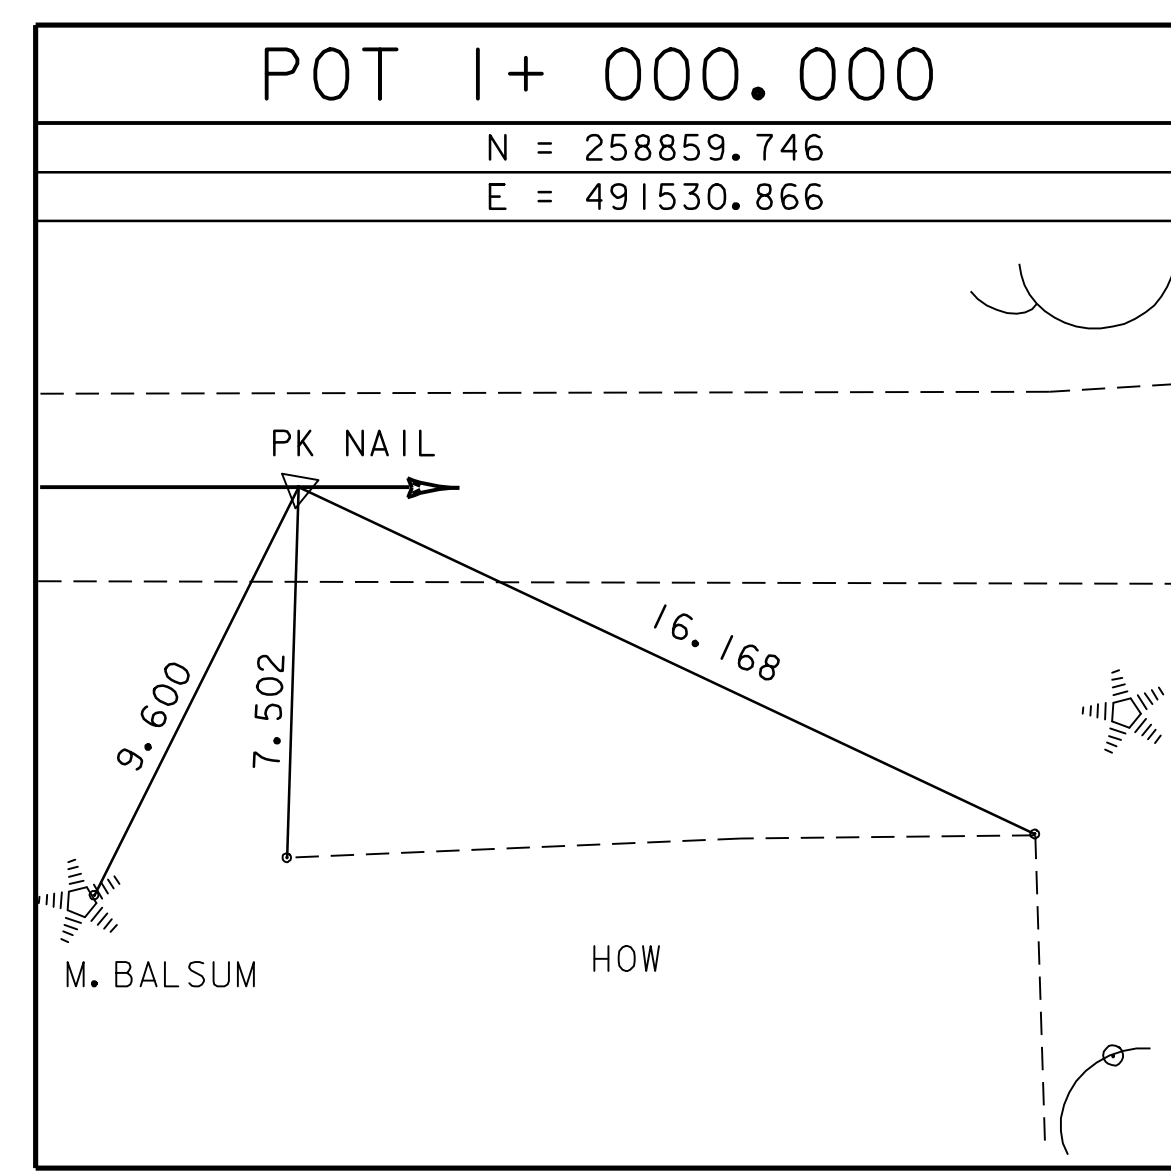

* ALIGNMENT STAKED ON JANUARY 20, 2002 BY R. GILMAN & P. WINTERS

| DATUM | |
|------------|-------------|
| VERTICAL | NAVD 88 |
| HORIZONTAL | NAD 83 (92) |

| | |
|-----------------|-------------------|
| PROJECT NAME: | MONTGOMERY |
| PROJECT NUMBER: | BRO 1448 (20) |
| FILE NAME: | 94J124\XJ1241.dgn |
| PROJECT LEADER: | J.HULETT |
| DESIGNED BY: | P.HODGE |
| PLOT DATE: | 08-JAN-2009 12:00 |
| DRAWN BY: | J.HULETT |
| CHECKED BY: | P.HODGE |
| SHEET | OF |