


**ABUTMENT #1 FOOTING REINFORCING**

SCALE: 1:25

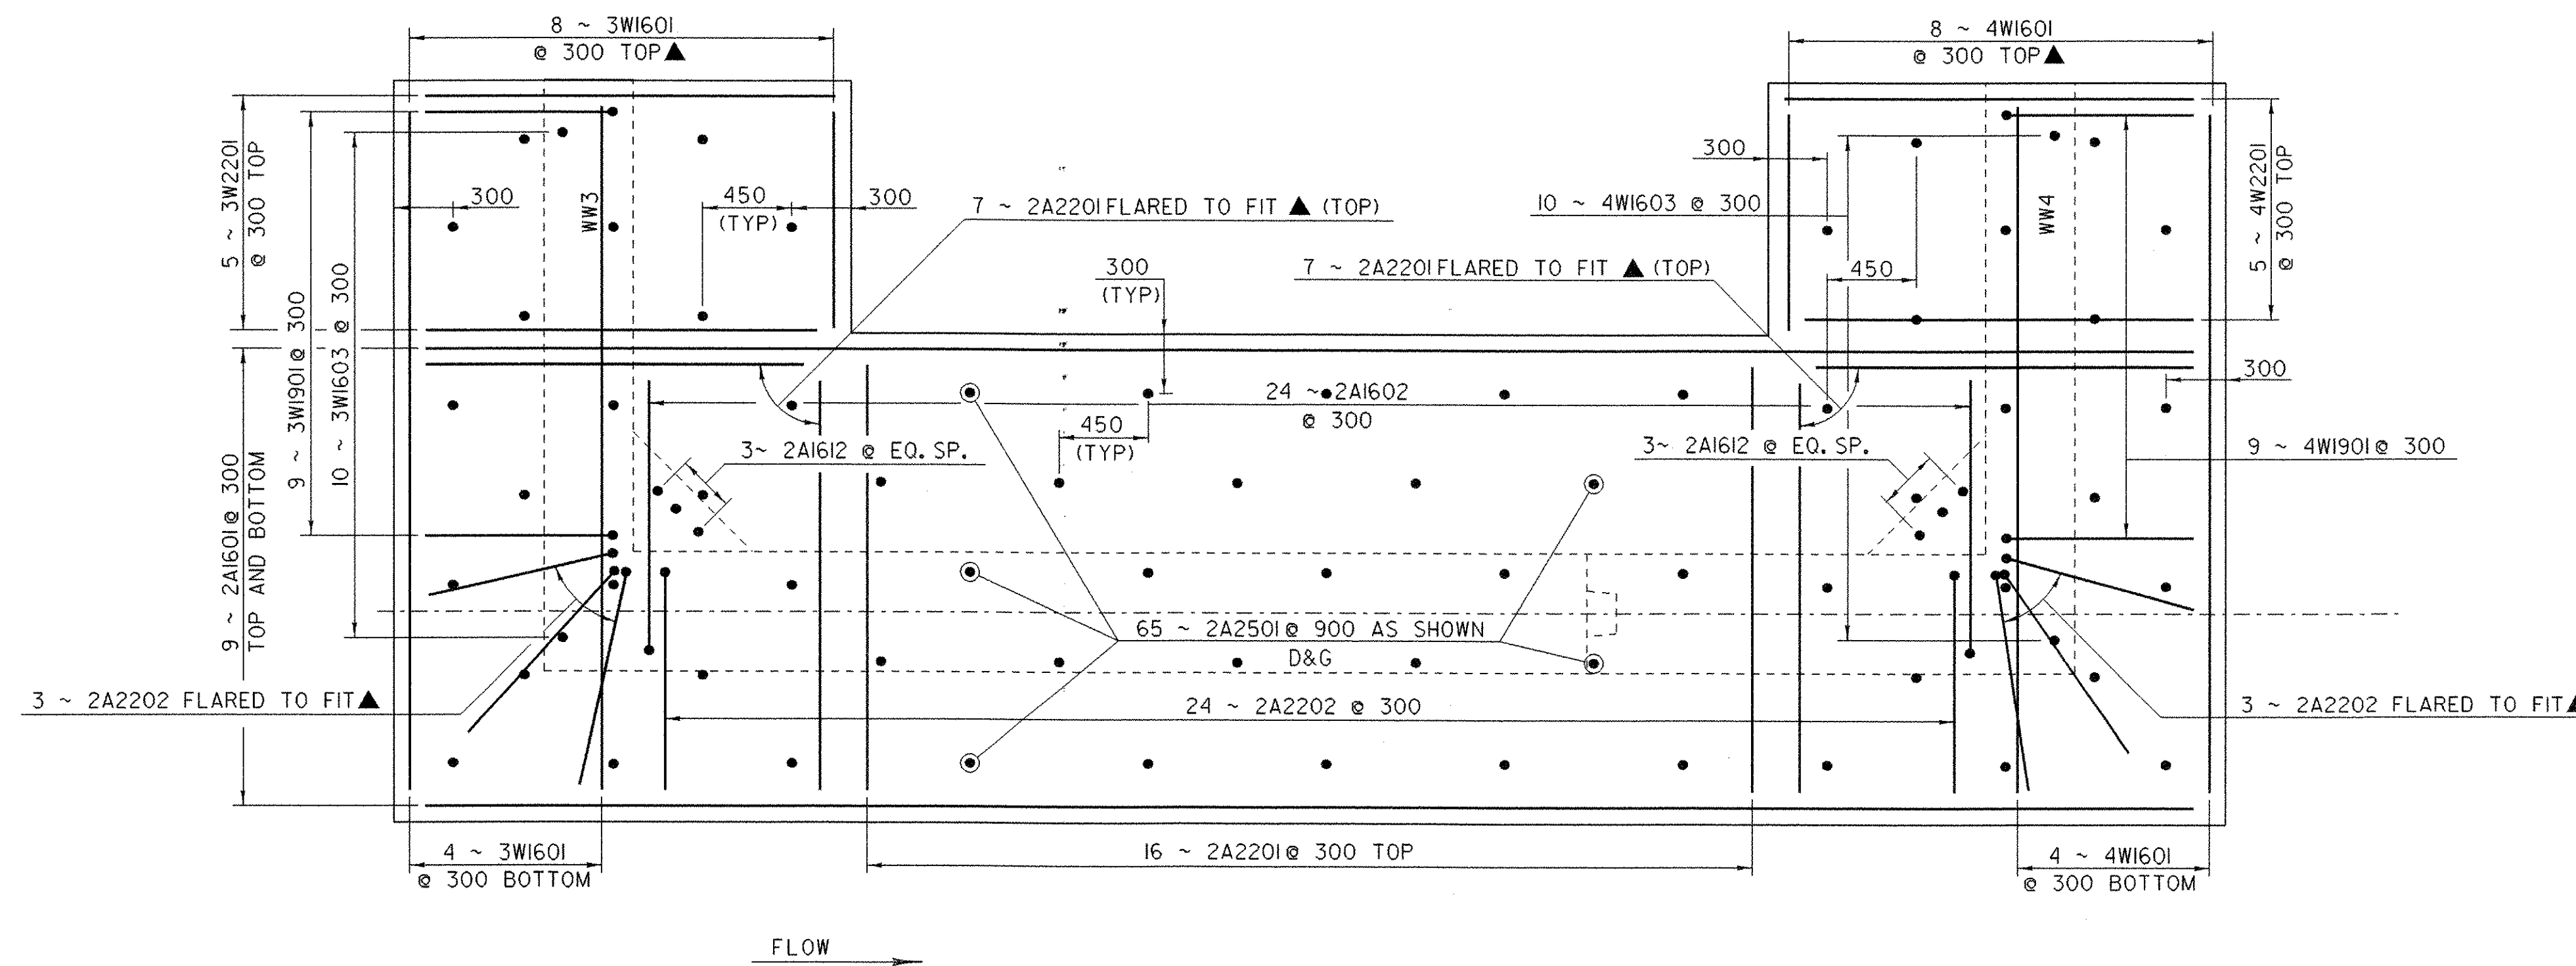

**ABUTMENT #2 FOOTING REINFORCING**

SCALE: 1:25

**NOTES:**

1. NF = NEAR FACE
2. FF = FAR FACE
3. EF = EACH FACE
4. ▲ = CUT TO FIT IN FIELD
5. 80 CLEAR UNLESS OTHERWISE SPECIFIED ON THE PLANS
6. D&G = DRILL AND GROUT, 450 MINIMUM DEPTH OF GROUTING

SHEET NAME: <b>FOOTING REINFORCING PLANS</b>	
PROJECT NAME: <b>MONTGOMERY</b>	HIGHWAY NO.: TH 35
PROJECT NUMBER: <b>BRO 1448(20)</b>	BRIDGE NO.: 24
	OVER: PACIFIC BROOK
FILE NAME: /PW/94J124/sj124sub.dgn	PLOT DATE: 06-DEC-2005
PROJECT MANAGER: R. WHITCOMB	DRAWN BY: J. GILMORE
DESIGNED BY: D. BONNEAU	IPARM NAME: sj124frp.1
BRIDGE SHEET NUMBER:	SHEET 32 OF 50