

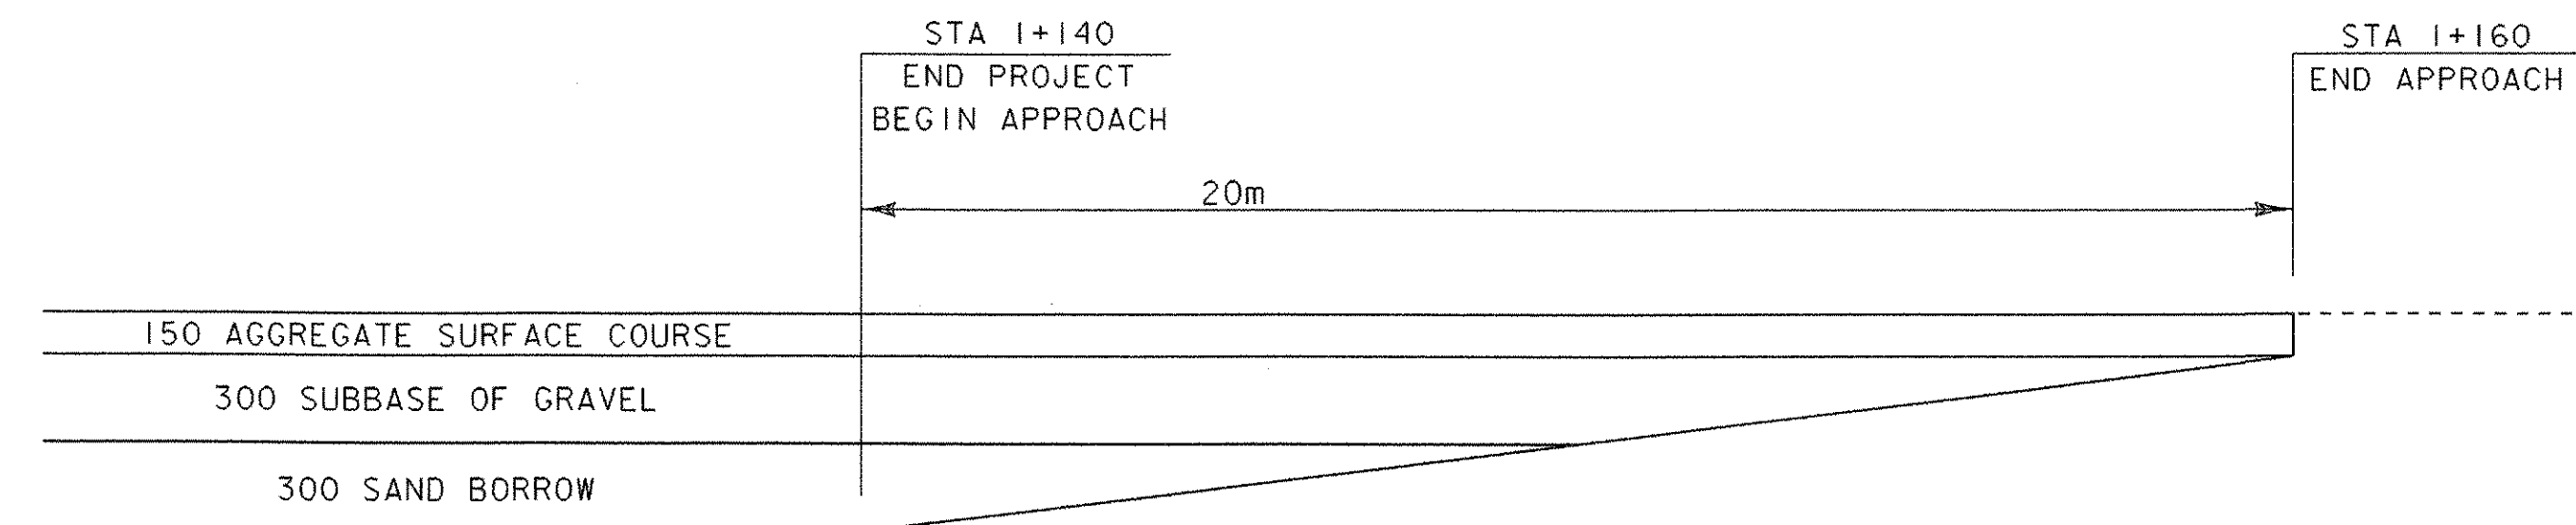
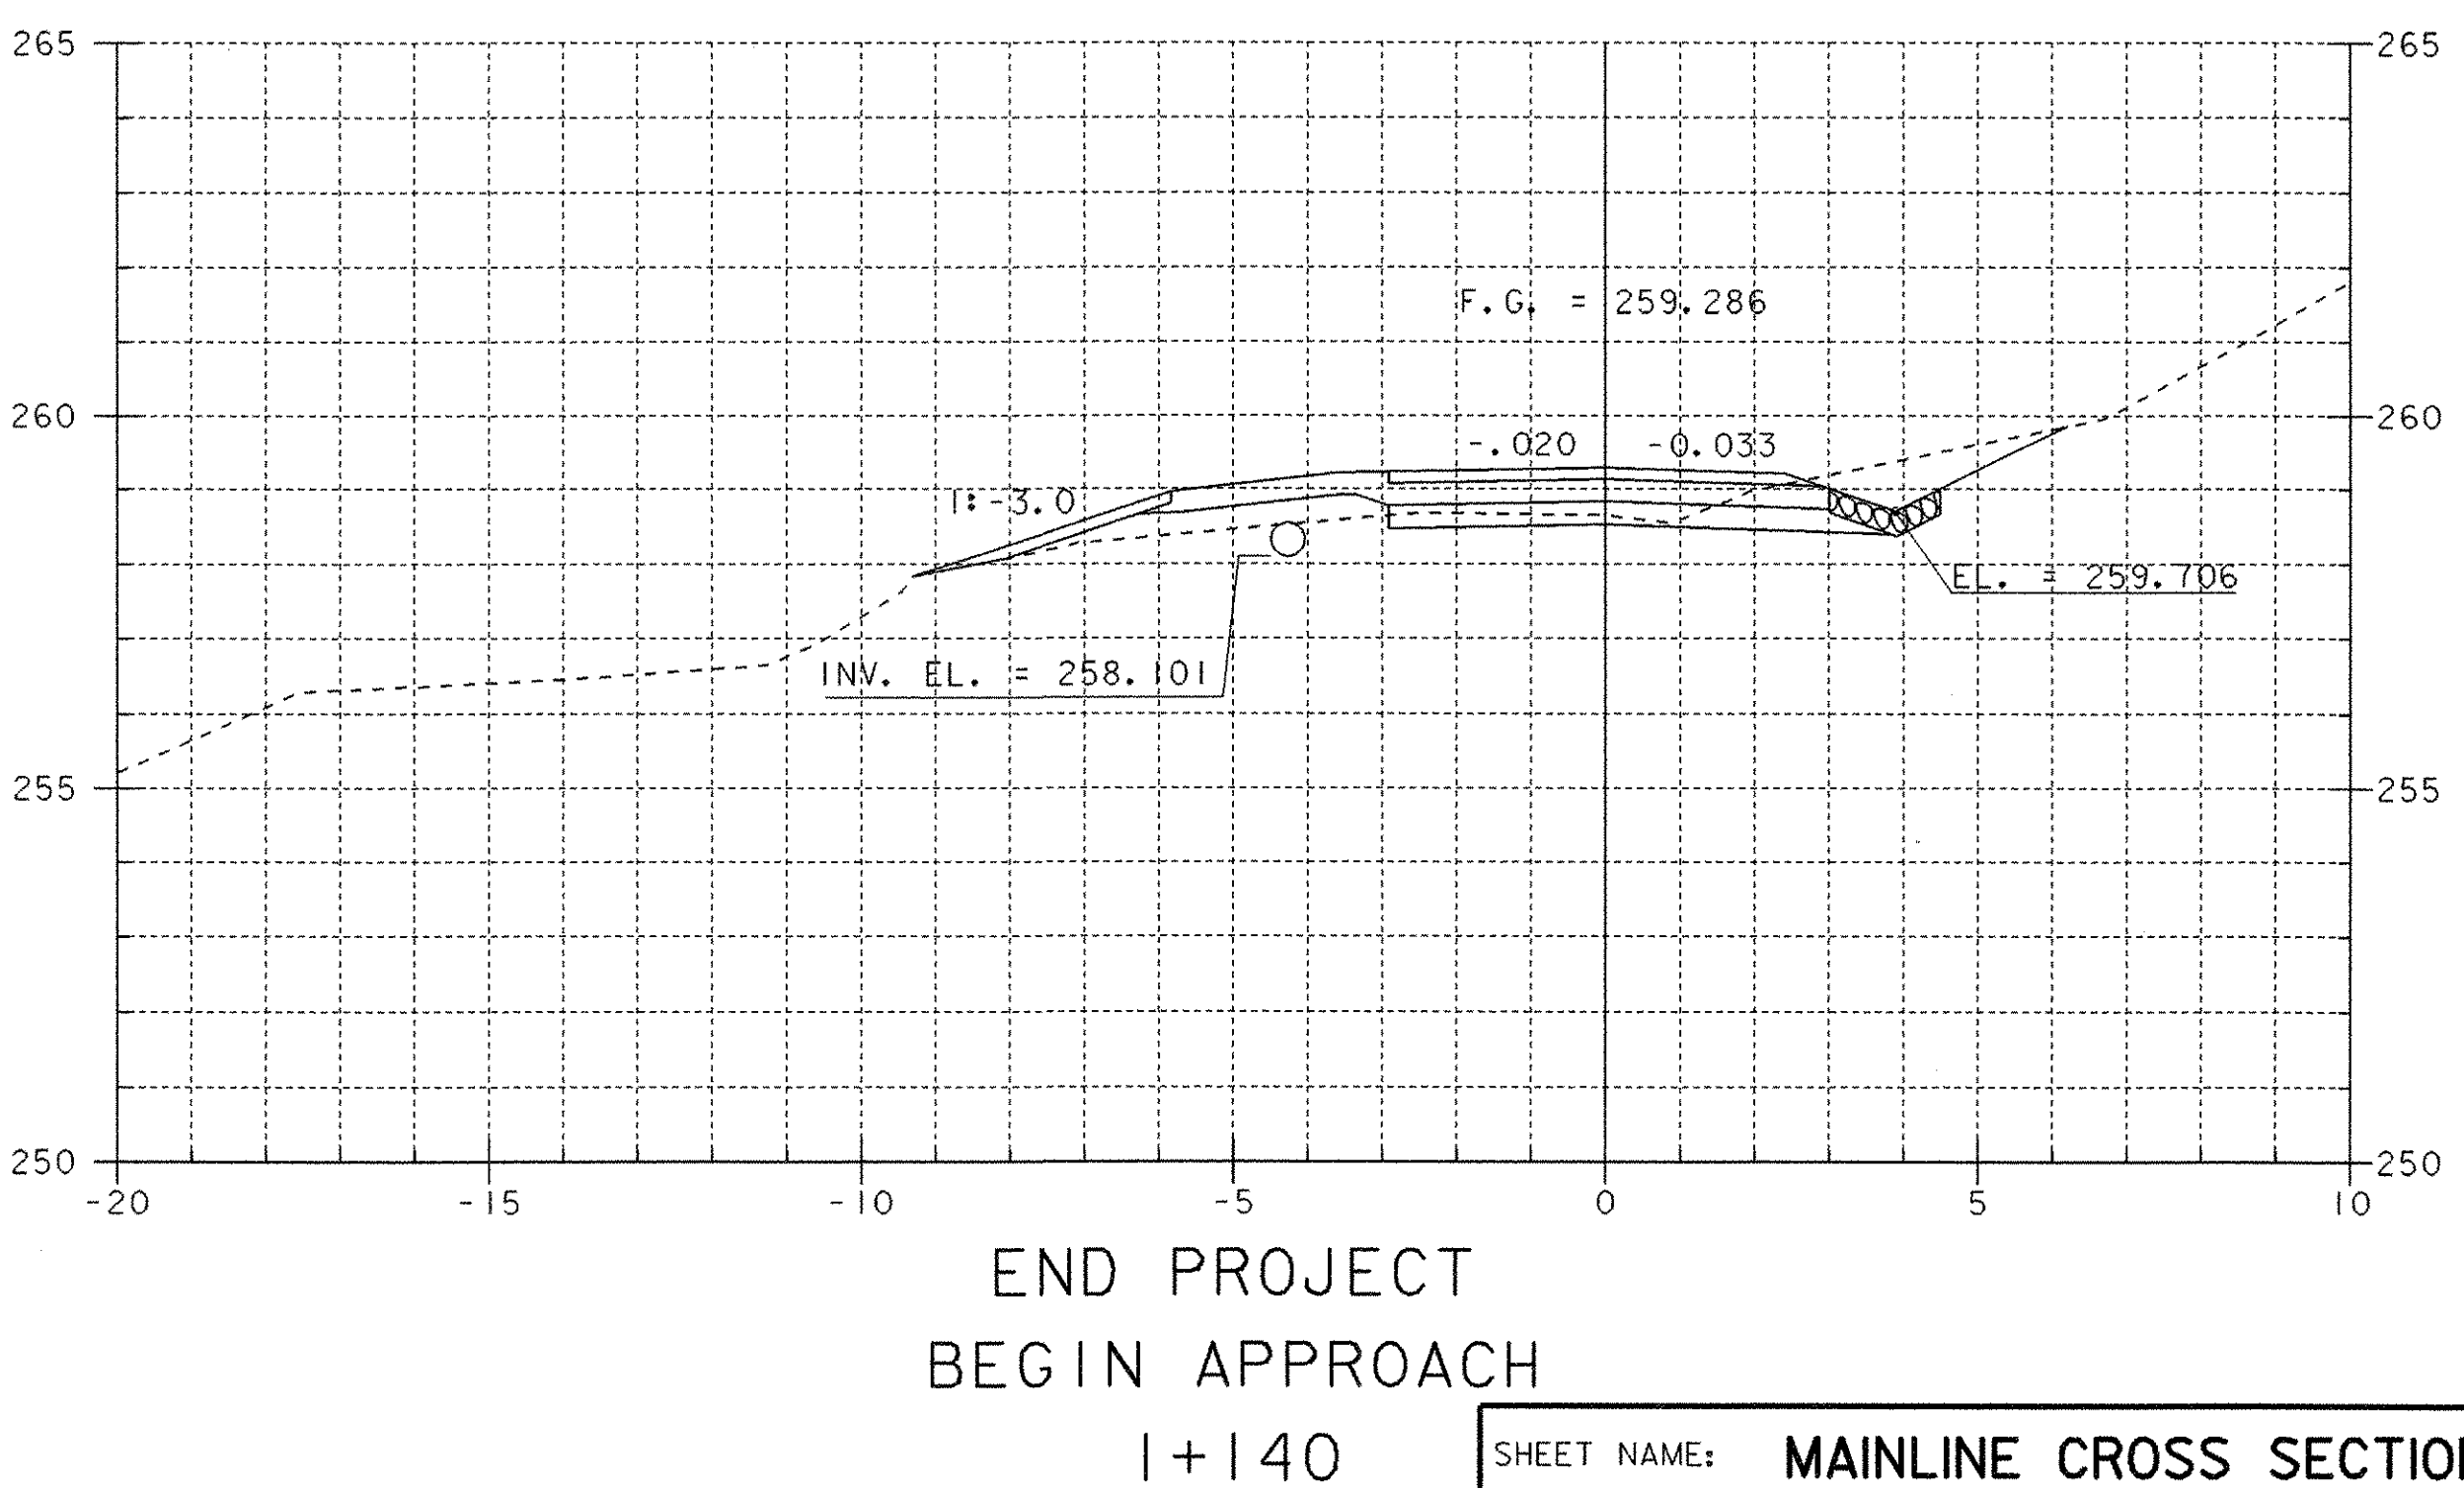
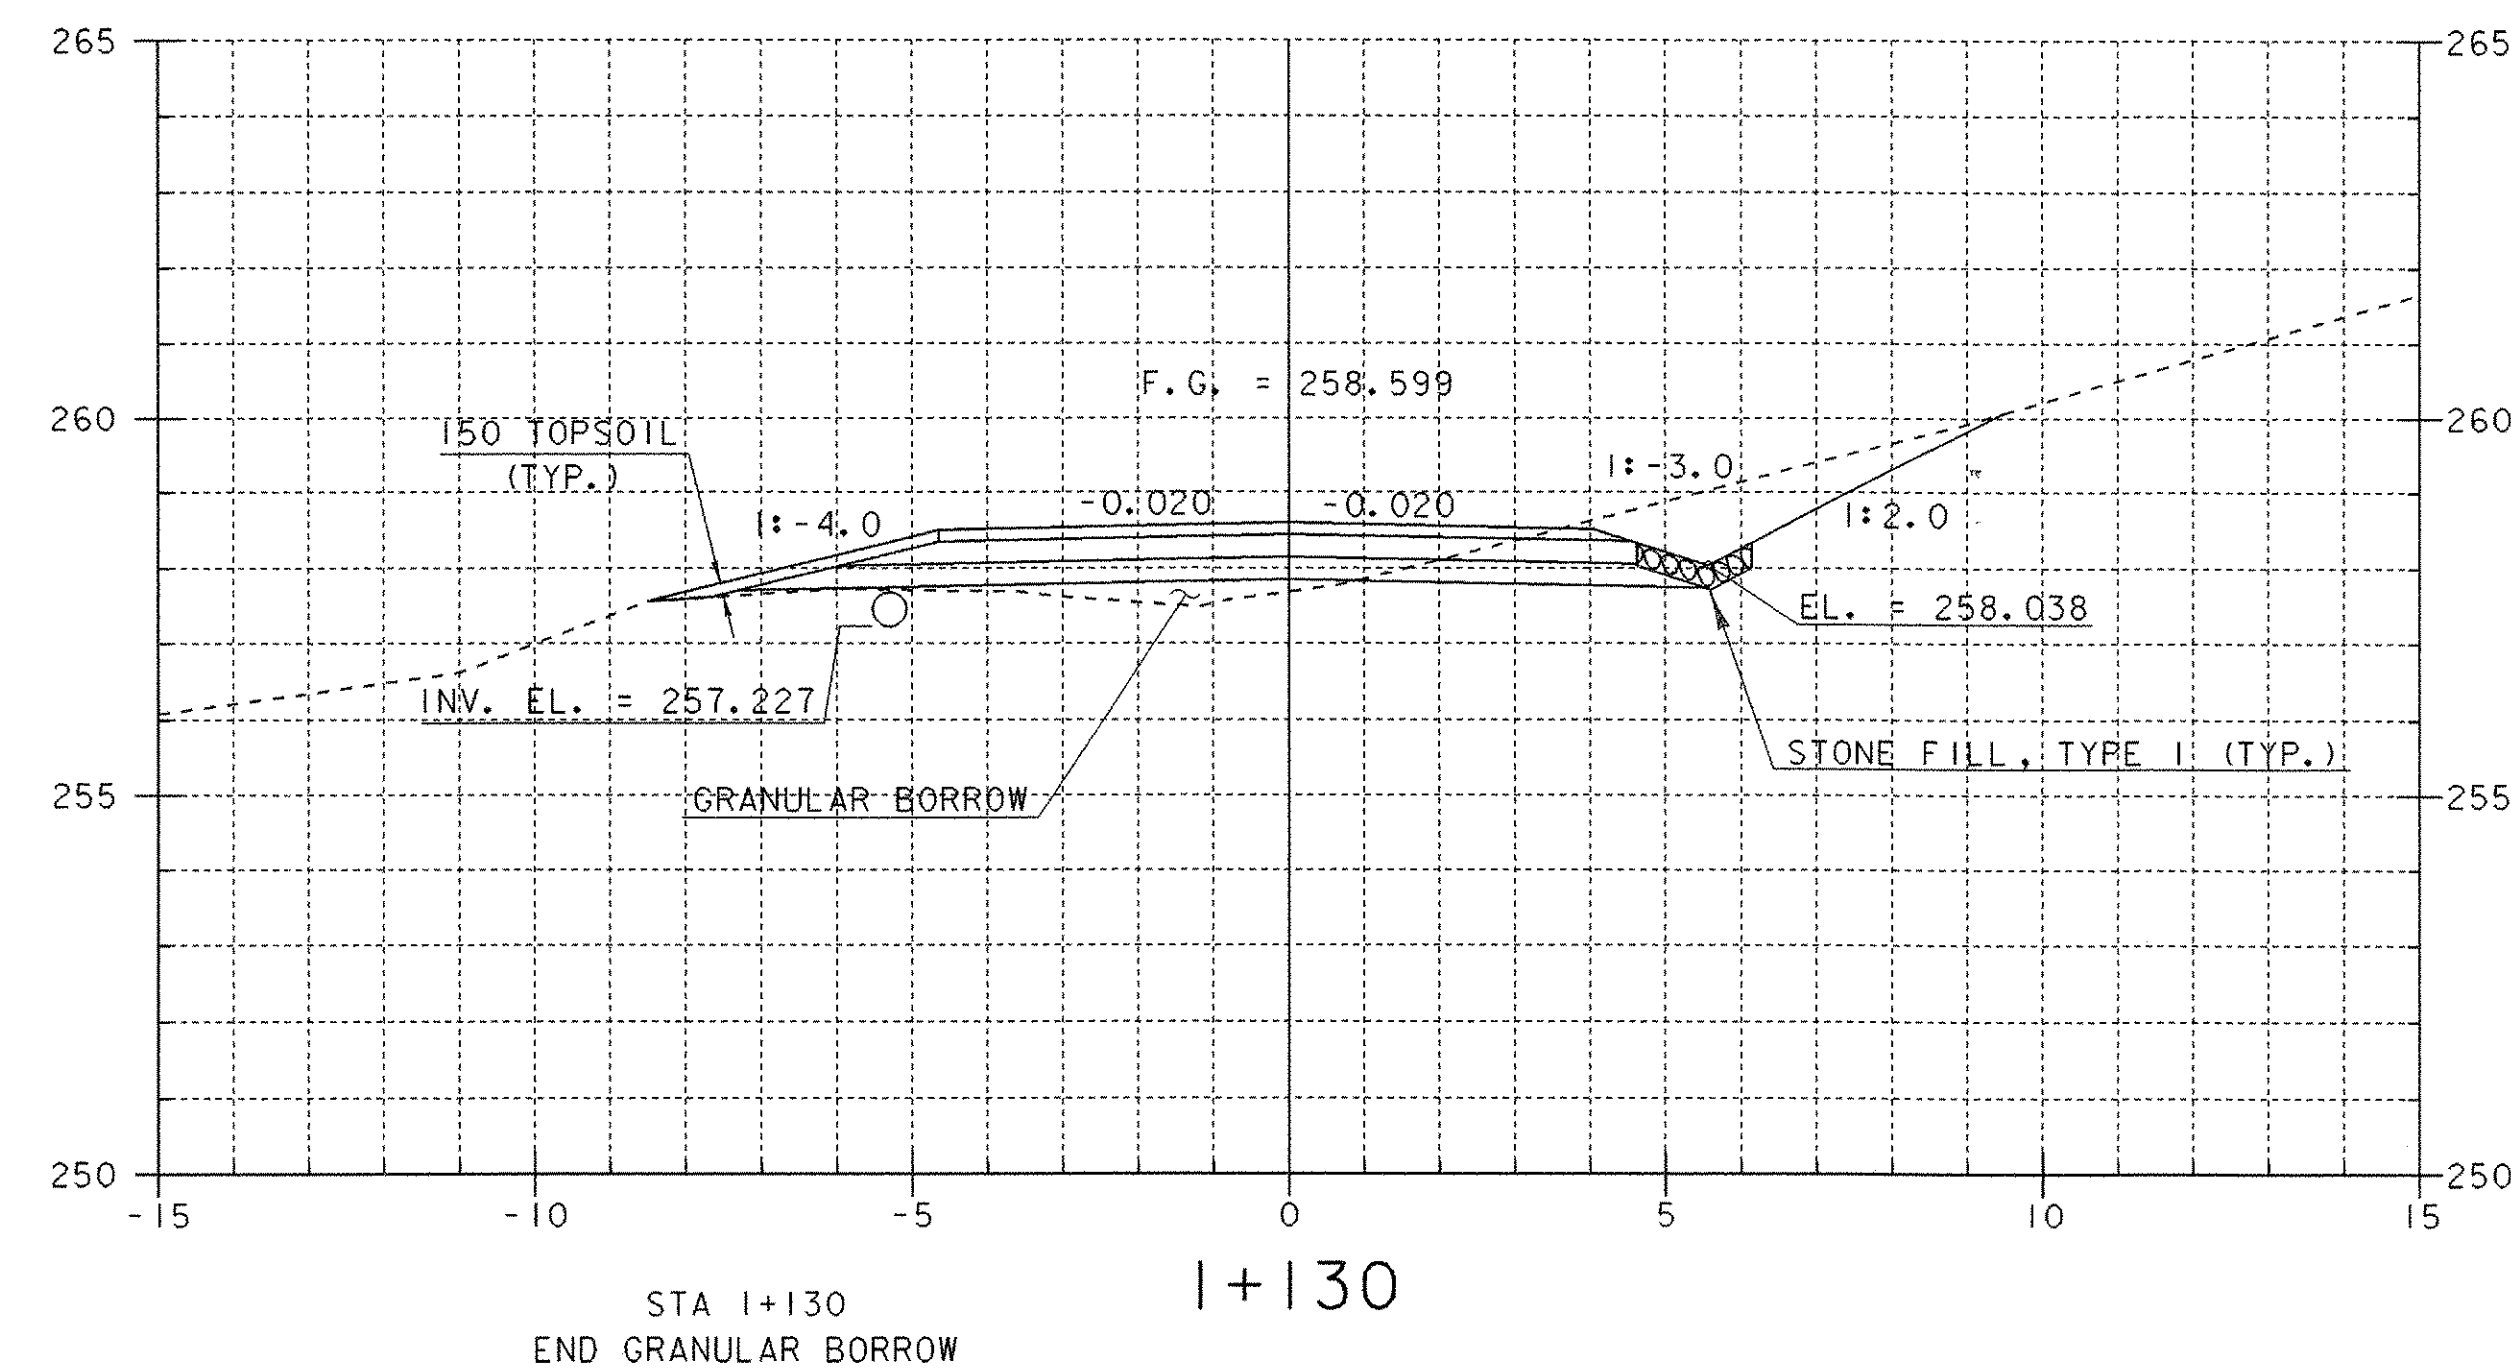


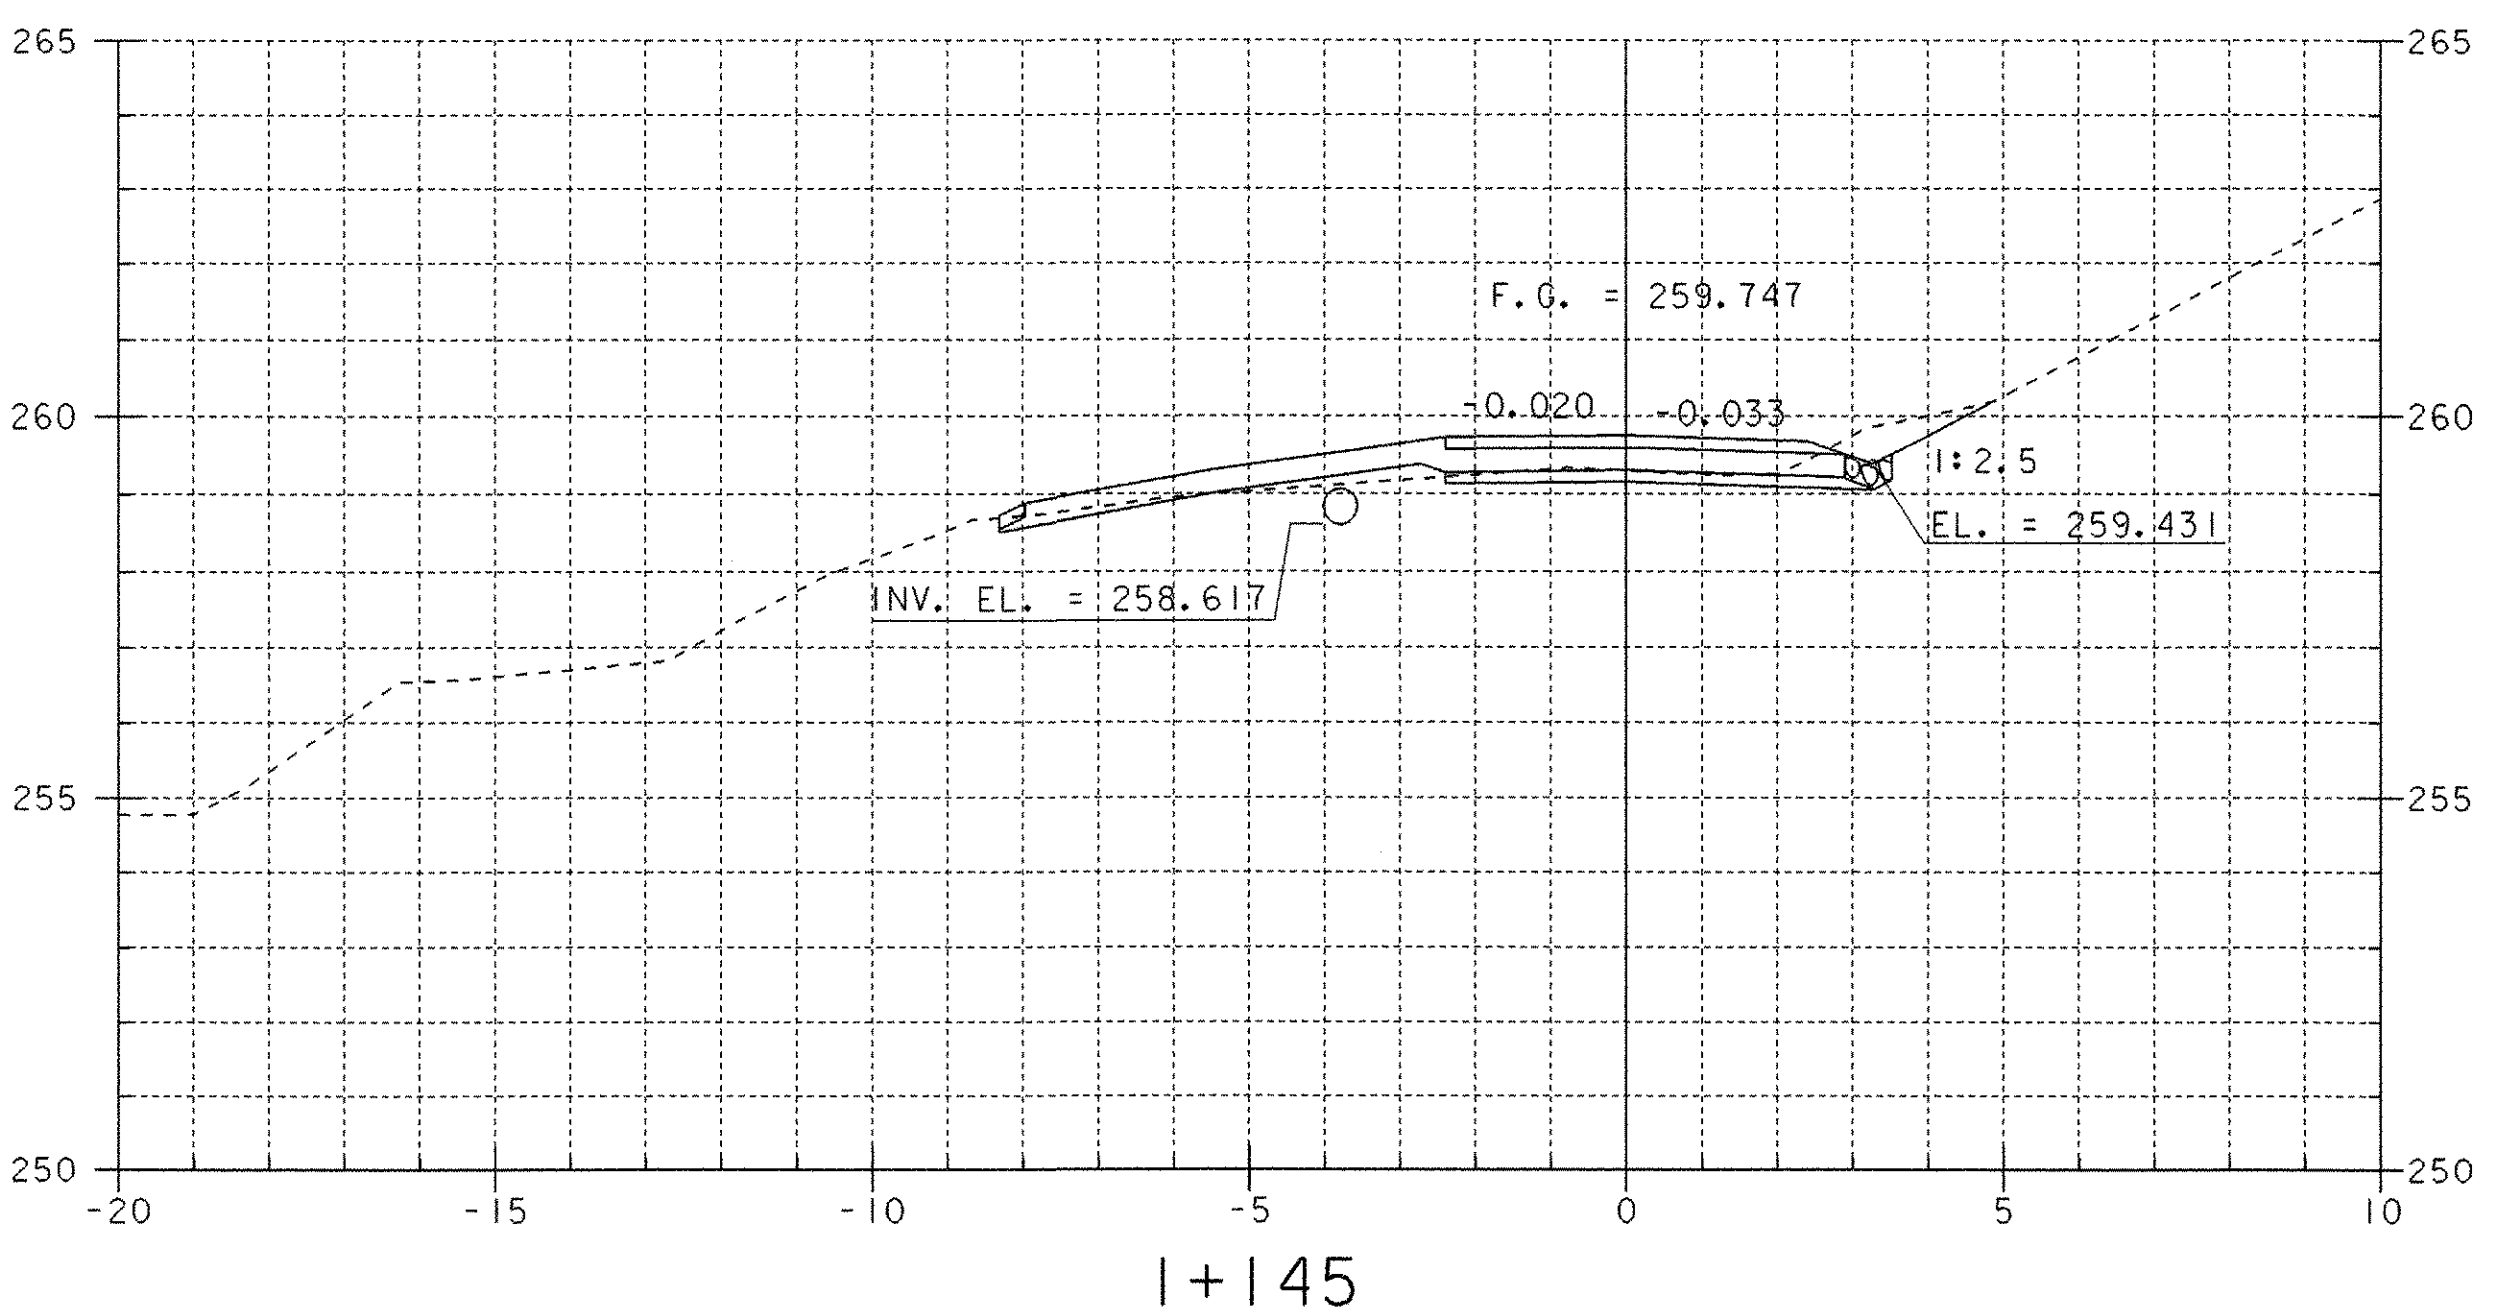

# TRANSITION DIAGRAM

NTS

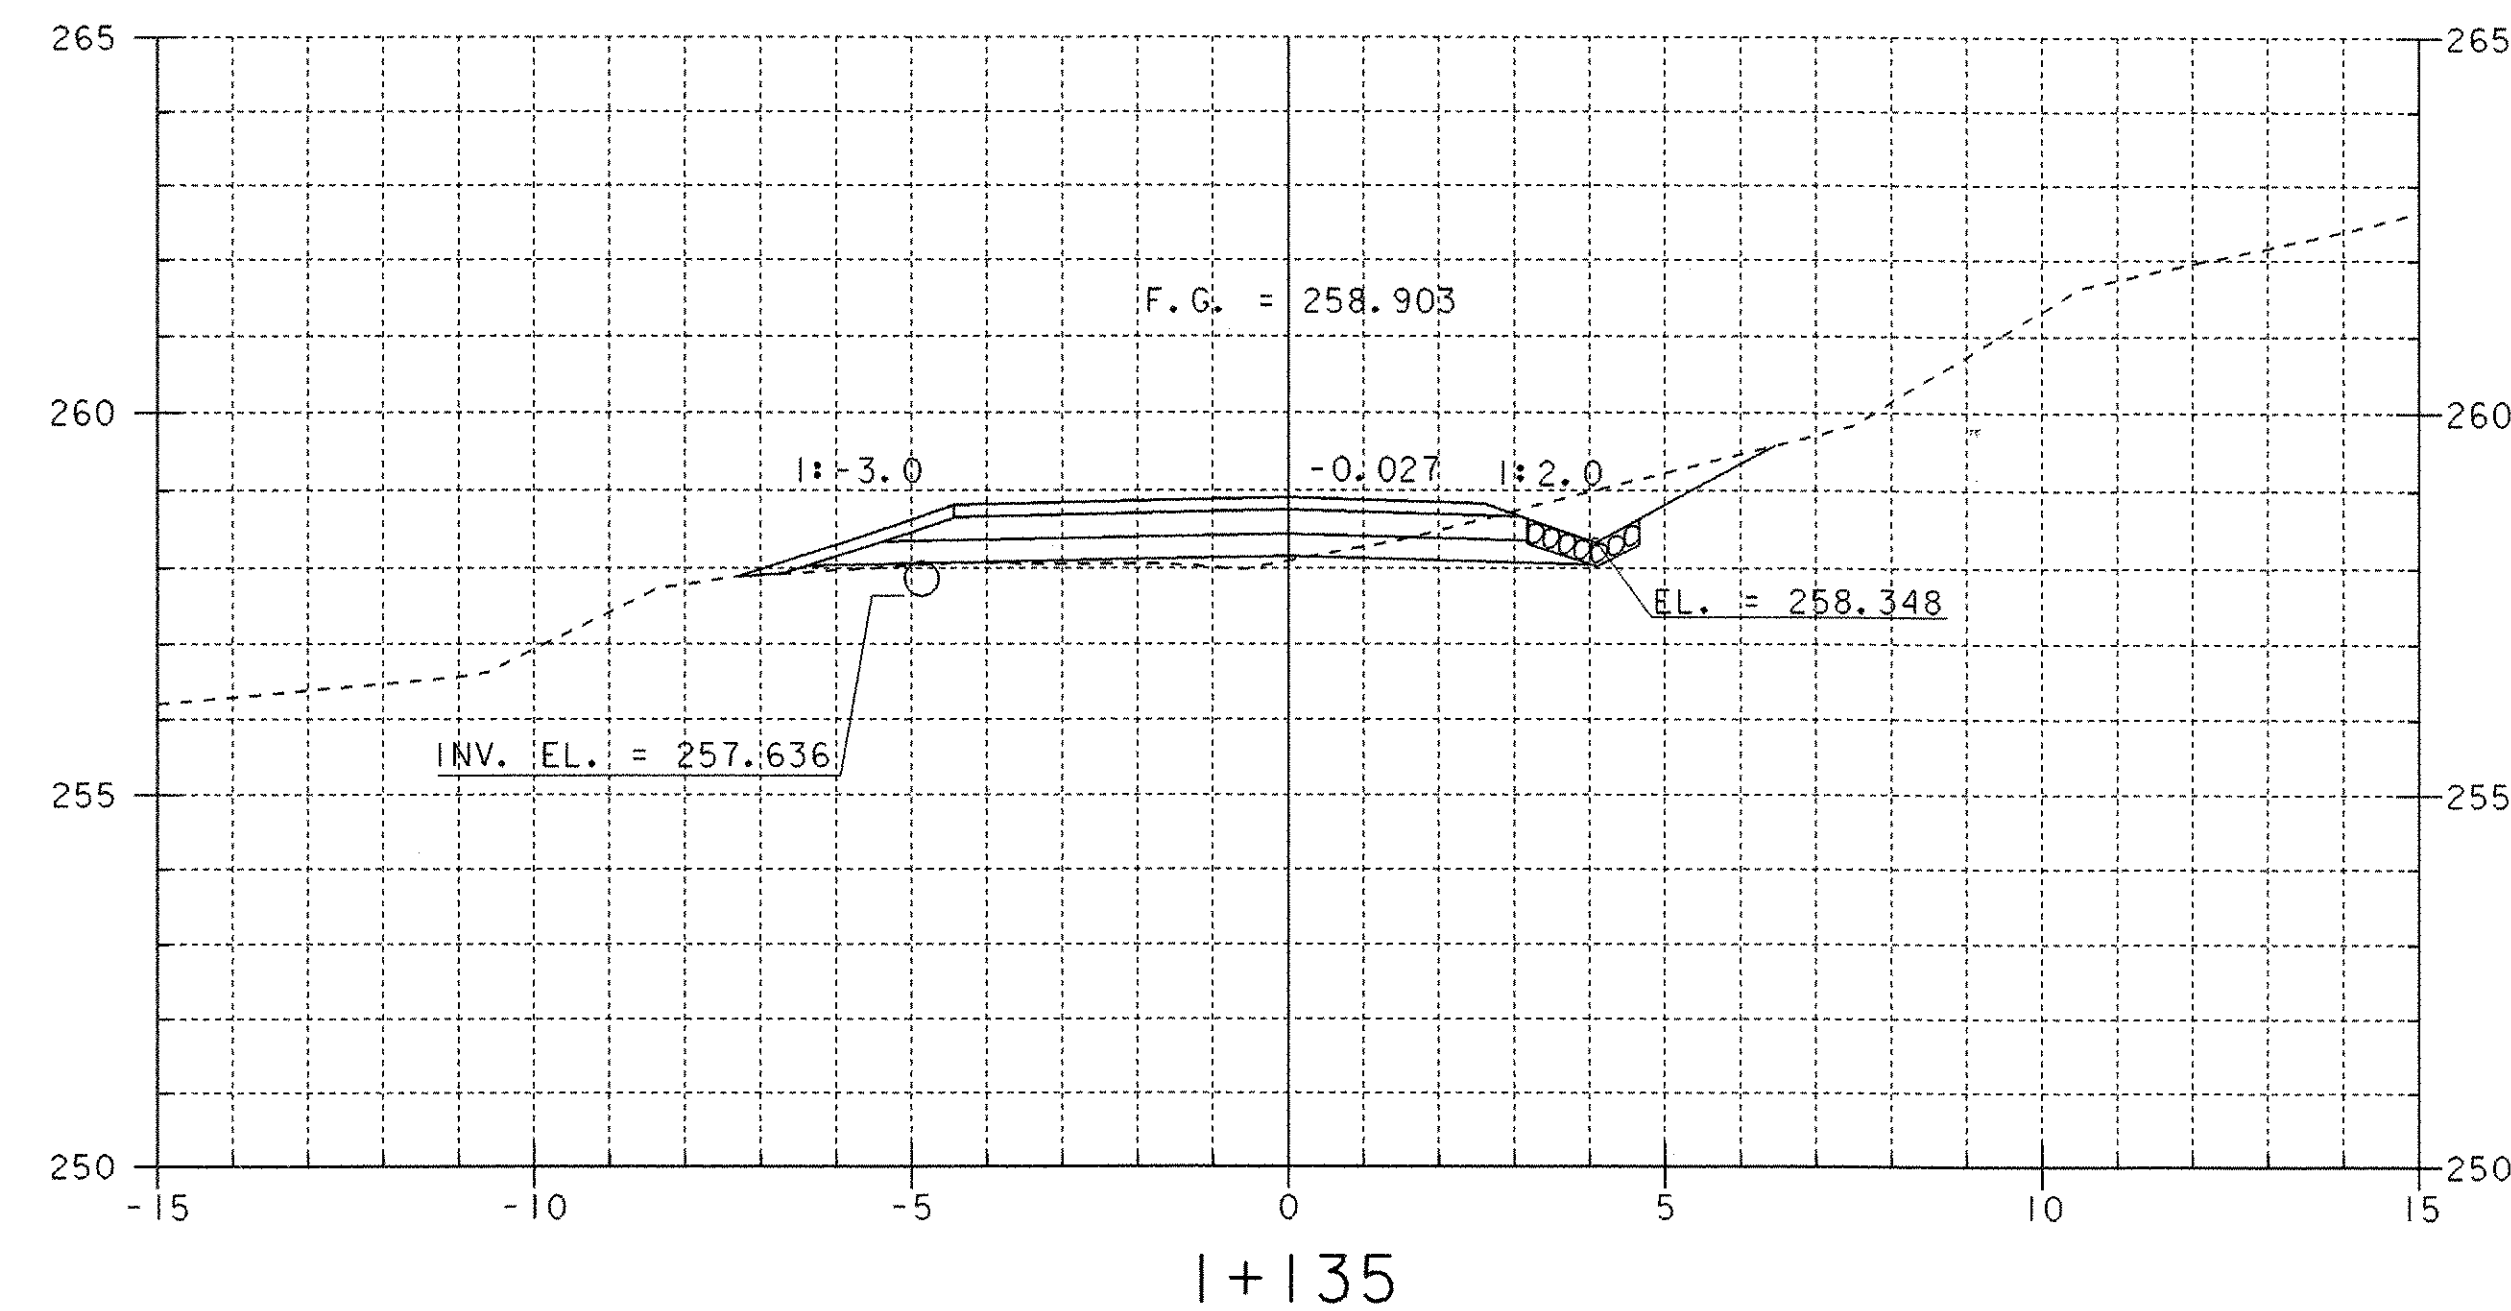

|                                            |                               |
|--------------------------------------------|-------------------------------|
| SHEET NAME: <b>MAINLINE CROSS SECTIONS</b> |                               |
| PROJECT NAME: <b>MONTGOMERY</b>            | HIGHWAY NO.: <b>TH 35</b>     |
| PROJECT NUMBER: <b>BRO 1448(20)</b>        | BRIDGE NO.: <b>24</b>         |
|                                            | OVER: <b>PACIFIC BROOK</b>    |
| FILE NAME: <b>/PW/94j124/sj124xsl.dgn</b>  | PLOT DATE: <b>06-DEC-2005</b> |
| PROJECT MANAGER: <b>R. WHITCOMB</b>        | DRAWN BY: <b>J. GILMORE</b>   |
| DESIGNED BY: <b>C. CARLSON</b>             | IPARM NAME: <b>sj124mx7.1</b> |
| BRIDGE SHEET NUMBER:                       | SHEET <b>43</b> OF <b>50</b>  |