


5+003

CHANNEL STA 5+002.5 LT + RT
BEGIN GRUBBING MATERIAL

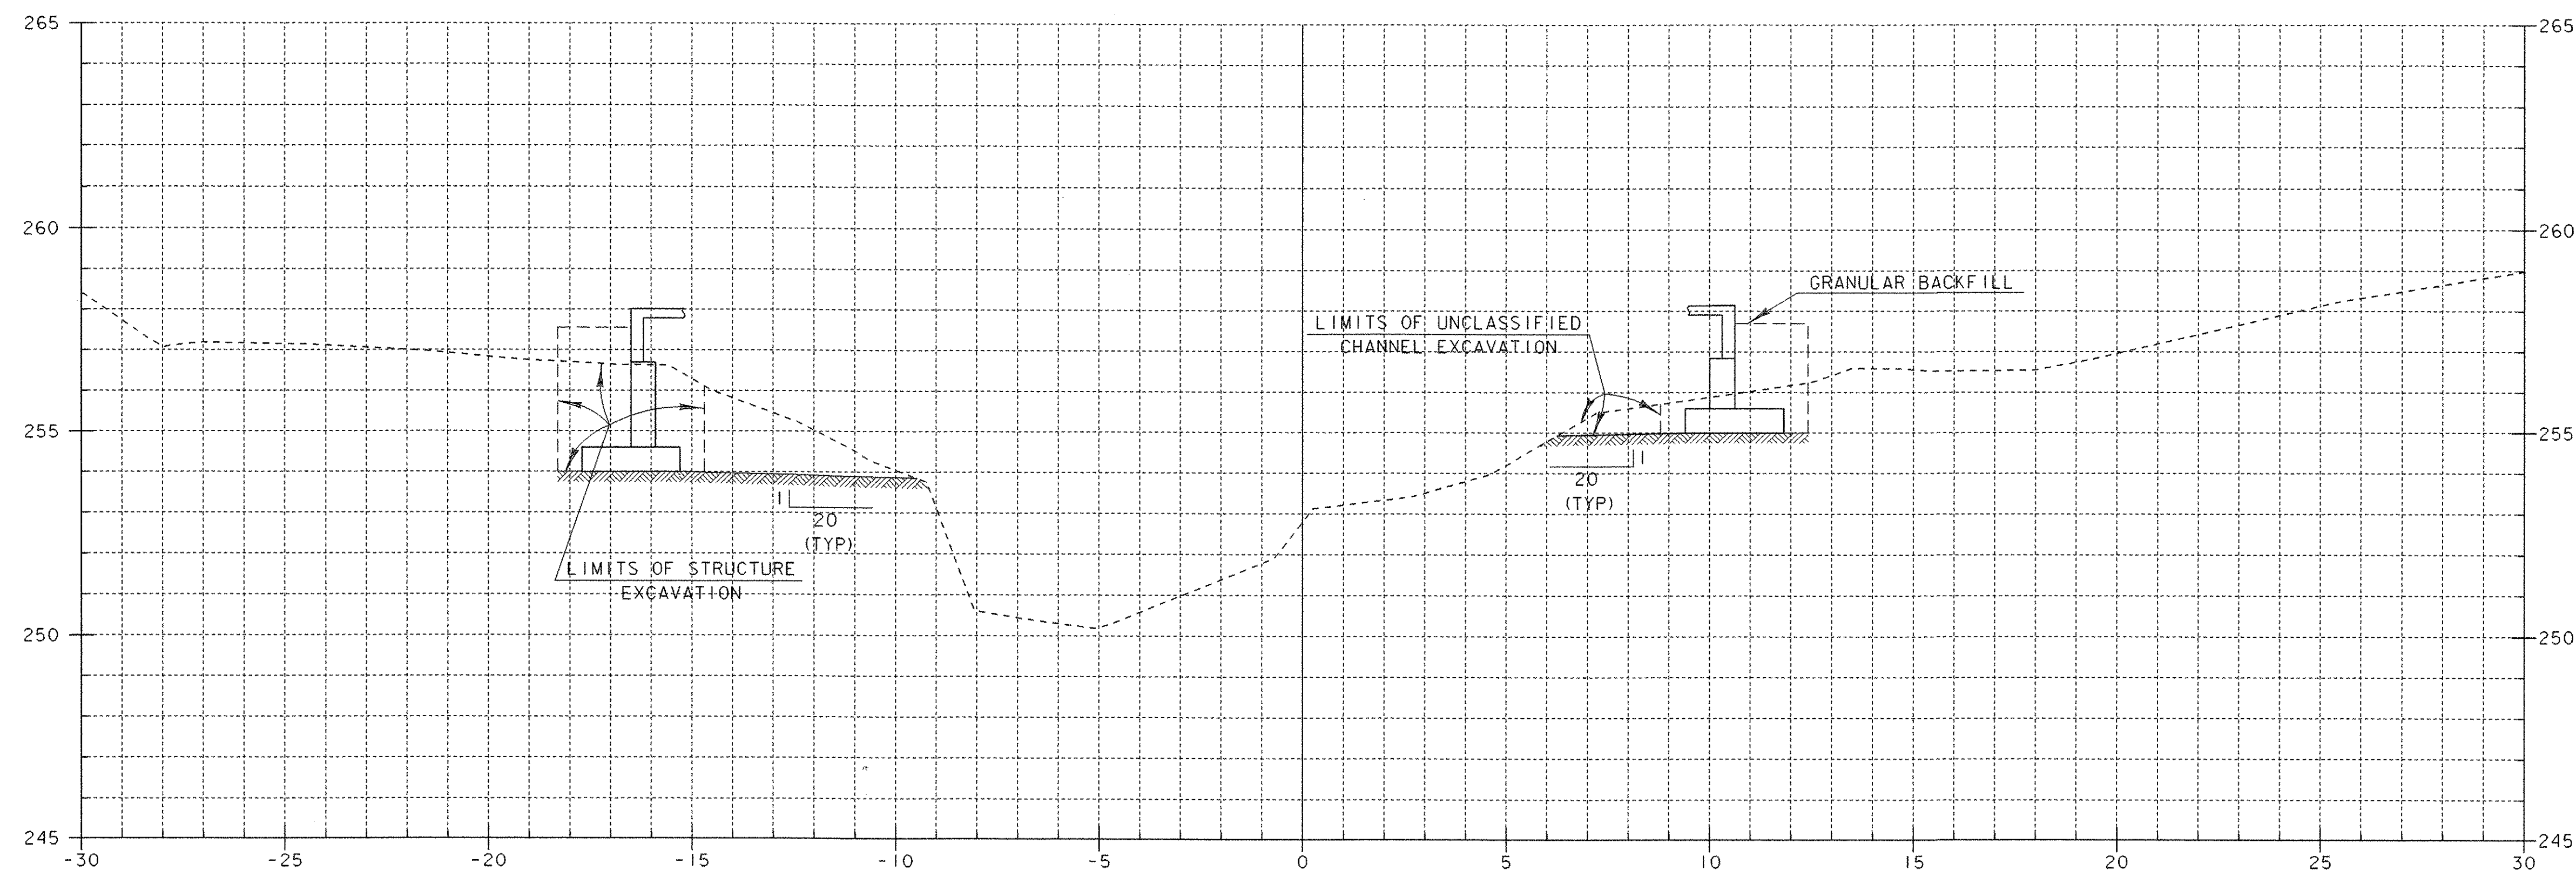

5+000

CHANNEL STA 4+997.5 LT + RT
END GRUBBING MATERIAL

SHEET NAME: CHANNEL CROSS SECTIONS	
PROJECT NAME: MONTGOMERY	HIGHWAY NO.: TH 35
PROJECT NUMBER: BRO 1448(20)	BRIDGE NO.: 24
	OVER: PACIFIC BROOK
FILE NAME: W/94j124/sj124xsl.dgn	PLOT DATE: 06-DEC-2005
PROJECT MANAGER: R. WHITCOMB	DRAWN BY: J. GILMORE
DESIGNED BY: C. CARLSON	IPARM NAME: sj124x5.1
BRIDGE SHEET NUMBER:	SHEET 47 OF 50