


ORIGINAL SURVEY
 DATE: 1/15/06
 DRAWN BY: CWG
 CHECKED BY: JMS
 SCALE: AS SHOWN
 SHEET NO.: 051

ORIGINAL SURVEY
 DATE: 1/15/06
 DRAWN BY: CWG
 CHECKED BY: JMS
 SCALE: AS SHOWN
 SHEET NO.: 051

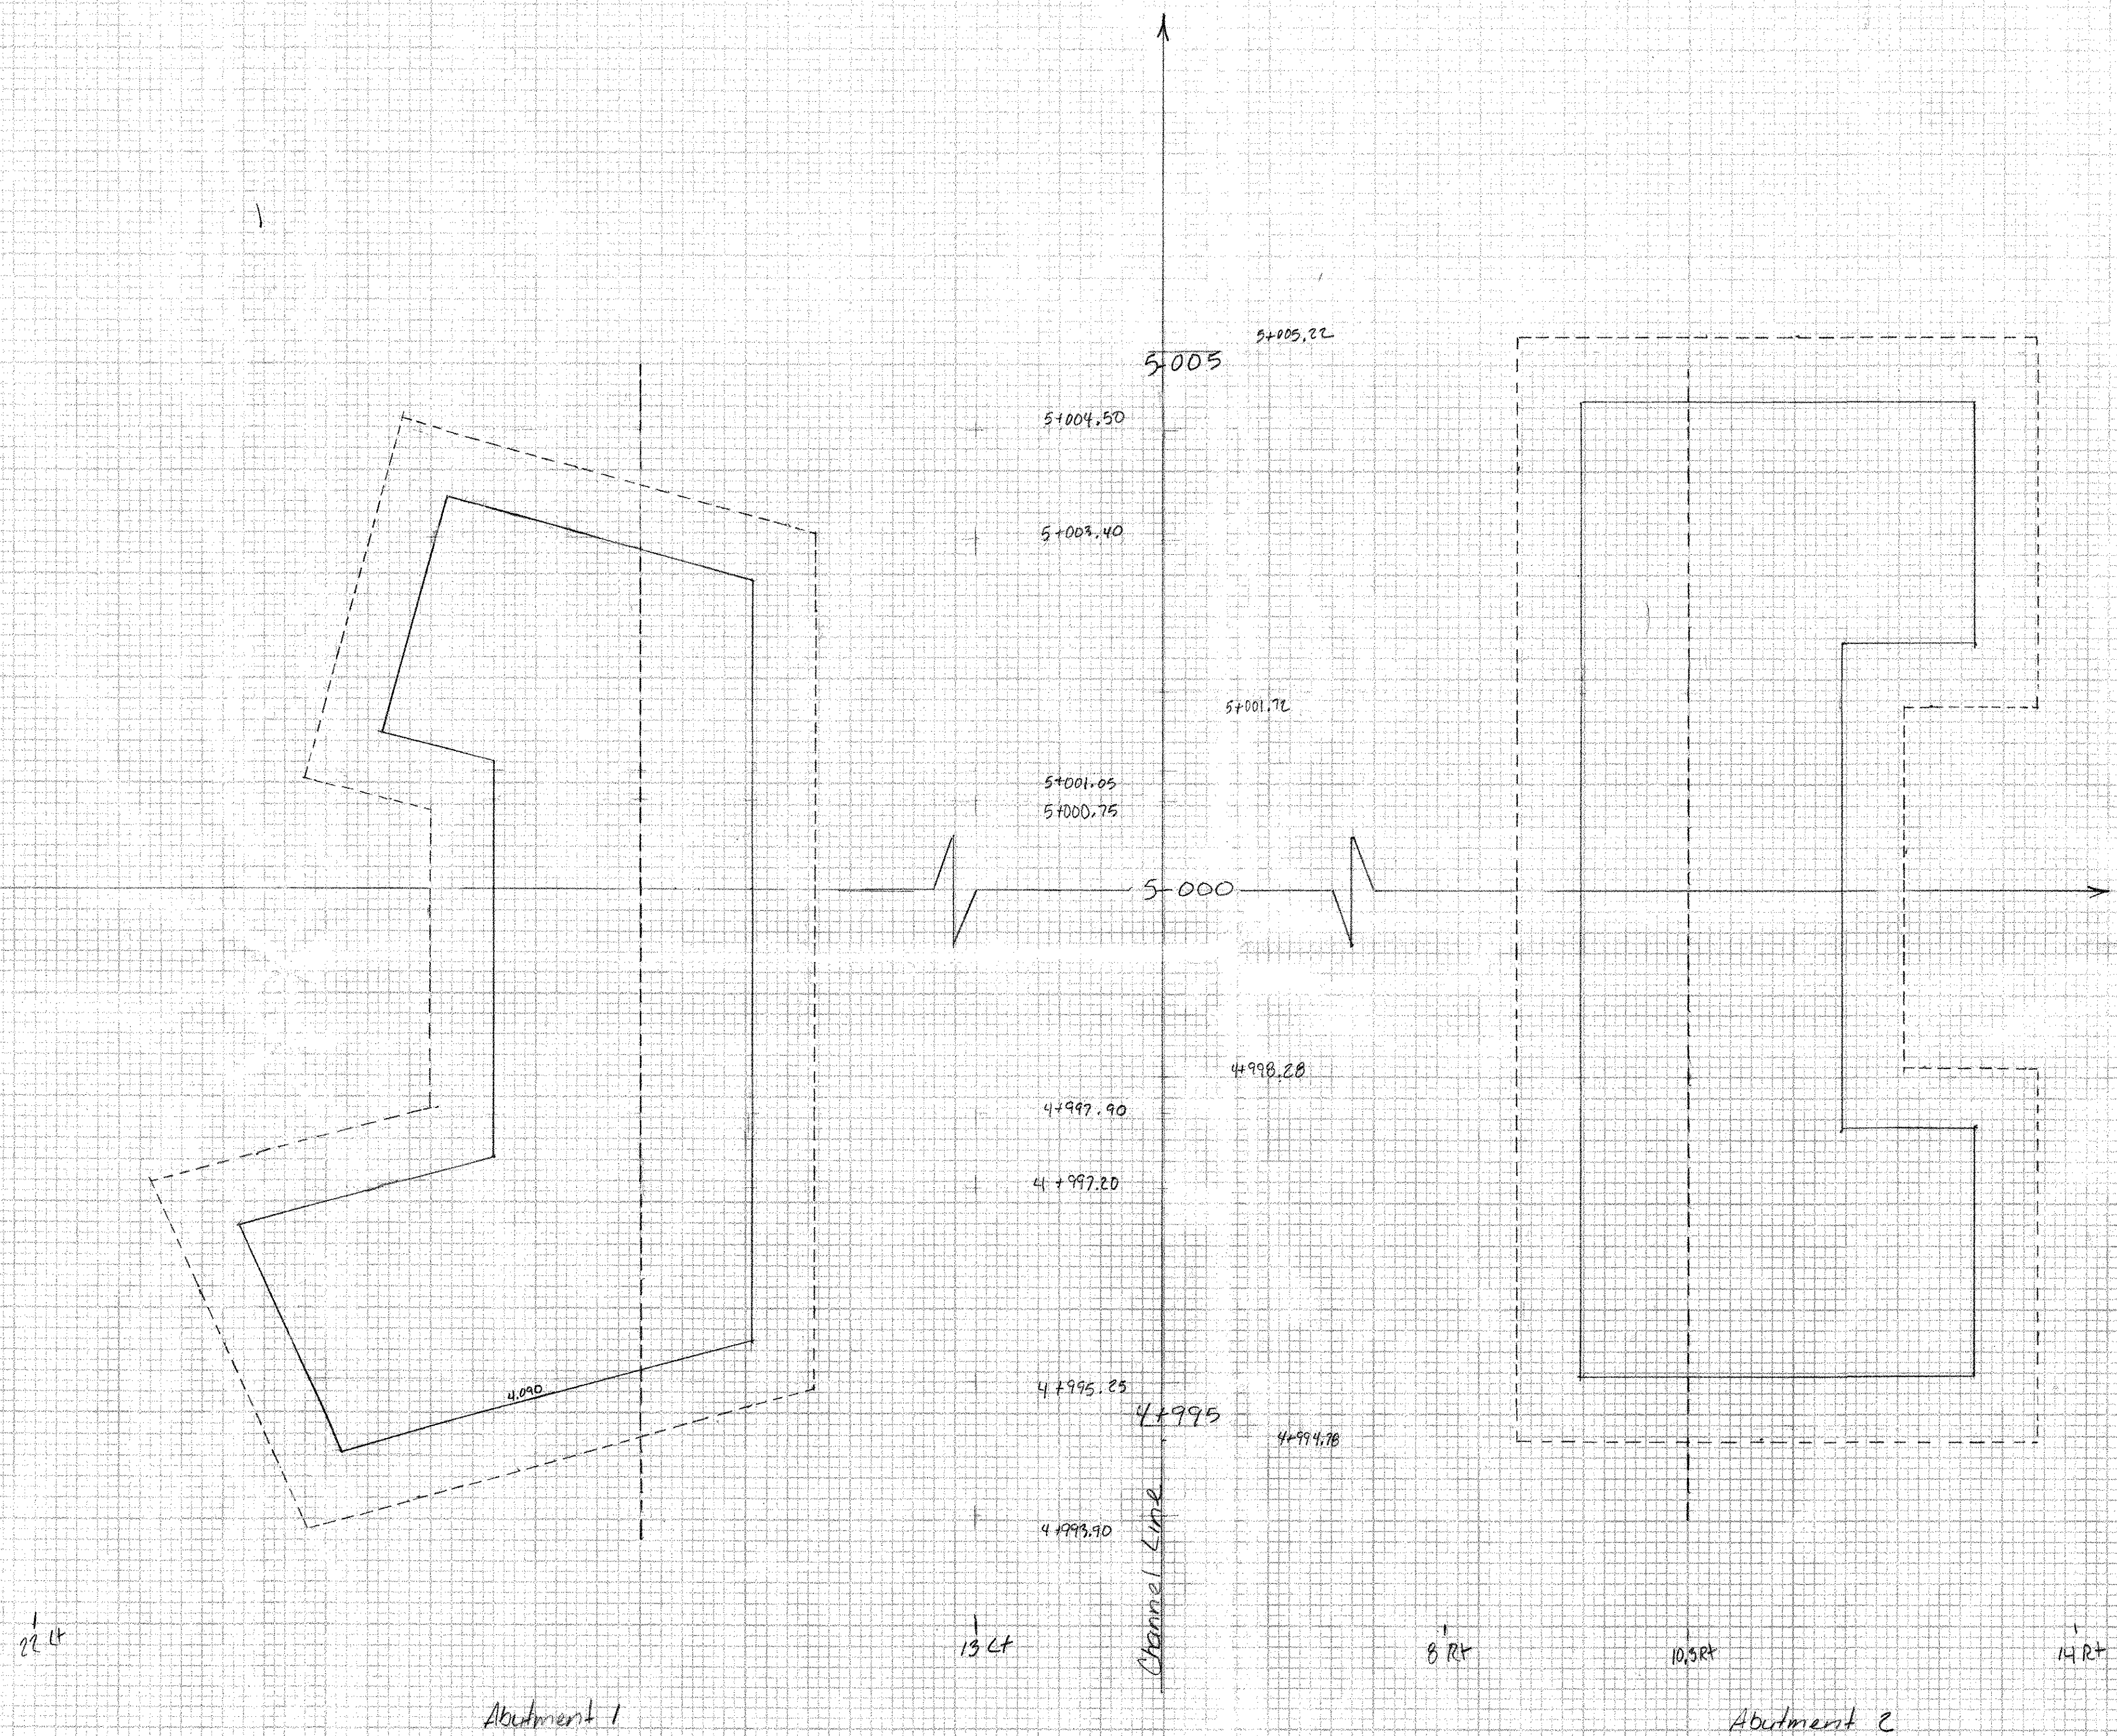

Structure Excavation
 Montgomery 3RD 1448 (20)
 051 CWG 4/15/06