



METRIC 1. ALL DIMENSIONS ARE IN MILLIMETERS UNLESS OTHERWISE NOTED.  
2. ALL WEIGHTS ARE IN KILOGRAMS.

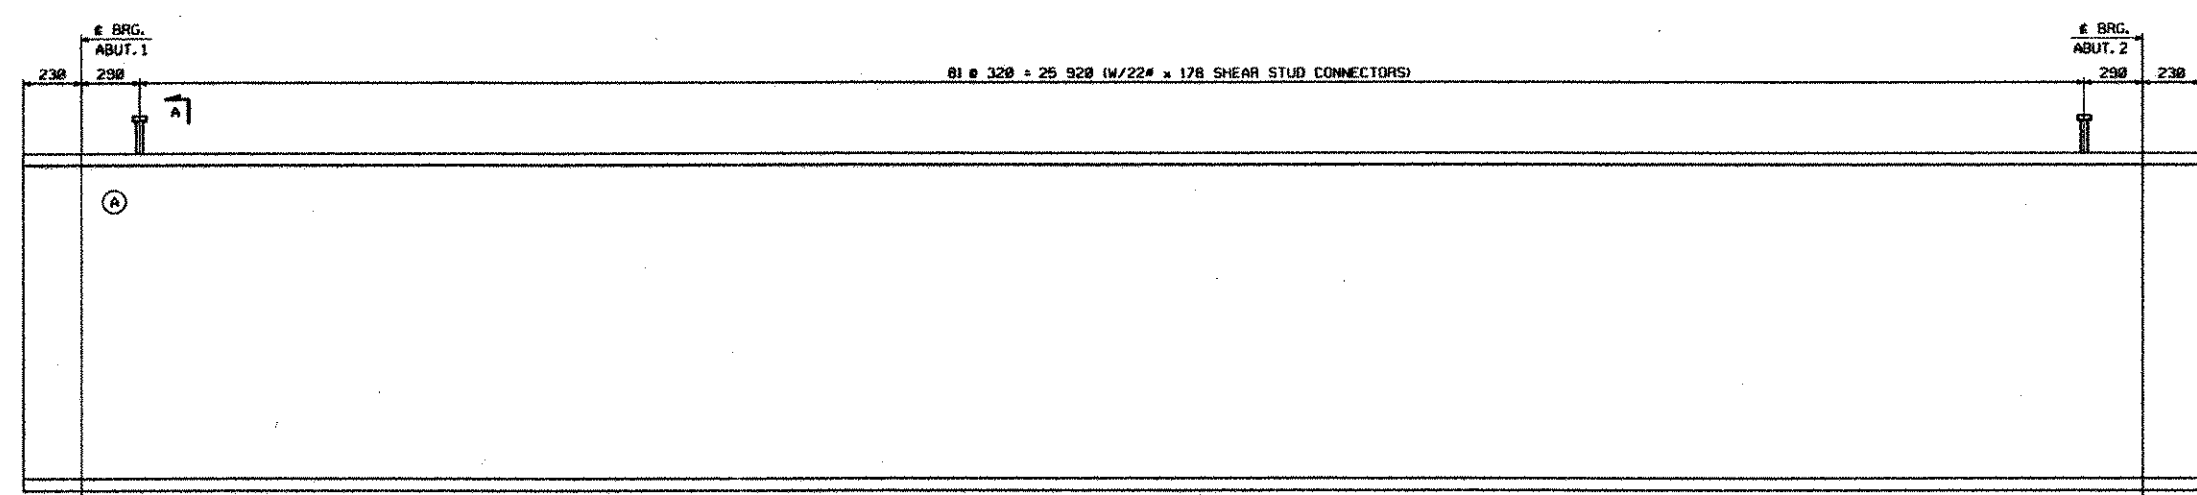

SHEAR STUD CONNECTOR LOCATION LAYOUT

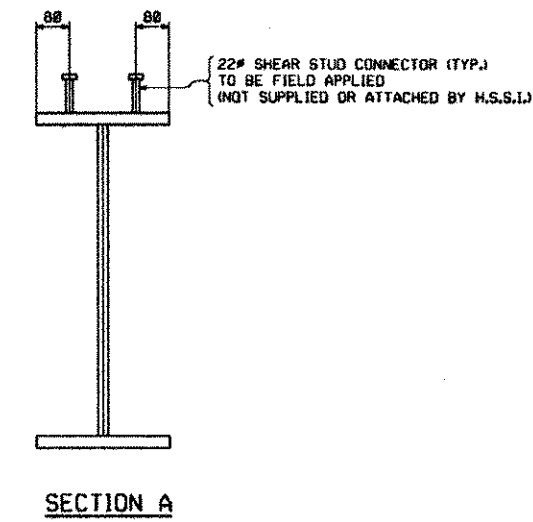


SECTION A

RECEIVED  
 OK'D BY Mit OK'D BY Cue  
 MAR 17 2006  
 RESUBMIT \_\_\_\_\_ APPROVED \_\_\_\_\_  
 BY \_\_\_\_\_ DATE \_\_\_\_\_

NOTES:  
 FOR NOTES SEE DRAWING E1.  
 WORK THIS DRAWING WITH DRAWING E1.  
 (C) INDICATES SUFFIX MARK OF SHIPPING PIECE.

NO.	REVISION	BY	DATE

HIGH STEEL STRUCTURES, INC.   
 ERECTION FRAMING PLAN - STUD LAYOUTS  
 RTE. NO. 14 35 BRIDGE NO. 242 OVER PACIFIC BROOK  
 STA. NO. 14 35 STA 1480+00 TO STA 1482+00  
 TOWN OF MONTGOMERY  
 FRANKLIN COUNTY, VERMONT  
 STATE OF VERMONT AGENCY OF TRANSPORTATION  
 STATE CONTRACT PROJECT NO. BRD 1448 (SR)  
 CONTRACTOR DAN ST. PIERRE CONTRACTOR, INC.  
 DRAWING SHEET NO. 100 100 100 100 DATE: 3/2/06  
 CONTRACT NO. VT-05001-1 SHEET E2 OF E2

062 ss