


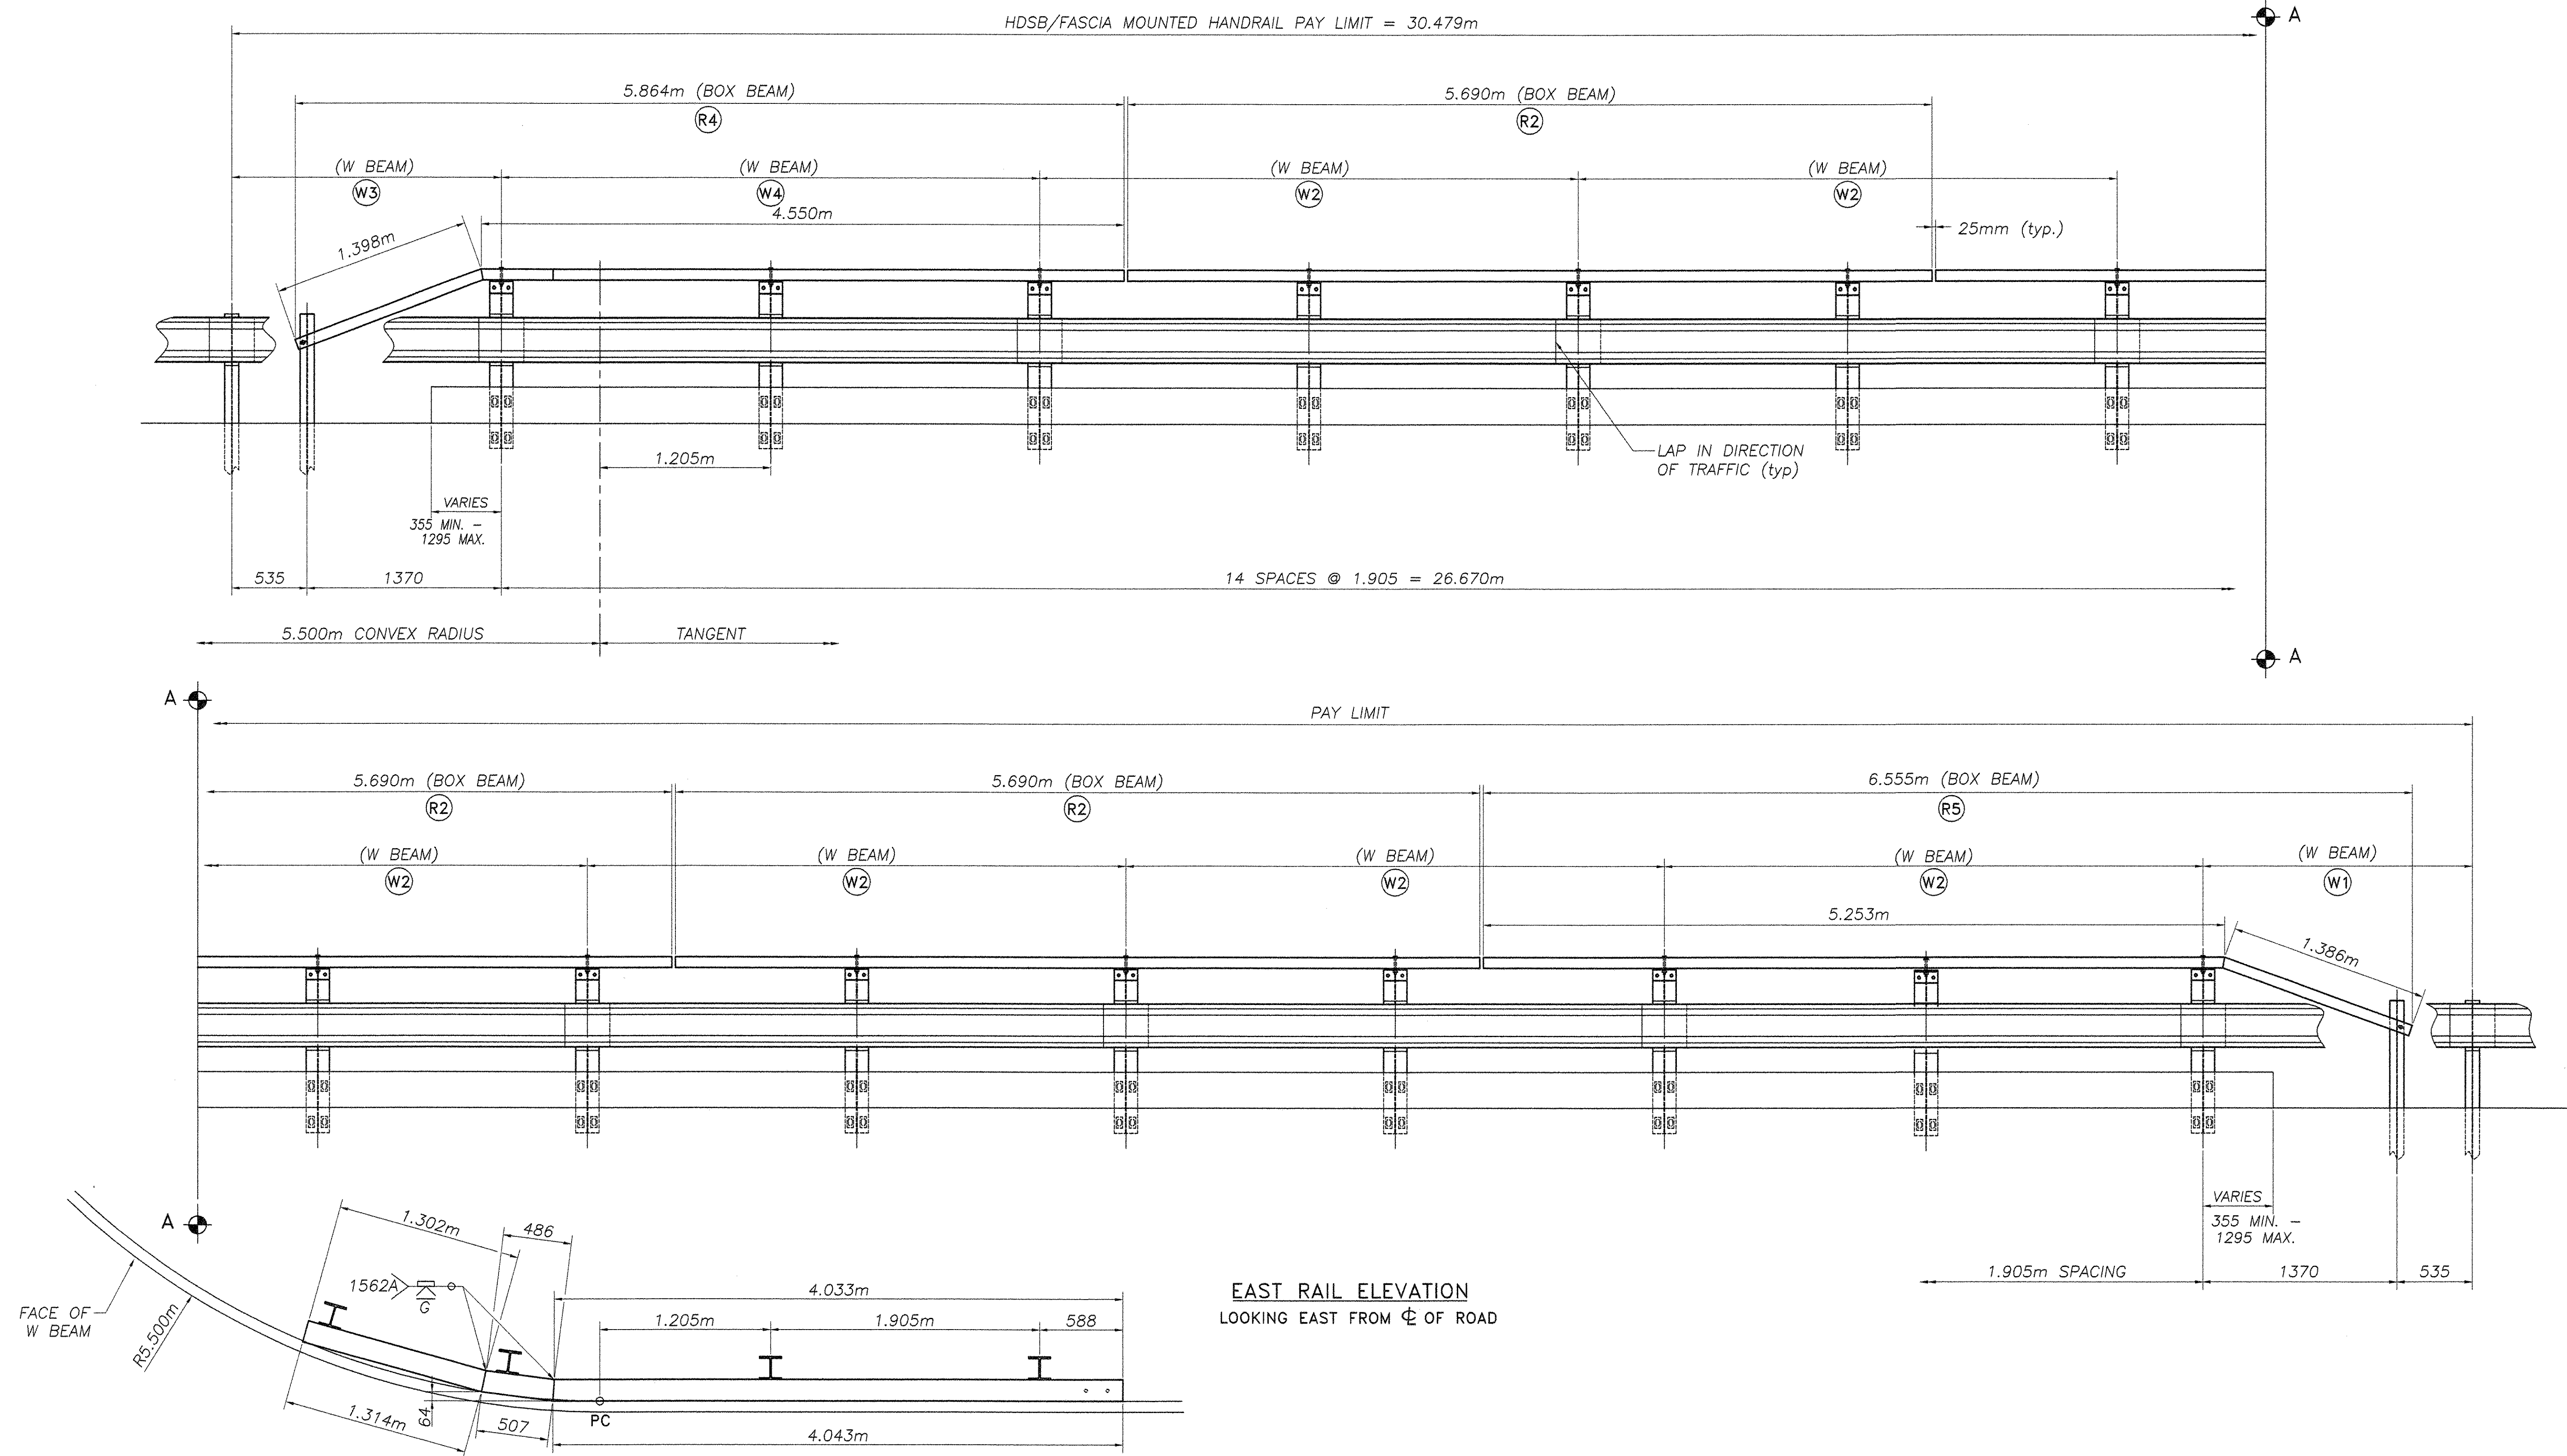

HIGHWAY SAFETY CORP.
GLASTONBURY, CT

VTrans - PDD
SEP 0 5 2006
Structures Design
Section

ITEM # 525.43 FASCIA MOUNTED HDSB WITH HANDRAIL
PROJECT NUMBER: BRO 1448 (20)
TOWN OF MONTGOMERY, VT
COUNTY OF FRANKLIN
ROUTE NO. TH 35, BRIDGE NO. 24

DATE 7/20/06
SCALE NTS
SHEET NO. 1562
REVISION 0

GENERAL CONTRACTOR
SUB CONTRACTOR F.R. LAFAYETTE INC.

REVISIONS		
No.	Remarks	Date
0	Initial submittal	7/31/06
0	Second submittal	8/16/06

—RECORD PLANS—