


106+00
STA 106+15 END APPROACH

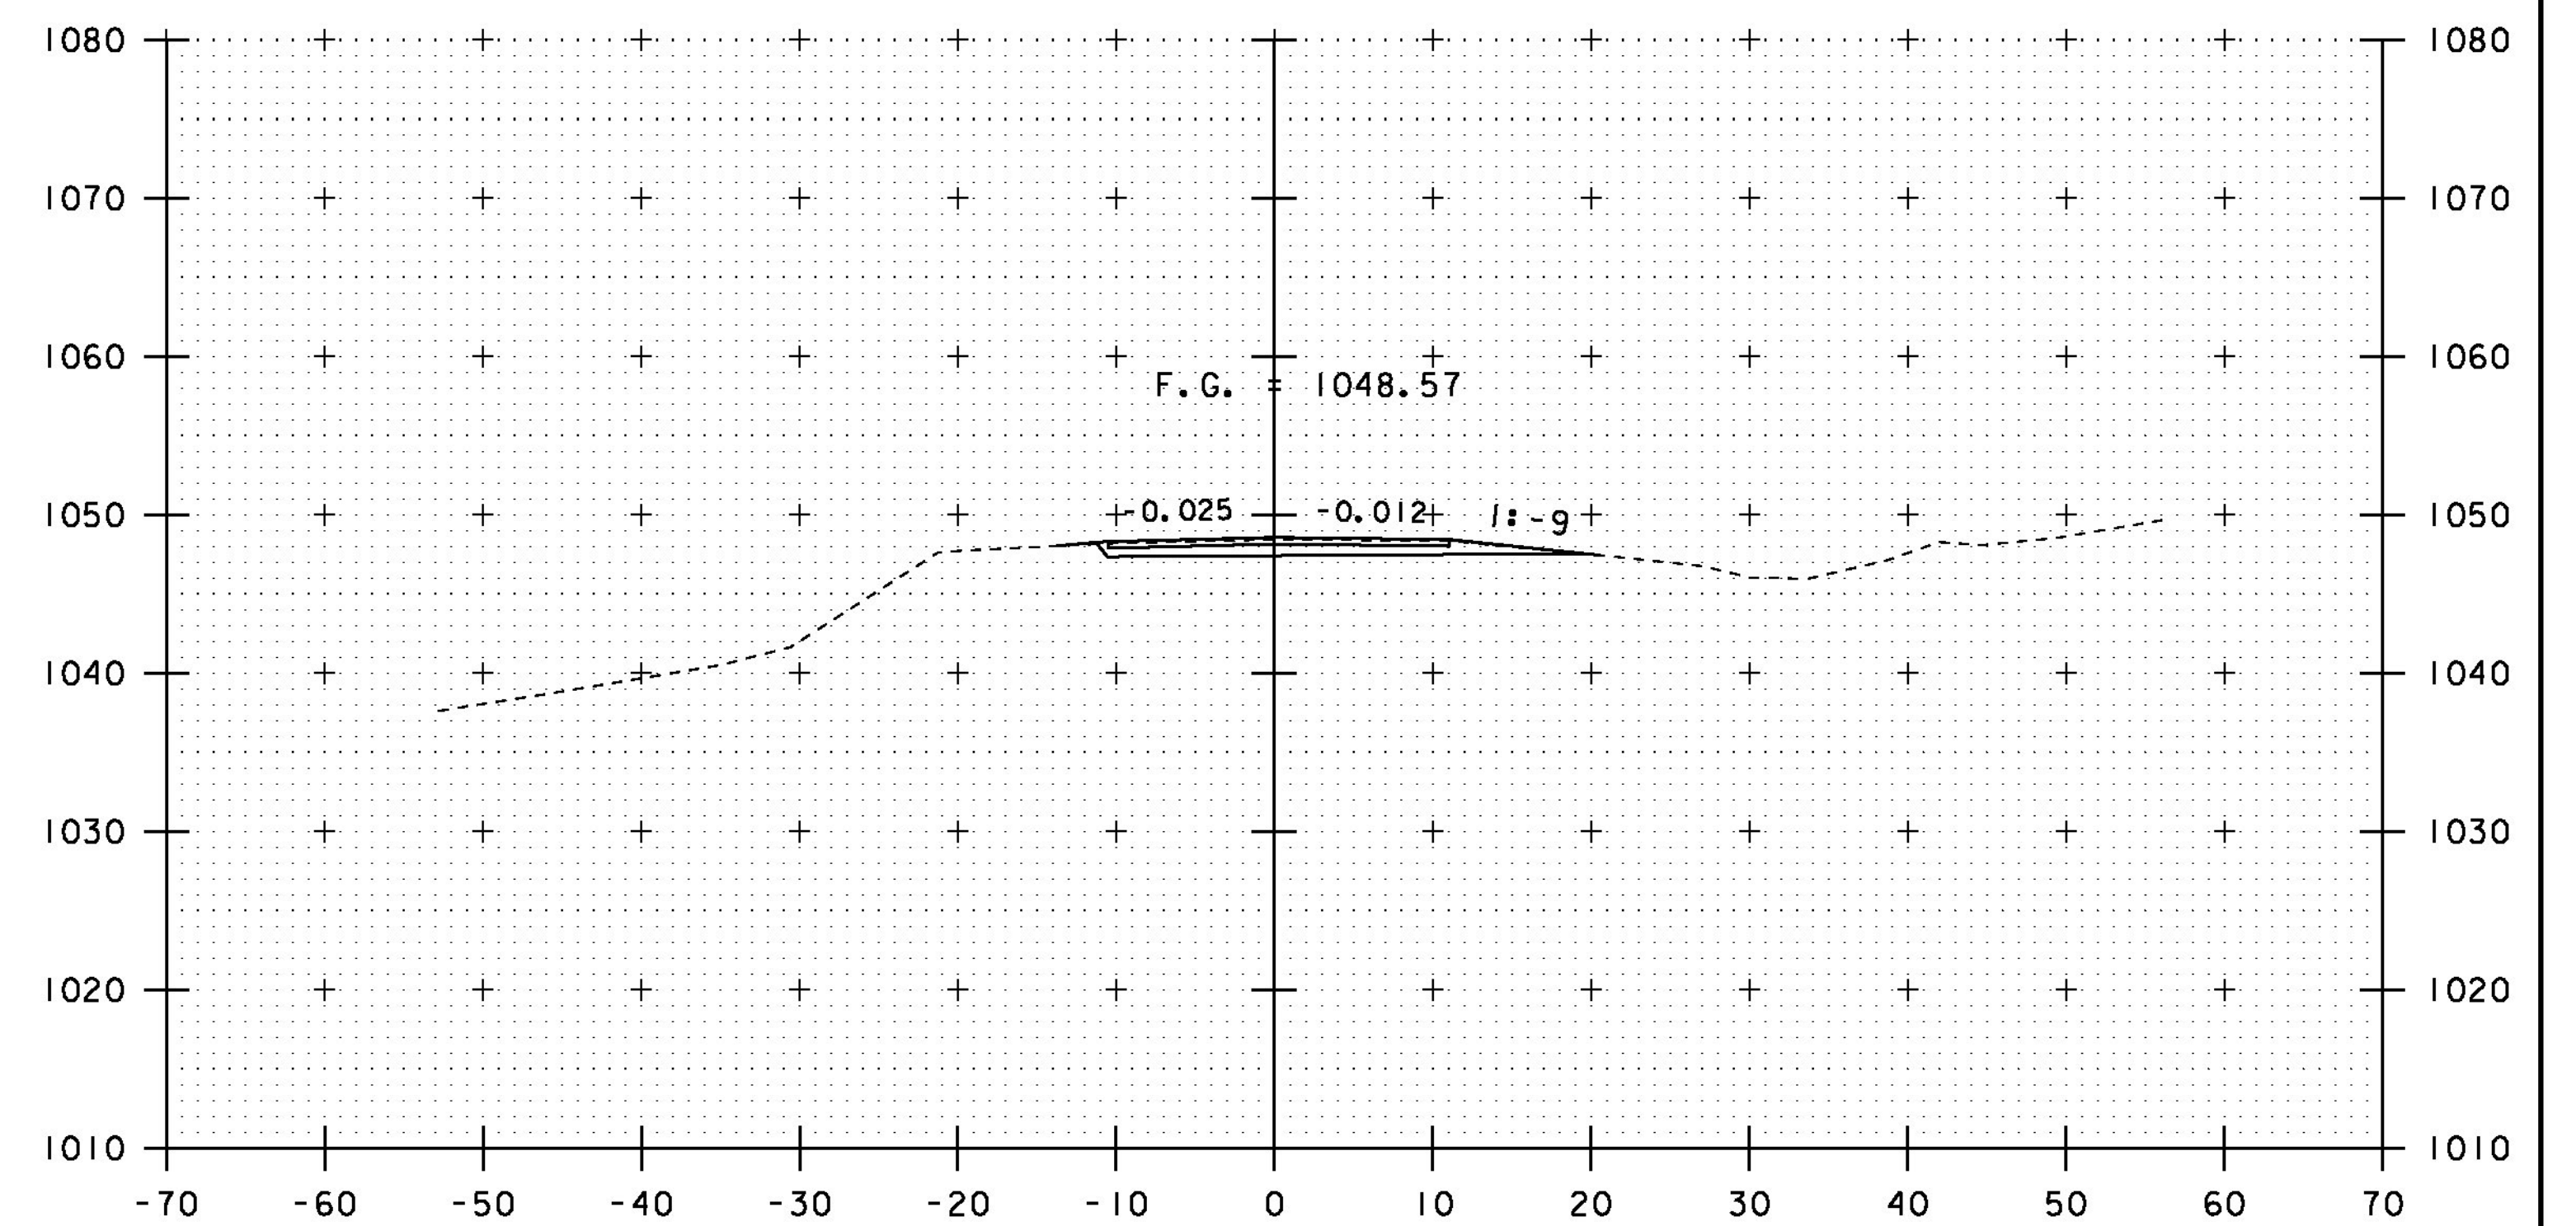

105+50

PROJECT NAME:	SHREWSBURY	FILE NAME:	s94j154xs.dgn	PLOT DATE:	12-MAY-2014
PROJECT NUMBER:	STP 1443 (44)	PROJECT LEADER:	C. CARLSON	DRAWN BY:	M. LONGSTREET
		DESIGNED BY:	N. VANDENBERG	CHECKED BY:	J. LACROIX
			TH 4 CROSS SECTION SHEET 4		SHEET 24 OF 36

STA. 105+50 TO STA. 106+00