




300+50

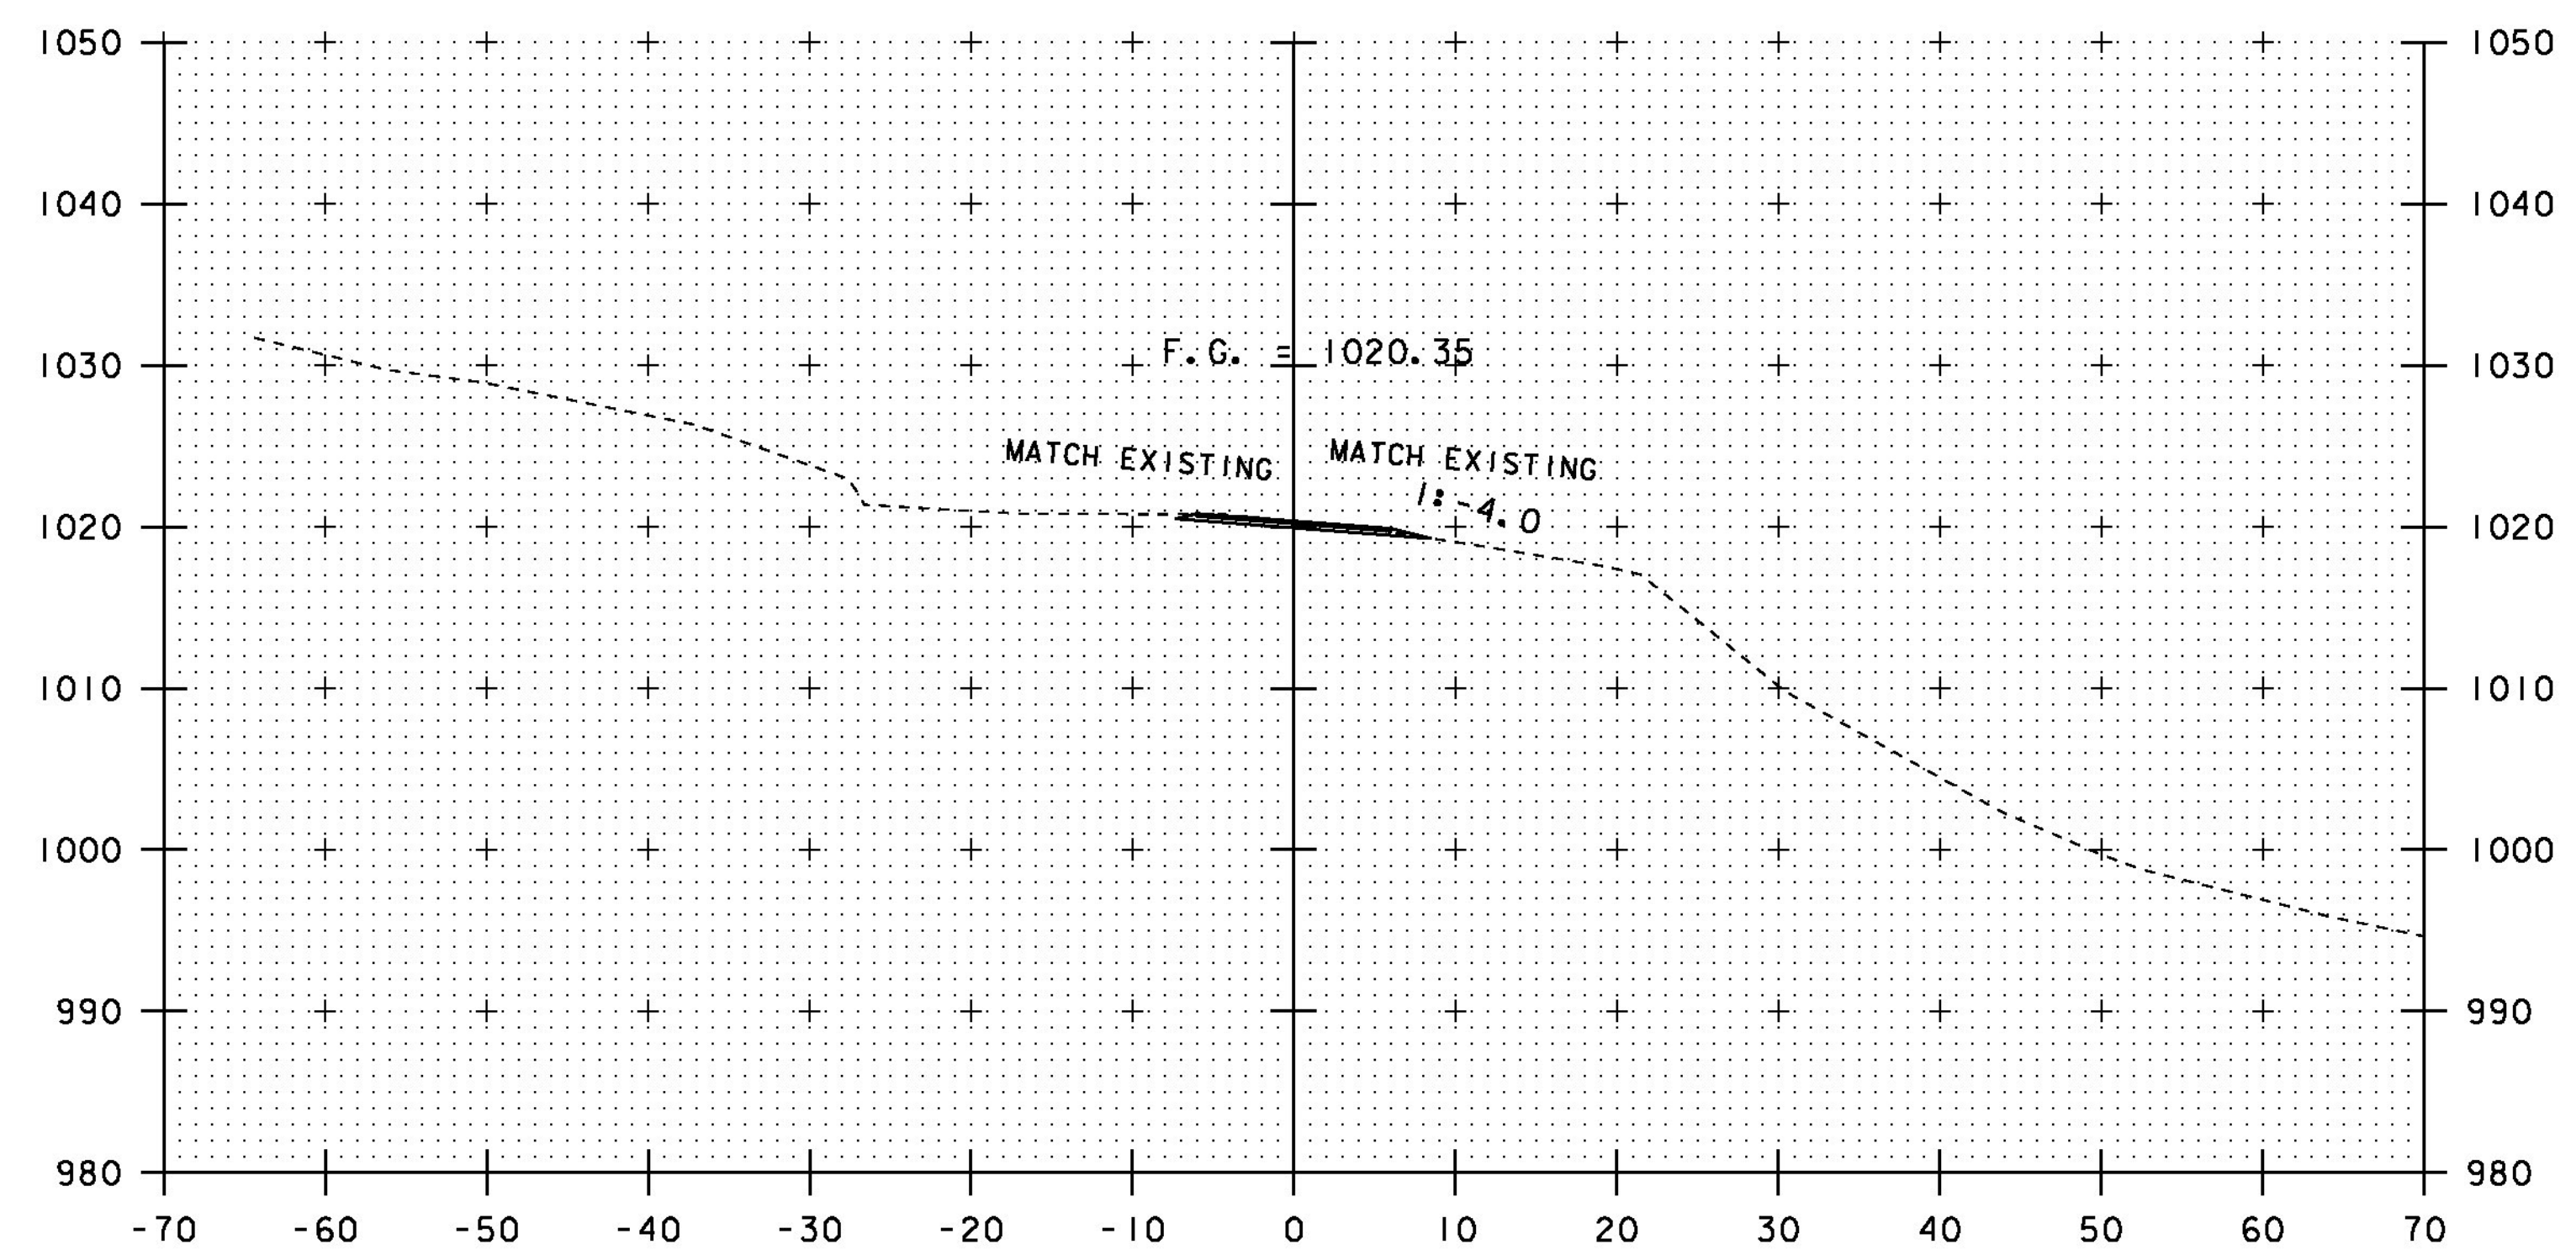

301+15
(END SIDE ROAD CONSTRUCTION)

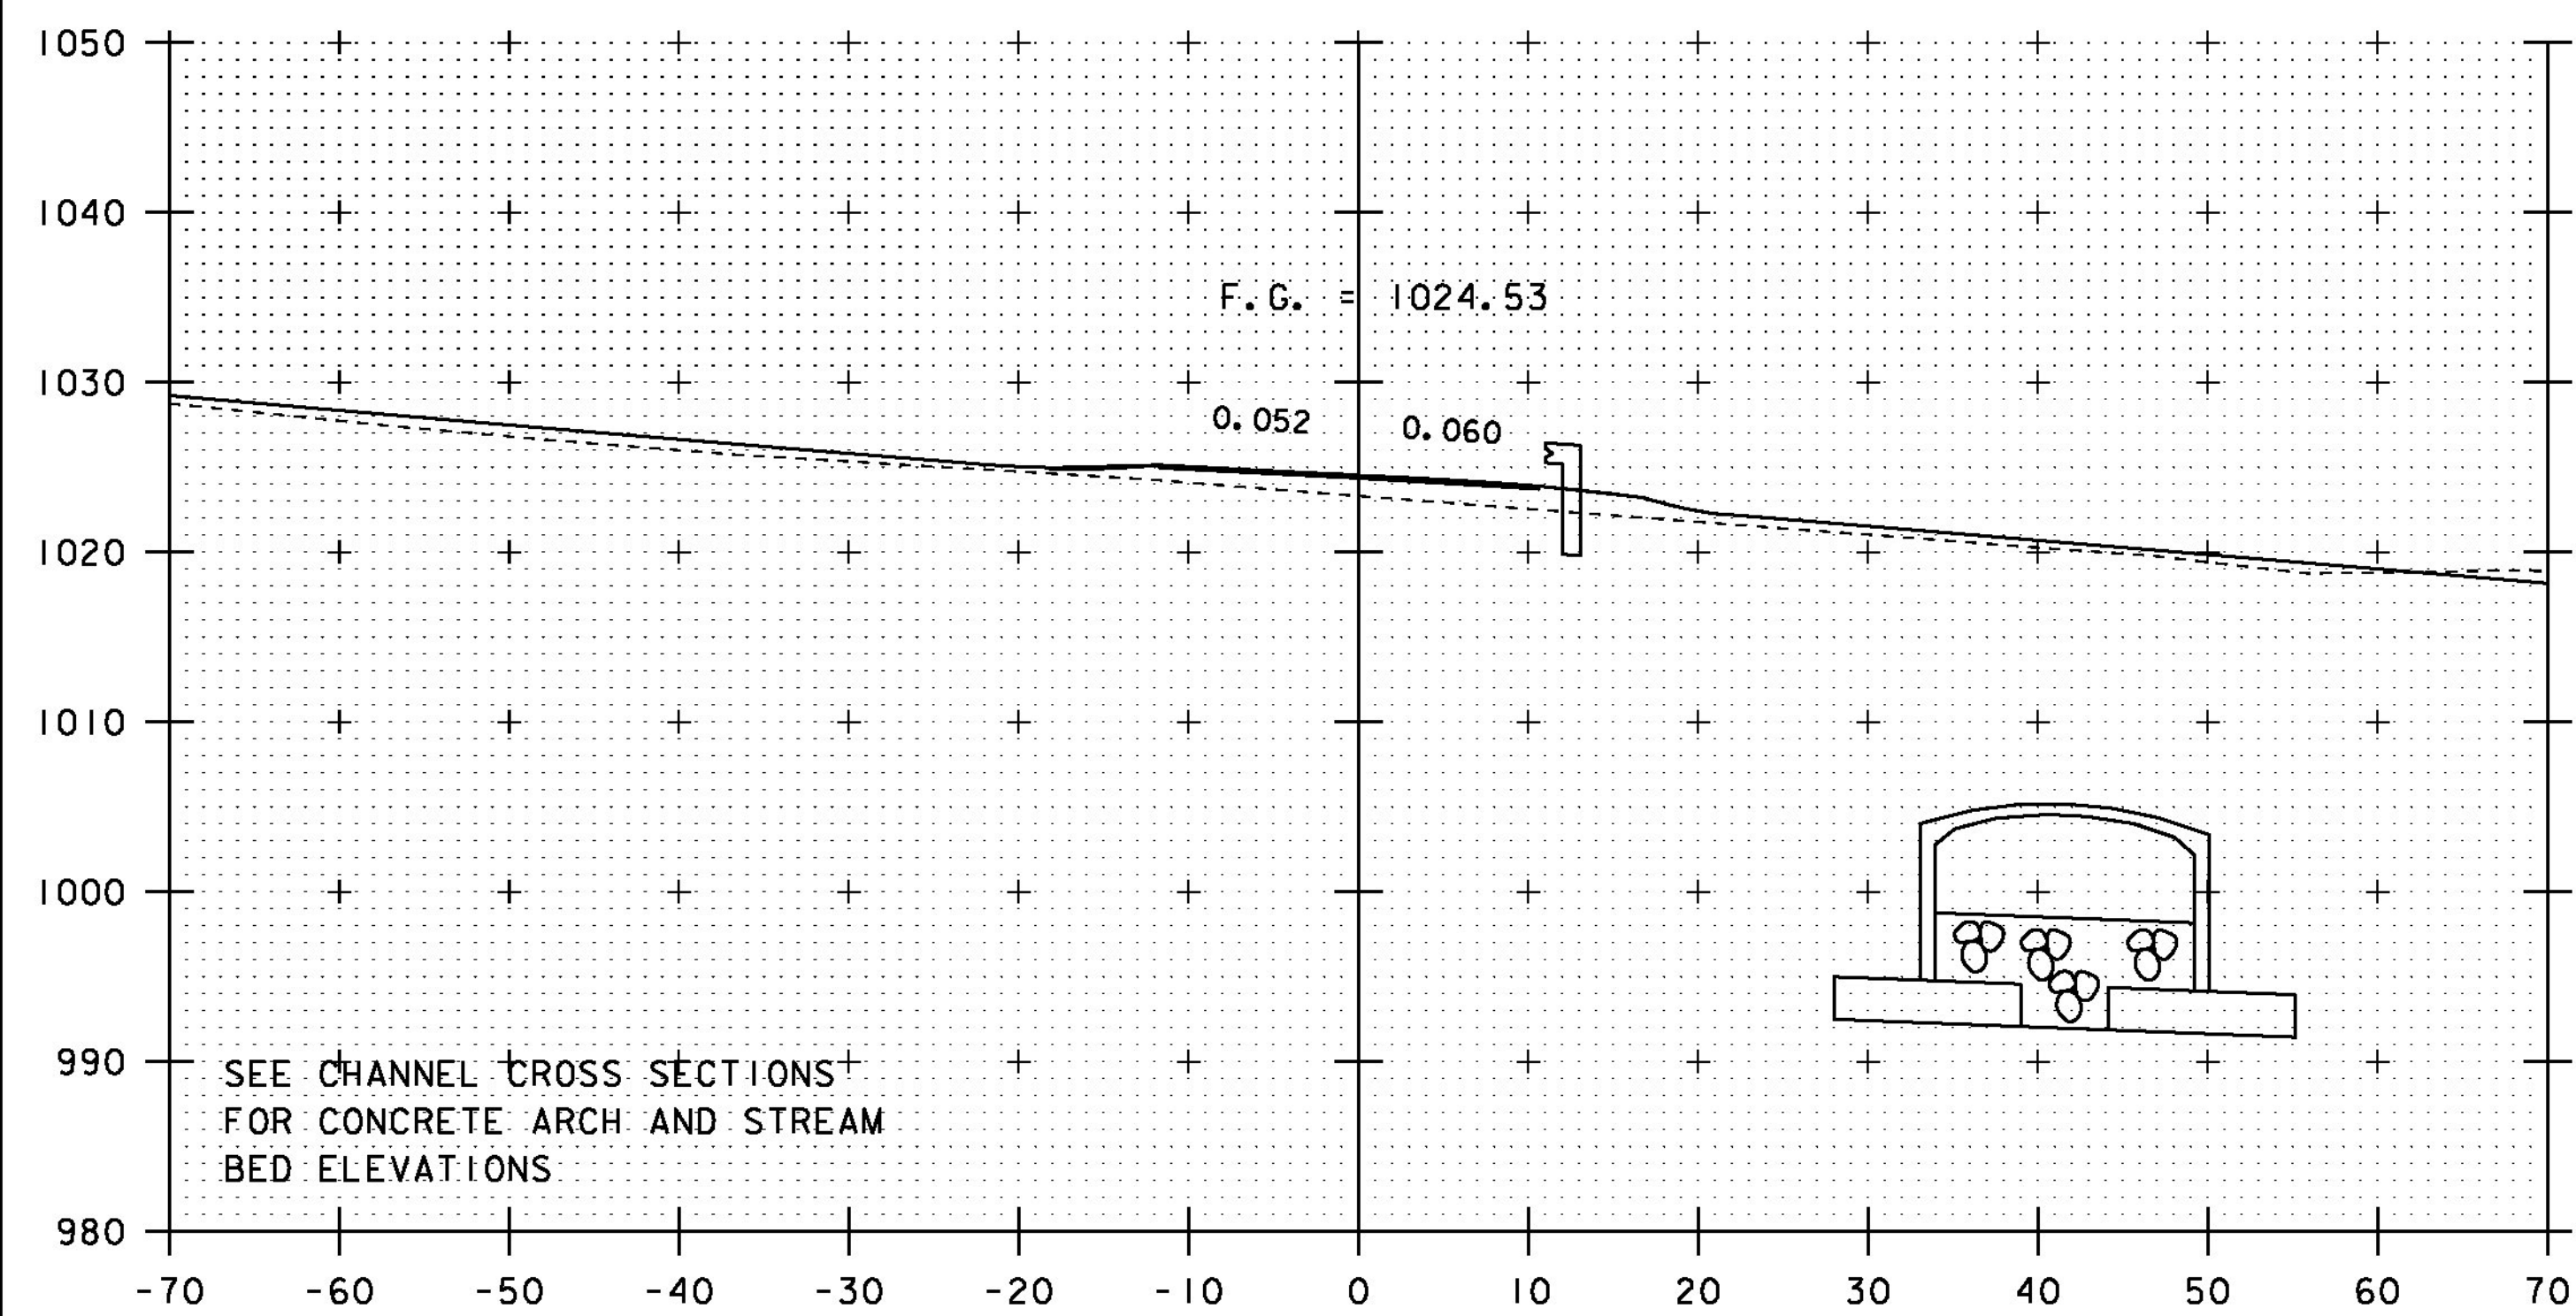

300+15

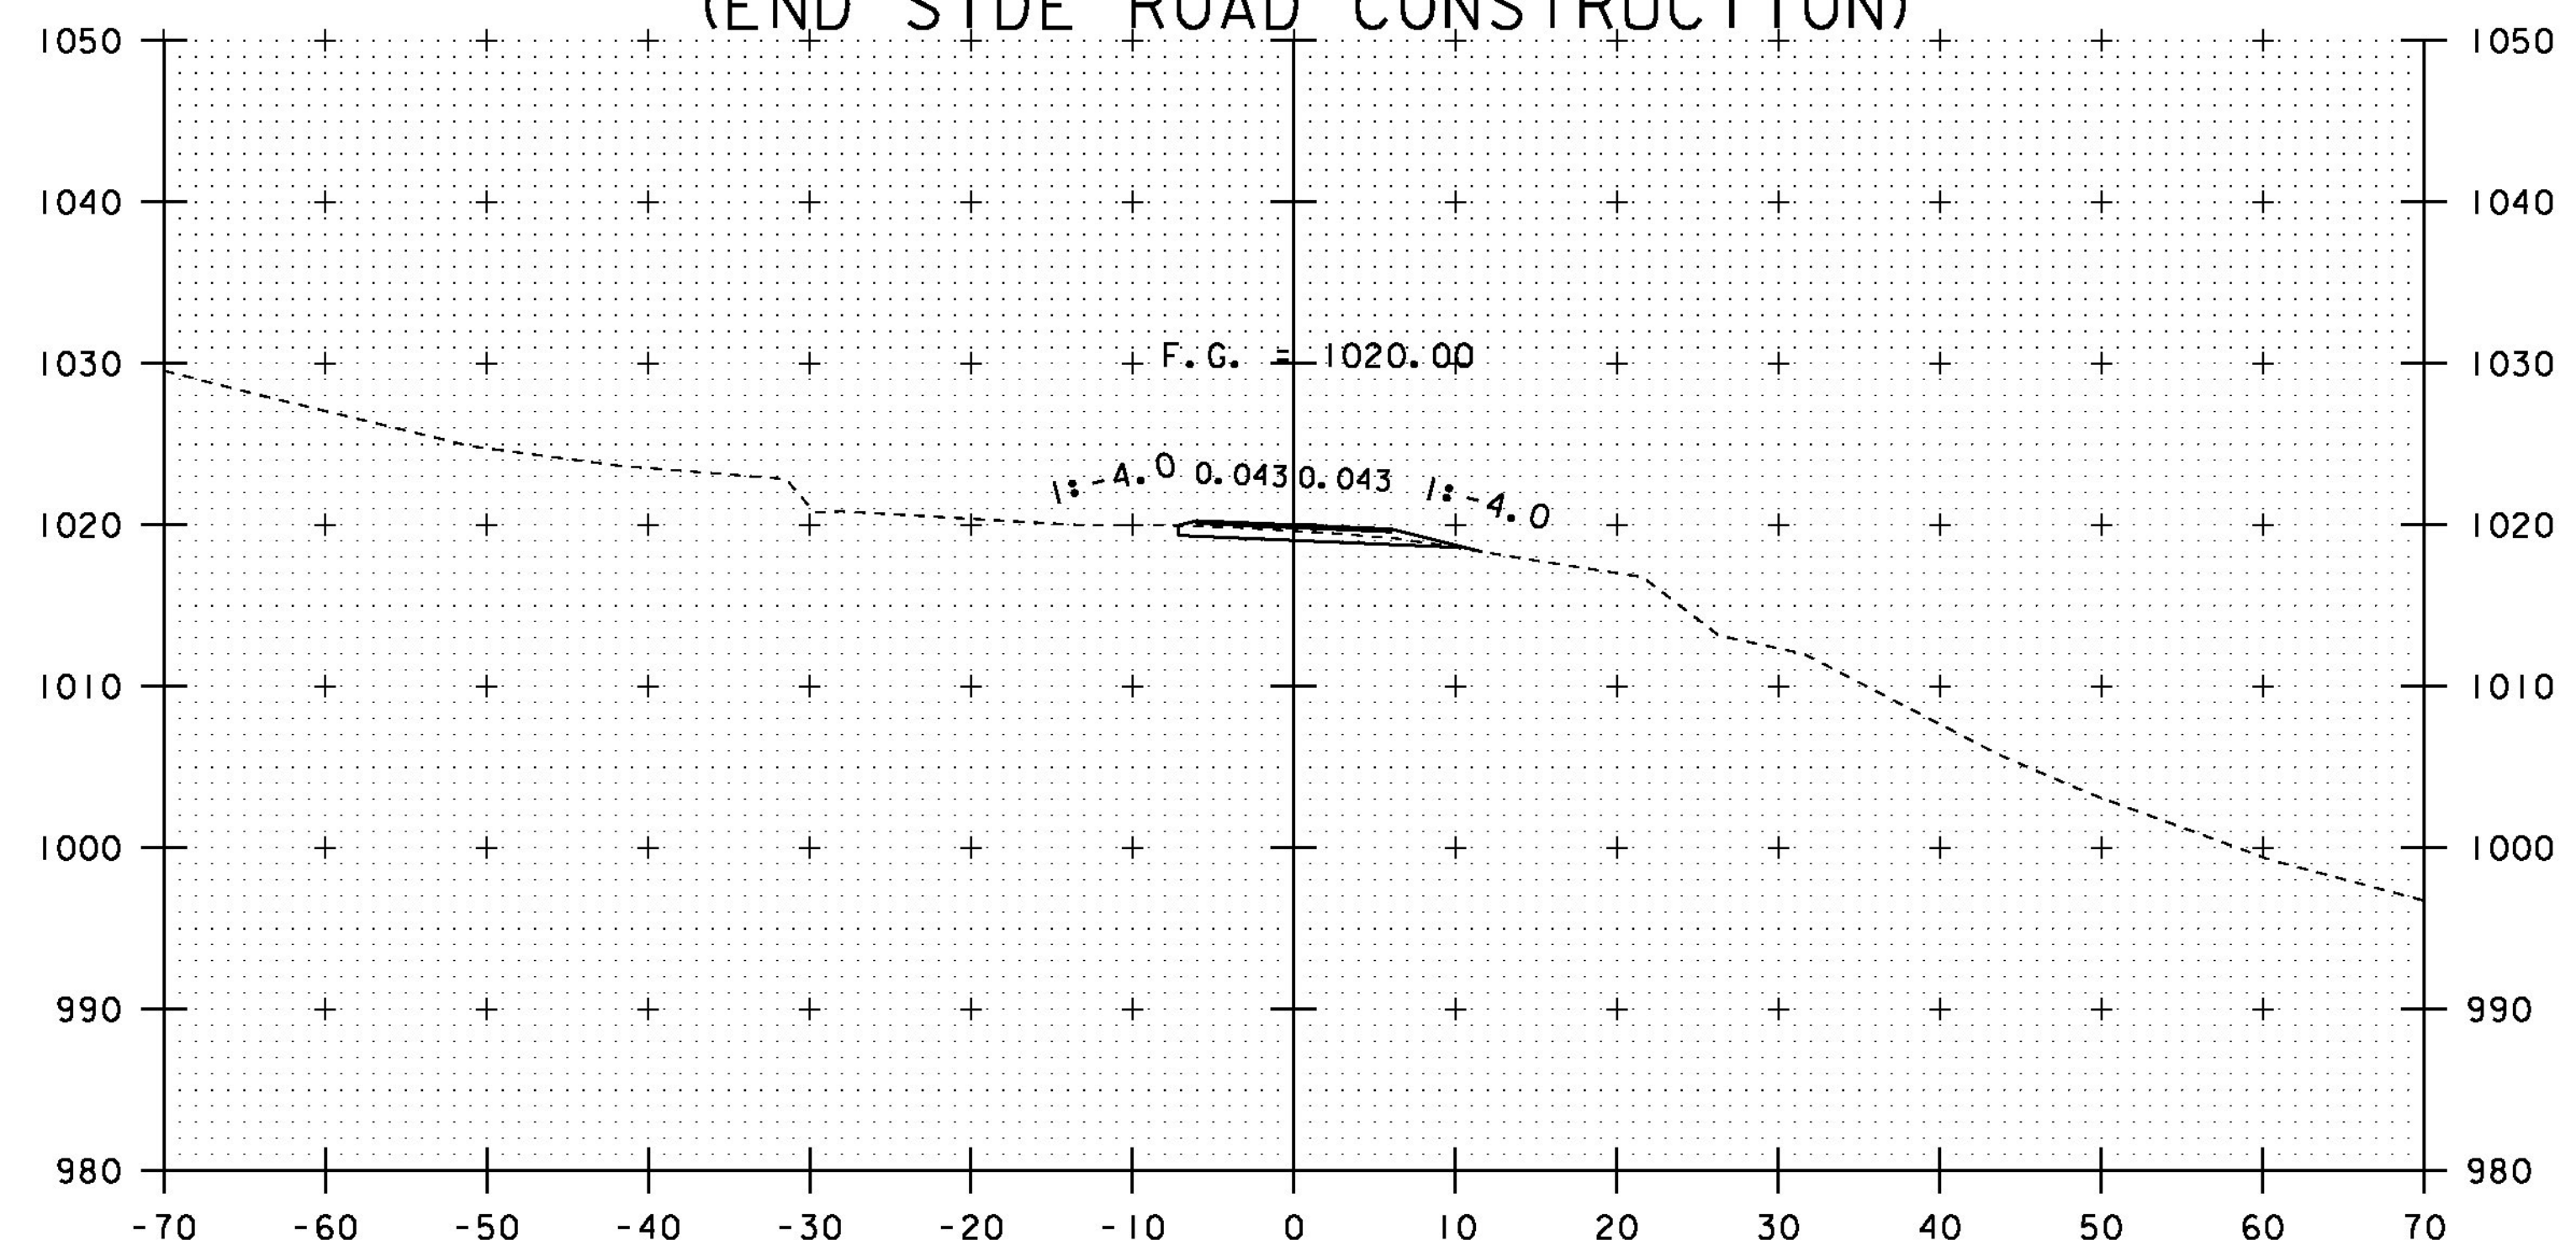

301+00

PROJECT NAME: SHREWSBURY	PLOT DATE: 12-MAY-2014
PROJECT NUMBER: STP 1443 (44)	DRAWN BY: M. LONGSTREET
FILE NAME: s94j154xs.dgn	CHECKED BY: J. LACROIX
PROJECT LEADER: C. CARLSON	SHEET 25 OF 36
DESIGNED BY: N. VANDENBERG	

STA. 300+15 TO STA. 301+15