




200+25  
BEGIN CHANNEL WORK

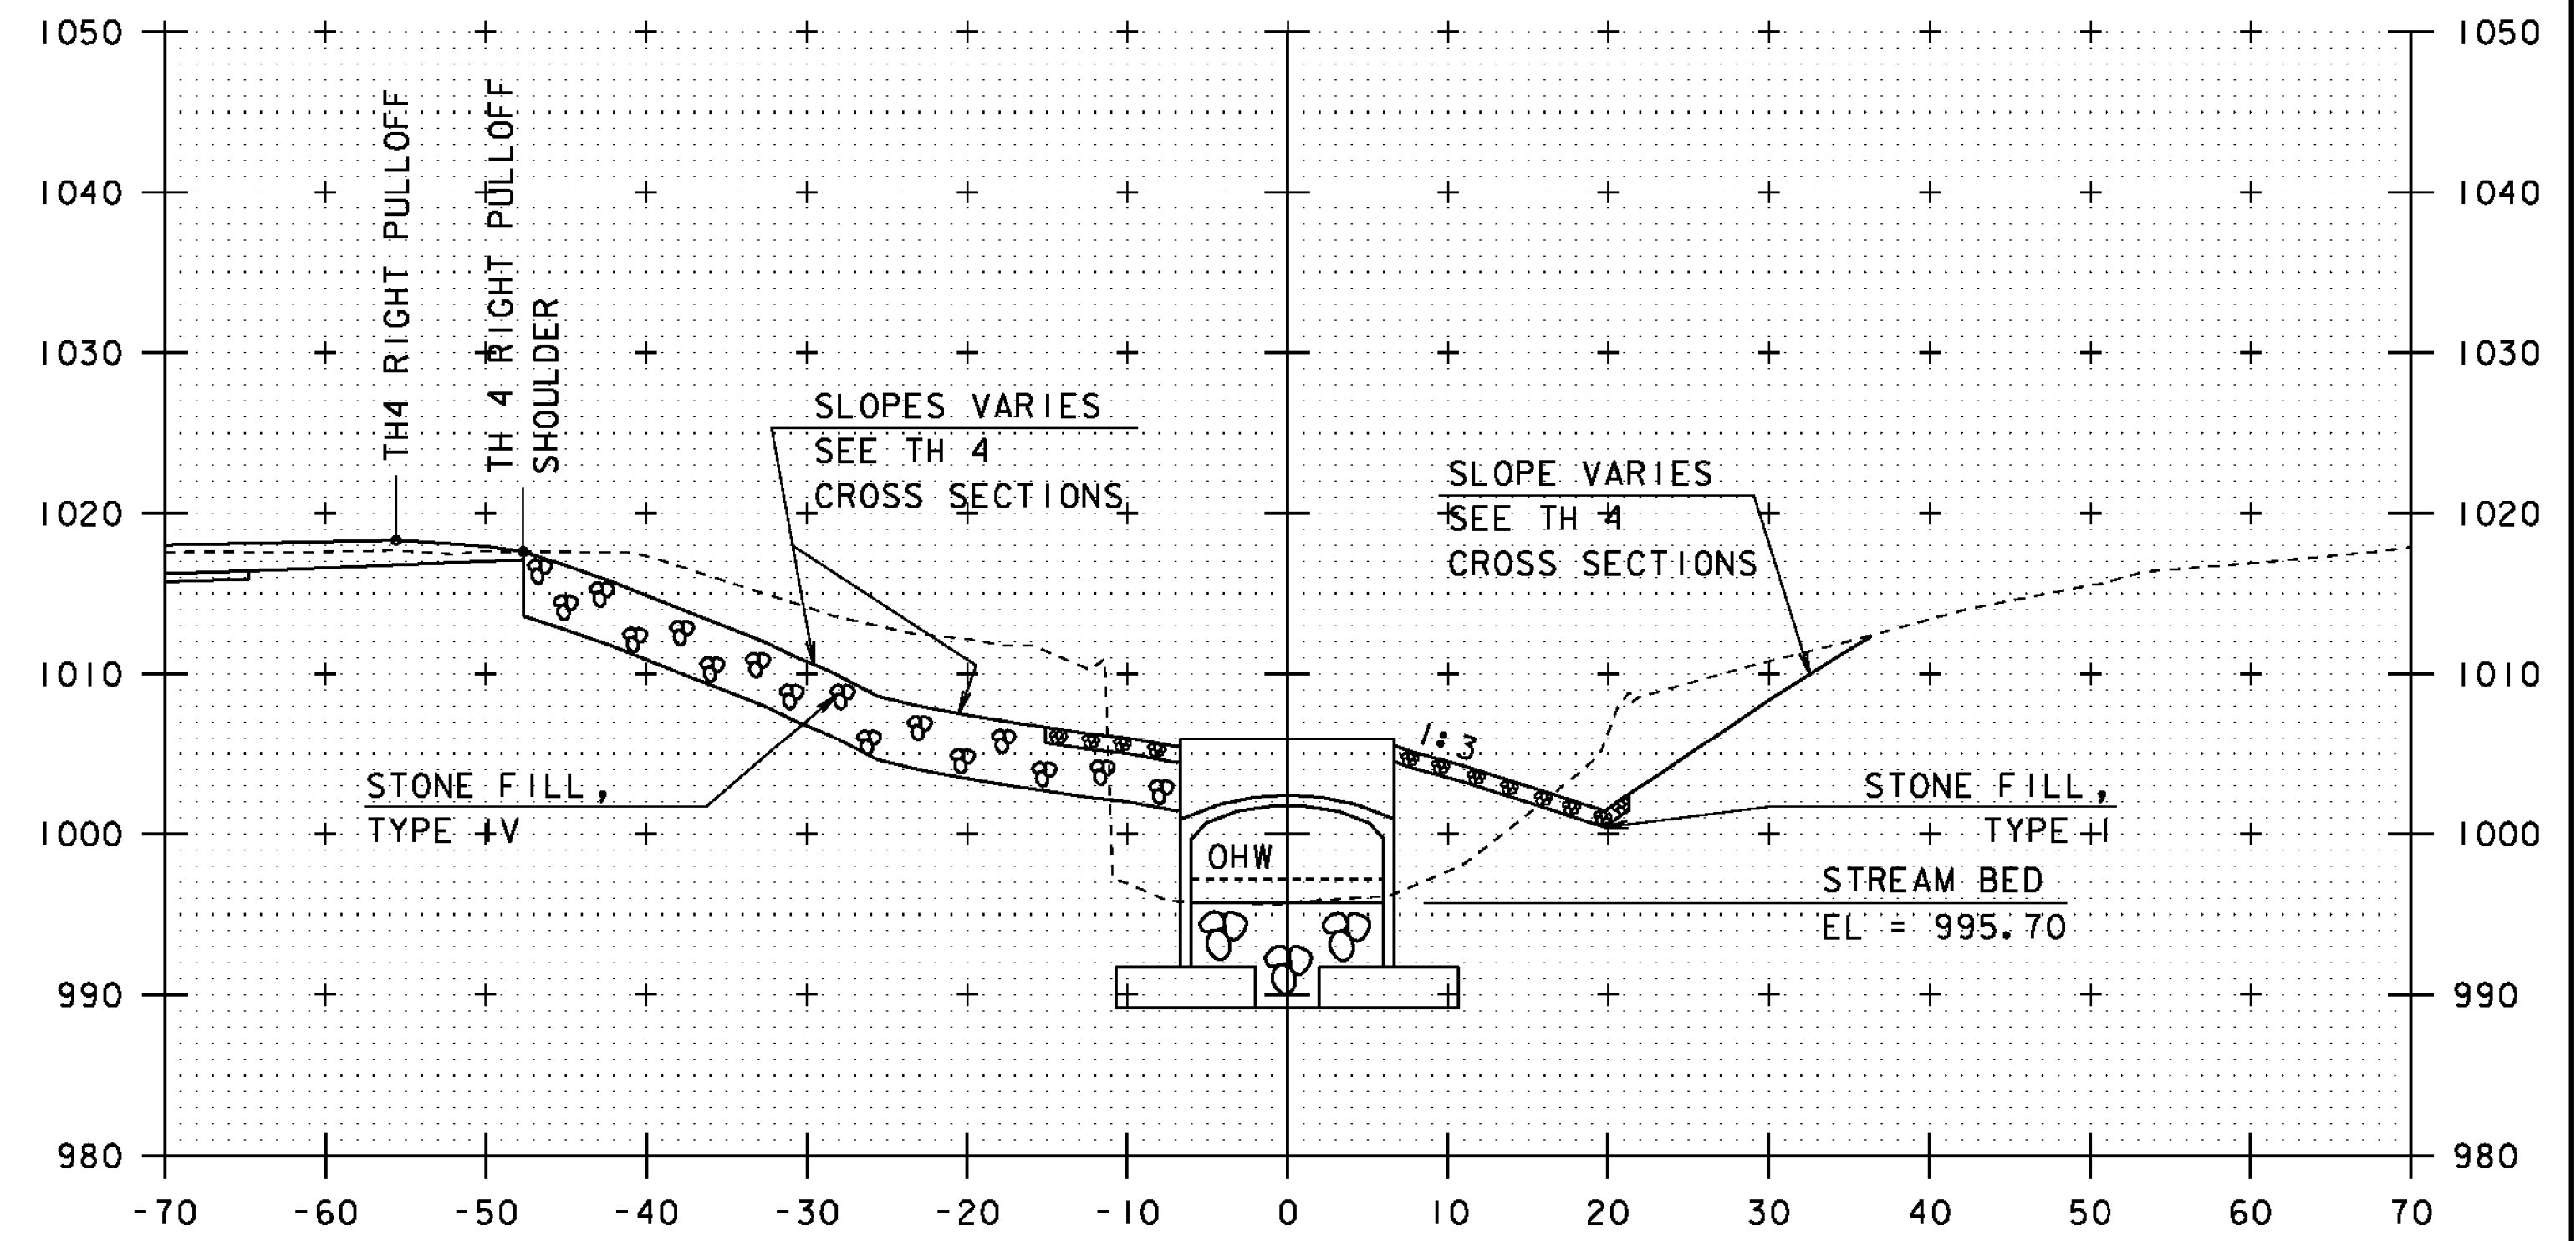

200+60.5

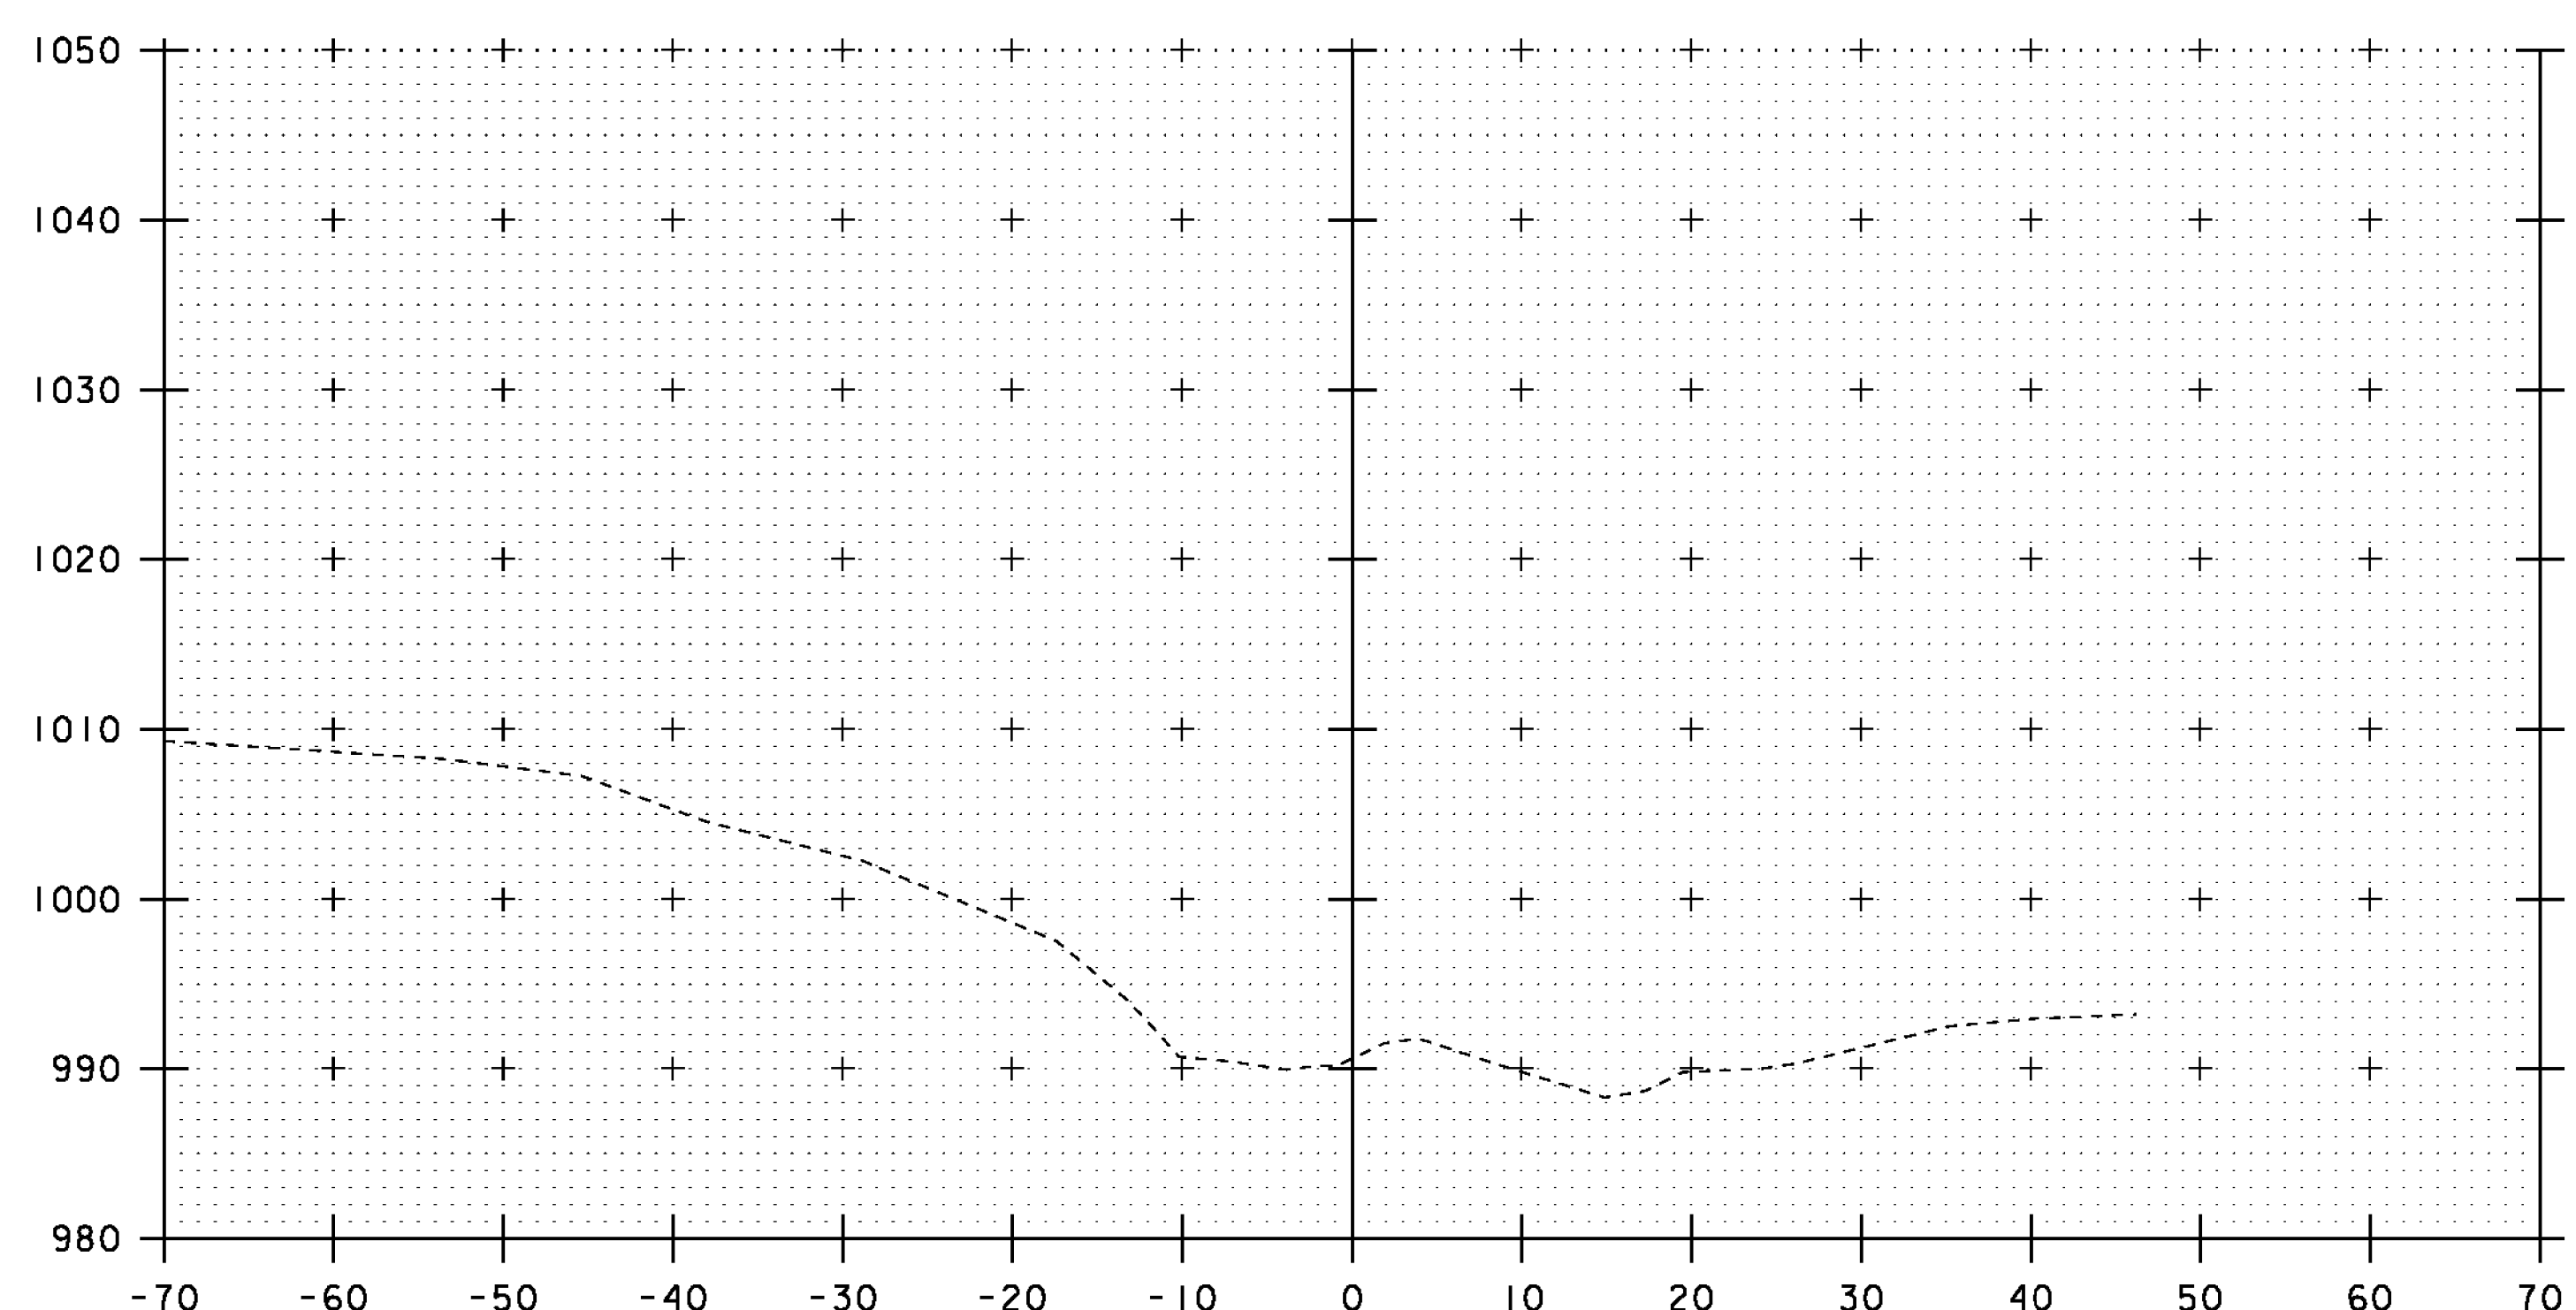

200+00

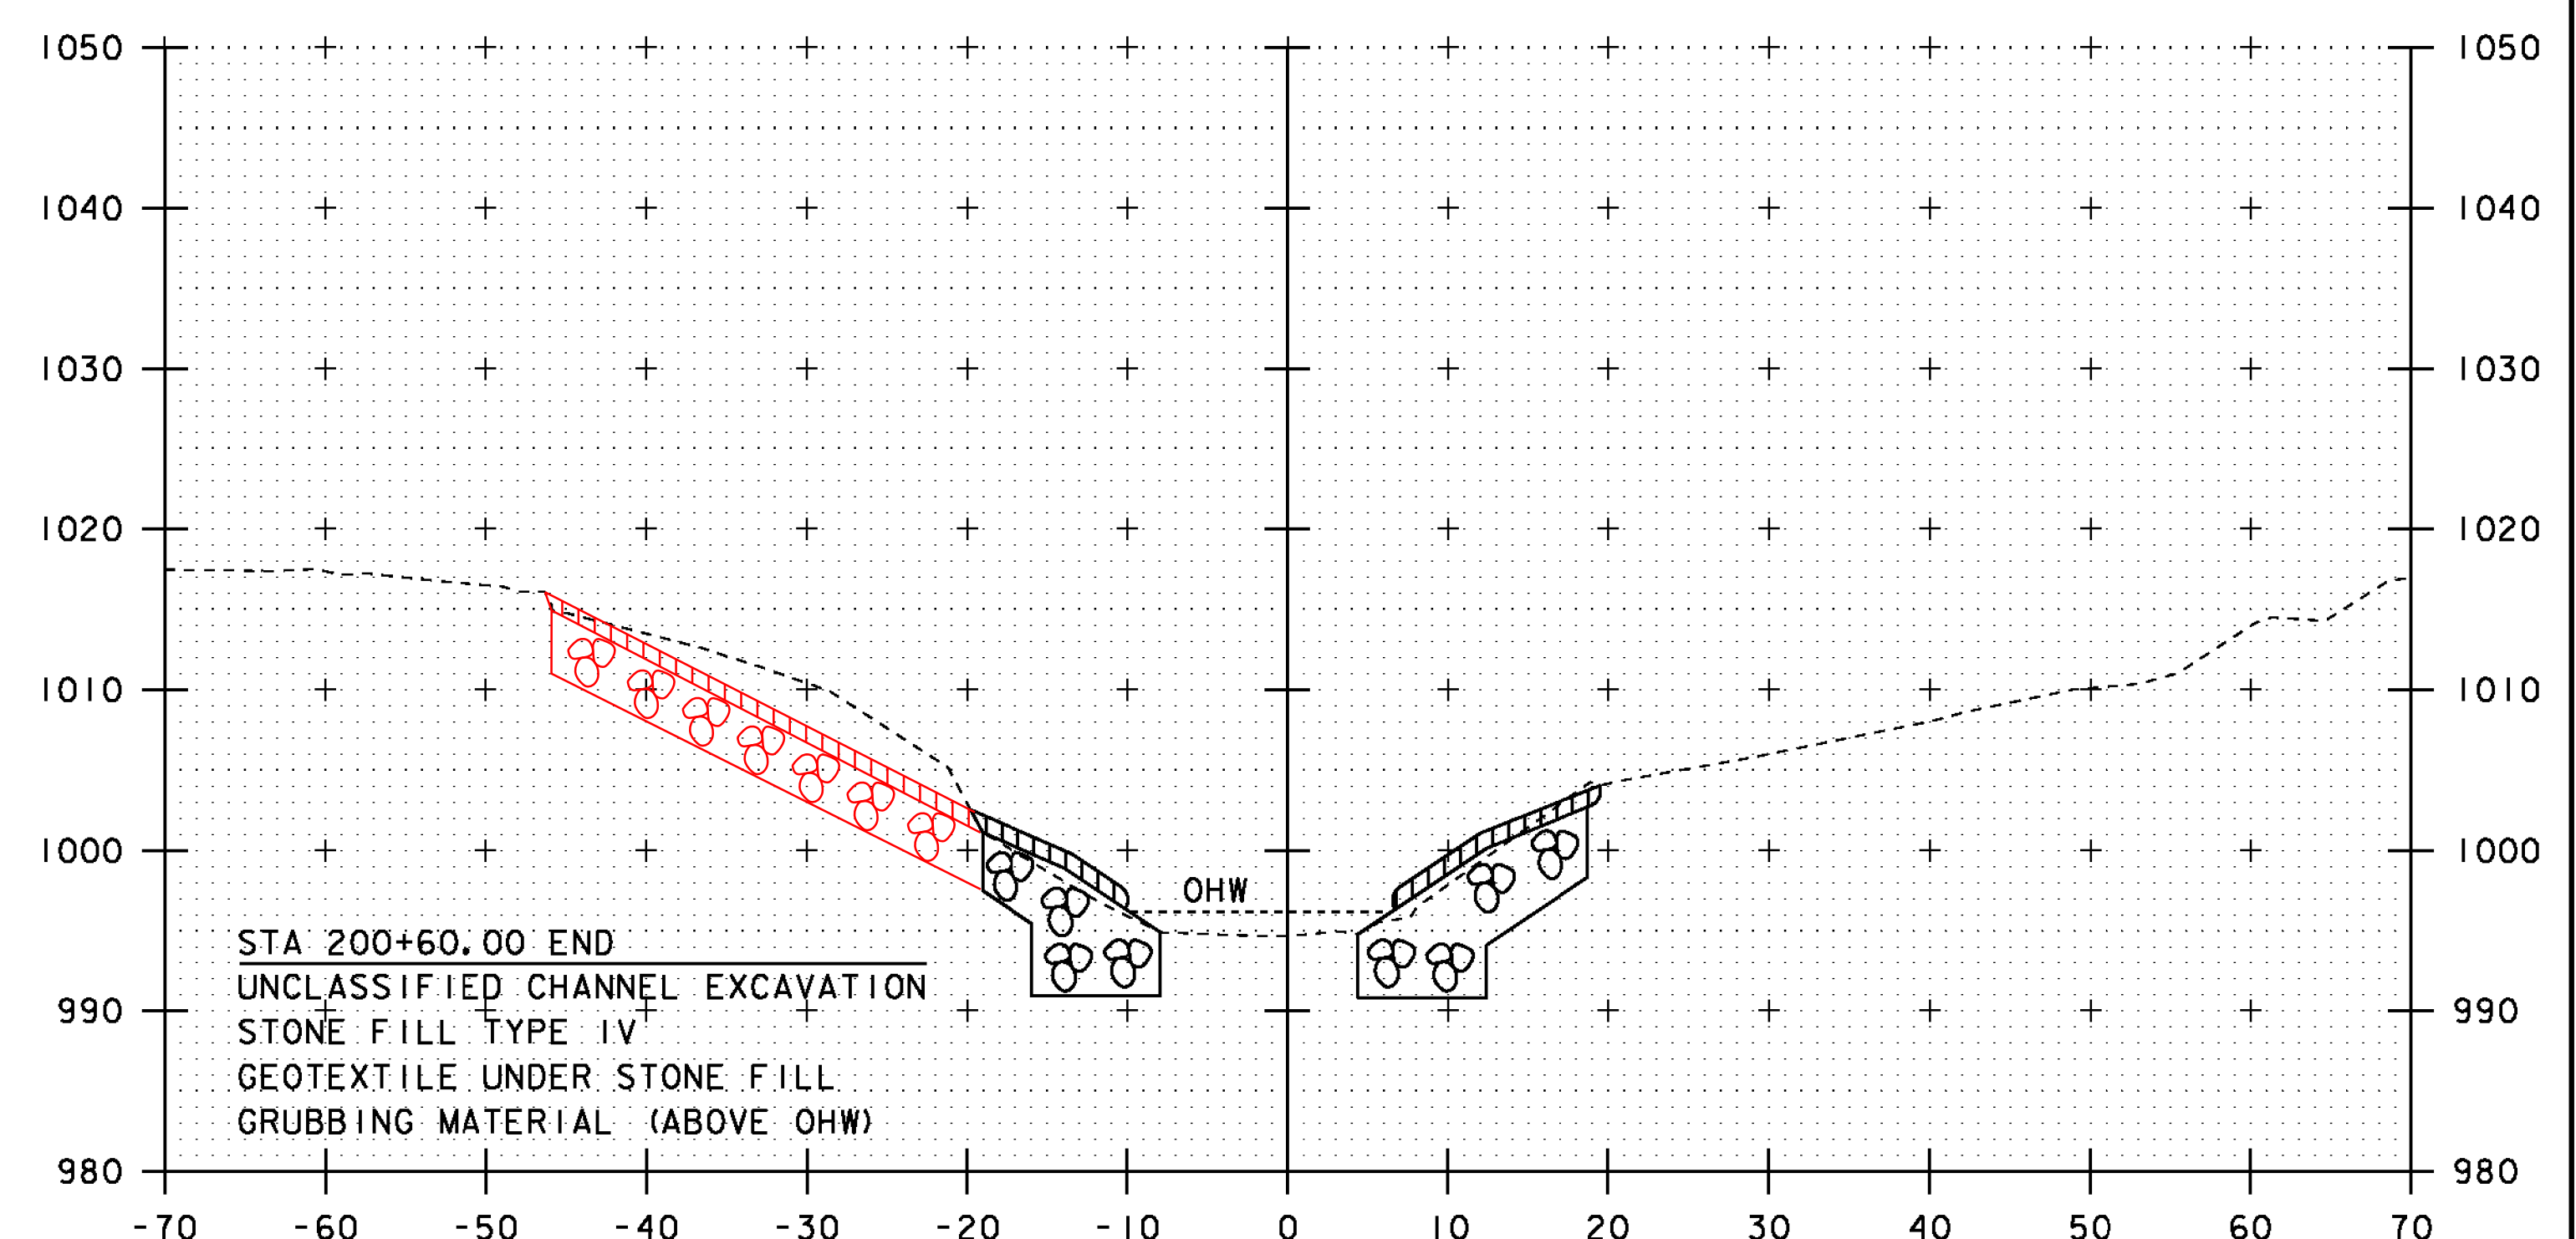

200+50  
STA 200+60 BEGIN SPECIAL PROVISION  
(STONE FILL, ARCH FLOW LINE)

STA. 200+00 TO STA. 200+60.5

PROJECT NAME: SHREWSBURY	
PROJECT NUMBER: STP 1443 (44)	
FILE NAME: s94j154xs.dgn	PLOT DATE: 12-MAY-2014
PROJECT LEADER: C. CARLSON	DRAWN BY: M. LONGSTREET
DESIGNED BY: N. VANDENBERG	CHECKED BY: J. LACROIX
CHANNEL CROSS SECTION SHEET 1	SHEET 26 OF 36