


I:\3 (44)\DWGS\RFB 12x8 CASELLA 5676.DWG 3/18/2015 9:09 AM

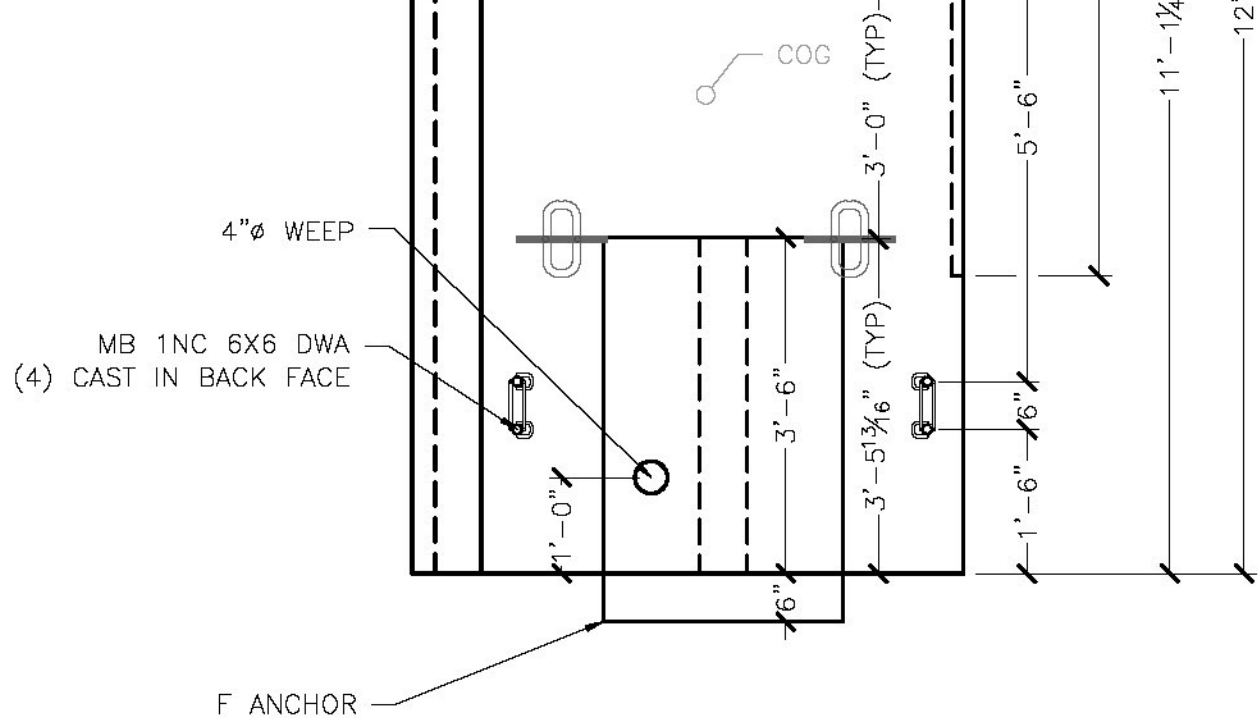

# Vermont Agency of Transportation

# RECEIVED

Precast Rigid Frame\_ Approved 3.18.15.pdf

ELEVATION VIEW

**CK'D BY** CLB

**OK'D BY** FDB

**March 18, 2015**

**RESUBMIT** NO

**Approved**

**BY** C. CARLSON

**DATE** 03/18/15