


S:\PROJECTS\CASELLA CONSTRUCTION\SHREWSBURY, VT - VTAOT STP 1443 (44)\DWGS\RFB 12X8 CASELLA 5576.DWG 3/18/2015 9:09 AM

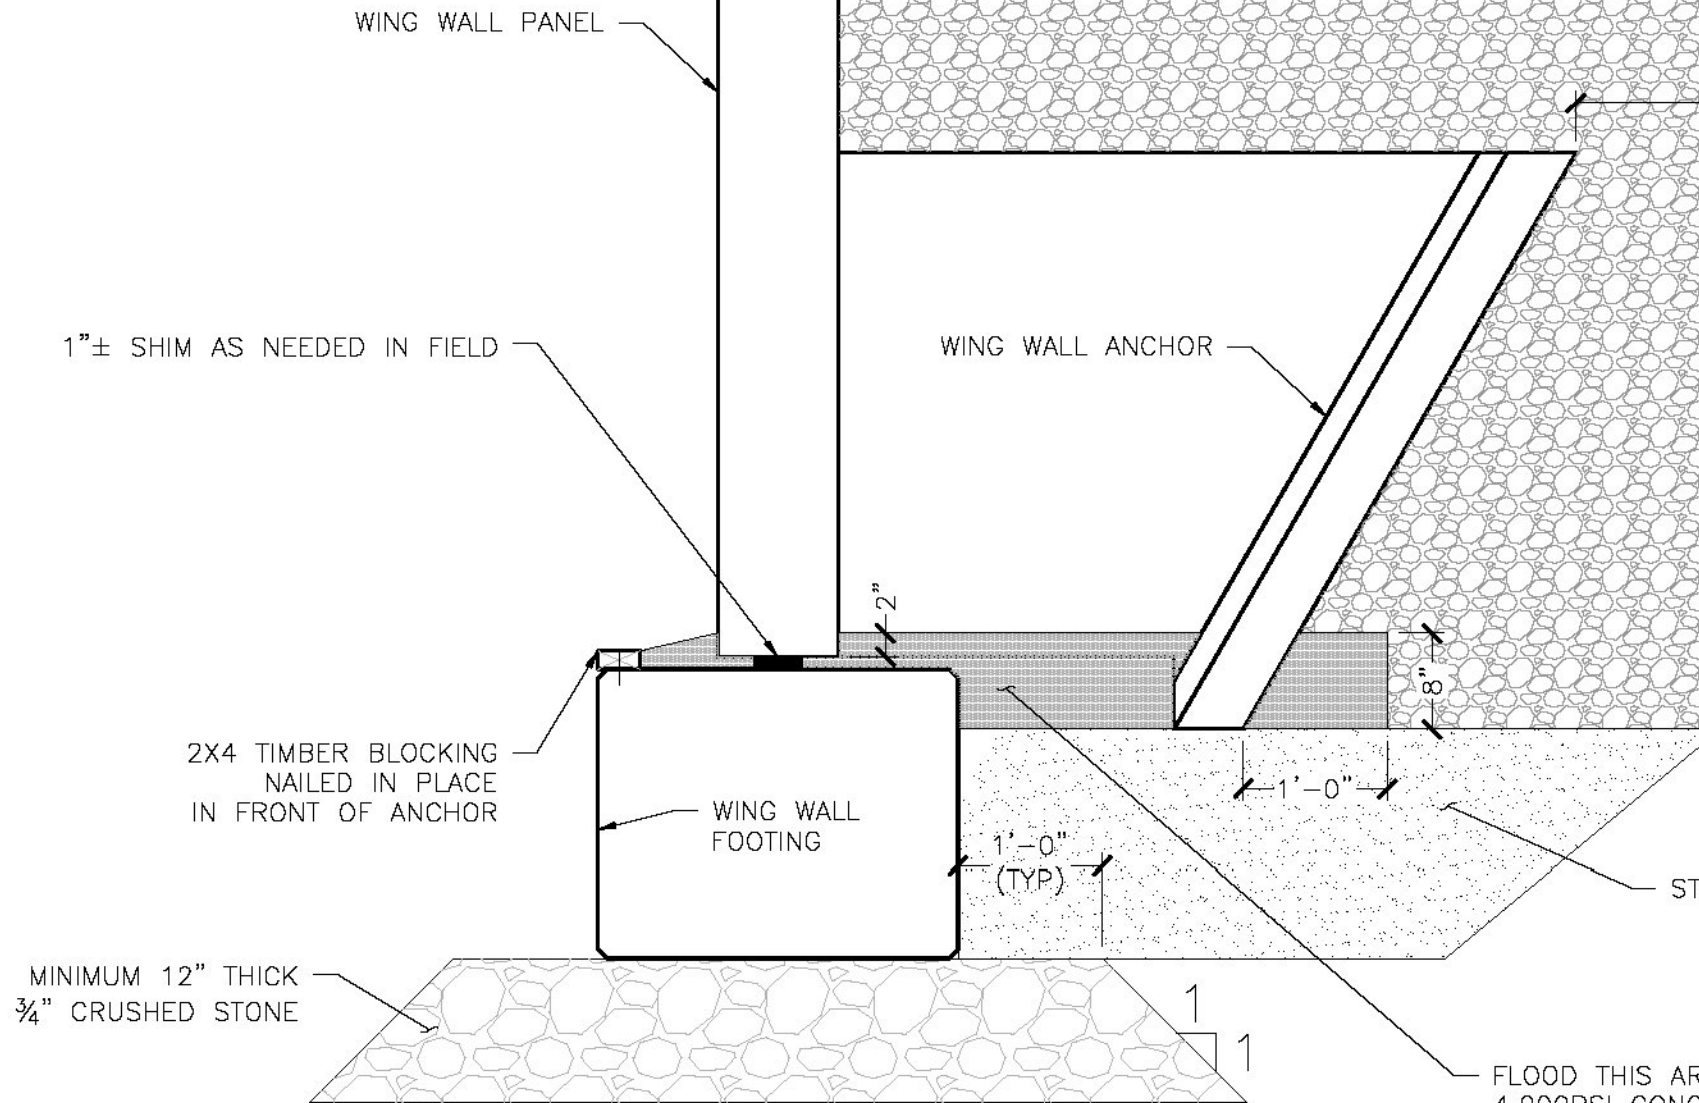

2  
S8.0

FOOTING TO WW  
ATTACHMENT DETAIL

NTS