

STATE OF VERMONT AGENCY OF TRANSPORTATION




PROPOSED IMPROVEMENT BRIDGE PROJECT TOWN OF NEWFANE COUNTY OF WINDHAM

ROUTE NO : T.H. 2 CLASS 2 (MAJOR COLLECTOR) BRIDGE NO : 14

PROJECT LOCATION : BEGINNING ON TH 2 (DOVER ROAD) AT 0.14 KM WEST OF TH 3 AND PROCEEDING EAST 0.13 KM ON TH 2.



PROJECT DESCRIPTION : REPLACEMENT OF THE EXISTING BRIDGE WITH APPROACH ROADWAY AND CHANNEL WORK.

LENGTH OF STRUCTURE : 37.150 METERS.
LENGTH OF ROADWAY : 89.503 METERS.
LENGTH OF PROJECT : 126.653 METERS.

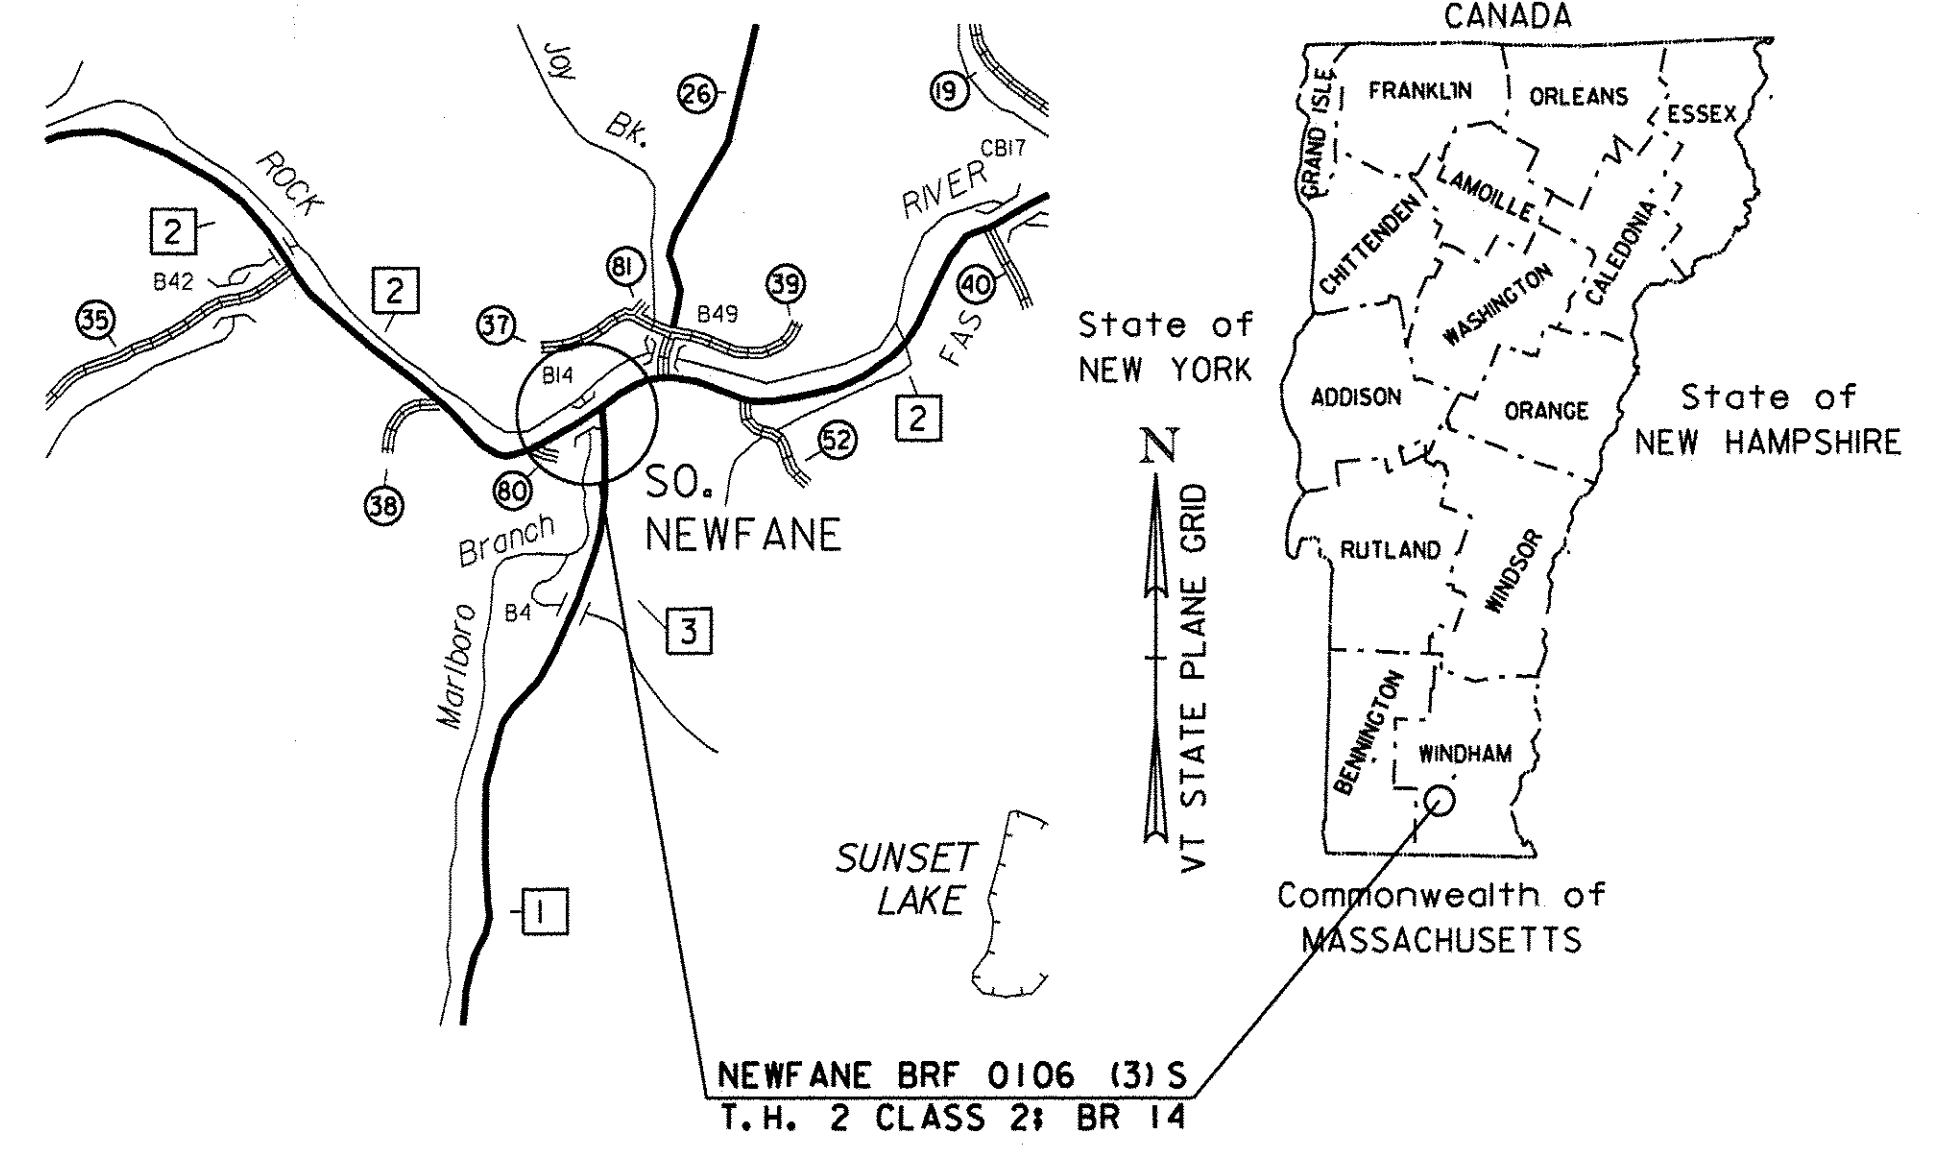

LOCATION MAP
NOT TO SCALE


RECORD PLANS	
CONTRACTOR:	RENAUD BROTHERS, INC. - VERNON, VT
RESIDENT ENGINEER:	CHAD GREENWOOD
CONSTRUCTION BEGAN:	DECEMBER 19, 2011
CONSTRUCTION COMPLETE:	MAY 15, 2013
RECORD PLANS BY:	CHAD GREENWOOD & JENNA HYDE
I HEREBY CERTIFY THAT ALL THE CONSTRUCTION REQUIRED BY THIS SET OF DRAWINGS HAS BEEN ACCOMPLISHED AS INDICATED HEREIN.	
BY	<i>[Signature]</i> RESIDENT ENGINEER
DATE	1/4/13
NOTE: Any further information concerning final quantities, amounts or other details relative to this project may be found at Central Files in the electronic archives.	

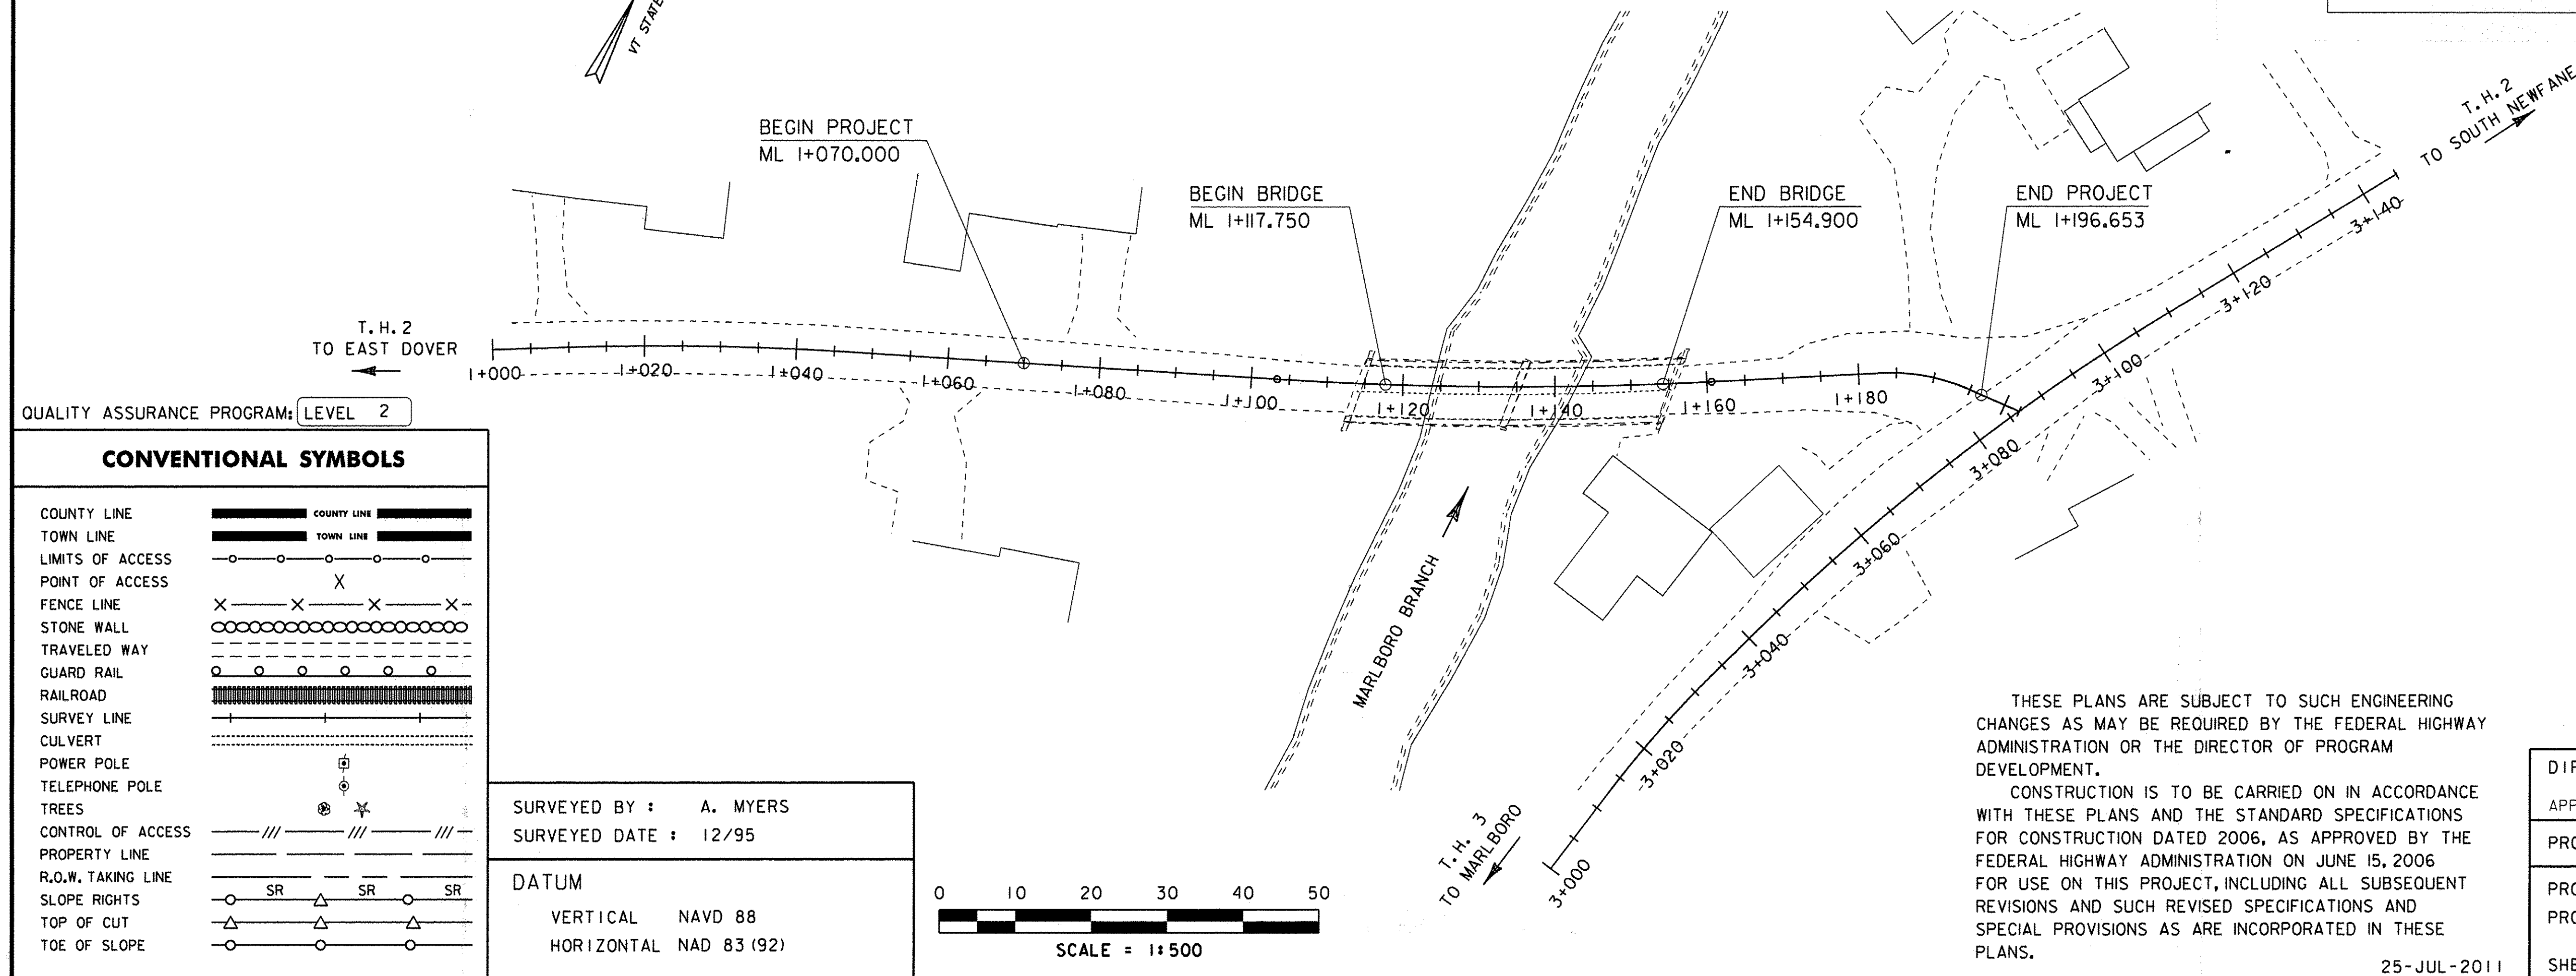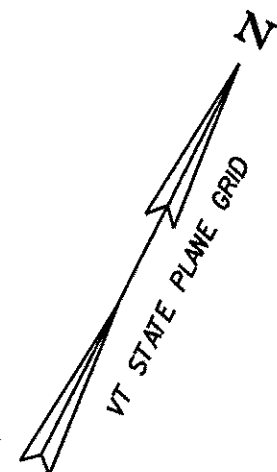

CONVENTIONAL SYMBOLS	
COUNTY LINE	
TOWN LINE	
LIMITS OF ACCESS	
POINT OF ACCESS	
FENCE LINE	
STONE WALL	
TRAVELED WAY	
GUARD RAIL	
RAILROAD	
SURVEY LINE	
CULVERT	
POWER POLE	
TELEPHONE POLE	
TREES	
CONTROL OF ACCESS	
PROPERTY LINE	
R.O.W. TAKING LINE	
SLOPE RIGHTS	
TOP OF CUT	
TOE OF SLOPE	

SURVEYED BY : A. MYERS
SURVEYED DATE : 12/95

DATUM
VERTICAL NAVD 88
HORIZONTAL NAD 83 (92)

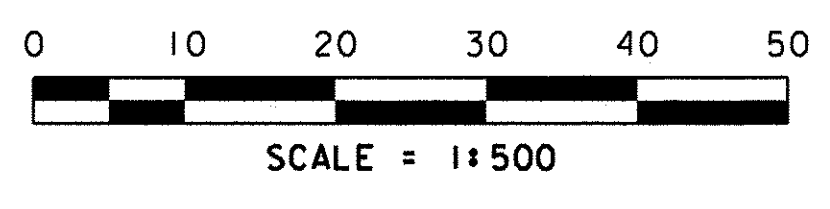

Metric
UNLESS NOTED OTHERWISE
STATIONS ARE IN KILOMETERS
ELEVATIONS ARE IN METERS
DIMENSIONS ARE IN MILLIMETERS

THESE PLANS ARE SUBJECT TO SUCH ENGINEERING CHANGES AS MAY BE REQUIRED BY THE FEDERAL HIGHWAY ADMINISTRATION OR THE DIRECTOR OF PROGRAM DEVELOPMENT.
CONSTRUCTION IS TO BE CARRIED ON IN ACCORDANCE WITH THESE PLANS AND THE STANDARD SPECIFICATIONS FOR CONSTRUCTION DATED 2006, AS APPROVED BY THE FEDERAL HIGHWAY ADMINISTRATION ON JUNE 15, 2006 FOR USE ON THIS PROJECT, INCLUDING ALL SUBSEQUENT REVISIONS AND SUCH REVISED SPECIFICATIONS AND SPECIAL PROVISIONS AS ARE INCORPORATED IN THESE PLANS.

DIRECTOR OF PROGRAM DEVELOPMENT	APPROVED <i>[Signature]</i> DATE 7-27-11
PROJECT MANAGER :	C. CARLSON
PROJECT NAME :	NEWFANE
PROJECT NUMBER :	BRF 0106 (3) S
SHEET 1 OF 70 SHEETS	