


CURVE #1 DATA
 ML PI STA 1+028.286
 DELTA= 5°26'50" RT
 R = 400.000 m
 T = 19.029 m
 L = 38.029 m
 E = 0.452 m

PLAN

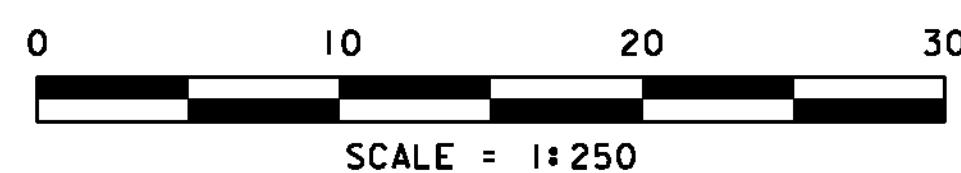

PROJECT NAME: NEWFANE
 PROJECT NUMBER: BRF 0106(3)S

FILE NAME: s95j280surv.dgn
 PROJECT LEADER: C. CARLSON
 DESIGNED BY: T. LACKEY
 SURVEY PLAN 1

PLOT DATE: 22-JUL-2011
 DRAWN BY: STR 3
 CHECKED BY: G. SWEENEY
 SHEET II OF 70