
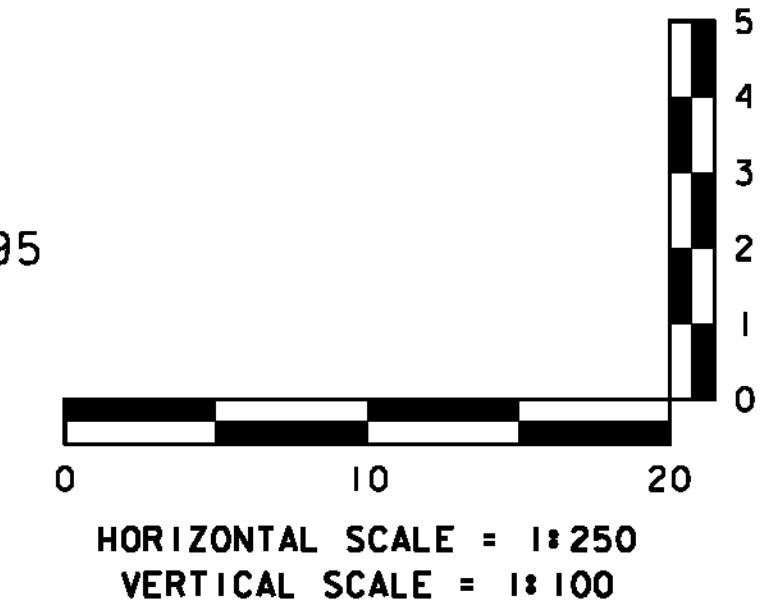



**PROFILE NOTES:**

1. PROFILE ELEVATIONS ARE GIVEN ALONG THE PROPOSED CENTERLINE.
2. EXISTING ELEVATIONS ARE GIVEN TO 0.01 m.
3. FINISH GRADE ELEVATIONS ARE GIVEN TO 0.001 m.


# TH #2

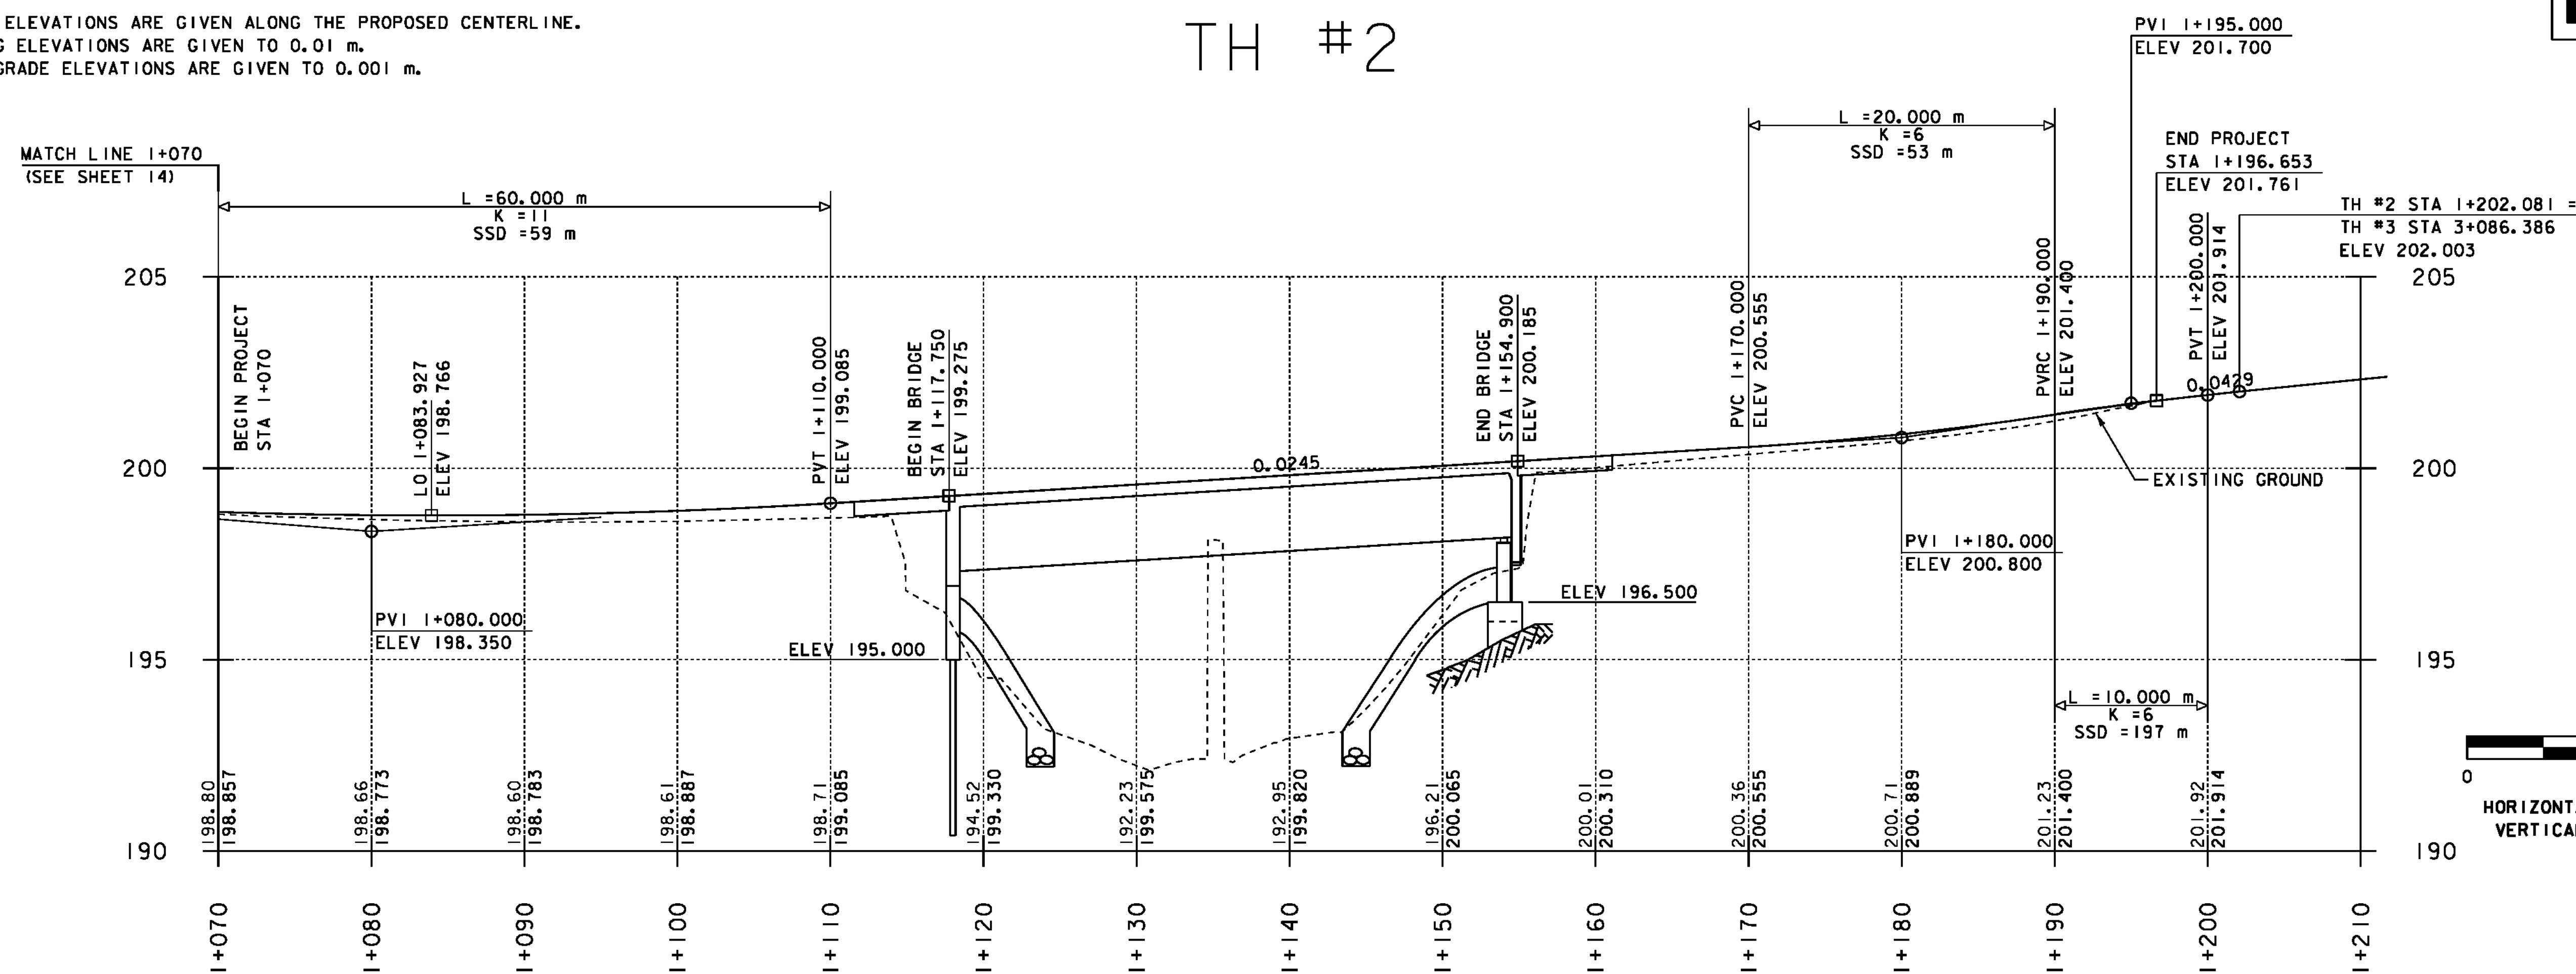

## PROFILE

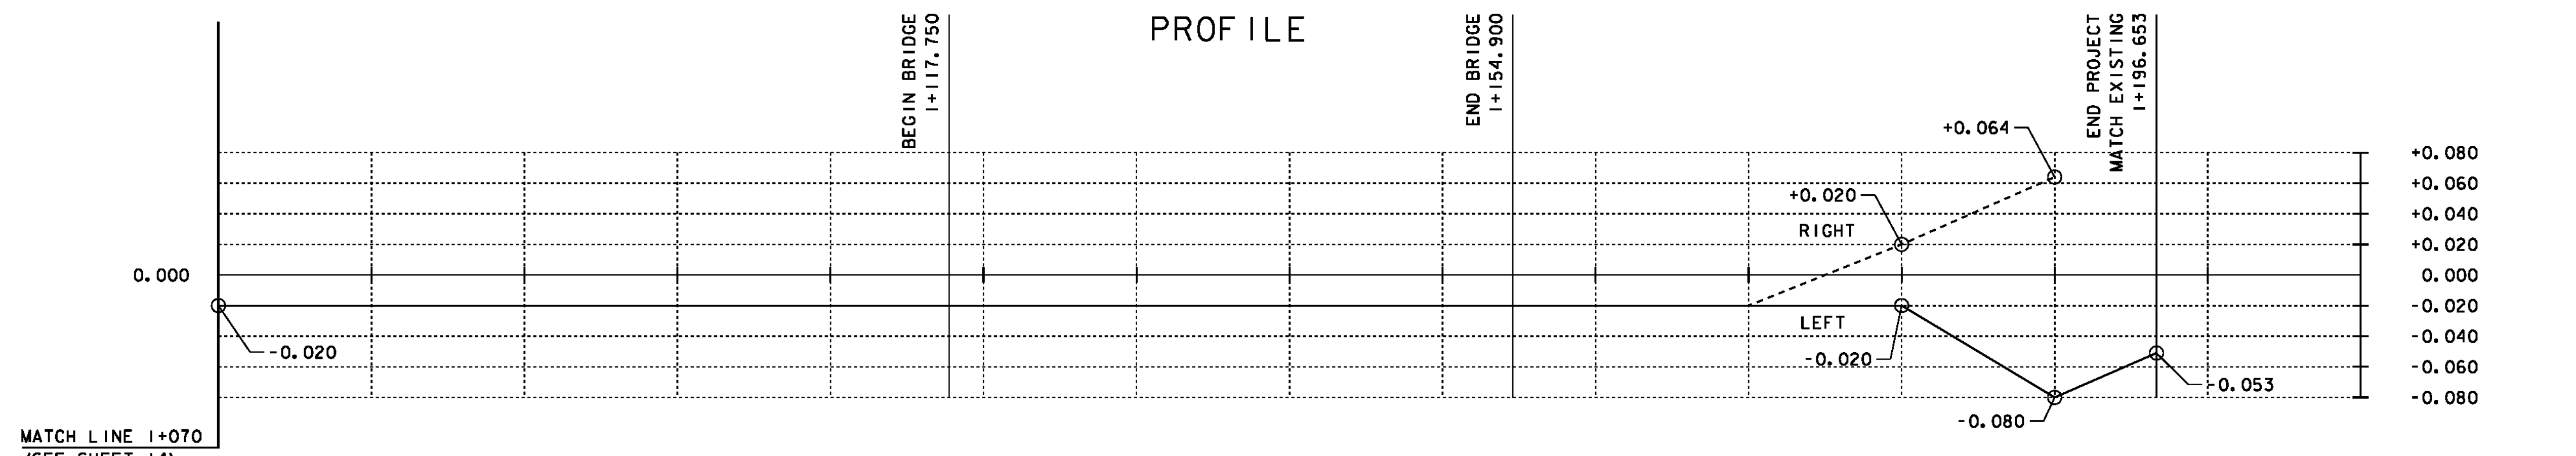

## SUPERELEVATION

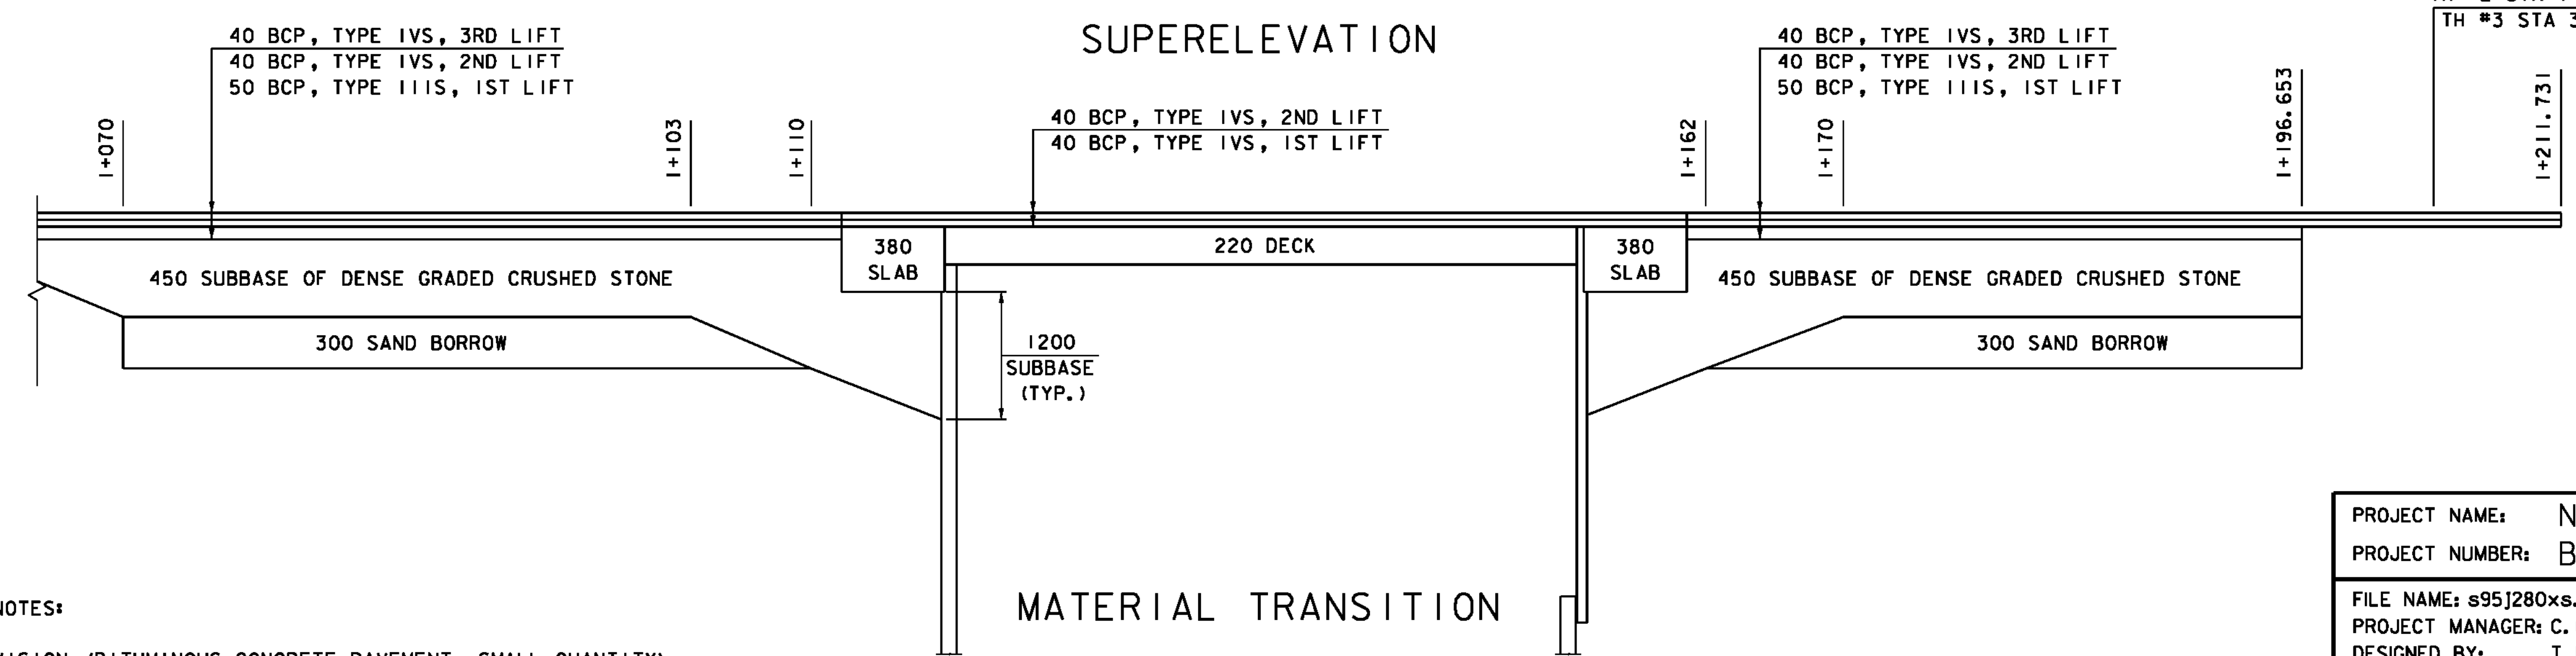

## MATERIAL TRANSITION

|                  |               |              |             |
|------------------|---------------|--------------|-------------|
| PROJECT NAME:    | NEWFANE       | PLOT DATE:   | 22-JUL-2011 |
| PROJECT NUMBER:  | BRF 0106 (3)S | DRAWN BY:    | C. MOONEY   |
| FILE NAME:       | s95J280xs.dgn | DESIGNED BY: | T. LACKEY   |
| PROJECT MANAGER: | C. CARLSON    | CHECKED BY:  | G. SWEENEY  |
| PROFILE SHEET 2  |               | SHEET 15     | OF 70       |