


DECK REINFORCING


SCALE 1:25

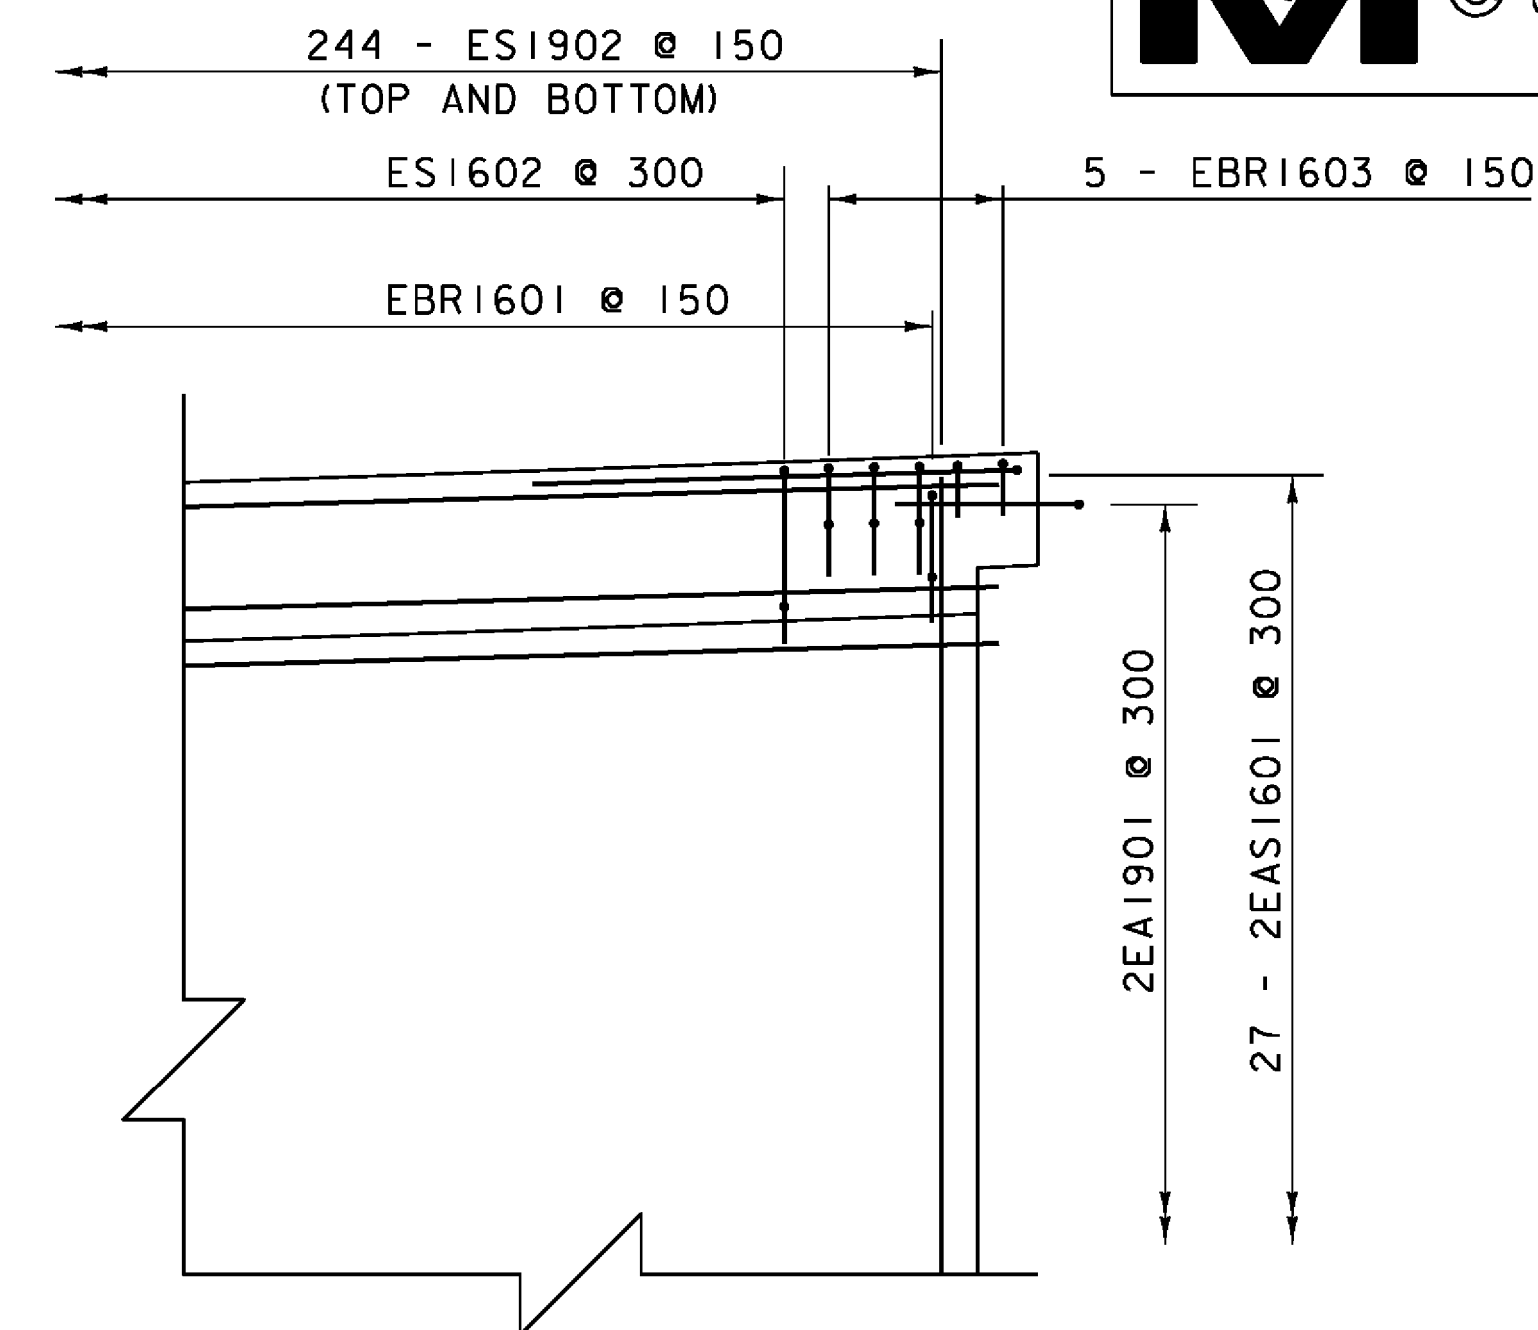

CURB SIDE CORNER SHOWN. SIDEWALK SIDE SIMILAR, SEE SHEET 45.

CORNER REINFORCING DETAIL

SCALE 1:25

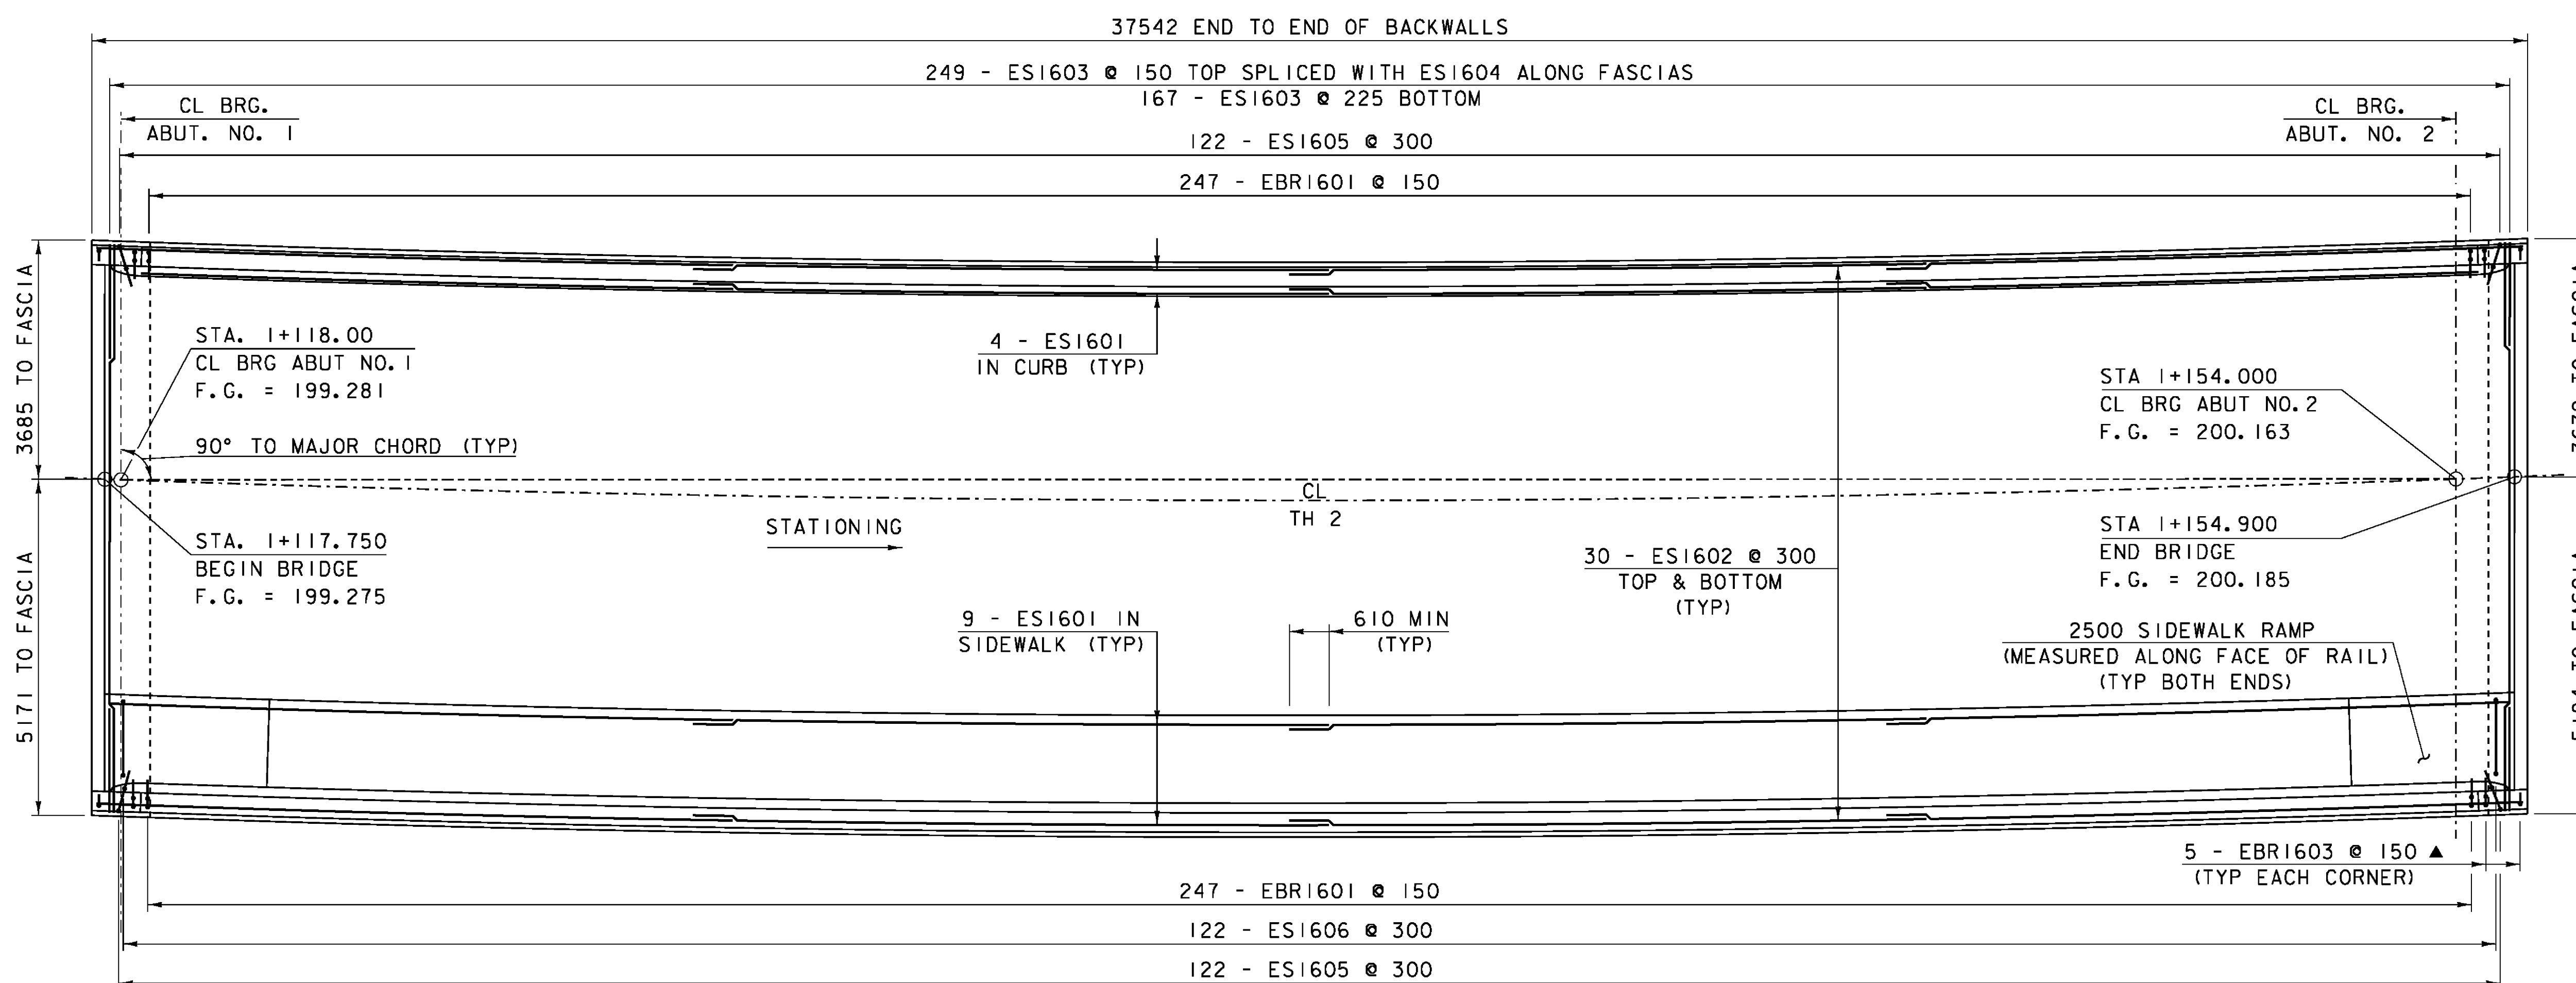

DECK REINFORCING PLAN

SCALE 1:60

BCP = SPECIAL PROVISION (BITUMINOUS CONCRETE PAVEMENT, SMALL QUANTITY)
 SEE BRIDGE RAILING DETAIL 1 FOR ADDITIONAL BRIDGE RAIL REINFORCING DETAILS
 SEE ABUTMENT TYPICALS SHEET FOR ADDITIONAL BACKWALL REINFORCING DETAILS

| KEY | DATE | BY | REVISION |
|-----|------------|------|---------------------------|
| △ | 04/24/2012 | VAOT | MODIFIED DECK DIMENSIONS. |

NOTES:
 NF = NEAR FACE
 FF = FAR FACE
 EF = EACH FACE
 ▲ = CUT TO FIT IN FIELD
 80 COVER UNLESS OTHERWISE SPECIFIED ON THE PLANS

| | |
|--------------------------------|------------------------|
| PROJECT NAME: NEWFANE | PLOT DATE: 25-APR-2012 |
| PROJECT NUMBER: BRF 0106 (3) S | DRAWN BY: C. MOONEY |
| FILE NAME: s95j280sup.dgn | CHECKED BY: G. SWEENEY |
| PROJECT LEADER: C. CARLSON | SHEET 26 OF 70 |
| DESIGNED BY: T. LACKEY | |
| DECK DETAILS | |