


APPROACH SLAB 1

SCALE = 1:40

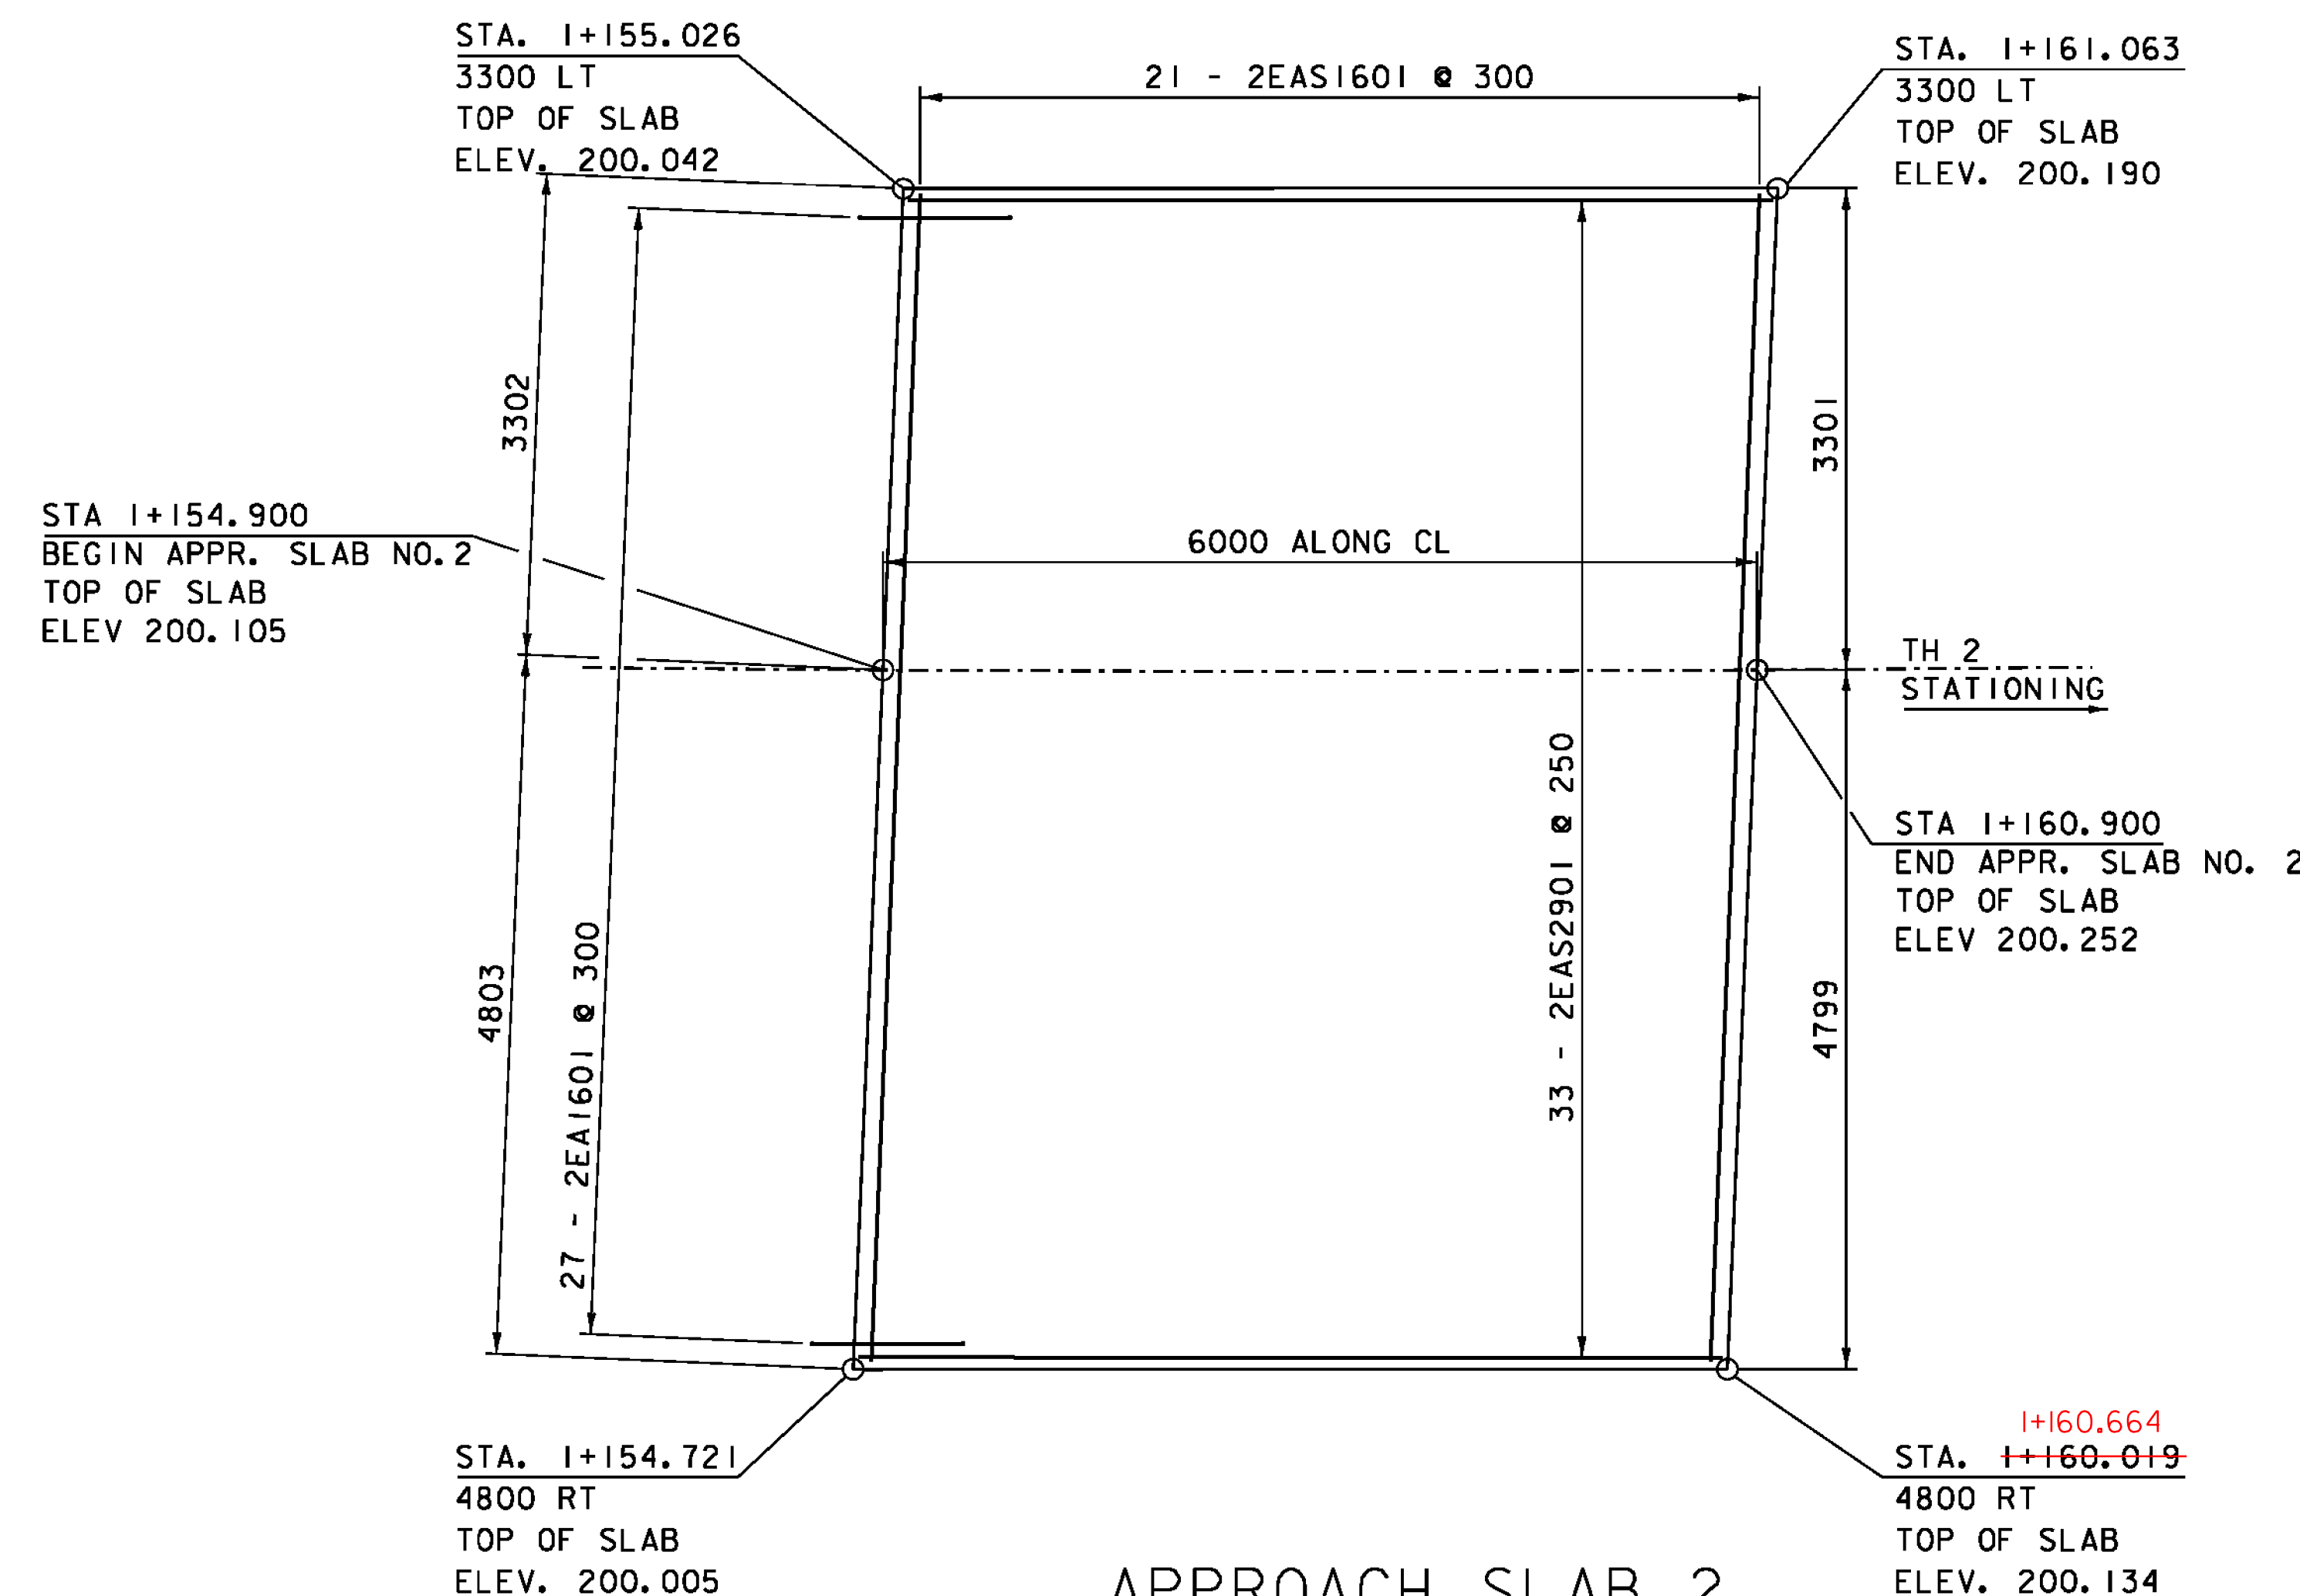


APPROACH SLAB 2

SCALE = 1:40

BCP = SPECIAL PROVISION (BITUMINOUS CONCRETE PAVEMENT, SMALL QUANTITY)

NOTES:

1. COMPACT THE SUBBASE IN THE AREA UNDER THE APPROACH SLAB TO A SMOOTH SURFACE.
2. MATERIAL FOR POLYETHYLENE SHEETING SHALL MEET THE REQUIREMENTS OF SUBSECTION 725.01(c) OF THE STANDARD SPECIFICATIONS. THE SHEETING THICKNESS SHALL BE 0.30 MILLIMETERS. PLACE THE SHEETING ON TOP OF THE FINISHED SUBBASE FOR THE FULL LENGTH AND WIDTH OF THE APPROACH SLAB, EXCEPT IN THE BRACKET AREA AT THE ABUTMENT. LAP SHEETING AT LEAST 600 MILLIMETERS.
3. POUR APPROACH SLAB CONCRETE IN THE EARLY MORNING BEFORE THE SUPERSTRUCTURE EXPANDS.
4. APPLY 2 COATS TAR EMULSION MEETING THE REQUIREMENTS OF SUBSECTION 702.05.
5. PAYMENT FOR POLYETHYLENE SHEETING AND TAR EMULSION WILL BE CONSIDERED INCIDENTAL TO CONTRACT ITEM 501.34.

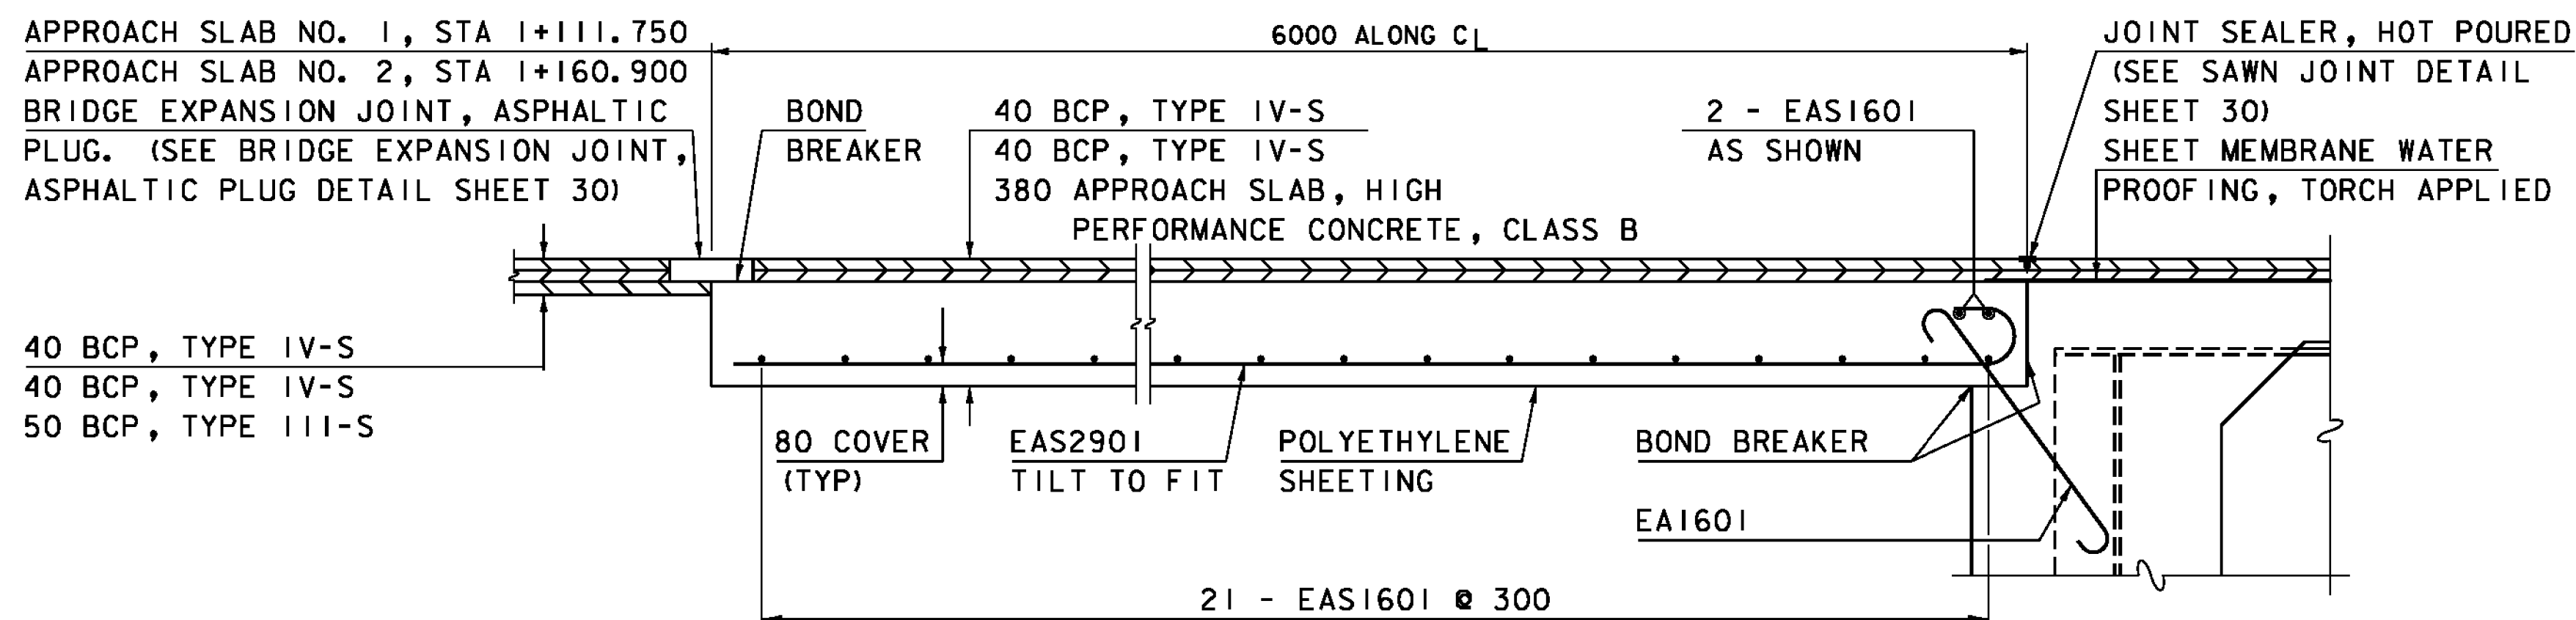

APPROACH SLAB TYPICAL SECTION

SCALE = 1:20

NOTES:

- NF = NEAR FACE
- FF = FAR FACE
- EF = EACH FACE
- ▲ = CUT TO FIT IN FIELD
- 80 COVER UNLESS OTHERWISE SPECIFIED ON THE PLANS

PROJECT NAME: NEWFANE	PLOT DATE: 22-JUL-2011
PROJECT NUMBER: BRF 0106 (3) S	DRAWN BY: C. MOONEY
FILE NAME: s95j280sub.dgn	CHECKED BY: G. SWEENEY
PROJECT LEADER: C. CARLSON	SHEET 29 OF 70
DESIGNED BY: T. LACKEY	
APPROACH SLAB DETAIL SHEET 1	