



ABUTMENT 2 PLAN
SCALE 1:25

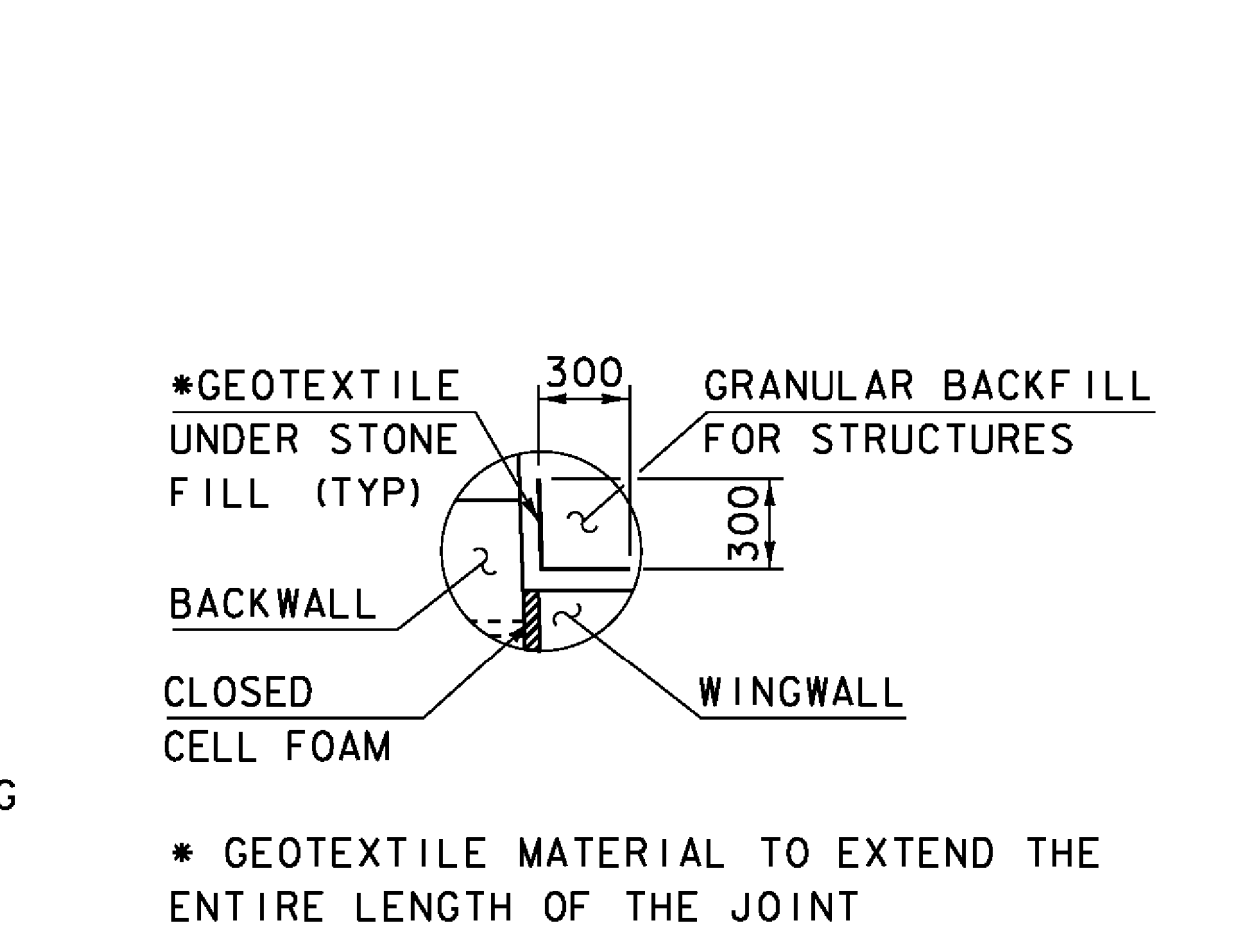

MATERIAL BUFFER DETAIL
SCALE 1:25

50 PREFORMED CLOSED CELL FOAM INCIDENTAL TO CONCRETE, HIGH PERFORMANCE CONCRETE CLASS B (TYP)

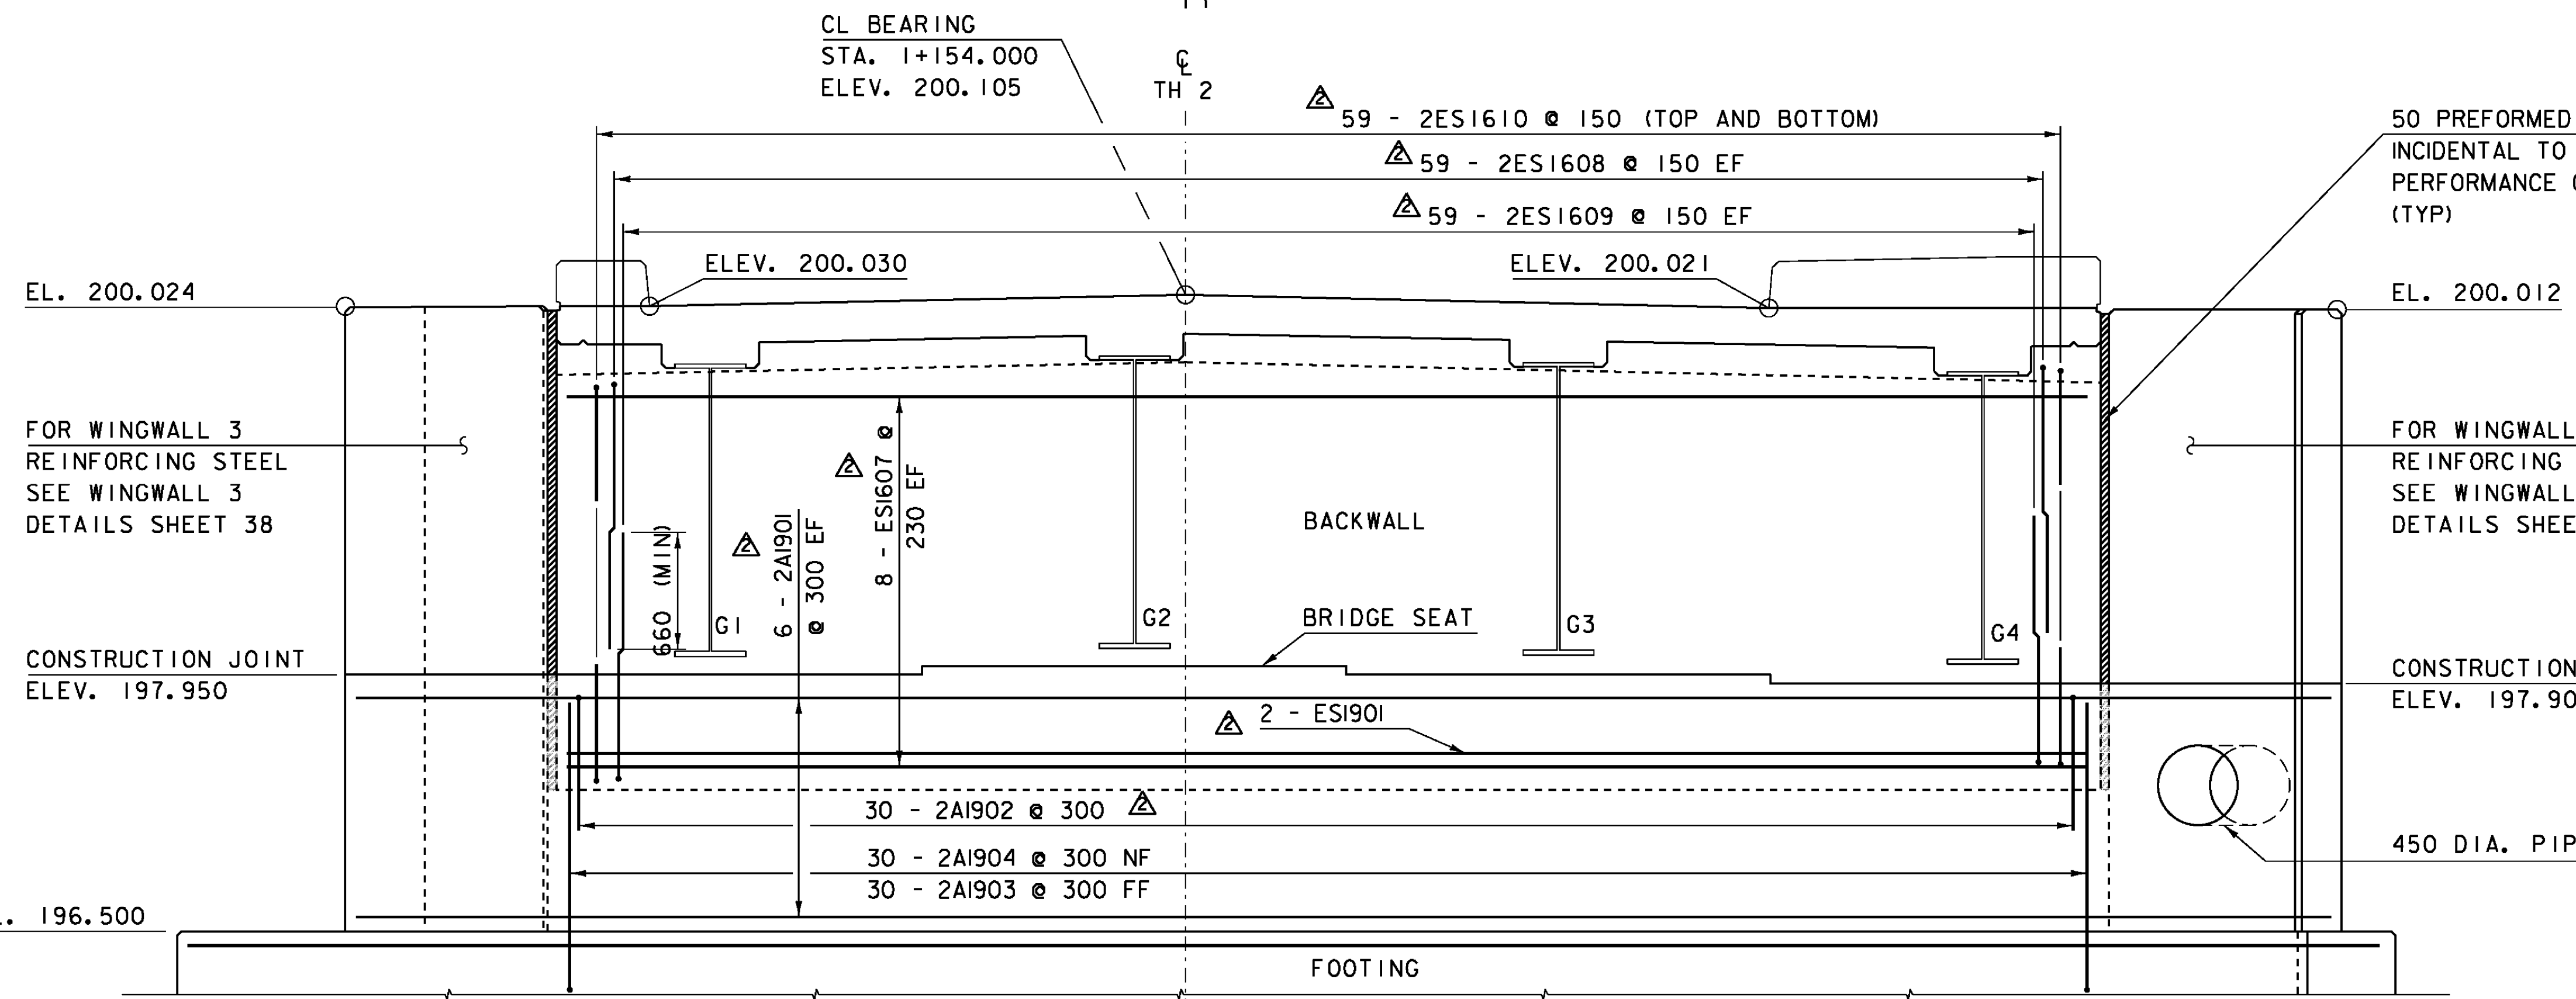

ABUTMENT 2 ELEVATION
SCALE 1:25

ABUTMENT 2 BRIDGE SEAT ELEVATION	
GIRDER 1	197.950
GIRDER 2	198.000
GIRDER 3	197.950
GIRDER 4	197.900

NOTES:
 NF = NEAR FACE
 FF = FAR FACE
 EF = EACH FACE
 ▲ = CUT TO FIT IN FIELD
 80 COVER UNLESS OTHERWISE SPECIFIED ON THE PLANS

KEY	DATE	BY	REVISION
▲	05/07/2012	VAOT	MODIFIED REINFORCING STEEL DIMENSIONS.
▲	04/24/2012	VAOT	MODIFIED ABUTMENT NO. 2 DIMENSIONS.

PROJECT NAME: NEWFANE
 PROJECT NUMBER: BRF 0106 (3) S

FILE NAME: s95j280sub.dgn PLOT DATE: 08-MAY-2012
 PROJECT LEADER: C. CARLSON DRAWN BY: C. MOONEY
 DESIGNED BY: T. LACKEY CHECKED BY: G. SWEENEY
 ABUTMENT 2 DETAILS SHEET 35 OF 70

NOTE:
 MAX BOTTOM OF FOOTING ELEV. 195.600
 SEE ABUTMENT 2 FOOTING REINFORCING PLAN (SHEET 36)